


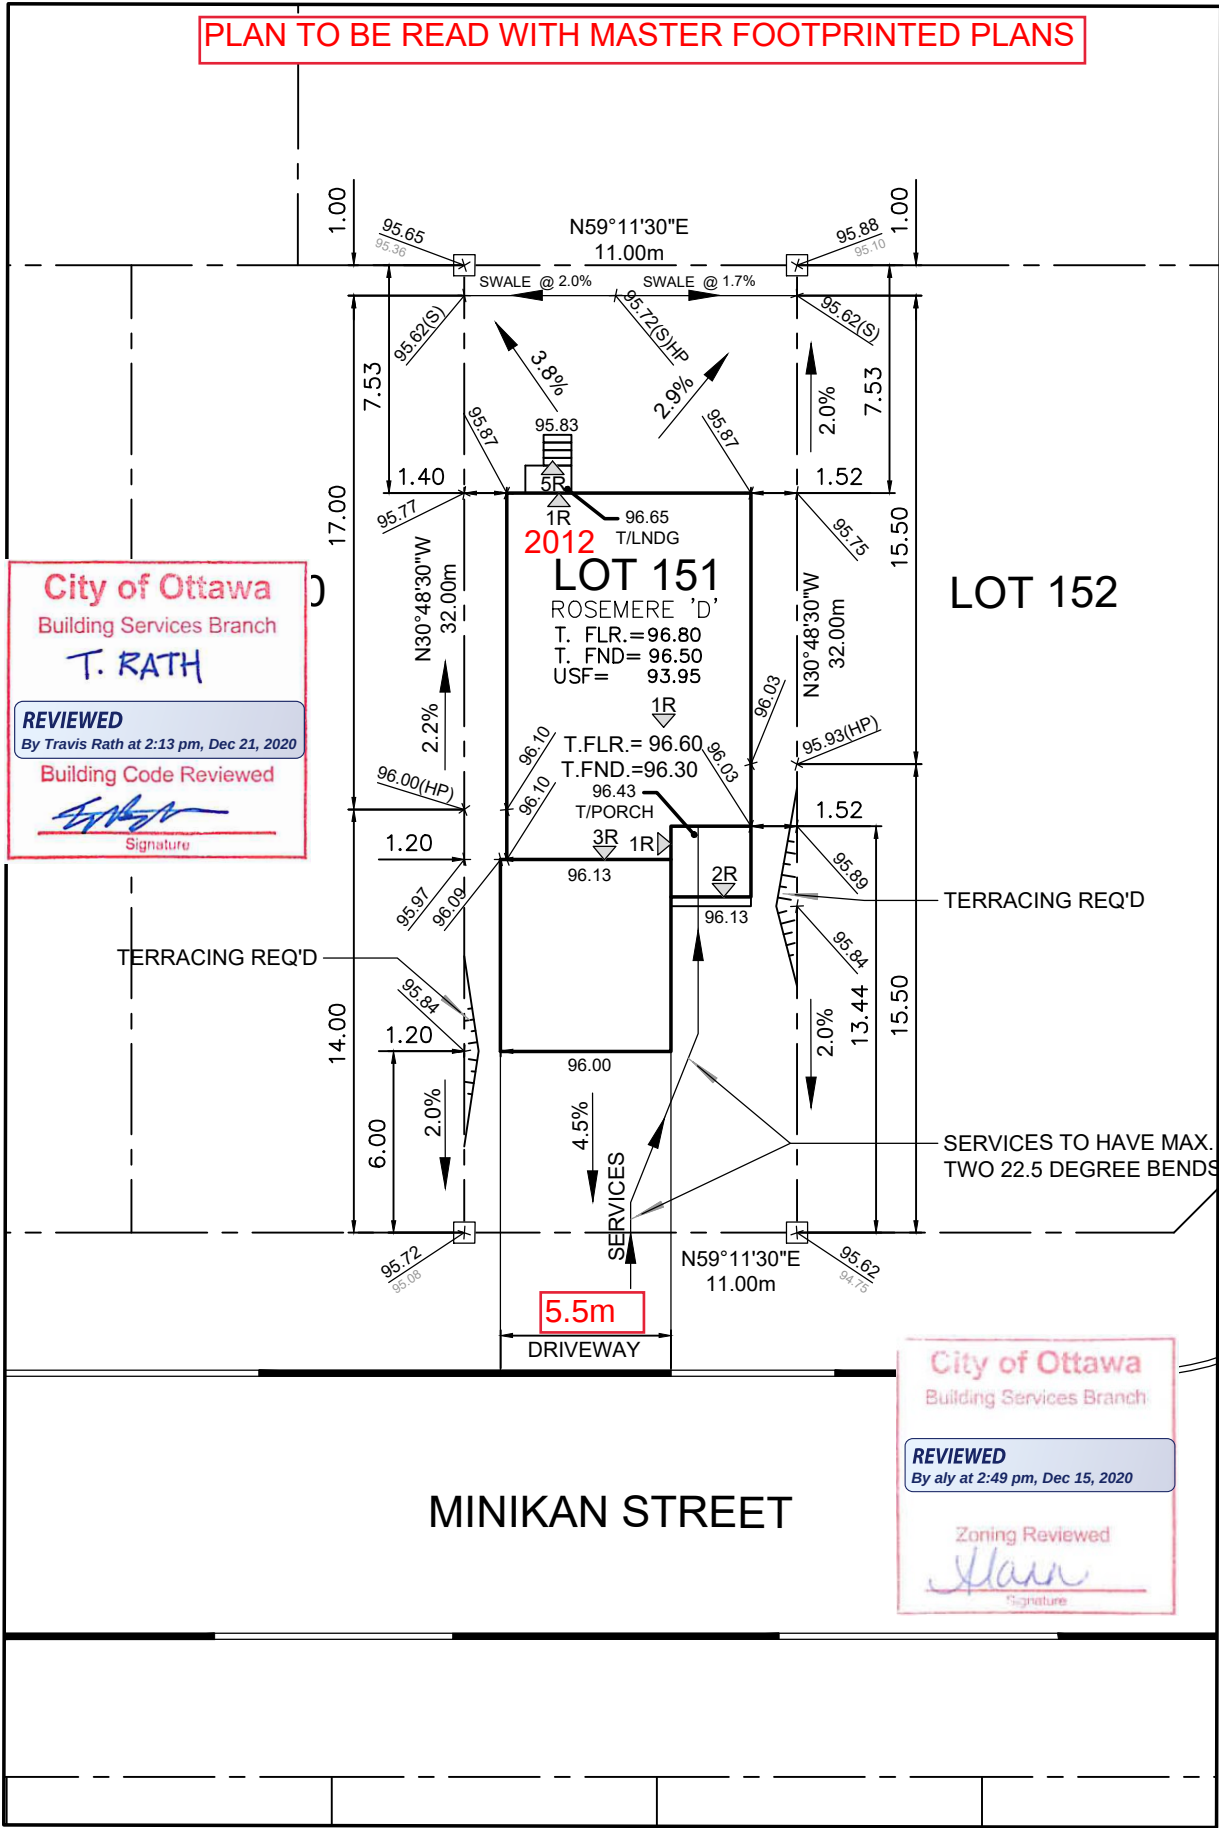

Owner/Applicant

DCR/PHOENIX HOMES

Telephone # 723-9227

Plan # 4M- 1617

Project name: PATHWAYS

Civic Address: 149 MINIKAN STREET

House model: ROSEMERE 'D'

Bldg. Ht. m

Lot coverage 38.9 %

Scale 1:250

Sod Area 206 m²

Asphalt Area 60 m²

CHECKED/APPROVED BY: T.L.MAK ENG.



SITE/GRADING PLAN
PATHWAYS

INDIVIDUAL LOT GRADING REVIEW SUMMARY FOR SITED
HOUSE AS COMPARED WITH OVERALL SUBDIVISION PLAN

NOTE: THIS PLAN IS NOT A SURVEY PLAN OR SUBDIVISION
PLAN WITHIN THE MEANING OF PLANNING ACT.

THIS PLAN IS FOR REFERENCE ONLY AND IS PRELIMINARY IN NATURE, ALL
DIMENSIONS SHOWN ARE APPROXIMATE. E.O&E.