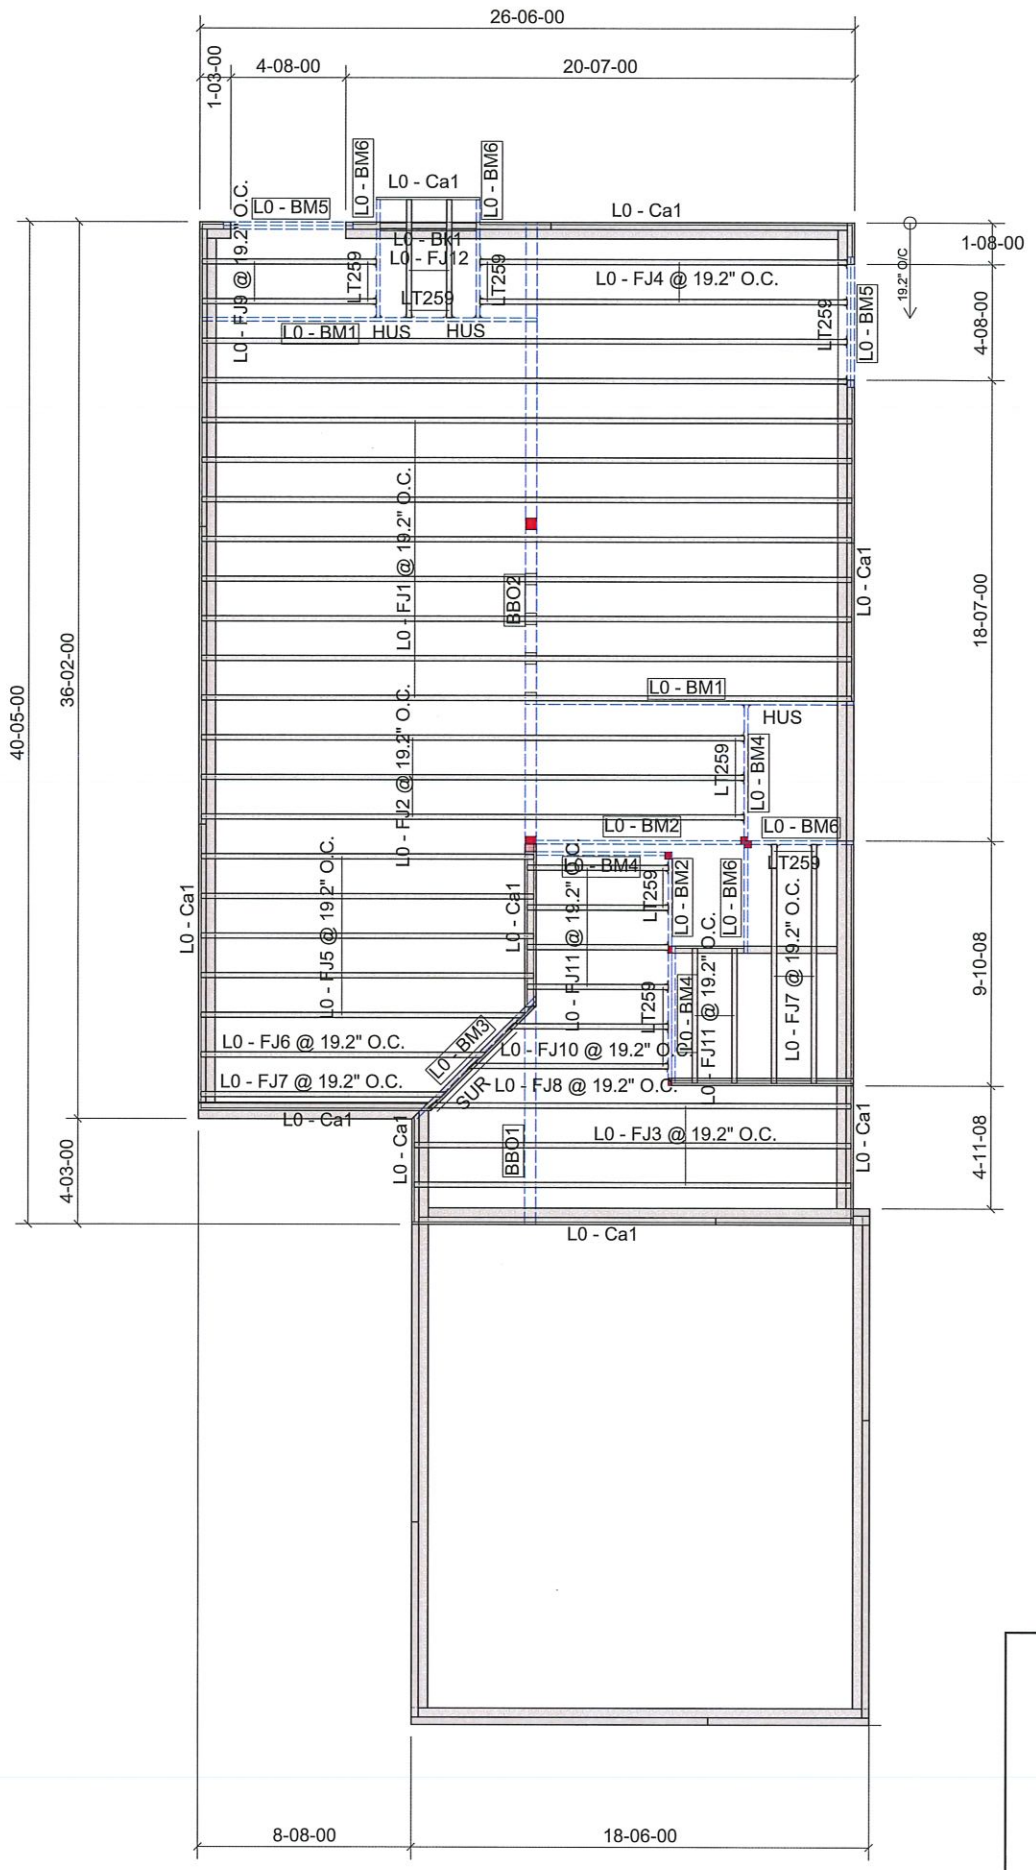

GLUED AND NAILED

LEVEL AND FLOOR CONTAINER NOTES	
Current Date:	10/30/2020
File Name:	Rosemere D.mmdl
Level Name:	1st Floor
Building Code - Design Methodology:	NBCC 2015
Floor Container:	FC1
Floor Area Loading is:	40 Live Load & 15 Dead Load
Maximum Allowed Deflection	L/480 Live Load & L/240 Total Load
Floor Container:	FC2
Floor Area Loading is:	40 Live Load & 15 Dead Load
Maximum Allowed Deflection	L/480 Live Load & L/240 Total Load
Floor Container:	FC5
Floor Area Loading is:	40 Live Load & 15 Dead Load
Maximum Allowed Deflection	L/480 Live Load & L/240 Total Load

Products

PlotID	Length	Product	Plies	Net Qty
L0 - FJ1 @ 19.2" O.C.	28-00-00	9 1/2" NI-20	1	10
L0 - FJ2 @ 19.2" O.C.	22-00-00	9 1/2" NI-20	1	3
L0 - FJ3 @ 19.2" O.C.	18-00-00	9 1/2" NI-20	1	3
L0 - FJ4 @ 19.2" O.C.	15-00-00	9 1/2" NI-20	1	2
L0 - FJ5 @ 19.2" O.C.	14-00-00	9 1/2" NI-20	1	5
L0 - FJ6 @ 19.2" O.C.	12-00-00	9 1/2" NI-20	1	1
L0 - FJ7 @ 19.2" O.C.	10-00-00	9 1/2" NI-20	1	3
L0 - FJ8 @ 19.2" O.C.	9-00-00	9 1/2" NI-20	1	1
L0 - FJ9 @ 19.2" O.C.	8-00-00	9 1/2" NI-20	1	2
L0 - FJ10 @ 19.2" O.C.	7-00-00	9 1/2" NI-20	1	1
L0 - FJ11 @ 19.2" O.C.	6-00-00	9 1/2" NI-20	1	6
L0 - FJ12 @ 19.2" O.C.	5-00-00	9 1/2" NI-20	1	2
L0 - BM1	14-00-00	1 3/4" x 9 1/2" (2.0E 3100) WestFraser LVL	1	2
L0 - BM2	10-00-00	1 3/4" x 9 1/2" (2.0E 3100) WestFraser LVL	1	2
L0 - BM3	8-00-00	1 3/4" x 9 1/2" (2.0E 3100) WestFraser LVL	1	1
L0 - BM4	6-00-00	1 3/4" x 9 1/2" (2.0E 3100) WestFraser LVL	1	3
L0 - BM5	6-00-00	1 3/4" x 9 1/2" (2.0E 3100) WestFraser LVL	2	4
L0 - BM6	5-00-00	1 3/4" x 9 1/2" (2.0E 3100) WestFraser LVL	1	4
L0 - Ca1	12-00-00	1 1/8" x 9 1/2" APA Rim Board	1	13
L0 - Bk1	4-00-00	9 1/2" NI-20	1	1

Accessories

PlotID	Length	Product	Plies	Net Qty
		3/4" Plywood or OSB (23/32" APA Rated Sheathing 48/24 Exposure 1)	1	32

Connector Summary

Qty	Manuf	Product	Skew	Supported Mtl
21	SIMPSON	LT259	-	9 1/2" NI-20
3	SIMPSON	SUR2569	45° (R)	9 1/2" NI-20
3	SIMPSON	HUS18110	-	9 1/2" WF LVL

ANGELO SARRAZIN
City of Ottawa
Building Services Branch
REVIEWED
By sarrazinan at 10:10 am, Nov 20, 2020
Building Code Reviewed

THIS DESIGN COMPLIES WITH:

- PART 4 OR 9 OF OBC 2012 Reg. 332/12
- NORDIC LAM CCMC: 13216-R
- NORDIC JOISTS CCMC: 13032-R
- WEST FRASER CCMC: 12904

(REFER TO INDIVIDUAL FLOOR DRAWINGS FOR SPECIFIC LOADS & SPACING)

FLOOR NOTES:

- FLOOR JOIST SYSTEMS ABOVE THE GARAGE HAS BEEN DESIGNED WITHOUT A DIRECTLY APPLIED CEILING. USE APPLICABLE BLOCKING OR STRAPPING WHERE REQUIRED AS INDICATED ON THE FRAMING PLAN.
- BLOCKING MATERIAL WILL BE SUPPLIED AND INDICATED AS "BLOCKING". NO LONGER ONLY 12' LENGTHS.

GRANDOR LUMBER INC.

JOB:
PHOENIX HOMES
MODEL: ROSEMERE D
1ST FLOOR 1 OF 2

DATE: 10/30/2020