


<p align="center">CUSTOMER APPROVAL</p> <p>I have reviewed these drawings and understand the details of the design and the Cartier Kitchens specifications</p> <p>Signature _____</p> <p>Date _____</p>	<p>All dimensions _size designations given are subject to verification on job site and adjustment to fit job conditions.</p>		<p>This is an original design and must not be released or copied unless applicable fee has been paid or job order placed.</p>	<p>Designed: 12/1/2020 Printed: 12/1/2020</p>
	<p>DCR #28 WTR - 517 Rutherford ALT Kitchen 2</p>			<p>All</p>

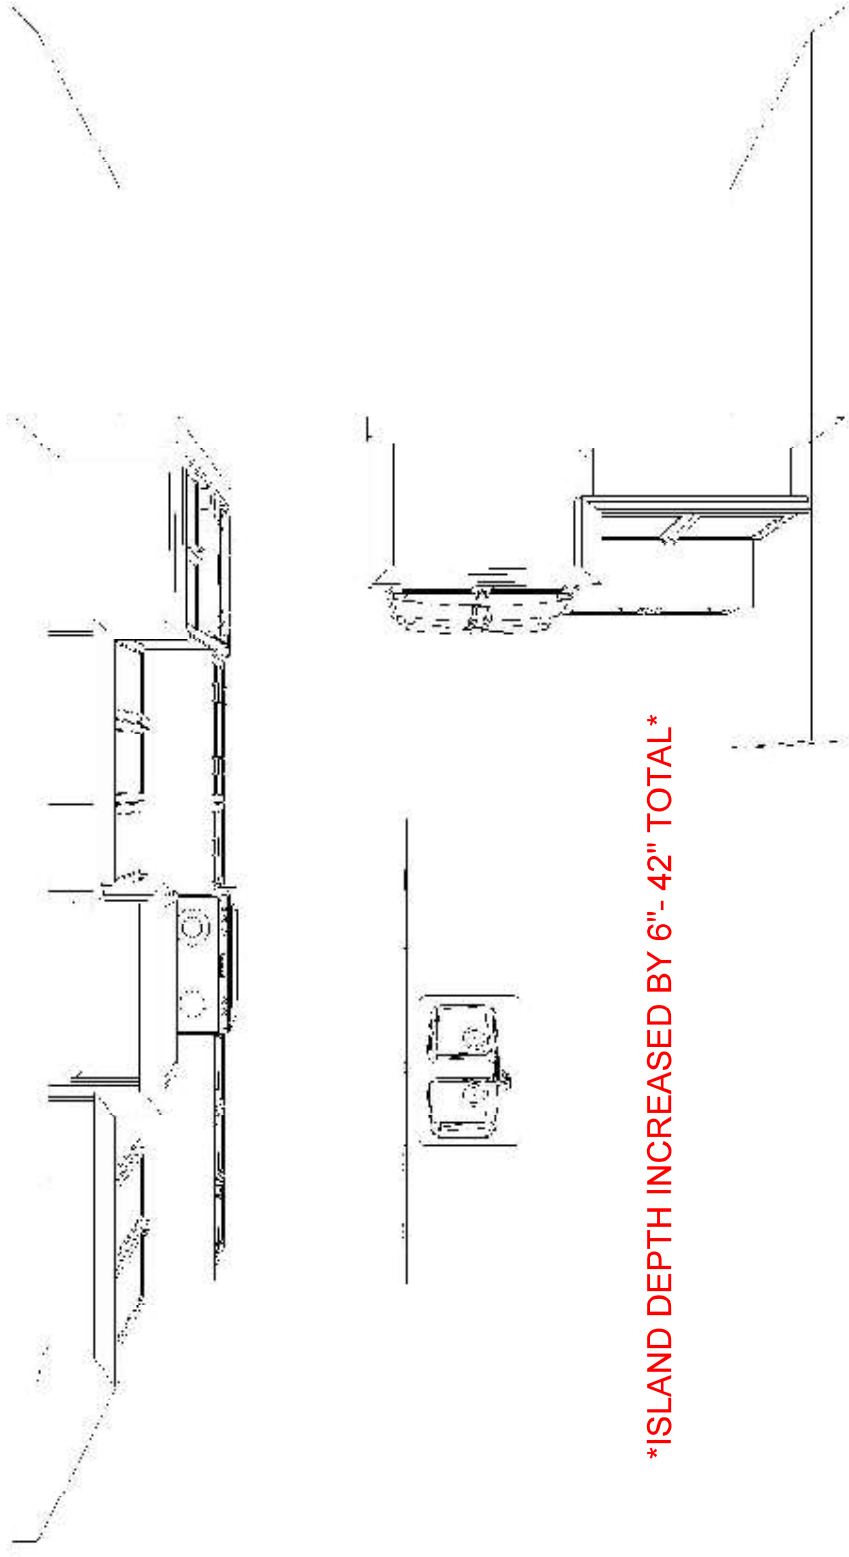

ISLAND DEPTH INCREASED BY 6" - 42" TOTAL


KITCHEN - TOP VIEW


CUSTOMER APPROVAL

I have reviewed these drawings and understand the details of the design and the Cartier Kitchens specifications

Signature _____

Date _____

Note: This drawing is an artistic interpretation of the general appearance of the design. It is not meant to be an exact rendition.		Designed: 12/1/2020 Printed: 12/1/2020	
		DCR #28 WTR - 517 Rutherford ALT Kitchen 2	All Drawing #: 1

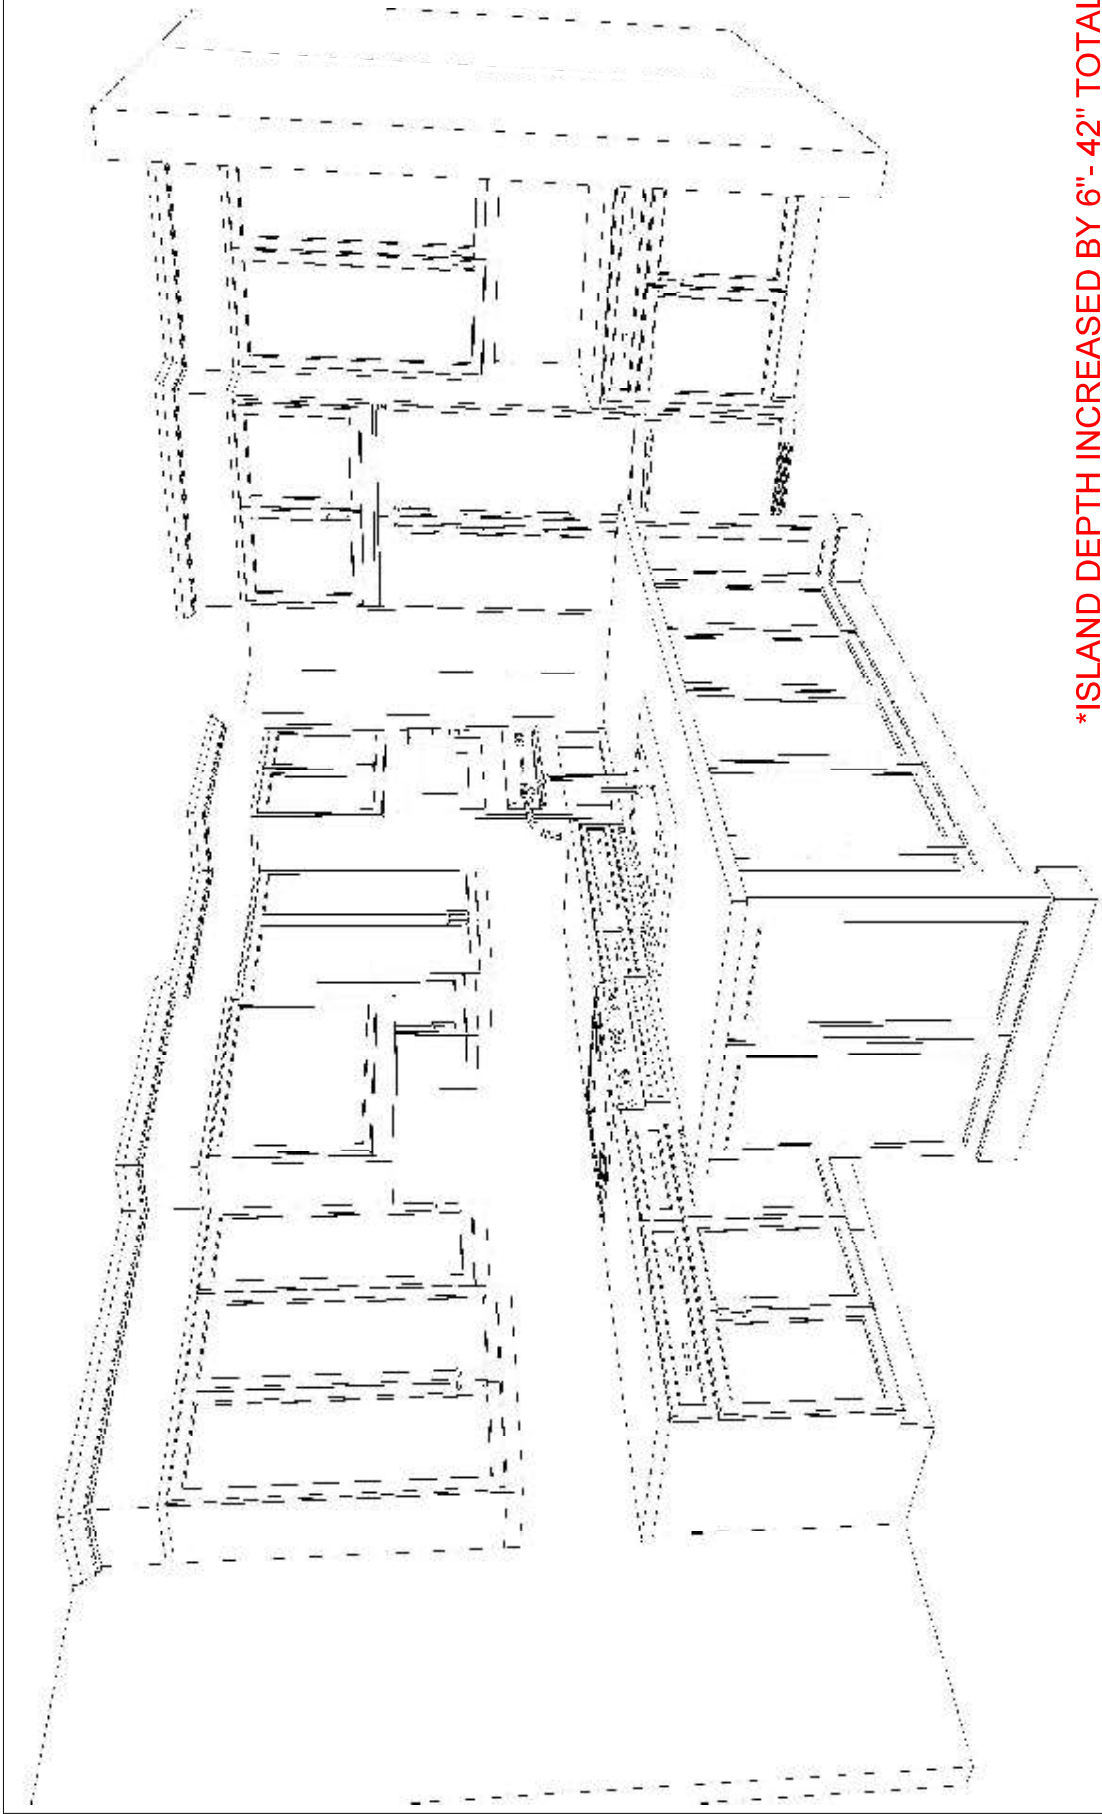

*ISLAND DEPTH INCREASED BY 6" - 42" TOTAL *


KITCHEN - 3D VIEW #1


CUSTOMER APPROVAL

I have reviewed these drawings and understand the details of the design and the Cartier Kitchens specifications

Signature _____

Date _____

Note: This drawing is an artistic interpretation of the general appearance of the design. It is not meant to be an exact rendition.		Designed: 12/1/2020 Printed: 12/1/2020	
		DCR #28 WTR - 517 Rutherford ALT Kitchen 2	All
		Drawing #: 1	

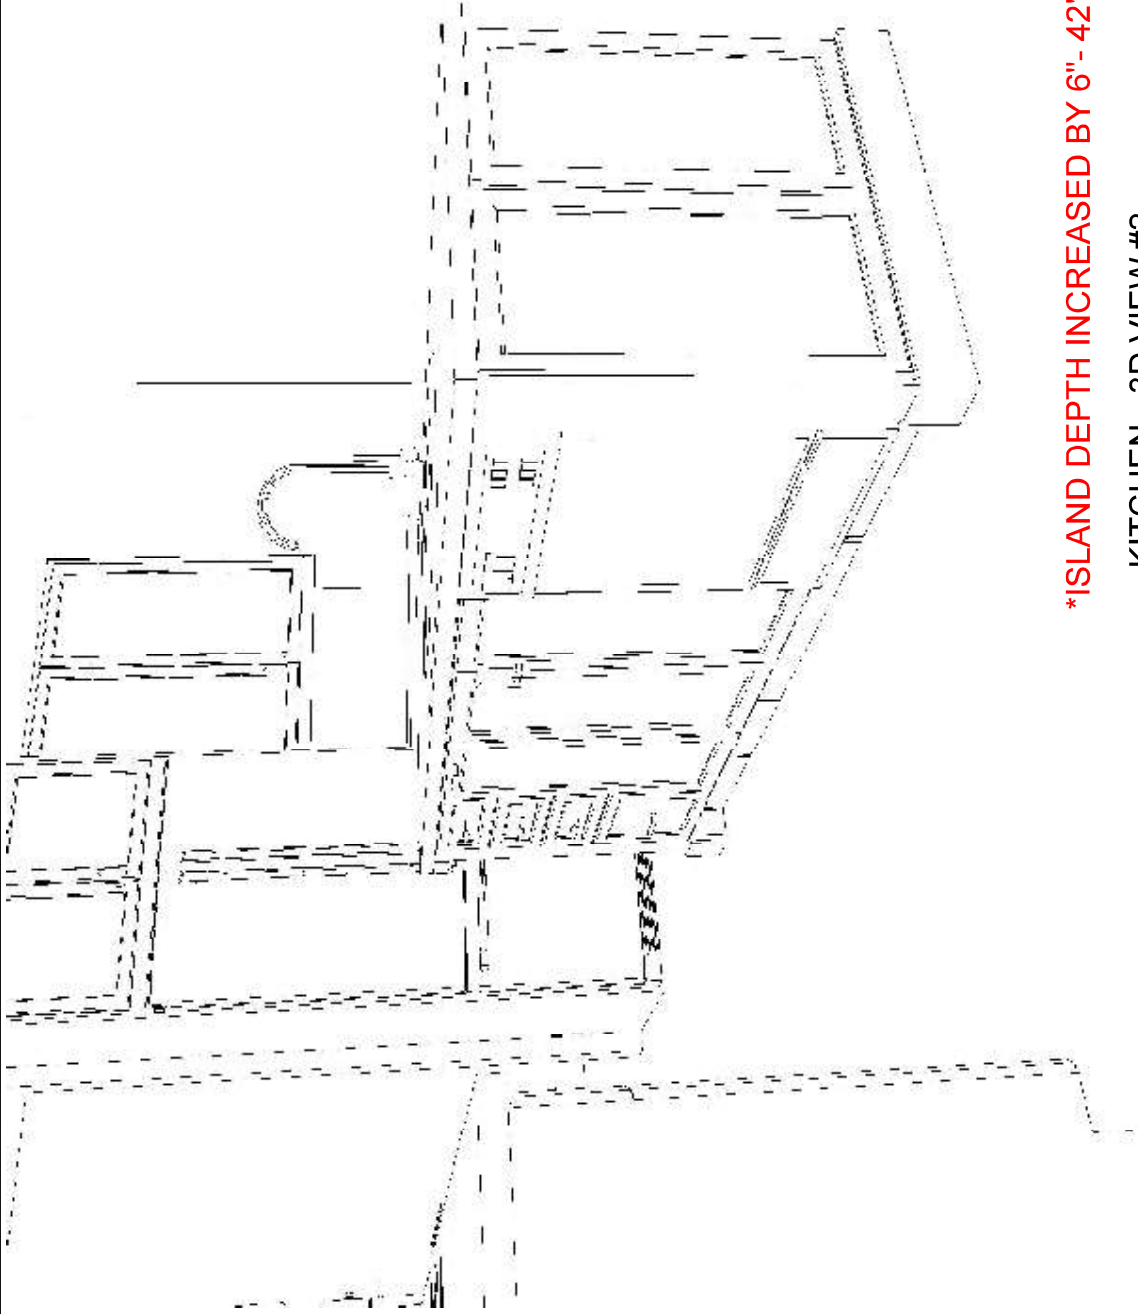

ISLAND DEPTH INCREASED BY 6" - 42" TOTAL

KITCHEN - 3D VIEW #2

CUSTOMER APPROVAL

I have reviewed these drawings and understand the details of the design and the Cartier Kitchens specifications

Signature _____

Date _____

Note: This drawing is an artistic interpretation of the general appearance of the design. It is not meant to be an exact rendition.




Designed: 12/1/2020
Printed: 12/1/2020

Drawing #: 1

All

DCR #28 WTR - 517 Rutherford ALT Kitchen 2

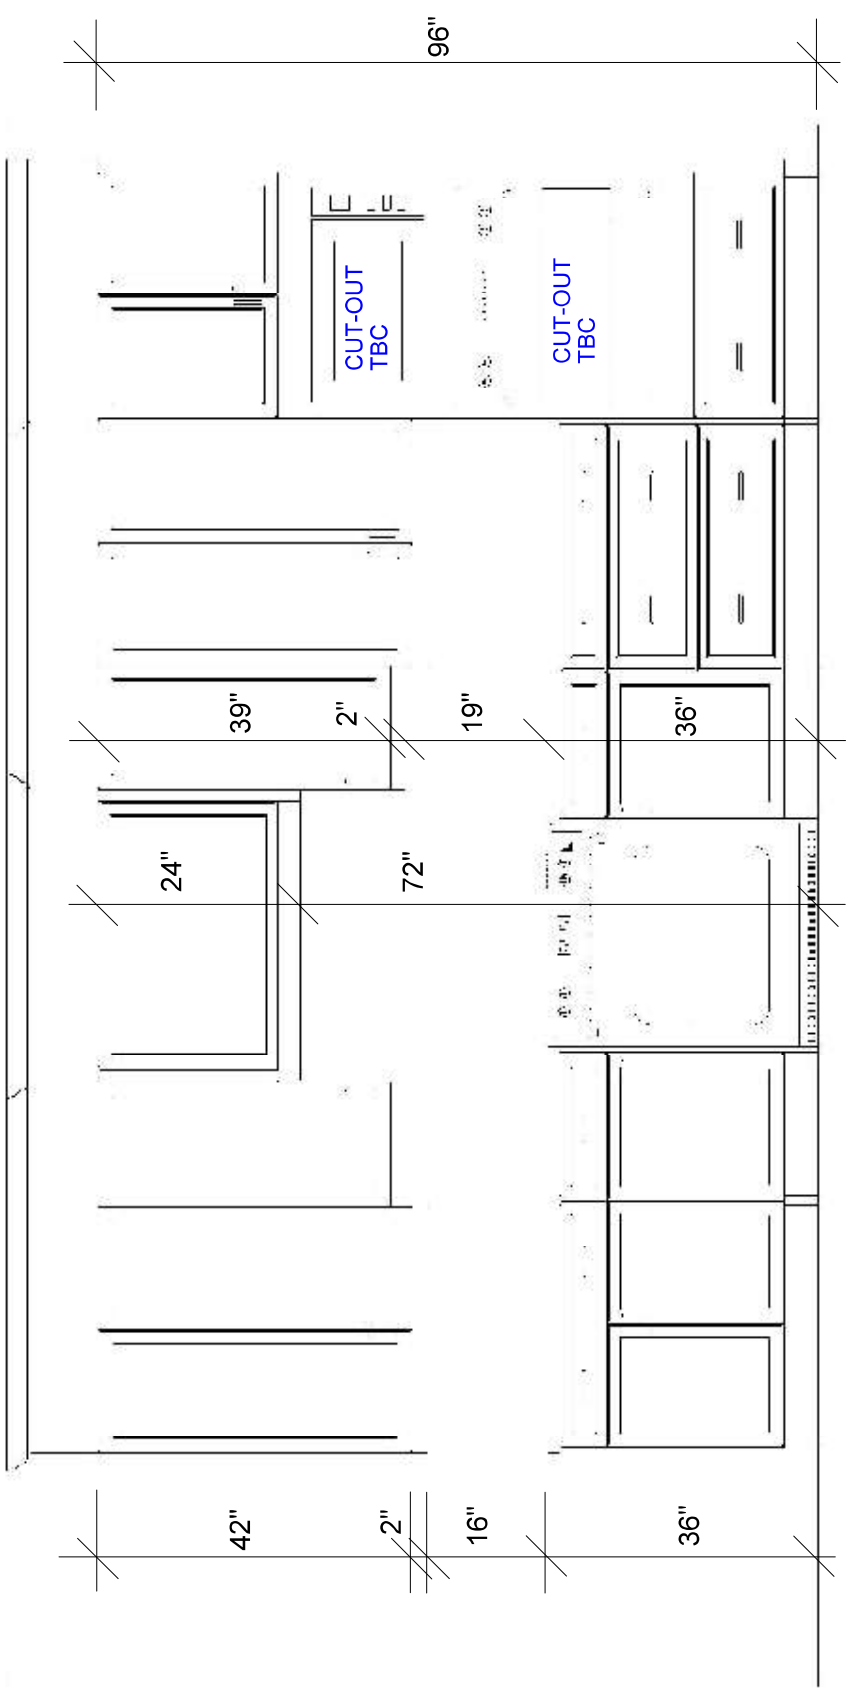


RANGE / WALL OVEN WALL ELEVATION

CUSTOMER APPROVAL


I have reviewed these drawings and understand the details of the design and the Cartier Kitchens specifications

Signature _____

Date _____

Note: This drawing is an artistic interpretation of the general appearance of the design. It is not meant to be an exact rendition.		Designed: 12/1/2020 Printed: 12/1/2020	
		DCR #28 WTR - 517 Rutherford ALT Kitchen 2	All
		Drawing #: 1	

1" MOULDING + PANEL + CEILING CROWN

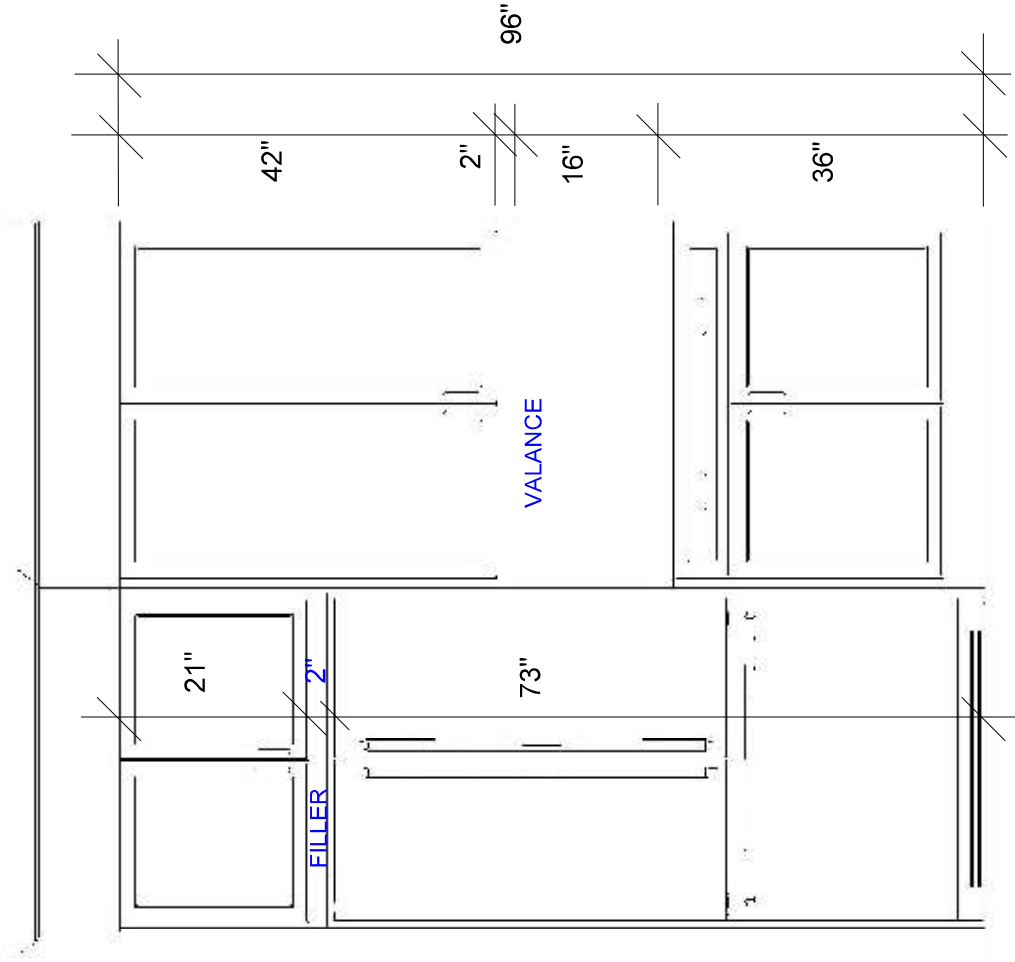

FRIDGE WALL ELEVATION

CUSTOMER APPROVAL

I have reviewed these drawings and understand the details of the design and the Cartier Kitchens specifications

Signature _____

Date _____

Note: This drawing is an artistic interpretation of the general appearance of the design. It is not meant to be an exact rendition.



Designed: 12/1/2020
Printed: 12/1/2020

Drawing #: 1

All

DCR #28 WTR - 517 Rutherford ALT Kitchen 2