TF7 UNIT 128

DCR PHOENIX HOMES
TERRA FLATS

MODEL - TYPE A (LOWER FLOOR)

KITCHEN / VANITIES

MOUNTING HEIGHT - 84

LINE 1
HARDWARE - U1
STANDARD WHITE INTERIOR
METAL DRAWER BOX
3 PCS - 5/8" KICK - FIN. BOTH ENDS
2 PCS - LOOSE FILLER - 6 x 96
2 PCS - 90 DEG. CORNER MOULD
1 PCS - T-MOULDING
4 PCS - FLAT MOULDING

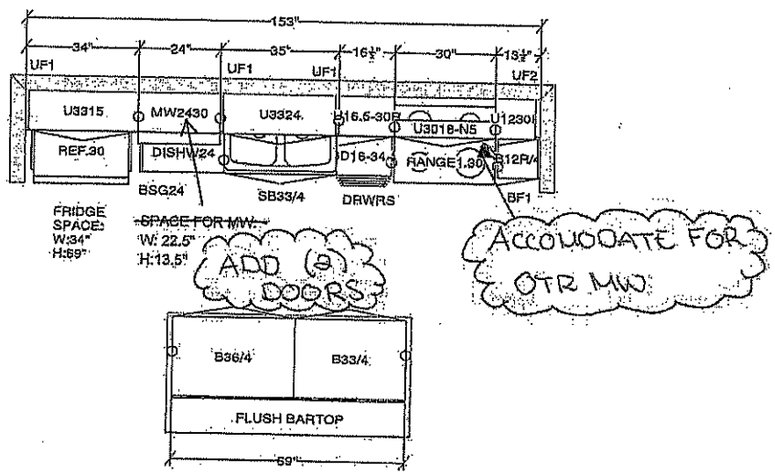

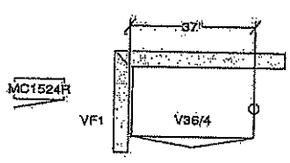

MAIN BATH

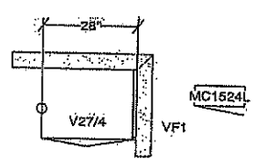

ENSUITE

All dimensions size designations shown are subject to modification to job site and adjustment to fit job conditions.	SPECTRUM	This is an original design and must not be released or copied unless applicable fee has been paid or job order placed.	Designed: 2017-04-04 Printed: 2017-04-07
TYPE A		All	Drawing #: 1 | No Scale

RK.

MB