


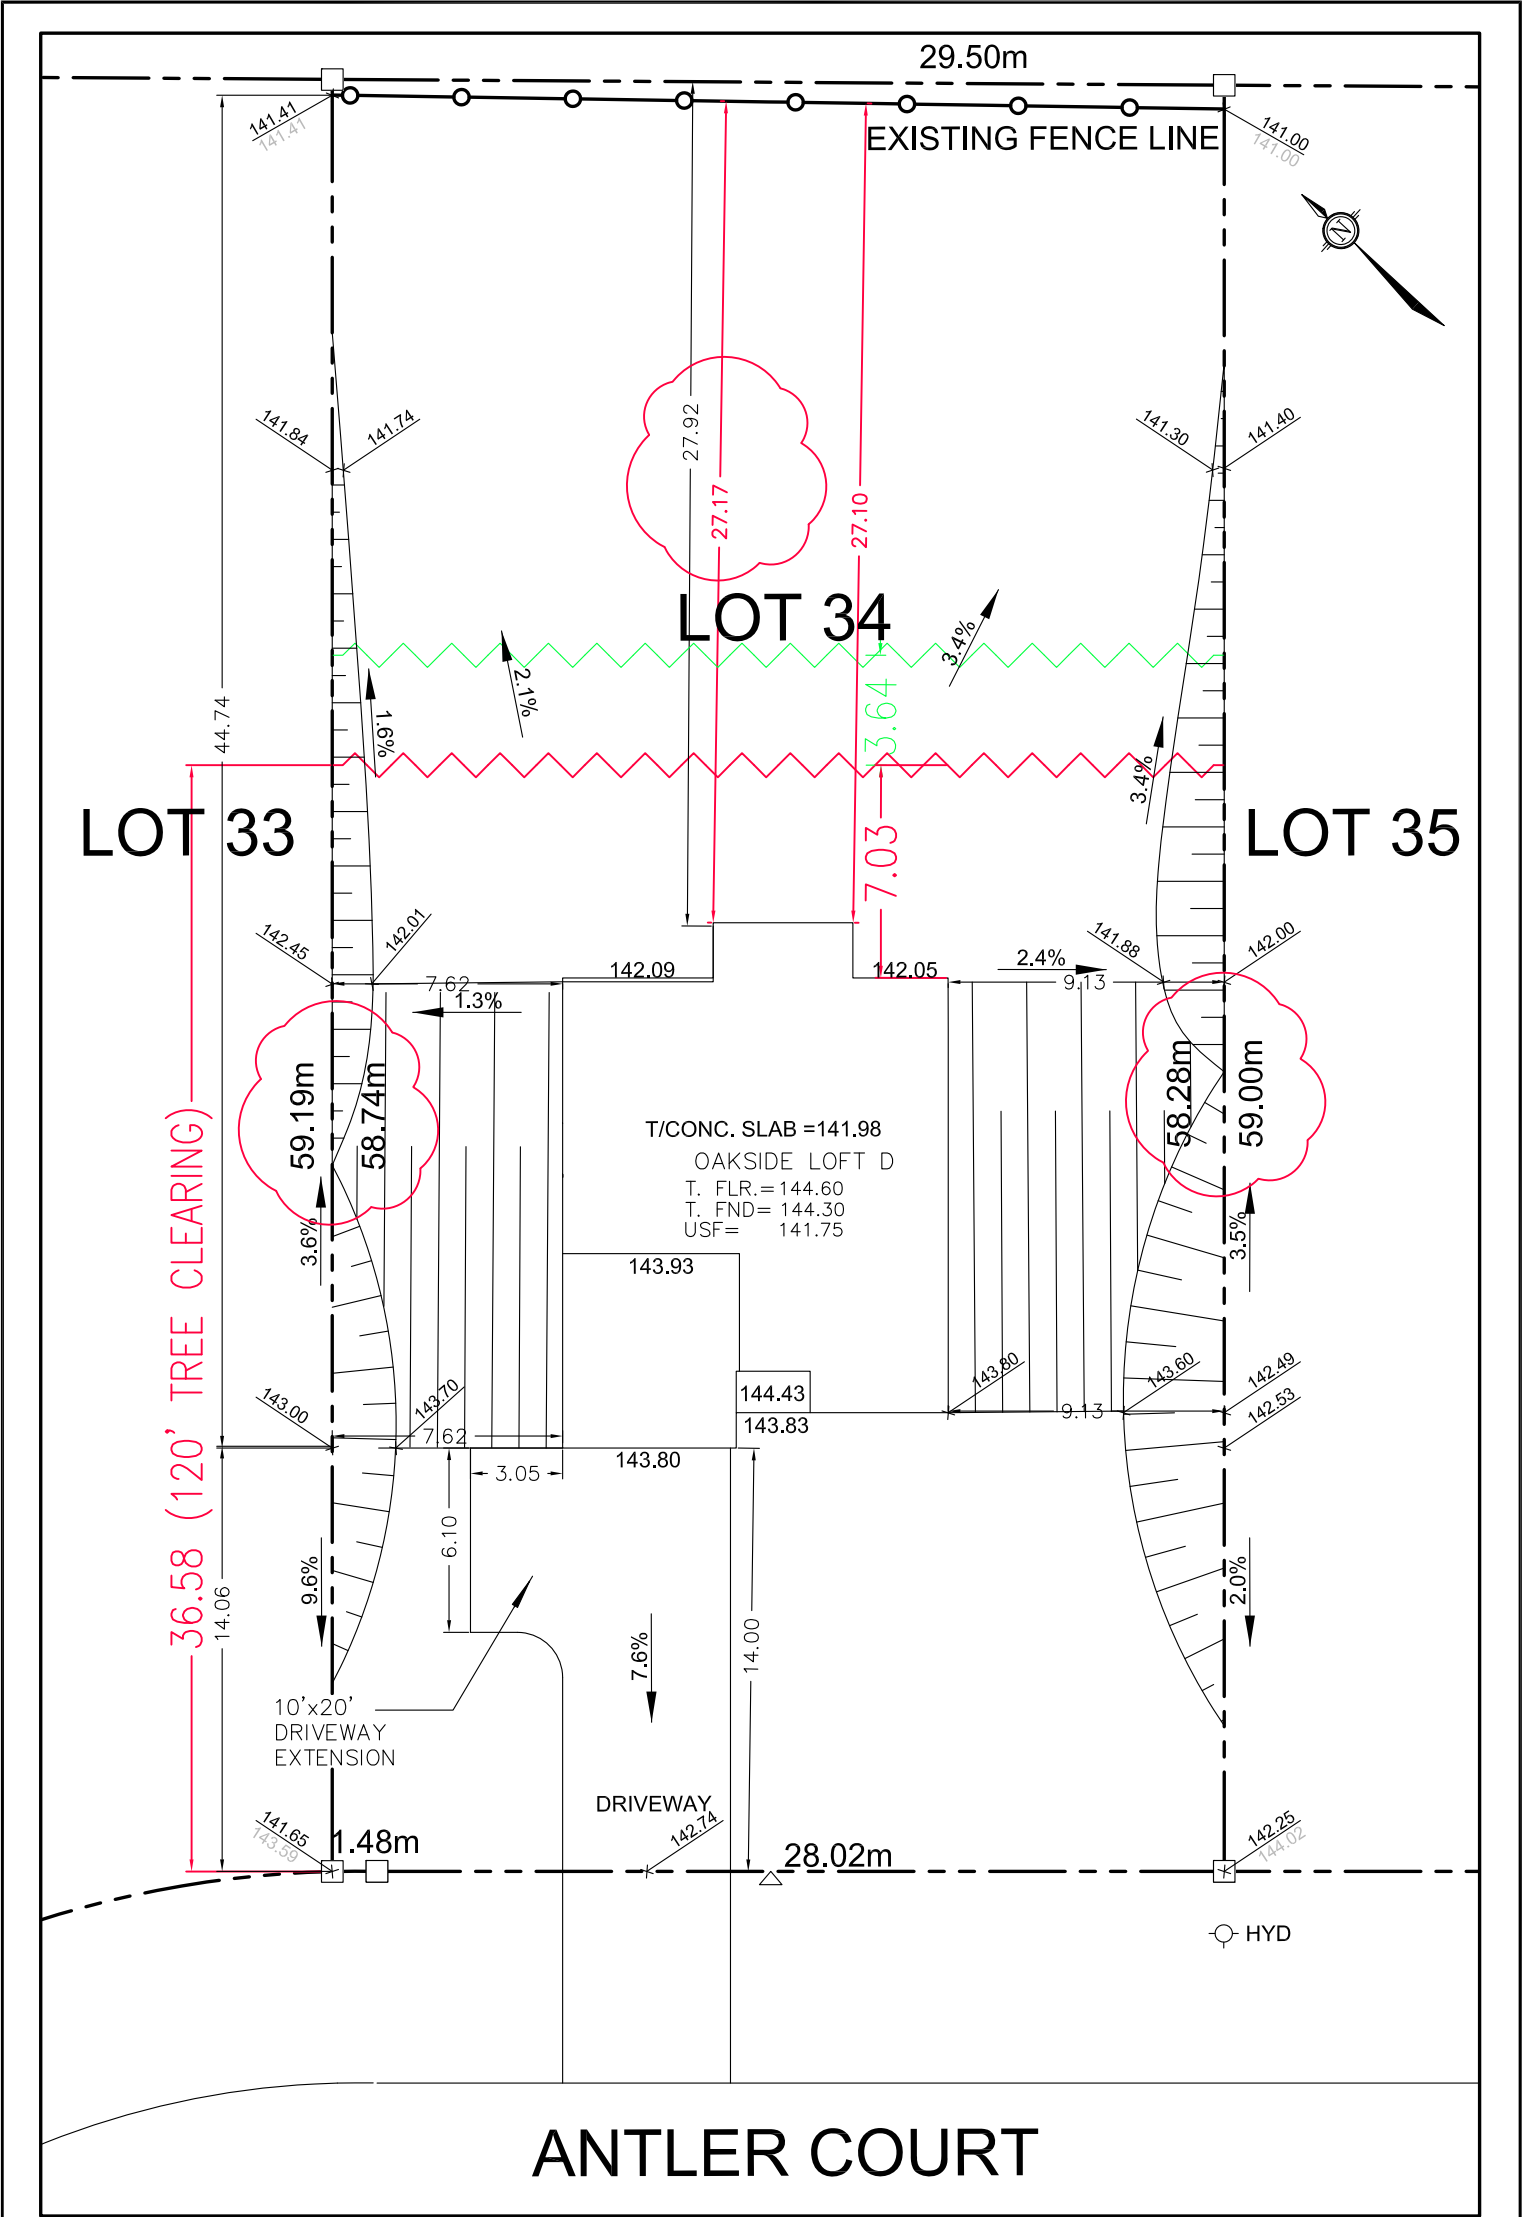

DCR/PHOENIX HOMES

Plan # 27M-47
Address: 246 ANTLER COURT
House model:
Lot coverage 11.2 %
Scale 1:250
Asphalt area 135 m²

CHECKED/APPROVED BY: T.L.MAK ENG.

REVISED JUNE 24,2021



LOT 34 SITE/GRADING PLAN
WHITE TAIL RIDGE PH.II

INDIVIDUAL LOT GRADING REVIEW SUMMARY FOR SITED HOUSE AS COMPARED WITH OVERALL SUBDIVISION PLAN
NOTE: THIS PLAN IS NOT A SURVEY PLAN OR SUBDIVISION PLAN WITHIN THE MEANING OF PLANNING ACT.
THIS PLAN IS FOR REFERENCE ONLY AND IS PRELIMINARY IN NATURE, ALL DIMENSIONS SHOWN ARE APPROXIMATE. E,O&E.