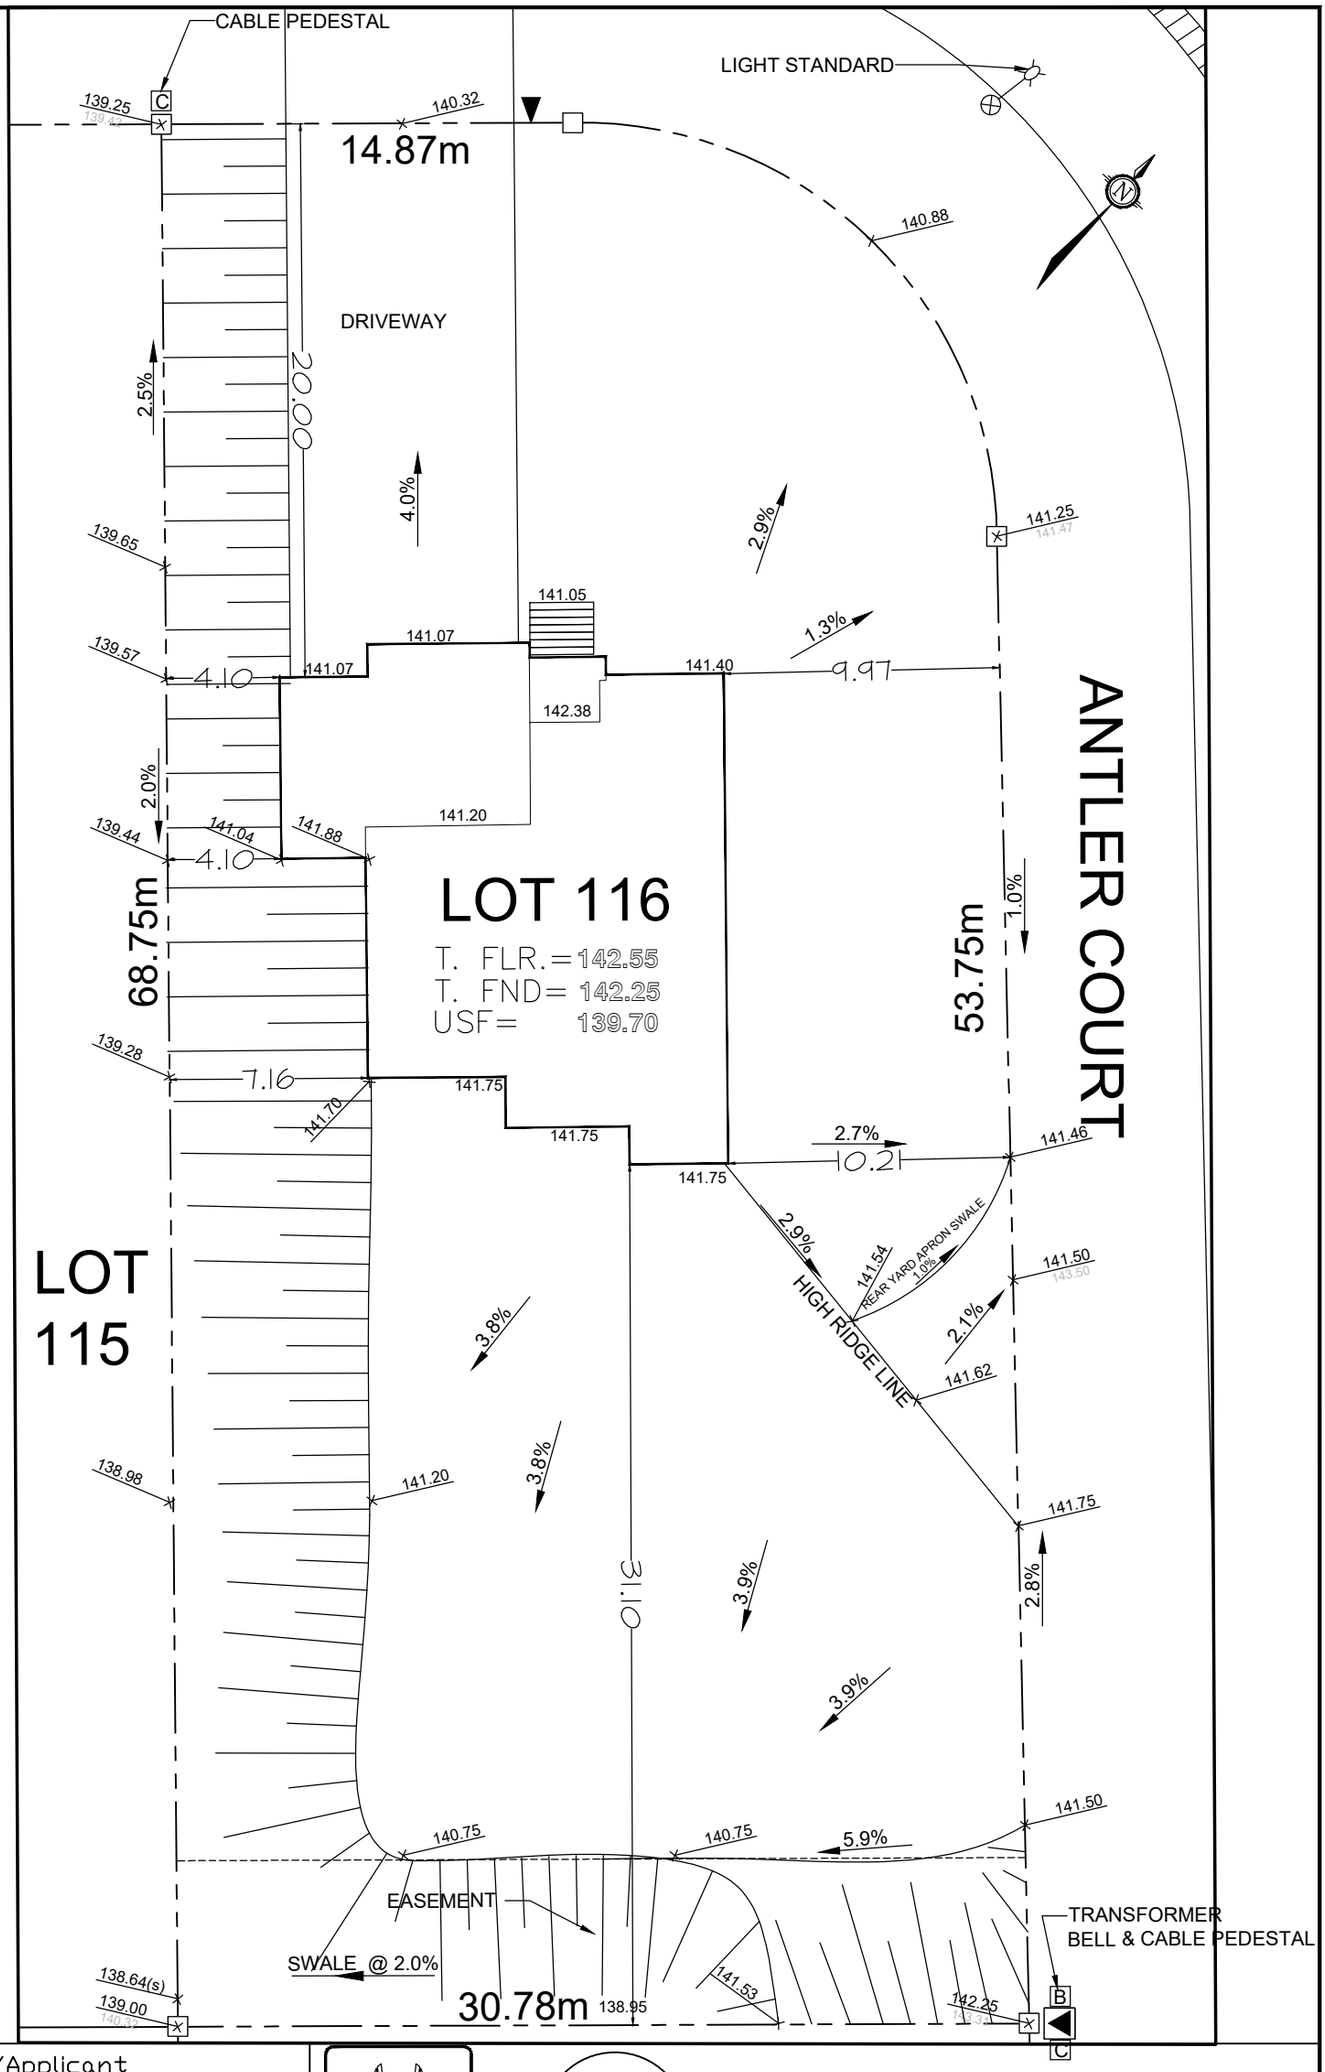

Owner/Applicant
DCR/PHOENIX HOMES

Telephone # 723-9227
Plan # 27m-47
Civic Address: 233 ANTLER COURT
House model: OAKSIDE E
Lot coverage 12.8 %
Scale 1:400

Asphalt Area 226 m^2

CHECKED/APPROVED BY: T.L.MAK ENG.
May 3 (modified)

PHOENIX HOMES

LOT 6

SITE/GRADING PLAN
WHITE TAIL RIDGE PH.II

INDIVIDUAL LOT GRADING REVIEW SUMMARY FOR SITED HOUSE AS COMPARED WITH OVERALL SUBDIVISION PLAN

NOTE: THIS PLAN IS NOT A SURVEY PLAN OR SUBDIVISION PLAN WITHIN THE MEANING OF PLANNING ACT.

THIS PLAN IS FOR REFERENCE ONLY AND IS PRELIMINARY IN NATURE, ALL DIMENSIONS SHOWN ARE APPROXIMATE. E,O&E.