




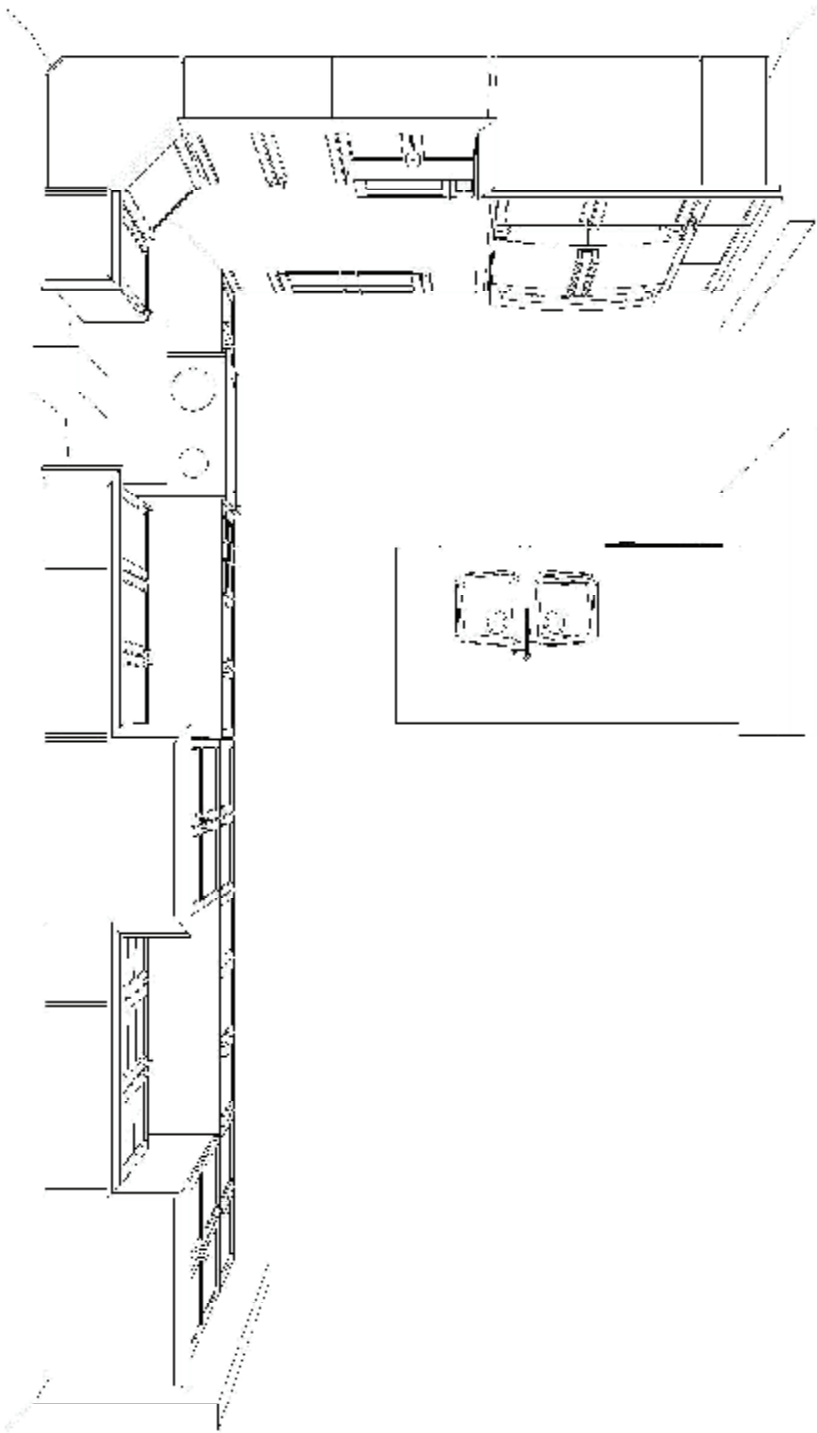


KITCHEN - TOP VIEW

|   |                                                                                     |                                             |              |
|---|-------------------------------------------------------------------------------------|---------------------------------------------|--------------|
| Note: This drawing is an artistic interpretation of the general appearance of the design. It is not meant to be an exact rendition. |  | Designed: 11/27/2020<br>Printed: 11/27/2020 |              |
|   |                                                                                     | DCR #156 PWYS - Melbourne 4 Bdrmt           | Drawing #: 1 |

CUSTOMER APPROVAL


I have reviewed these drawings and understand the details of the design and the Cartier Kitchens specifications

 \_\_\_\_\_

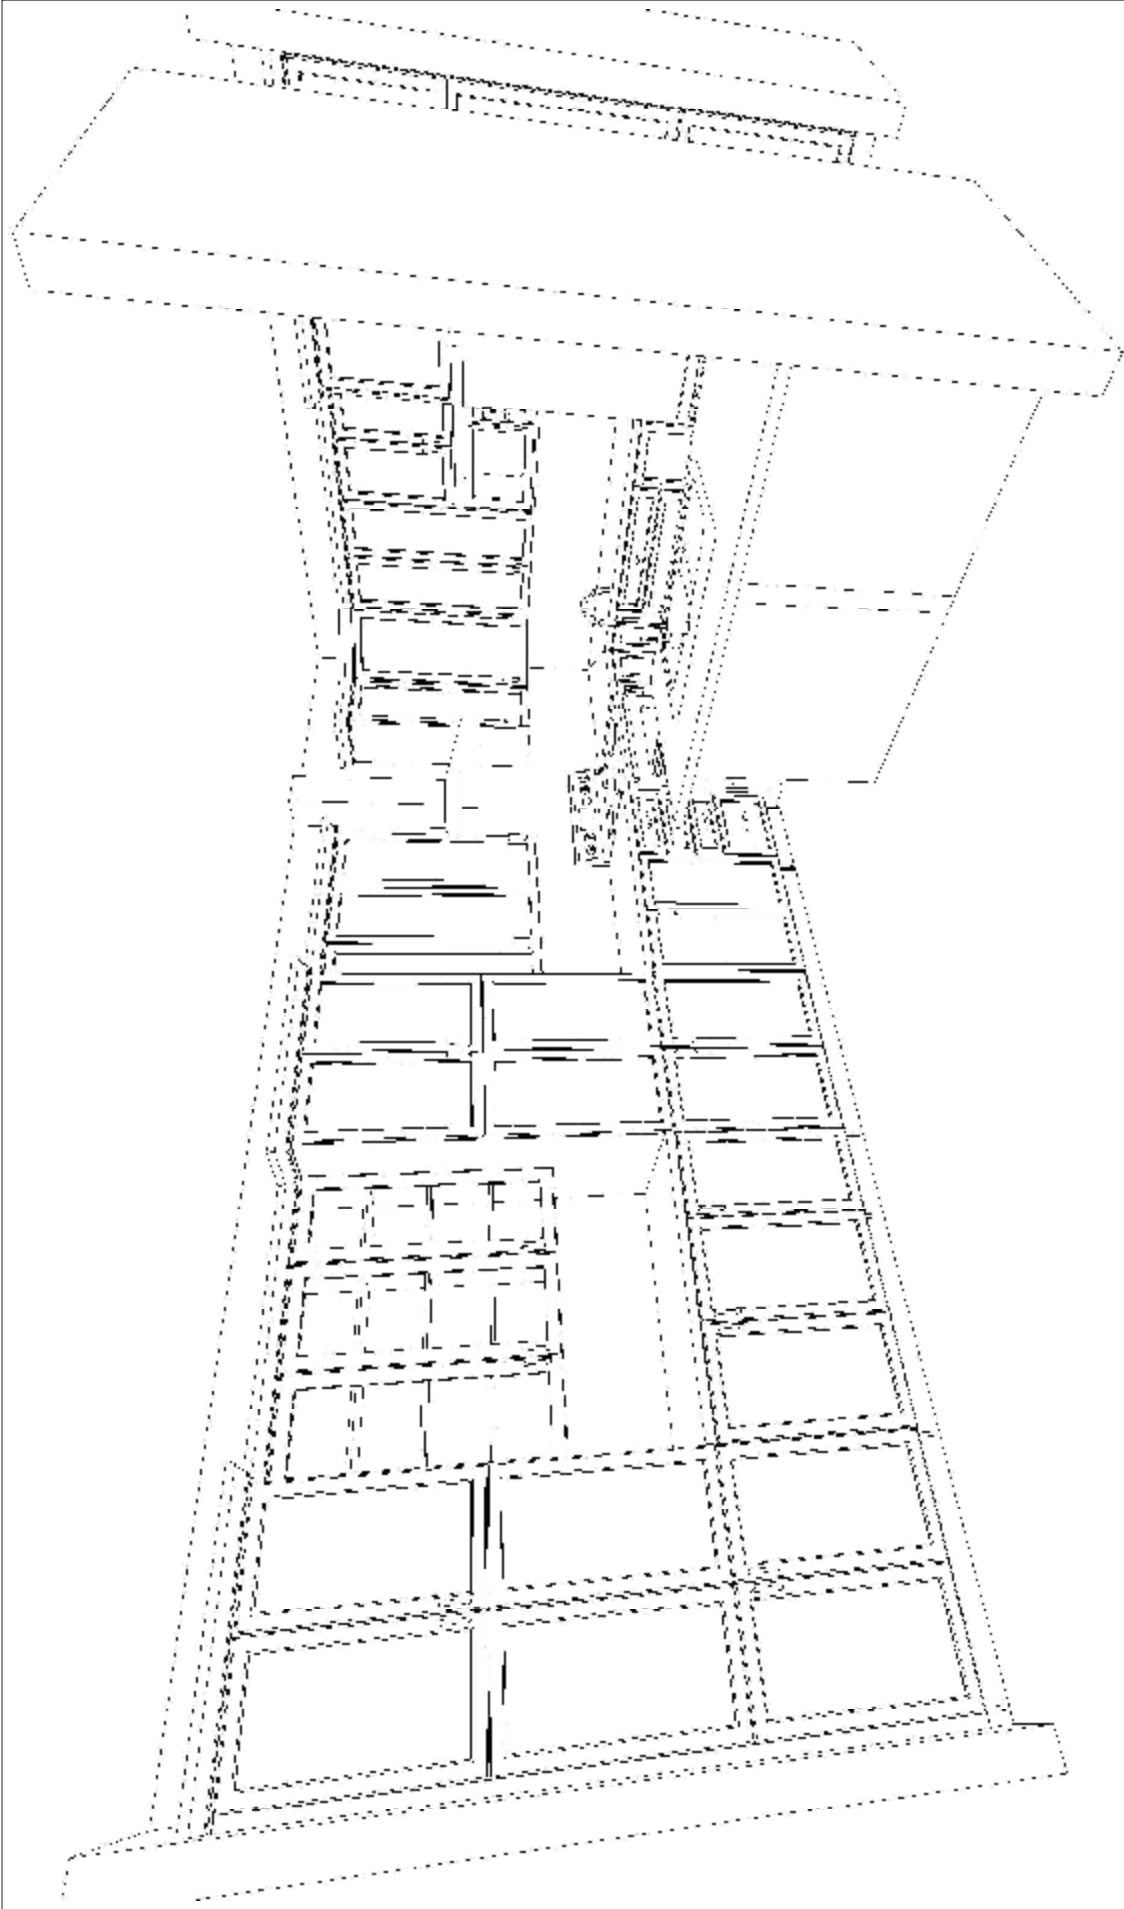

KITCHEN - 3D VIEW #1

|   |  |                                                                                                |                                                         |  |
|---|--|------------------------------------------------------------------------------------------------|---------------------------------------------------------|--|
| <div><div><p><b>CUSTOMER APPROVAL</b></p><p>I have reviewed these drawings and understand the details of the design and the Carter Kitchens specifications</p><div><div>Signature</div><div></div></div><div><div>Date</div><div>— —</div></div></div></div> |  | <div></div> | <div>Designed: 11/27/2020<br/>Printed: 11/27/2020</div> |  |
| <div>DCR #156 PWYS - Melbourne 4 Bdrmt</div>   |  | <div>All</div>                                                                                 | <div>Drawing #: 1</div>                                 |  |

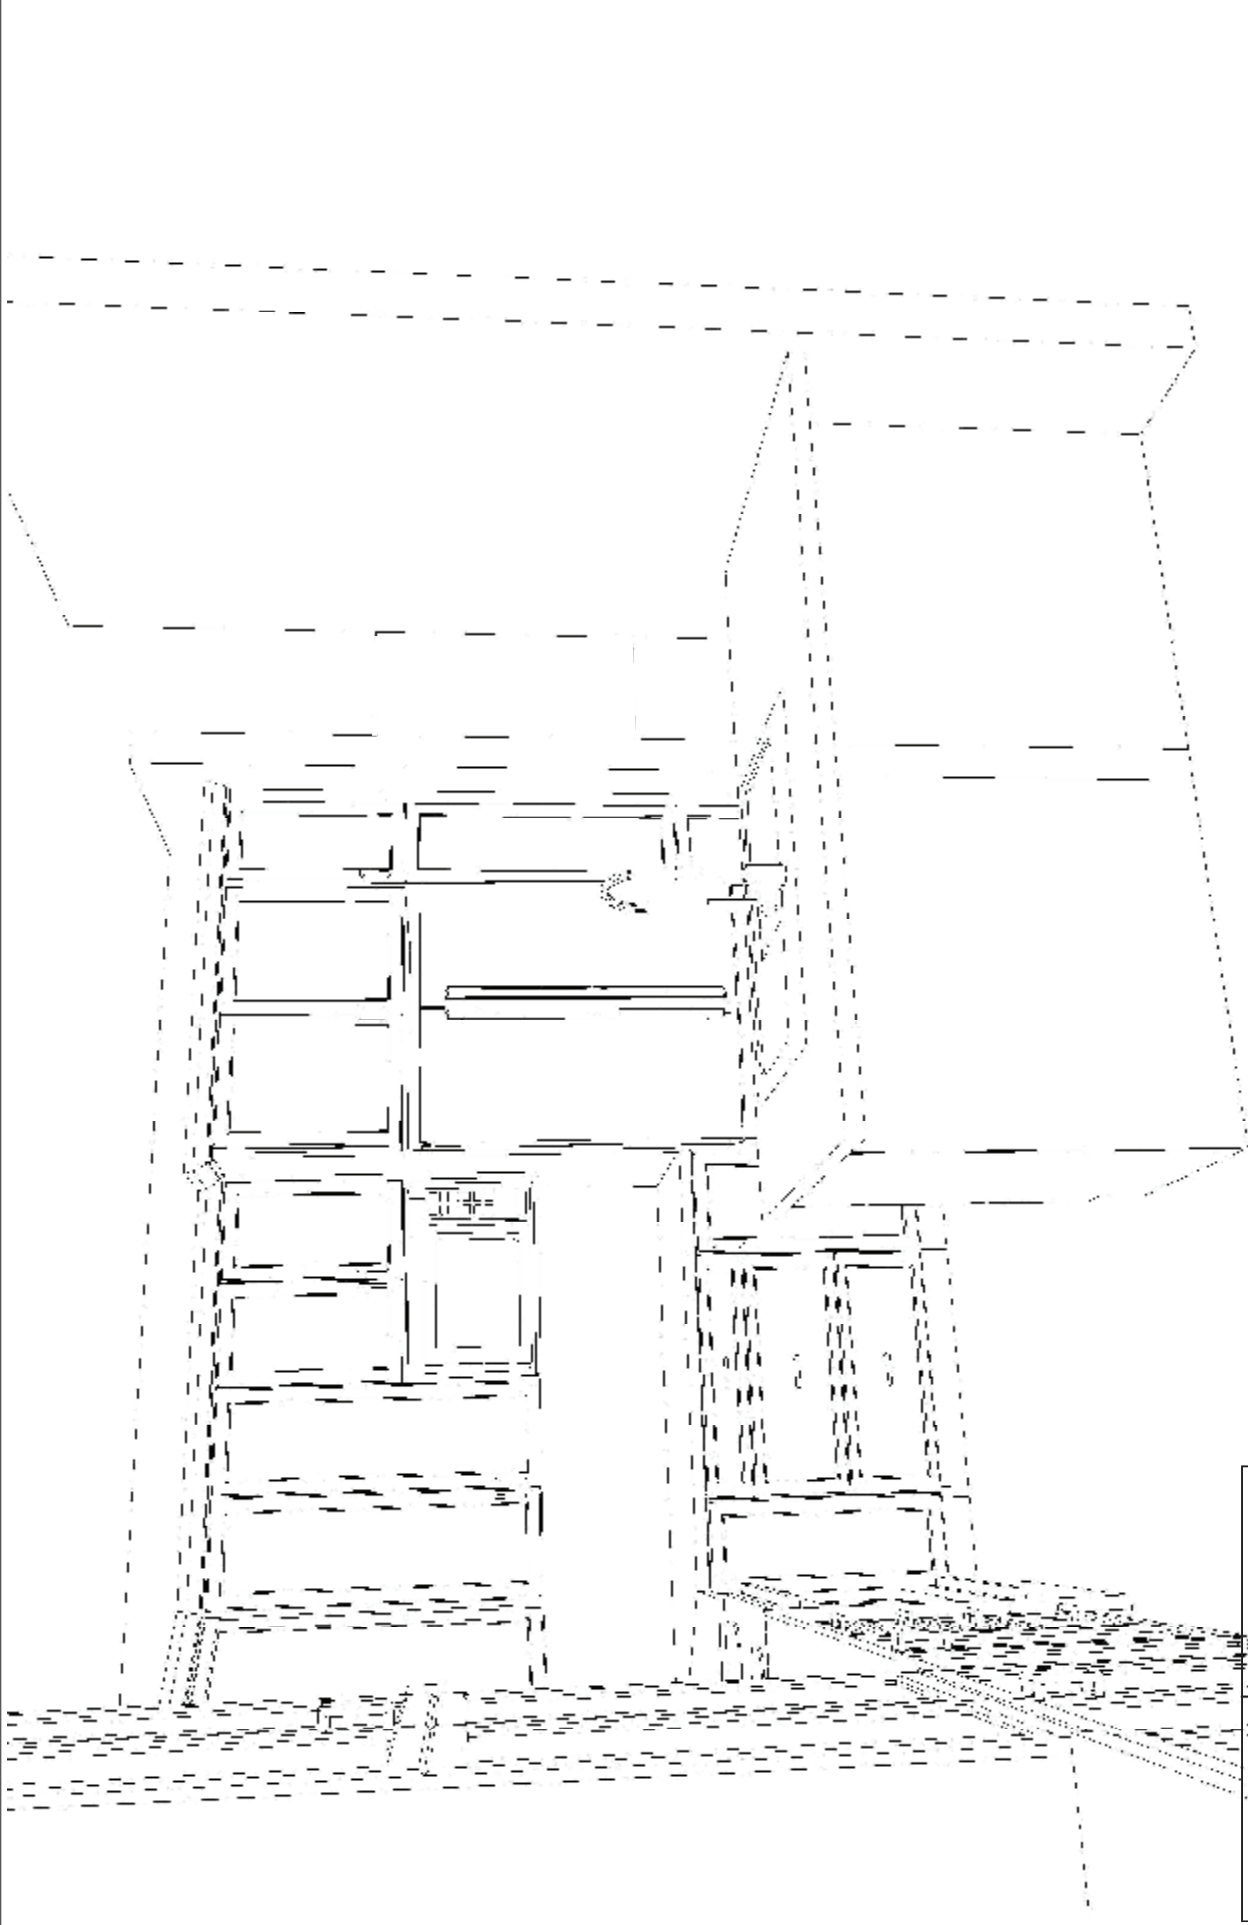

KITCHEN - 3D VIEW #2

Note: This drawing is an artistic interpretation of the general appearance of the design. It is not meant to be an exact rendition.

|   |                                                                                     |                                             |     |
|---|-------------------------------------------------------------------------------------|---------------------------------------------|-----|
| Note: This drawing is an artistic interpretation of the general appearance of the design. It is not meant to be an exact rendition. |  | Designed: 11/27/2020<br>Printed: 11/27/2020 |     |
|   |                                                                                     | DCR #156 PWYS - Melbourne 4 Bdrmt           | All |




CUSTOMER APPROVAL

I have reviewed these drawings and understand the details of the design and the Cartier Kitchens specifications

Signature \_\_\_\_\_  
Date \_\_\_\_\_



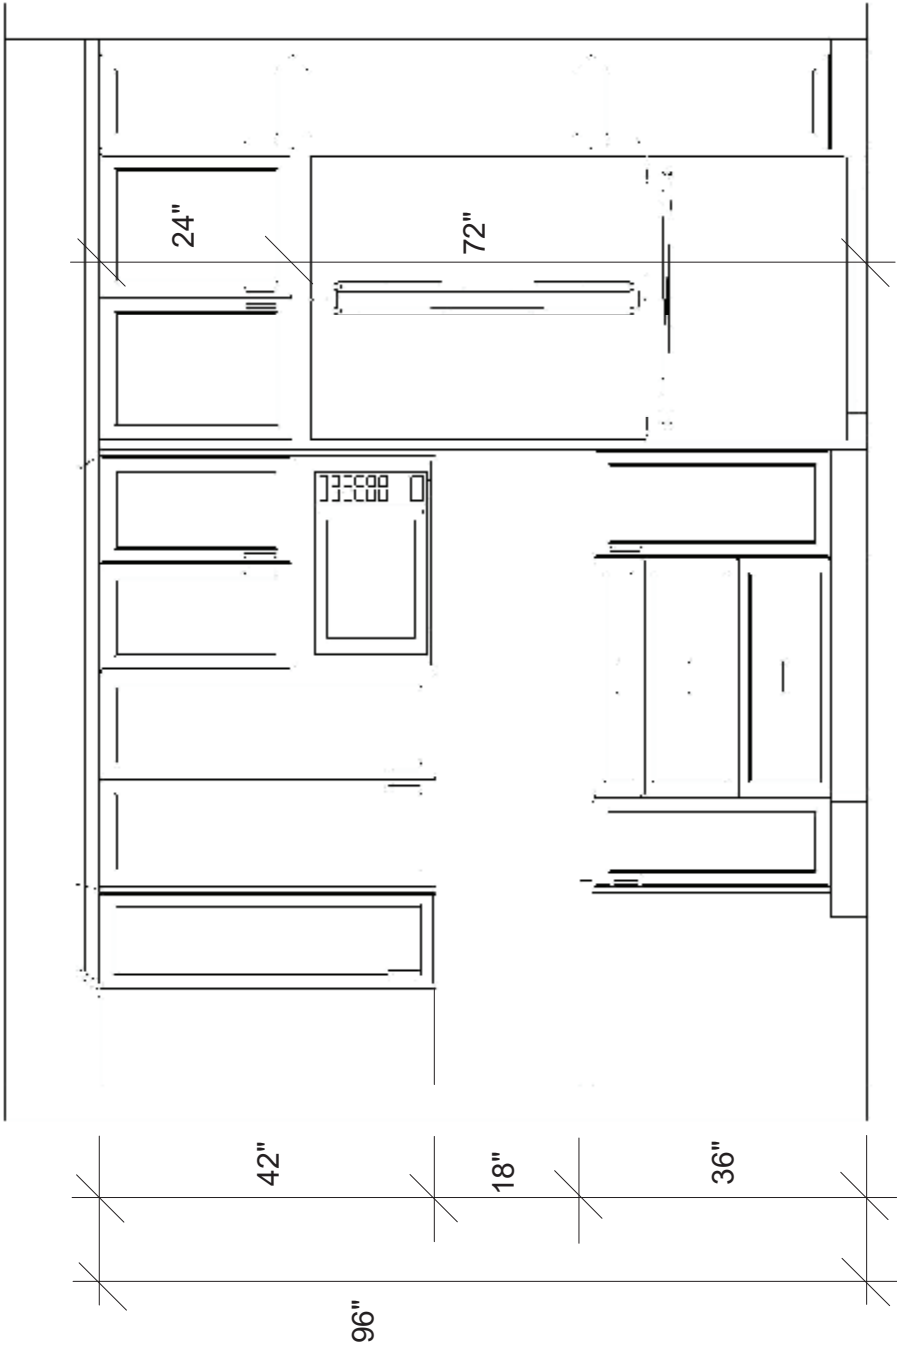

# FRIDGE WALL ELEVATION

**Note:** This drawing is an artistic interpretation of the general appearance of the design. It is not meant to be an exact rendition.



Designed: 11/27/2020  
Printed: 11/27/2020

DCR #156 PWYS - Melbourne 4 Bdrmt

All

Drawing #: 1


**CUSTOMER APPROVAL**

have reviewed these drawings and understand the details of the design and the Cartier Kitchens specifications

Signature \_\_\_\_\_


Date \_\_\_\_\_

DS  
AR

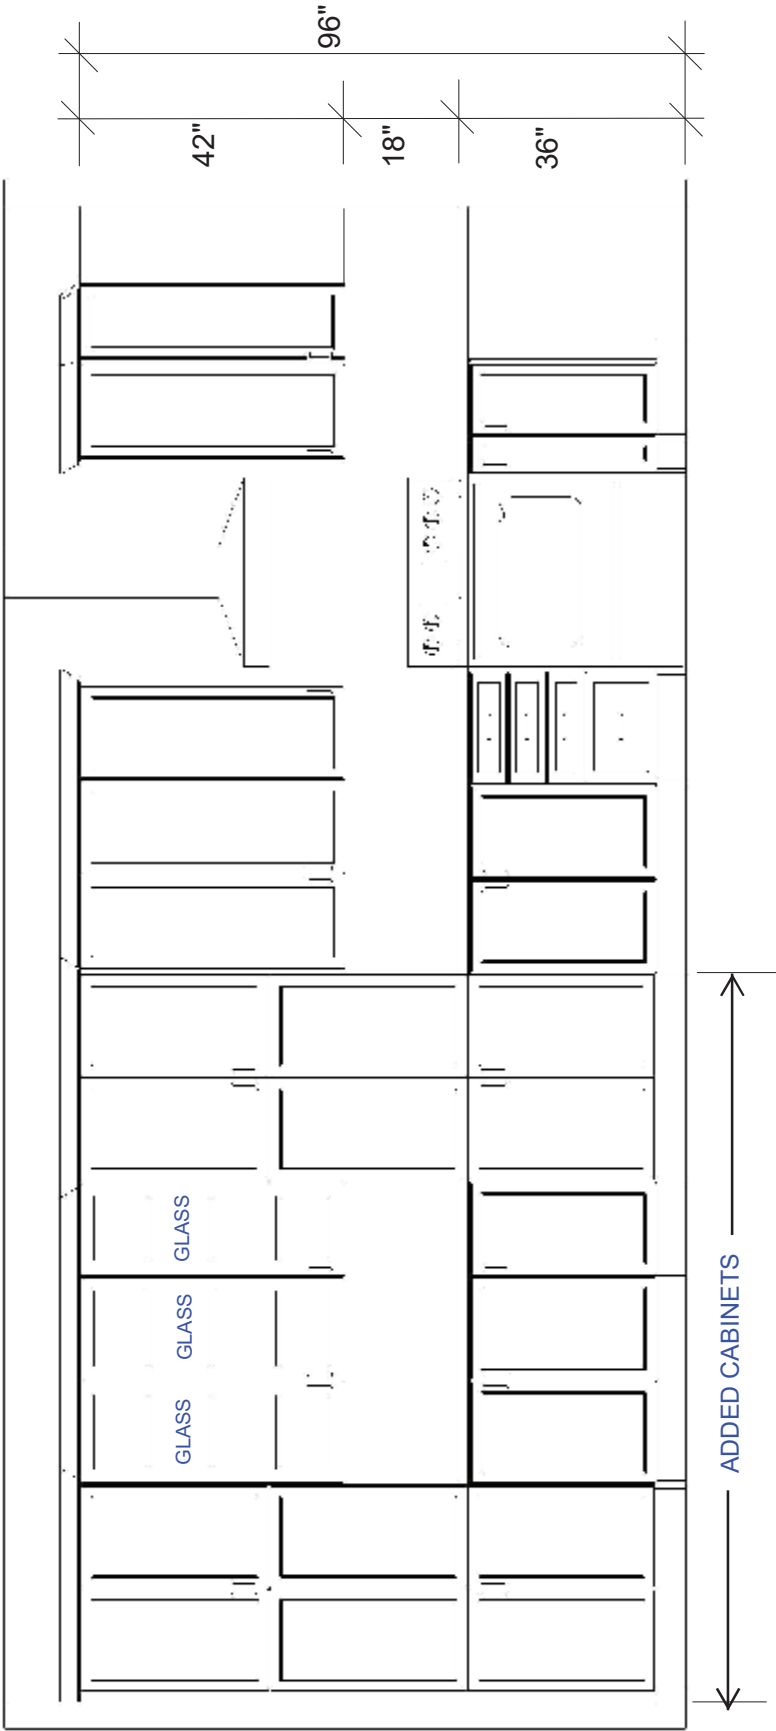


RANGE / PANTRY WALL ELEVATION


|   |   |                                             |                     |
|---|---|---------------------------------------------|---------------------|
| <div><div><div>CUSTOMER APPROVAL</div><div>I have reviewed these drawings and understand the details of the design and the Cartier Kitchens specifications</div><div>Signature _____</div><div>Date _____</div></div><div></div></div> | <div><div></div><div>Note: This drawing is an artistic interpretation of the general appearance of the design. It is not meant to be an exact rendition.</div></div> | Designed: 11/27/2020<br>Printed: 11/27/2020 |                     |
|   |   | DCR #156 PWYS - Melbourne 4 Bdrmt           | All<br>Drawing #: 1 |

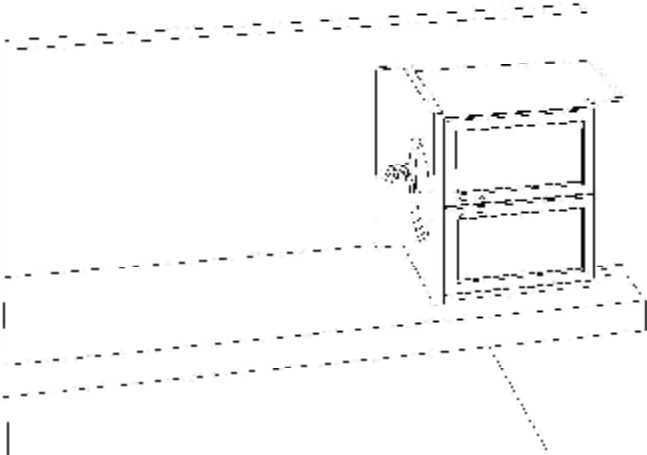

POWDER ROOM

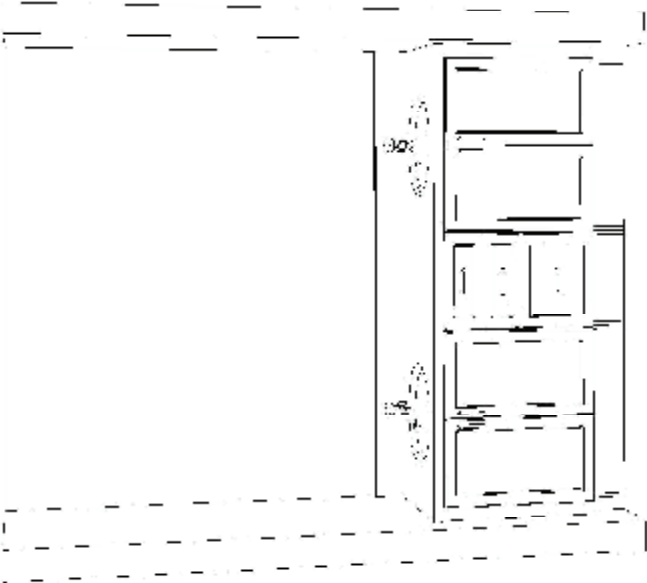

MAIN BATH

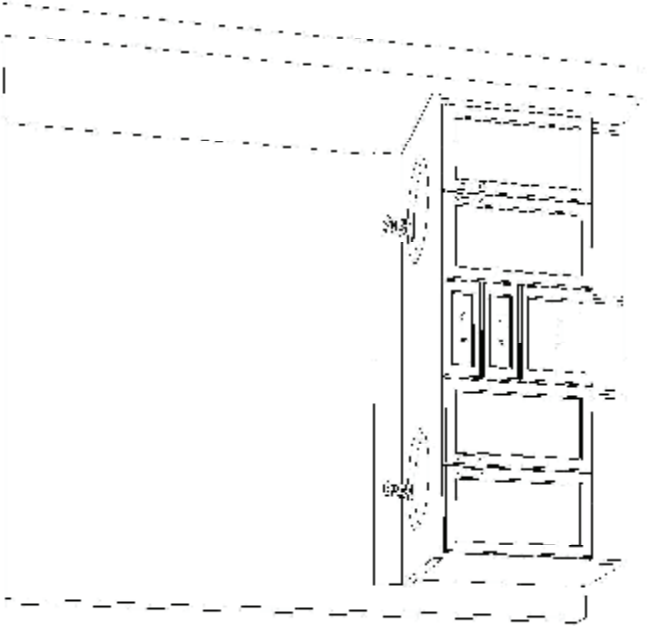

ENSUITE

CUSTOMER APPROVAL

I have reviewed these drawings and understand the details of the design and the Cartier Kitchens specifications

Signature \_\_\_\_\_

Date \_\_\_\_\_



Note: This drawing is an artistic interpretation of the general appearance of the design. It is not meant to be an exact rendition.



Designed: 11/27/2020  
Printed: 11/27/2020

DCR #156 PWYS - Melbourne 4 Bdrmt

All

Drawing #: 1