PATHWAYS-PH 1 - LOT 152

DCR PHOENIX HOMES

MODEL - WINCHESTER (43-4)

KITCHEN

MOUNTING HEIGHT - 84

LINE - 1 & 2

HARDWARE - STD & 1ST UPGRADE

STANDARD WHITE INTERIOR

METAL DRAWER BOX

4 PCS - 5/8" KICK - FIN. BOTH ENDS

2 PCS - LOOSE FILLER - 6 x 96

2 PCS - 90 DEG. CORNER MOULD

1 PCS - T-MOULD

* LAYOUT & DIMENSIONS ARE SUBJECT TO CHANGE DUE TO SITE CONDITIONS W/O NOTICE *

* 42" H UPPERS *

* 2" H LIGHT VALANCE *

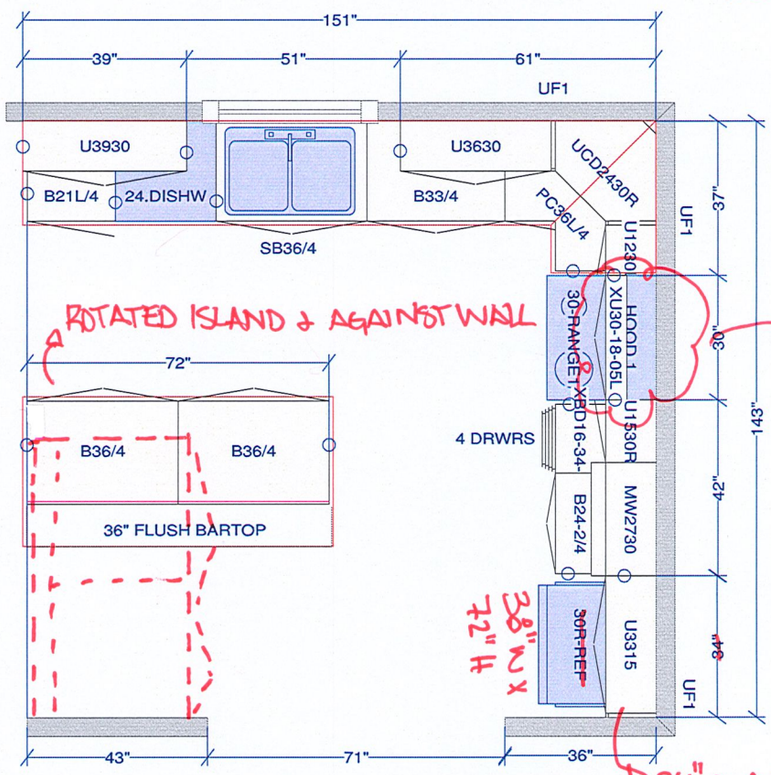

ROTATED ISLAND & AGAINST WALL

30" CHIMNEY HOODFAN + 3" SPACE EACH SIDE

38" W x 72" H

24" D & SIDE PANEL

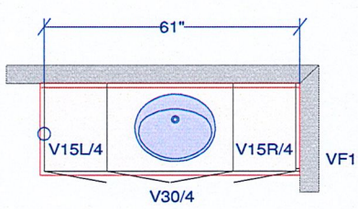

POWDER

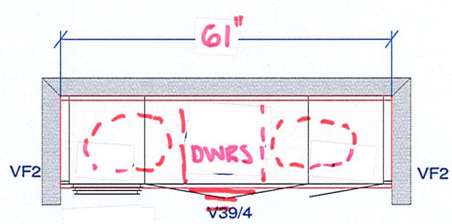

ENSUITE #2

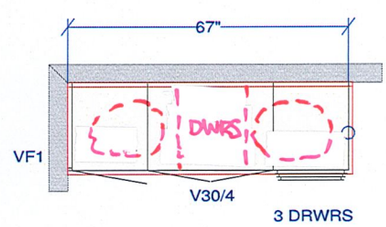

ENSUITE

* DOUBLE SINKS *

* MAIN BATH VANITY STANDARD — 79" W *

All dimensions ,size designations given are subject to verification on job site and adjustment to fit job conditions.	2020 TECHNOLOGIES	This is an original design and must not be released or copied unless applicable fee has been paid or job order placed.	Designed: 17/07/2013 Printed: 13/10/2014
Cartier Kitchens Ottawa		Drawn by: Lori Di Saverio, B.I.D. Cartier Kitchens Ottawa	
43-4 Winchester.kit		All	Drawing #: 1 | No Scale.