


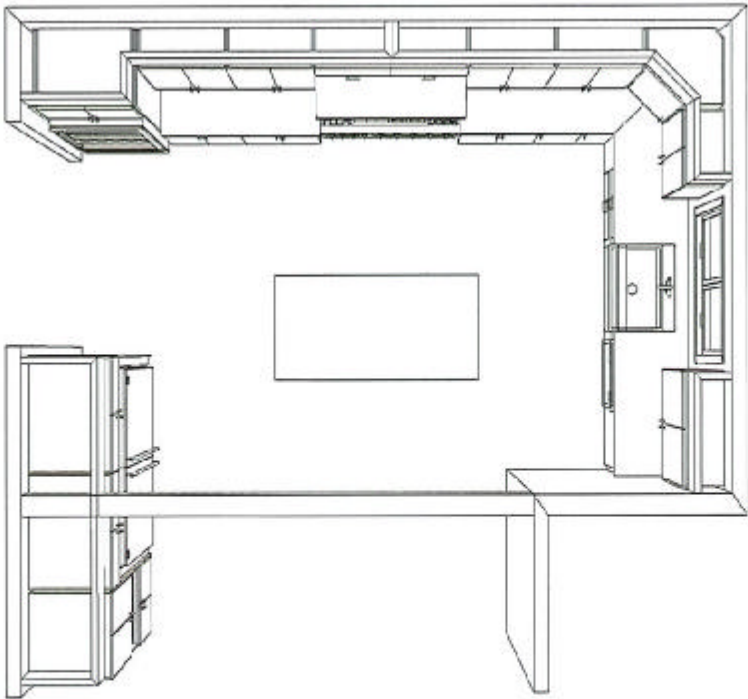

KITCHEN - TOP VIEW


<u>CUSTOMER APPROVAL</u> have reviewed these drawings and understand the details of the design and the Carrier's specifications Signature _____ Date _____
--

Note: This drawing is an artistic interpretation of the general appearance of the design. It is not meant to be an exact rendition.



Designed: 11/11/2020
Printed: 11/11/2020

DS
RP

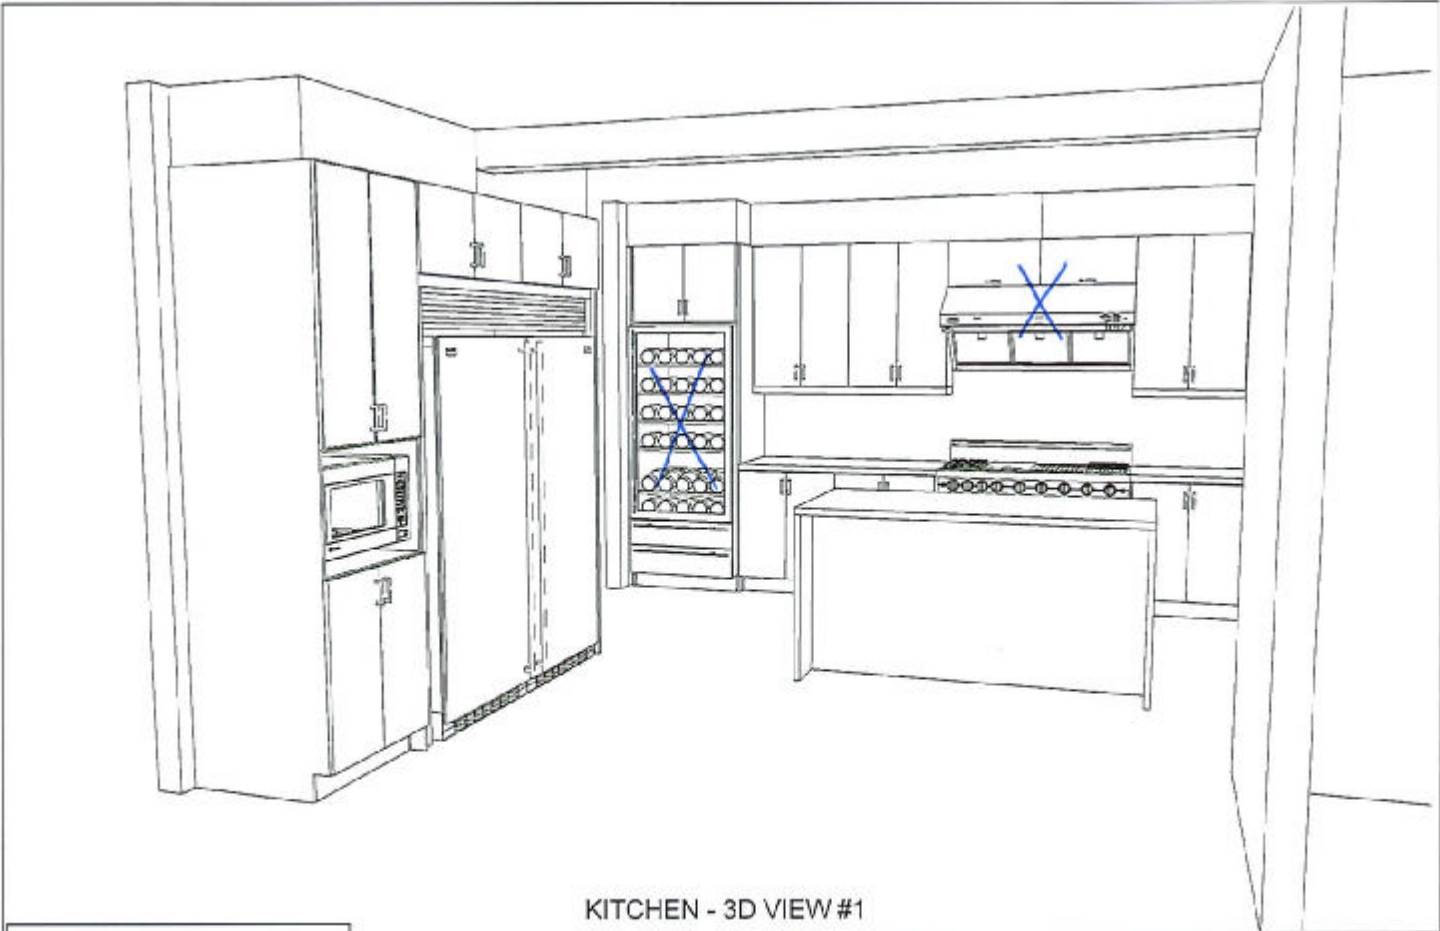

KITCHEN - 3D VIEW #1


<u>CUSTOMER APPROVAL</u> I have reviewed these drawings and understand the details of the design and the Carrier Systems specifications. Signature _____ Date _____

Note: This drawing is an artistic interpretation of the general appearance of the design. It is not meant to be an exact rendition.




Designed: 11/10/2020
Printed: 11/11/2020

DS
RP

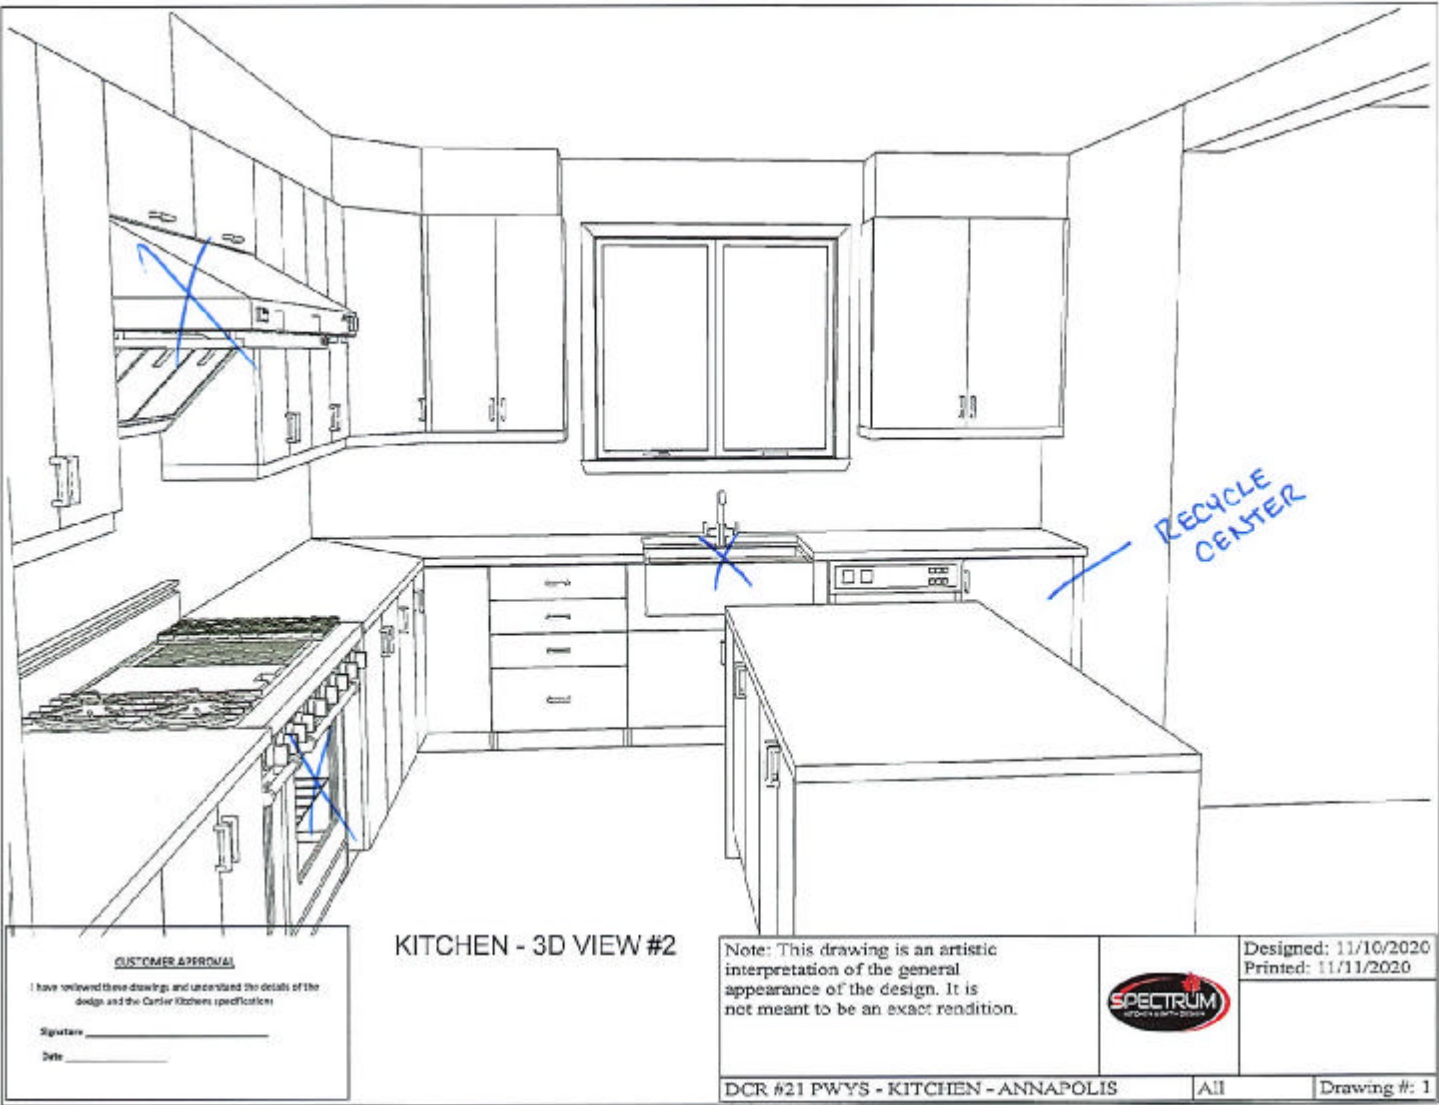

DS
RP

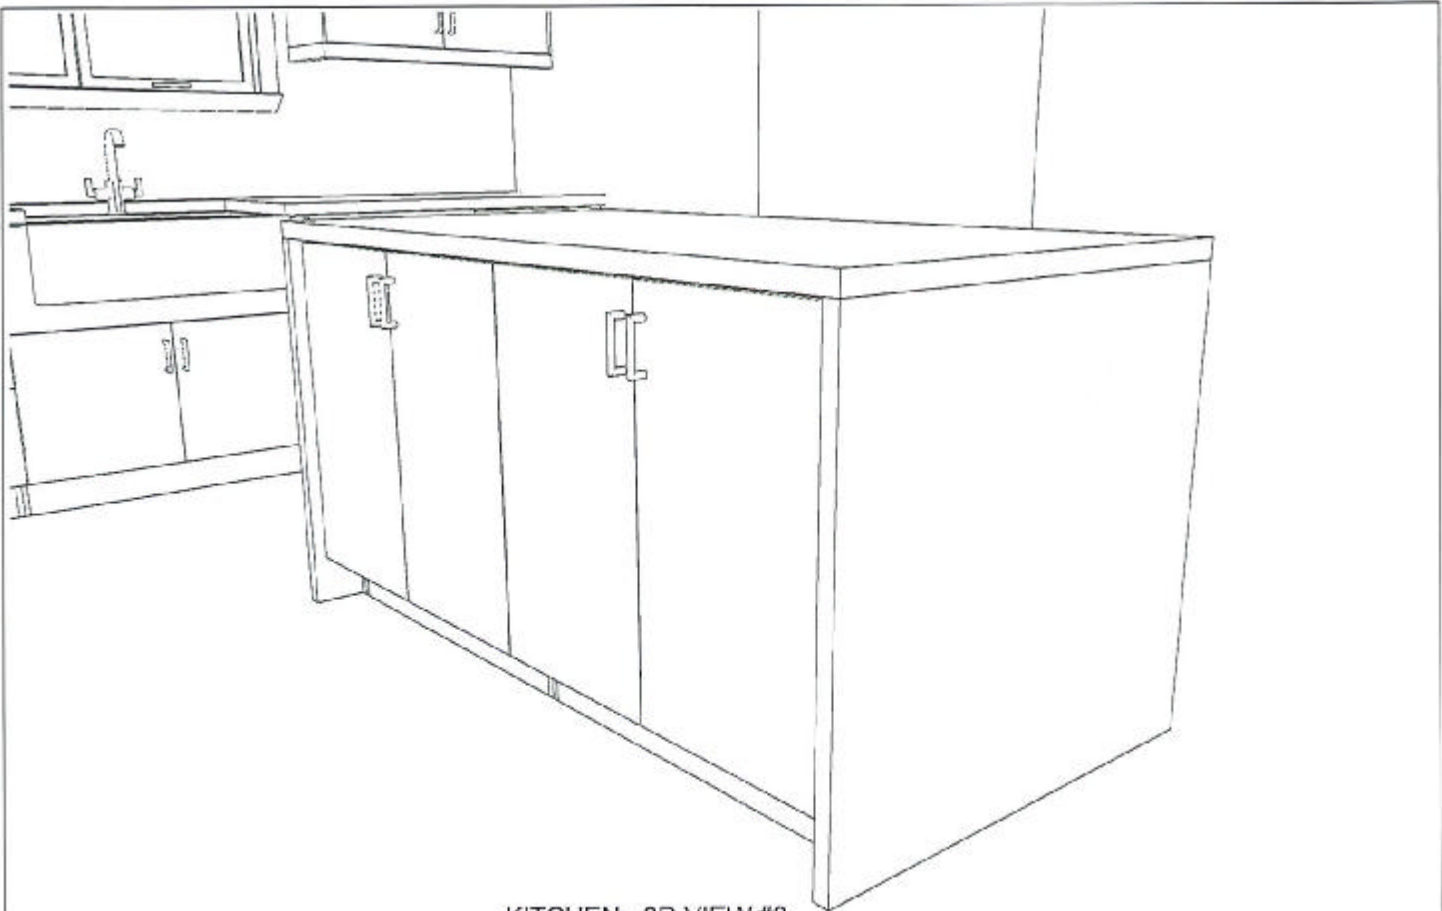

KITCHEN - 3D VIEW #3


CUSTOMER APPROVAL I have reviewed these drawings and understand the details of the design and the Center Kitchens specifications. Signature _____ Date _____

Note: This drawing is an artistic interpretation of the general appearance of the design. It is not meant to be an exact rendition.




Dsgned: 11/10/2020 Printed: 11/11/2020
--


DS
RP

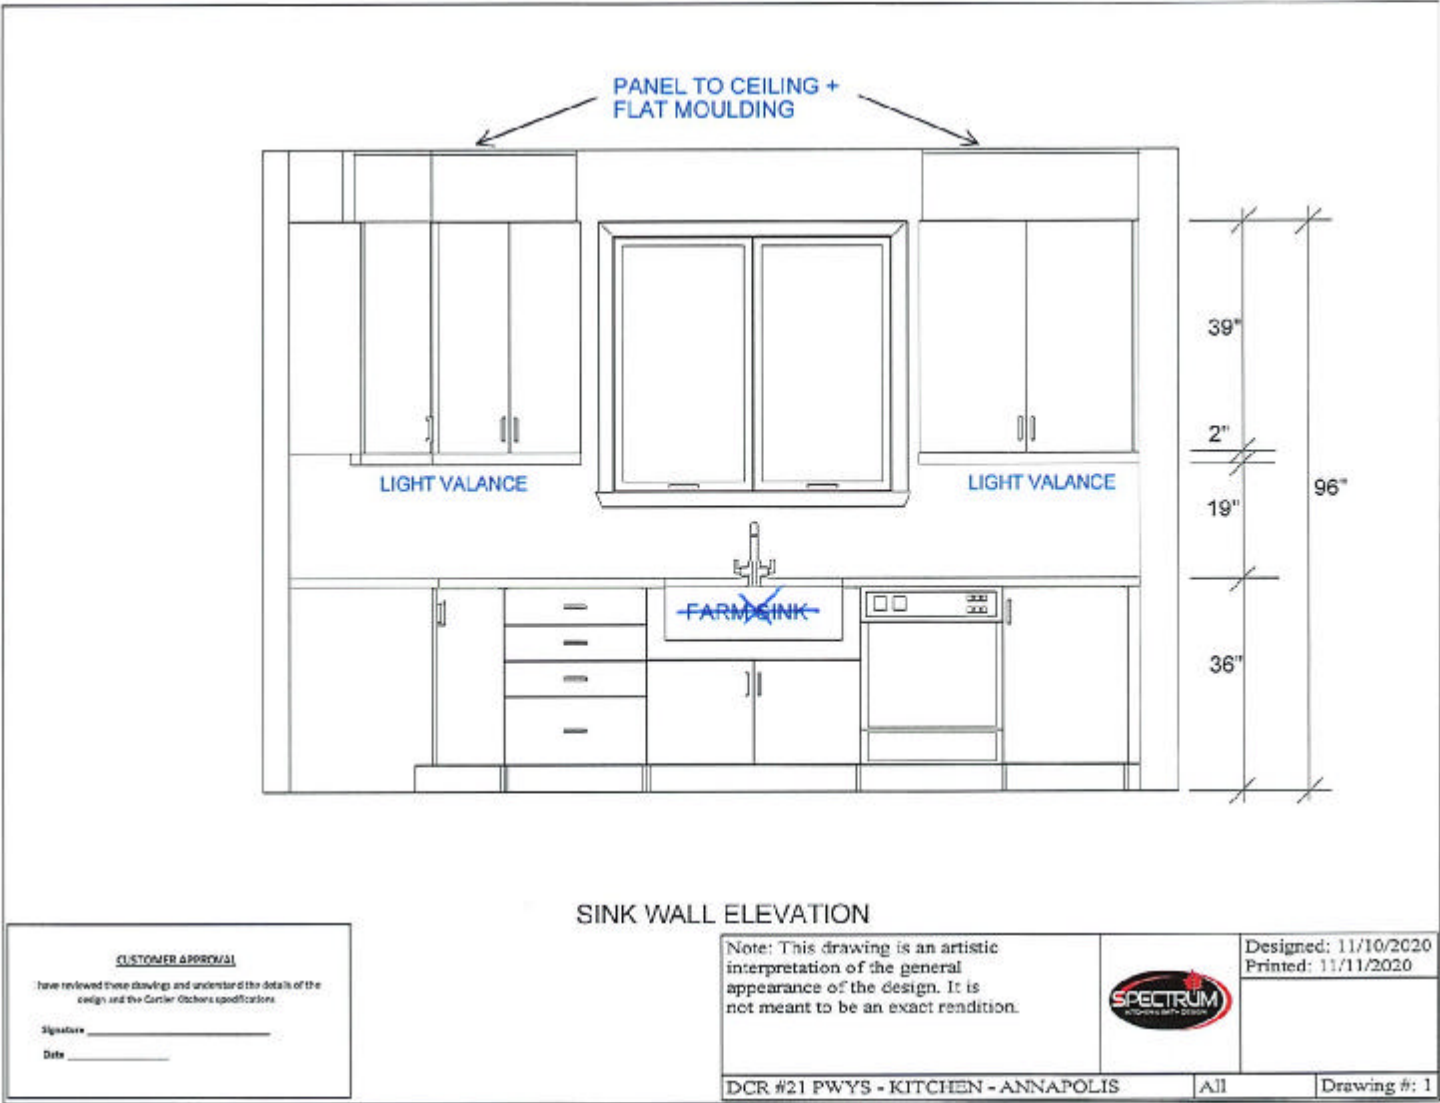

DS
RP

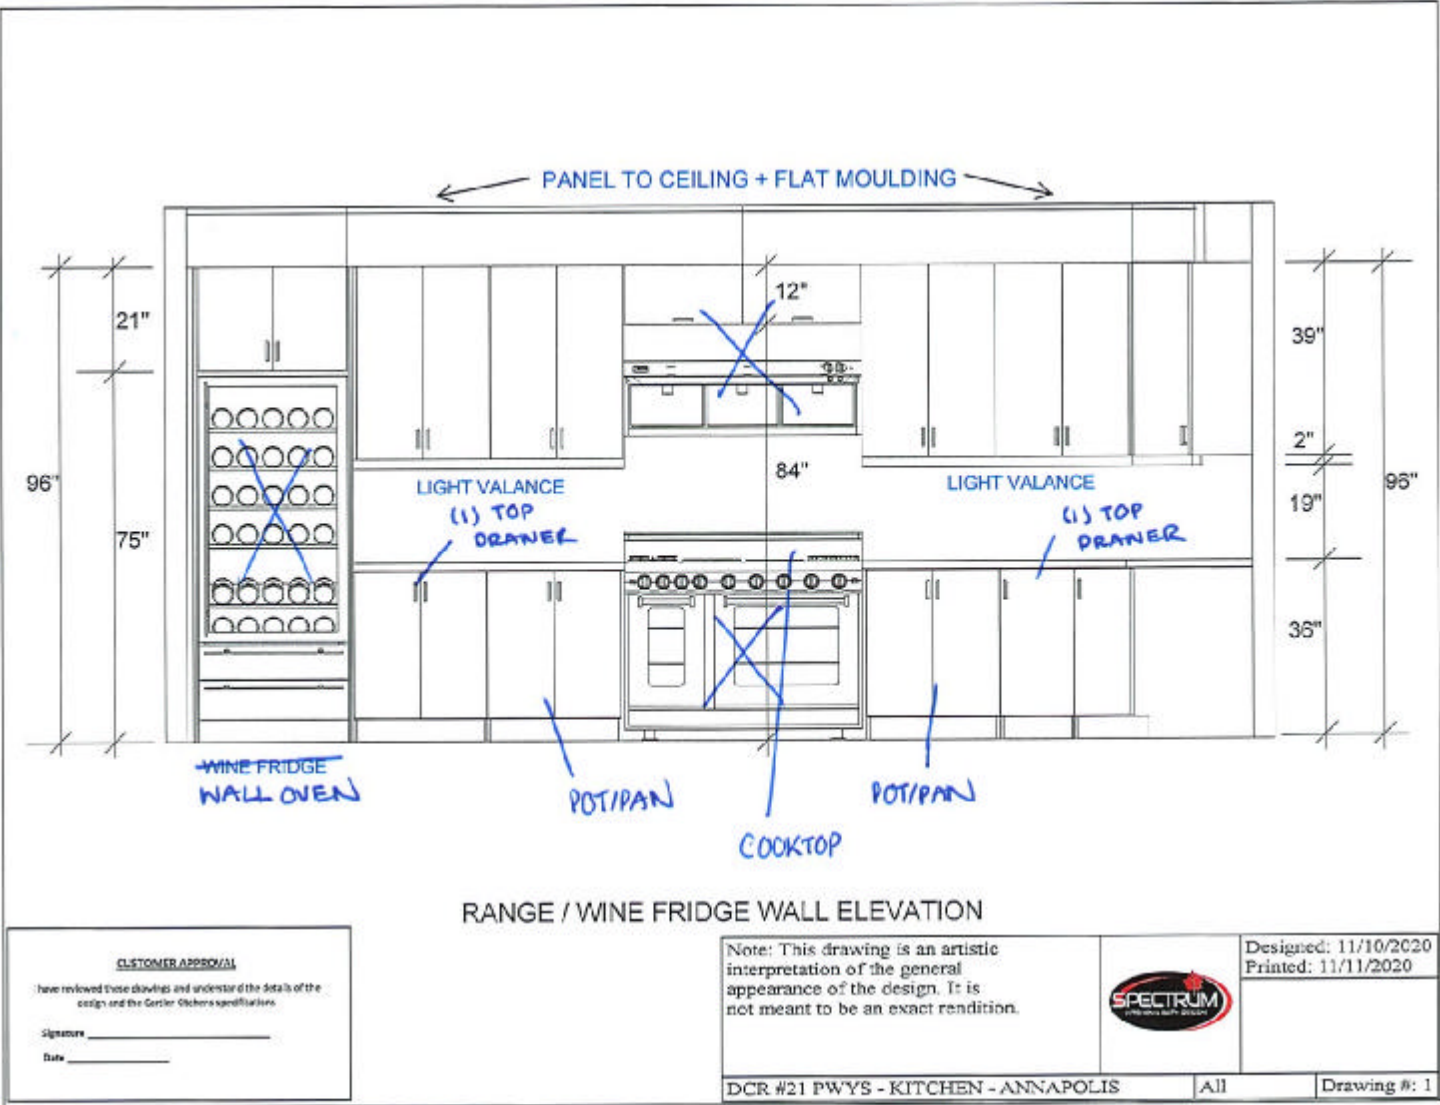

DS
RP

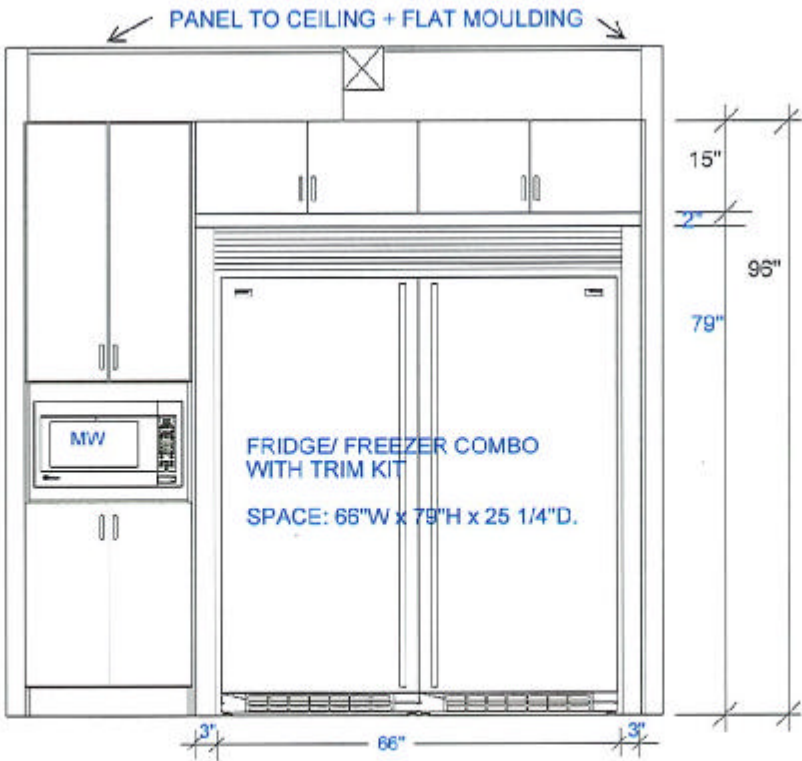

FRIDGE WALL ELEVATION

<u>CUSTOMER APPROVAL</u> I have reviewed this drawing, and understand the details of the design and the Carter Kitchen specifications. Signature _____ Date _____

Note: This drawing is an artistic interpretation of the general appearance of the design. It is not meant to be an exact rendition.		Designed: 11/10/2020
		Printed: 11/11/2020
DCR #21 PWYS - KITCHEN - ANNAPOLIS	All	Drawing #: 1

DS
RP