


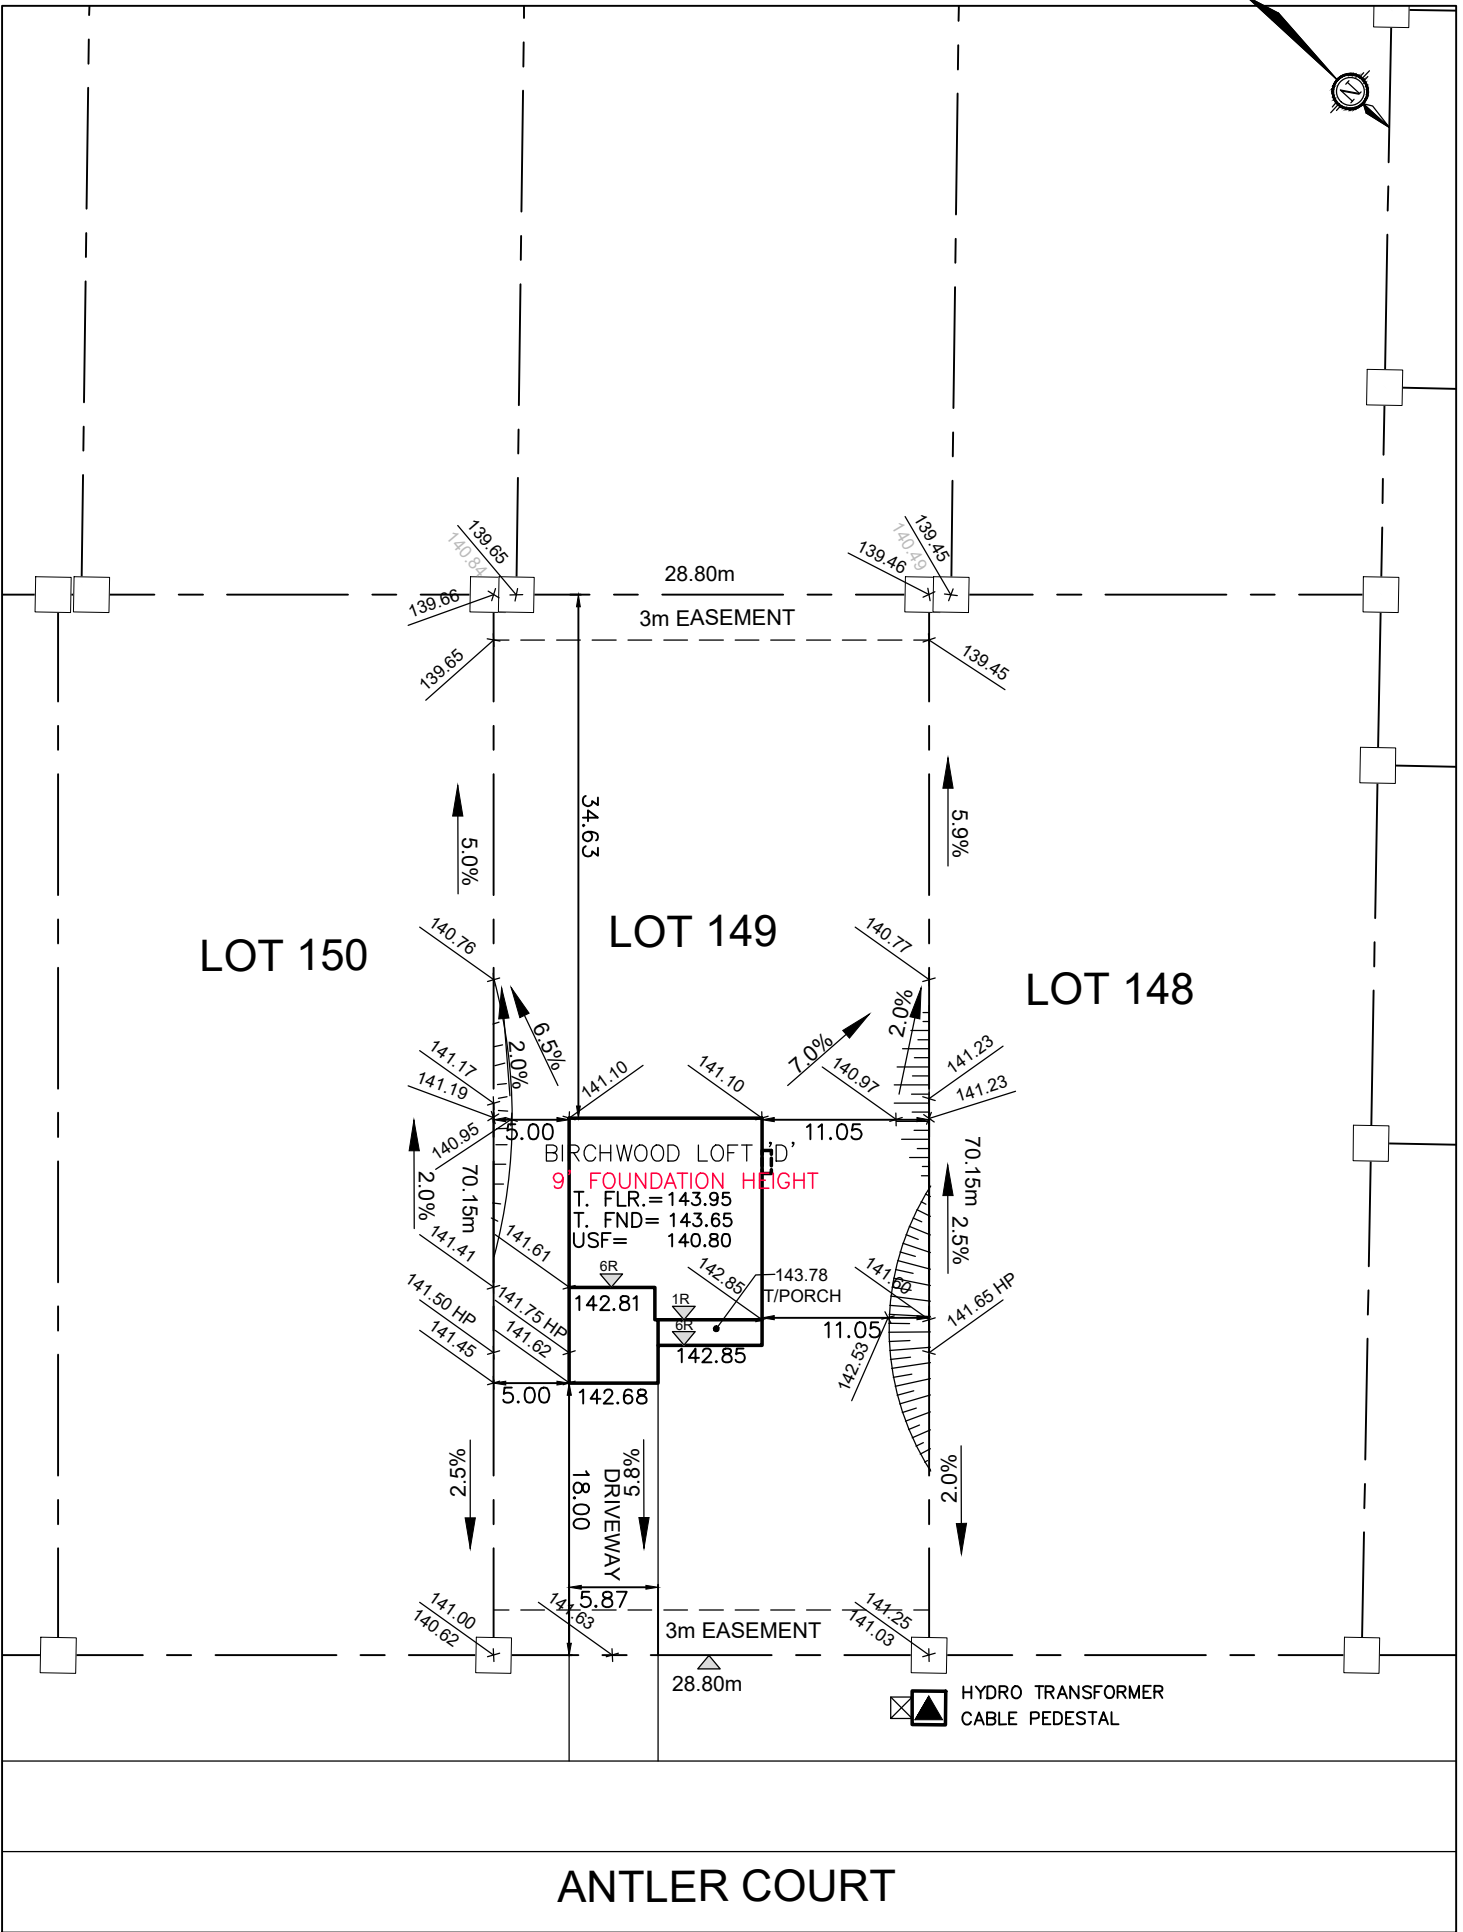

LOT
149

SITE/GRADING PLAN
WHITE TAIL RIDGE PH. II

INDIVIDUAL LOT GRADING REVIEW SUMMARY FOR SITED
HOUSE AS COMPARED WITH OVERALL SUBDIVISION PLAN

NOTE: THIS PLAN IS NOT A SURVEY PLAN OR SUBDIVISION
PLAN WITHIN THE MEANING OF PLANNING ACT.
THIS PLAN IS FOR REFERENCE ONLY AND IS PRELIMINARY IN
NATURE, ALL DIMENSIONS SHOWN ARE APPROXIMATE. E.O&E.

Owner/Applicant	
DCR/PHOENIX HOMES	
Telephone #	723-9227
Plan #	27M-47
Project name: PATHWAYS	
Civic Address: 263 ANTLER COURT	
House model: BIRCHWOOD LOFT 'D'	
Bldg. Ht.	m
Lot coverage	10.20 %
Scale	1:500
Sod Area	1870 m ²
Asphalt Area	147 m ²
CHECKED/APPROVED BY: T.L.MAK ENG.	
MAR 22-22	