




Owner/Applicant
DCR/PHOENIX HOMES
Telephone # 723-9227
Plan # 4M- 1618
Project name: PATHWAYS
Civic Address: 309 SPREADWING WAY
House model: ANNAPOLIS A

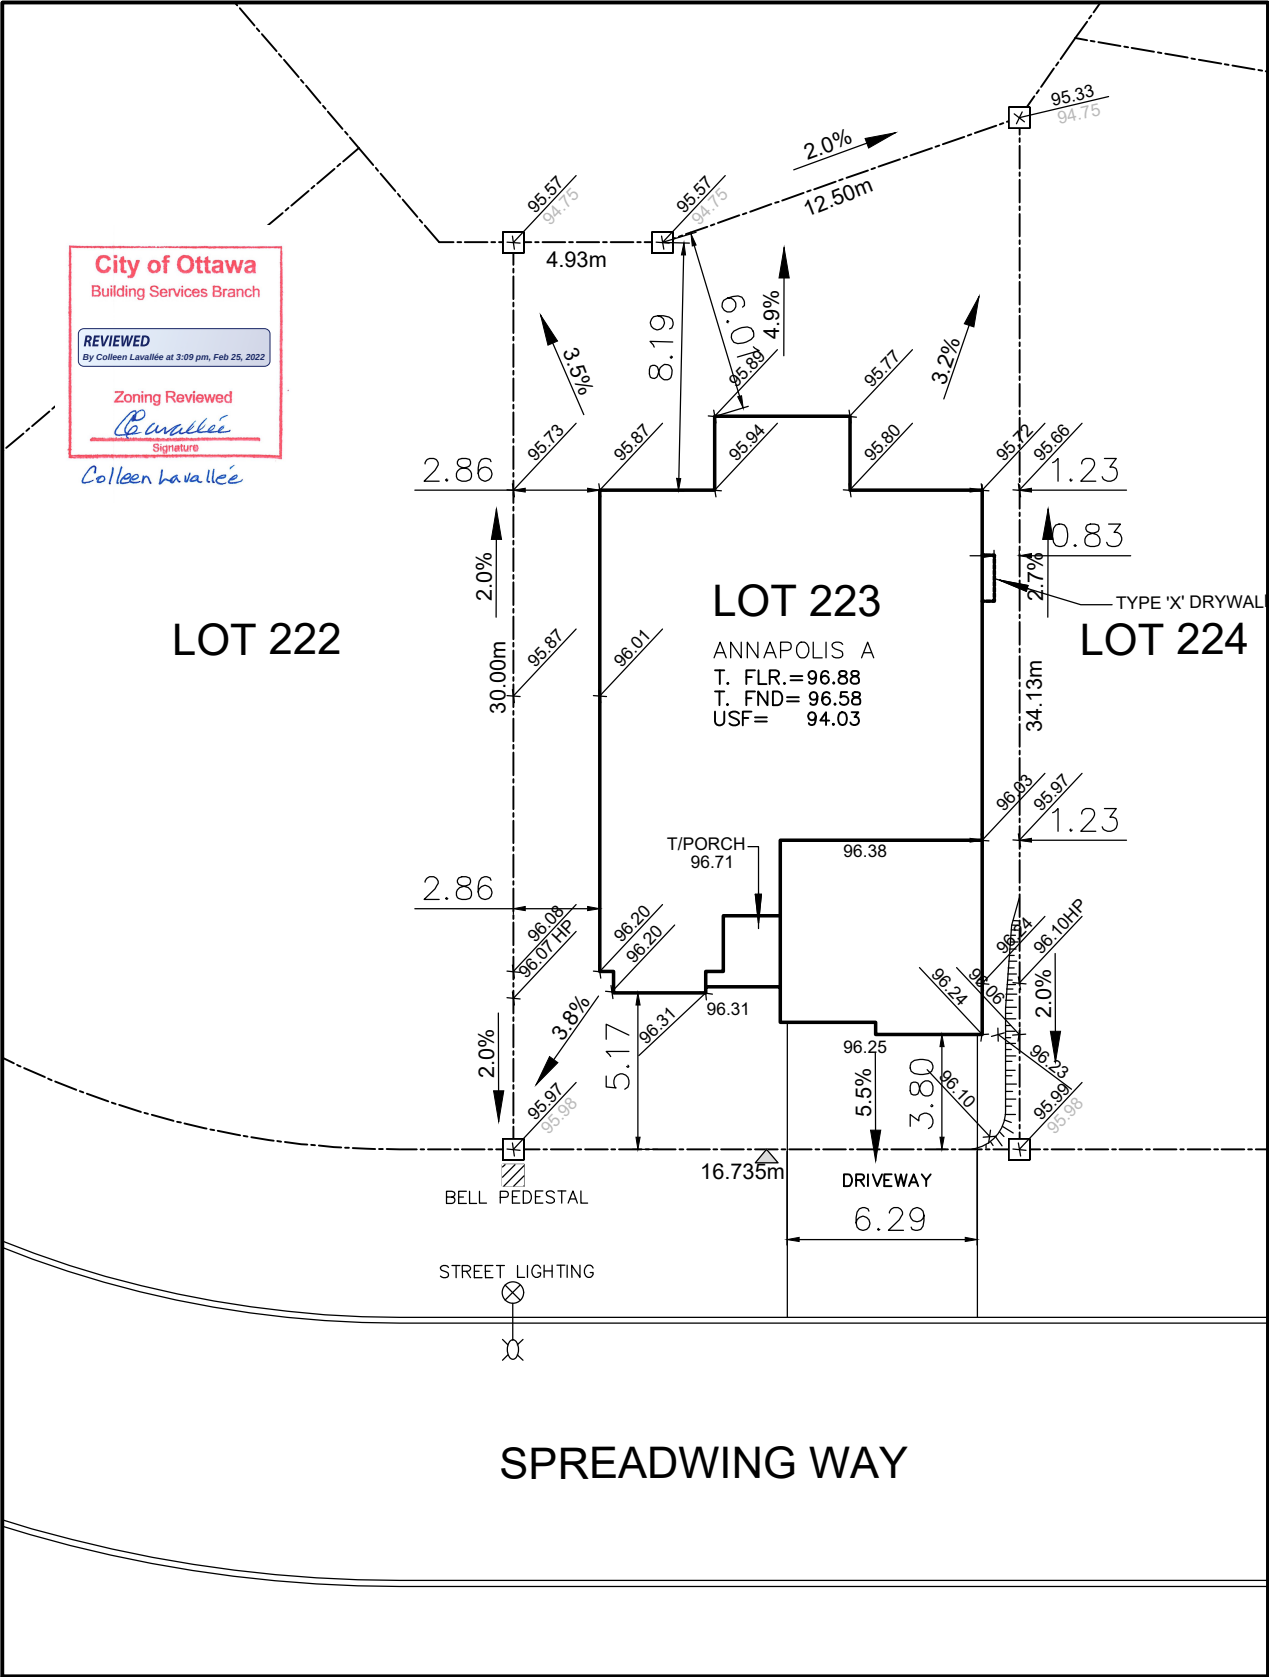

SITE/GRADING PLAN

PATHWAYS PHASE 2

Bldg. Ht. **m**
Lot coverage 43 **%**
Scale 1:250
Sod Area 332 **m²**
Asphalt Area 61 **m²**

CHECKED/APPROVED BY: T.L.MAK ENG.
NOV 5, 2021
FEB 23, 2022
FEB 24, 2022

INDIVIDUAL LOT GRADING REVIEW SUMMARY FOR SITED
HOUSE AS COMPARED WITH OVERALL SUBDIVISION PLAN

NOTE: THIS PLAN IS NOT A SURVEY PLAN OR SUBDIVISION
PLAN WITHIN THE MEANING OF PLANNING ACT.