


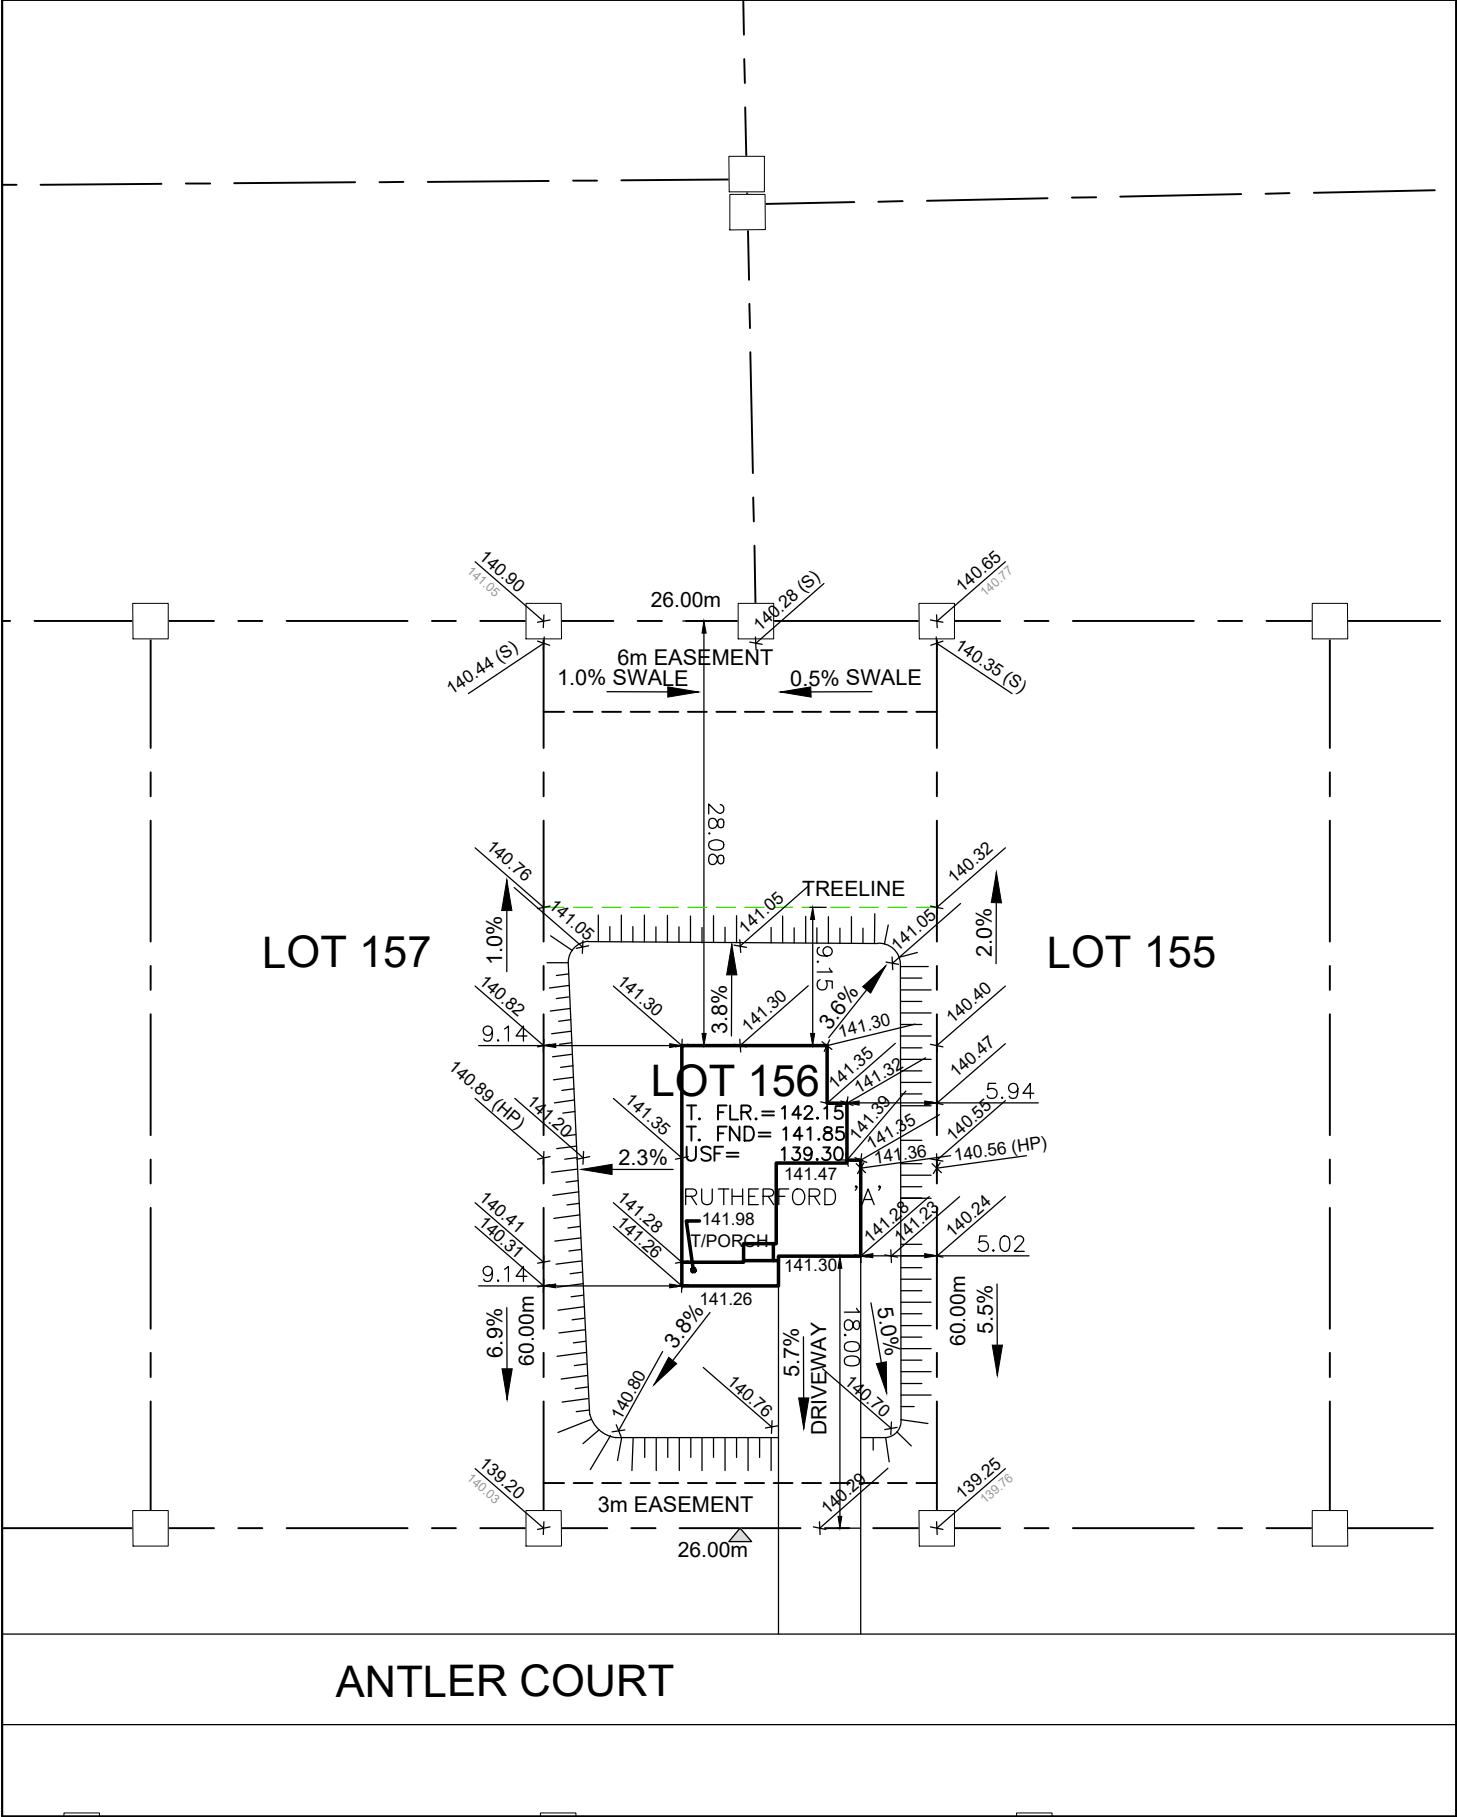

Owner/Applicant DCR/PHOENIX HOMES Telephone # 723-9227 Plan # 24M-47 Project name: PATHWAYS Civic Address: 303 ANTLER COURT House model: RUTHERFORD 'A'		 LOT 156 SITE/GRADING PLAN WHITE TAIL RIDGE PH.II
Bldg. Ht. m Lot coverage 10.6 % Scale 1:500 Sod Area 1440 m² Asphalt Area 136.26 m²		INDIVIDUAL LOT GRADING REVIEW SUMMARY FOR SITED HOUSE AS COMPARED WITH OVERALL SUBDIVISION PLAN
CHECKED/APPROVED BY: T.L.MAK ENG. APRIL 26, 2022		NOTE: THIS PLAN IS NOT A SURVEY PLAN OR SUBDIVISION PLAN WITHIN THE MEANING OF PLANNING ACT.