DCR - PHOENIX HOMES

LOT #44

DIAMONDVIEW ESTATES 2

NEWINGTON
STANDARD KITCHEN

MOUNTING HEIGHT: 96

KITCHEN

CABINETS -

HARDWARE -

STANDARD WHITE INTERIOR

METAL DRAWER BOX

4 PCS - 5/8" KICK - FIN. BOTH ENDS

2 PCS - 90 DEG. CORNER MOULD

1 PCS - T-MOULD

5 PCS - FLAT MOULDING

FILL TO CEILING
WITH 1" MOULDING,
FURRING PANEL &
CEILING CROWN

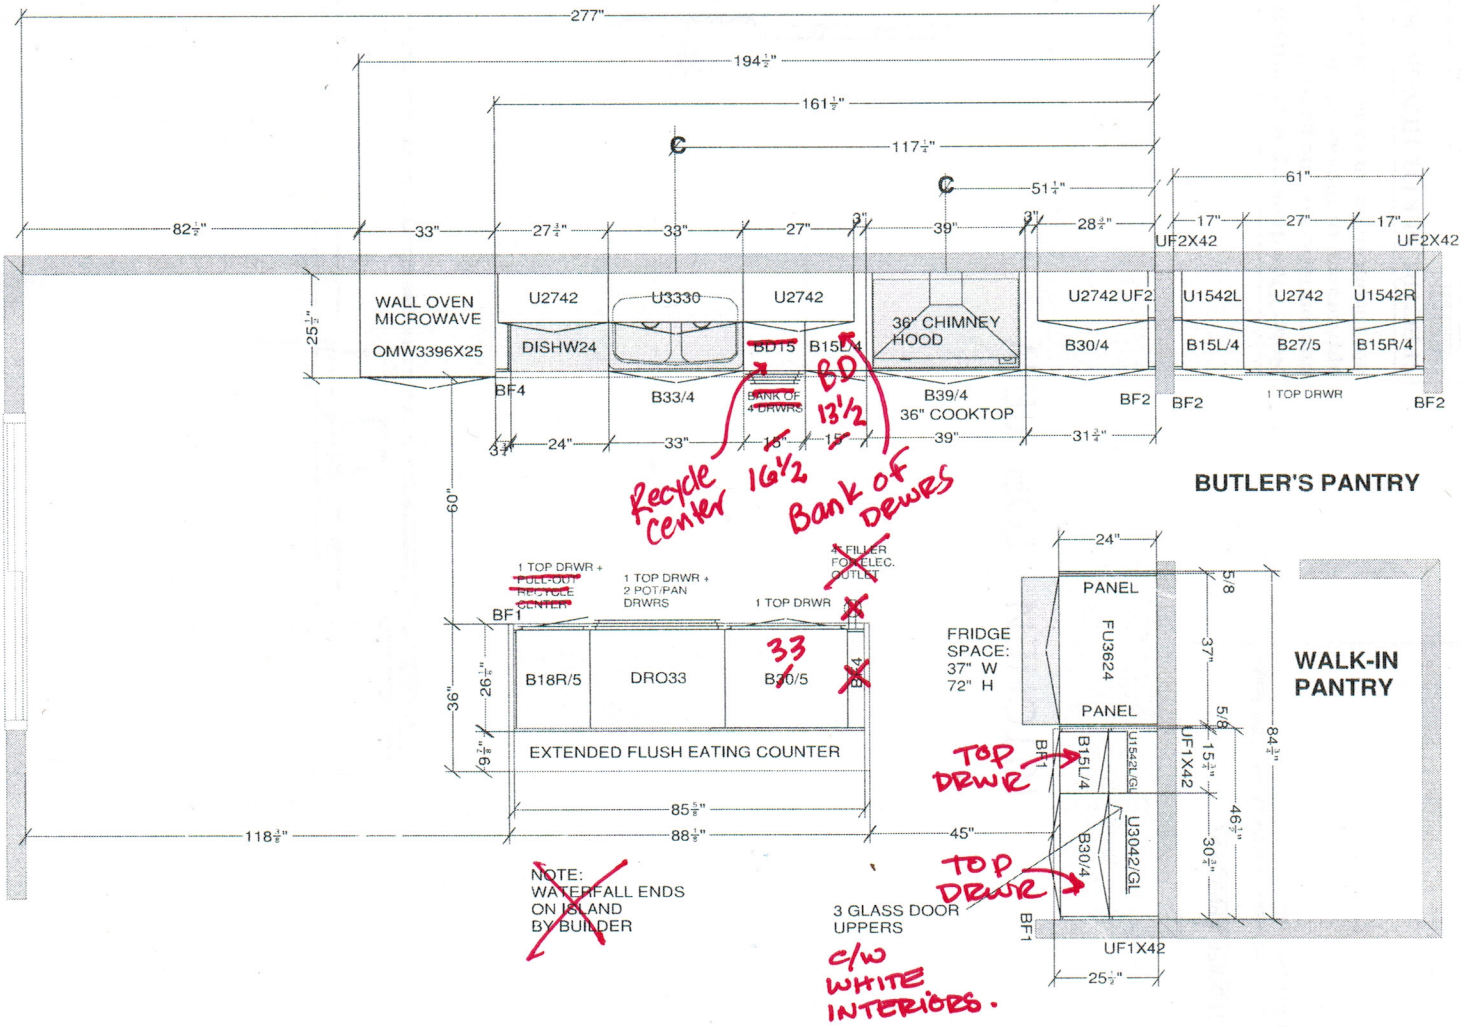

All dimensions _size designations given are subject to verification on job site and adjustment to fit job conditions. SPECTRUM KITCHEN and BATH DESIGN	SPECTRUM KITCHEN & BATH DESIGN	This is an original design and must not be released or copied unless applicable fee has been paid or job order placed. DRAWN BY: LORI DISAVERIO, B.I.D	Designed: 2021-09-19 Printed: 2021-09-19
DCR #44 Diamondview Estates 2 - NEWINGTON - STD KITCHEN.kit	All	Drawing #: 1	No Scale.