TO BE READ IN CONJUNCTION WITH MASTER FOOTPRINTED PLANS

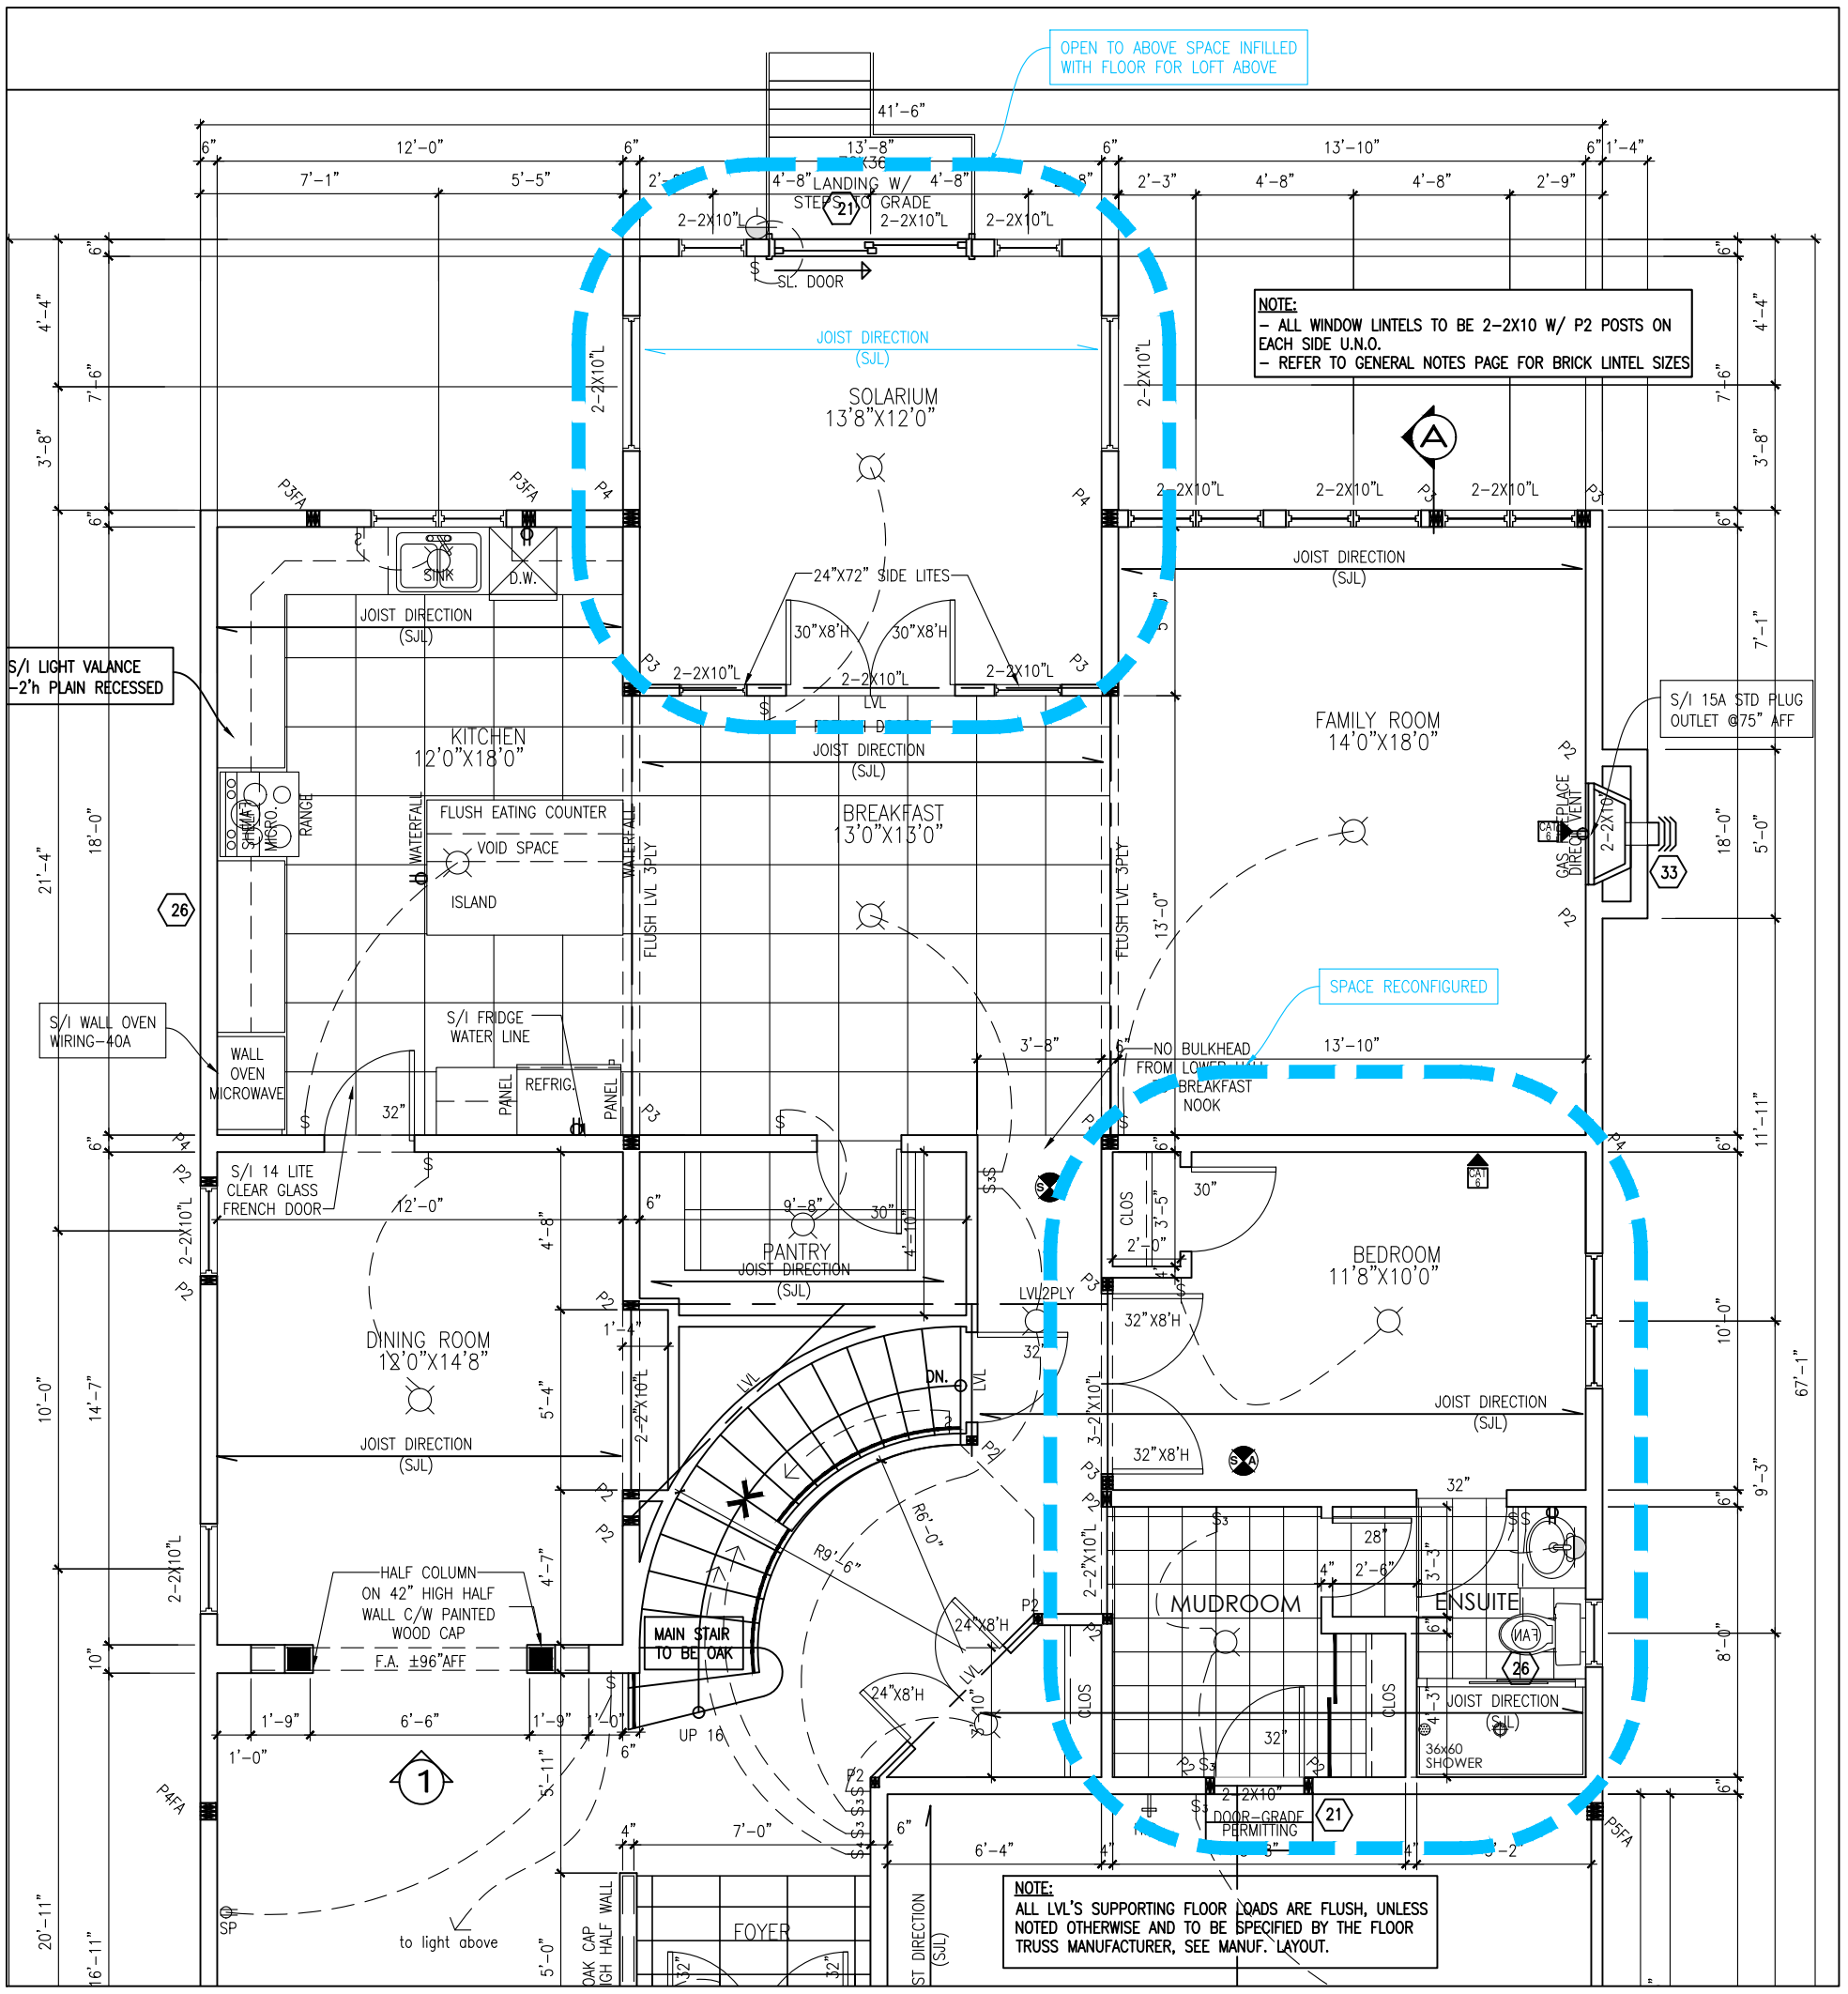

1
2
PARTIAL GROUND FLOOR PLAN
scale: 3/16"=1'-0"

City of Ottawa
Building Services Branch
REVIEWED
By Nicholas Winn at 9:37 am, May 26, 2022
Building Code Reviewed
Signature

PHOENIX HOMES

ANNAPOLIS-2019-B

SITE: PATHWAYS PH2

LOT NUMBER: 256

CIVIC ADDRESS:
306 SPREADWING WAY

No.	Description	Date	By
9	STRUCTURAL REVIEW	MAY-2-22	SP
8	FINAL BLACKLINES	FEB-9-22	GK
7	BEP BLACKLINES	NOV-25-21	KE
6	STRUCTURAL REVIEW	JUN-25-19	SP
5	ADD GARAGE WALL HEIGHTS	SEP-20-18	SP

REVISIONS

file number: 509
drawn by: T.L.
date: DEC. 2012
scale: 3/16"=1'
DCL-192 sheet no: 10
3B/9

TO BE READ IN CONJUNCTION WITH MASTER FOOTPRINTED PLANS

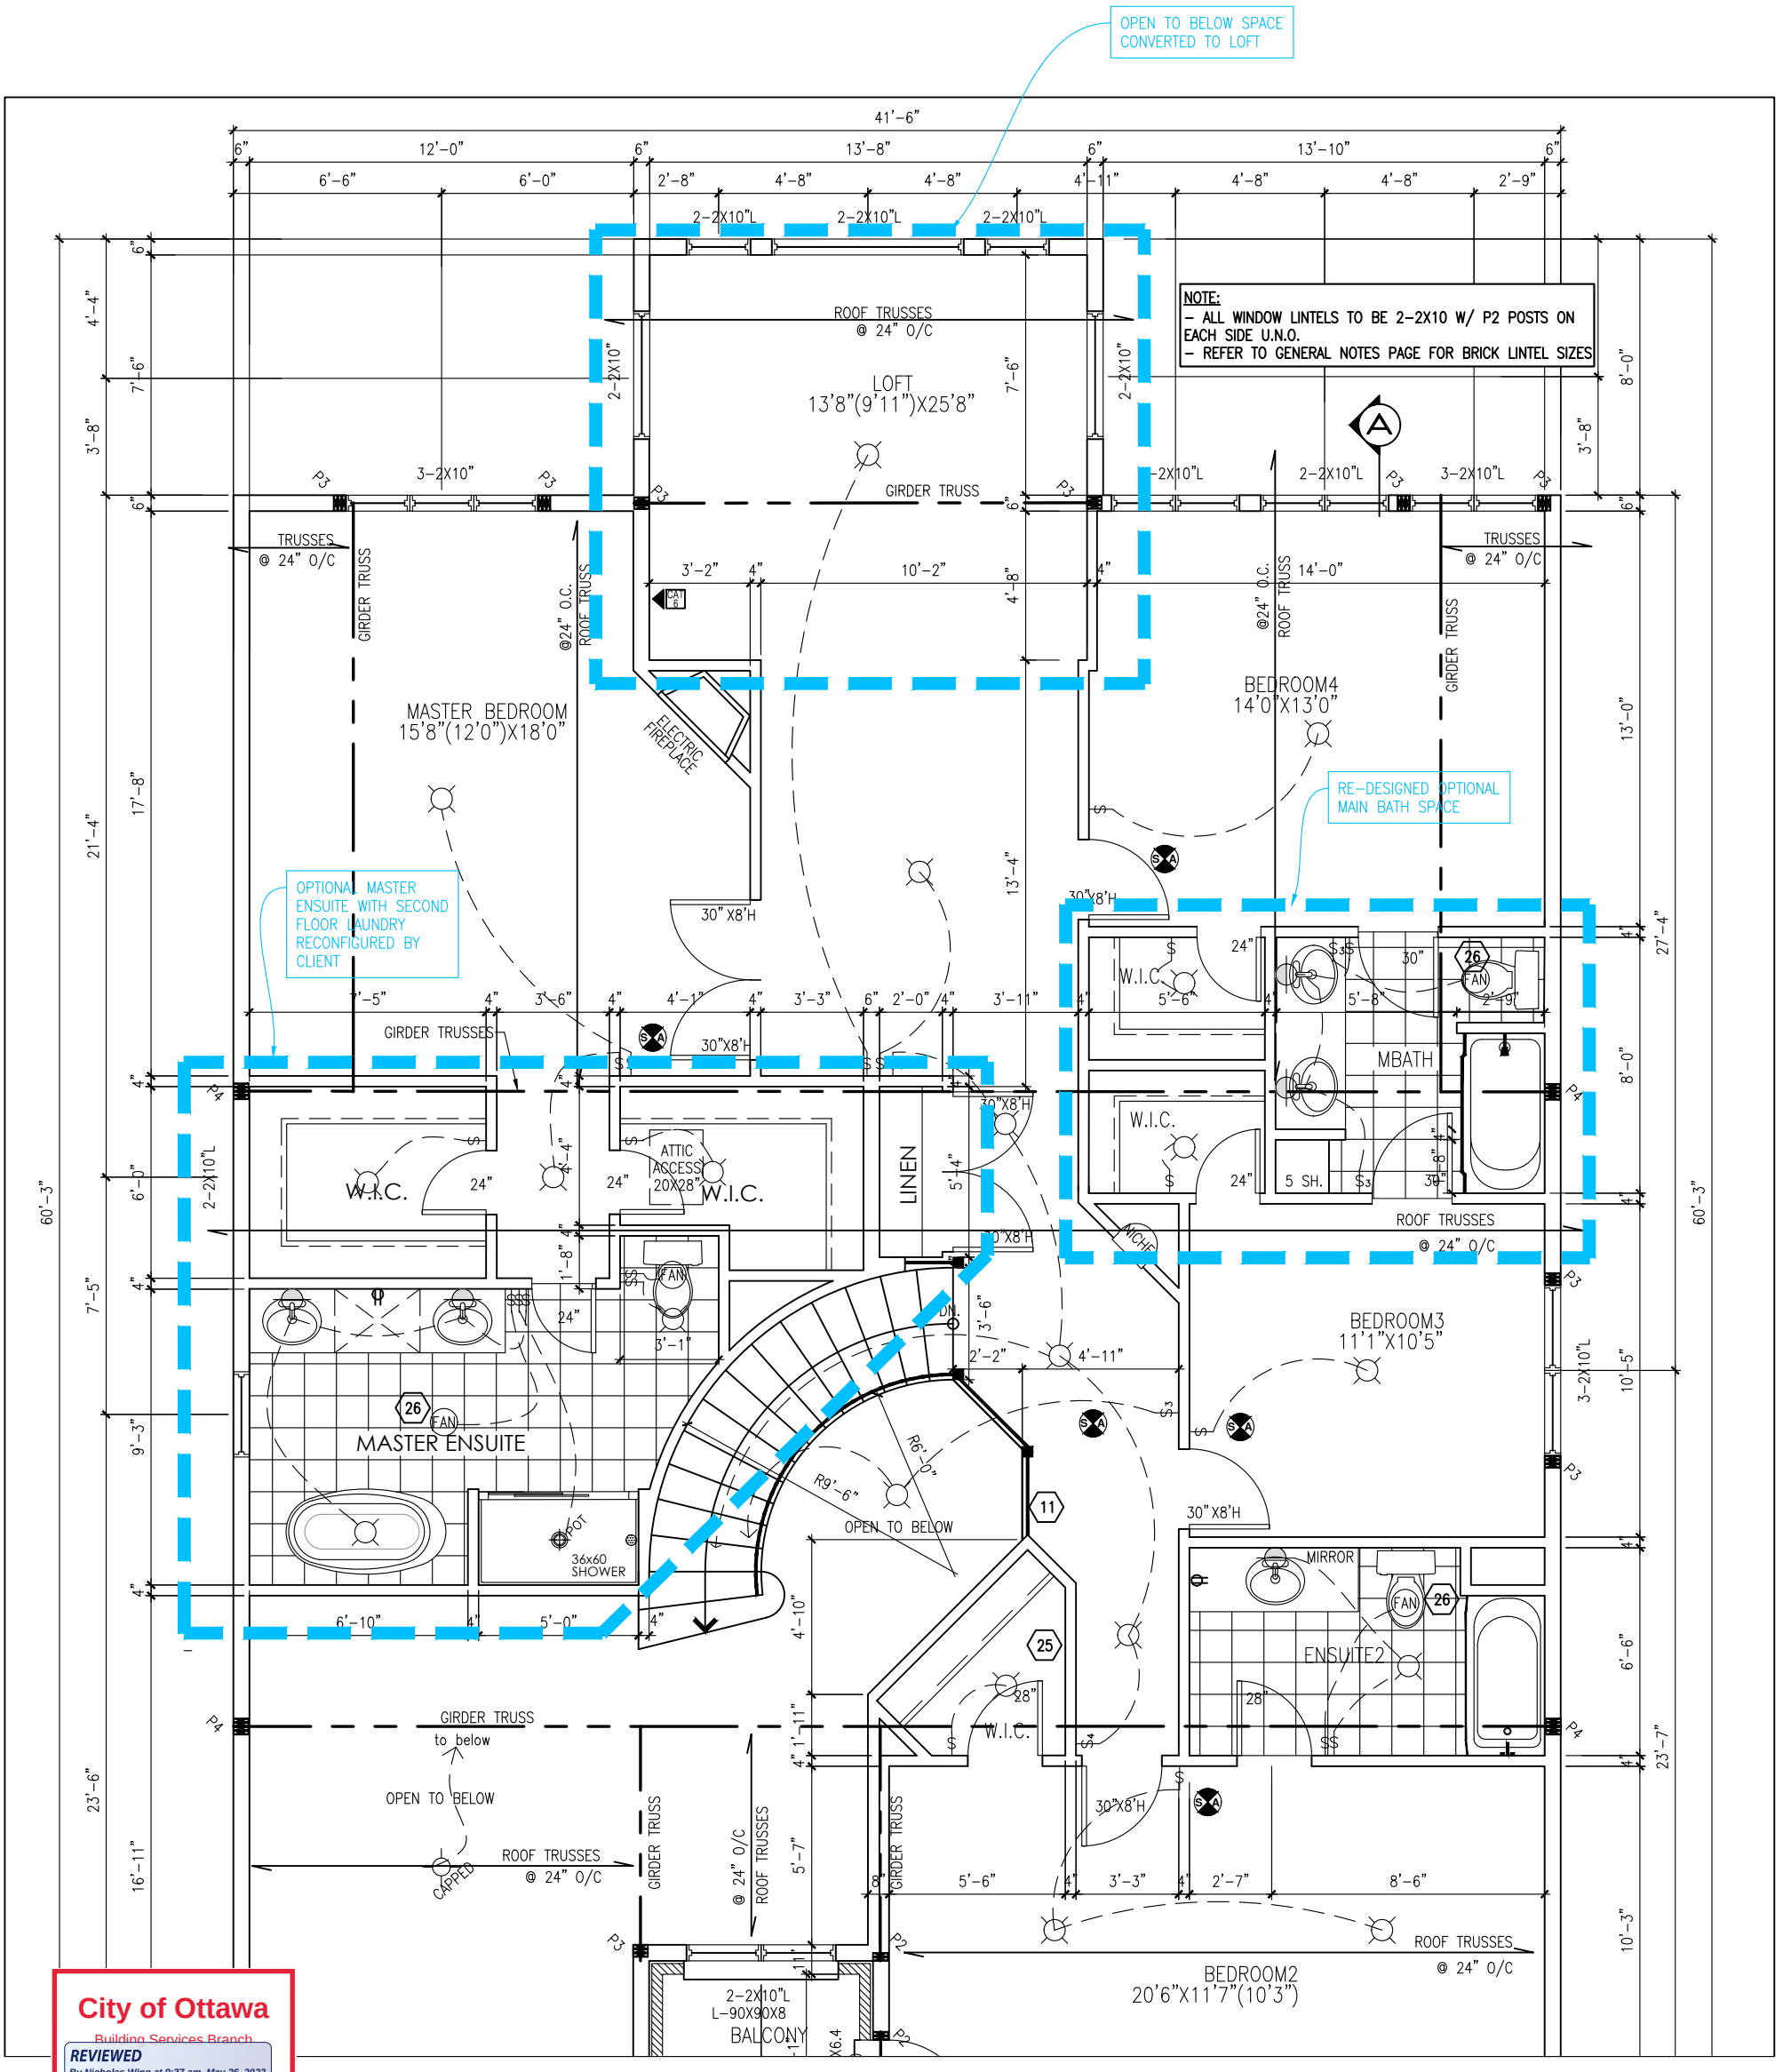

City of Ottawa
Building Services Branch
REVIEWED
By Nicholas Winn at 9:37 am, May 26, 2022
Building Code Reviewed
Signature

PHOENIX HOMES

ANNAPOLIS-2019-B

SITE: PATHWAYS PH2

LOT NUMBER: 256

CIVIC ADDRESS: 306 SPREADWING WAY

No.	Description	Date	By
9	STRUCTURAL REVIEW	MAY-2-22	SP
8	FINAL BLACKLINES	FEB-9-22	GK
7	BEP BLACKLINES	NOV-25-21	KE
6	STRUCTURAL REVIEW	JUN-25-19	SP
5	ADD GARAGE WALL HEIGHTS	SEP-20-18	SP

REVISIONS

file number: 509
drawn by: T.L.
date: DEC. 2012
scale: 3/16"=1'
DCL-192 sheet no: 11
4B/9