


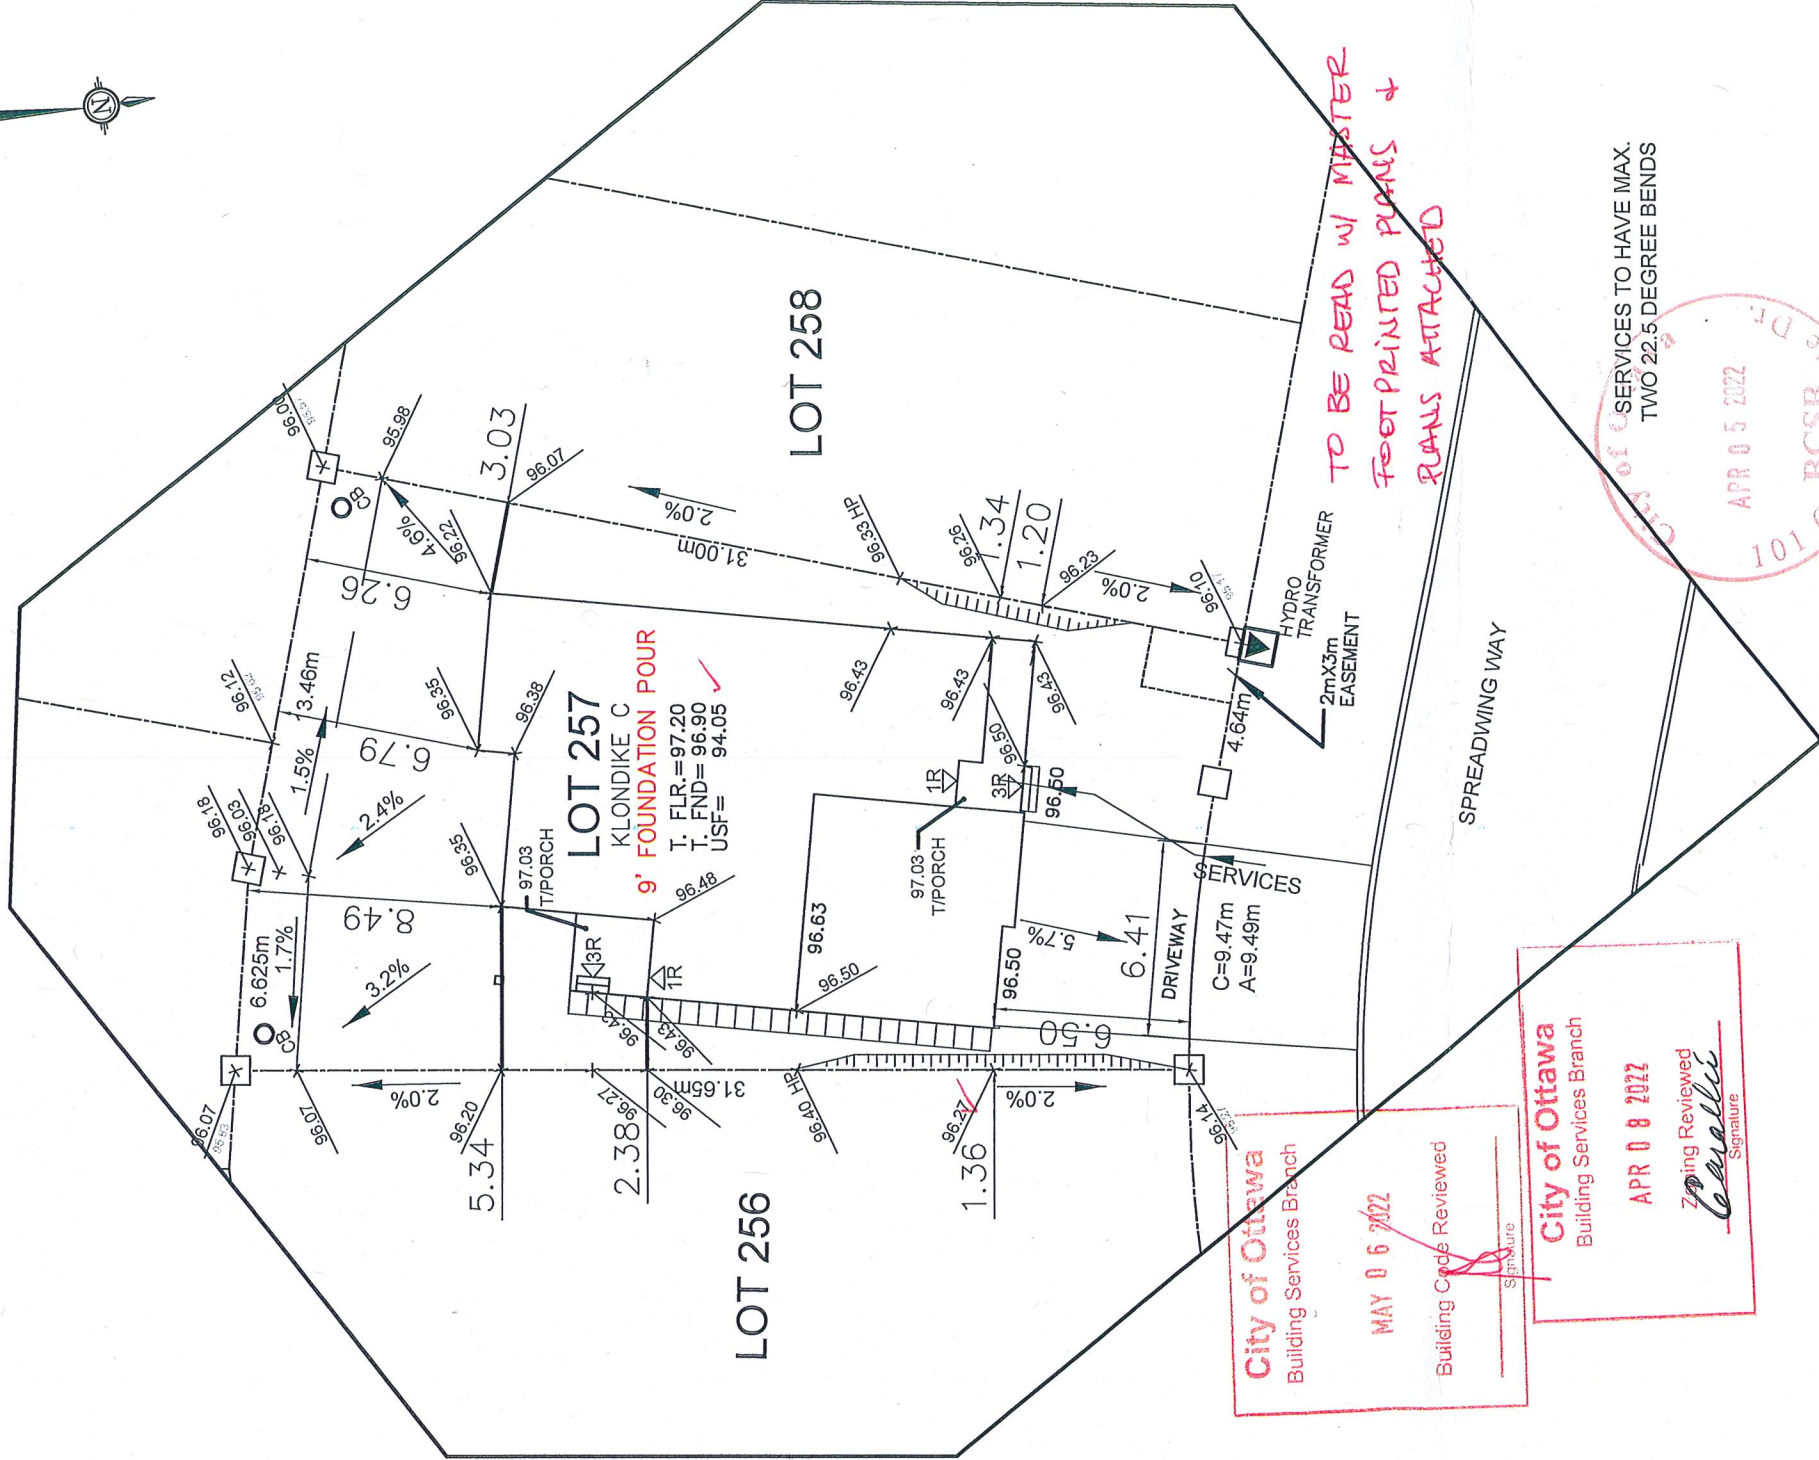

Owner/Applicant

DCR/PHOENIX HOMES

Telephone # 723-9227
Plan # 4M- 1618
Project name:PATHWAYS
Civic Address:304 SPREADING
House model: KLONDIKE C

Bldg. Ht. _____ m
Lot coverage 40.4 %
Scale 1:250
Sod Area 327 m²
Asphalt Area 76 m²

CHECKED/APPROVED BY: T.L.MAK ENG.



LOT 257 SITE/GRADING PLAN
PATHWAYS PHASE 2

INDIVIDUAL LOT GRADING REVIEW SUMMARY FOR SITED
HOUSE AS COMPARED WITH OVERALL SUBDIVISION PLAN

NOTE: THIS PLAN IS NOT A SURVEY PLAN OR SUBDIVISION
PLAN WITHIN THE MEANING OF PLANNING ACT.
THIS PLAN IS FOR REFERENCE ONLY AND IS PRELIMINARY IN NATURE, ALL
DIMENSIONS SHOWN ARE APPROXIMATE. E.O&E.