


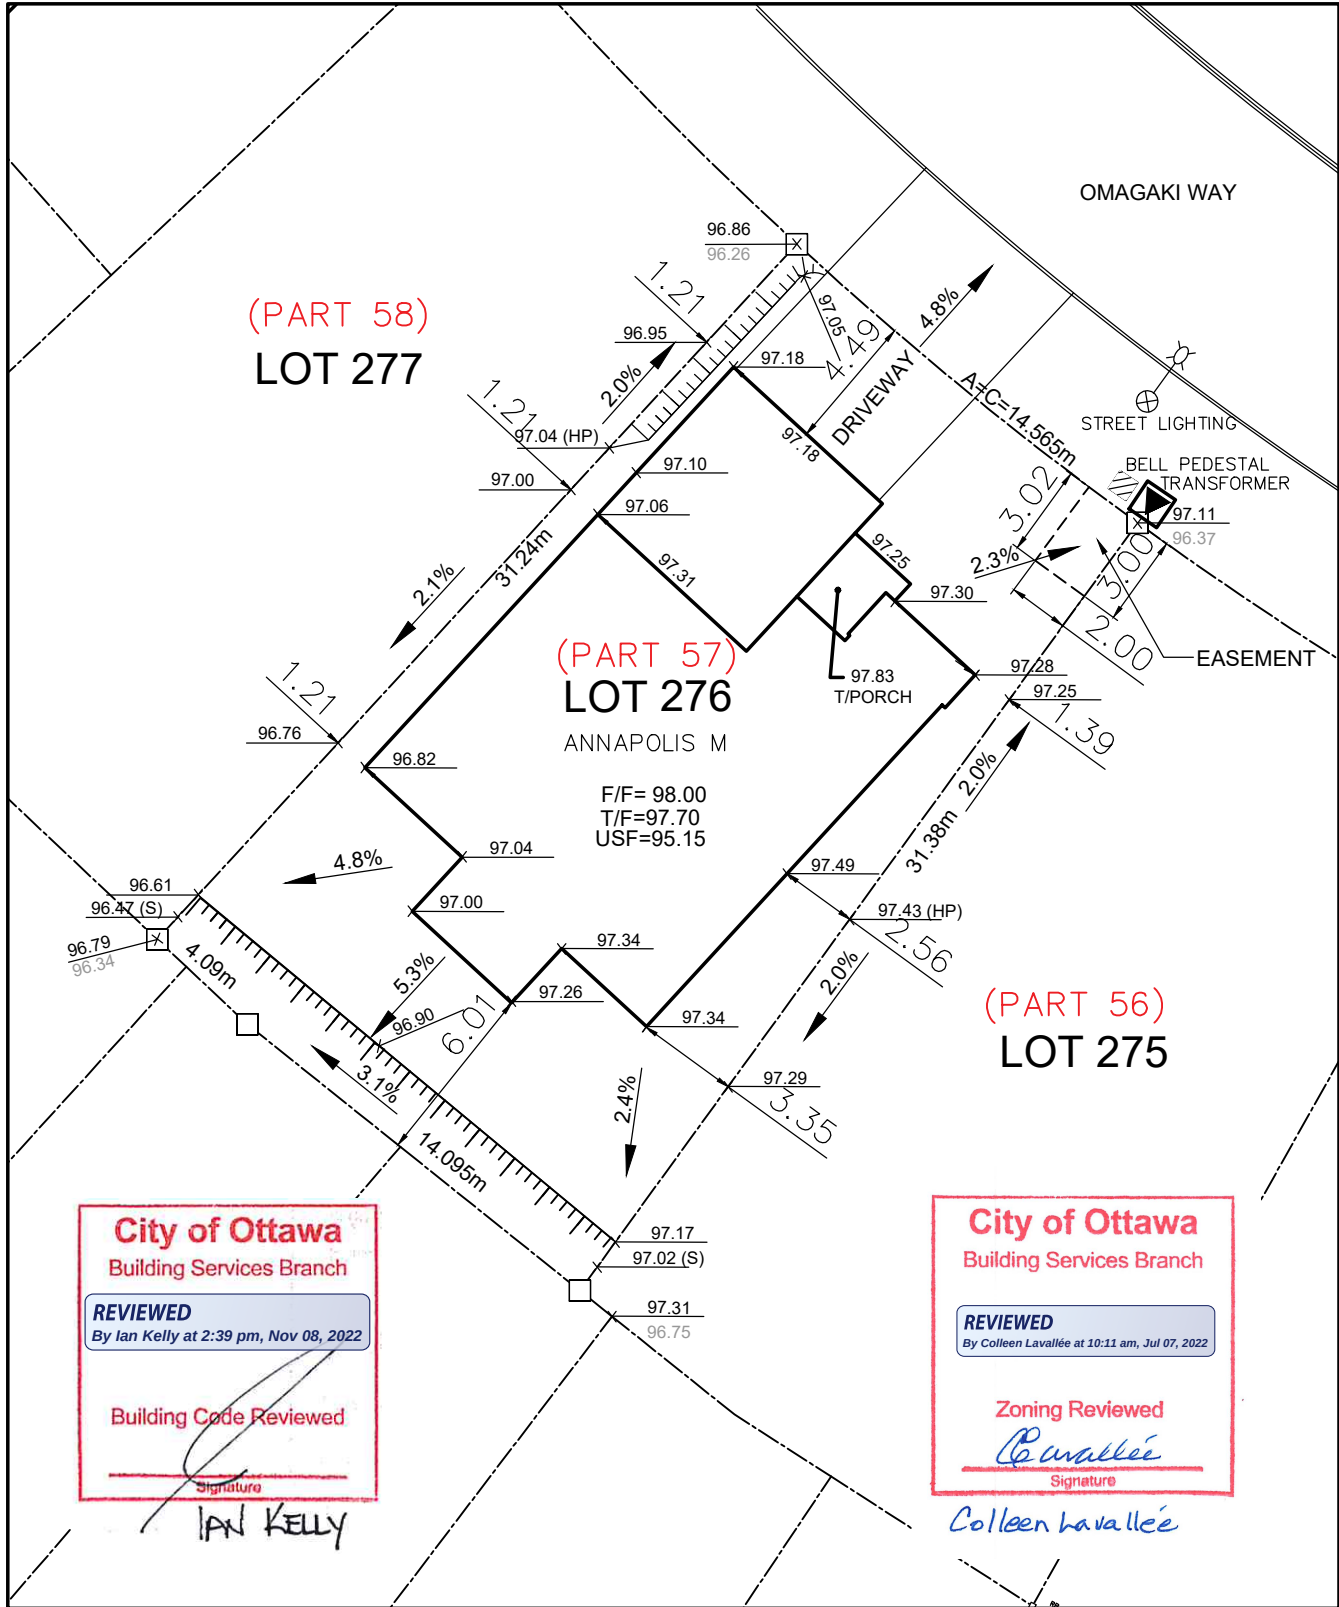

Owner/Applicant	
DCR/PHOENIX HOMES	
Telephone #	723-9227
Plan #	4M- 1618
Project name:	PATHWAYS
Civic Address:	906 OMAGAKI WAY
House model:	ANNAPOLIS M
Bldg. Ht.	m
Lot coverage	44.6 %
Scale	1:250
Sod Area	292.30 m ²
Asphalt Area	59.47 m ²
CHECKED/APPROVED BY: T.L.MAK ENG.	
MAY 11, 2022	



PHOENIX HOMES

LOT 276

SITE/GRADING PLAN

PATHWAYS PHASE 2

INDIVIDUAL LOT GRADING REVIEW SUMMARY FOR SITED HOUSE AS COMPARED WITH OVERALL SUBDIVISION PLAN

NOTE: THIS PLAN IS NOT A SURVEY PLAN OR SUBDIVISION PLAN WITHIN THE MEANING OF PLANNING ACT.