




**SITE COPY**  
City of Ottawa

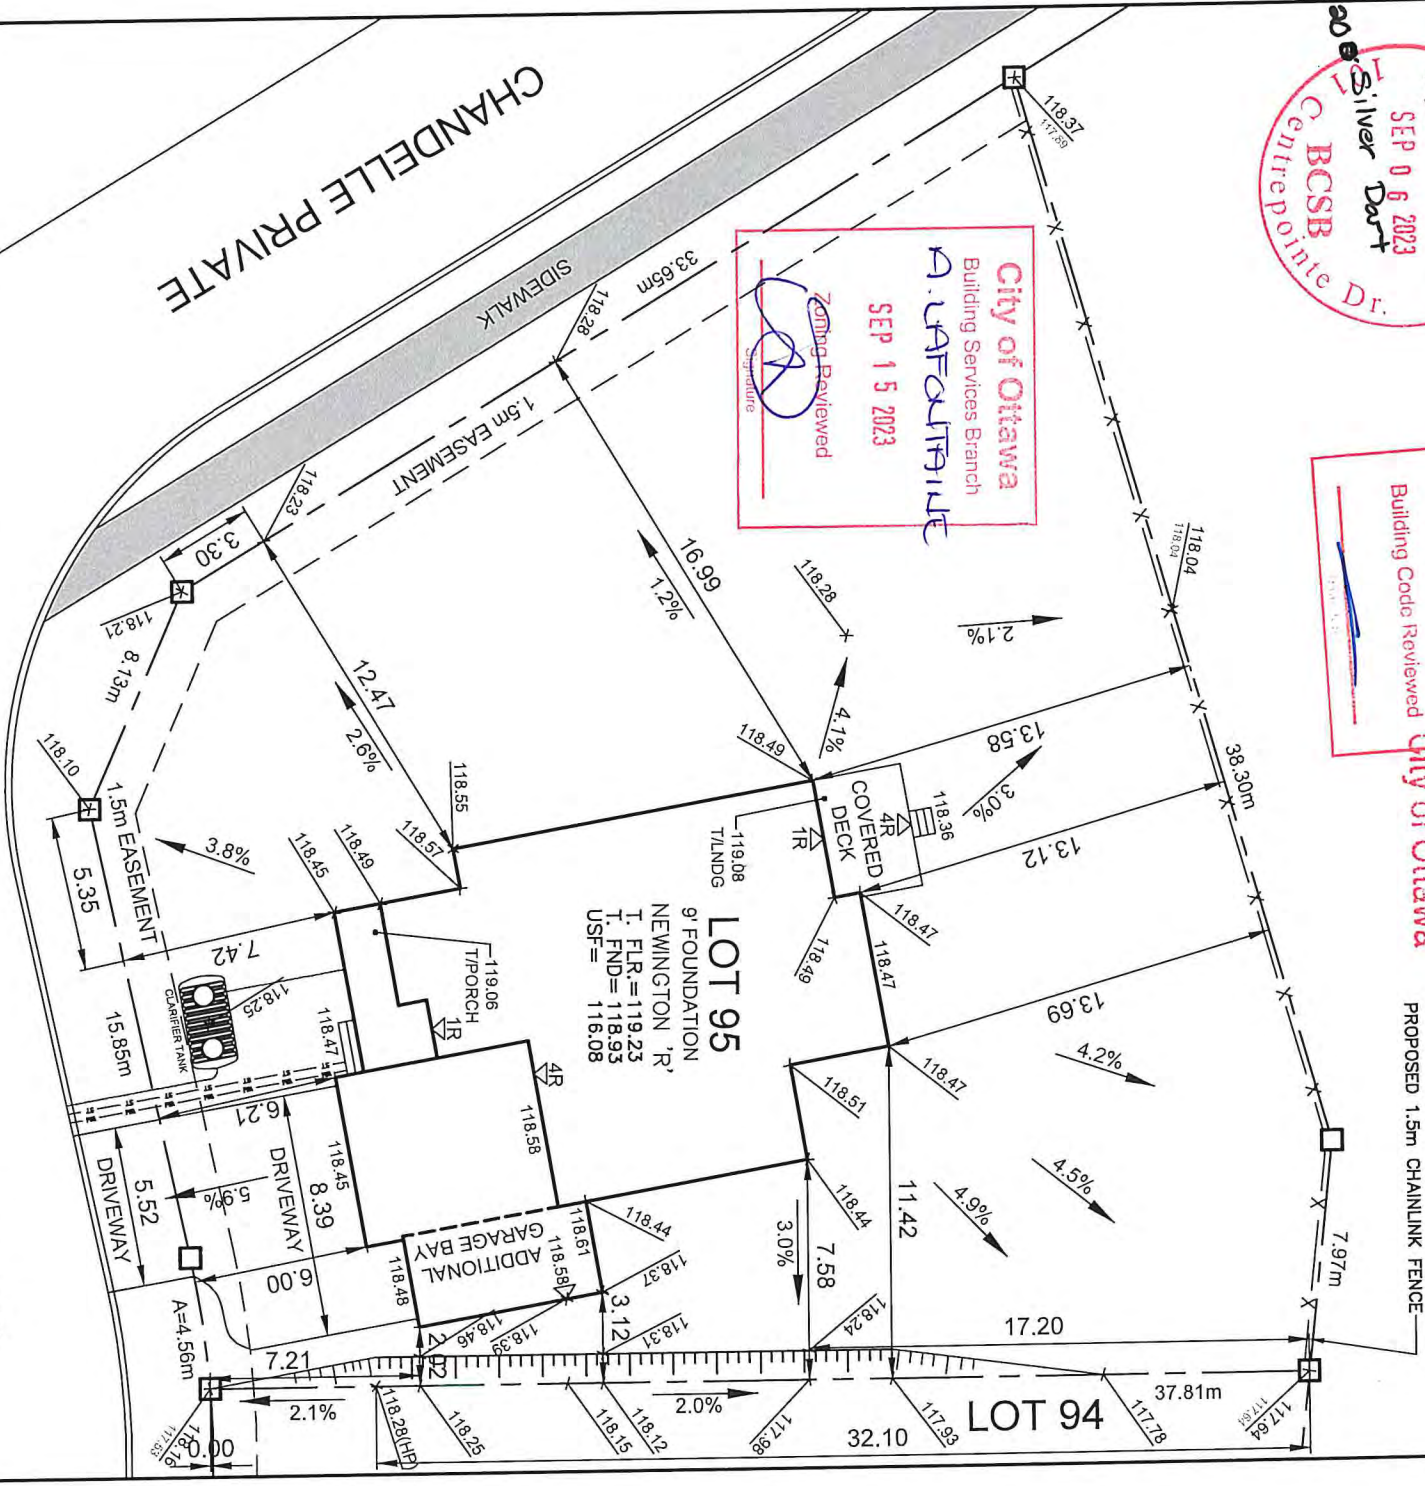

PROPOSED 1.5m CHAINLINK FENCE



CLARIFIER TANK INVERTS  
BUILDING OUTLET=117.89  
CLARIFIER INLET= 117.77  
CLARIFIER OUTLET=117.69

SILVER DART PRIVATE

Owner/Applicant

DCR/PHOENIX HOMES

Telephone # 723-9227  
Plan # 4M-1593

Project name: DIAMONDVIEW  
Civic Address: 200 SILVER DART  
House model: NEWINGTON 'R'

Bldg. Ht. \_\_\_\_\_ m  
Lot coverage 17.3 %  
Scale 1:250  
Sod Area 1230 m<sup>2</sup>  
Asphalt Area 68 m<sup>2</sup>

CHECKED/APPROVED BY: T.L.MAK ENG.



**LOT 95**  
SITE/GRADING PLAN  
DIAMONDVIEW PHASE 3

NOTE: THIS PLAN IS NOT A SURVEY PLAN OR SUBDIVISION  
PLAN WITHIN THE MEANING OF PLANNING ACT.  
THIS PLAN IS FOR REFERENCE ONLY AND IS PRELIMINARY IN  
NATURE. ALL DIMENSIONS SHOWN ARE APPROXIMATE. E.O.&E.



No excess drainage to be directed towards adjacent properties

Top of Foundation to be min. 0.15m above final grade


USF to have min. 1.5m cover around foundation or foundation shall be insulated

Sleeved services required under retaining walls / footings / garage, and are recommended under porches, decks, and similar structures

Grading to be 2-7%.  
Grading over 7% to be terraced (max. 3H:1V)




Maximum 2 - 22.5 degree horizontal radius bends for each service lateral (excluding septic system piping). Bends must be located on private property, spaced min. 1.0m apart, and 1.0m away from all valves

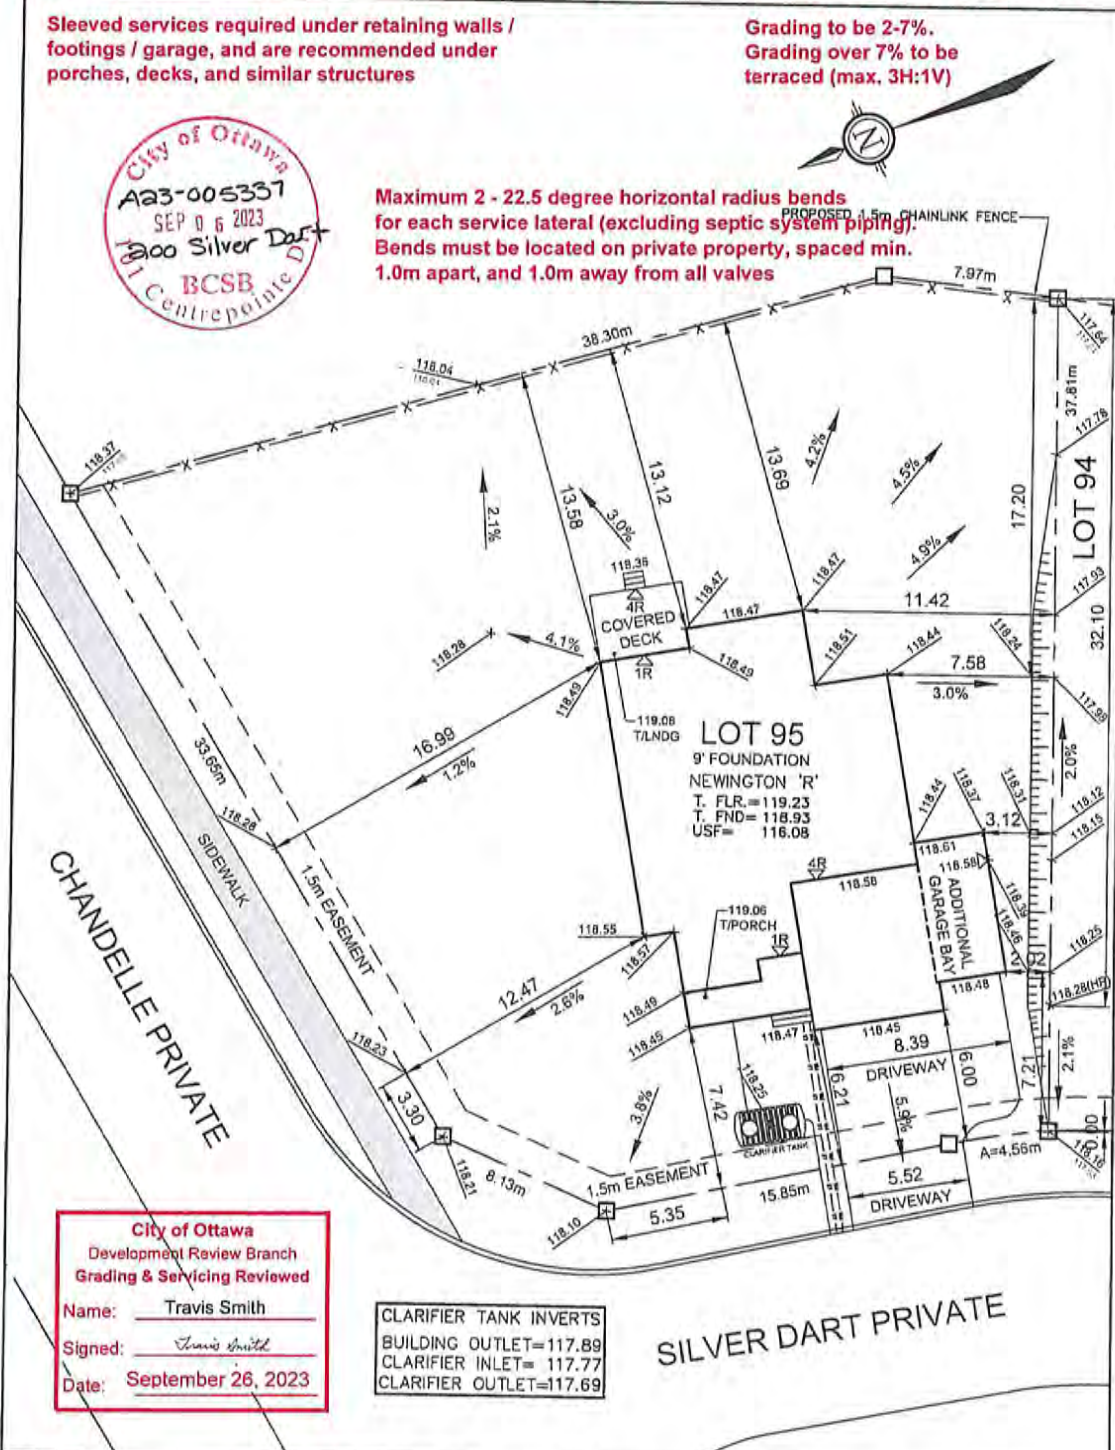

City of Ottawa  
Development Review Branch  
Grading & Servicing Reviewed  
Name: Travis Smith  
Signed: Travis Smith  
Date: September 26, 2023

CLARIFIER TANK INVERTS  
BUILDING OUTLET=117.89  
CLARIFIER INLET= 117.77  
CLARIFIER OUTLET=117.69

Owner/Applicant <b>DCR/PHOENIX HOMES</b>	
Telephone #	723-9227
Plan #	4M-1593
Project name:	DIAMONDVIEW
Civic Address:	200 SILVER DART PRIVATE
House model:	NEWINGTON 'R'
Bldg. Ht.	m
Lot coverage	17.3 %
Scale	1:250
Sod Area	1230 m <sup>2</sup>
Asphalt Area	68 m <sup>2</sup>
CHECKED/APPROVED BY: T.L.MAK ENG.	
	
<b>LOT 95 SITE/GRADING PLAN</b> DIAMONDVIEW PHASE 3	
INDIVIDUAL LOT GRADING REVIEW SUMMARY FOR SITED HOUSE AS COMPARED WITH OVERALL SUBDIVISION PLAN	
NOTE: THIS PLAN IS NOT A SURVEY PLAN OR SUBDIVISION PLAN WITHIN THE MEANING OF PLANNING ACT. THIS PLAN IS FOR REFERENCE ONLY AND IS PRELIMINARY IN NATURE. ALL DIMENSIONS SHOWN ARE APPROXIMATE. E.O&E.	



# Kollaard Associates

Engineers

210 Prescott Street  
P.O. Box 189  
Kemptville, Ontario K0G 1J0

Civil • Geotechnical •  
Structural • Environmental •  
Hydrogeology •

**(613) 860-0923**

FAX: (613) 258-0475

September 1, 2023

Kollaard File # 230021 – LOT95

Phoenix Homes  
18A Bentley Avenue  
Ottawa, Ontario  
K2E 6T8

Attn: Catherine Buck  
Tel: 613-723-9227 x 191  
Email: CBuck@phoenixhomes.ca



**SITE  
COPY**  
City of Ottawa

**Re: Proposed Single Family Dwelling, Lot # 95 Silver Dart Private, Diamondview Estates, Carp, City of Ottawa, Kollaard Associates File # 230021**

With regard to structural issues only, Kollaard Associates has reviewed the following drawings:

- Phoenix Homes, 200 Silver Dart Private, Pages # 1R to 9R, Dated 01/09/2023
- Grandor Lumber Inc., Upper Roof Truss Layout, Newington 'R', DV3-95, Dated 08/31/2023
- Grandor Lumber Inc., Lower Roof Truss Layout, Newington 'R', DV3-95, Dated 08/31/2023
- Grandor Lumber Inc., 2<sup>nd</sup> Floor Joist Layout, Newington M/R, Dated 07/16/2021
- Grandor Lumber Inc., 1<sup>st</sup> Floor Joist Layout, Newington M/R, Dated 07/16/2021

Kollaard Associates offers the following comments:

Second Floor Plan – Pages # 4R:

1. It is the opinion of Kollaard Associates that the proposed lintels and supporting posts shown on Phoenix Homes Pages # 4R are adequate.
2. The proposed tall wall noted on Phoenix Homes Pages # 1R is adequate.
3. Posts supporting girders may consist of built up 2x6 posts as indicated on Phoenix Homes Pages # 4R and are laterally supported by plywood or OSB sheathing (i.e. posts form part of sheathed exterior walls unless noted).
4. Truss design is by others.

Ground Floor Plan – Pages # 3R:

5. It is the opinion of Kollaard Associates that the proposed lintels, beams and supporting posts shown on Phoenix Homes Pages # 3R are adequate.



Professional Engineers  
Ontario

Authorized by the Association of Professional Engineers  
of Ontario to offer professional engineering services.



6. Ramset a 2x6 to the top flange of all steel beams to attach the above framing, floor joists and flush LVL beams.
7. The proposed web packing of the web of the steel beam to fasten the face mounted hangers shown on Phoenix Homes Pages # 9R is adequate.
8. Truss design is by others.
9. Floor joist design and flush LVL beams within the floor structure are by the manufacturer.

Basement Plan – Pages # 2R:

10. It is the opinion of Kollaard Associates that the proposed steel beams steel posts shown on Phoenix Homes Pages # 2R are adequate.
11. The front porch slab reinforcement described on Phoenix Homes Pages # 1R is adequate.
12. The proposed rear deck beams, posts, joists, ledger connections and sonotubes shown on Phoenix Homes Pages # 2R are adequate.
13. The foundation walls at the bottom of the window openings that exceed 47¼" in width (or the sum of the widths of the window openings exceed 25% of the length of the wall) are considered to be laterally unsupported as per 2012 OBC 9.15.4.3. The proposed reinforcement noted on Phoenix Homes Pages # 2R is adequate to withstand the lateral earth pressures.
14. The remaining proposed foundation walls conform to 2012 OBC Table 9.15.4.2.A. ensuring that the grade difference between the basement slab and the exterior grade (including the garage slab) does not exceed 7'-6½" for the full height 8'-10" foundation walls.
15. The proposed strip footings, interior pad footings and exterior pad footings shown on Phoenix Homes Page # 2R and noted on Phoenix Homes Page # 1R are adequate.
16. Floor joist design, flush LVL beams within the floor structure and LVL lintels are by the manufacturer. The posts supporting the flush LVL lintels shown on Phoenix Homes Pages # 2R are adequate.

General Notes:

17. All gravity loads to be carried to foundation through solid blocking.
18. Truss design is by others.
19. Floor joist design, flush LVL beams within the floor structure and LVL lintels are by the manufacturer.
20. The self supporting stairs are to be designed by the stair manufacturer.
21. All dimension lumber, except non-load bearing 8 ft 2x6 studs to be No.2 grade SPF or better.
22. Non-load bearing 8 ft 2x6 studs to be No.3 or Stud grade SPF or better.
23. All guards to be as per OBC SB-7, unless otherwise mentioned and designed by others.
24. All brick lintels to be as per OBC Table 9.20.5.2.B.



25. Unless otherwise noted, LVL to be 1.8E 3000Fb LVL (Canadian Limit States bending strength of at least 39.5 MPa) with 1¾" nominal width or better.
26. Pemco Steel adjustable posts are designed and approved by the manufacturer. The adjustable steel posts are designed for a maximum allowable load of 106.8 kN at a maximum height of 9'-3".
27. All 3" x 3" x 3/16" HSS posts c/w 6" x 6" x 3/8" top and bottom bearing plates.
28. The assumed soil bearing resistance of 100 kPa is to be verified prior to construction.
29. Note that the truss manufacturer/floor joist supplier has sized the flush LVL beams and girder trusses shown on the building drawings. The comments provided by Kollaard Associates in this report are based in part on the design indicated in the truss and floor layouts. If a different truss and/or floor layout is used in construction, comments made in this report may no longer be valid. Provide Kollaard Associates with the full truss package prior to construction.
30. Comments provided in this report are made in consideration of Part 9 and Part 4 (where applicable) of the 2012 OBC as amended.
31. This report constitutes a review of the structural information indicated on the building plans cited in this report for the client indicated above.

We trust this letter provides sufficient information for your present purposes. If you have any questions concerning this letter please do not hesitate to contact our office.

Sincerely,  
Kollaard Associates Inc.



Christopher Cogliati, P.Eng.

# Energy Efficiency Design Summary: Prescriptive Method

(Building Code Part 9, Residential)

This form is used by a designer to demonstrate that the energy efficiency design of a house complies with the building code using the prescriptive method described in Subsection 3.1.1. of SB-12. This form is applicable where the ratio of gross area of windows/sidelights/skylights/glazing in doors and sliding glass doors to the gross area of peripheral walls is not more than 22%.

For use by Principal Authority	
Application No:	Model/Certification Number

## A. Project Information

Building number, street name <b>200 Silver Dart Private</b>		Unit number	Lot/Con <b>95</b>
Municipality <b>West Carleton</b>	Postal code	Reg. Plan number / other description <b>4M-1593</b>	

## B. Prescriptive Compliance [indicate the building code compliance package being employed in this house design]

SB-12 Prescriptive (input design package): Package: <b>A1</b>	Table: <b>3.1.1.2.A(IP)</b>
---	-----------------------------

## C. Project Design Conditions

<b>Climatic Zone (SB-1):</b>		<b>Heating Equipment Efficiency</b>		<b>Space Heating Fuel Source</b>	
<input checked="" type="checkbox"/> Zone 1 (< 5000 degree days)		<input checked="" type="checkbox"/> ≥ 92% AFUE		<input checked="" type="checkbox"/> Gas	<input type="checkbox"/> Propane
<input type="checkbox"/> Zone 2 (≥ 5000 degree days)		<input type="checkbox"/> ≥ 84% < 92% AFUE		<input type="checkbox"/> Oil	<input type="checkbox"/> Electric
				<input type="checkbox"/> Solid Fuel	
				<input type="checkbox"/> Earth Energy	
<b>Ratio of Windows, Skylights &amp; Glass (W, S &amp; G) to Wall Area</b>			<b>Other Building Characteristics</b>		
Area of walls = _____ m <sup>2</sup> or <b>4182</b> ft <sup>2</sup>			<input type="checkbox"/> Log/Post&Beam <input type="checkbox"/> ICF Above Grade <input type="checkbox"/> ICF Basement <input type="checkbox"/> Slab-on-ground <input type="checkbox"/> Walkout Basement <input type="checkbox"/> Air Conditioning <input type="checkbox"/> Combo Unit <input type="checkbox"/> Air Sourced Heat Pump (ASHP) <input type="checkbox"/> Ground Sourced Heat Pump (GSHP)		
W, S & G % = <b>14.1</b>					
Area of W, S & G = _____ m <sup>2</sup> or <b>590.87</b> ft <sup>2</sup>			Utilize window averaging: <input type="checkbox"/> Yes <input checked="" type="checkbox"/> No		

## D. Building Specifications [provide values and ratings of the energy efficiency components proposed]

Energy Efficiency Substitutions			
<input type="checkbox"/> ICF (3.1.1.2.(5) & (6) / 3.1.1.3.(5) & (6)) <input type="checkbox"/> Combined space heating and domestic water heating systems (3.1.1.2.(7) / 3.1.1.3.(7)) <input type="checkbox"/> Airtightness substitution(s) Airtightness test required (Refer to Design Guide Attached)			
<input type="checkbox"/> Table 3.1.1.4.B Required: _____ Permitted Substitution: _____ <input type="checkbox"/> Table 3.1.1.4.C Required: _____ Permitted Substitution: _____ Required: _____ Permitted Substitution: _____		<div style="border: 2px solid red; padding: 5px; text-align: center;"> <b>City of Ottawa</b>          Building Services Branch   <b>SEP 14 2023</b>          Building Code Reviewed  </div>	
Building Component	Minimum RSI / R values or Maximum U-Value <sup>(1)</sup>	Building Component	Efficiency Ratings
<b>Thermal Insulation</b>	Nominal   Effective	<b>Windows &amp; Doors</b> Provide U-Value <sup>(1)</sup> or ER rating	
Ceiling with Attic Space	R60	Windows/Sliding Glass Doors	25
Ceiling without Attic Space	R31	Skylights/Glazed Roofs	0.49
Exposed Floor	R31	<b>Mechanicals</b>	
Walls Above Grade	R22	Heating Equip.(AFUE)	96%
Basement Walls <b>R12 + 10a</b>	<b>OR</b> R21.12	HRV Efficiency (SRE% at 0°C)	75%
Slab (all >600mm below grade)	—	DHW Heater (EF)	0.8
Slab (edge only ≤600mm below grade)	R10	DWHR (CSA B55.1 (min. 42% efficiency))	1   # Showers <b>4</b>
Slab (all ≤600mm below grade, or heated)	R10	Combined Heating System	NO

(1) U value to be provided in either W/(m<sup>2</sup>·K) or Btu/(h·ft<sup>2</sup>·F) but not both.

## E. Designer(s) [name(s) & BCIN(s), if applicable, of person(s) providing information herein to substantiate that design meets the building code]

Qualified Designer Declaration of designer to have reviewed and take responsibility for the design work		
Name <b>Catherine Buck</b>	BCIN <b>46674</b>	Signature 





# Mechanical Design Report

## Low rise residential



Address		House Builder PHOENIX	
Location of Installation		House Model (if applicable) NEWINGTON 5BED	
Name HARDING MECHANICAL		City of Ottawa Building Services Branch	
Address 2210 CAVANMORE RD		SEP 14 2023	
City OTTAWA		Postal Code K0A 1L0	
Telephone Number 613-831-2257		Fax Number 613-831-9011	
Installing Contractor		Building Code Reviewed 	

### SYSTEM DESIGN PARAMETERS

<b>Combustion Appliances 9.32.3.1.(1)</b> a) <input checked="" type="checkbox"/> Direct vent (sealed combustion) only b) <input type="checkbox"/> Positive venting induced draft (except fireplaces) c) <input type="checkbox"/> Natural draft, B-vent or induced draft fireplace d) <input type="checkbox"/> Solid Fuel (including fireplaces) e) <input type="checkbox"/> No Combustion Appliances	<b>Heating System</b> <input checked="" type="checkbox"/> Forced Air <input type="checkbox"/> Non-Forced Air (Other - _____) <input type="checkbox"/> Electric Space Heat <input type="checkbox"/> Radiant Floor Heat (attach pipe details) <input type="checkbox"/> Geothermal (attach loop, pipe & well details) <input type="checkbox"/> High Velocity Residential (attach duct details)
<b>House Type 9.32.3.1.(2)</b> <input checked="" type="checkbox"/> I Type a) or b) appliances only, no solid fuel <input type="checkbox"/> II Type I except with solid fuel (including fireplace) <input type="checkbox"/> III Any Type c) appliance = Part 6 Design <input type="checkbox"/> IV Electric space heat <input type="checkbox"/> Other: No forced air = Option 4	<b>Ventilation System</b> <input type="checkbox"/> CAN/CSA-F326 <input type="checkbox"/> HRV - Exhaust Ducts / Forced Air System <input checked="" type="checkbox"/> HRV - Simplified Connection to Forced Air System <input type="checkbox"/> HRV - Full Ducting / Not Coupled to Forced Air System <input type="checkbox"/> Part 6 Design (Other - _____)

### EQUIPMENT DESIGN REQUIREMENTS

<b>Total Ventilation Capacity 9.32.3.3.(1)</b>	<b>TOTAL</b>
Master Bedroom 1 x 10 L/s = 10 L/s	
Unfinished Basement 1 x 10 L/s = 10	
Other Habitable Rooms 14 x 5 L/s = 70	90 T.V.C.
<b>Principal Ventilation Capacity 9.32.3.4.(1)</b>	
Master Bedroom 1 x 15 L/s = 15	
Other Bedrooms 4 x 7.5 L/s = 30	- 45 P.V.C.
<b>Required Supplemental Ventilation Capacity (T.V.C. less P.V.C.) =</b>	<b>45</b>

Furnace size: \_\_\_\_\_ GMEC960804CNA 80,000 BTU'S \_\_\_\_\_ KJ


Air conditioner size: \_\_\_\_\_ GSX13042 3.5 TON \_\_\_\_\_ KJ (If provided / applicable)

Heating / Cooling Equipment sized according to heat loss/gain calculations of CAN/CSA F280: Yes

Geothermal Equipment designed according to CAN/CSA-C448.2: No

Hydronic Equipment designed according to CAN/CSA-B214: No

Duct (and pipe) schematic attached including sizes, runs and material used: Yes

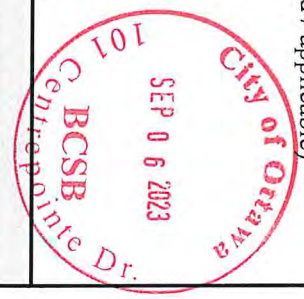

### VENTILATION EQUIPMENT

#### Heat Recovery Ventilator

Model: CLEAN COMFORT VH30100RNC HRV

90 \_\_\_\_\_ L/s High 45 \_\_\_\_\_ L/s Low

Exhaust Fans

	Location	Model	L/s	Sones	Principal or Supplemental
1	PDRM	DX90	45	2.5	PRINCIPAL
2	ENSUITE	EC50	25	3.	SUPPLEMENTAL
3	BATH/BATH 2	EC50/EC50	25/25	3./3.	SUPPLEMENTAL
4	GUEST BATH	EC50	25	3.	SUPPLEMENTAL

EQUIPMENT EFFICIENCIES (Please also refer to Energy Efficiency Design Summary)

Heating system:

Cooling system (if applicable):

Water heater:

HRV: 75 % sensible efficiency at 0 degrees:

60 % sensible efficiency at -25 degrees:

DESIGNER CERTIFICATION

I hereby certify that this ventilation system has been designed in accordance with the 2012 Ontario Building Code.

Name: LINDA MCPARLAN Company Name: HARDING MECHANICAL

Signature: Linda McParlan Date: MAY 3/21 BCIN 24379 HRAI # 6080






Furn GMEC960804CNA  
 Plenum 63" & CAE 10"x23 1/2" x5'  
 Date Description  
 210519.1AK Prelim Newington 5Bed+Office

PLAN (ELEVATION C)

Heat Loss			
Room Name	Htg cfm	Clg cfm	Htg btu
1-BREAKFAST	74	74	0
1-DININGROOM	60	61	0
1-ENITE 1	25	17	0
1-FOYER	44	15	0
1-GREATROOM	132	248	0
1-INLAW SUITE	24	11	0
1-KITCHEN	32	411	0
1-LAUNDRY	46	16	0
1-OFFICE	93	89	0
1-PDRM	13	9	0
1-SUNROOM	151	142	0
2-BATH	19	0	0
2-BATH 2	28	20	0
2-BEDROOM 3	66	52	0
2-BEDROOM 4	76	59	0
2-BONUSROOM	101	67	0
2-ENSUITE	44	28	0
2-HALL	7	6	0
2-LOFT	90	87	0
2-MASTERBEDROOM	86	82	0
2-W.I.C.	10	4	0
B-BMT	323	27	0
	1544	1525	0

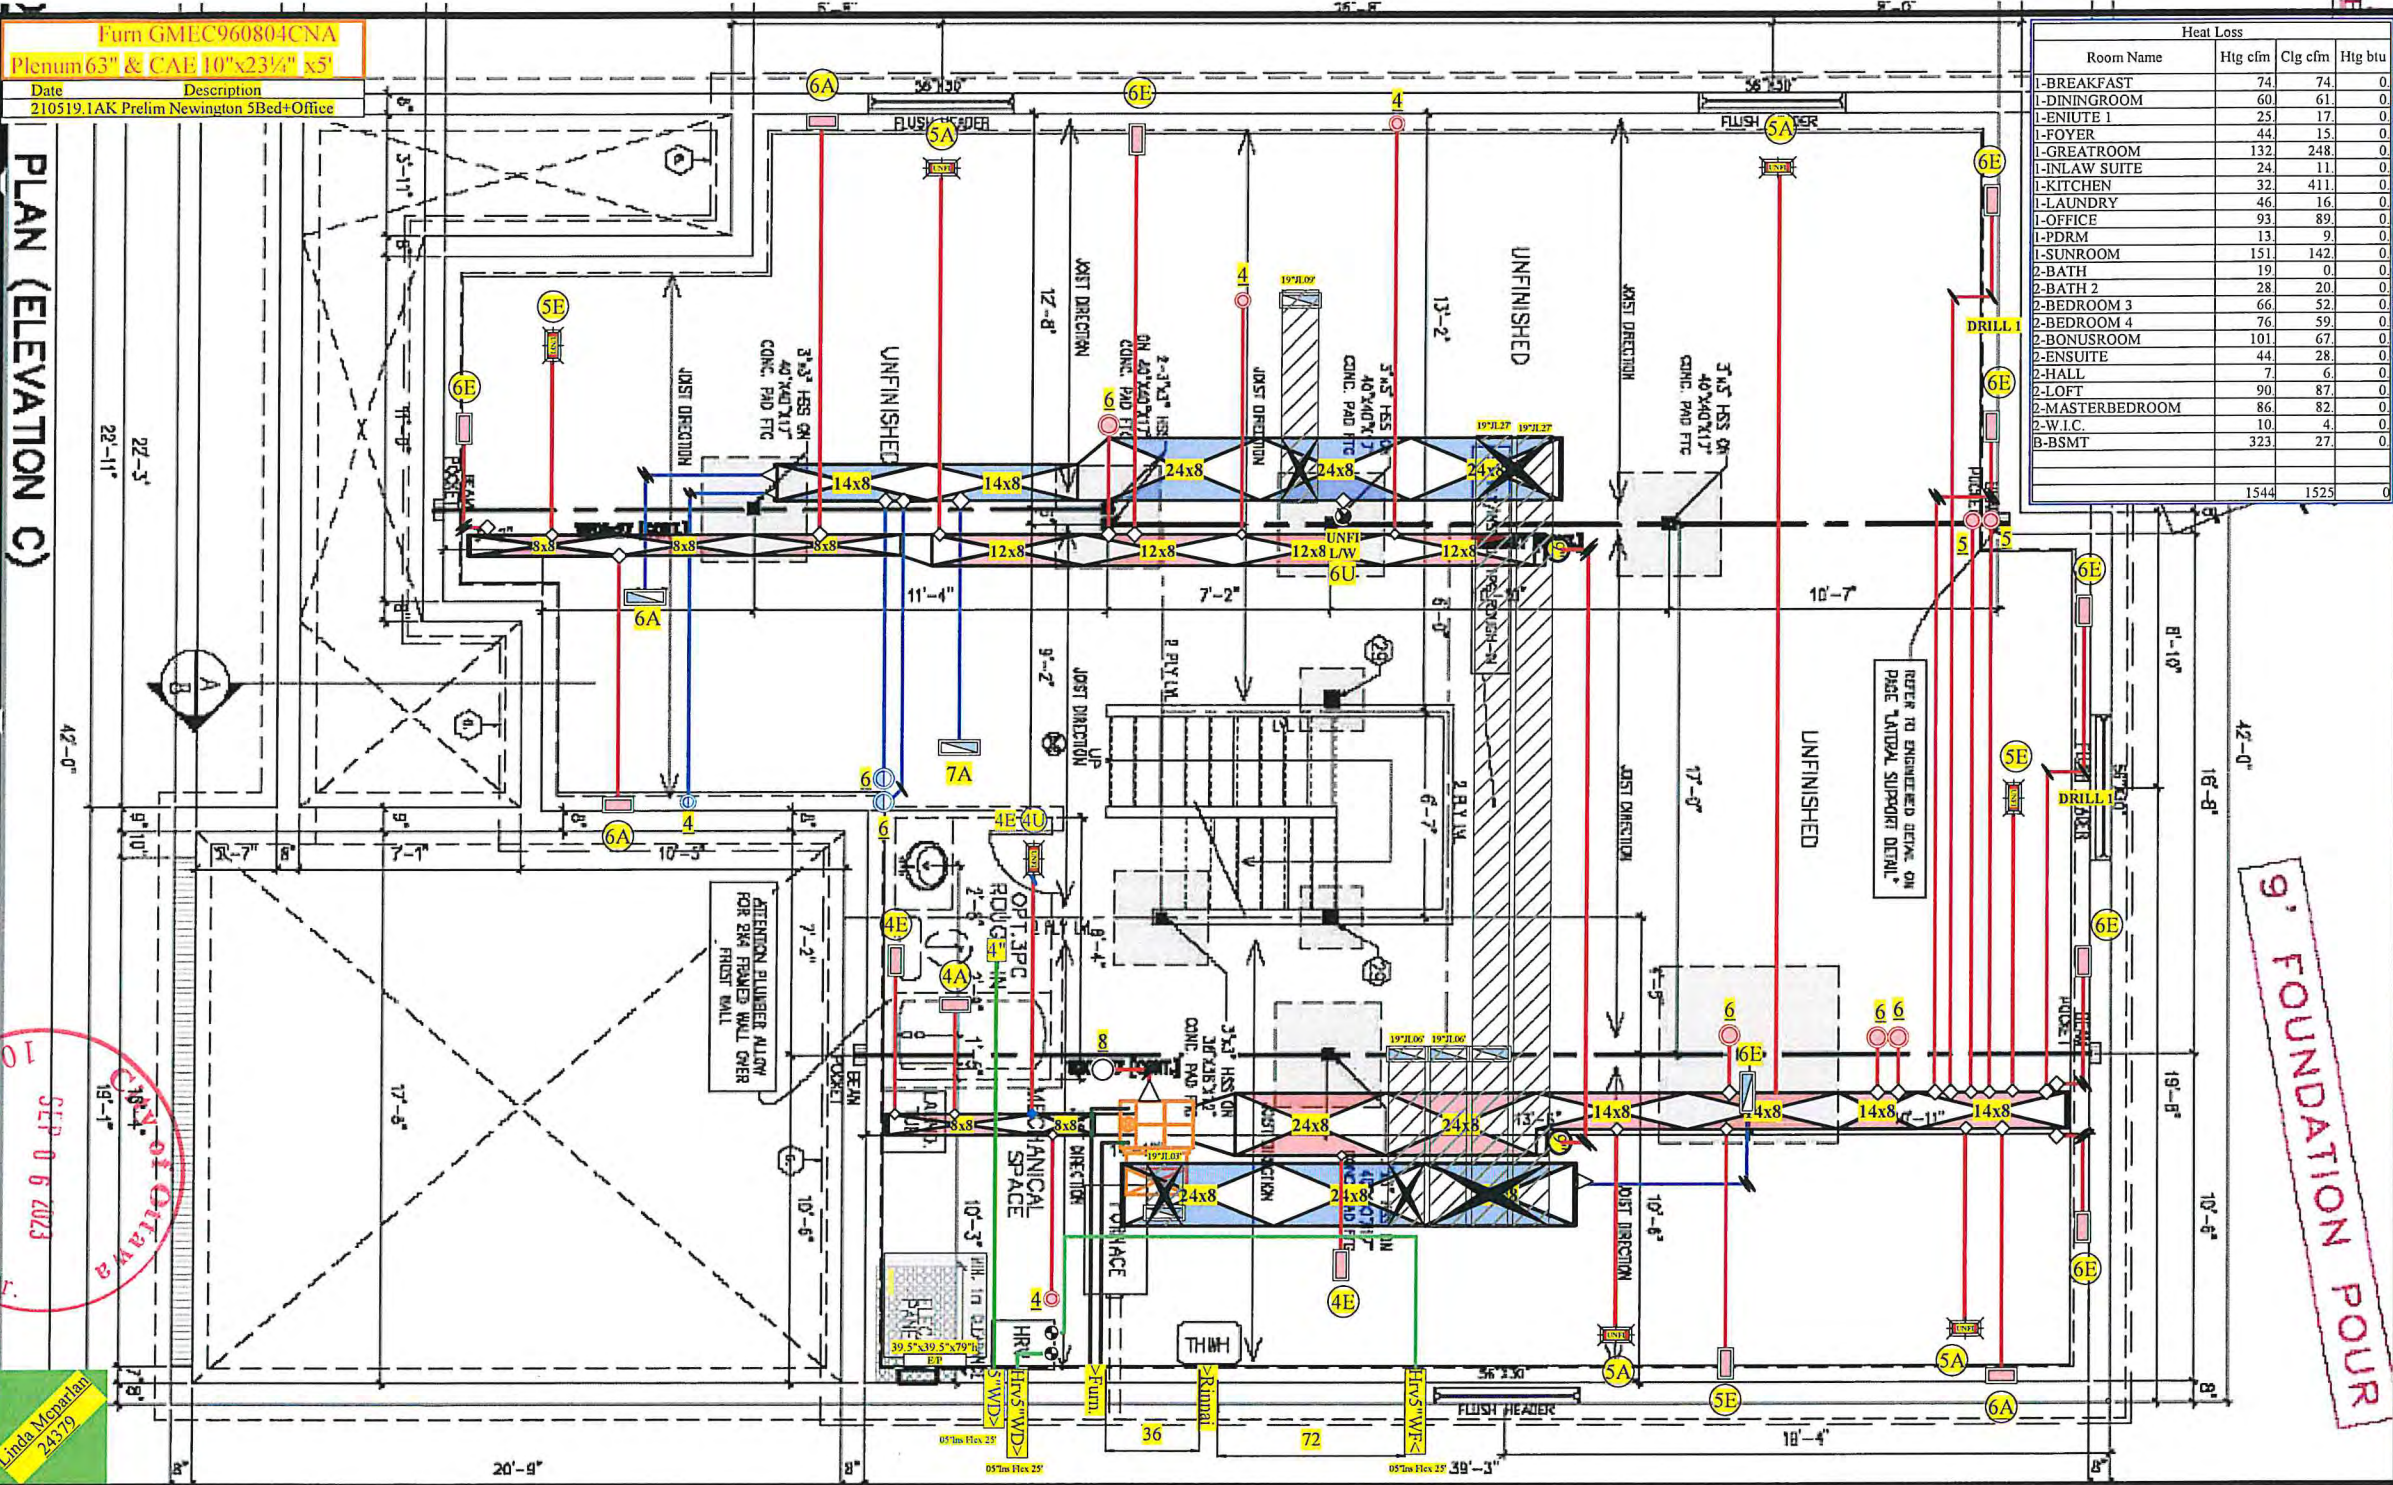

9' FOUNDATION POUR

Centrepointe  
 BCSB  
 18/05/21  
 518

Linda Mowbray  
 24570









Heat Loss			
Room Name	Htg cfm	Clg cfm	Htg btu
1-BREAKFAST	74	74	0
1-DININGROOM	60	61	0
1-ENIUTE 1	25	17	0
1-FOYER	44	15	0
1-GREATROOM	132	248	0
1-INLAW SUITE	24	11	0
1-KITCHEN	32	411	0
1-LAUNDRY	46	16	0
1-OFFICE	93	89	0
1-PDRM	13	9	0
1-SUNROOM	151	142	0
2-BATH	19	0	0
2-BATH 2	28	20	0
2-BEDROOM 3	66	52	0
2-BEDROOM 4	76	59	0
2-BONUSROOM	101	67	0
2-ENSUITE	44	28	0
2-HALL	7	6	0
2-LOFT	90	87	0
2-MASTERBEDROOM	86	82	0
2-W.I.C.	10	4	0
B-BSMT	323	27	0
	1544	1525	0

## 2ND FLOOR PLAN (ELEVATION C)

Date	Description
210519.1AK Prelim Newington 5Bed+Office	

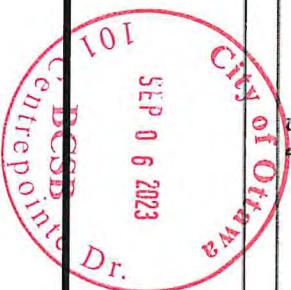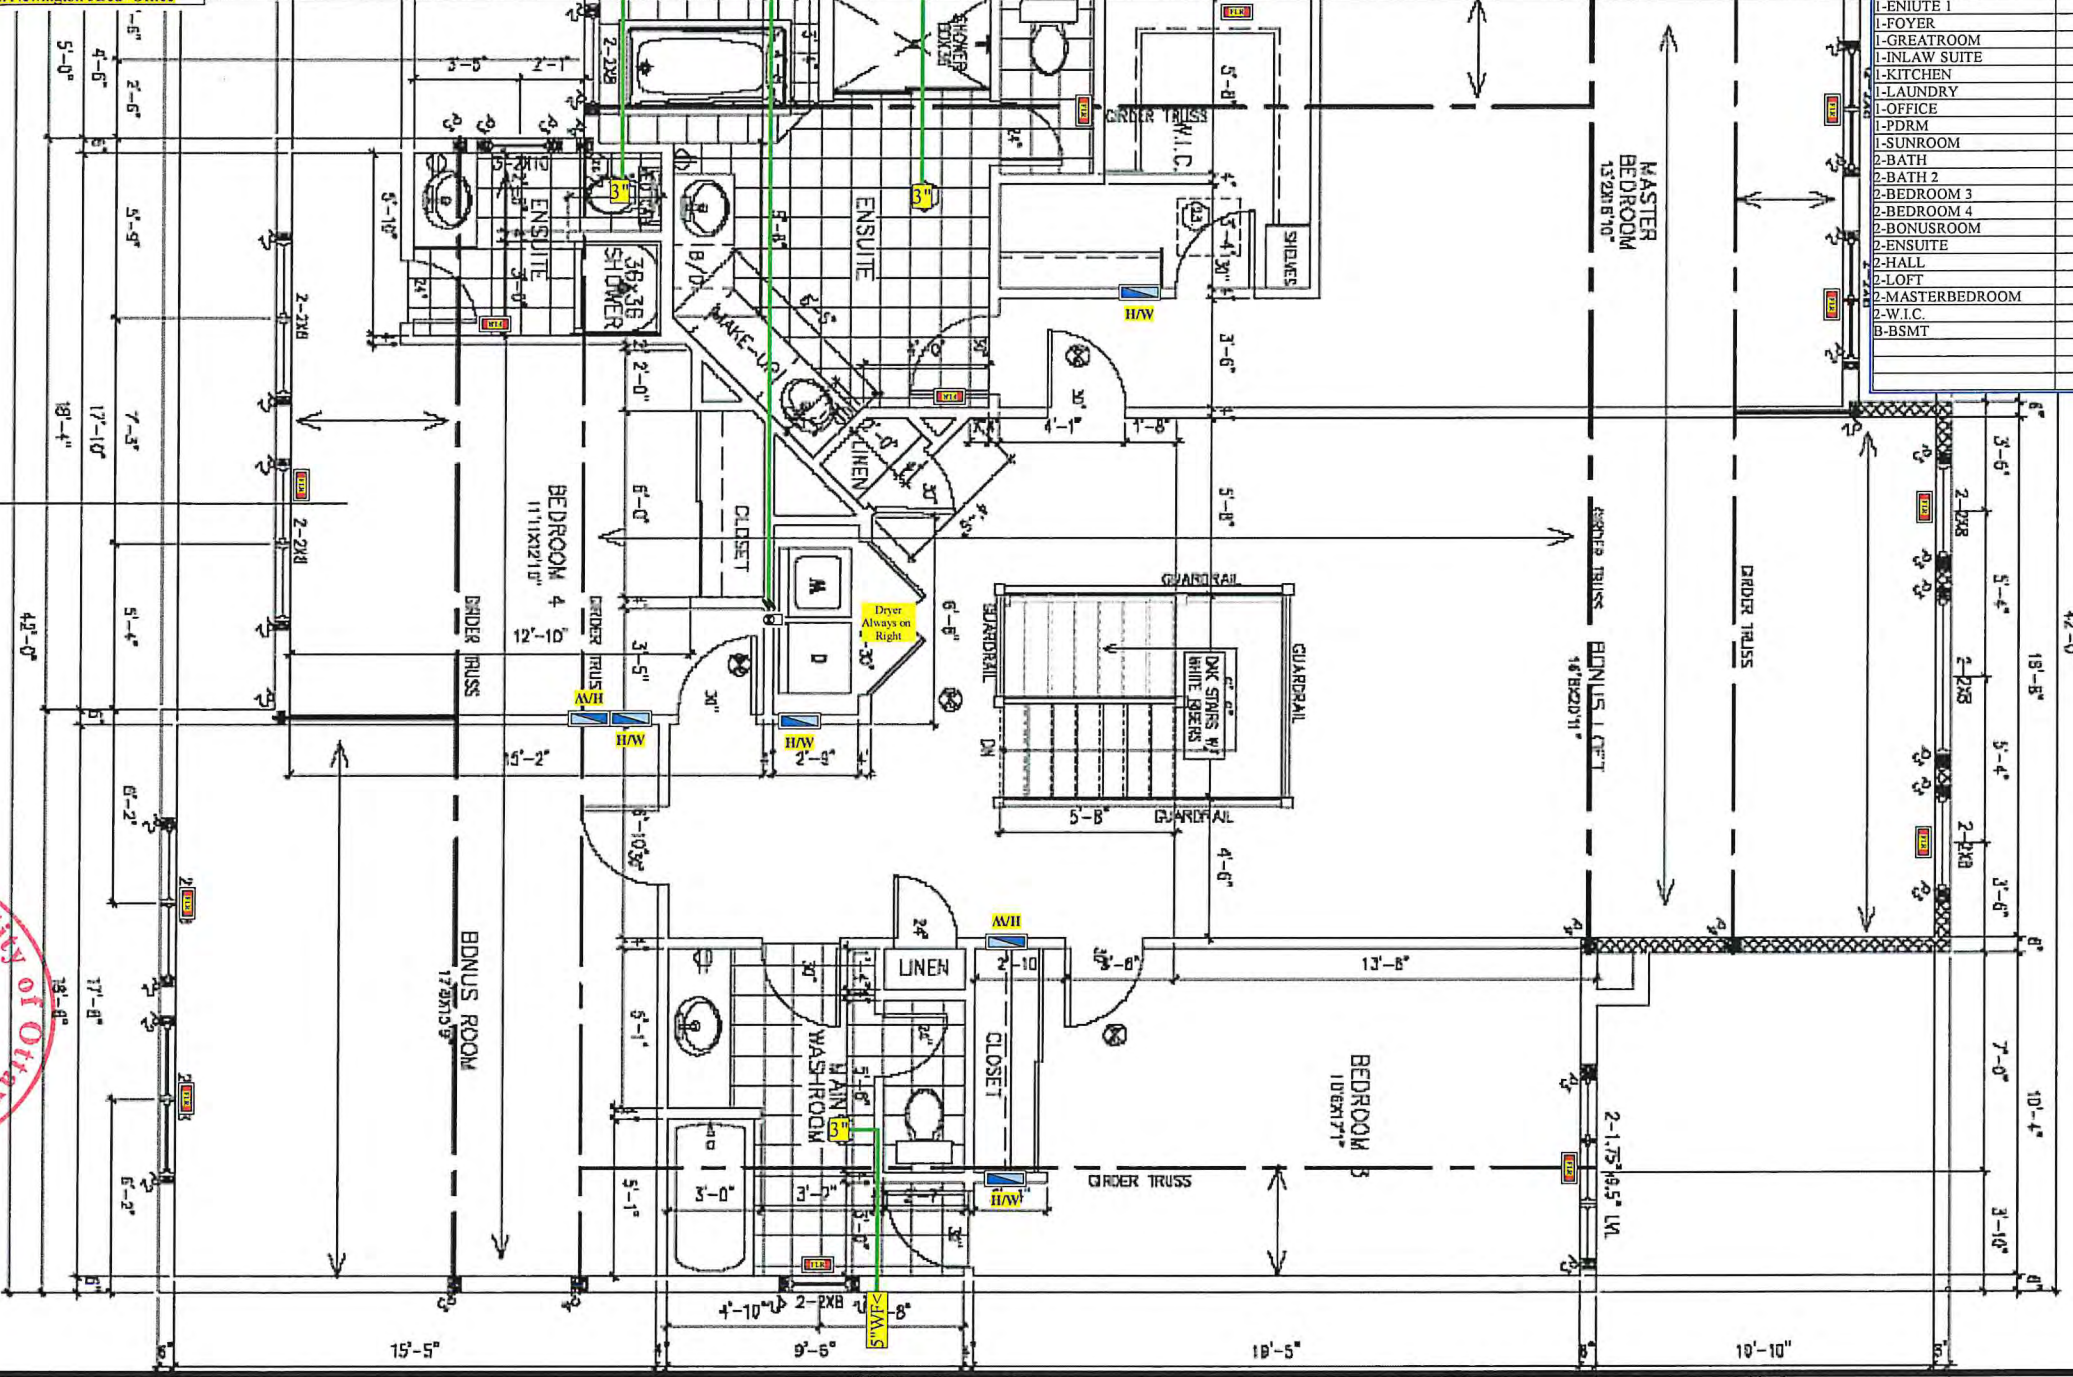

Linda Moravjan  
245790



CONSTRUCTION NOTES

ALL CONSTRUCTION TO ADHERE TO THESE PLANS AND SPEC'S AND TO CONFORM TO THE ONTARIO BUILDING CODE AND ALL OTHER APPLICABLE CODES AND AUTHORITIES HAVING JURISDICTION. THESE REQUIREMENTS ARE TO BE TAKEN AS MINIMUM SPECIFICATIONS. ONT. REG. 332/12

1. ROOF CONSTRUCTION  
NO.210 (10.25kg/m2) ASPHALT SHINGLES, 11.1mm (7/16") ASPENITE SHEATHING WITH "H" CLIPS. APPROVED WOOD TRUSSES @ 600mm (24") O.C. MAX. APPROVED EAVES PROTECTION TO EXTEND 900mm (3'-0") FROM EDGE OF ROOF AND MIN. 300mm (12") BEYOND INNER FACE OF EXTERIOR WALL. (EAVES PROTECTION NOT REQ'D. FOR ROOF R-12 OR GREATER). 38x89 (2"x4") TRUSS BRACING @ 1830mm (6'-0") O.C. AT BOTTOM CHORD. PREPIN. ALUM. ENASTROUGH, FASCLA PVL & VENTED SOFT. ATTIC VENTILATION 1:300 OF INSULATED CEILING AREA WITH 25% AT EAVES. AND 25% AT RIDGE (OBC 9.19.1.2)

2. FRAME WALL CONSTRUCTION (2"x6")  
SOUND AS PER ELEVATION, APPROVED AIR BARRIER 11.1mm (7/16") EXTERIOR TYPE SHEATHING, 38x140 (2"x6") STUDS @ 400mm (16") O.C., RSI 3.87 (R22) INSULATION AND APPROVED VAPOUR BARRIER AND APPROVED CONT. AIR BARRIER, 13mm (1/2") INT. DRYWALL FINISH. SIDING TO BE MIN. 200mm (8") ABOVE FIN. GRADE

2A. FRAME WALL CONSTRUCTION (2"x4" GARAGE WALL)  
SIDING AS PER ELEVATION, APPROVED AIR BARRIER, 38x89 (2"x4") STUDS @ 400mm (16") O.C., [FOR CLIENT UPGRADE ONLY - RSI 3.35 (R19) INSULATION AND APPROVED VAPOUR BARRIER, 13mm (1/2") INT. DRYWALL FINISH.] SIDING TO BE MIN. 200mm (8") ABOVE FIN. GRADE

3. BRICK VENEER CONSTRUCTION (2"x6")  
90mm (4") FACE BRICK 25mm (1") AIR SPACE  
22x180x76mm (7/8"x7"x0.03") CALV. METAL TIES @ 400mm (16") O.C. HORIZONTAL 600mm (24") O.C. VERTICAL. APPROVED AIR BARRIER 11.1mm (7/16") EXTERIOR TYPE SHEATHING, 38x140 (2"x6") STUDS @ 400mm (16") O.C., RSI 3.87 (R22) INSULATION AND APPROVED VAPOUR BARRIER WITH APPROVED CONTIN. AIR BARRIER, 13mm (1/2") INT. DRYWALL FINISH. PROVIDE WEEP HOLES @ 800mm (32") O.C. BOTTOM COURSE AND OVER OPENINGS. PROVIDE THRU-WALL FLASHING UP MIN. 150mm (6") BEHIND BUILDING PAPER. BRICK TO BE 150mm (6") ABOVE FINISH GRADE.

3A. BRICK VENEER CONSTRUCTION (2"x4" GARAGE WALL)  
90mm (4") FACE BRICK 25mm (1") AIR SPACE  
22x180x76mm (7/8"x7"x0.03") CALV. METAL TIES @ 400mm (16") O.C. HORIZONTAL 600mm (24") O.C. VERTICAL. APPROVED AIR BARRIER, 38x89 (2"x4") STUDS @ 400mm (16") O.C. [FOR CLIENT UPGRADE ONLY - RSI 3.35 (R19) INSULATION AND APPROVED VAPOUR BARRIER, 13mm (1/2") INT. DRYWALL FINISH.] PROVIDE WEEP HOLES @ 800mm (32") O.C. BOTTOM COURSE AND OVER OPENINGS. PROVIDE THRU-WALL FLASHING UP MIN. 150mm (6") BEHIND BUILDING PAPER. BRICK TO BE MIN. 150mm (6") ABOVE FINISH GRADE.

4. INTERIOR STUD PARTITIONS FOR BEARING PARTITIONS 38x89 (2"x4") @ 400mm (16") O.C. FOR 2 STOREYS AND 300mm (12") O.C. FOR 3 STOREYS; NON-BEARING PARTITIONS 38x89 (2"x4") @ 600mm (24") O.C. PROVIDE 38x89 (2"x4") BOTTOM PLATE AND 2/38x89 (2/2"x4") TOP PLATE. 13mm (1/2") INT. DRYWALL BOTH SIDES OF STUDS, PROVIDE 38x140 (2"x6") STUDS/PLATES WHERE NOTED.

5. FOUNDATION WALL/FOOTINGS: -SEE OBC 9.15.3.1, 9.15.4.2 200mm (8") POURED CONC. FTDN. WALL 20MPa (C/W 2-15M REBAR TOP & BOTTOM) WITH BITUMINOUS DAMPROOFING AND OPT. DRAINAGE LAYER REQ'D. WHEN BASEMENT INSUL. EXTENDS 900 (2'-11") BELOW FIN. GRADE. MAXIMUM POUR HEIGHT 2300 (7'-10") ON 500x155 (20"x6") CONTINUOUS KEYED CONC. FTG. BRACE FTDN. WALL PRIOR TO BACKFILLING. ALL FOOTINGS SHALL REST ON NATURAL UNDISTURBED SOIL OR COMPACTED ENGINEERED FILL WITH MIN. BEARING CAPACITY OF 100KPa OR GREATER. IF SOIL BEARING DOES NOT MEET MIN. CAPACITY, ENGINEERED FOOTINGS ARE REQUIRED. MAX. LENGTH OF LINE LOAD OF 2.4kPa(50psi) PER FLOOR, AND MAX. LENGTH OF SUPPORTED JOISTS IS 4.9m (16'-1"). REFER TO SOILS REPORT FOR SOILS CONDITIONS AND BEARING CAPACITY.

6. 100mm (4") DIA. WEEP TILE 150mm (6") CRUSHED STONE OVER AND AROUND WEEPING TILES.

7. BASEMENT SLAB OBC 9.3.1.6(1)(b) & 9.16.4.5(1) 80mm (C/W MIN. 25MPa (3500psi) CONC. SLAB ON 100mm (4") COARSE GRANULAR FILL, OR 15MPa. (2200psi) CONC. WITH DAMPROOFING BELOW SLAB.

8. EXPOSED FLOOR TO EXTERIOR PROVIDE RSI 5.46 (R31) INSULATION, APPROVED VAPOUR BARRIER AND CONTINUOUS AIR BARRIER, FINISHED SOFFIT.

9. OBC 12.3.2.1 & 12.3.3.7 ATTIC INSULATION RSI 8.81 (R60) BLOWN IN ROOF INSULATION AND APPROVED VAPOUR BARRIER, 13mm (1/2") INT. DRYWALL FINISH OR APPROVED EQUAL.

10. STAIRS, STEPS, HANDRAILS -OBC 9.8.2--9.8.2.1(2) STAIR WIDTH MEASURED BETWEEN WALL FACES OR GUARDS SHALL BE NOT LESS THAN 800mm (33") FOR REQUIRED EXIT STAIRS SERVING A HOUSE OR DWELLING UNIT. -9.8.2.2(3) CLEAR HEIGHT OVER STAIRS SHALL NOT BE LESS THAN 1950mm (76') -9.8.4 STEP DIMENSIONS (TABLE 9.8.4.1)

11. GUARDS -OBC 9.8.8.3--(1) EXT. GUARDS HEIGHT: =1070mm (42') MIN. (2) INT. GUARDS HEIGHT: =900mm (35') MIN. (3) STAIR LANDING GUARDS: =1070mm (42') MIN. -9.8.8.5(1) MAX. OPENINGS THROUGH GUARDS =100mm (3 1/8")

12. 38x89 (2"x4") SILL PLATE WITH 13mm (1/2") DIA. ANCHOR BOLTS 200mm (8") LONG, EMBEDDED MIN. 100mm (4") INTO CONC. @ 2400mm (7'-10") O.C. USE NON-SHRINK GROUT TO LEVEL SILL PLATE WHEN REQUIRED. (SEE OBC 9.23.7)

13. -R12 (3") CONTINUOUS BATT INSULATION, 2"x4" STUD WALL PLACED 3" AWAY FROM WALL FILL STUD CAVITY WITH R10 BATT INSULATION, APPROVED VB TO 8" ABOVE FLOOR LEVEL. OR -APPROVED BLANKET INSULATION (R20) MECHANICALLY SECURED TO CONCRETE FOUNDATION WALL WITH 100mm HILTI PINS (COMES WITH PLASTIC WASHER) DAMPROOF WITH BUILDING PAPER BETWEEN THE FOUNDATION WALL AND INSULATION UP TO GRADE LEVEL. (SEE DETAIL ON "5B-12 DETAILS" PAGE)
- 
- PHOENIX HOMES
- CIVIC ADDRESS:  
200 SILVER DART PRIVATE
- 95
- NEWINGTON R - 2022
- SITE: DIAMONDVIEW PHASE 3
- LOT NUMBER:
- SITE: DIAMONDVIEW PHASE 3
- COPY
- ISSUED FOR ENGINEERING City of Ottawa 01/09/23 CB
- BEP BLACKLINES 17/08/23 CB
- KITCHEN LIGHT UPDATE 28/10/22 SP
- FOR LAYOUTS AND STRUCTURE REVIEW 11/05/22 SP
- No. Description REVISIONS
- footprint: 50-22-7
- drawn by: SP
- date: JUN 12/16
- scale: 3/16"=1'-0"
- D.C. - A-11
- Sheet no: 1
- 1R of 9
- CONTRACTOR MUST VERIFY ALL DIMENSIONS ON THE JOB AND REPORT ANY DISCREPANCY TO THE BUILDER BEFORE PROCEEDING WITH THE WORK. DO NOT SCALE DRAWINGS. USE DIMENSIONS PROVIDED. ALL DRAWINGS TO BE USED FOR CONSTRUCTION ONLY AFTER BUILDING PERMIT HAS BEEN ISSUED.
- SITE
38. CONVENTIONAL ROOF FRAMING 38x140 (2"x6") RAFTERS @ 400mm (16"O.C.), FOR MAX. 11'-7" SPAN. 38x184 (2"x8") RIDGE BOARD. 38x89 (2"x4") COLLAR TIES AT MIDSPANS. CEILING JOISTS TO BE 38x89 (2"x4") @ 400mm (16") O.C. FOR MAX. 2350mm (9'-5") SPAN & 38x140 (2"x6") @ 400mm (16") O.C. THE STRIP FOOTING SIZE IS AS FOLLOWS:  
2 STOREY (STANDARD) 500x155 (20"x6")  
2 STOREY (WALK-OUT BASEMENT) 545x175 (22"x7")  
(UNLESS OTHERWISE NOTED ON PLAN)

41. STRIP FOOTING SUPPORTING EXTERIOR WALLS -SEE OBC 9.15.3.  
-ASSUMING MASONRY VENEER CONSTRUCTION, MAX. FLOOR LIVE LOAD OF 2.4kPa (50psi) PER FLOOR, AND MAX. LENGTH OF SUPPORTED FLOOR JOISTS IS 4.9m (16'-1").  
THE STRIP FOOTING SIZE IS AS FOLLOWS:  
2 STOREY (STANDARD) 500x155 (20"x6")  
2 STOREY (WALK-OUT BASEMENT) 545x175 (22"x7")  
(UNLESS OTHERWISE NOTED ON PLAN)

42. EXTERIOR WALLS FOR WALK-OUT CONDITIONS THE EXTERIOR BASEMENT STUD WALL TO BE 38x140 (2"x6") STUDS @ 16" o.c. OR 38x89 (2"x4") STUDS @ 12" o.c.

43. FLASHING FOR EXT. WALL OPENINGS (O.B.C.9.27.3.8(3))

44. SUMP PITS (WHERE REQ'D) SEE O.B.C. 9.14.5.2 -MUST BE SEALED AS PER 9.25.3.3(16)
39. TWO STOREY VOLUME SPACES  
FOR HIGH WALL UP TO 18'-0": CONSTRUCTION: 2"x6" SHEATHING AS INDICATED BLOCKING; 3 ROWS @ 4'-6" O/C & SHEATHING; 7/16" ASPENITE NAILING; 2" STAPLES BET. 4" AND 6" O/C ALONG STUDS  
C/W R22 100x140

40. TYPICAL 1 HOUR RATED PARTYWALL. REFER TO DETAILS FOR TYPE AND SPECIFICATIONS.
42. STUD SPACING WITH VARIOUS FINISHES:  
1. SIDING-METAL OR VINYL- 2"x6" @ 12" O/C  
2. STUCCO -2"x6" @ 16" O/C  
3. BRICK TO 4'-0" -2"x6" @ 16" O/C  
4. BRICK FULL HEIGHT -2"x6" @ 12" O/C
- WINDOWS:
1. MINIMUM BEDROOM WINDOW -OBC 9.9.10. AT LEAST ONE BEDROOM WINDOW ON A GIVEN FLOOR IS TO HAVE MIN. 0.35m<sup>2</sup> UNOBSTRUCTED GLAZED OR OPENABLE AREA WITH MIN. CLEAR WIDTH OF 380 mm (1'-3"). WINDOW GLAZING -OBC 9.8.8.1. A GUARD IS REQUIRED WHERE THE TOP OF THE WINDOW SILL IS LOCATED LESS THAN 800mm (1'-7") ABOVE FIN. FLOOR AND THE DISTANCE FROM THE FIN. FLOOR TO THE ADJACENT GRADE IS GREATER THAN 1800mm (5'-11")

3. ALL WINDOWS TO COMPLY WITH THERMAL RESISTANCE REQUIREMENTS STATED IN OBC 12.3.2.6. AND S612 PRESCRIPTIVE COMPLIANCE PACKAGE, AND OBC 9.5, 9.6, 9.7
- GENERAL
1. MECHANICAL VENTILATION IS REQUIRED TO PROVIDE 0.3 AIR CHANGES PER HOUR AVERAGED OVER 24 HOURS. SEE MECHANICAL DRAWINGS.

2. ALL DOWNSPOUTS TO DRAIN AWAY FROM THE BUILDINGS PER OBC 9.26.18.2 AND MUN. STANDARDS.

3. ALL WINDOW WALLS TO DRAIN TO FOOTING LEVEL PER OBC 9.14.6.3 CHECK WITH LOCAL AUTHORITY.

4. PROVIDE STUD WALL REINFORCEMENT FOR FUTURE GRAB BARS IN BATHROOMS. REIN. OF STUD WALLS SHALL BE INSTALLED ADJACENT TO WATER CLOSETS AND SHOWER OR BATHTUB IN MAIN BATHROOM, SEE OBC 9.5.2.3.
- LUMBER
1. ALL LUMBER SHALL BE SPRUCE NO.2 GRADE, UNLESS NOTED OTHERWISE.

2. STUDS SHALL BE STUD GRADE SPRUCE, UNLESS NOTED OTHERWISE.

3. LUMBER EXPOSED TO THE EXTERIOR TO BE SPRUCE NO.2 GRADE PRESSURE TREATED OR CEDAR, UNLESS NOTED OTHERWISE.

4. ALL LAMINATED VENEER LUMBER (L.V.L.) BEAMS, GIRDER TRUSSES, AND METAL HANGER CONNECTIONS SUPPORTING ROOF FRAMING TO BE DESIGNED & CERTIFIED BY TRUSS MANUF.

5. LVL BEAMS SHALL BE 2.0E WS MICRO-LAM LVL (F<sub>b</sub>=2800psi MIN.) OR EQUIVALENT. NAIL EACH PLY OF LVL WITH 89mm (3 1/2") LONG COMMON WIRE NAILS @ 300mm (12") O.C. STAGGERED IN 2 ROWS FOR 184, 240 & 300mm (7 1/4", 9 1/2", 11 7/8") DEPTHS AND STAGGERED IN 3 ROWS FOR GREATER DEPTHS AND FOR 4 PLY MEMBERS ADD 13mm (1/2") DIA. GALVANIZED BOLTS BOLTED AT MID-DEPTH OF BEAM @ 915mm (3'-0") O.C.

6. PROVIDE TOP MOUNT BEAM HANGERS TYPE "SCL" MANUFACTURED BY MGA CONNECTOR LTD. Tel. (905) 642-3175 OR EQUIVALENT FOR ALL LVL BEAM TO BEAM CONNECTIONS UNLESS OTHERWISE NOTED.

7. BUILT-UP WOOD MEMBERS: PROVIDE METAL HANGERS FOR ALL JOISTS AND BUILT-UP WOOD MEMBERS INTERSECTING FLUSH.

8. WOOD FRAMING NOT TREATED WITH A WOOD PRESERVATIVE, IN CONTACT WITH CONCRETE, SHALL BE SEPARATED FROM THE CONCRETE BY AT LEAST 2 mil. POLYETHYLENE FILM, No. 50 (45lbs) ROLL ROOFING OR OTHER DAMPROOFING MATERIAL, EXCEPT WHERE THE WOOD MEMBER IS AT LEAST 150mm (6") ABOVE THE GROUND.
- STEEL
1. STRUCTURAL STEEL SHALL CONFORM TO CAN/CSA-G40-21 GRADE 300W. HOLLOW STRUCTURAL SECTIONS SHALL CONFORM TO CAN/CSA-G40-21 GRADE 350W CLASS "H".

2. REINFORCING STEEL SHALL CONFORM TO CSA-G30-18M GRADE 40R.
- WOOD, LINTELS AND BUILT-UP WOOD BEAMS
- L1 2/38 x 184 (2/2" x 8") SPR #2

L2 3/38 x 184 (3/2" x 8") SPR #2

L3 4/38 x 184 (4/2" x 8") SPR #2

L4 2/38 x 235 (2/2" x 10") SPR #2

L5 3/38 x 235 (3/2" x 10") SPR #2

L6 4/38 x 235 (4/2" x 10") SPR #2

L7 90 x 90 x 6.0L (3-1/2" x 3-1/2" x 1/4")

L8 90 x 90 x 8.0L (3-1/2" x 3-1/2" x 5/16")

L9 100 x 90 x 8.0L (4" x 3-1/2" x 5/16")

L10 125 x 90 x 8.0L (5" x 3-1/2" x 5/16")

L11 125 x 90 x 10.0L (5" x 3-1/2" x 3/8")

L12 150 x 100 x 10.0L (6" x 4" x 3/8")
- STEEL COLUMNS (UNLESS NOTED OTHERWISE)
- TP = (1) 3" DIA. ADL. ST. POST

TIP = (2) 3" DIA. ADL. ST. POSTS

HSS = 3.5"x3.5" HOLLOW STRUCTURAL SECTION STEEL POST
- LAMINATED VENEER LUMBER (LVL) BEAMS
- LVL1 2-1 3/4"x7 1/4" (2-45x184)

LVL2 3-1 3/4"x7 1/4" (3-45x184)

LVL3 4-1 3/4"x7 1/4" (4-45x184)

LVL4 2-1 3/4"x8 1/2" (2-45x240)

LVL5 3-1 3/4"x8 1/2" (3-45x240)

LVL6 2-1 3/4"x11 7/8" (2-45x300)

LVL7 3-1 3/4"x11 7/8" (3-45x300)
- | MASONRY VENEER LUNTEL SCHEDULE [OBC2012] | LUNTEL SIZE            |
|--|------------------------|
| PROVIDE 6" MINIMUM BEARING EACH END      | 9, 20, 5, 2B           |
| OPENINGS                                 |                        |
| UP TO 8'-0"                              | 3 1/2" x 3 1/2" x 1/4" |
| 8'-0" TO 8'-8"                           | 4" x 3 1/2" x 1/4"     |
| 8'-8" TO 10'-10"                         | 5" x 3 1/2" x 5/16"    |
| 10'-10" TO 11'-5"                        | 5" x 3 1/2" x 7/16"    |
| 11'-5" TO 11'-9"                         | 5" x 3 1/2" x 1/2"     |
| 11'-9" TO 12'-6"                         | 6" x 3 1/2" x 7/16"    |
| 12'-6" TO 13'-4"                         | 6" x 3 1/2" x 1/2"     |
- LEGEND
- M.C. MEDICINE CABINET

DOUBLE VOLUME WALL SEE NOTE 39

SOLID WOOD BEARING

P2 - 2 MEMBER BUILT-UP STUD

P3 - 3 MEMBER BUILT-UP STUD

P4 - 4 MEMBER BUILT-UP STUD

P5 - 5 MEMBER BUILT-UP STUD

NOTE: SOLID BEARING TO BE AS WIDE AS SUPPORTED MEMBER. SOLID BEARING TO BE A MINIMUM OF P2 (ONE CONTINUOUS STUD AND ONE JACK STUD, UNLESS OTHERWISE NOTED ON PLAN)

EXHAUST VENT

DUPLEX OUTLET (12" HIGH)

WEATHERPROOF DUPLEX OUTLET

HEAVY DUTY OUTLET

POT LIGHT

LIGHT FIXTURE (CEILING MOUNTED)

LIGHT FIXTURE (WALL MOUNTED)

SWITCH

SWITCH (3-WAY)

FLOOR DRAIN

HOSE BB

DOUBLE JOIST

LAMINATED VENEER LUMBER

POINT LOAD FROM ABOVE

P.T. PRESSURE TREATED LUMBER

G.T. GIRDER TRUSS BY ROOF TRUSS MANUF.

FLAT ARCH


CURVED ARCH

SHOKE ALARM (AUDIBLE/VISUAL)-OBC 9.10.19. PROVIDE 1 PER FLOOR, NEAR THE STAIRS CONNECTING THE FLOOR LEVEL ONE PER SLEEPING ROOM, INCLUDING HALLWAYS BE CONNECTED TO AN ELECTRICAL CIRCUIT AND INTERCONNECTED TO ACTIVATE ALL ALARMS WHEN ONE ALARM SOUNDS. -9.10.19.1(2) REQUIRED SMOKE ALARMS TO HAVE A VISUAL COMPONENT


CARBON MONOXIDE ALARM (OBC 9.33.4) WHERE A FUEL-BURNING APPLIANCE IS INSTALLED IN A DWELLING UNIT, A CARBON MONOXIDE ALARM CONFORMING TO CAN/CSA-6.19, CSA 6.19 OR UL2034 SHALL BE INSTALLED ADJACENT TO EACH SLEEPING AREA. CARBON MONOXIDE ALARM(S) SHALL BE PERMANENTLY WIRED SO THAT ITS ACTIVATION WILL ACTIVATE ALL CARBON MONOXIDE ALARMS AND BE EQUIPPED WITH AN ALARM THAT IS AUDIBLE WITHIN BEDROOMS WHEN THE INTERVENING DOORS ARE CLOSED.

SOIL GAS CONTROL (OBC 9.13.1.1 & 9.13.4.4 & S68) PROVIDE CONSTRUCTION TO PREVENT LEAKAGE OF SOIL GAS INTO THE BUILDING WHERE REQUIRED. (SEE ALSO O.B.C. 9.1.1.7(1))



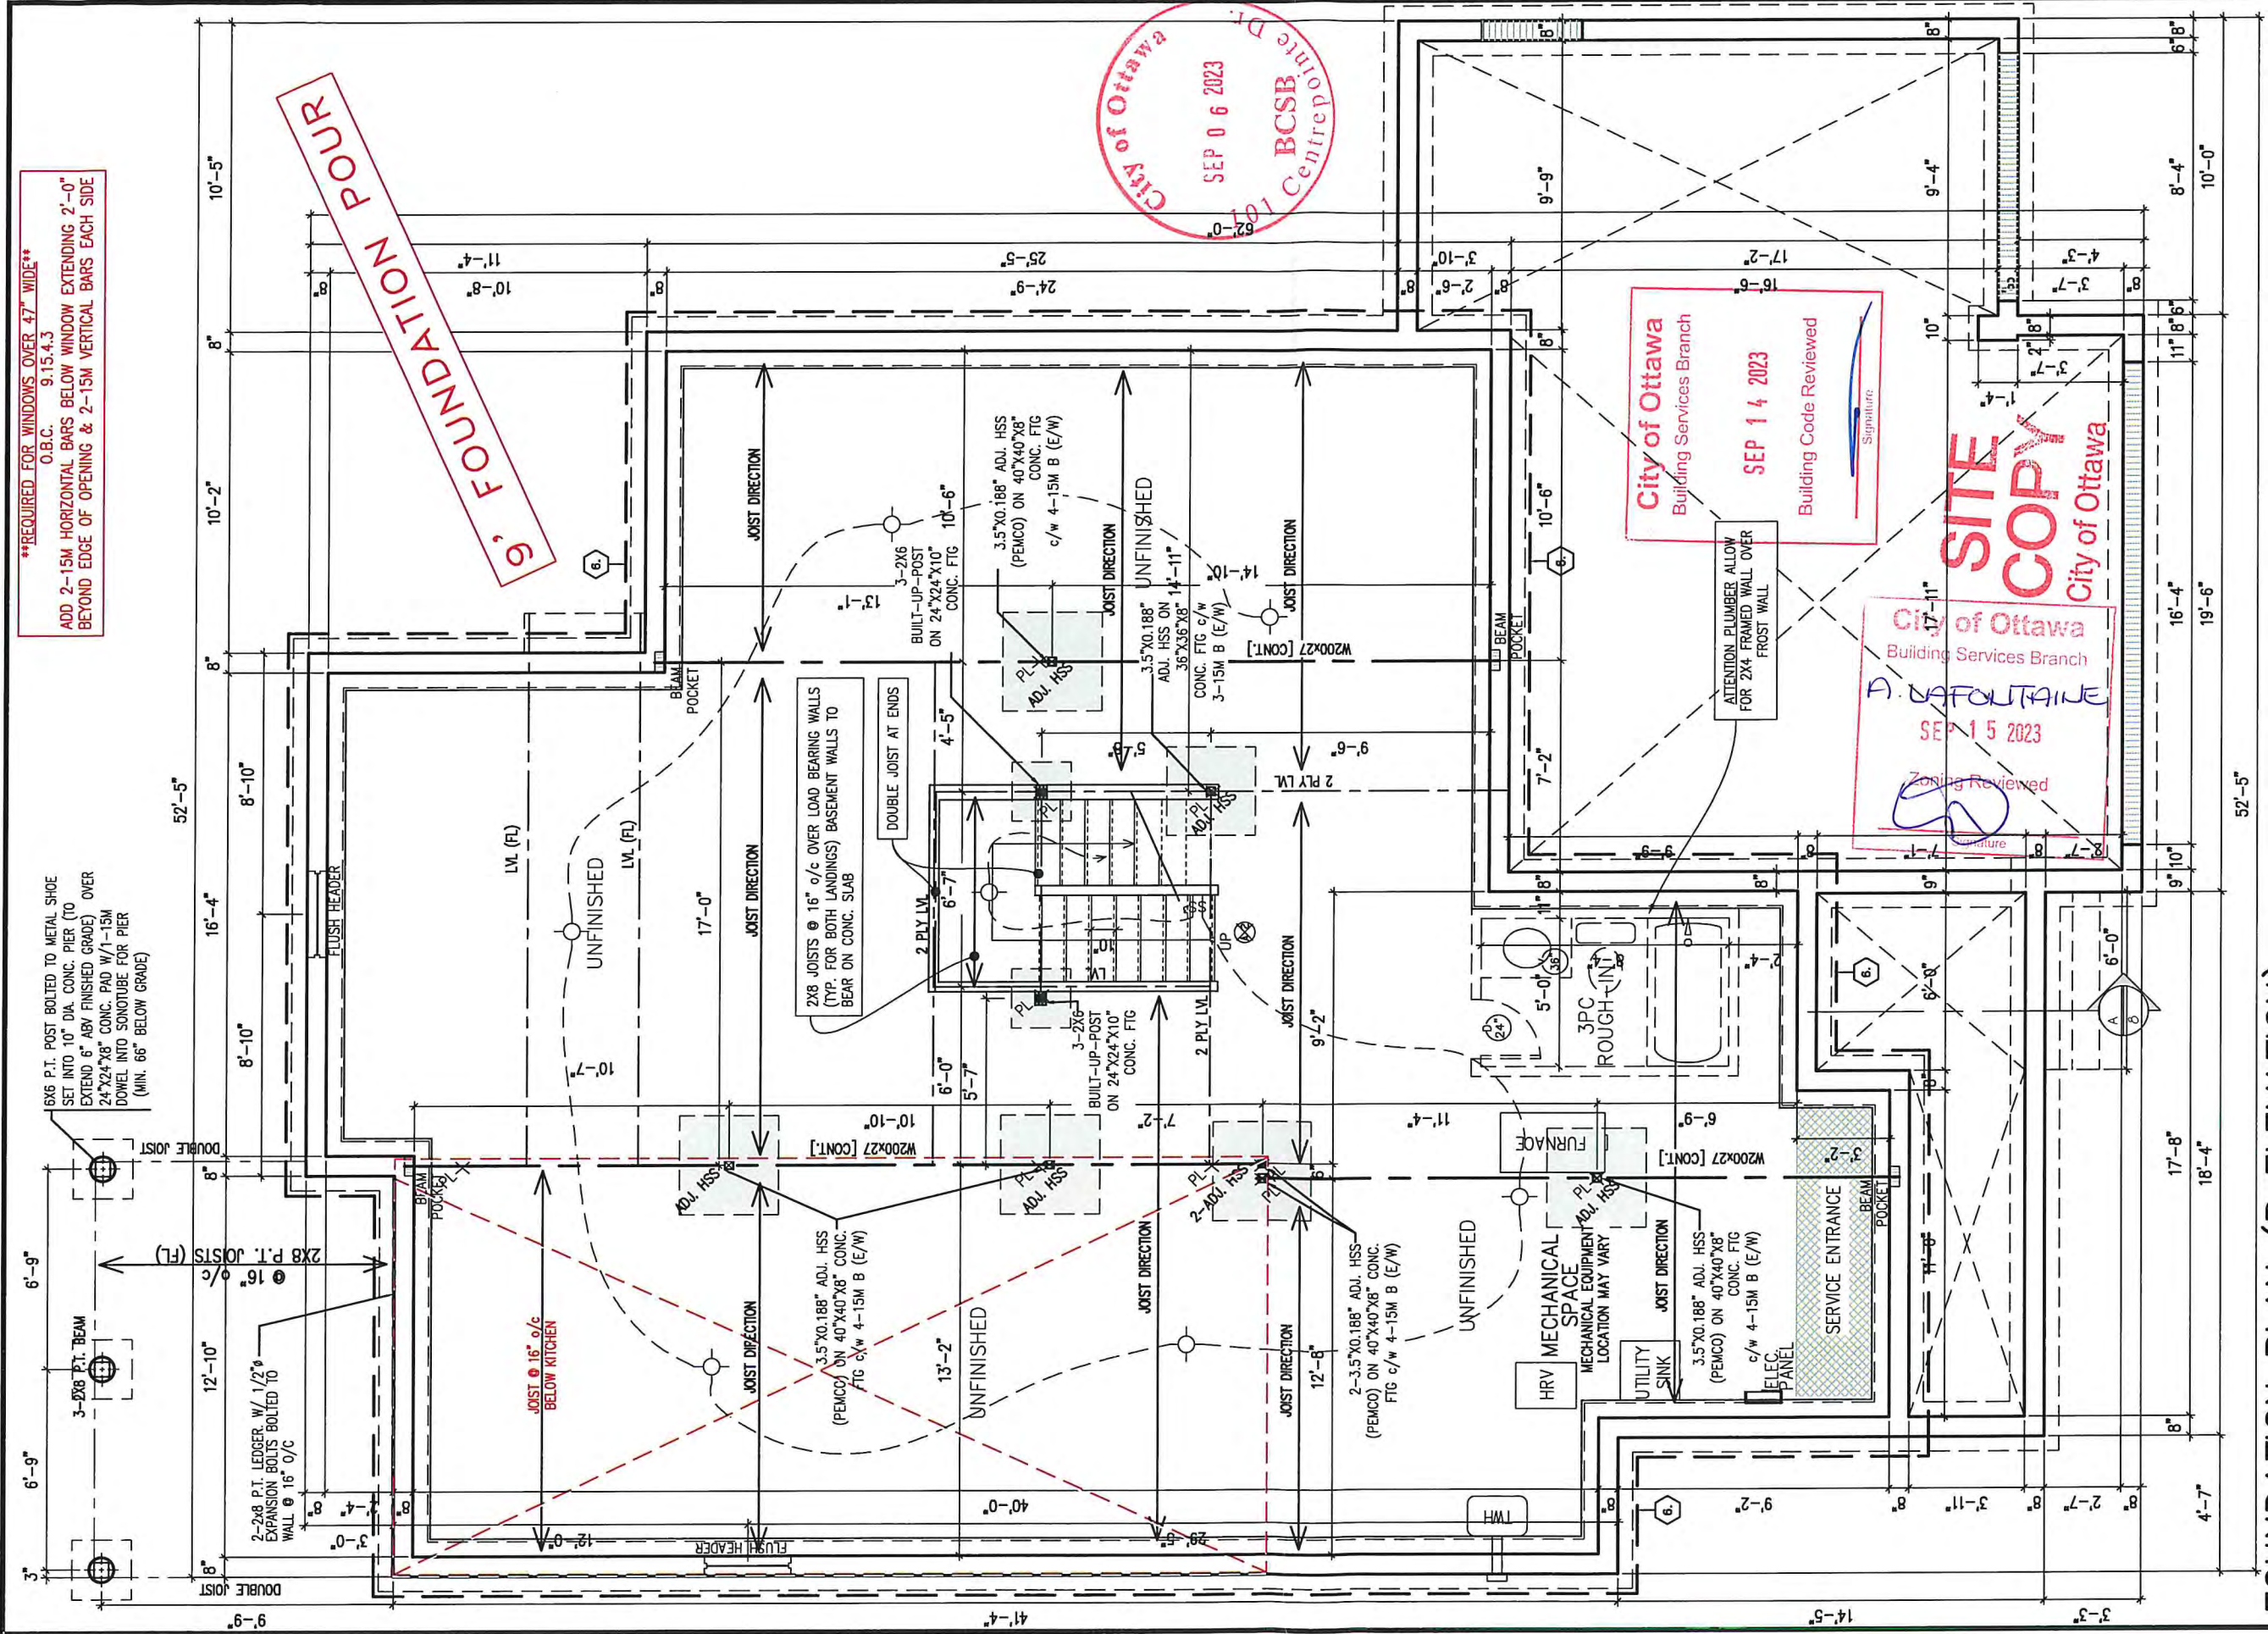

FOUNDATION PLAN (R ELEVATION)

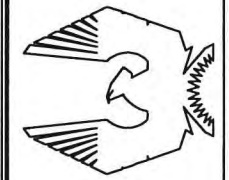

PHOENIX HOMES

NEWINGTON R - 2022

SITE: DIAMONDVIEW PHASE 3

LOT NUMBER:


CIVIC ADDRESS:  
200 SILVER DART PRIVATE

95

No.	Description	REVISIONS
4	ISSUED FOR ENGINEERING	01/09/23 CB
3	BEP BLACKLINES	17/08/23 CB
2	KITCHEN LIGHT UPDATE	20/10/22 SP
1	FOR LAYOUTS AND STRUCTURE REVIEW	11/03/22 SP

footprint:	50-22-7
drawn by:	SP
date:	JUN 12/16
scale:	3/16"=1'-0"
D.C.L. -	A-11
sheet no:	2
2R of	9



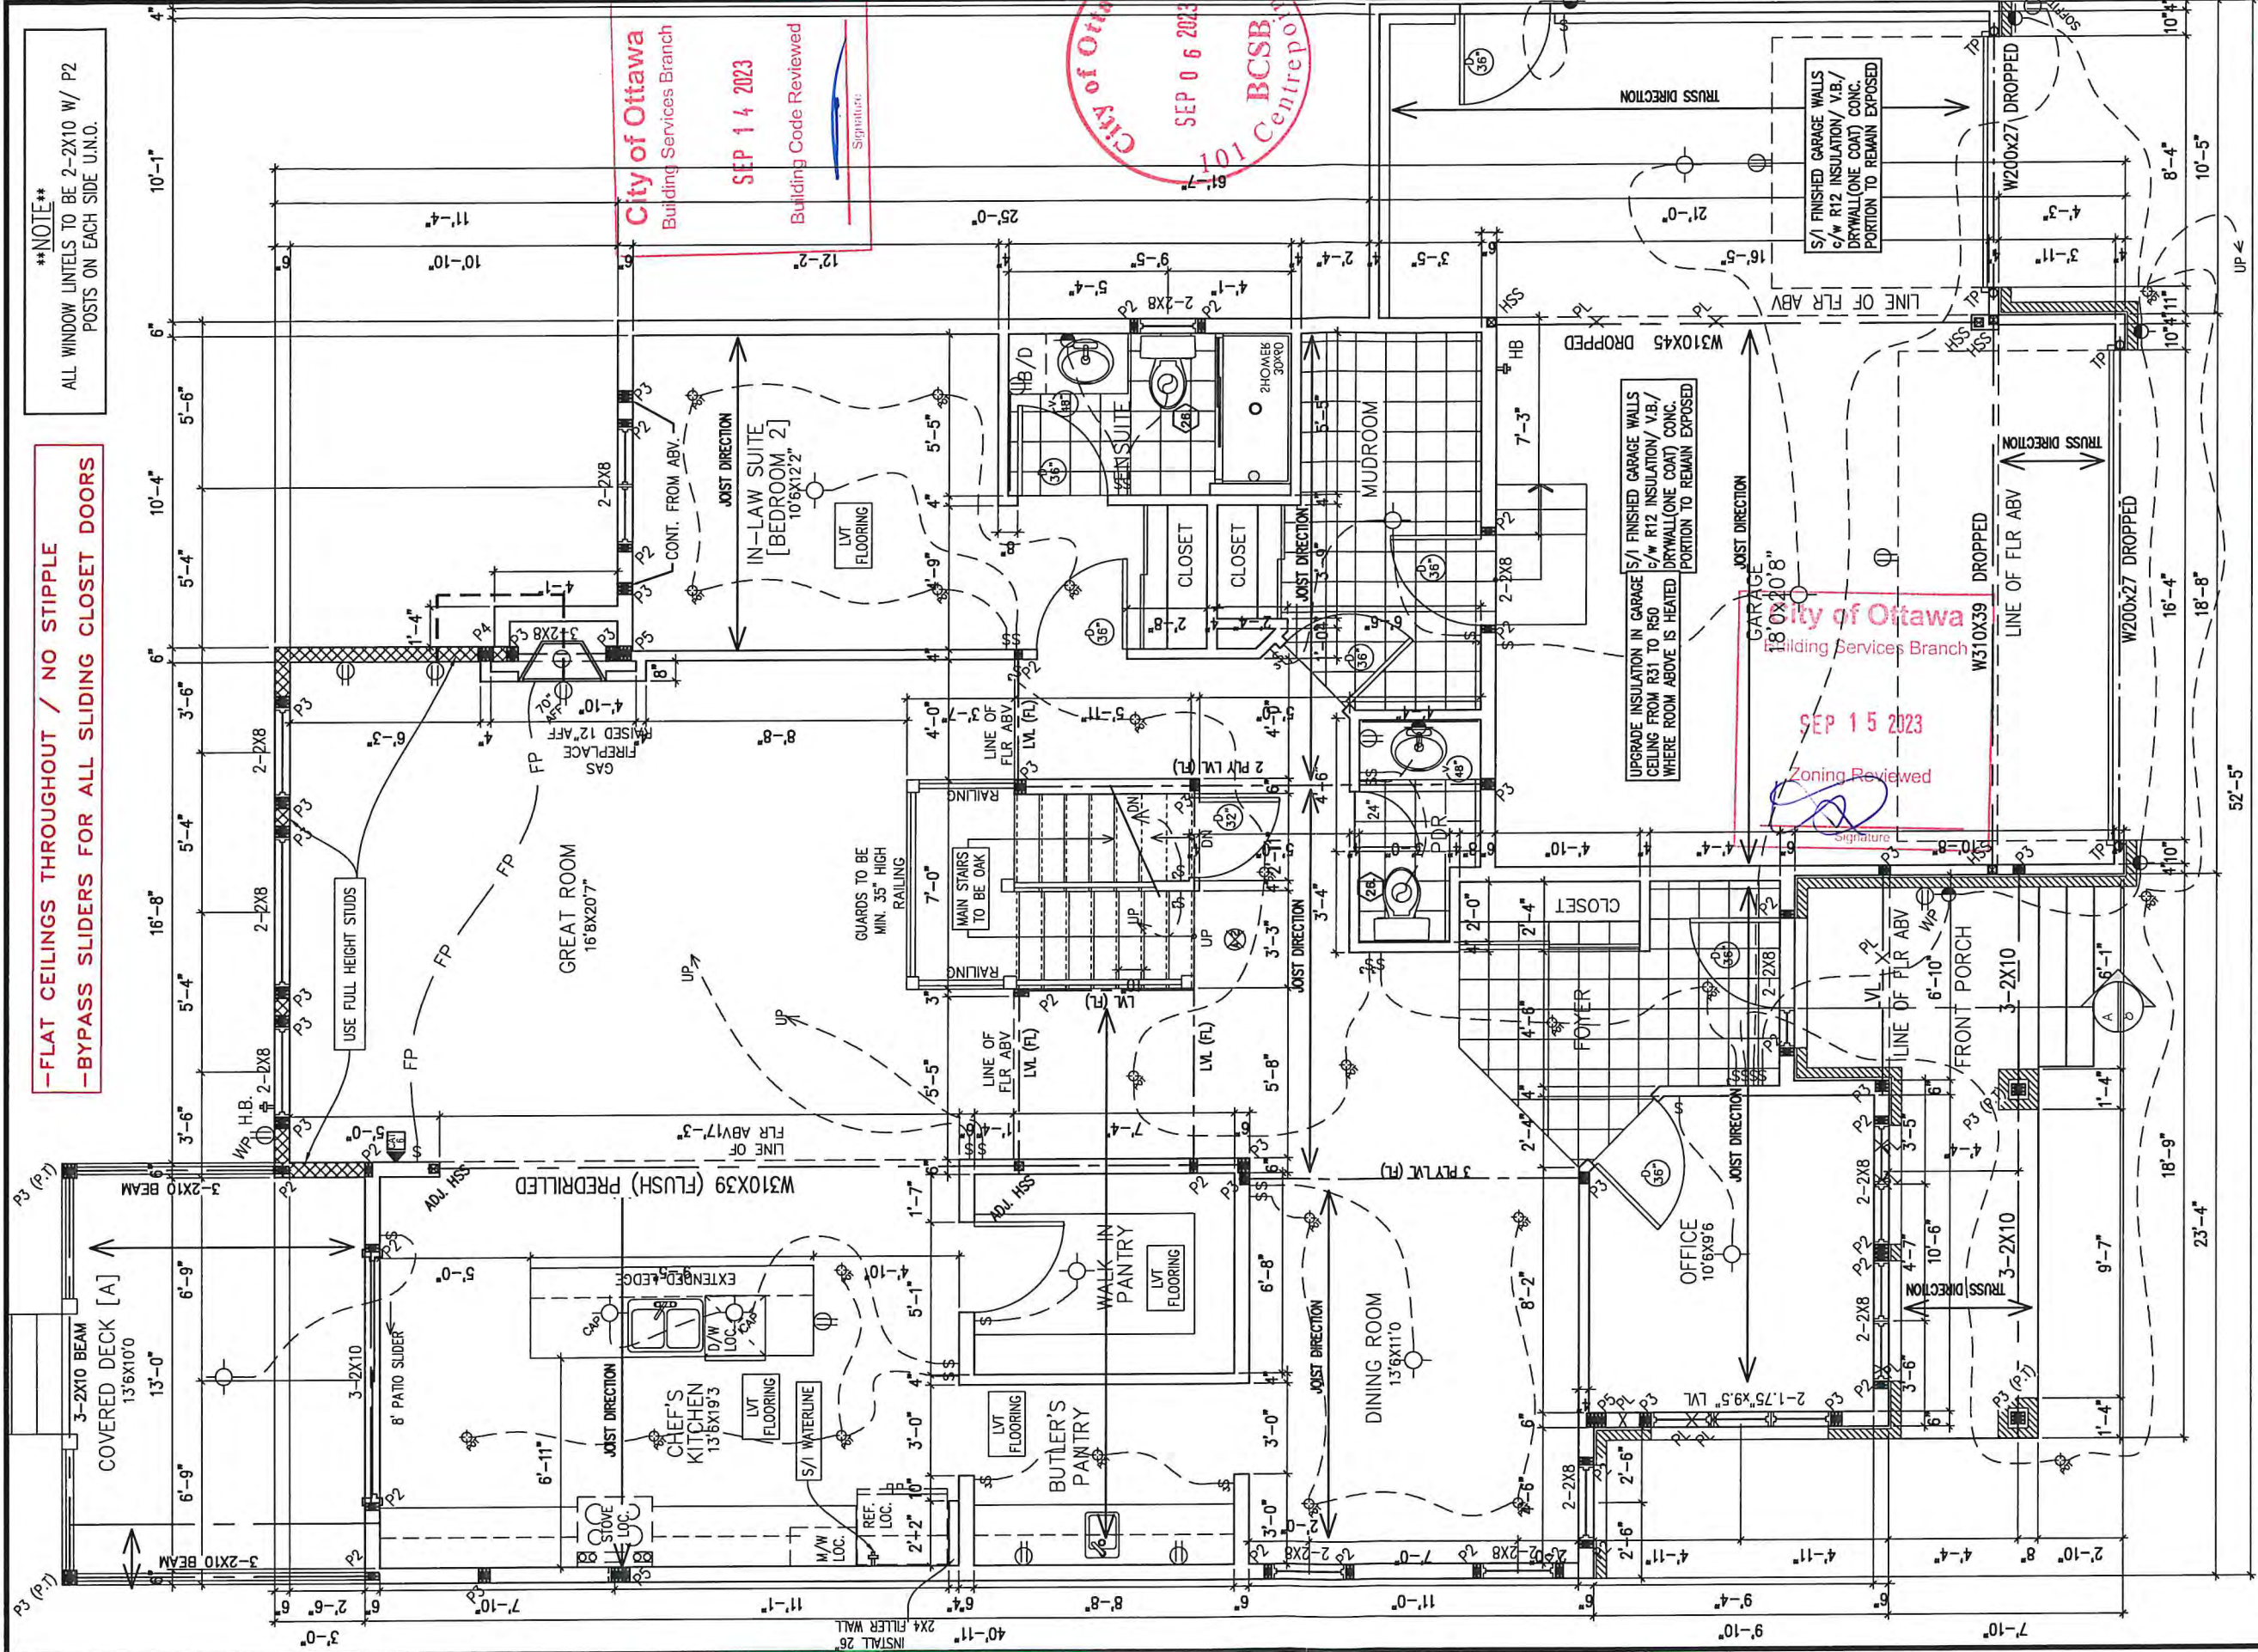


-FLAT CEILINGS THROUGHOUT / NO STIPPLE  
-BYPASS SLIDERS FOR ALL SLIDING CLOSET DOORS

\*\*NOTE\*\*  
ALL WINDOW LINTELS TO BE 2-2X10 W/ P2  
POSTS ON EACH SIDE UNO.

# GROUND FLOOR PLAN (ELEVATION R) 1782 SQ. FT.

**SITE COPY**

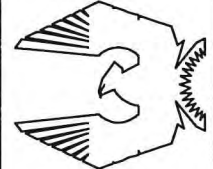

PHOENIX HOMES


NEWINGTON R - 2022  
SITE: DIAMONDVIEW PHASE 3  
LOT NUMBER: 95  
CIVIC ADDRESS:  
200 SILVER DART PRIVATE

4	ISSUED FOR ENGINEERING	01/09/23	CB
3	BEP BLACKLINES	17/08/23	CB
2	KITCHEN LIGHT UPDATE	20/10/22	SP
1	FOR LAYOUTS AND STRUCTURE REVIEW	11/03/22	SP
No.	Description	dd/mm/yy	By

footprint: 50-22-7  
drawn by: SP  
date: JUN 12/16  
scale: 3/16"=1'-0"  
D.C.L. - A-11  
sheet no: 3  
3R of 9



-FLAT CEILINGS THROUGHOUT / NO STIPPLE  
-BYPASS SLIDERS FOR ALL SLIDING CLOSET DOORS

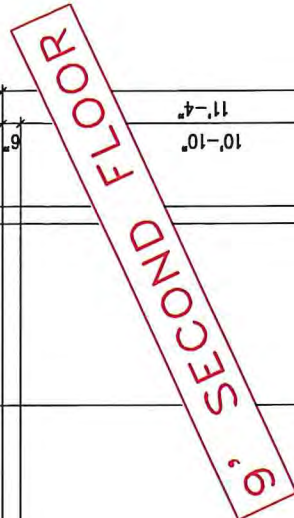







SITE: DIAMONDVIEW PHASE 3

CIMC ADDRESS:  
200 SILVER DART PRIVATE

**PHOENIX HOMES**

	Synopsis		
4	ISSUED FOR ENGINEERING	01/09/23	CB
3	BEP BLACKLINES	17/08/23	CB
2	KITCHEN LIGHT UPDATE	20/10/22	SP
1	FOR LAYOUTS AND STRUCTURE REVIEW	11/03/22	SP
No.	Description	dd/mm/yy	By
REVISIONS			

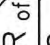footprint:	50-22-77
drawn by:	SP
date:	JUN 12/16
scale:	$3/16'' = 1' - 0''$
D.C.L. - A-11	
sheet no:	







REAR ELEVATION R



9' FOUNDATION POUR

T. WALL  
T. WINDOW

T. SUB-FLOOR  
T. WALL  
T. WINDOW

T. SUB-FLOOR  
T. CONC.

T. FTG  
U.S.

9'-1"

9'-1"

8'-10"

HEEL HEIGHT  
9'-6" T/FND TO T/BREAM

T. FTG  
U.S.

9'-1"

T. SUB-FLOOR  
T. WALL  
T. WINDOW

T. SUB-FLOOR  
T. CONC.

T. FTG  
U.S.

9'-1"

9'-1"

8'-10"

HEEL HEIGHT  
9'-6" T/FND TO T/BREAM



9' SECOND FLOOR

City of Ottawa  
Building Services Branch  
  
SEP 14 2023  
Building Code Reviewed  
  
Signature

SITE  
COPY  
City of Ottawa

footprint:	50-22-7
drawn by:	SP
date:	JUN 12/16
scale:	3/16"=1'-0"
D.C.L. - A-11	
sheet no:	6R of 9

No.	Description	By
4	ISSUED FOR ENGINEERING	01/09/23 CB
3	BEP BLACKLINES	17/08/23 CB
2	KITCHEN LIGHT UPDATE	20/10/22 SP
1	FOR LAYOUTS AND STRUCTURE REVIEW	11/03/22 SP
REVISIONS		

NEWINGTON R - 2022
SITE: DIAMONDVIEW PHASE 3
LOT NUMBER: 95
CIVIC ADDRESS: 200 SILVER DART PRIVATE

PHOENIX HOMES





WALL AREA 724 SQ. FT.  
LIMITING DISTANCE 1.2 M (7%)  
OPENINGS ALLOWED 50.68 SQ. FT.  
OPENINGS PROVIDED 16 SQ. FT.

RIGHT SIDE ELEVATION R

9' SECOND FLOOR

SITE COPY  
City of Ottawa



City of Ottawa  
Building Services Branch  
SEP 14 2023  
Building Code Reviewed

Signature  
I. WALL  
I. WINDOW

T. SUB-FLOOR  
T. WALL  
T. WINDOW

T. SUB-FLOOR  
T. CONC.

8'-10"  
T. FTG  
U.S.G.

9' FOUNDATION POUR

City of Ottawa  
Building Services Branch  
SEP 15 2023  
Zoning Reviewed

footprint:	50-22-7
drawn by:	SP
date:	JUN 12/16
scale:	3/16"=1'-0"
D.C.L. - A-11	7R of 9
sheet no:	

		01/09/23	CB
4	ISSUED FOR ENGINEERING	17/08/23	CB
3	BEP BLACKLINES	20/10/22	SP
2	KITCHEN LIGHT UPDATE	11/03/22	SP
1	FOR LAYOUTS AND STRUCTURE REVIEW	dd/mm/yy	By
No.	Description		
REVISIONS			




NEWINGTON R - 2022
SITE: DIAMONDVIEW PHASE 3
LOT NUMBER: 95
CIVIC ADDRESS: 200 SILVER DART PRIVATE

PHOENIX HOMES







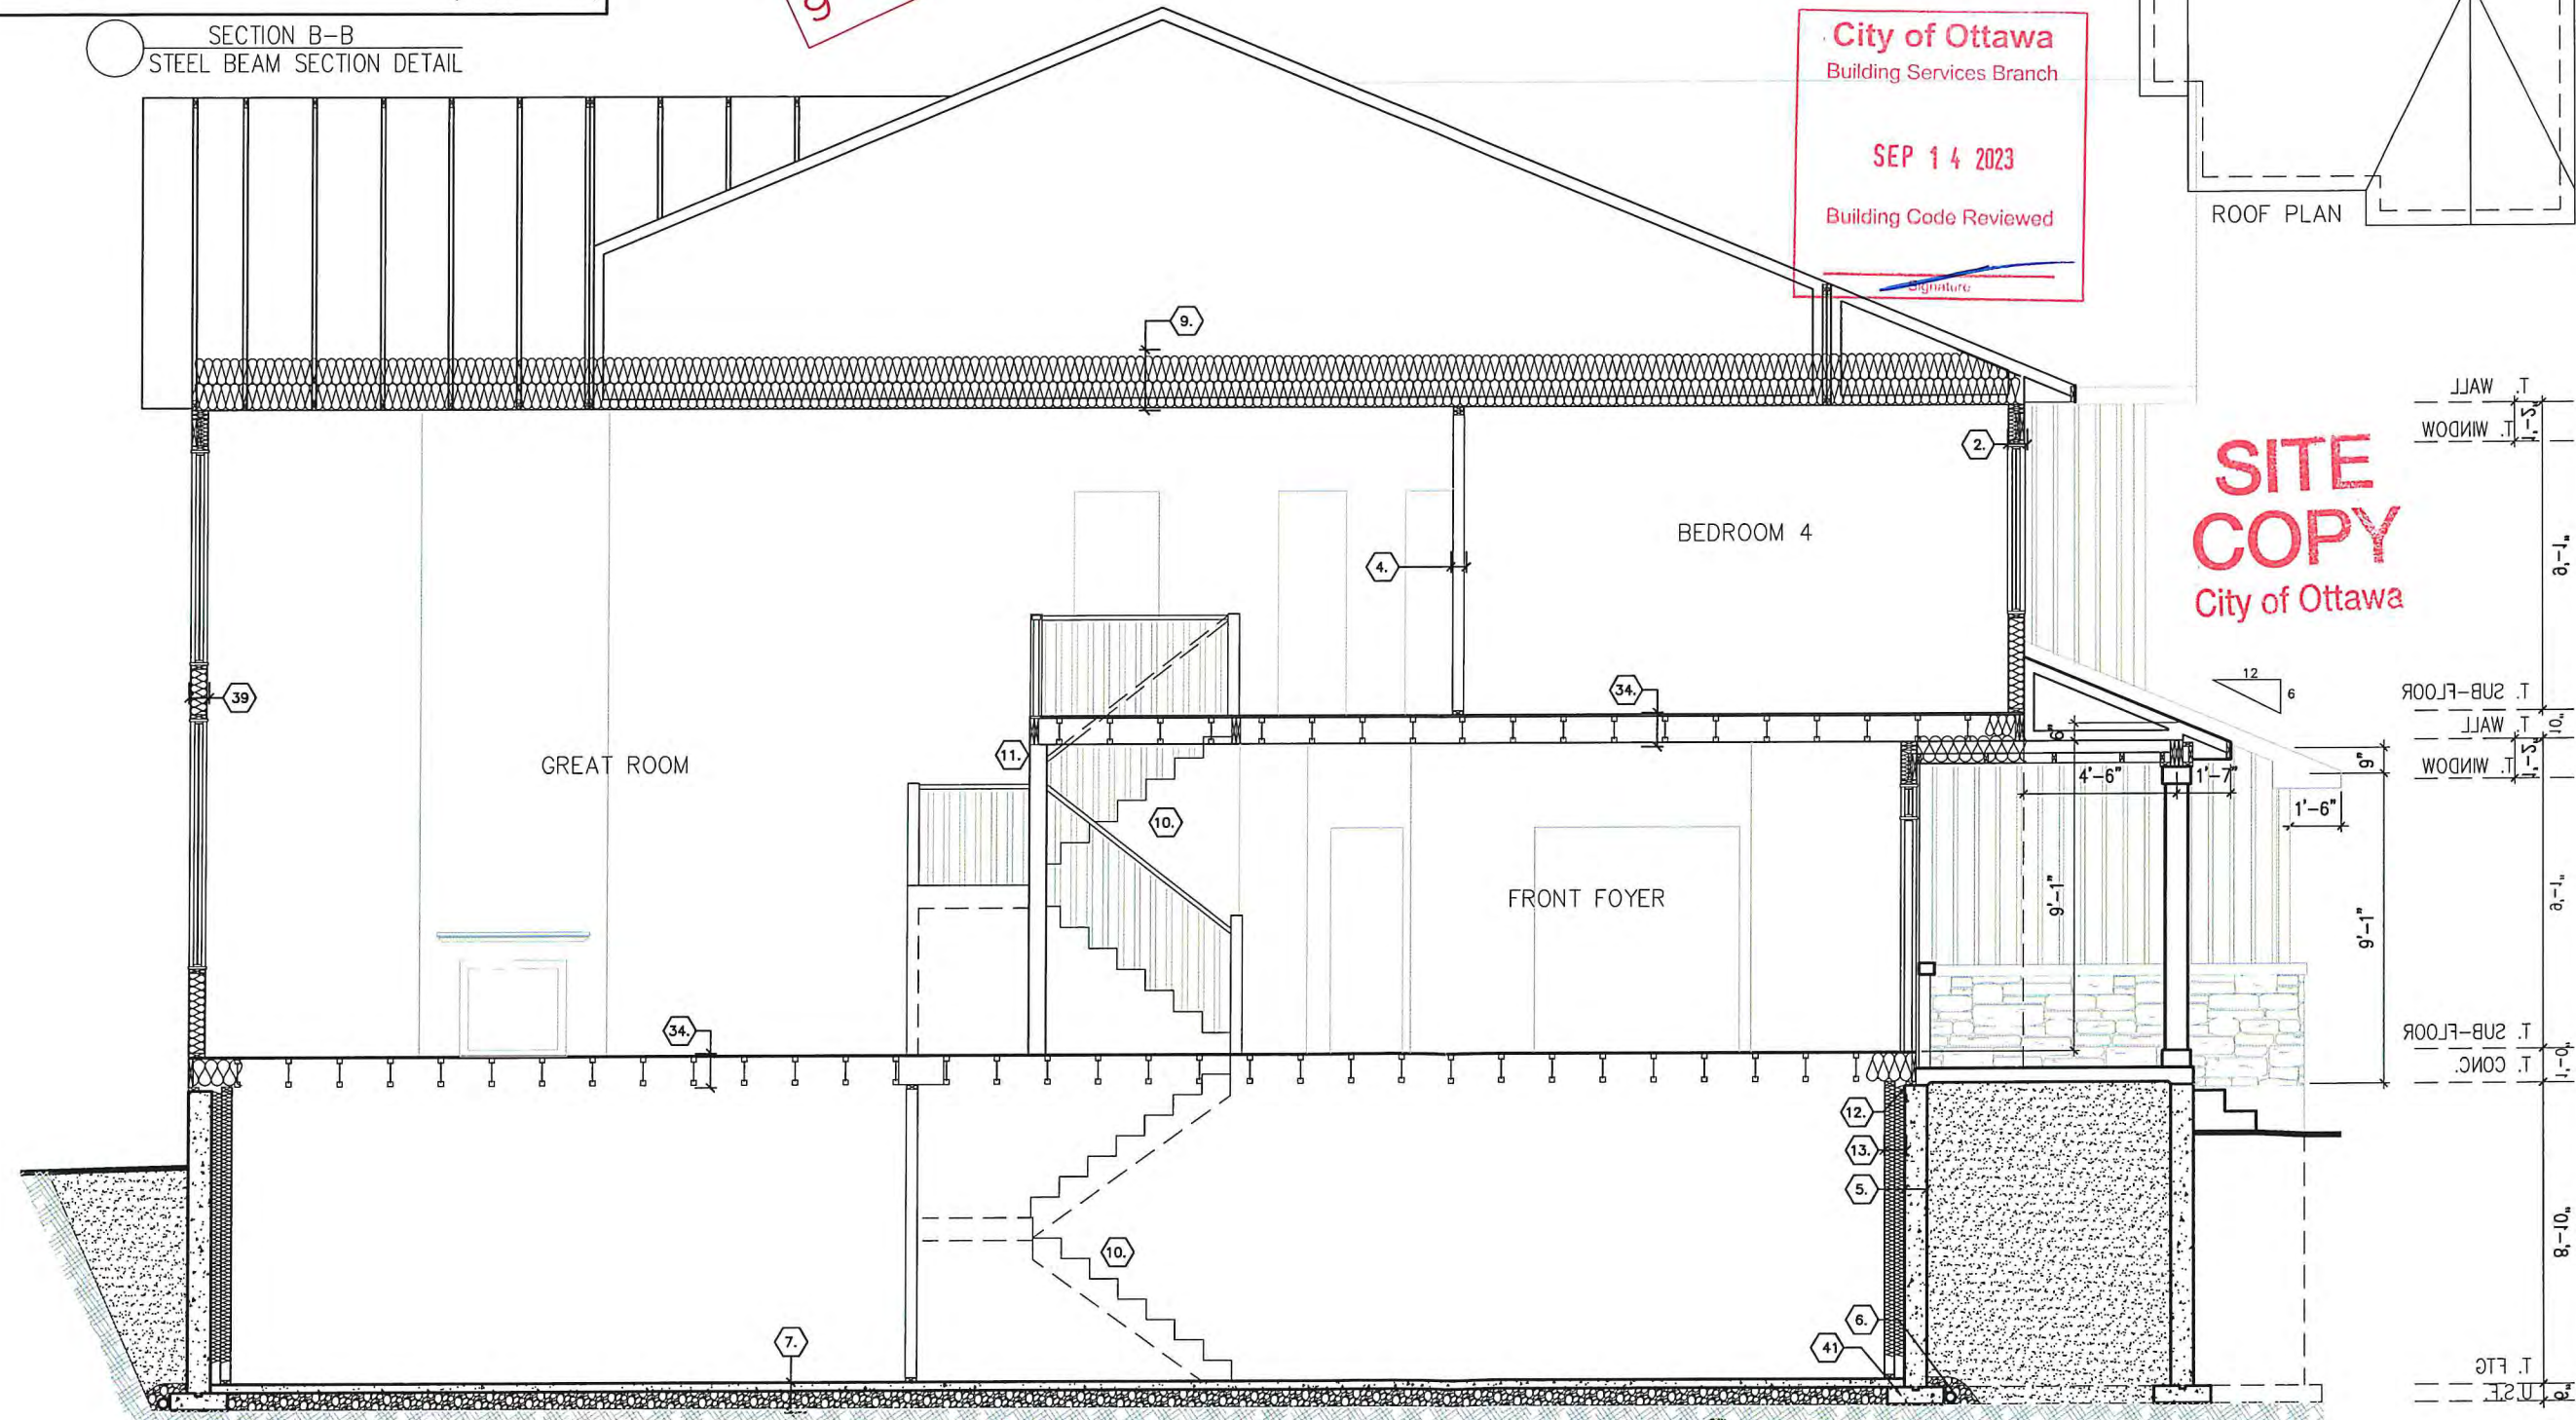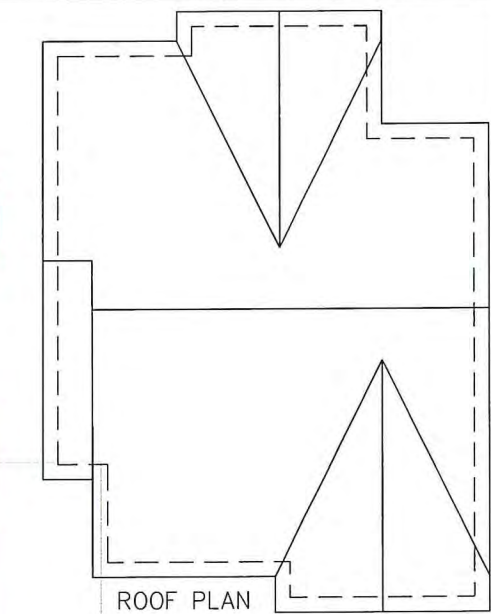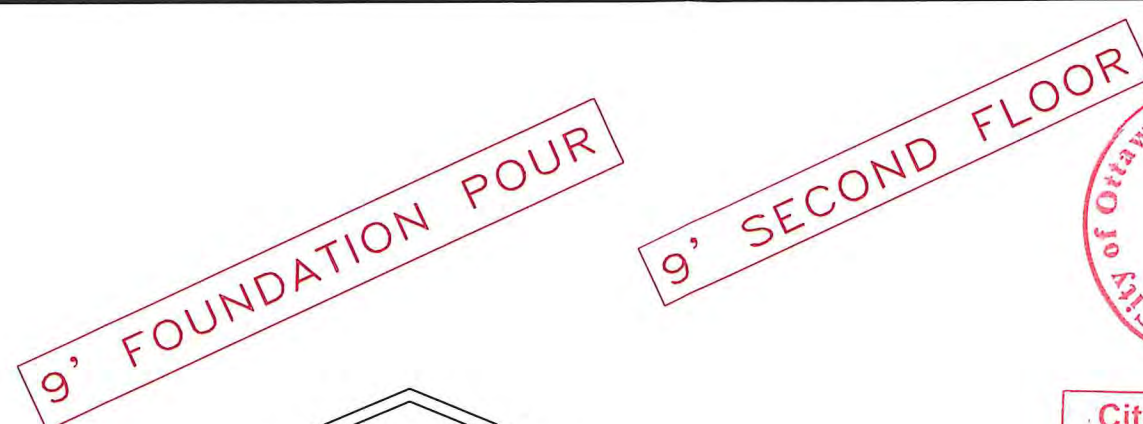

SECTION A-A

City of Ottawa  
SEP 06 2023  
101 Centrepointe Dr. BCSB


**City of Ottawa**  
Building Services Branch

**SEP 14 2023**

**Building Code Reviewed**


  
Signature

**SITE  
COPY**  
City of Ottawa

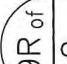
footprint:	50-22-7	
drawn by:	SP	
date:	JUN 12/16	
scale:	3/16"=1'-0"	
D.C.L. - A-11		
sheet no:		

4	ISSUED FOR ENGINEERING	01/09/23	CB
3	BEP BLACKLINES	17/08/23	CB
2	KITCHEN LIGHT UPDATE	20/10/22	SP
1	FOR LAYOUTS AND STRUCTURE REVIEW	11/03/22	SP
No.	Description	dd/mm/yy	By
REVISIONS			




NEWINGTON R - 2022	
SITE: DIAMONDVIEW PHASE 3	
LOT NUMBER:	95
CIVIC ADDRESS: 200 SILVER DART PRIVATE	

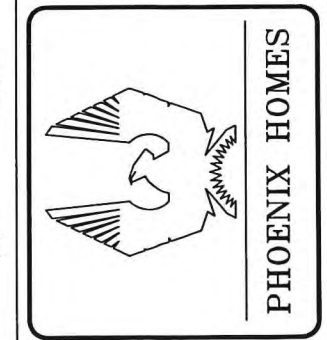



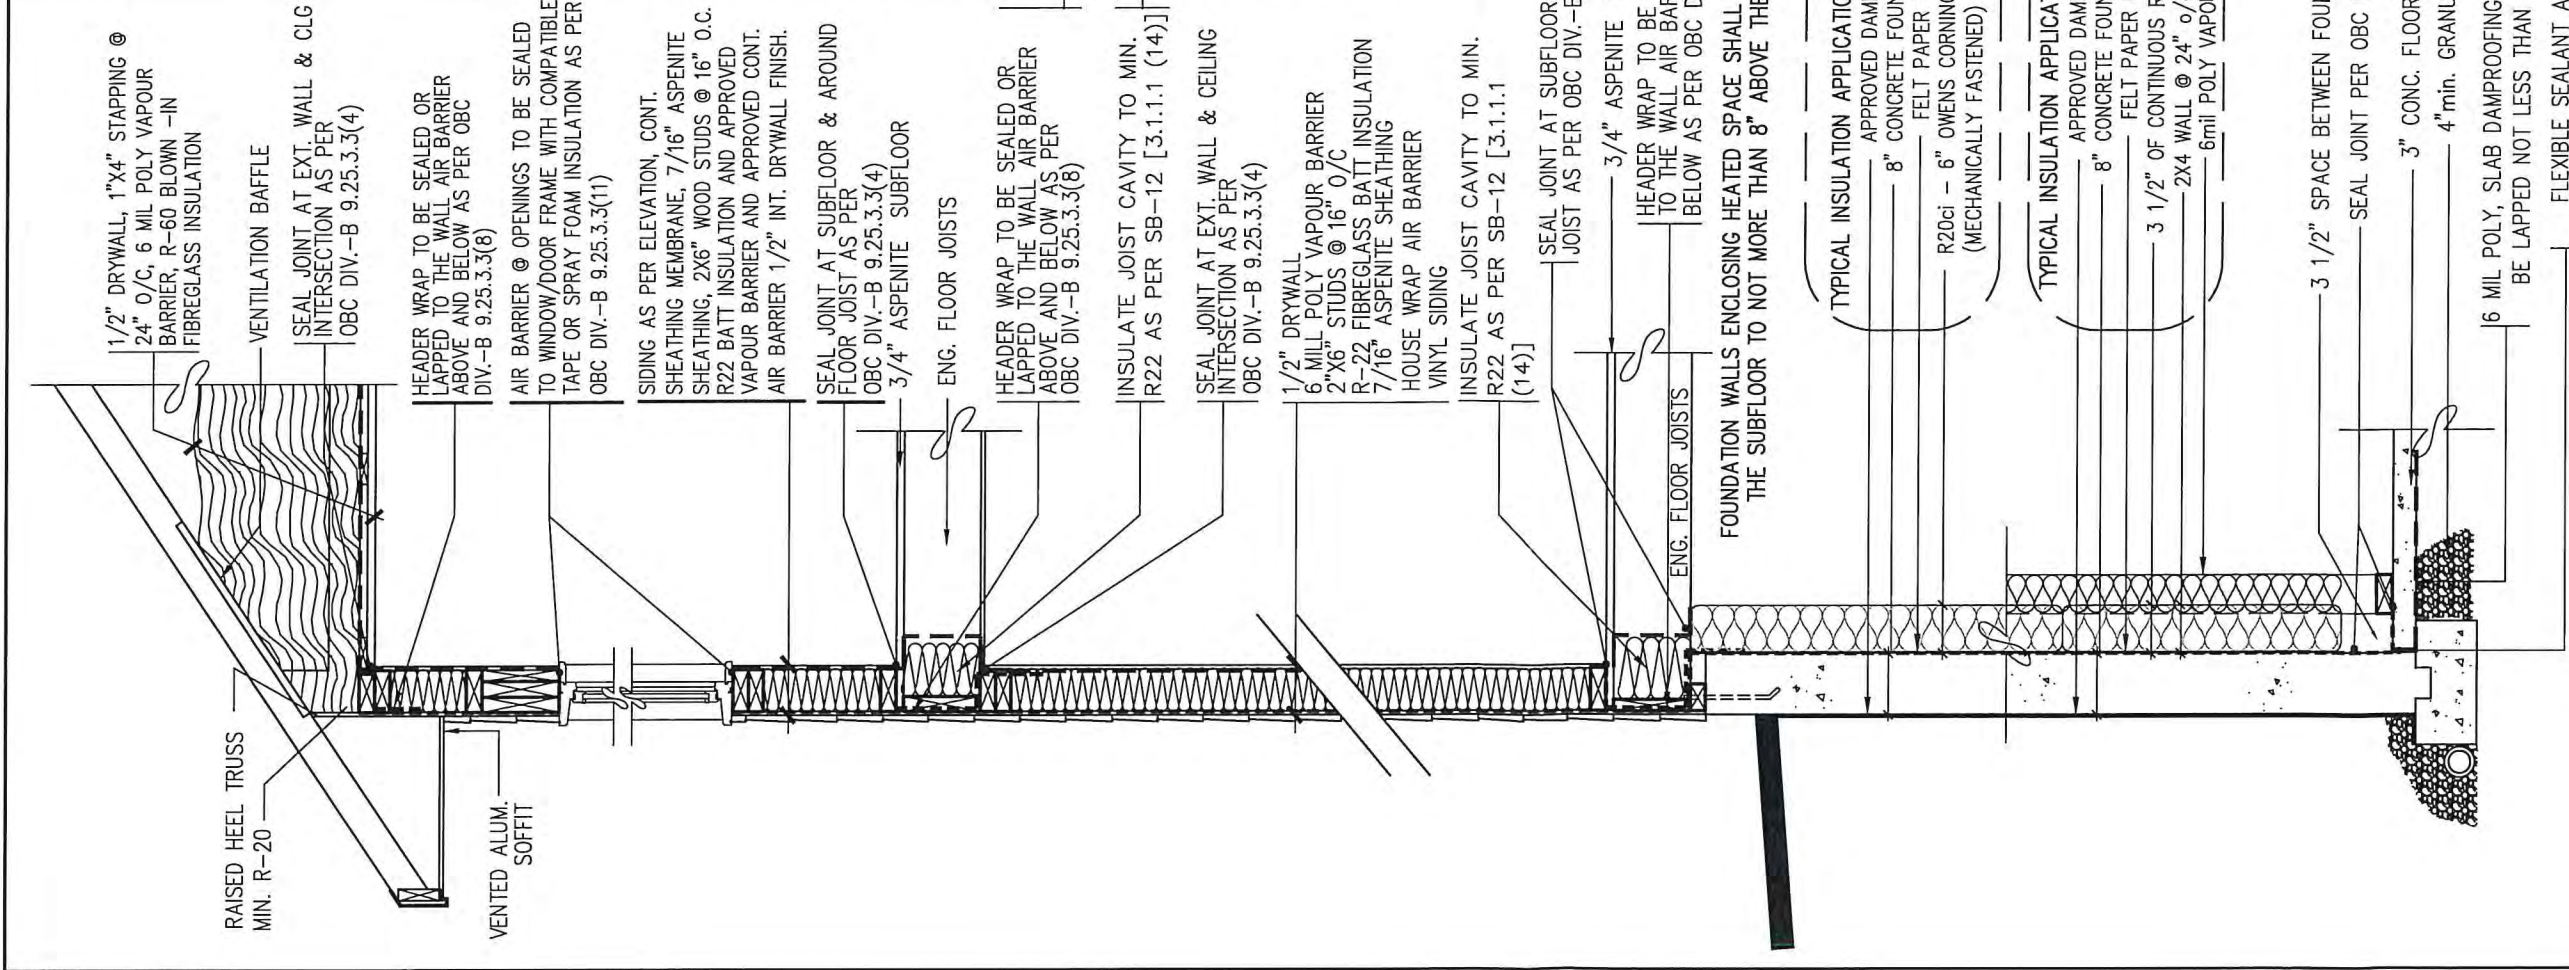

**NOTES:**  
**MECHANICAL**  
SPACE HEATING EQUIPMENT AS PER COMPLIANCE PACKAGE A1 OF SB-12 [TABLE 3.1.1.2.A(IP)]  
AIR BARRIERS AS PER OBC 9.25.3  
ALL JOINTS TO HAVE A MIN. OVERLAP OF 4"  
ALL JOINTS TAPED TO MANUFACTURER'S SPECIFICATIONS  
ALL FASTENERS AS PER MANUFACTURER'S SPECIFICATIONS  
ALL PENETRATIONS SEALED TO MAINTAIN A CONTINUOUS AIR BARRIER  
NOTES FROM OBC SB-9 SECTION 3.3 (SEALING THE PERIMETER & PENETRATIONS)  
(1) A FLOOR-ON-GROUND SHALL BE SEALED AROUND ITS PERIMETER TO THE INNER SURFACES OF ADJACENT WALL USING FLEXIBLE SEALANT.  
(2) ALL PENETRATIONS OF A FLOOR-ON-GROUND BY PIPES OR OTHER OBJECTS SHALL BE SEALED AGAINST SOIL GAS LEAKAGE.  
(3) ALL PENETRATIONS OF A FLOOR-ON-GROUND THAT ARE REQUIRED TO DRAIN WATER FROM THE FLOOR SURFACE SHALL BE SEALED IN A MANNER THAT PREVENTS THE UPWARD FLOW OF SOIL GAS WITHOUT PREVENTING THE DOWNWARD FLOW OF LIQUID WATER.

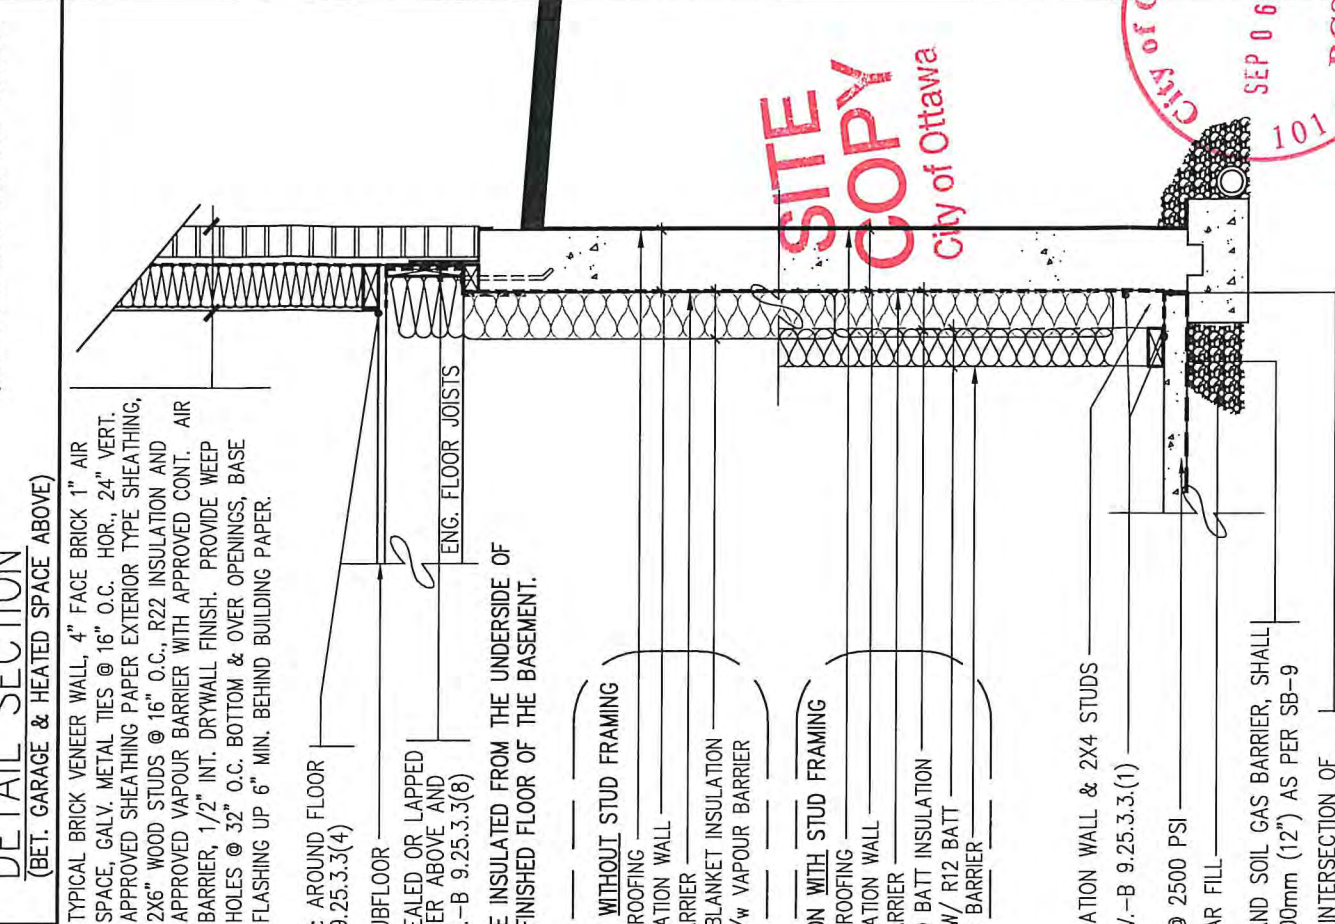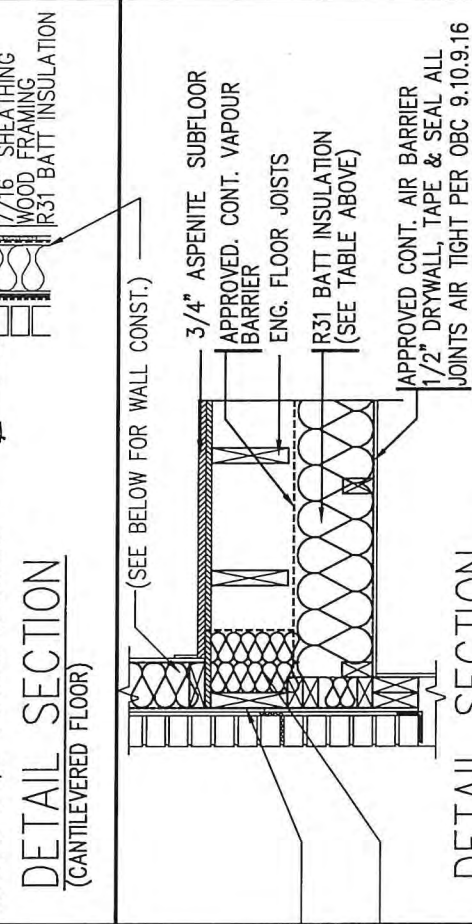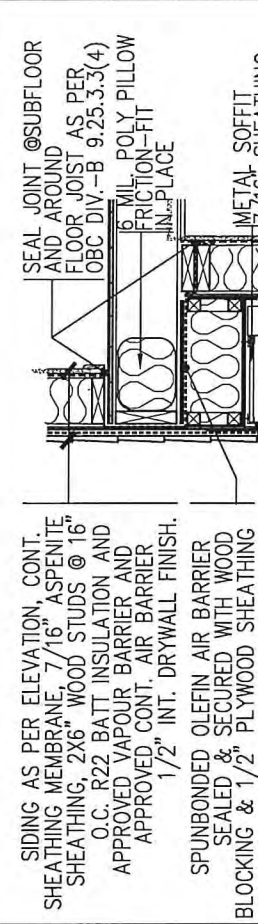


## TYP. DETAIL SECTION (PARTIAL)

FOR SIDING APPLICATION

## TYP. DETAIL SECTION (PARTIAL)

FOR BRICK VENEER APPLICATION

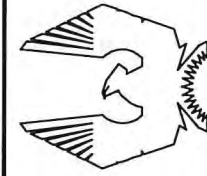

PHOENIX HOMES

SB-12 COMPLIANCE PACKAGE  
DETAILS (ALL MODELS)

City of Ottawa  
Building Services Branch

SEP 14 2023


Building Code Reviewed

Signature

No.	Description	Date	By
4	SB-12 - 2022 UPDATE	JAN - 2022	SP
3	SB-12 - 2017 UPDATE	JAN - 2017	SP
2	ADDED CANTILEVERED FLOOR DETAIL	MAR28-12	TL
1	OBC SB-9 & SB-12 COMPLIANCE PACKAGE	JAN22-12	TL
REVISIONS			

footprint:	SP
drawn by:	SP
date:	
scale:	N/A
sheet no:	SB-12 DETAILS



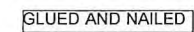

LEVEL AND FLOOR CONTAINER NOTES	
Current Date:	7/14/2021
File Name:	Newington M.mmdl
Level Name:	1st Floor
Building Code - Design Methodology:	NBCC 2015
Floor Container:	FC1
Floor Area Loading is:	40 Live Load & 15 Dead Load
Maximum Allowed Deflection	L/480 Live Load & L/240 Total Load

PlotID	Products		Plies	Net Q
	Length	Product		
L0 - FJ1 @ 19.2" O.C.	28-00-00	9 1/2" NI-20	1	6
L0 - FJ2 @ 19.2" O.C.	24-00-00	9 1/2" NI-20	1	2
L0 - FJ3 @ 19.2" O.C.	20-00-00	9 1/2" NI-20	1	6
L0 - FJ4 @ 19.2" O.C.	19-00-00	9 1/2" NI-20	1	4
L0 - FJ5 @ 19.2" O.C.	16-00-00	9 1/2" NI-20	1	12
L0 - FJ6 @ 19.2" O.C.	12-00-00	9 1/2" NI-20	1	2
L0 - FJ7 @ 19.2" O.C.	42-00-00	9 1/2" NI-40x	1	6
L0 - FJ8 @ 19.2" O.C.	34-00-00	9 1/2" NI-40x	1	3
L0 - FJ9 @ 19.2" O.C.	32-00-00	9 1/2" NI-40x	1	2
L0 - FJ10 @ 19.2" O.C.	18-00-00	9 1/2" NI-80	1	2
L0 - BM1	20-00-00	1 3/4" x 9 1/2" (2.0E 3100) WestFraser LVL	3	3
L0 - BM2	19-00-00	1 3/4" x 9 1/2" (2.0E 3100) WestFraser LVL	1	2
L0 - BM3	18-00-00	1 3/4" x 9 1/2" (2.0E 3100) WestFraser LVL	2	2
L0 - BM4	13-00-00	1 3/4" x 9 1/2" (2.0E 3100) WestFraser LVL	2	2
L0 - BM5	10-00-00	1 3/4" x 9 1/2" (2.0E 3100) WestFraser LVL	1	1
L0 - BM6	4-00-00	1 3/4" x 9 1/2" (2.0E 3100) WestFraser LVL	2	4
L0 - Ca1	12-00-00	1 1/8" x 9 1/2" APA Rim Board	1	16
L0 - Bk1	6-00-00	9 1/2" NI-20	1	1

Accessories				
PlotID	Length	Product	Plies	Net Qty
		3/4" Plywood or OSB (23/32" APA Rated Sheathing 48/24 Exposure 1)	1	56

			Connector Summary	
Qty	Manuf	Product	Skew	Supported Mtl
26	SIMPSON	LT259	-	9 1/2" NI-20
2	SIMPSON	HUS18110	-	1 3/4 x 9 1/2" WF LVL
1	SIMPSON	HHUS410	-	2- 1 3/4" x 9 1/2" WF LVL
1	SIMPSON	HGUS55010	-	3- 1 3/4" x 9 1/2" WF LVL

THIS DESIGN COMPLIES WITH:

- PART 4 OR 9 OF OBC 2012 Reg. 332/12
- NORDIC LAM CCMC: 13216-R
- NORDIC JOISTS CCMC: 13032-R
- WEST FRASER CCMC: 12904

(REFER TO INDIVIDUAL FLOOR DRAWINGS  
FOR SPECIFIC LOADS & SPACING)

FLOOR NOTES:

- 2
- FLOOR JOIST SYSTEMS ABOVE THE GARAGE HAS BEEN DESIGNED WITHOUT A DIRECTLY APPLIED CEILING. USE APPLICABLE BLOCKING OR STRAPPING WHERE REQUIRED AS INDICATED ON THE FRAMING PLAN.
- GS
- BLOCKING MATERIAL WILL BE SUPPLIED AND INDICATED AS "BLOCKING". NO LONGER ONLY 12" LENGTHS.



JOB:  
PHOENIX HOMES  
NEWINGTON M/R  
1ST FLOOR 1 OF 2

DATE: 7/16/2021

**City of Ottawa**  
Building Services Branch

SEP 14 2023

Building Code Reviewed

**SITE  
COPY**  
City of Ottawa







**GLUED AND NAILED**

LEVEL AND FLOOR CONTAINER NOTES	
Current Date:	7/14/2021
File Name:	Newington M.mmdl
Level Name:	2nd Floor
Building Code - Design Methodology:	NBCC 2015
Floor Container:	FC2
Floor Area Loading is:	40 Live Load & 15 Dead Load
Maximum Allowed Deflection	L/480 Live Load & L/240 Total Load

Products				
PlotID	Length	Product	Plies	Net Qty
L1 - FJ1 @ 19.2" O.C.	28-00-00	9 1/2" NI-20	1	1
L1 - FJ2 @ 19.2" O.C.	20-00-00	9 1/2" NI-20	1	4
L1 - FJ3 @ 19.2" O.C.	14-00-00	9 1/2" NI-20	1	20
L1 - FJ4 @ 19.2" O.C.	13-00-00	9 1/2" NI-20	1	5
L1 - FJ5 @ 19.2" O.C.	12-00-00	9 1/2" NI-20	1	8
L1 - FJ6 @ 19.2" O.C.	16-00-00	9 1/2" NI-40x	1	10
L1 - FJ7 @ 19.2" O.C.	38-00-00	9 1/2" NI-80	1	6
L1 - FJ8 @ 19.2" O.C.	30-00-00	9 1/2" NI-80	1	2
L1 - FJ9 @ 19.2" O.C.	19-00-00	9 1/2" NI-80	1	2
L1 - BM1	16-00-00	1 3/4" x 9 1/2" (2.0E 3100) WestFraser LVL	2	2
L1 - BM2	13-00-00	1 3/4" x 9 1/2" (2.0E 3100) WestFraser LVL	2	2
L1 - BM3	12-00-00	1 3/4" x 9 1/2" (2.0E 3100) WestFraser LVL	3	3
L1 - BM4	8-00-00	1 3/4" x 9 1/2" (2.0E 3100) WestFraser LVL	2	2
L1 - BM5	6-00-00	1 3/4" x 9 1/2" (2.0E 3100) WestFraser LVL	1	2
L1 - BM6	5-00-00	1 3/4" x 9 1/2" (2.0E 3100) WestFraser LVL	1	1
L1 - Ca1	12-00-00	1 1/8" x 9 1/2" APA Rim Board	1	13
L1 - Ca2	12-00-00	1 1/8" x 9 1/2" APA Rim Board	2	6
L1 - Bk1	12-00-00	9 1/2" NI-20	1	1

Accessories				
PlotID	Length	Product	Plies	Net Qty
		3/4" Plywood or OSB (23/32" APA Rated Sheathing 48/24 Exposure 1)	1	52

			Connector Summary	
Qty	Manuf	Product	Skew	Supported Mtl
2	SIMPSON	HUS18110	-	1 3/4" x 9 1/2" WF LVL
1	SIMPSON	HHUS410	-	2- 1 3/4" x 9 1/2" WF LVL
44	SIMPSON	LT259	-	9 1/2" NI-20
2	SIMPSON	LT359	-	9 1/2" NI-80

THIS DESIGN COMPLIES WITH:

- PART 4 OR 9 OF OBC 2012 Reg. 332/12
- NORDIC LAM CCMC: 13216-R
- NORDIC JOISTS CCMC: 13032-R
- WEST FRASER CCMC: 12904

(REFER TO INDIVIDUAL FLOOR DRAWINGS  
FOR SPECIFIC LOADS & SPACING)

FLOOR NOTES:

- FLOOR JOIST SYSTEMS ABOVE THE GARAGE HAS BEEN DESIGNED WITHOUT A DIRECTLY APPLIED CEILING. USE APPLICABLE BLOCKING OR STRAPPING WHERE REQUIRED AS INDICATED ON THE FRAMING PLAN.

- BLOCKING MATERIAL WILL BE SUPPLIED AND INDICATED AS "BLOCKING". NO LONGER ONLY 12' LENGTHS.

**City of Ottawa**  
Building Services Branch

SEP 14 2023

Building Code Reviewed

Signature \_\_\_\_\_


**SITE  
COPY**  
City of Ottawa

JOB:  
PHOENIX HOMES  
NEWINGTON M/R  
2ND FLOOR 2 OF 2

DATE: 7/16/2021



# HIGH ROOF

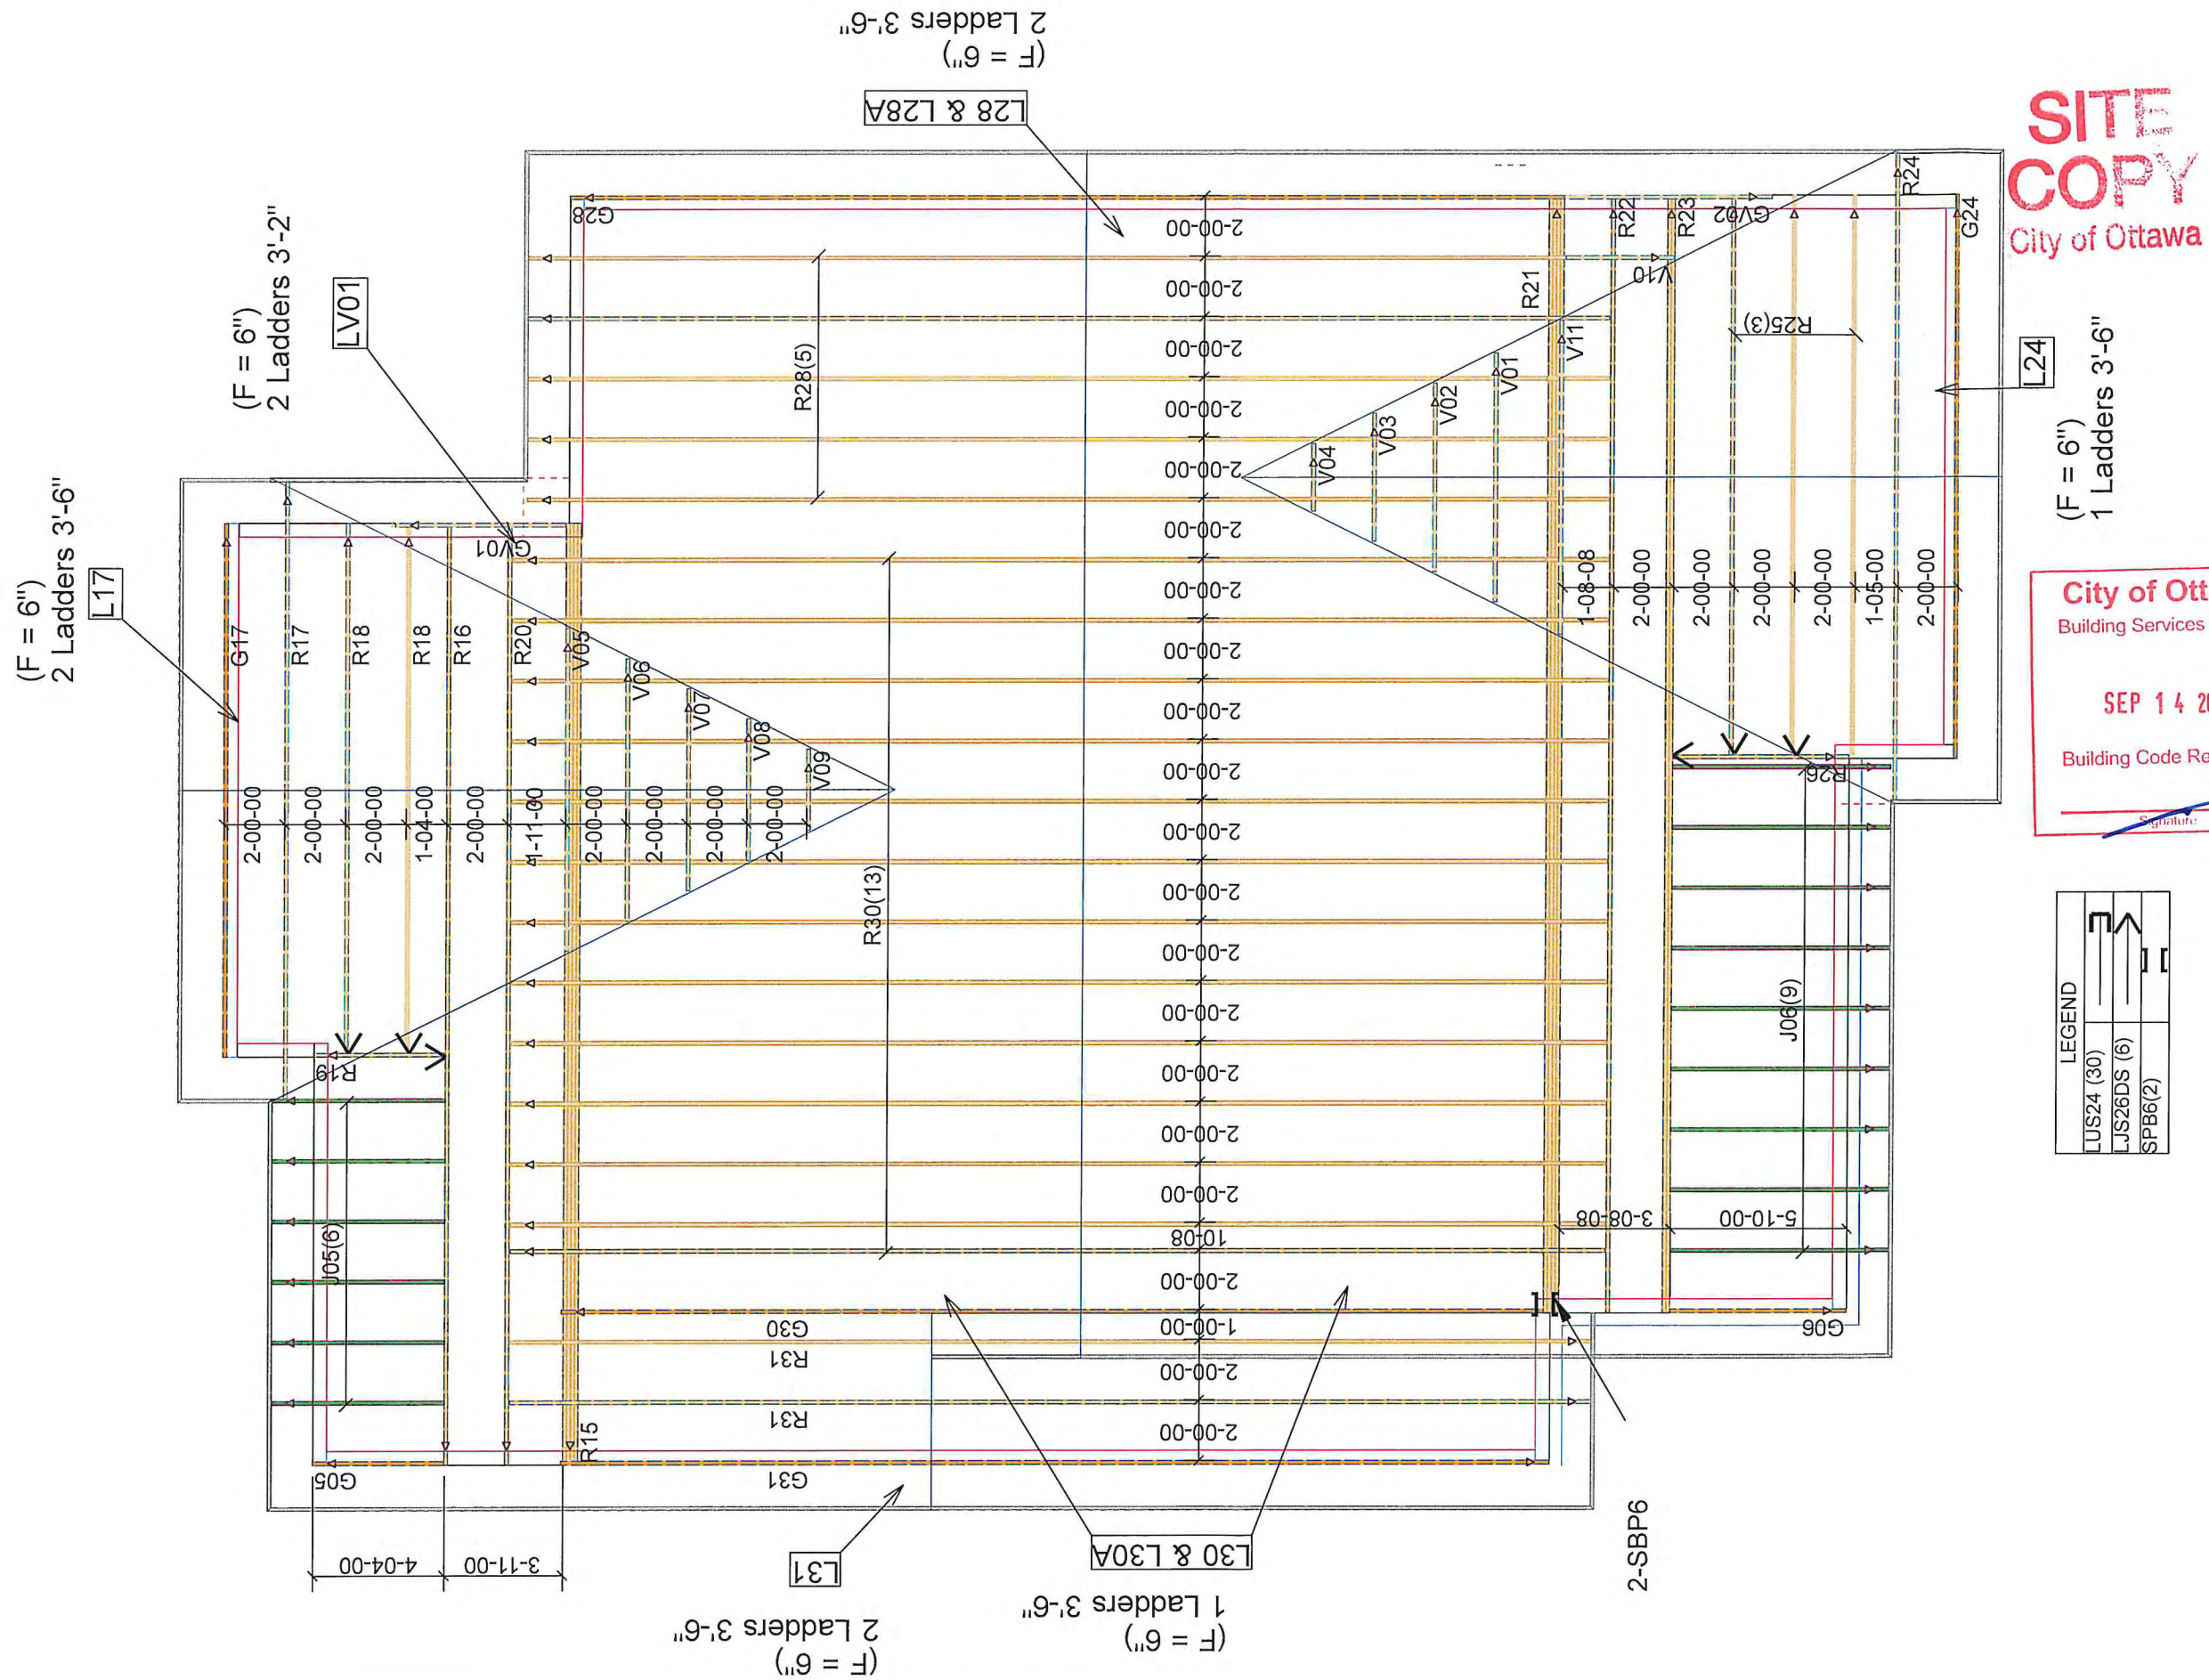

**SITE  
COPY**  
City of Ottawa




(F = 6")  
1 Ladders 3'-6"

**City of Ottawa**  
Building Services Branch

SEP 14 2023

Building Code Reviewed

Signature \_\_\_\_\_

LEGEND	
LUS24 (30)	
LJS26DS (6)	
SPB6(2)	

Member	Load Type	PT 9	PT 4
Top Chord	Snow	37.1	50
	Dead	3	5-10
Bot Chord	Live	0	10
	Dead	7	7

TYPICAL SPACING = 24.0 IN C/C

**HURRICANE AND SEISMIC TIES:**

- ANY TIES SPECIFIED ON THIS LAYOUT FOR UPLIFT OR SEISMIC CONNECTIONS MUST BE REVIEWED AND APPROVED BY THE BUILDING DESIGNER/ENGINEER, AS STATED IN THE TPIC 2011. THE TRANSFER OF THESE LOADS TO THE ENTIRE STRUCTURE BELOW HAS NOT BEEN ANALYZED.

THIS DESIGN COMPLIES WITH:

- PART 4 OR 9 OF OBC 2012 Reg. 332/12
- CSA 086-09
- CCMC ACCEPTANCE 11996-L, 0319-L, 13270-L
- TPIC 2011

(REFER TO INDIVIDUAL TRUSS DRAWINGS FOR SPECIFIC LOADS & SPACING)

JOB: PHOENIX HOMES  
NEWINGTON 'R'  
PNEW-2  
DV3-95




GRANDOR LUMBER INC.  
ALPA LUMBER GROUP

8/31/2023



LOW ROOF

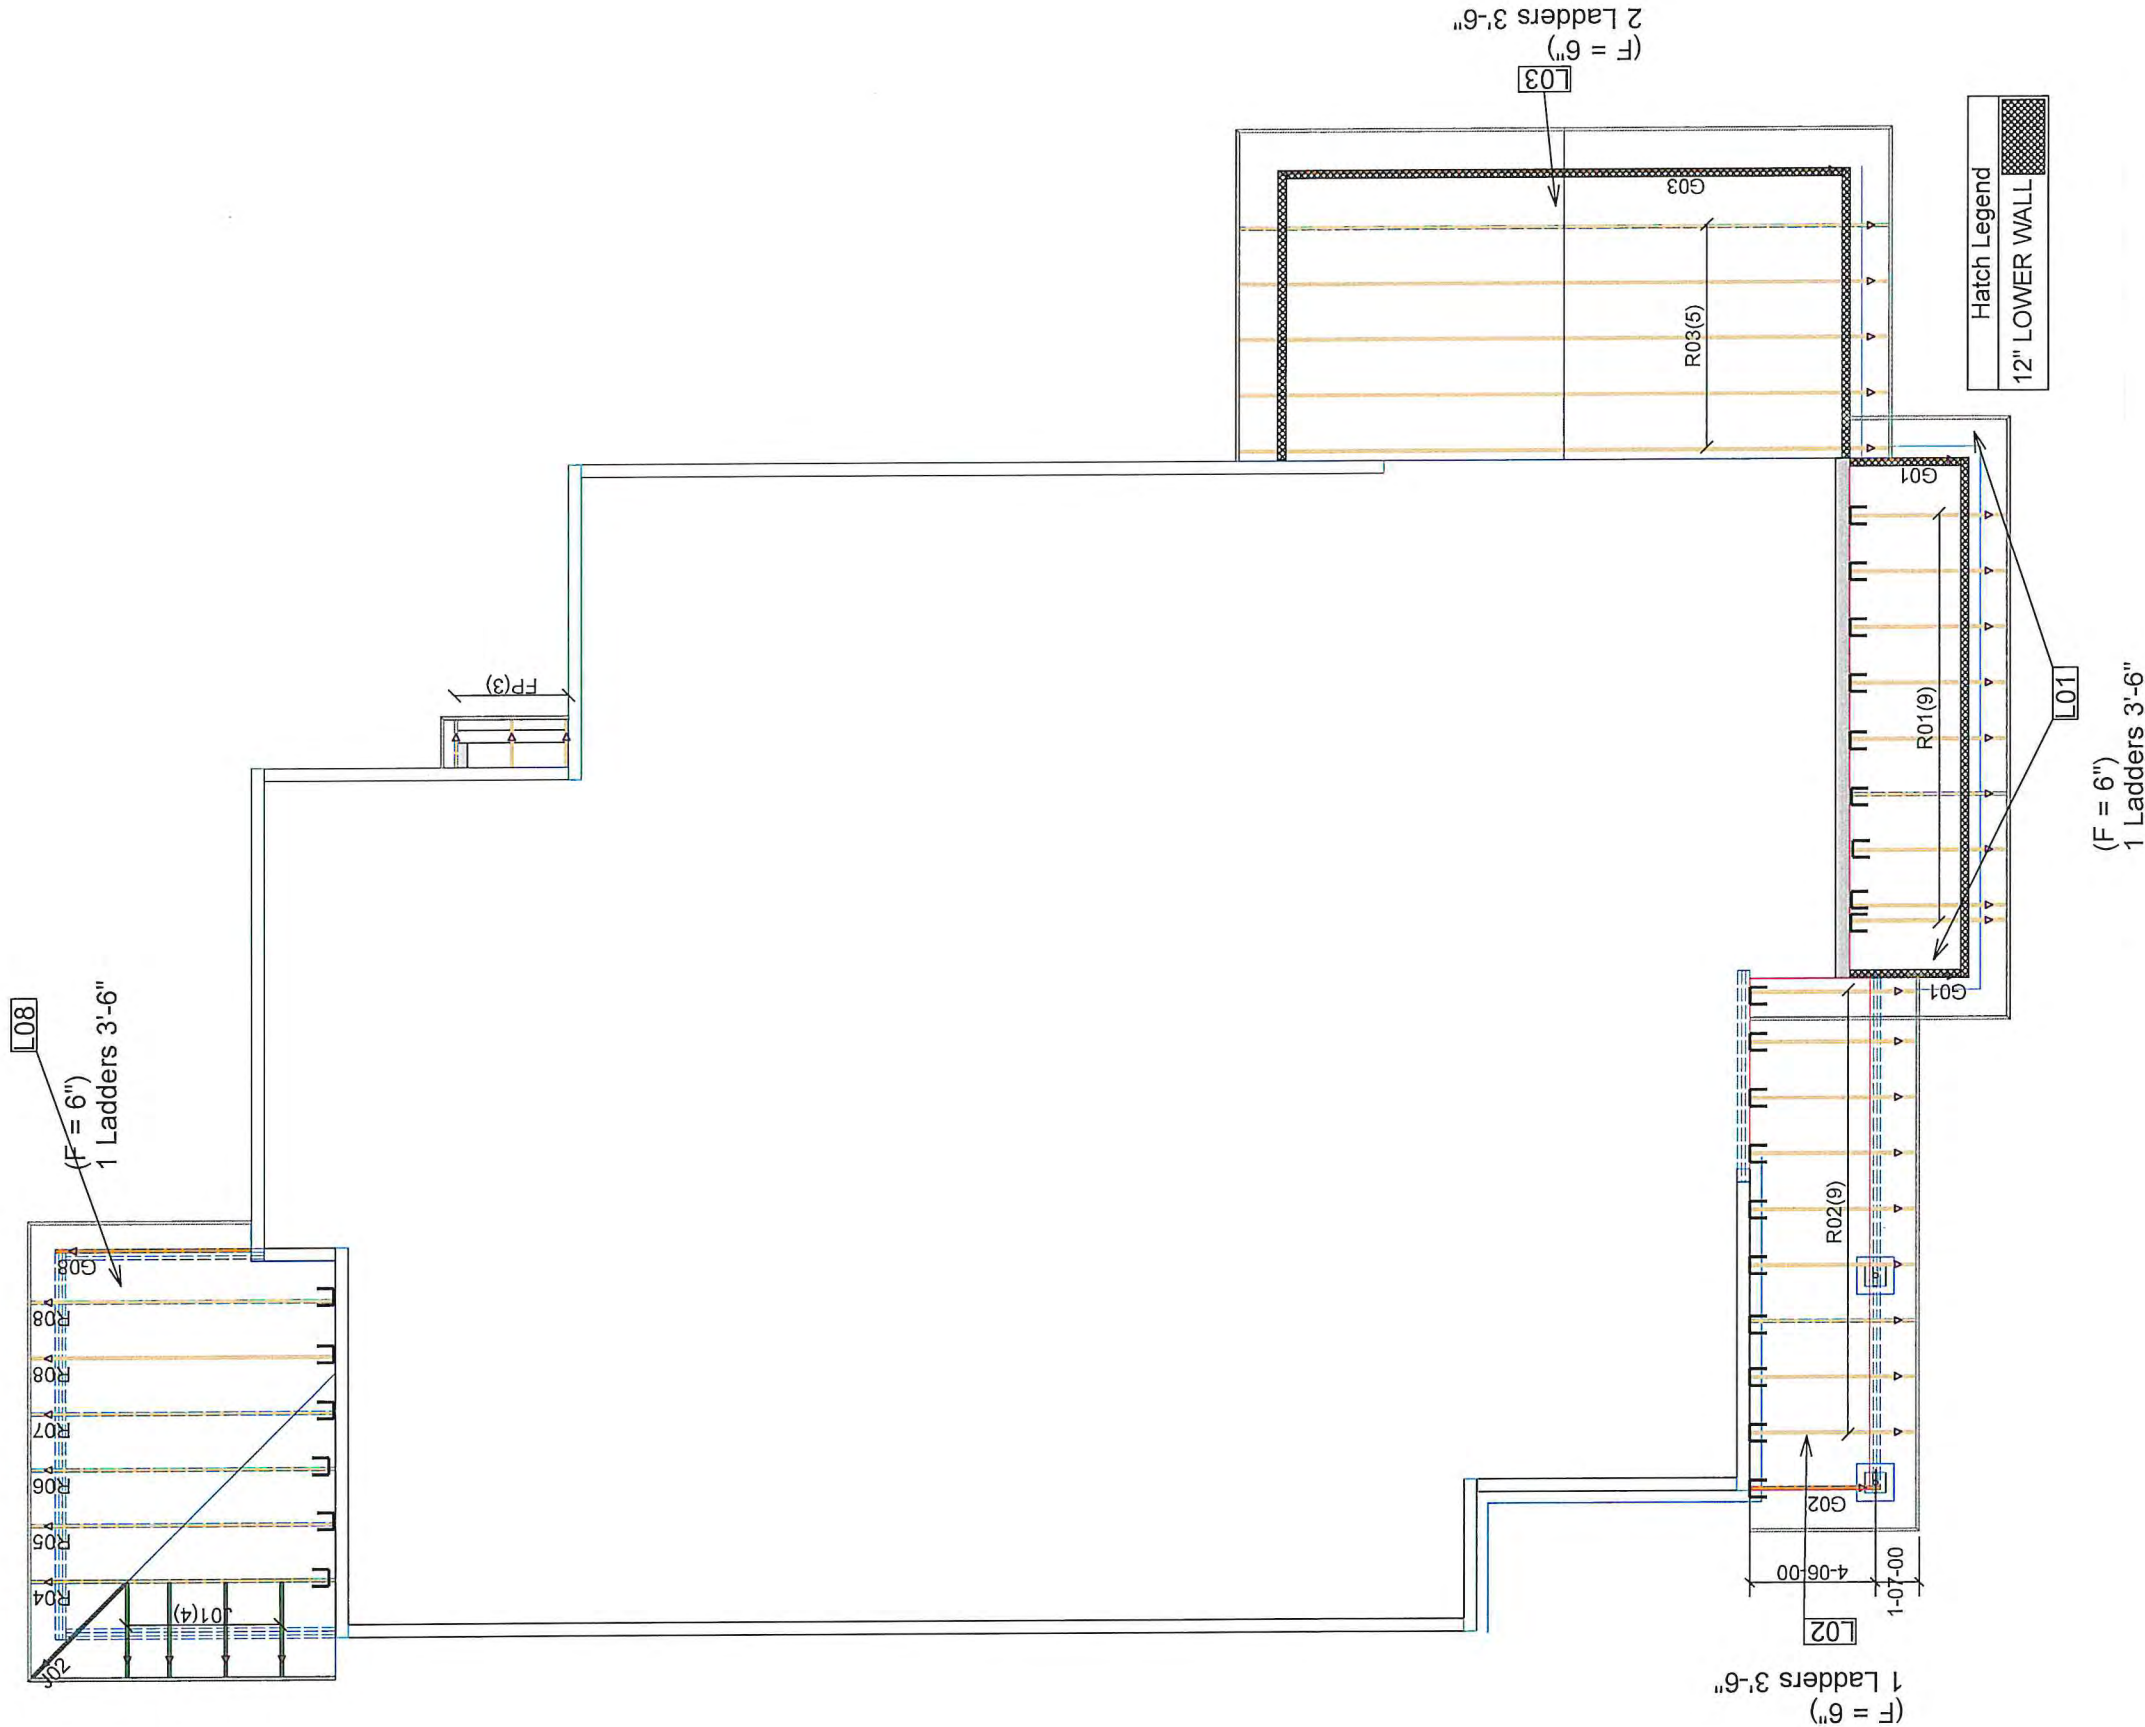

City of Ottawa  
Building Services Branch

SEP 14 2023

Building Code Reviewed

Signature: \_\_\_\_\_

**SITE COPY**  
City of Ottawa



TYPICAL OTTAWA DESIGN LOADS

Member	Load Type	PT 9	PT 4
Top Chord	Snow	37.1	50
	Dead	3	5-10
Bot Chord	Live	0	10
	Dead	7	7

TYPICAL SPACING = 24.0 IN C/C

THIS DESIGN COMPLIES WITH:

- PART 4 OR 9 OF OBC 2012 Reg. 332/12
  - CSA 086-09
  - CCMC ACCEPTANCE 11995-L, 0319-L, 13270-L
  - TPIC 2011
- (REFER TO INDIVIDUAL TRUSS DRAWINGS FOR SPECIFIC LOADS & SPACING)

HURRICANE AND SEISMIC TIES:

- ANY TIES SPECIFIED ON THIS LAYOUT FOR UPLIFT OR SEISMIC CONNECTIONS MUST BE REVIEWED AND APPROVED BY THE BUILDING DESIGNER/ENGINEER, AS STATED IN THE TPIC 2011. THE TRANSFER OF THESE LOADS TO THE ENTIRE STRUCTURE BELOW HAS NOT BEEN ANALYZED.



JOB: PHOENIX HOMES  
NEWINGTON 'R'  
PNEWR-2  
DV3-95

DATE: 8/31/2023





CITY OTTAWA

INVOICE

Number /  
c de la facture  
79-2023  
ilcon Number /  
c de la demande  
005337

Sep-06

Fee Description / Description des frais

Construction

3,6€

Invoice Total / total de la facture

3,6€



Notes / notes

Location / emplacement

200 SILVER DART PRIV

Invoiced To / facturé à

DCR PHOENIX DEVELOPMENT CORP CORPORATION  
18-A BENTLEY AVE  
OTTAWA, ON  
K2E 6T8



City of Ottawa  
101 Centrepoin Drive, 2nd Floor  
Ottawa, ON K2G 5K7  
Location: 32-500  
BFP Building Code Services

City of Ottawa / Ville d'Ottawa

Receipt / Reçu  
City of Ottawa / Ville d'Ottawa

Receipt / Reçu

Receipt / Reçu

BCS-0006 09/06/2023 15:19:28 0032689  
Cashier: Nicole

555 3661.24

MAPP / MAPP

Account # 1045261037923366124

Cheque/Chèque 3661.24  
# XXXXXXXXXXXXXXX5991

www.ottawa.ca

HST/TVH#: 863935995RT0001

BCS-0006 09/06/2023 15:19:50 0032689

ir / Copie du payeur