

DCR PHOENIX HOMES

LOT #129

WHITE TAIL RIDGE 4

MODEL - SPRINGFIELD

GARAGE LEFT

KITCHEN

MOUNTING HEIGHT - 115

STACKED UPpers - 42"H + 1" MOULDING + 18"H
@ 18" ABOVE COUNTER

LIGHT VALANCE

1.25" TOP MOULDING + 3" SHAKER CROWN

CABINETS -

HARDWARE -

STANDARD WHITE INTERIOR

STANDARD METAL DRAWER BOX

STANDARD HINGES

5 PCS - 5/8" KICK - FIN. BOTH ENDS


6 PCS - FLAT SHE MOULDING

2 PCS - 90 DEG. CORNER MOULD

1 PCS - T-MOULD

~~DUMMY DOORS
ON SIDES OF ALL
EXPOSED UPPER
AND BASE ENDS~~ REFER TO 3D
DRAWINGS FOR
DUMMY DOORS

DUMMY DOORS & FLUSH KICK
ON BACK & SIDES OF ISLAND

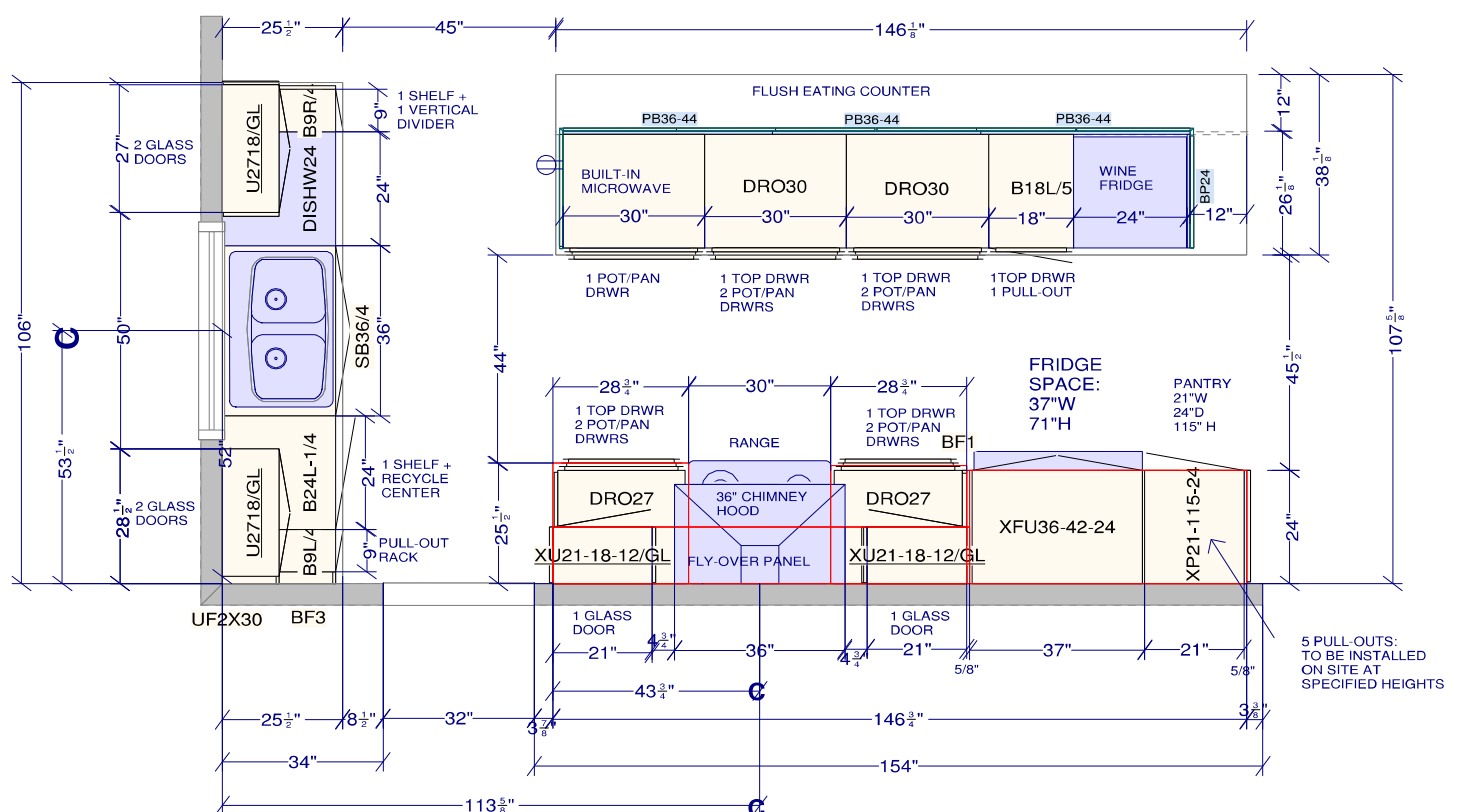

CUSTOMER APPROVAL

I have reviewed these drawings and understand the details of the design and the CARTIER KITCHENS specifications.

Signature _____

Date _____

All dimensions _size designations given are subject to verification on job site and adjustment to fit job conditions.



This is an original design and must not be released or copied unless applicable fee has been paid or job order placed.


Designed: 2023-06-28
Printed: 2023-06-28

DS	DS
Mt	W.t.

129 White Tail Ridge 4 - Springfield (Left) Kitchen 2.kit

A11

Drawing #:	1	No Scale.
------------	---	-----------

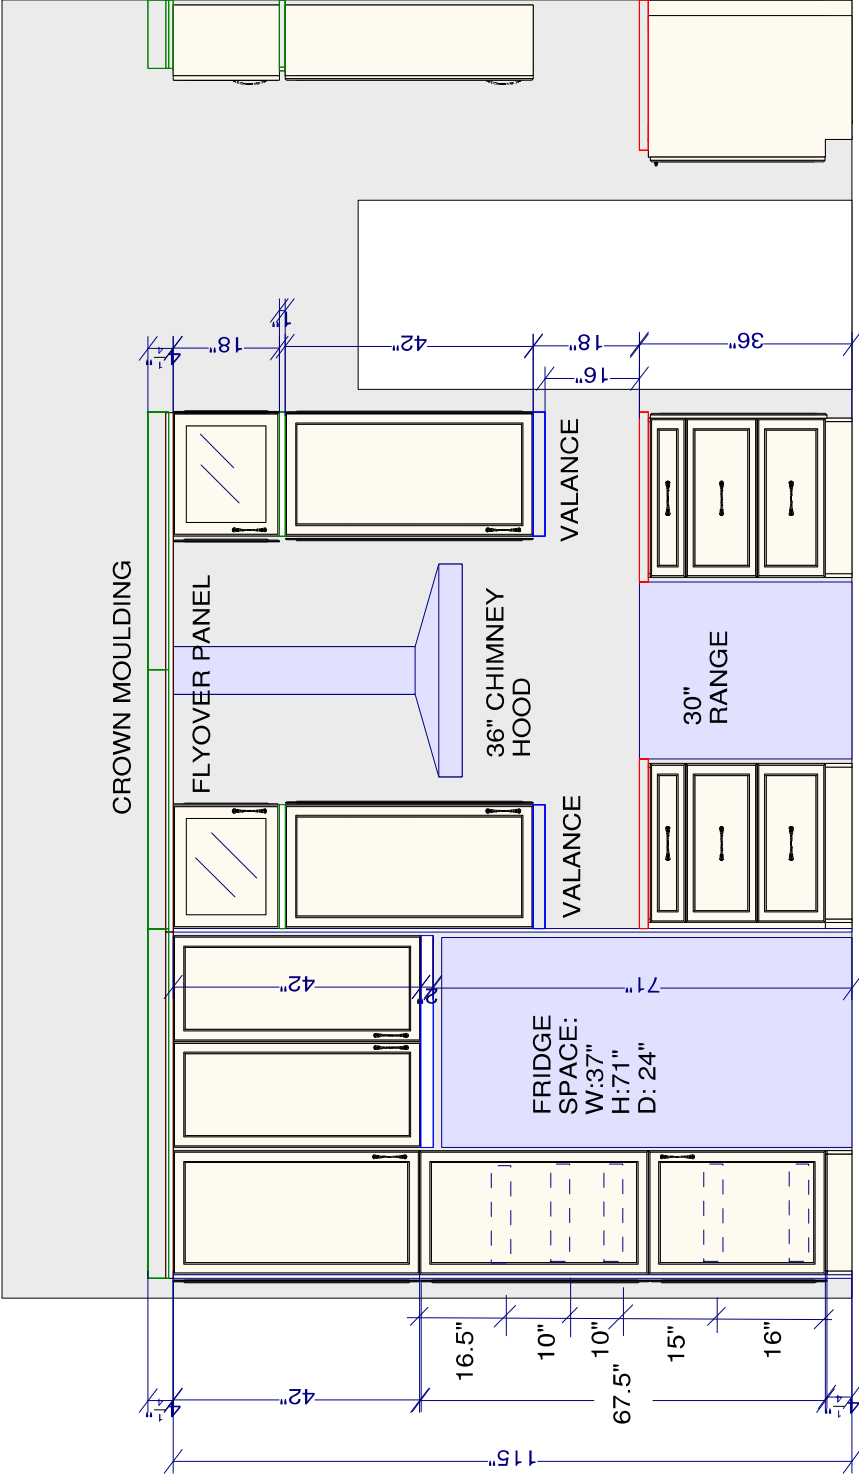

FRIDGE / RANGE WALL ELEVATION

REVISED: JUNE 28-23


CUSTOMER APPROVAL

I have reviewed these drawings and understand the details of the design and the CARTIER KITCHENS specifications.

Signature _____

Date _____

All dimensions .size designations given are subject to verification on job site and adjustment to fit job conditions.		This is an original design and must not be released or copied unless applicable fee has been paid or job order placed.	Designed: 2023-06-28 Printed: 2023-06-28
			
129 White Tail Ridge 4 - Springfield (Left) Kitchen 2 .kit		EI 2	Drawing #: 1 No Scale.

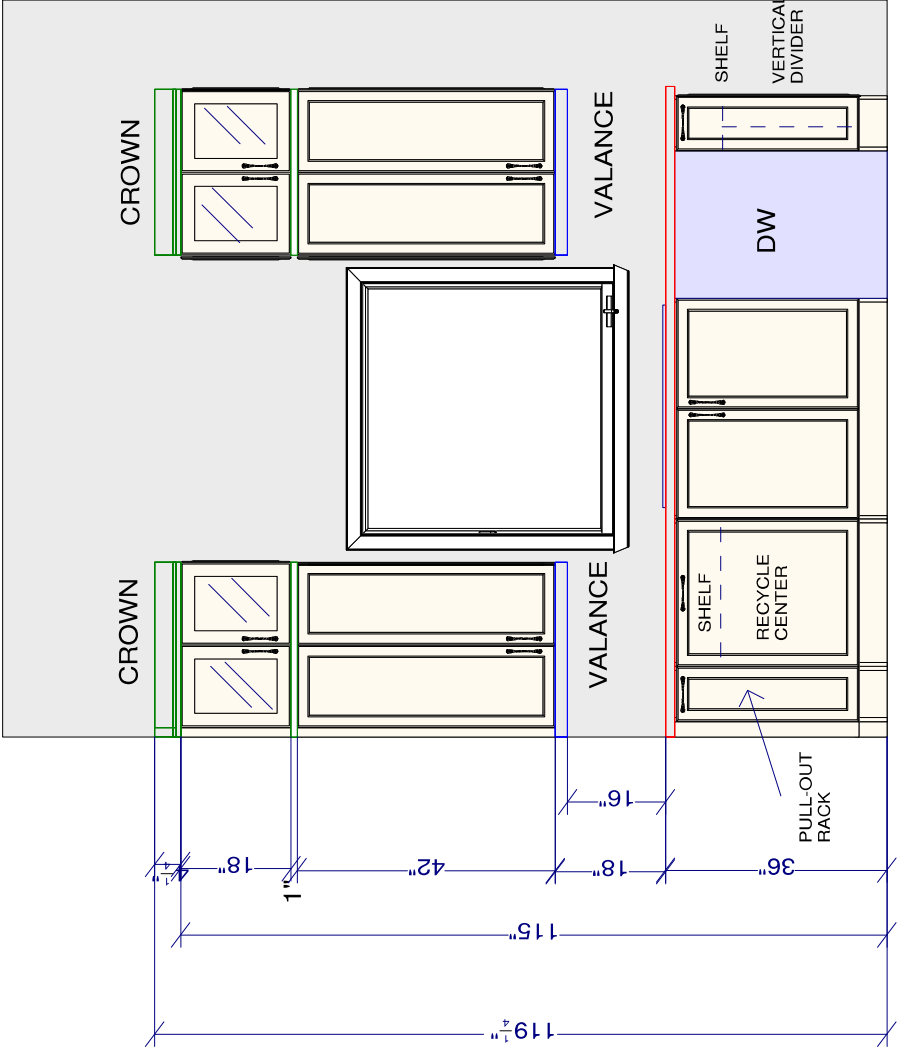

SINK WALL ELEVATION

REVISED: JUNE 28-23


CUSTOMER APPROVAL

I have reviewed these drawings and understand the details of the design and the CARTIER KITCHENS specifications.

Signature _____


Date _____

All dimensions .size designations given are subject to verification on job site and adjustment to fit job conditions.		This is an original design and must not be released or copied unless applicable fee has been paid or job order placed.	Designed: 2023-06-28 Printed: 2023-06-28
129 White Tail Ridge 4 - Springfield (Left) Kitchen 2 .kit			
129 White Tail Ridge 4 - Springfield (Left) Kitchen 2 .kit		El 1	Drawing #: 1 No Scale.

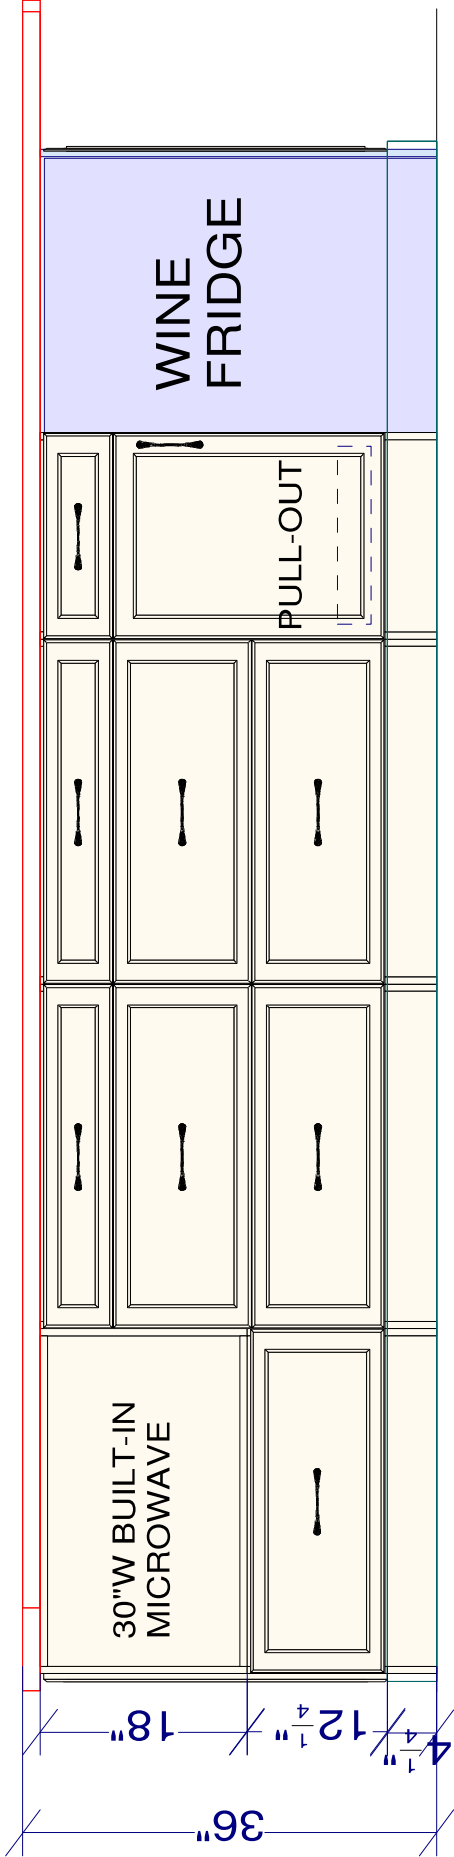

ISLAND ELEVATION

All dimensions .size designations given are subject to verification on job site and adjustment to fit job conditions.		This is an original design and must not be released or copied unless applicable fee has been paid or job order placed.	Designed: 2023-06-28 Printed: 2023-06-28	
				
129 White Tail Ridge 4 - Springfield (Left) Kitchen 2 .kit			El 3	Drawing #: 1 No Scale.

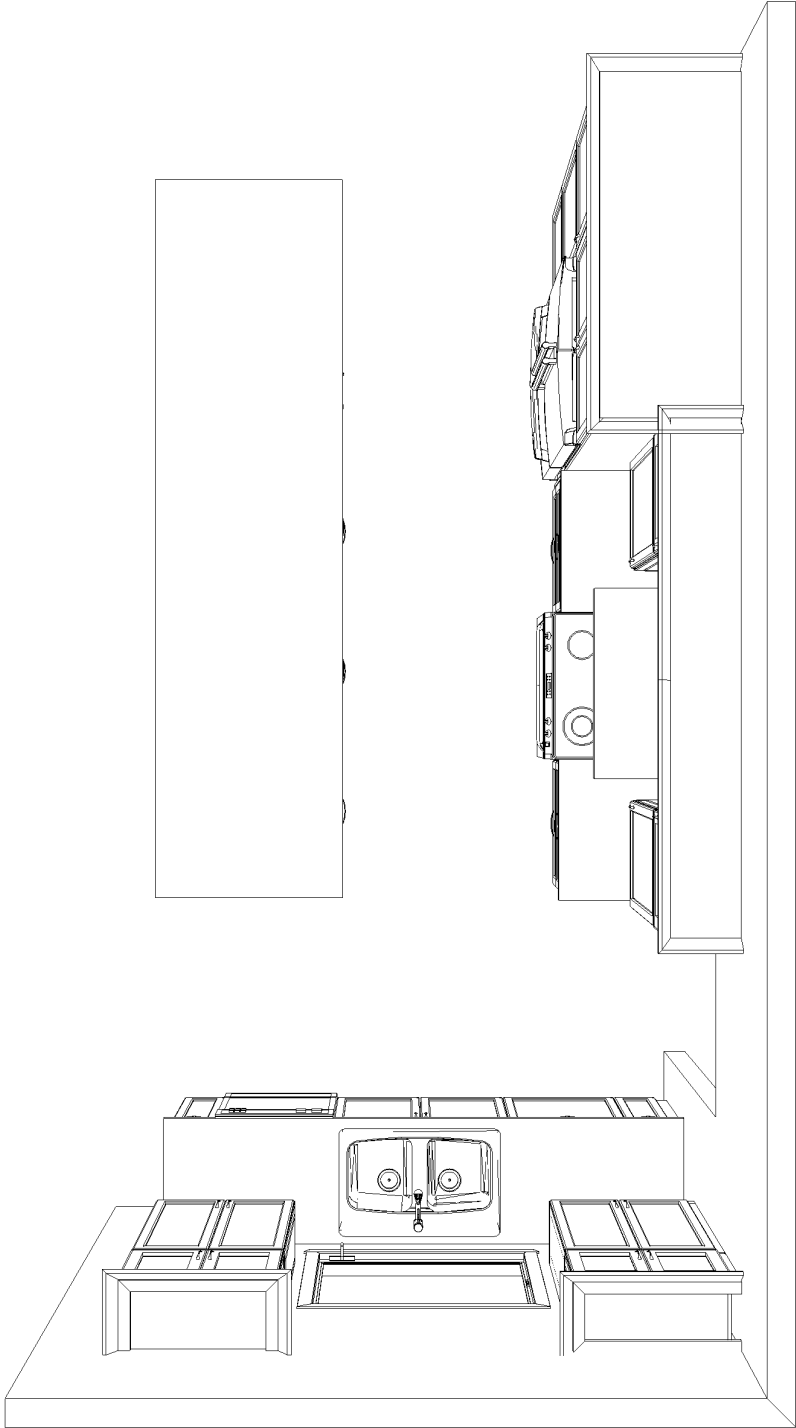

KITCHEN - TOP VIEW

REVISED: JUNE 28-23

CUSTOMER APPROVAL

I have reviewed these drawings and understand the details of the design and the CARTIER KITCHENS specifications.

Signature _____

Date _____

Note: This drawing is an artistic interpretation of the general appearance of the design. It is not meant to be an exact rendition.



Designed: 2023-06-28
Printed: 2023-06-28




129 White Tail Ridge 4 - Springfield (Left) Kitchen 2

All

Drawing #: 1

(X12) TOTAL DUMMY DOORS DELETED

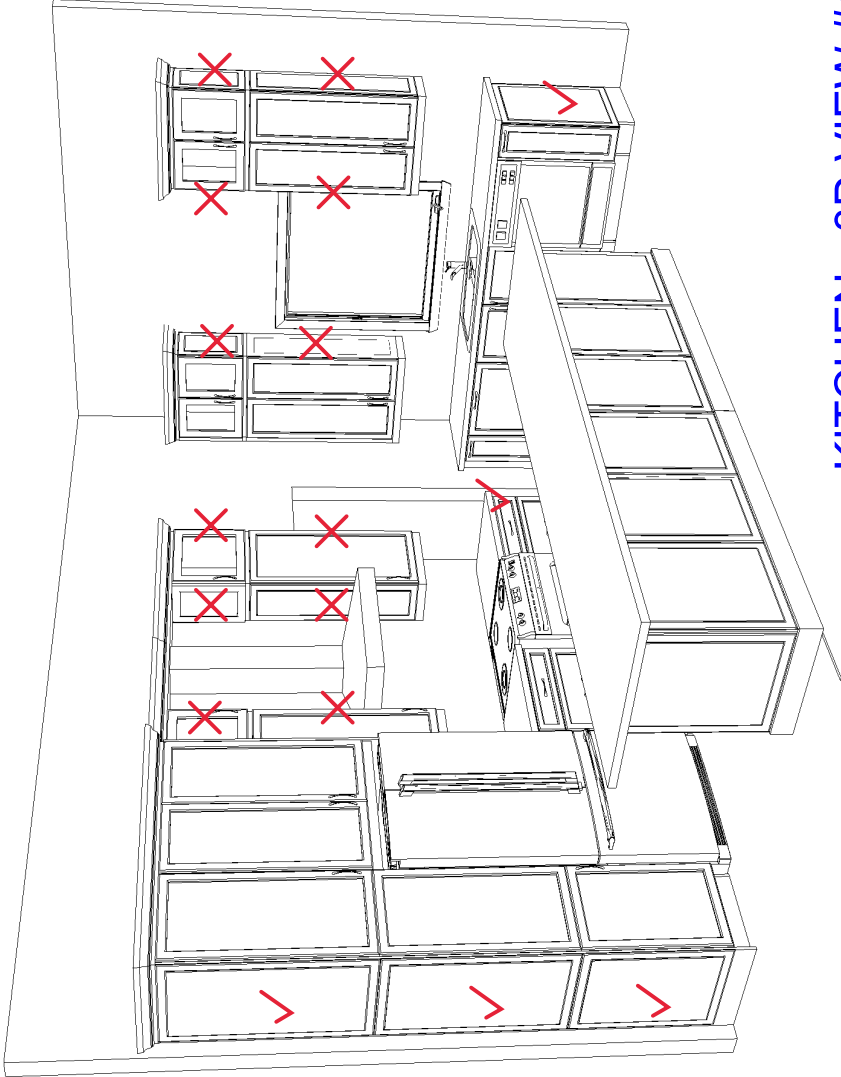

KITCHEN - 3D VIEW #1

REVISED: JUNE 28-23

CUSTOMER APPROVAL

I have reviewed these drawings and understand the details of the design and the CARTIER KITCHENS specifications.


Signature _____


Date _____

Note: This drawing is an artistic interpretation of the general appearance of the design. It is not meant to be an exact rendition.



Designed: 2023-06-28
Printed: 2023-06-28

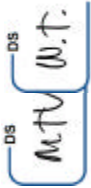

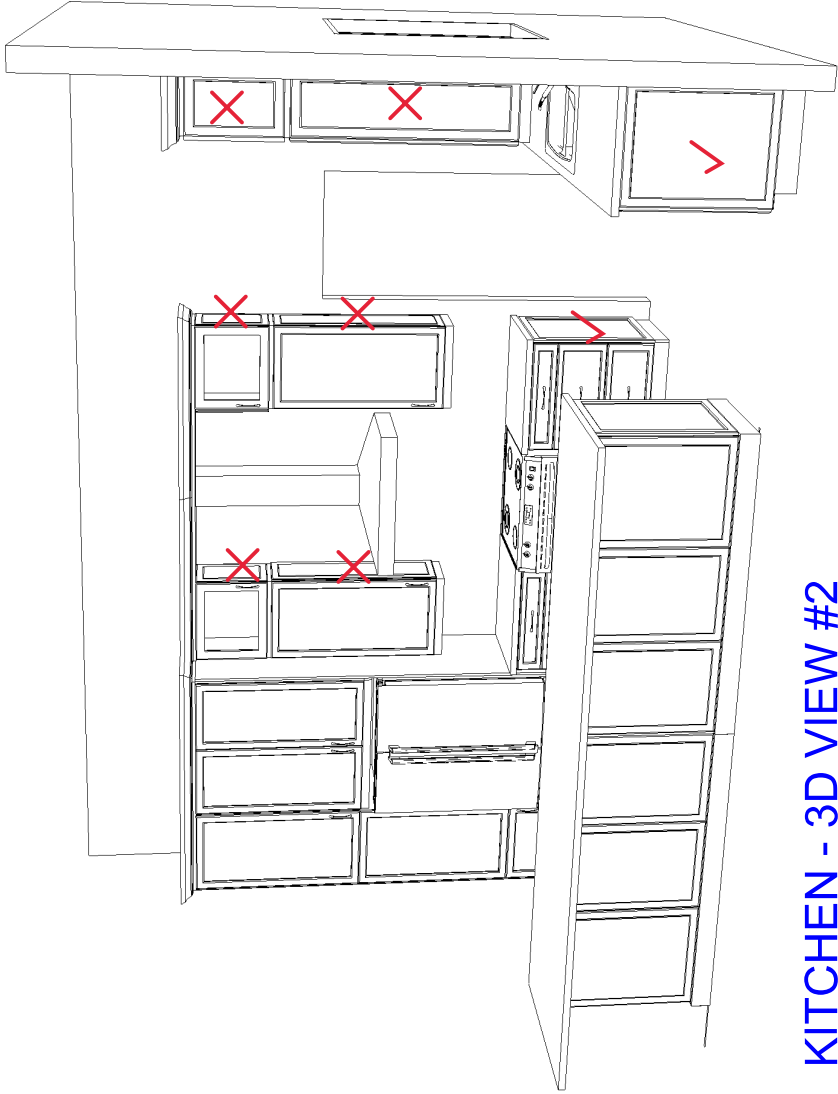

KITCHEN - 3D VIEW #2

REVISED: JUNE 28-23


CUSTOMER APPROVAL

I have reviewed these drawings and understand the details of the design and the CARTIER KITCHENS specifications.


Signature _____

Date _____

Note: This drawing is an artistic interpretation of the general appearance of the design. It is not meant to be an exact rendition.

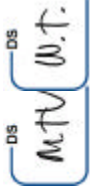

Designed: 2023-06-28
Printed: 2023-06-28

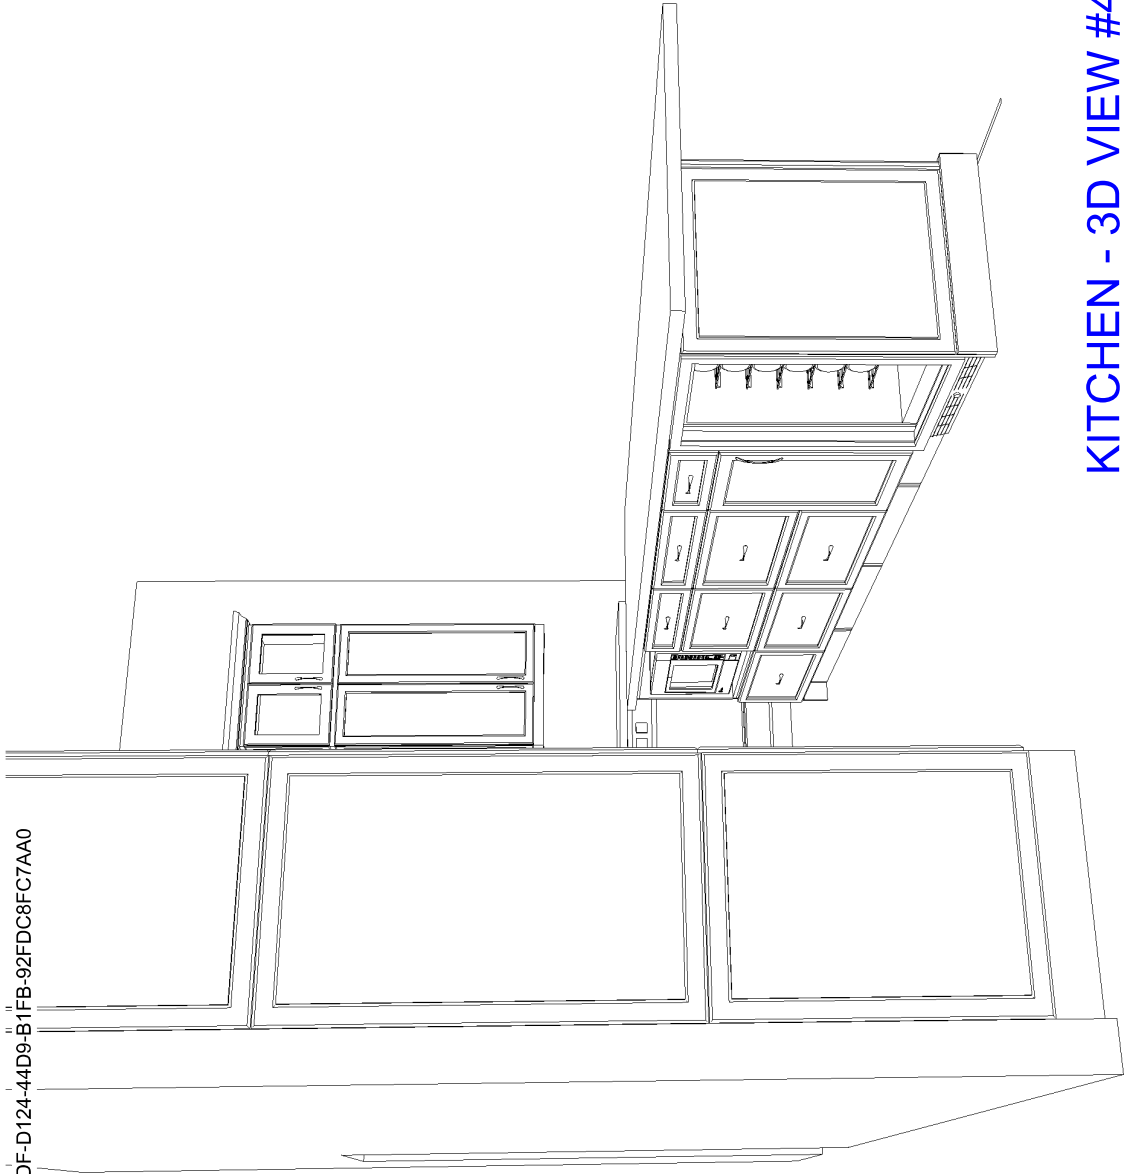

KITCHEN - 3D VIEW #4

REVISED: JUNE 28-23

CUSTOMER APPROVAL

I have reviewed these drawings and understand the details of the design and the CARTIER KITCHENS specifications.

Signature_____


Date_____

Note: This drawing is an artistic interpretation of the general appearance of the design. It is not meant to be an exact rendition.



Designed: 2023-06-28
Printed: 2023-06-28



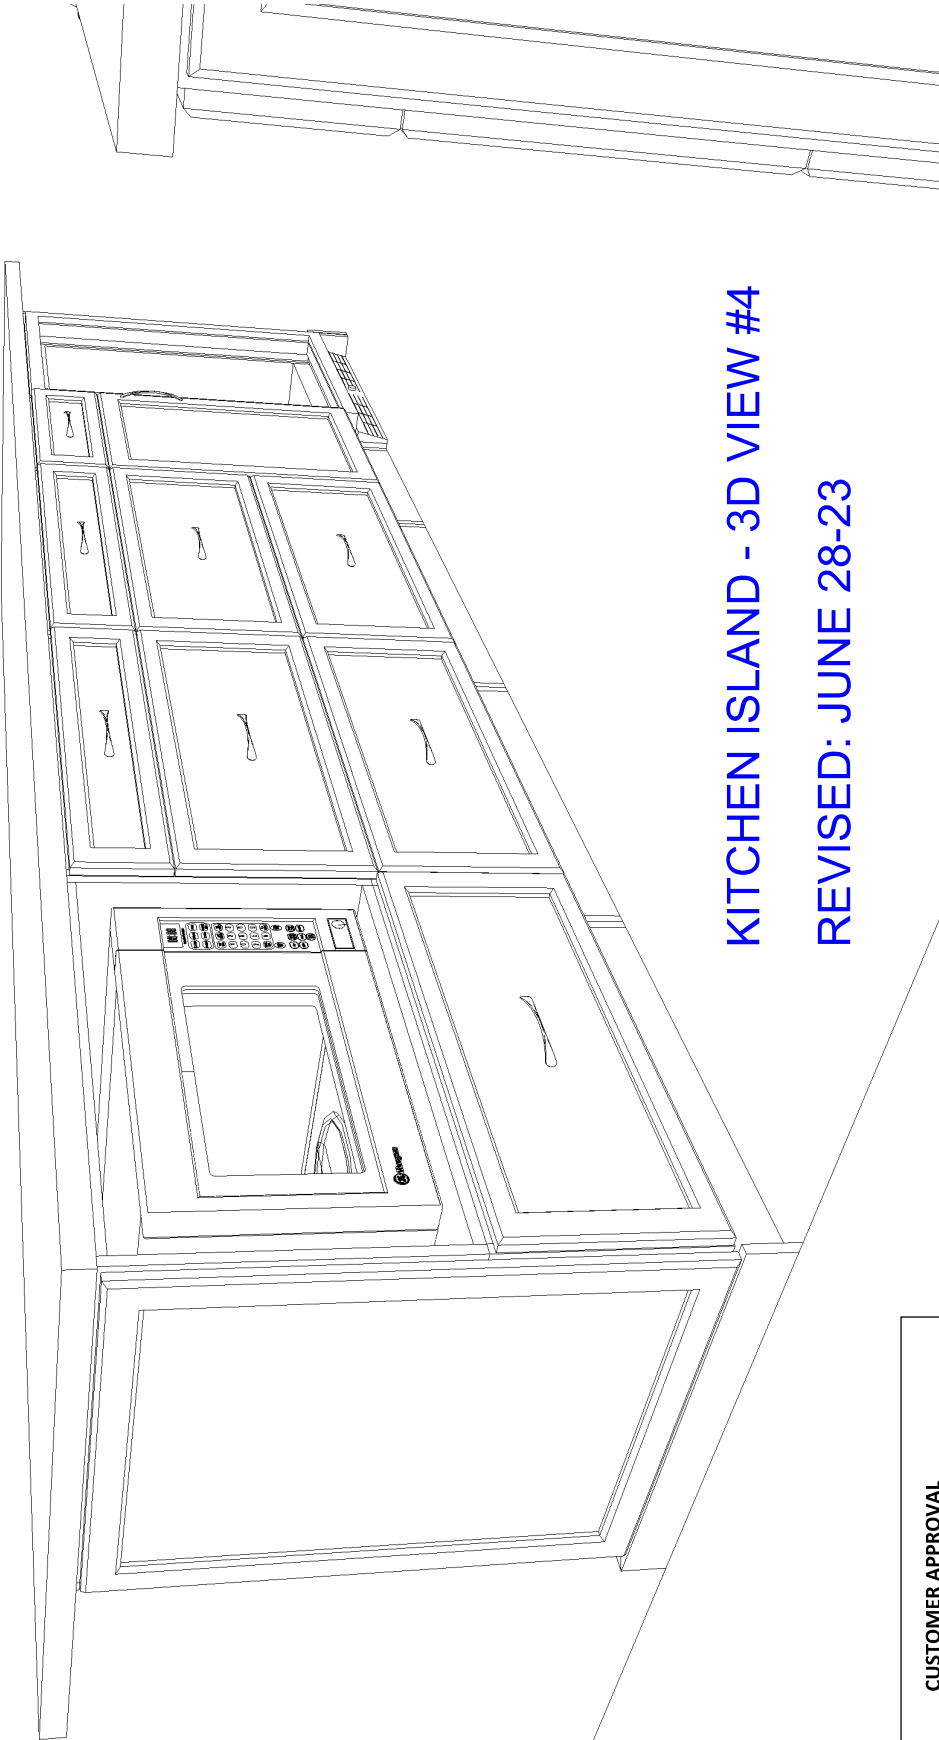

KITCHEN ISLAND - 3D VIEW #4

REVISED: JUNE 28-23

CUSTOMER APPROVAL

I have reviewed these drawings and understand the details of the design and the CARTIER KITCHENS specifications.

Signature_____

Date_____

Note: This drawing is an artistic interpretation of the general appearance of the design. It is not meant to be an exact rendition.



Designed: 2023-06-28
Printed: 2023-06-28



DCR PHOENIX HOMES

LOT #129
WHITE TAIL RIDGE 4
SPRINGFIELD
GARAGE LEFT

VANITIES / LAUNDRY / MUDROOM

CUSTOMER APPROVAL


I have reviewed these drawings and understand the details of the design and the CARTIER KITCHENS specifications.

Signature_____

Date_____


REVISED: NOV 30-23

MAIN BATH

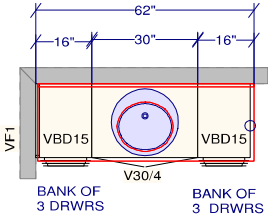


2ND BANK OF DRAWERS ADDED

PRIMARY ENSUITE

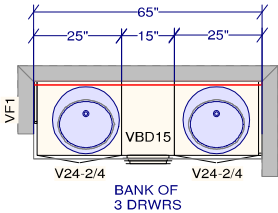

ACCOMODATE FOR 2 SINKS

BASEMENT VANITY


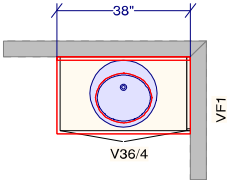


LAUNDRY ROOM

BASE CABINET & LAMINATE COUNTER FOR DROP-IN SINK

2 UPPER CABINETS 27"W x 42"H x 12"D

COUNTERTOP ABOVE WASHER/DRYER SPACE

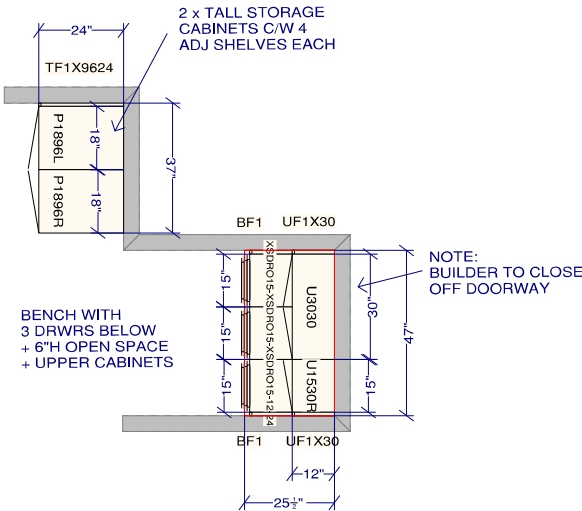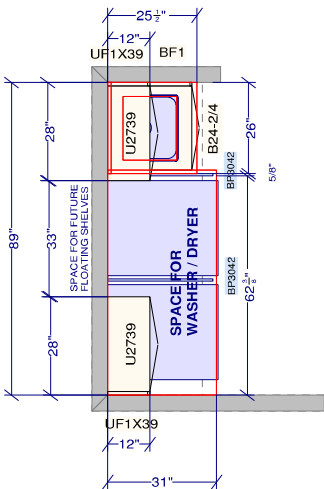



All dimensions _size designations given are subject to verification on job site and adjustment to fit job conditions.



This is an original design and must not be released or copied unless applicable fee has been paid or job order placed.

Designed: 2023-11-29
Printed: 2023-11-30

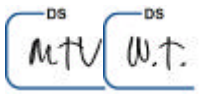

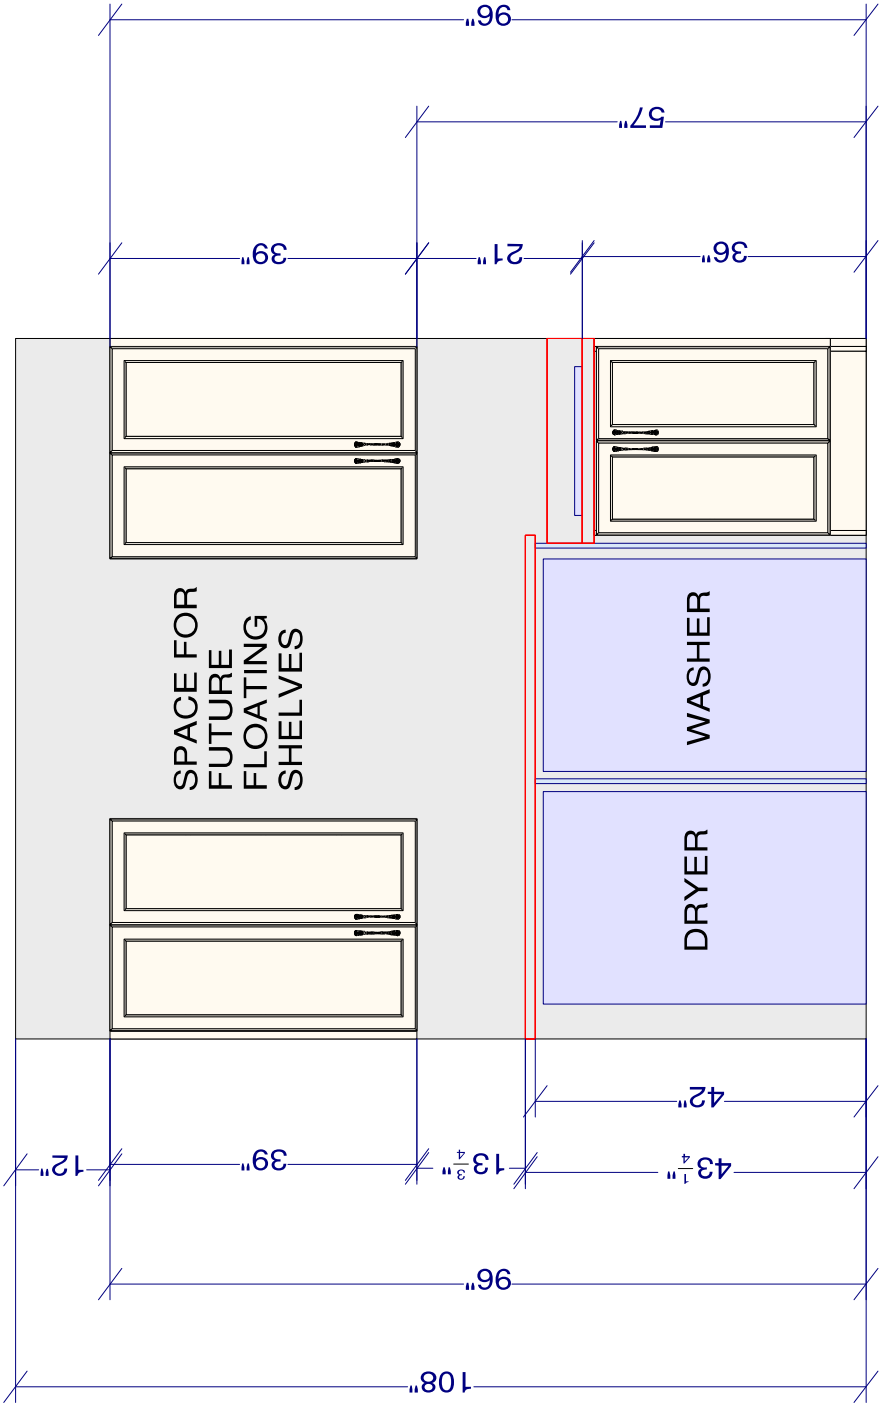

CUSTOMER APPROVAL

I have reviewed these drawings and understand the details of the design and the CARTIER KITCHENS specifications.

Signature_____

Date_____

LAUNDRY WALL ELEVATION


All dimensions _size designations given are subject to verification on job site and adjustment to fit job conditions.



This is an original design and must not be released or copied unless applicable fee has been paid or job order placed.

Designed: 2023-05-11
Printed: 2023-07-06



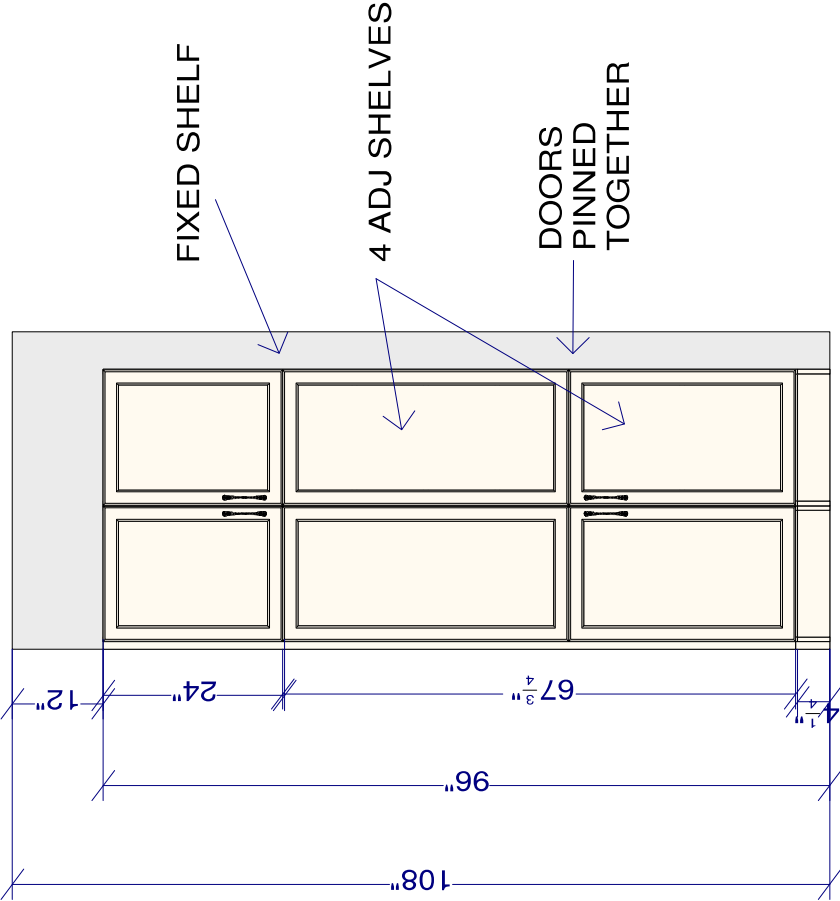

TALL STORAGE CABINETS ELEVATION

INCLUDES 4 ADJUSTABLE/ REMOVEABLE
SHELVES IN EACH

CUSTOMER APPROVAL

I have reviewed these drawings and understand the details of the design and the CARTIER KITCHENS specifications.

Signature_____

Date_____


All dimensions _size designations given are subject to verification on job site and adjustment to fit job conditions.



This is an original design and must not be released or copied unless applicable fee has been paid or job order placed.

Designed: 2023-05-11
Printed: 2023-07-06




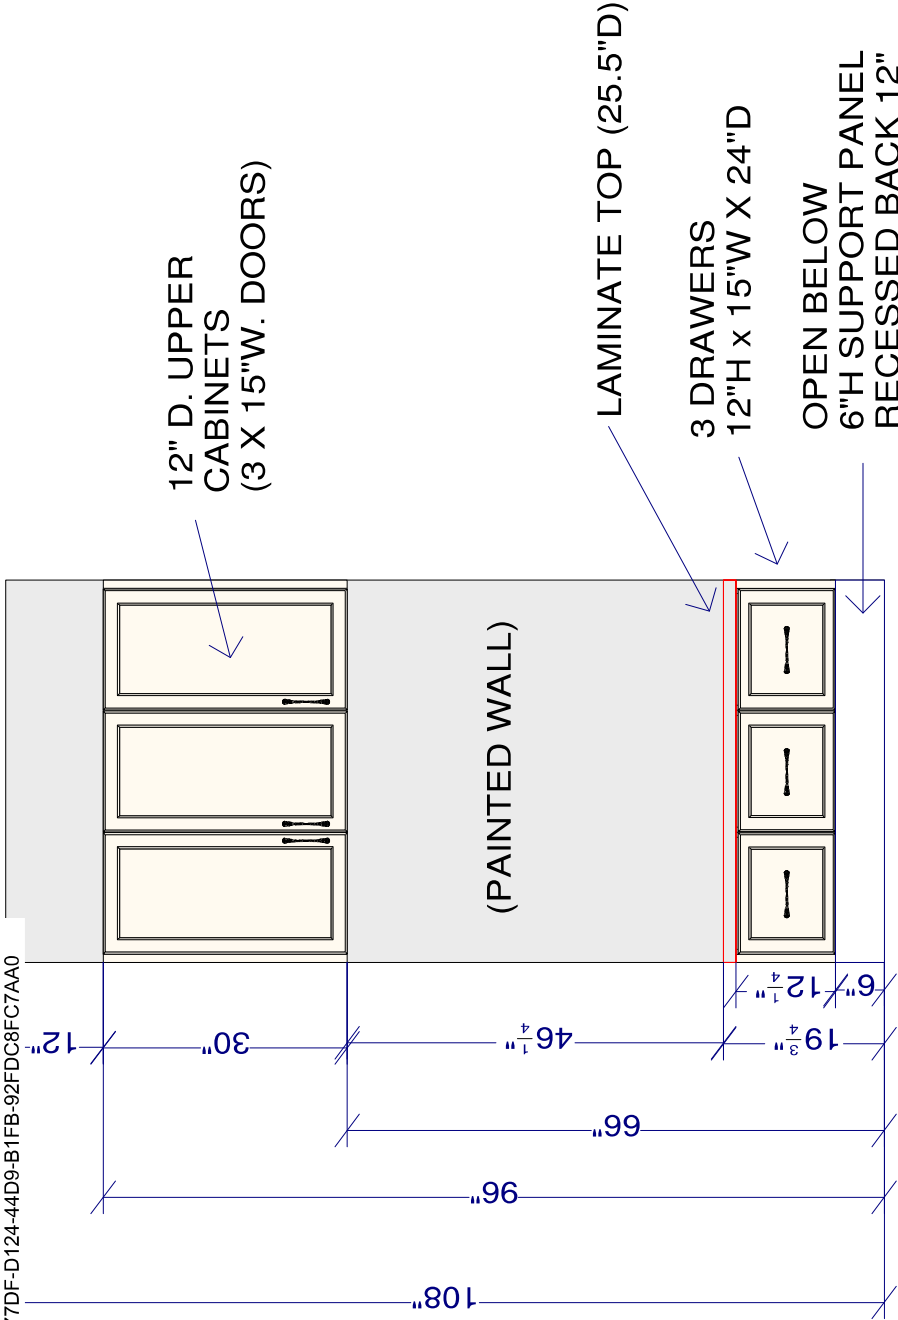

MUDROOM BENCH & UPpers ELEVATION

REVISED: NOV 29-23

CUSTOMER APPROVAL I have reviewed these drawings and understand the details of the design and the CARTER KITCHENS specifications. Signature _____ Date _____	All dimensions _size designations given are subject to verification on job site and adjustment to fit job conditions.	This is an original design and must not be released or copied unless applicable fee has been paid or job order placed.	Designed: 2023-11-29 Printed: 2023-11-29
			DS MTV W.T. DS Drawing #: 1 No Scale.

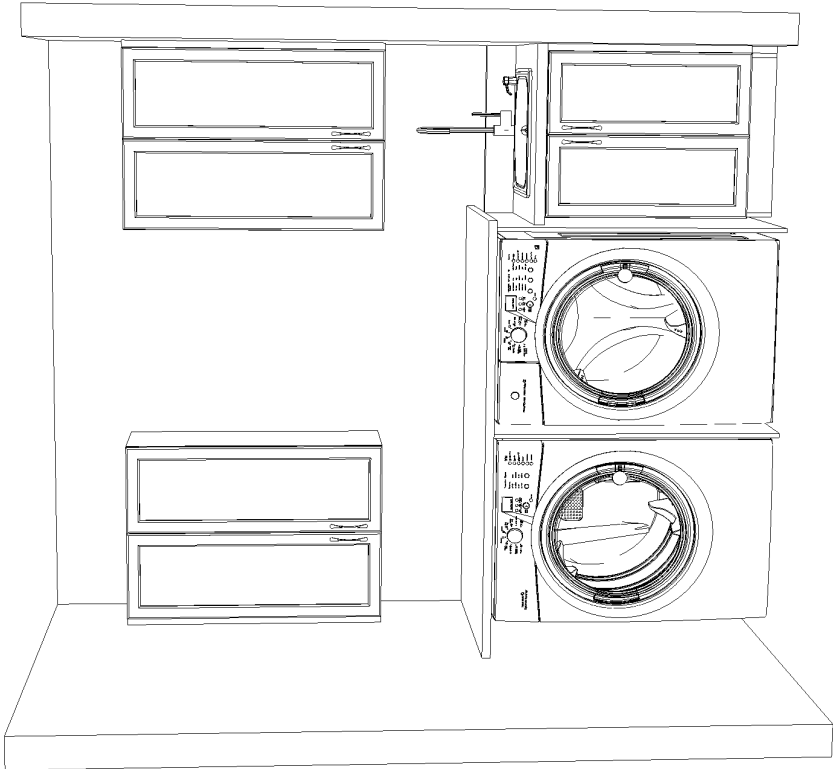

LAUNDRY CABINETS
3D VIEW

CUSTOMER APPROVAL

I have reviewed these drawings and understand the details of the design and the CARTIER KITCHENS specifications.

Signature _____

Date _____


Note: This drawing is an artistic interpretation of the general appearance of the design. It is not meant to be an exact rendition.



Designed: 2023-05-11
Printed: 2023-07-06



MUDROOM - 3D VIEW

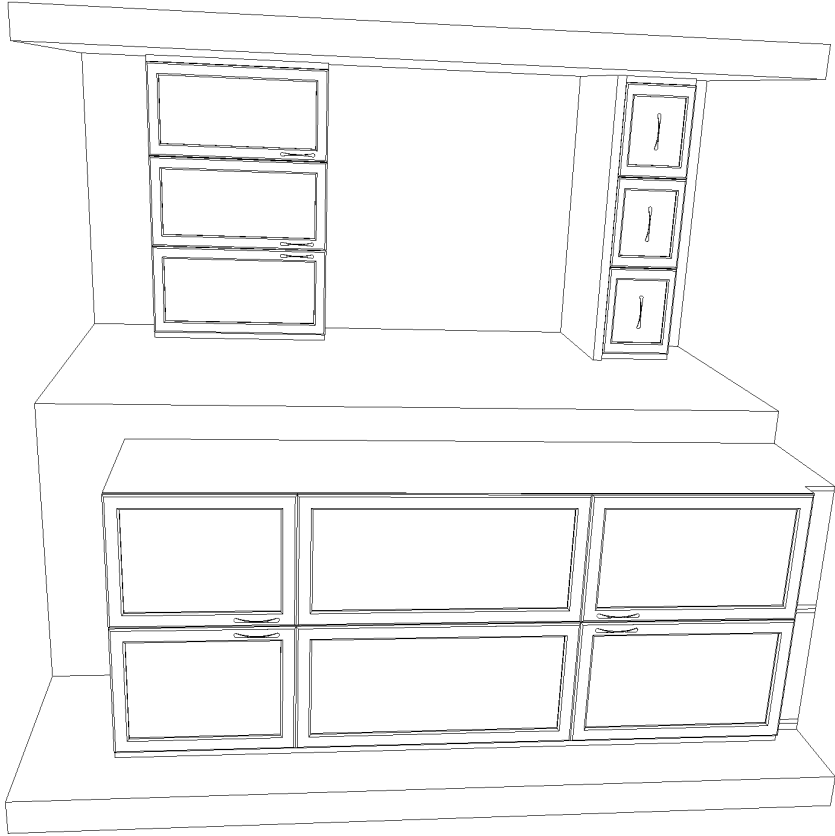

STORAGE CABINET

MUDROOM BENCH
& UPPERS

REVISED: NOV 29-23

CUSTOMER APPROVAL

I have reviewed these drawings and understand the details of the design and the CARTIER KITCHENS specifications.


Signature

Date


Note: This drawing is an artistic interpretation of the general appearance of the design. It is not meant to be an exact rendition.		Designed: 2023-11-29 Printed: 2023-11-29	
			
		129 WTR4 - Springfield (Left) - Vanities Laundry	All

VANITIES - 3D VIEW (ALL STANDARD HEIGHT)


REVISED: NOV 30-23

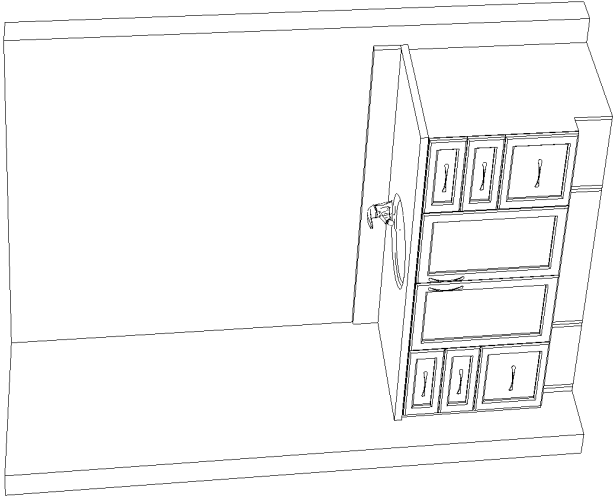

MAIN BATH

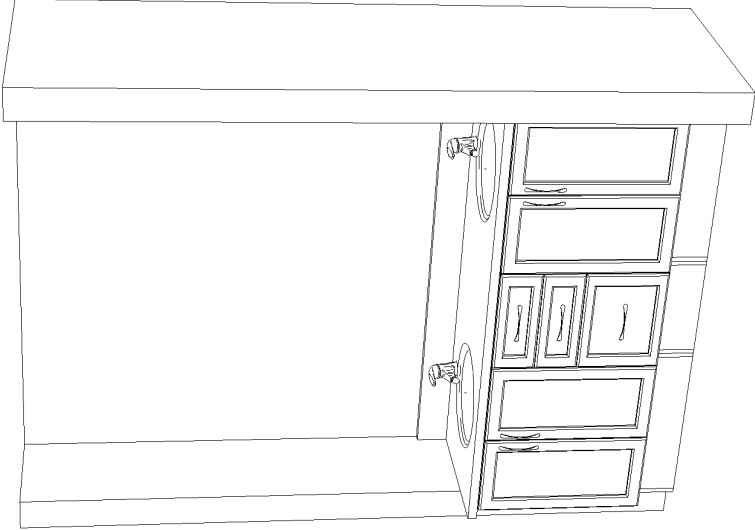

PRIMARY ENSUITE

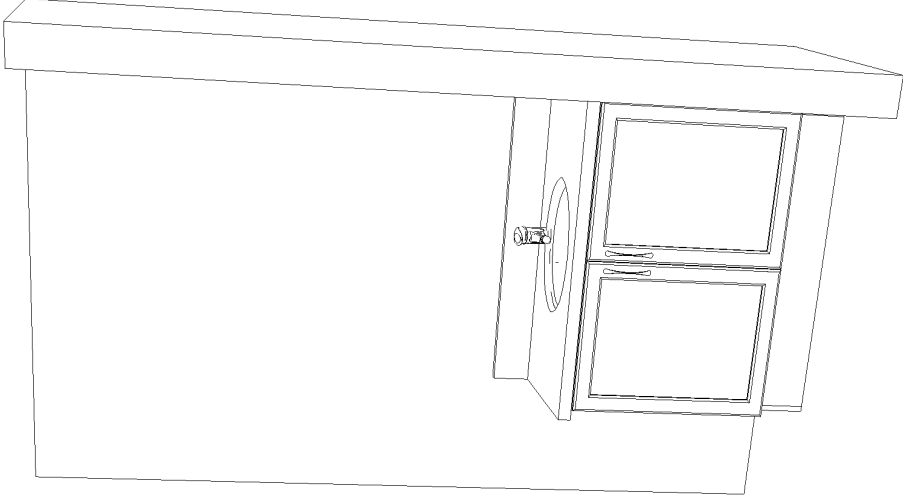

BASEMENT

CUSTOMER APPROVAL

I have reviewed these drawings and understand the details of the design and the CARTIER KITCHENS specifications.

Signature _____

Date _____

Note: This drawing is an artistic interpretation of the general appearance of the design. It is not meant to be an exact rendition.



Designed: 2023-11-29
Printed: 2023-11-30

