



MIN. PARKING SPACE
2.6M X 5.2M

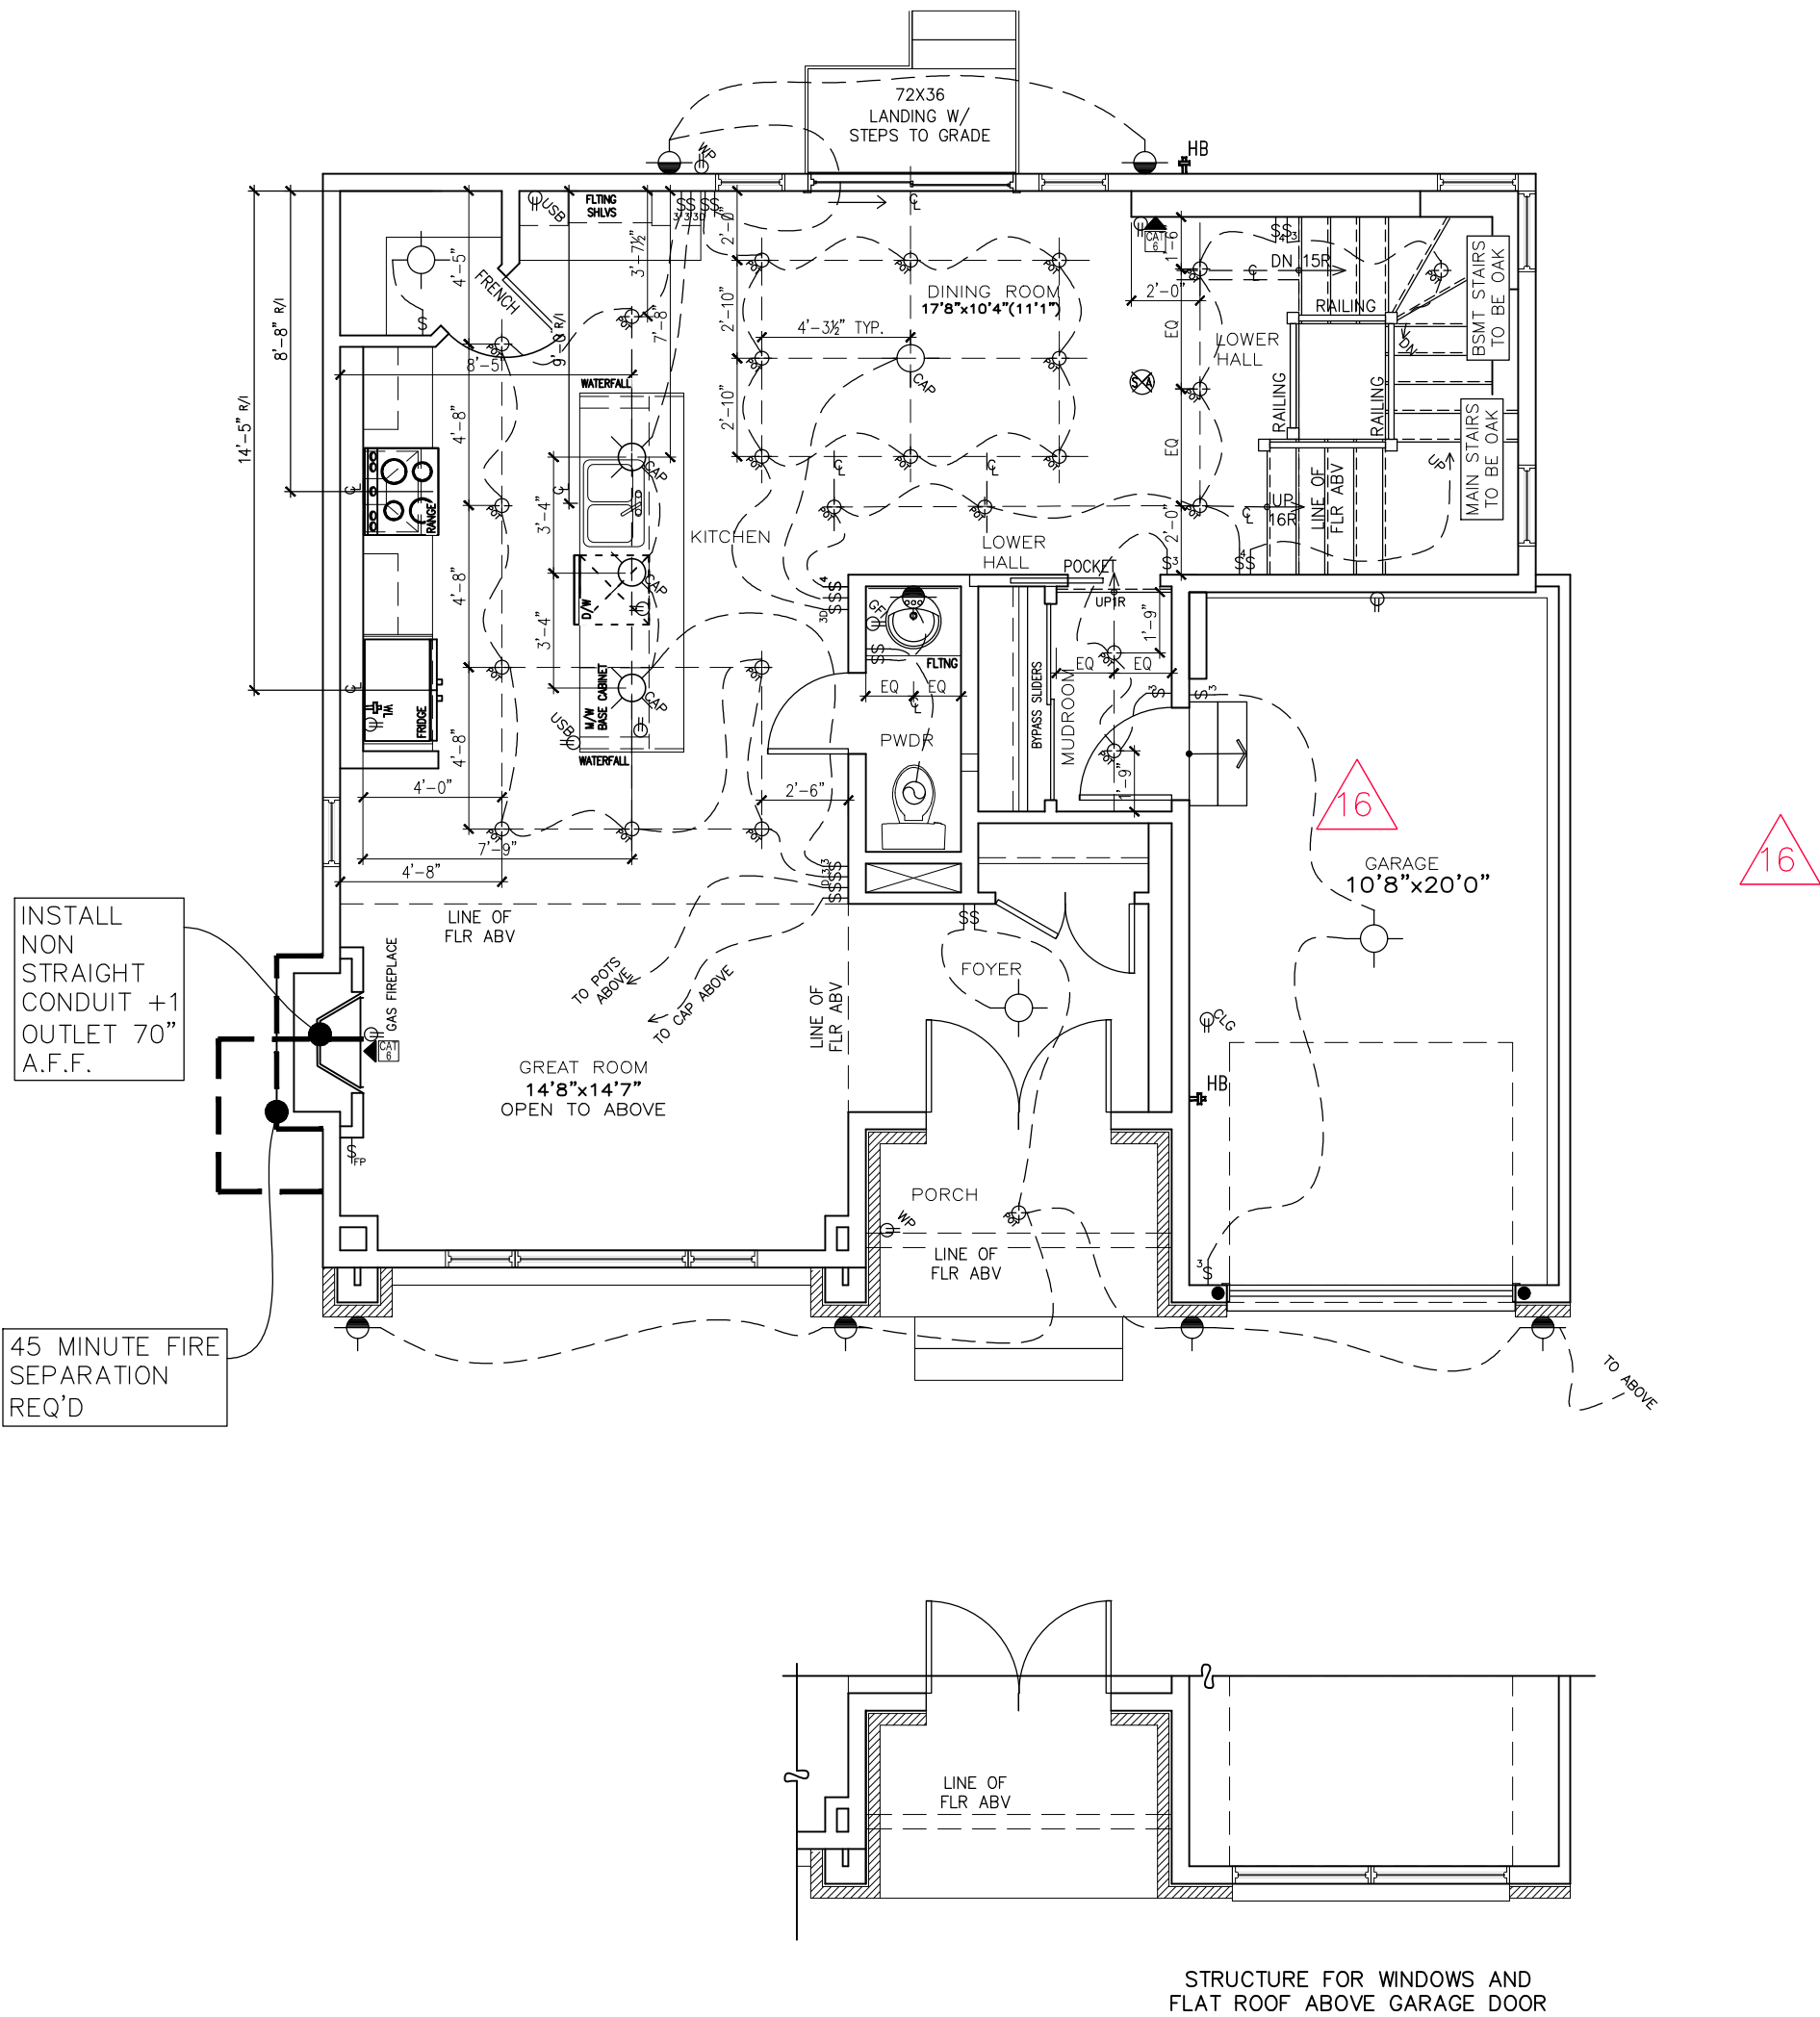

GROUND FLOOR PLAN
885 SQ. FT.

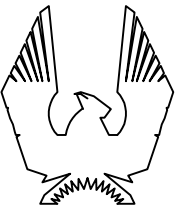

PHOENIX HOMES

THREE STOREY SINGLE

SITE: DUVERNAY DRIVE

LOT NUMBER: 489

CIVIC ADDRESS:
489 DUVERNAY DRIVE

17	REV FND REINFORCING AT STAIRS EXTENDED	27/05/24	CB
16	REV SUNKEN MUDROOM FLOOR	16/05/24	CB
15	REV ENSUITE WINDOW & CAP LIGHT LOCATIONS	08/05/24	CB
14	ISSUED FOR CONSTRUCTION	07/05/24	CB
13	REVISED ELECTRICAL	26/03/24	CB
12	FOOTING REVISION – LEFT ELEVATION	02/10/23	CB
No.	Description	dd/mm/yy	By
REVISIONS			

489 DUVERNAY DR.	
drawn by:	CB
date:	FEB/23
scale:	3/16"=1'-0"
sheet no:	3A 13