

DCR PHOENIX HOMES

PATHWAYS



NUVO - TERRACE HOMES

BLDG 6 - LOWER UNIT #136


33H SALAMANDER WAY

JULY 29, 2024
AS PER SITE MEASURE


CLIENT ACCEPTANCE - AS PER EMAIL 30 AUG 2024

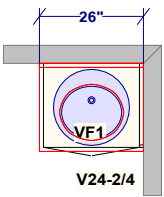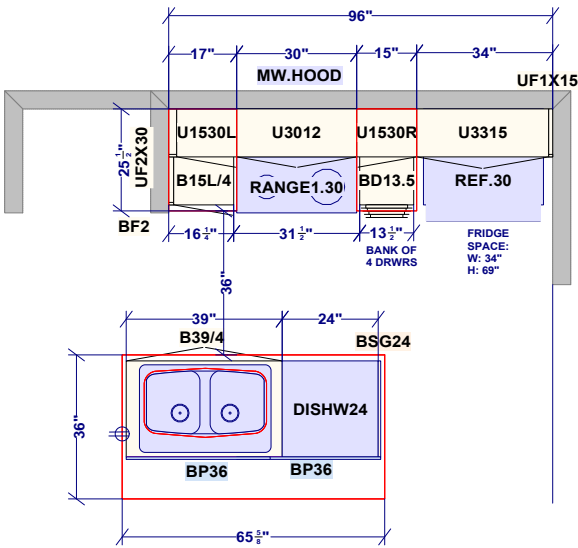

POWDER ROOM

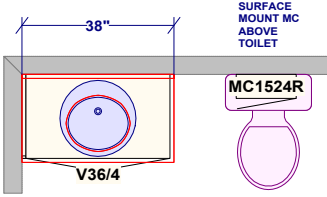

MAIN BATH

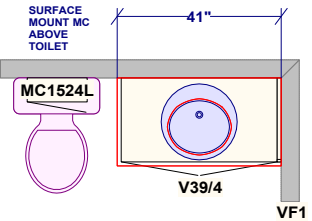

ENSUITE

All dimensions .size designations given are subject to verification on job site and adjustment to fit job conditions.



This is an original design and must not be released or copied unless applicable fee has been paid or job order placed.

Designed: 5/23/2024
Printed: 7/29/2024