



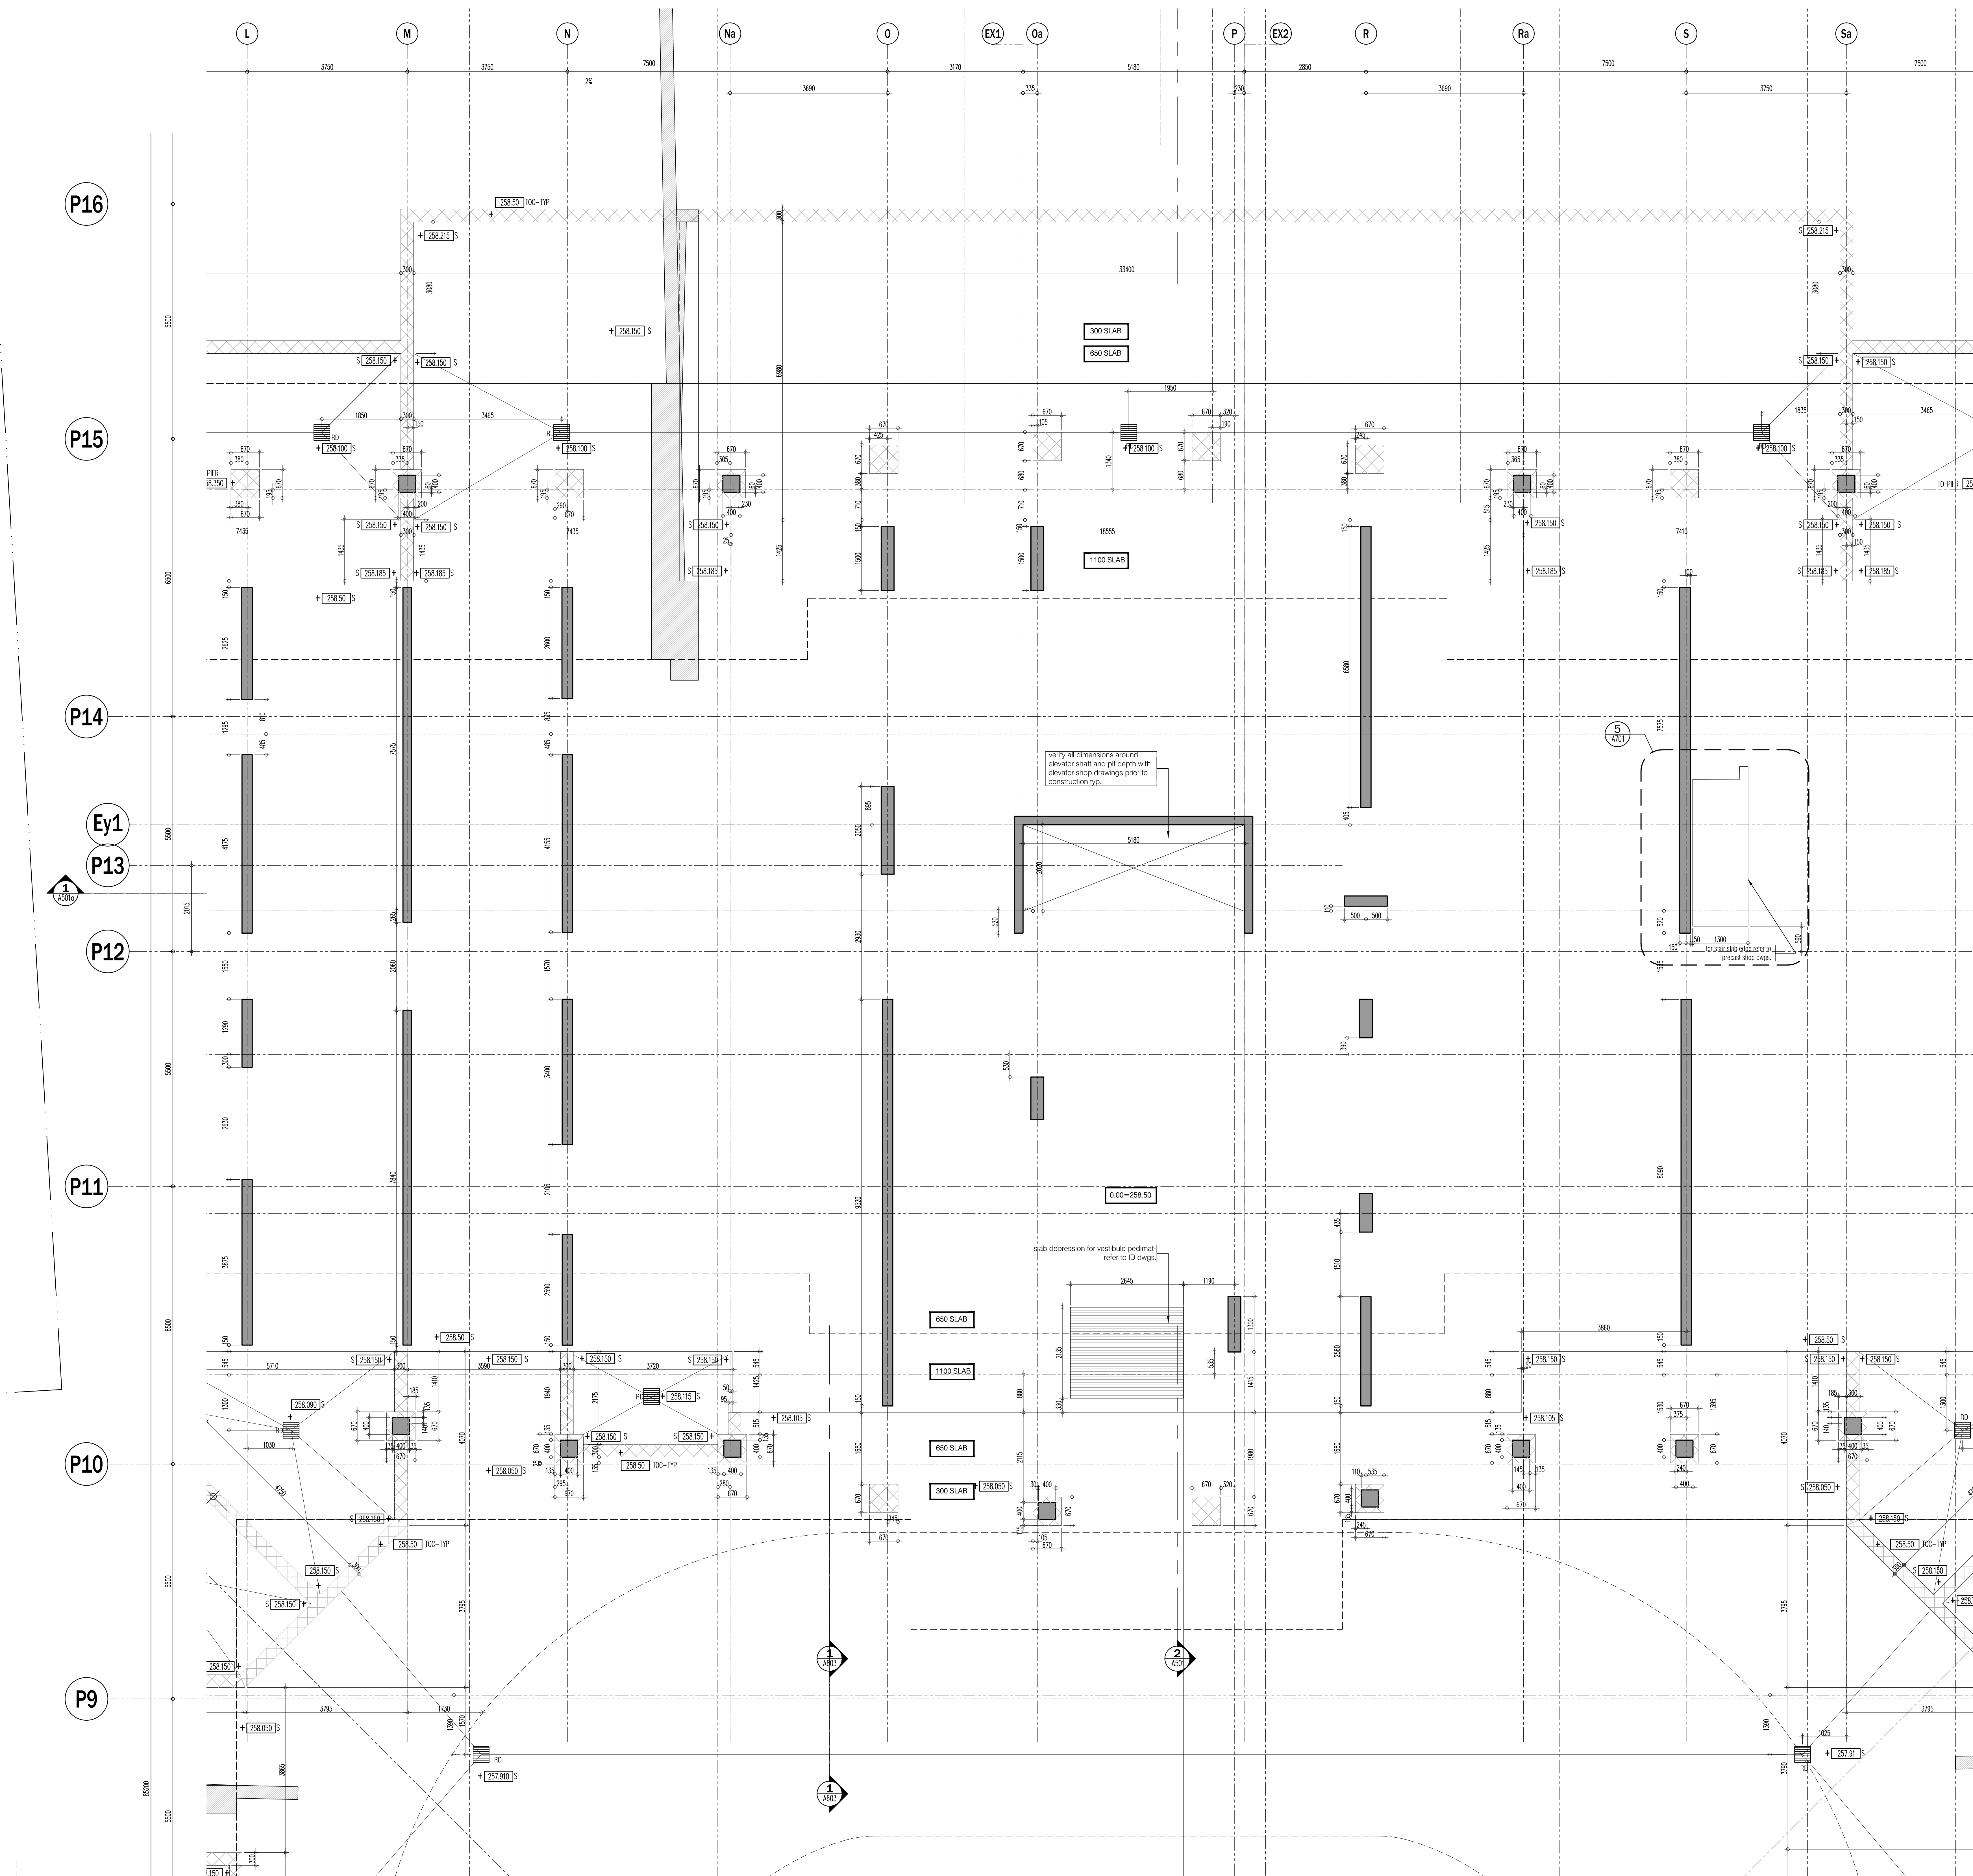

This drawing, as an instrument of service, is provided by and is the property of Grazianni & Corazza Architects Inc. The architect must verify and accept responsibility for all dimensions and conditions on site and must notify Grazianni & Corazza Architects Inc. of any variations from the approved information. Grazianni & Corazza Architects Inc. is not responsible for the accuracy of survey, structural, mechanical, electrical, etc., engineering information shown on this drawing. When the structural engineering drawings are provided to the client, the structural engineer must confirm to all applicable codes and requirements of the authorities having jurisdiction. Other relevant codes, as highlighted, have been considered or reported on by this office in regard to the environmental condition of the site. This drawing is not to be used for construction purposes until counterchecked by the architect.

01.	FEB.28.2014	issued to city for SPA	B.G.
02.	JUL.9.2014	re-issued to city for SPA	B.G.
03.	SEP.11.2014	re-issued to city for SPA	B.G.
04.	JAN.15.2015	re-issued to city for SPA	B.G.
05.	MAR.15.2015	issued for tender	B.G.
06.	DEC.28.2016	issued for building permit	B.G.
07.	MAY.10.2017	re-issued for building permit	B.G.
08.	MAY.10.2017	issued for Footings and Foundation Permit	B.G.
09.	JULY.07.2017	issued for Construction	B.G.
10.	JULY.19.2017	Progress for Construction	B.G.
11.	OCT.25.2017	Revision to Envelope	B.G.
12.	NOV.08.2017	Added Dimensions	B.G.

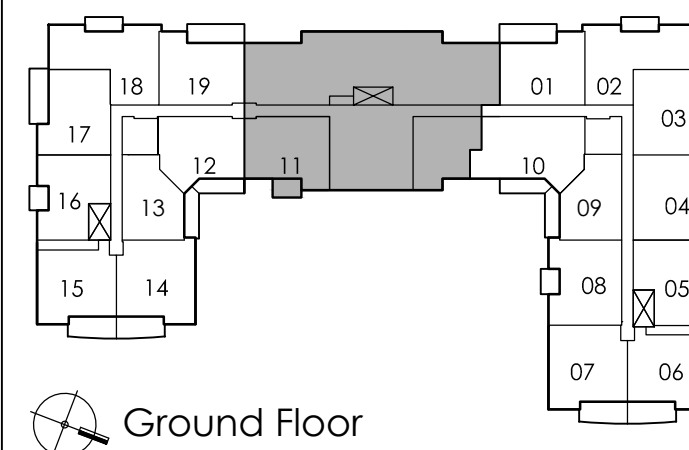

01. AUG.25.2017 5104 EXTENDED GROUND STRUCTURAL SOFFIT B.G.
issued for revisions

GRAZIANI
CORAZZA
ARCHITECTS INC.

1337 Denison Street, Suite 105, Richmond Hill, Ontario L4B 1C1
Phone: 905.705.2671 Fax: 905.705.3544 www.grazianni.com

PROPOSED RESIDENTIAL DEVELOPMENT

25 BAKER HILL BLVD.

STUFFVILLE ONTARIO

ROYAL PINES HOMES

Project Architect: B. GRAZIANI
Assistant Designer: R. LINCOLN
Drawn By: S.G.
Checked By: G. COLANGELO/D.B.I.A.E.
Plot Date: Nov. 8, 2017
Job #: 1134.1.3

GROUND FLOOR PLAN ENLARGED CS PART PLAN

1:50 CS301b

TITLEBLOCK SIZE: 915 x 1400