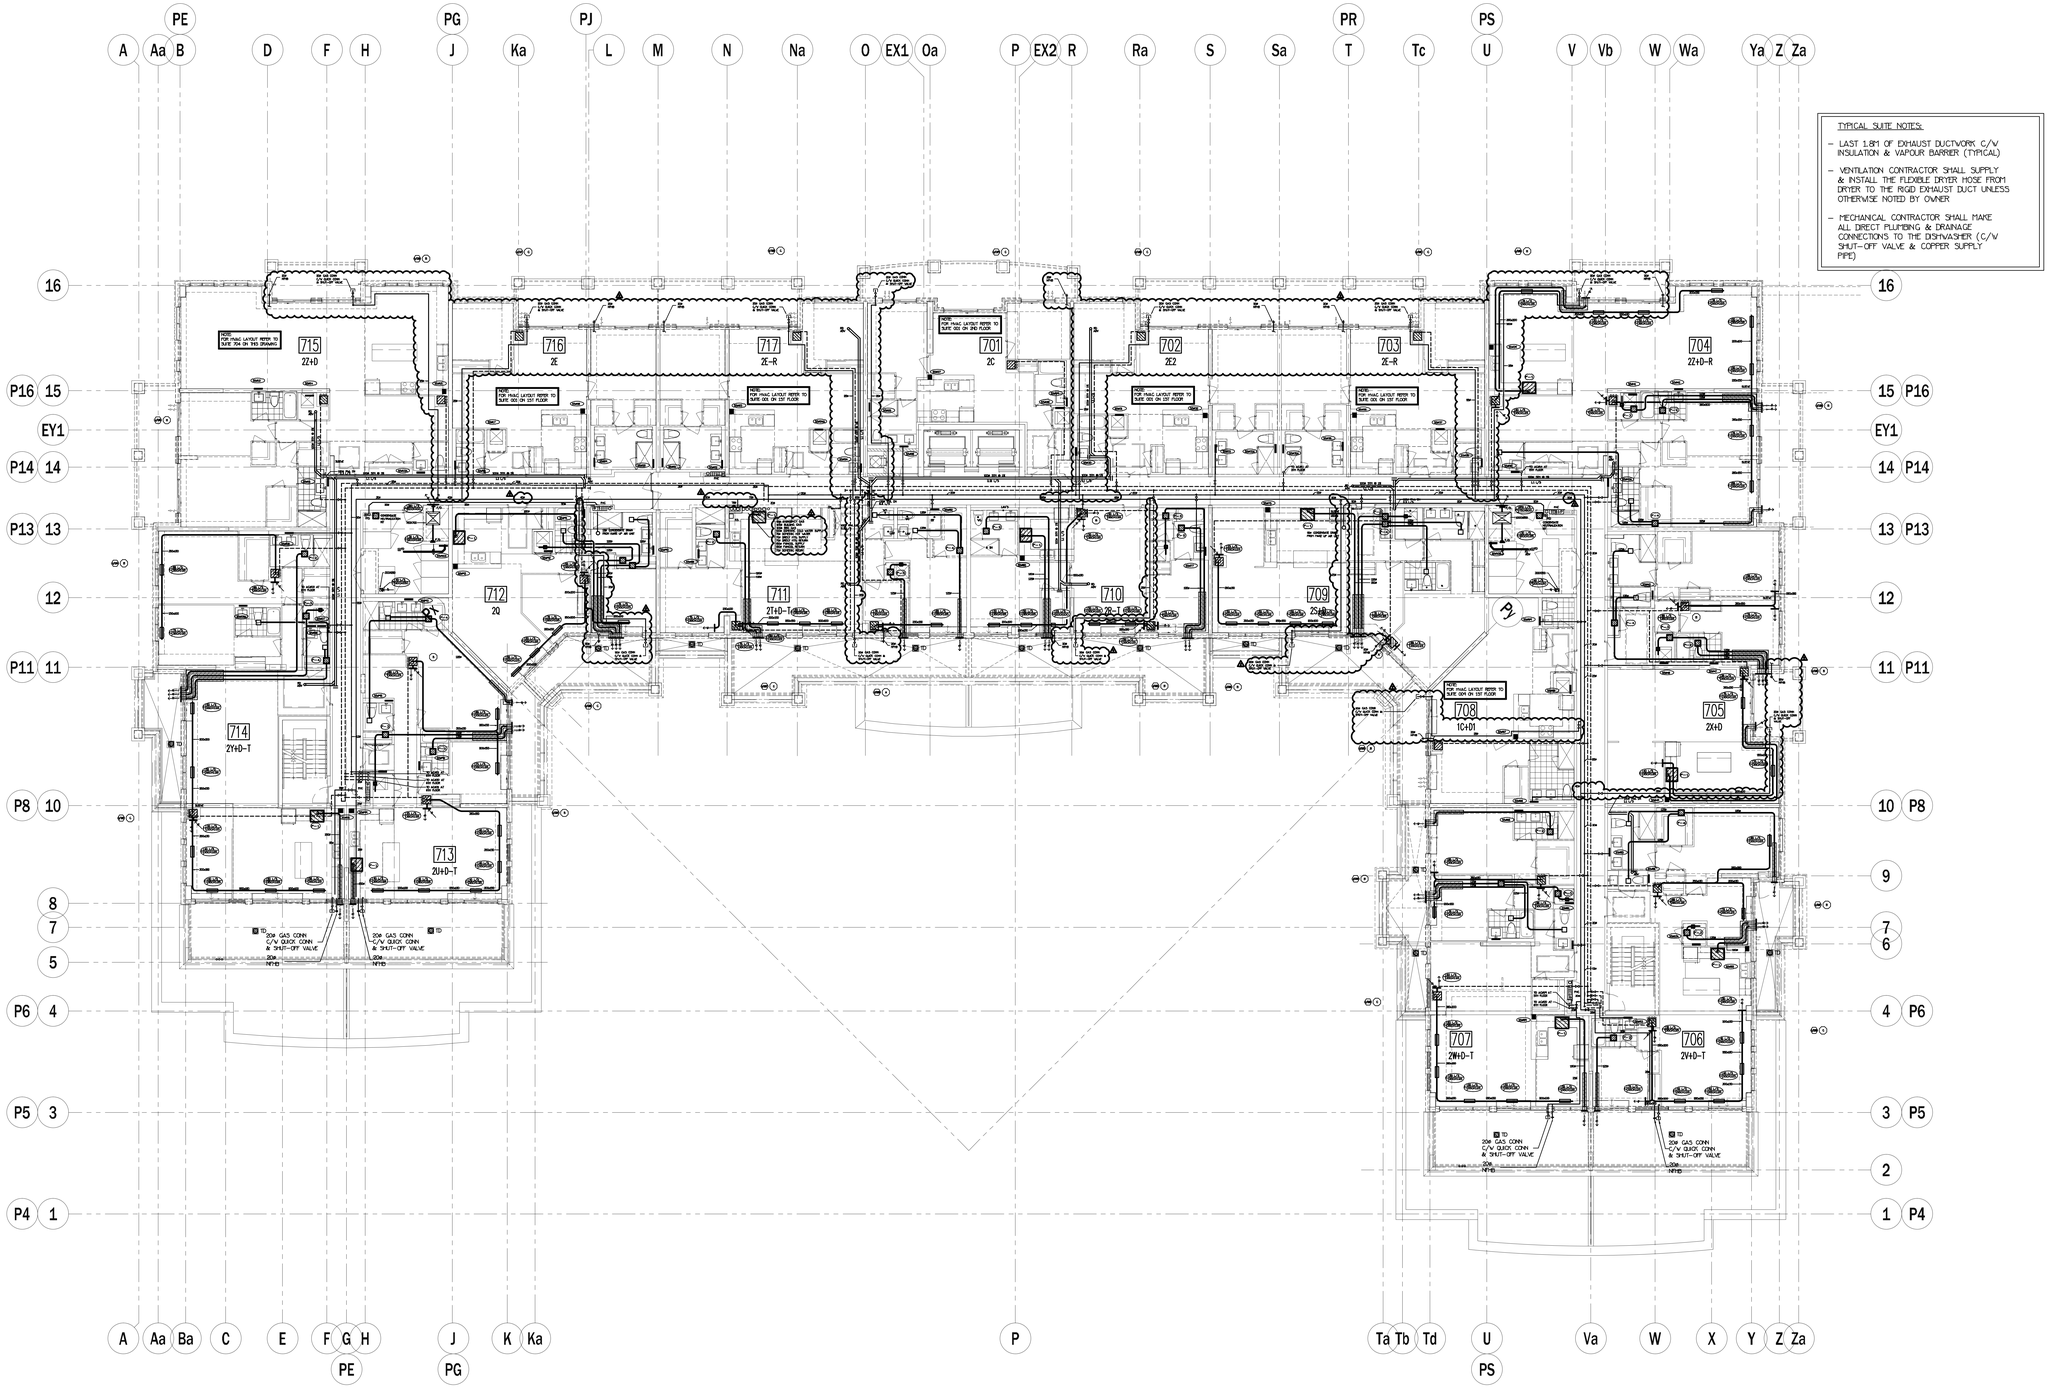

NOTE: FULLY SPRINKLERED BUILDING FOR FIRE PROTECTION DESIGN PLEASE REFER TO DISANO SPRINKLER DESIGN LIMITED DRAWINGS.

NO.	BY	DESCRIPTION	DATE
2	GP	REVISED AS PER SITE INSTRUCTION M-2	AUG/18/2016
1	LH	ISSUED FOR TENDER	MAR/31/2016

REVISIONS

This drawing, is an instrument of service, is provided by and is the property of United Engineering Inc. The contractor must verify and accept responsibility for all dimensions and conditions on site and must notify United Engineering Inc. of any discrepancy before proceeding.
United Engineering Inc. is not responsible for the accuracy of Architectural, structural, interior design, etc. on this drawing.
Refer to the appropriate trade drawings before proceeding with any work. Installation must conform to all applicable codes and requirements of the authorities having juriadiction.
This drawing is not to be scaled, all symbols are graphic representations only.

Y. HOU 100117097 LICENSED PROFESSIONAL ENGINEER PROVINCE OF ONTARIO

United Engineering Inc.
Mechanical Electrical Consulting Engineers
5045 Keele Street, Suite 105,
Toronto, Ontario, M3J 1N6
Tel: (416) 598 1999, Fax: (416) 598 1933

TITLE
PART 7TH FLOOR PLAN MECHANICAL

PROJECT
25 BAKER HILL BLVD.
ROYAL PINE HOMES
STOUFFVILLE, ONTARIO
PROPOSED RESIDENTIAL DEVELOPMENT

DRAWN	CHECKED	SCALE
GC	BT	1:100
DATE	PROJECT	DRAWING
JUNE 2015	14-016	M-30
		OF 42