GRAZIANI + CORAZZA ARCHITECTS INC.

# Site Instruction

| SI 13 | |
|---|---|
| PROJECT | : Hampton Manor |
| PROJECT No | : 1136.13 |
| DATE | : February 12, 2018 |

Royal Pine Homes
3550 Langstaff Road, Suite 200
Woodbridge, Ontario
L4L 9G3

Attn: Vince Staffieri

Site instructions/memos and Addendums are issued only for the purpose of recording any clarification or interpretation of the contract documents or giving direction on problems resulting from field conditions. These memos are subject to the provisions of the contract documents and unless reviewed with and authorized by the Client, will not affect the contract. Should the Contractor require a change in the contract price or project schedule, he shall submit to the Client, prior to commencement of work outlined in this memo, an itemized proposal for approval.

Title: Revising Operable windows on Drawings

A301, A301a –c Ground Floor Overall Plan and Partial Plans
- Indicating operable windows on plans.

A302, A302a –c Second Floor Overall Plan and Partial Plans
- Indicating operable windows on plans.

A303, A303a Third Floor Overall Plan and Partial Plan
- Indicating operable windows on plans.

A304 Fourth Floor Overall Plan
- Indicating operable windows on plans.

A305 Fifth Floor Overall Plan
- Indicating operable windows on plans.

A306, A306a-c Sixth Floor Overall Plan and Partial Plan
- Indicating operable windows on plans.

A307, A307a-c Seventh Floor Overall Plan and Partial Plan
- Indicating operable windows on plans.

A401a-c Building Elevations
- Revising operable windows on elevations.

Reason: **Coordinating plans and elevations based on window shop drawings**
References: **A301, A301a-c, A302, A302a-c, A303, A303a, A304, A305, A306, A306a-c, A307, A307a-c, A401a-c.**

GRAZIANI + CORAZZA
ARCHITECTS INC

**G. Colangelo** Diploma Arch. Technology
Associate, Director of Contract Documents

GRAZIANI + CORAZZA ARCHITECTS INC.

Distribution:

| | | |
|---|---|---|
| Royal Pine Homes | Cinzia Caruso | cinzia@royalpinehomes.com |
| Dineen Construction | Dominic Salvati | dsalvati@dineen.com |
| Dineen Construction | Jeff Ellis | jellis@dineen.com |
| Dineen Construction | Eric Wright | rwright@dineen.com |

PROPERTY LINE

PROPERTY LINE

0M min. SETBACK

EXTENT OF U/G

Clashed line indicates extent of transfer slab below

Clashed line indicates change in slab thickness

Dashed line indicates change in slab thickness

Dashed line indicates extent of transfer slab below

018 2J+D-P-2 | 019 2E-P | 017 2F-P | 016 2A-P | 013 1C+D-R-P | 012 2D-P | 011 2E1-P | 015 2K-P2 | 014 2H+D-P2 | 010 2L+D-P | 009 1C+D-P | 001 2E-R-P | 002 2J+D-P | 003 2F-R-P | 004 2G+D-P | 008 2G+D-P2 | 005 2A-R-P | 007 2H+D-P | 006 2K-P

Amenity | Guest Suite | Electrical Room | Emergency Shaft | Pet Wash | Stair C | Corridor | Lobby | Property Management Office | Mail Room | Residential Drop Off | Stair A | Stair B | Stair D | Lockers | Electrical closet | Terrace | Exhaust | FA Shaft | Recycling and Shredding | access to plaza | driveway

258.35 | 258.50 FFE | 258.55 | 253.35 | 258.05 TOC

| CEILING HEIGHTS | | | |
|---|---|---|---|
| FLOOR | FOYER & KITCHEN | BULKHEADS | LIVING/ DINING/DEN/BEDROOM |
| GRD | 2950 | 2750 | 2950 |
| 2ND | 2600 | 2450 | SLAB AT 2750 |
| 3RD | 2600 | 2450 | SLAB AT 2750 |
| 4TH | 2600 | 2450 | SLAB AT 2750 |
| 5TH | 2600 | 2450 | SLAB AT 2750 / 2700 |
| 6TH | 2600 | 2450 | SLAB AT 2750 / 2700 |
| 7TH | 2900 | 2750 | 3050 |

This drawing, as an instrument of service, is provided by and is the property of Graziani + Corazza Architects Inc. and may not be used and may not be reproduced without permission. All dimensions and conditions on site must be verified by Graziani + Corazza Architects Inc. of any variations from the supplied information. Graziani + Corazza Architects Inc. is not responsible for the accuracy of survey, structural, mechanical, electrical, etc., engineering information shown on this drawing. Refer to the appropriate engineering drawings before proceeding with the work. Construction must conform to all applicable codes and requirements of the authorities having jurisdiction. Unless otherwise noted, no investigation has been undertaken or reported on by this office in regards to the environmental condition of this site.

This drawing is not to be used for construction purposes until countersigned by the Architect.

This drawing is not to be scaled. All architectural symbols indicated on this drawing are graphic representations only.

| | | | |
|---|---|---|---|
| 01. | FEB.28.2014 | issued to city for SPA | B.G. |
| 02. | JUL.9.2014 | re-issued to city for SPA | B.G. |
| 03. | SEP.11.2014 | re-issued to city for SPA | B.G. |
| 04. | JAN.15.2015 | re-issued to city for SPA | B.G. |
| 05. | MAR.15.2015 | issued for tender | B.G. |
| 06. | DEC.28.2016 | issued for building permit | B.G. |
| 07. | MAY.10.2017 | re-issued for building permit | B.G. |
| 08. | MAY.10.2017 | Issued for Footings and Foundation Permit | B.G. |
| 10. | JULY.19.2017 | Progress for Construction | B.G. |
| 11. | AUG.09.2017 | Issued for Construction | B.G. |
| 12. | OCT.25.2017 | Revision to Envelope | B.G. |

| | | | |
|---|---|---|---|
| 03. | FEB.12.2018 | S11.1 REVISING OPERABLE WINDOWS | BG |
| 02. | DEC.07.2017 | S110 SHOWING BARRIER-FREE SYMBOL | BG |
| 01. | SEPT.06.2017 | S106 TRANSOM/BULKHEADS REVISION | BG |

issued for revisions

GRAZIANI + CORAZZA ARCHITECTS INC.

1220 Shawson Drive, Suite 100 Mississauga Ontario L4W 1C3
Phone 905.790.2601 Fax 905.790.2944 www.gc-architects.com

PROPOSED RESIDENTIAL DEVELOPMENT

# 25 BAKER HILL BLVD.

ROYAL PINES HOMES

STOUFFVILLE ONTARIO

| | |
|---|---|
| Project Architect: | B.GRAZIANI |
| Assistant Designer: | R.LINCOLN |
| Drawn By: | S.G. |
| Checked By: | G.COLANGELO/D.BIASE |
| Plot Date: | Nov. 7, 2017 |
| Job # | 1136.13 |

GROUND FLOOR PLAN
OVERALL PLAN

1:100 A301

TITLEBLOCK SIZE: 915 x 1400

This drawing, as an instrument of service, is provided by and is the property of Graziani + Corazza Architects Inc. and may not be used or reproduced without the consent of Graziani + Corazza Architects Inc. Graziani + Corazza Architects Inc. will not be responsible for any variations from the supplied information. Graziani + Corazza Architects Inc. is not responsible for the accuracy of survey, structural, mechanical, electrical, etc., engineering information shown on this drawing. Refer to the appropriate engineering drawings before proceeding with the work. Construction must conform to all applicable codes and requirements of the authorities having jurisdiction. Unless otherwise noted, no investigation has been undertaken or reported on by this office in regards to the environmental condition of this site.

This drawing is not to be used for construction purposes until countersigned by the Architect.

This drawing is not to be scaled. All architectural symbols indicated on this drawing are graphic representations only.

| | | |
|---|---|---|
| 01. | FEB.28.2014 | issued to city for SPA B.G. |
| 02. | JUL.9.2014 | re-issued to city for SPA B.G. |
| 03. | SEP.11.2014 | re-issued to city for SPA B.G. |
| 04. | JAN.15.2015 | re-issued to city for SPA B.G. |
| 05. | MAR.15.2015 | issued for tender B.G. |
| 06. | DEC.28.2016 | issued for building permit B.G. |
| 07. | MAY.10.2017 | re-issued for building permit B.G. |
| 08. | MAY.10.2017 | Issued for Footings and Foundation Permit B.G. |
| 10. | JULY.19.2017 | Progress for Construction B.G. |
| 11. | AUG.09.2017 | Issued for Construction B.G. |
| 12. | OCT.25.2017 | Revision to Envelope B.G. |

Dashed line indicates change in transfer slab thickness

2hr fire rated shaft/ bulkhead (refer to typical details 18/A812)

Dashed line indicates change in transfer slab thickness

Hatch indicates heat tape@ slab/slab

pyrotenax to stop 150mm from edges

| CEILING HEIGHTS | | | |
|---|---|---|---|
| FLOOR | FOYER & KITCHEN | BULKHEADS | LIVING/ DINING/DEN/BEDROOM |
| GRD | 2950 | 2750 | 2950 |
| 2ND | 2600 | 2450 | SLAB AT 2750 |
| 3RD | 2600 | 2450 | SLAB AT 2750 |
| 4TH | 2600 | 2450 | SLAB AT 2750 |
| 5TH | 2600 | 2450 | SLAB AT 2750 / 2700 |
| 6TH | 2600 | 2450 | SLAB AT 2750 / 2700 |
| 7TH | 2900 | 2750 | 3050 |

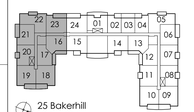


25 Bakerhill
2nd Floor

| | | |
|---|---|---|
| 04. | FEB.12.2018 | S11.3 REVISING OPERABLE WINDOWS BG |
| 03. | DEC.07.2017 | S110 SHOWING BARRIER-FREE SYMBOL BG |
| 02. | NOV.23.2017 | S108 TERRACE/PATIO & STEP REVISION BG |
| 01. | SEPT.06.2017 | S106 TRANSOM/BULKHEADS REVISION BG |

issued for revisions

GRAZIANI + CORAZZA ARCHITECTS INC.
1339 Dawson Drive, Suite 100, Mississauga, Ontario L4W 1C3
Phone: 905.790.2661 Fax:905.790.2944 www.gc-architects.com

PROPOSED RESIDENTIAL DEVELOPMENT

# 25 BAKER HILL BLVD.

STOUFFVILLE ROYAL PINES HOMES ONTARIO

| | |
|---|---|
| Project Architect: | B.GRAZIANI |
| Assistant Designer: | R.LINCOLN |
| Drawn By: | S.G. |
| Checked By: | G.COLANGELO/D.BIASE |
| Plot Date: | Nov. 7, 2017 |
| Job # | 1136.13 |

GROUND FLOOR ENLARGED PART PLAN

1:50 A301a

TITLEBLOCK SIZE: 915 x 1400

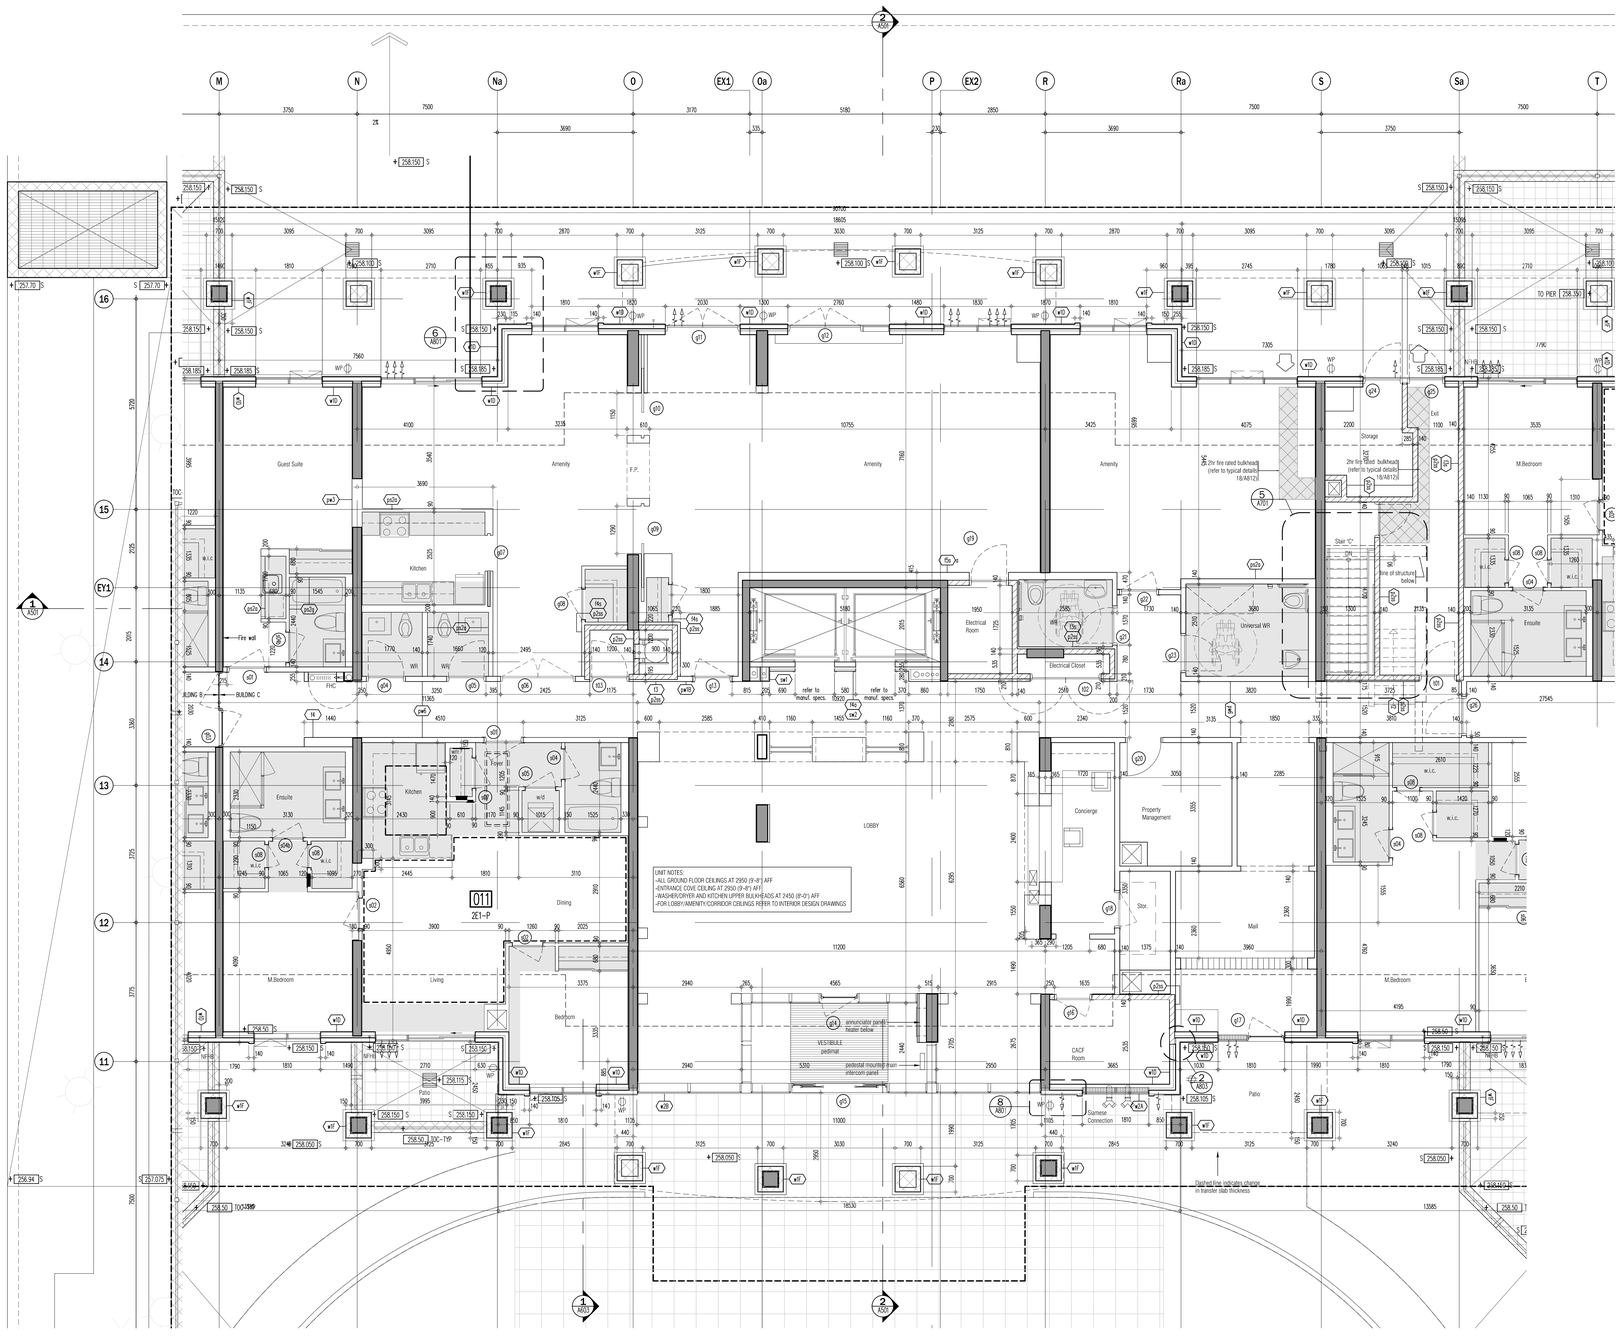


| CEILING HEIGHTS | | | |
|---|---|---|---|
| FLOOR | FOYER & KITCHEN | BULKHEADS | LIVING/ DINING/DEN/BEDROOM |
| GRD | 2950 | 2750 | 2950 |
| 2ND | 2600 | 2450 | SLAB AT 2750 |
| 3RD | 2600 | 2450 | SLAB AT 2750 |
| 4TH | 2600 | 2450 | SLAB AT 2750 |
| 5TH | 2600 | 2450 | SLAB AT 2750 / 2700 |
| 6TH | 2600 | 2450 | SLAB AT 2750 / 2700 |
| 7TH | 2900 | 2750 | 3050 |

This drawing, as an instrument of service, is provided by and is the property of Graziani + Corazza Architects Inc. and may not be used or reproduced without permission. All dimensions and conditions on site must be verified by Graziani + Corazza Architects Inc. of any variations from the supplied information. Graziani + Corazza Architects Inc. is not responsible for the accuracy of survey, structural, mechanical, electrical, etc., engineering information shown on this drawing. Refer to the appropriate engineering drawings before proceeding with the work. Construction must conform to all applicable codes and requirements of the authorities having jurisdiction. Unless otherwise noted, no investigation has been undertaken or reported on by this office in regards to the environmental condition of this site.

This drawing is not to be used for construction purposes until countersigned by the Architect.

This drawing is not to be scaled. All architectural symbols indicated on this drawing are graphic representations only.

| | | | |
|---|---|---|---|
| 01. | FEB.28.2014 | issued to city for SPA | B.G. |
| 02. | JUL.9.2014 | re-issued to city for SPA | B.G. |
| 03. | SEP.11.2014 | re-issued to city for SPA | B.G. |
| 04. | JAN.15.2015 | re-issued to city for SPA | B.G. |
| 05. | MAR.15.2015 | issued for tender | B.G. |
| 06. | DEC.28.2016 | issued for building permit | B.G. |
| 07. | MAY.10.2017 | re-issued for building permit | B.G. |
| 08. | MAY.10.2017 | Issued for Footings and Foundation Permit | B.G. |
| 10. | JULY.19.2017 | Progress for Construction | B.G. |
| 11. | AUG.09.2017 | Issued for Construction | B.G. |
| 12. | OCT.25.2017 | Revision to Envelope | B.G. |

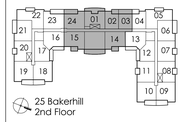


| | | | |
|---|---|---|---|
| 03. | FEB.12.2018 | S11 REVISING OPERABLE WINDOWS | BG |
| 02. | DEC.13.2017 | SI 11 REV.1 –STAIR C | BG |
| 01. | SEP.1.06.2017 | S106 TRANSOM/BULKHEADS REVISION | BG |

Issued for revisions

GRAZIANI + CORAZZA ARCHITECTS INC.

PROPOSED RESIDENTIAL DEVELOPMENT

# 25 BAKER HILL BLVD.

ROYAL PINES HOMES

STOUFFVILLE ONTARIO

| | |
|---|---|
| Project Architect: | B.GRAZIANI |
| Assistant Designer: | R.LINCOLN |
| Drawn By: | S.G. |
| Checked By: | G.COLANGELO/D.BIASE |
| Plot Date: | Nov. 7, 2017 |
| 3DD #: | 1136.13 |

GROUND FLOOR ENLARGED PART PLAN

1:50 A301b

TITLEBLOCK SIZE: 915 x 1400

This drawing, as an instrument of service, is provided by and is the property of Graziani + Corazza Architects Inc. and may not be used or reproduced without permission. All dimensions and conditions on site must be verified by Graziani + Corazza Architects Inc. of any variations from the supplied information. Graziani + Corazza Architects Inc. is not responsible for the accuracy of survey, structural, mechanical, electrical, etc., engineering information shown on this drawing. Refer to the appropriate engineering drawings before proceeding with the work. Construction must conform to all applicable codes and requirements of the authorities having jurisdiction. Unless otherwise noted, no investigation has been undertaken or reported on by this office in regards to the environmental condition of this site.

This drawing is not to be used for construction purposes until countersigned by the Architect.

This drawing is not to be scaled. All architectural symbols indicated on this drawing are graphic representations only.

| | | | |
|---|---|---|---|
| 01. | FEB.28.2014 | issued to city for SPA | B.G. |
| 02. | JUL.9.2014 | re-issued to city for SPA | B.G. |
| 03. | SEP.11.2014 | re-issued to city for SPA | B.G. |
| 04. | JAN.15.2015 | re-issued to city for SPA | B.G. |
| 05. | MAR.15.2015 | issued for tender | B.G. |
| 06. | DEC.28.2016 | issued for building permit | B.G. |
| 07. | MAY.10.2017 | re-issued for building permit | B.G. |
| 08. | MAY.10.2017 | Issued for Footings and Foundation Permit | B.G. |
| 10. | JULY.19.2017 | Progress for Construction | B.G. |
| 11. | AUG.09.2017 | Issued for Construction | B.G. |
| 12. | OCT.25.2017 | Revision to Envelope | B.G. |

Dashed line indicates change in transfer slab thickness

| CEILING HEIGHTS | | | |
|---|---|---|---|
| FLOOR | FOYER & KITCHEN | BULKHEADS | LIVING/ DINING/DEN/BEDROOM |
| GRD | 2950 | 2750 | 2950 |
| 2ND | 2600 | 2450 | SLAB AT 2750 |
| 3RD | 2600 | 2450 | SLAB AT 2750 |
| 4TH | 2600 | 2450 | SLAB AT 2750 |
| 5TH | 2600 | 2450 | SLAB AT 2750 / 2700 |
| 6TH | 2600 | 2450 | SLAB AT 2750 / 2700 |
| 7TH | 2900 | 2750 | 3050 |

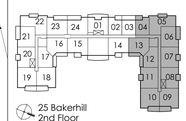


| | | | |
|---|---|---|---|
| 03. | FEB.12.2018 | S13. REVISING OPERABLE WINDOWS | BG |
| 02. | DEC.07.2017 | S110 SHOWING BARRIER-FREE SYMBOL | BG |
| 01. | SEPT.06.2017 | S106 TRANSOM/BULKHEADS REVISION | BG |

issued for revisions

GRAZIANI + CORAZZA ARCHITECTS INC.

1333 Shawne Drive, Suite 100 Mississauga Ontario L4W 1C3
Phone 905.795.2601 Fax 905.795.2644 www.gc-architects.com

PROPOSED RESIDENTIAL DEVELOPMENT

# 25 BAKER HILL BLVD.

ROYAL PINES HOMES

STOUFFVILLE ONTARIO

| | |
|---|---|
| Project Architect: | B.GRAZIANI |
| Assistant Designer: | R.LINCOLN |
| Drawn By: | S.G. |
| Checked By: | G.COLANGELO/D.BIASE |
| Plot Date: | Nov. 7, 2017 |
| Job # | 1136.13 |

GROUND FLOOR ENLARGED PART PLAN

1:50 A301c

TITLEBLOCK SIZE: 915 x 1400

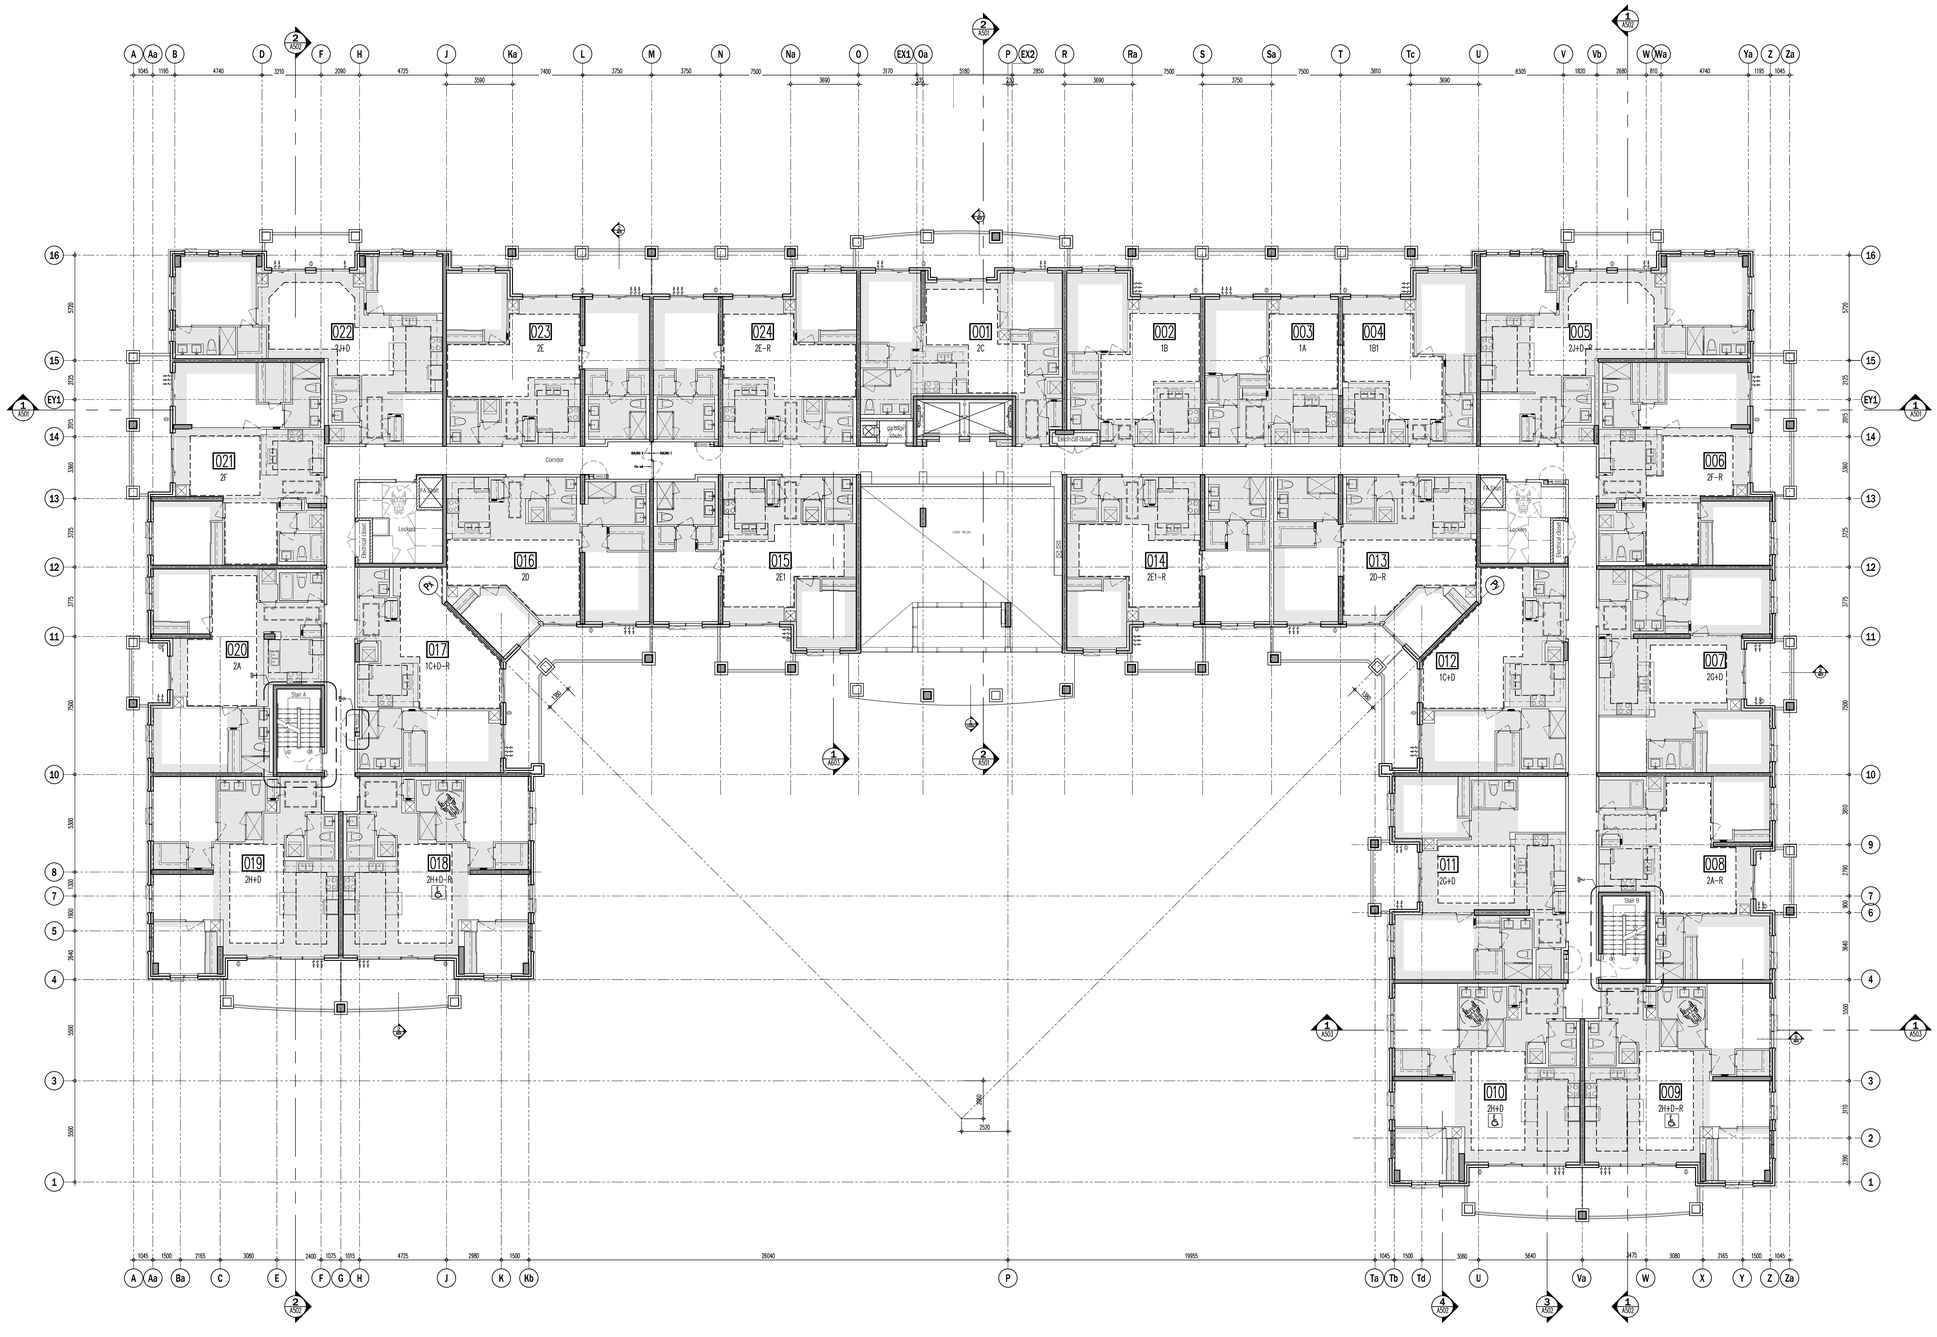


| CEILING HEIGHTS | | | |
|---|---|---|---|
| FLOOR | FOYER & KITCHEN | BULKHEADS | LIVING/ DINING/DEN/BEDROOM |
| GRD | 2950 | 2750 | 2950 |
| 2ND | 2600 | 2450 | SLAB AT 2750 |
| 3RD | 2600 | 2450 | SLAB AT 2750 |
| 4TH | 2600 | 2450 | SLAB AT 2750 |
| 5TH | 2600 | 2450 | SLAB AT 2750 / 2700 |
| 6TH | 2600 | 2450 | SLAB AT 2750 / 2700 |
| 7TH | 2900 | 2750 | 3050 |

This drawing, as an instrument of service, is provided by and is the property of Graziani + Corazza Architects Inc. and may not be used in any way without the consent of Graziani + Corazza Architects Inc. The contractor shall verify and be responsible for all dimensions and conditions on site and must notify Graziani + Corazza Architects Inc. of any variations from the supplied information. Graziani + Corazza Architects Inc. is not responsible for the accuracy of survey, structural, mechanical, electrical, etc., engineering information shown on this drawing. Refer to the appropriate engineering drawings before proceeding with the work. Construction must conform to all applicable codes and requirements of the authorities having jurisdiction. Unless otherwise noted, no investigation has been undertaken or reported on by this office in regards to the environmental condition of this site.

This drawing is not to be used for construction purposes until countersigned by the Architect.

This drawing is not to be scaled. All architectural symbols indicated on this drawing are graphic representations only.

| | | | |
|---|---|---|---|
| 01. | FEB.28.2014 | issued to city for SPA | B.G. |
| 02. | JUL.9.2014 | re-issued to city for SPA | B.G. |
| 03. | SEP.11.2014 | re-issued to city for SPA | B.G. |
| 04. | JAN.15.2015 | re-issued to city for SPA | B.G. |
| 05. | MAR.15.2015 | issued for tender | B.G. |
| 06. | DEC.28.2016 | issued for building permit | B.G. |
| 07. | MAY.10.2017 | re-issued for building permit | B.G. |
| 08. | MAY.10.2017 | Issued for Footings and Foundation Permit | B.G. |
| 10. | JULY.19.2017 | Progress for Construction | B.G. |
| 11. | AUG.09.2017 | Issued for Construction | B.G. |
| 12. | OCT.25.2017 | Revision to Envelope | B.G. |

| | | | |
|---|---|---|---|
| 03. | FEB.12.2018 | S13 REVISING OPERABLE WINDOWS | BG |
| 02. | DEC.07.2017 | S110 SHOWING BARRIER-FREE SYMBOL | BG |
| 01. | DEC.07.2017 | S109 GARBAGE CHUTE PIPE SPACE | BG |

issued for revisions

GRAZIANI + CORAZZA ARCHITECTS INC.
1300 Skyview Drive, Suite 100 Mississauga Ontario L4W 1C3
Phone 905.795.2601 Fax 905.795.2644 www.gc-architects.com

PROPOSED RESIDENTIAL DEVELOPMENT

# 25 BAKER HILL BLVD.

ROYAL PINES HOMES

STOUFFVILLE ONTARIO

| | |
|---|---|
| Project Architect: | B.GRAZIANI |
| Assistant Designer: | R.LINCOLN |
| Drawn By: | S.G. |
| Checked By: | G.COLANGELO/D.BIASE |
| Plot Date: | Nov. 7, 2017 |
| Job # | 1136.13 |

## 2nd FLOOR PLAN
## OVERALL PLAN

1:100 A302

TITLEBLOCK SIZE: 915 x 1400

This drawing, as an instrument of service, is provided by and is the property of Graziani + Corazza Architects Inc. and may not be used or reproduced without permission and is not to be used by any other person or firm. Graziani + Corazza Architects Inc. will not be responsible for any variations from the supplied information. Graziani + Corazza Architects Inc. is not responsible for the accuracy of survey, structural, mechanical, electrical, etc., engineering information shown on this drawing. Refer to the appropriate engineering drawings before proceeding with the work. Construction must conform to all applicable codes and requirements of the authorities having jurisdiction. Unless otherwise noted, no investigation has been undertaken or reported on by this office in regards to the environmental condition of this site.

This drawing is not to be used for construction purposes until countersigned by the Architect.

This drawing is not to be scaled. All architectural symbols indicated on this drawing are graphic representations only.

| | | | |
|---|---|---|---|
| 01. | FEB.28.2014 | issued to city for SPA | B.G. |
| 02. | JUL.9.2014 | re-issued to city for SPA | B.G. |
| 03. | SEP.11.2014 | re-issued to city for SPA | B.G. |
| 04. | JAN.15.2015 | re-issued to city for SPA | B.G. |
| 05. | MAR.15.2015 | issued for tender | B.G. |
| 06. | DEC.28.2016 | issued for building permit | B.G. |
| 07. | MAY.10.2017 | re-issued for building permit | B.G. |
| 08. | MAY.10.2017 | Issued for Footings and Foundation Permit | B.G. |
| 10. | JULY.19.2017 | Progress for Construction | B.G. |
| 11. | AUG.09.2017 | Issued for Construction | B.G. |
| 12. | OCT.25.2017 | Revision to Envelope | B.G. |

NOTES:
- ALL 2nd - 5th FLOOR CEILINGS AT 2750 (9'-0") AFF
- ENTRANCE COVE CEILING AT 2600 (8'-6") AFF
- WASHER / DRYER AND KITCHEN UPPER BULKHEADS AT 2450 (8'-0") AFF
- FOR CORRIDOR CEILINGS REFER TO INTERIOR DESIGN DRAWINGS

| CEILING HEIGHTS | | | |
|---|---|---|---|
| FLOOR | FOYER & KITCHEN | BULKHEADS | LIVING/ DINING/DEN/BEDROOM |
| GRD | 2950 | 2750 | 2950 |
| 2ND | 2600 | 2450 | SLAB AT 2750 |
| 3RD | 2600 | 2450 | SLAB AT 2750 |
| 4TH | 2600 | 2450 | SLAB AT 2750 |
| 5TH | 2600 | 2450 | SLAB AT 2750 / 2700 |
| 6TH | 2600 | 2450 | SLAB AT 2750 / 2700 |
| 7TH | 2900 | 2750 | 3050 |

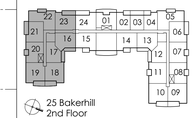


25 Bakerhill
2nd Floor

| | | | |
|---|---|---|---|
| 03. | FEB.12.2018 | S13 REVISING OPERABLE WINDOWS | BG |
| 02. | DEC.07.2017 | S10 SHOWING BARRIER-FREE SYMBOL | BG |
| 01. | AUG.21.2017 | S103 SANDBLAST PRECAST ON BALCONIES | BG |

Issued for revisions

GRAZIANI
CORAZZA
ARCHITECTS INC.

1220 Sheppard Ave. Suite 100 Mississauga Ontario L4W 1C3
Phone 905.795.2601 Fax 905.795.2964 www.gc-architects.com

PROPOSED RESIDENTIAL DEVELOPMENT

# 25 BAKER HILL BLVD.

ROYAL PINES HOMES

STOUFFVILLE ONTARIO

| | |
|---|---|
| Project Architect: | B.GRAZIANI |
| Assistant Designer: | R.LINCOLN |
| Drawn By: | S.G. |
| Checked By: | G.COLANGELO/D.BIASE |
| Plot Date: | Nov. 7, 2017 |
| Job # | 1136.13 |

## 2ND FLOOR ENLARGED PART PLAN

1:50 A302a

TITLEBLOCK SIZE: 915 x 1400

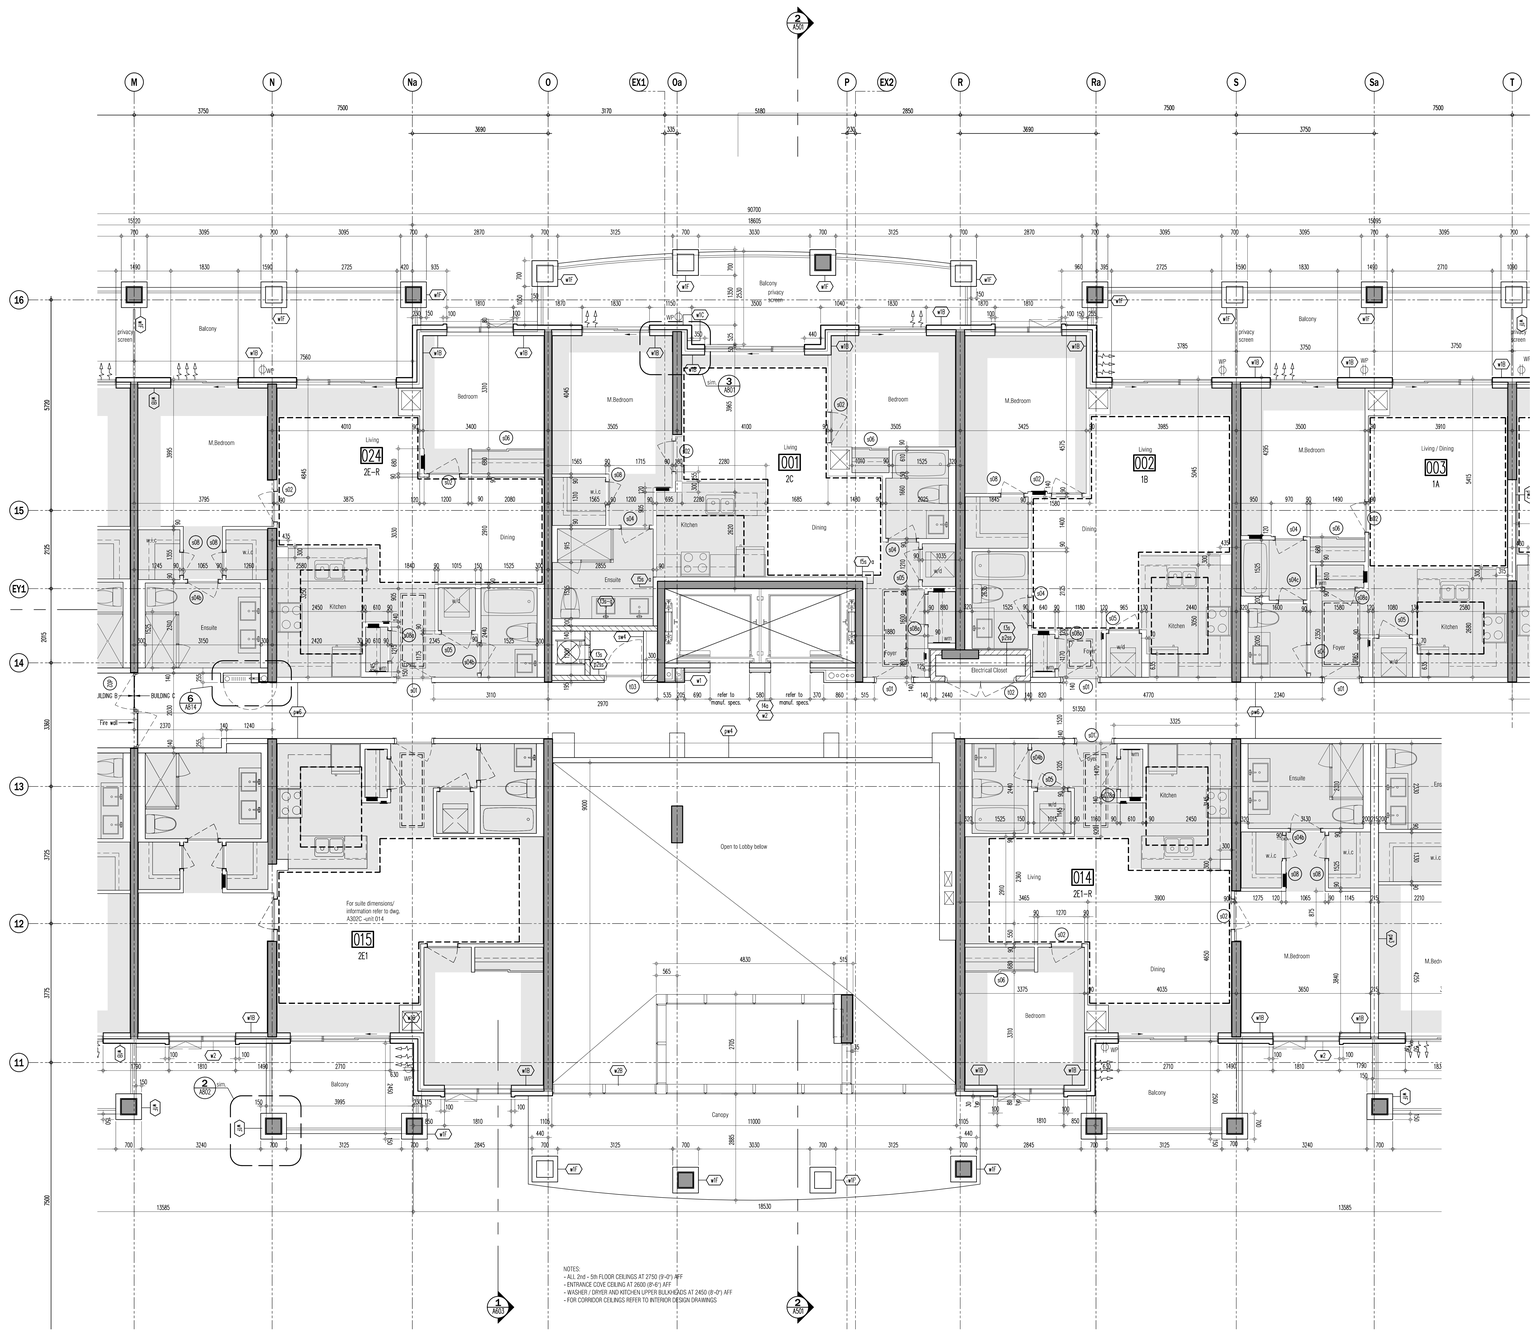


| CEILING HEIGHTS | | | |
|---|---|---|---|
| FLOOR | FOYER & KITCHEN | BULKHEADS | LIVING/ DINING/DEN/BEDROOM |
| GRD | 2950 | 2750 | 2950 |
| 2ND | 2600 | 2450 | SLAB AT 2750 |
| 3RD | 2600 | 2450 | SLAB AT 2750 |
| 4TH | 2600 | 2450 | SLAB AT 2750 |
| 5TH | 2600 | 2450 | SLAB AT 2750 / 2700 |
| 6TH | 2600 | 2450 | SLAB AT 2750 / 2700 |
| 7TH | 2900 | 2750 | 3050 |

This drawing, as an instrument of service, is provided by and is the property of Graziani + Corazza Architects Inc. and may not be used or reproduced without permission and condition as set forth in the Agreement between Graziani + Corazza Architects Inc. and the client. Graziani + Corazza Architects Inc. is not responsible for the accuracy of survey, structural, mechanical, electrical, etc., engineering information shown on this drawing. Refer to the appropriate engineering drawings before proceeding with the work. Construction must conform to all applicable codes and requirements of the authorities having jurisdiction. Unless otherwise noted, no investigation has been undertaken or reported on by this office in regards to the environmental condition of this site.

This drawing is not to be used for construction purposes until countersigned by the Architect.

This drawing is not to be scaled. All architectural symbols indicated on this drawing are graphic representations only.

| | | | |
|---|---|---|---|
| 01. | FEB.28.2014 | issued to city for SPA | B.G. |
| 02. | JUL.9.2014 | re-issued to city for SPA | B.G. |
| 03. | SEP.11.2014 | re-issued to city for SPA | B.G. |
| 04. | JAN.15.2015 | re-issued to city for SPA | B.G. |
| 05. | MAR.15.2015 | issued for tender | B.G. |
| 06. | DEC.28.2016 | issued for building permit | B.G. |
| 07. | MAY.10.2017 | re-issued for building permit | B.G. |
| 08. | MAY.10.2017 | Issued for Footings and Foundation Permit | B.G. |
| 10. | JULY.19.2017 | Progress for Construction | B.G. |
| 11. | AUG.09.2017 | Issued for Construction | B.G. |
| 12. | OCT.25.2017 | Revision to Envelope | B.G. |

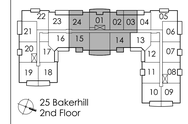


25 Bakerhill
2nd Floor

| | | | |
|---|---|---|---|
| 03. | FEB.12.2018 | S13. REVISING OPERABLE WINDOWS | BG |
| 02. | DEC.07.2017 | S109. GARBAGE CHUTE PIPE SPACE | BG |
| 01. | AUG.21.2017 | S103. SANDBLAST PRECAST ON BALCONIES | BG |

Issued for revisions

GRAZIANI + CORAZZA ARCHITECTS INC.

1220 Sheppard Drive, Suite 100, Mississauga Ontario L4W 1C3
Phone 905.795.7601 Fax 905.795.2944 www.gc-architects.com

PROPOSED RESIDENTIAL DEVELOPMENT

# 25 BAKER HILL BLVD.

STOUFFVILLE ROYAL PINES HOMES ONTARIO

| | |
|---|---|
| Project Architect: | B.GRAZIANI |
| Assistant Designer: | R.LINCOLN |
| Drawn By: | S.G. |
| Checked By: | G.COLANGELO/D.BIASE |
| Plot Date: | Nov. 7, 2017 |
| Job # | 1136.13 |

## 2ND FLOOR ENLARGED PART PLAN

1:50

A302b

TITLEBLOCK SIZE: 915 x 1400

This drawing, as an instrument of service, is provided by and is the property of Graziani + Corazza Architects Inc. and may not be used or reproduced without permission and is not to be changed or modified in any fashion. Graziani + Corazza Architects Inc. assumes no responsibility for the accuracy of existing structural, mechanical, electrical, etc., engineering information shown on this drawing. Refer to the appropriate engineering drawings before proceeding with the work. Construction must conform to all applicable codes and requirements of the authorities having jurisdiction. Unless otherwise noted, no investigation has been undertaken or reported on by this office in regards to the environmental condition of this site.

This drawing is not to be used for construction purposes until countersigned by the Architect.

This drawing is not to be scaled. All architectural symbols indicated on this drawing are graphic representations only.

| | | | |
|---|---|---|---|
| 01. | FEB.28.2014 | issued to city for SPA | B.G. |
| 02. | JUL.9.2014 | re-issued to city for SPA | B.G. |
| 03. | SEP.11.2014 | re-issued to city for SPA | B.G. |
| 04. | JAN.15.2015 | re-issued to city for SPA | B.G. |
| 05. | MAR.15.2015 | issued for tender | B.G. |
| 06. | DEC.28.2016 | issued for building permit | B.G. |
| 07. | MAY.10.2017 | re-issued for building permit | B.G. |
| 08. | MAY.10.2017 | Issued for Footings and Foundation Permit | B.G. |
| 10. | JULY.19.2017 | Progress for Construction | B.G. |
| 11. | AUG.09.2017 | Issued for Construction | B.G. |
| 12. | OCT.25.2017 | Revision to Envelope | B.G. |

NOTES:
- ALL 2nd - 5th FLOOR CEILINGS AT 2750 (9'-0") AFF
- ENTRANCE COVE CEILING AT 2600 (8'-6") AFF
- WASHER / DRYER AND KITCHEN UPPER BULKHEADS AT 2450 (8'-0") AFF
- FOR CORRIDOR CEILINGS REFER TO INTERIOR DESIGN DRAWINGS

| CEILING HEIGHTS | | | |
|---|---|---|---|
| FLOOR | FOYER & KITCHEN | BULKHEADS | LIVING/ DINING/DEN/BEDROOM |
| GRD | 2950 | 2750 | 2950 |
| 2ND | 2600 | 2450 | SLAB AT 2750 |
| 3RD | 2600 | 2450 | SLAB AT 2750 |
| 4TH | 2600 | 2450 | SLAB AT 2750 |
| 5TH | 2600 | 2450 | SLAB AT 2750 / 2700 |
| 6TH | 2600 | 2450 | SLAB AT 2750 / 2700 |
| 7TH | 2900 | 2750 | 3050 |

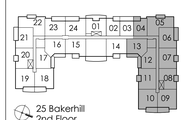


| | | | |
|---|---|---|---|
| 03. | FEB.12.2018 | S13 REVISING OPERABLE WINDOWS | BG |
| 02. | DEC.07.2017 | S110 SHOWING BARRIER-FREE SYMBOL | BG |
| 01. | AUG.21.2017 | S103 SANDBLAST PRECAST ON BALCONIES | BG |

issued for revisions

GRAZIANI + CORAZZA ARCHITECTS INC.
1220 Stephenson Drive, Suite 100, Mississauga Ontario L4W 1C3
Phone 905.795.2601 Fax 905.795.2944 www.gc-architects.com

PROPOSED RESIDENTIAL DEVELOPMENT

# 25 BAKER HILL BLVD.

STOUFFVILLE ROYAL PINES HOMES ONTARIO

| | |
|---|---|
| Project Architect: | B.GRAZIANI |
| Assistant Designer: | R.LINCOLN |
| Drawn By: | S.G. |
| Checked By: | G.COLANGELO/D.BIASE |
| Plot Date: | Nov. 7, 2017 |
| Job # | 1136.13 |

## 2ND FLOOR ENLARGED PART PLAN

1:50 A302c

TITLEBLOCK SIZE: 915 x 1400

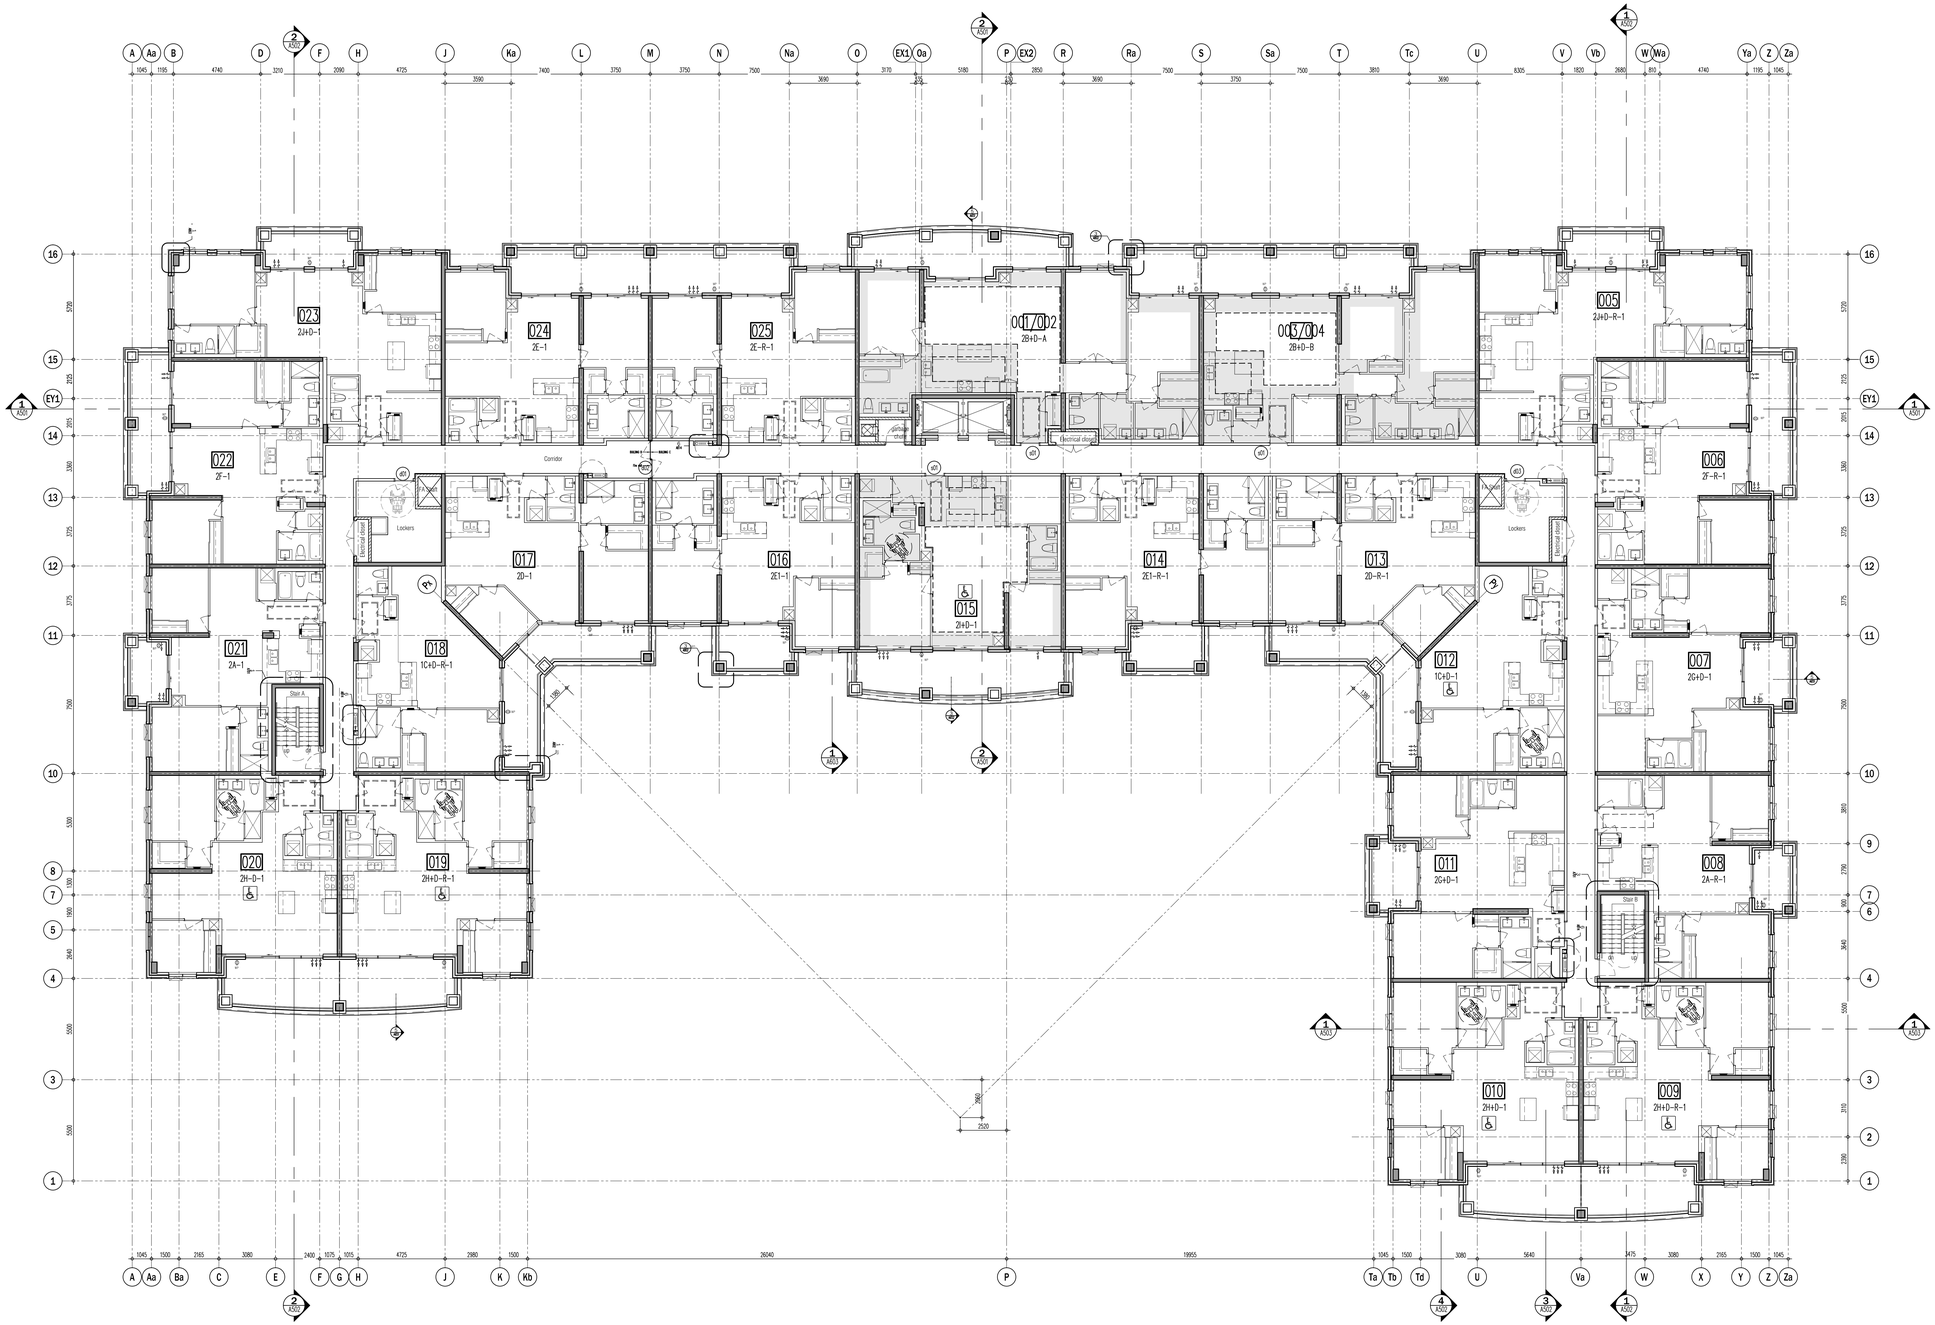


Note: Suites are the same as 2nd floor with the exception of units 001/002, 003/004 and 015. For other suite dimensions / information, please refer to dwgs A302b-d.

| CEILING HEIGHTS | | | |
|---|---|---|---|
| FLOOR | FOYER & KITCHEN | BULKHEADS | LIVING/ DINING/DEN/BEDROOM |
| GRD | 2950 | 2750 | 2950 |
| 2ND | 2600 | 2450 | SLAB AT 2750 |
| 3RD | 2600 | 2450 | SLAB AT 2750 |
| 4TH | 2600 | 2450 | SLAB AT 2750 |
| 5TH | 2600 | 2450 | SLAB AT 2750 / 2700 |
| 6TH | 2600 | 2450 | SLAB AT 2750 / 2700 |
| 7TH | 2900 | 2750 | 3050 |

This drawing, as an instrument of service, is provided by and is the property of Graziani + Corazza Architects Inc. and may not be used in any way without the consent of Graziani + Corazza Architects Inc. All dimensions and conditions on site must be verified by the Contractor. Graziani + Corazza Architects Inc. will not be responsible for any discrepancies found during construction. Graziani + Corazza Architects Inc. is not responsible for the accuracy of survey, structural, mechanical, electrical, etc., engineering information shown on this drawing. Refer to the appropriate engineering drawings before proceeding with the work. Construction must conform to all applicable codes and requirements of the authorities having jurisdiction. Unless otherwise noted, no investigation has been undertaken or reported on by this office in regards to the environmental condition of this site.

This drawing is not to be used for construction purposes until countersigned by the Architect.

This drawing is not to be scaled. All architectural symbols indicated on this drawing are graphic representations only.

| | | | |
|---|---|---|---|
| 01. | FEB.28.2014 | issued to city for SPA | B.G. |
| 02. | JUL.9.2014 | re-issued to city for SPA | B.G. |
| 03. | SEP.11.2014 | re-issued to city for SPA | B.G. |
| 04. | JAN.15.2015 | re-issued to city for SPA | B.G. |
| 05. | MAR.15.2015 | issued for tender | B.G. |
| 06. | DEC.28.2016 | issued for building permit | B.G. |
| 07. | MAY.10.2017 | re-issued for building permit | B.G. |
| 08. | MAY.10.2017 | Issued for Footings and Foundation Permit | B.G. |
| 10. | JULY.19.2017 | Progress for Construction | B.G. |
| 11. | AUG.09.2017 | Issued for Construction | B.G. |
| 12. | OCT.25.2017 | Revision to Envelope | B.G. |

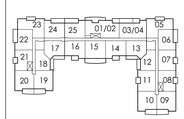

| | | | |
|---|---|---|---|
| 05. | FEB.12.2018 | S113 REVISING OPERABLE WINDOWS | BG |
| 04. | DEC.07.2017 | S110 SHOWING BARRIER-FREE SYMBOL | BG |
| 03. | DEC.07.2017 | S109 GARBAGE CHUTE PIPE SPACE | BG |
| 02. | AUG.24.2017 | S102-R1 REVISION TO SUITE NUMBERS | BG |
| 01. | AUG.18.2017 | S102 REVISION TO SUITE NUMBERS | BG |

Issued for revisions

GRAZIANI + CORAZZA ARCHITECTS INC.
1320 Dawson Drive, Suite 100 Mississauga Ontario L4W 1K3
Phone. 905.790.2601 Fax.905.790.2644 www.gc-architects.com

PROPOSED RESIDENTIAL DEVELOPMENT

# 25 BAKER HILL BLVD.

ROYAL PINES HOMES

STOUFFVILLE ONTARIO

| | |
|---|---|
| Project Architect: | B.GRAZIANI |
| Assistant Designer: | R.LINCOLN |
| Drawn By: | S.G. |
| Checked By: | G.COLANGELO/D.BIASE |
| Plot Date: | Nov. 7, 2017 |
| Job # | 1136.13 |

3rd FLOOR PLAN
OVERALL PLAN

1:100

A303

TITLEBLOCK SIZE: 915 x 1400

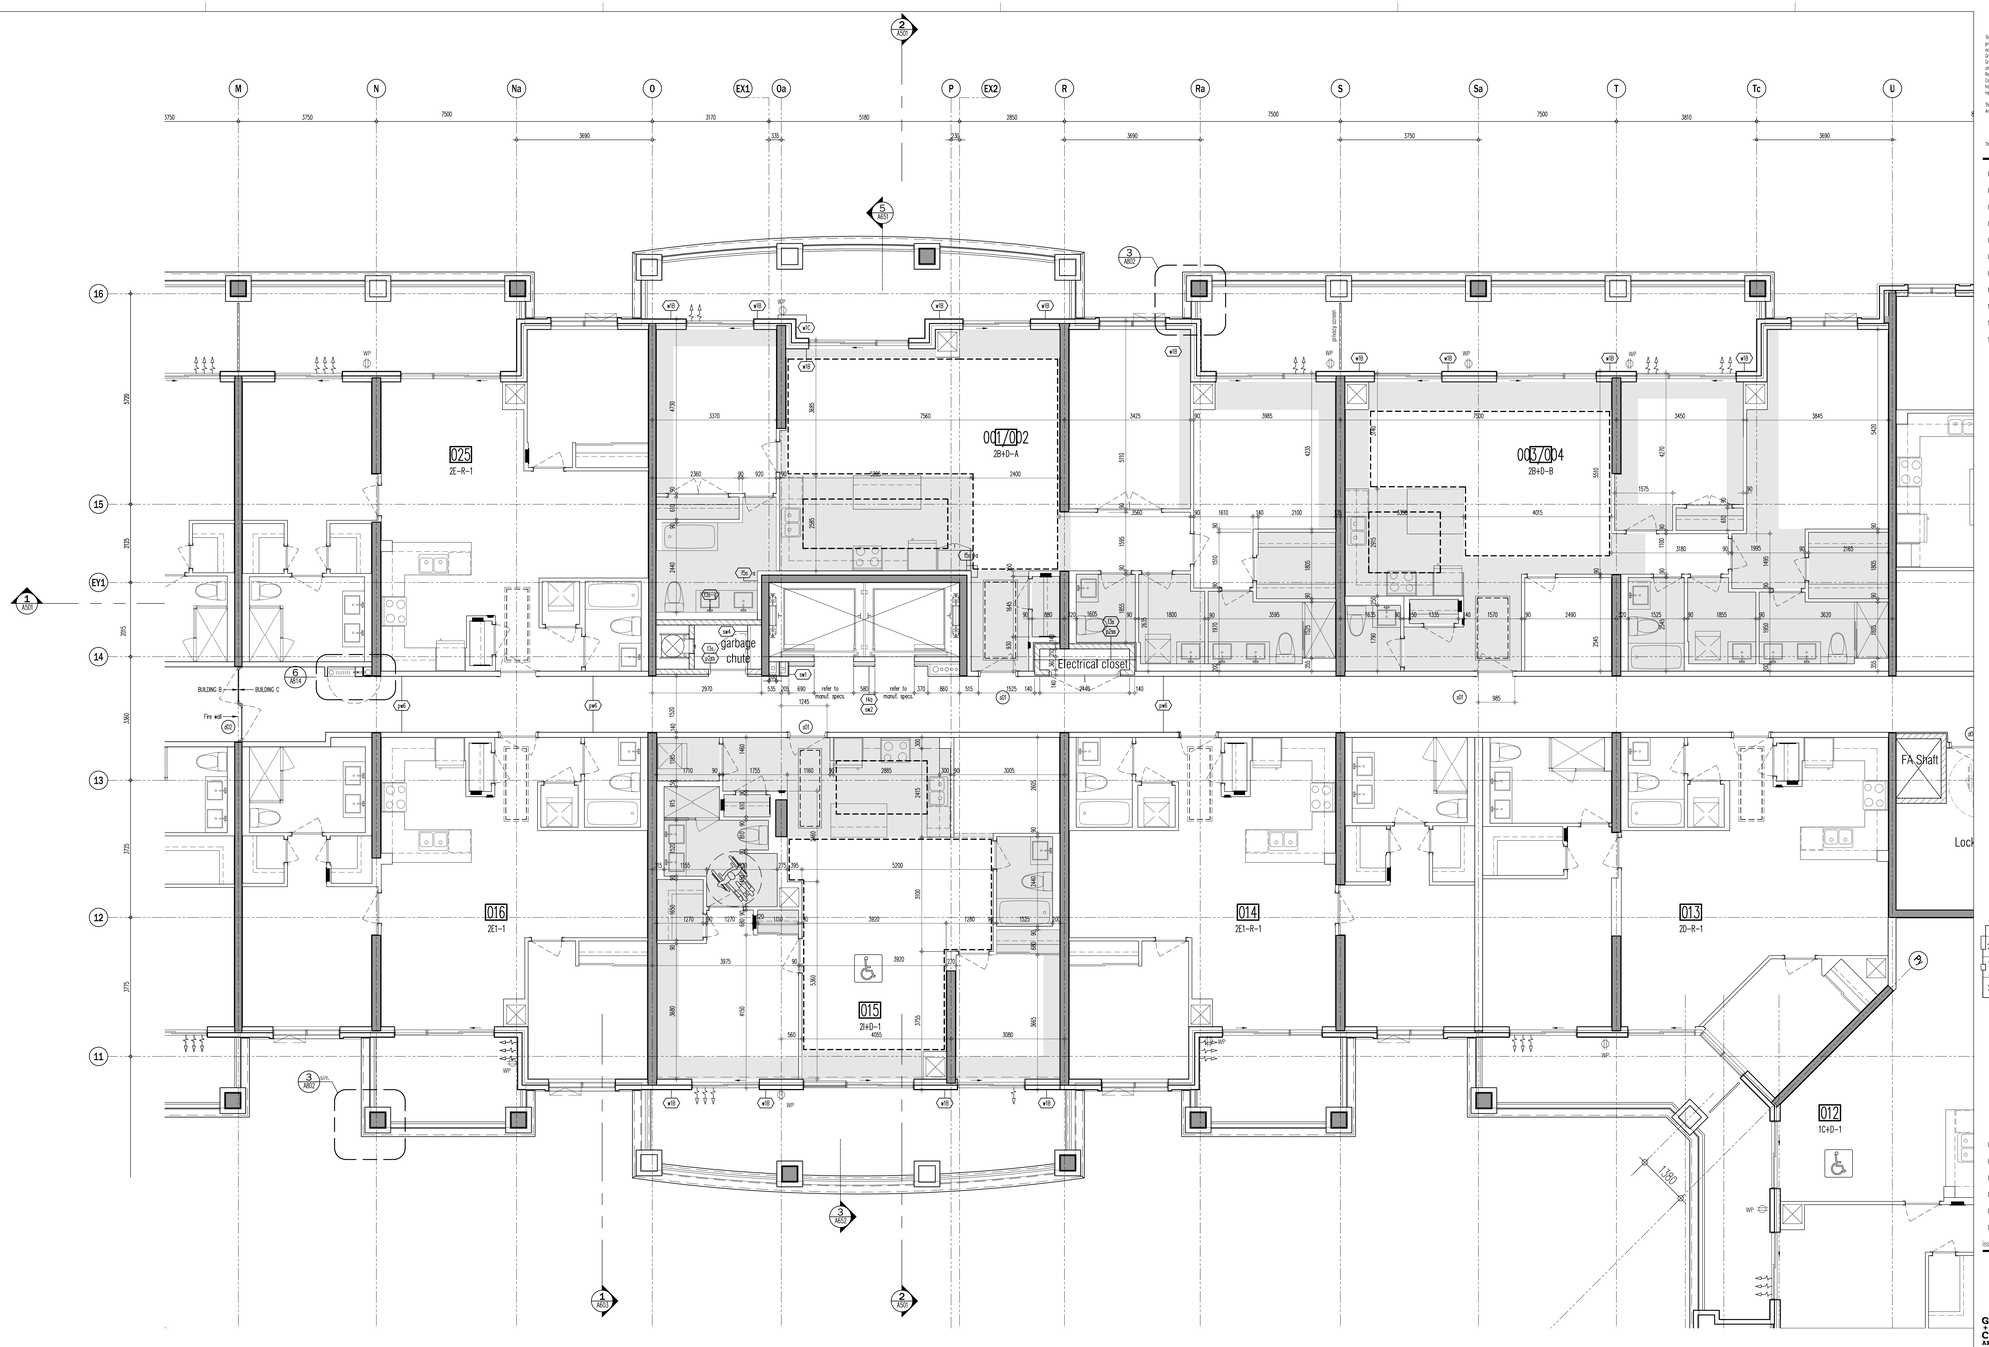


This drawing, as an instrument of service, is provided by and is the property of Graziani + Corazza Architects Inc. and may not be used without the Architect's written permission or reproduced on any medium. Graziani + Corazza Architects Inc. will not be responsible for any variations from the supplied information. Graziani + Corazza Architects Inc. is not responsible for the accuracy of survey, structural, mechanical, electrical, etc., engineering information shown on this drawing. Refer to the appropriate engineering drawings before proceeding with the work. Construction must conform to all applicable codes and requirements of the authorities having jurisdiction. Unless otherwise noted, no investigation has been undertaken or reported on by this office in regards to the environmental condition of this site.

This drawing is not to be used for construction purposes until countersigned by the Architect.

This drawing is not to be scaled. All architectural symbols indicated on this drawing are graphic representations only.

| | | | |
|---|---|---|---|
| 01. | FEB.28.2014 | issued to city for SPA | B.G. |
| 02. | JUL.9.2014 | re-issued to city for SPA | B.G. |
| 03. | SEP.11.2014 | re-issued to city for SPA | B.G. |
| 04. | JAN.15.2015 | re-issued to city for SPA | B.G. |
| 05. | MAR.15.2015 | issued for tender | B.G. |
| 06. | DEC.28.2016 | issued for building permit | B.G. |
| 07. | MAY.10.2017 | re-issued for building permit | B.G. |
| 08. | MAY.10.2017 | Issued for Footings and Foundation Permit | B.G. |
| 10. | JULY.19.2017 | Progress for Construction | B.G. |
| 11. | AUG.09.2017 | Issued for Construction | B.G. |
| 12. | OCT.25.2017 | Revision to Envelope | B.G. |

Note: Suites are the same as 2nd floor with the exception of units 001/002, 003/004 and 015. For other suite dimensions / information, please refer to dwgs A302b-d.

| CEILING HEIGHTS | | | |
|---|---|---|---|
| FLOOR | FOYER & KITCHEN | BULKHEADS | LIVING/ DINING/DEN/BEDROOM |
| GRD | 2950 | 2750 | 2950 |
| 2ND | 2600 | 2450 | SLAB AT 2750 |
| 3RD | 2600 | 2450 | SLAB AT 2750 |
| 4TH | 2600 | 2450 | SLAB AT 2750 |
| 5TH | 2600 | 2450 | SLAB AT 2750 / 2700 |
| 6TH | 2600 | 2450 | SLAB AT 2750 / 2700 |
| 7TH | 2900 | 2750 | 3050 |

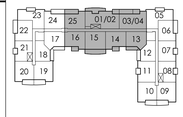


| | | | |
|---|---|---|---|
| 06. | FEB.12.2018 | S113 REVISING OPERABLE WINDOWS | BG |
| 05. | DEC.07.2017 | S110 SHOWING BARRIER-FREE SYMBOL | BG |
| 04. | DEC.07.2017 | S109 GARBAGE CHUTE PIPE SPACE | BG |
| 03. | AUG.24.2017 | S102-R1 REVISION TO SUITE NUMBERS | BG |
| 02. | AUG.21.2017 | S103 SANDBLAST PRECAST ON BALCONIES | BG |
| 01. | AUG.18.2017 | S102 REVISION TO SUITE NUMBERS | BG |

Issued for revisions

GRAZIANI + CORAZZA ARCHITECTS INC.

1220 Dorsan Drive, Suite 100 Mississauga Ontario L4W 1C3
Phone 905.795.2601 Fax 905.795.2944 www.gc-architects.com

PROPOSED RESIDENTIAL DEVELOPMENT

# 25 BAKER HILL BLVD.

ROYAL PINES HOMES

STOUFFVILLE ONTARIO

| | |
|---|---|
| Project Architect: | B.GRAZIANI |
| Assistant Designer: | R.LINCOLN |
| Drawn By: | S.G. |
| Checked By: | G.COLANGELO/D.BIASE |
| Plot Date: | Nov. 7, 2017 |
| Job # | 1136.13 |

## 3rd FLOOR PLAN
## PARTIAL PLAN

1:50 A303a

TITLEBLOCK SIZE: 915 x 1400

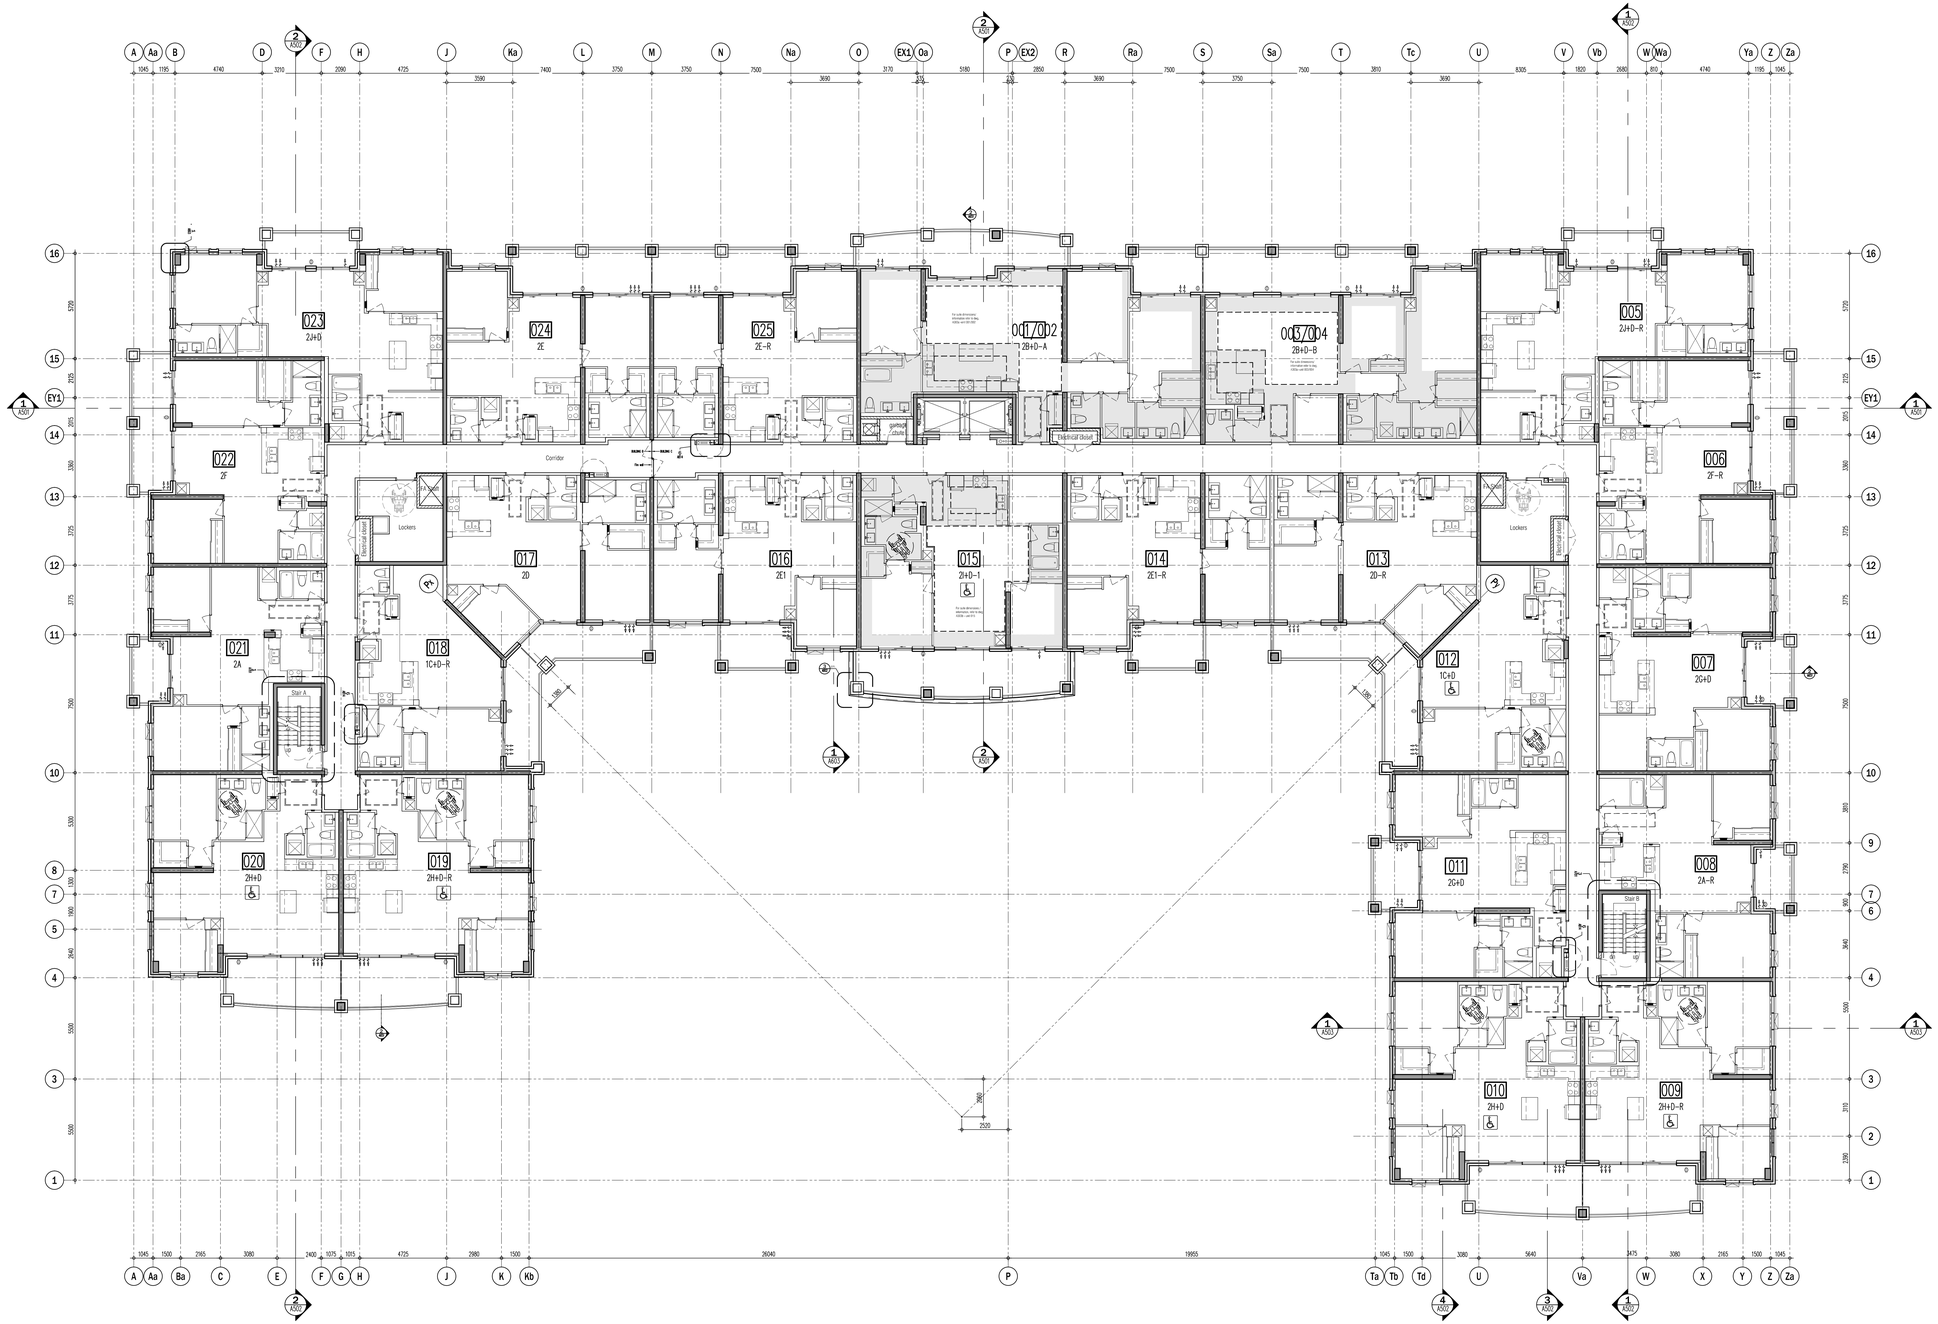


| CEILING HEIGHTS | | | |
|---|---|---|---|
| FLOOR | FOYER & KITCHEN | BULKHEADS | LIVING/ DINING/DEN/BEDROOM |
| GRD | 2950 | 2750 | 2950 |
| 2ND | 2600 | 2450 | SLAB AT 2750 |
| 3RD | 2600 | 2450 | SLAB AT 2750 |
| 4TH | 2600 | 2450 | SLAB AT 2750 |
| 5TH | 2600 | 2450 | SLAB AT 2750 / 2700 |
| 6TH | 2600 | 2450 | SLAB AT 2750 / 2700 |
| 7TH | 2900 | 2750 | 3050 |

Note: Suites are the same as 2nd floor with the exception of units 001/002, 003/004 and 015. For other suite dimensions / information, please refer to dwgs A302b-d.

This drawing, as an instrument of service, is provided by and is the property of Graziani + Corazza Architects Inc. and may not be used and reproduced without our consent. All dimensions and conditions on site must be verified by Graziani + Corazza Architects Inc. of any variations from the supplied information. Graziani + Corazza Architects Inc. is not responsible for the accuracy of survey, structural, mechanical, electrical, etc., engineering information shown on this drawing. Refer to the appropriate engineering drawings before proceeding with the work. Construction must conform to all applicable codes and requirements of the authorities having jurisdiction. Unless otherwise noted, no investigation has been undertaken or reported on by this office in regards to the environmental condition of this site.

This drawing is not to be used for construction purposes until countersigned by the Architect.

This drawing is not to be scaled. All architectural symbols indicated on this drawing are graphic representations only.

| | | | |
|---|---|---|---|
| 01. | FEB.28.2014 | issued to city for SPA | B.G. |
| 02. | JUL.9.2014 | re-issued to city for SPA | B.G. |
| 03. | SEP.11.2014 | re-issued to city for SPA | B.G. |
| 04. | JAN.15.2015 | re-issued to city for SPA | B.G. |
| 05. | MAR.15.2015 | issued for tender | B.G. |
| 06. | DEC.28.2016 | issued for building permit | B.G. |
| 07. | MAY.10.2017 | re-issued for building permit | B.G. |
| 08. | MAY.10.2017 | Issued for Footings and Foundation Permit | B.G. |
| 10. | JULY.19.2017 | Progress for Construction | B.G. |
| 11. | AUG.09.2017 | Issued for Construction | B.G. |
| 12. | OCT.25.2017 | Revision to Envelope | B.G. |

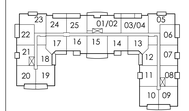


| | | | |
|---|---|---|---|
| 05. | FEB.12.2018 | S113 REVISING OPERABLE WINDOWS | BG |
| 04. | DEC.07.2017 | S110 SHOWING BARRIER-FREE SYMBOL | BG |
| 03. | DEC.07.2017 | S109 GARBAGE CHUTE PIPE SPACE | BG |
| 02. | AUG.24.2017 | S102-R1 REVISION TO SUITE NUMBERS | BG |
| 01. | AUG.18.2017 | S102 REVISION TO SUITE NUMBERS | BG |

Issued for revisions

GRAZIANI + CORAZZA ARCHITECTS INC.
1320 Dawson Drive, Suite 100 Mississauga Ontario LN9 1K3
Phone 905.790.2601 Fax 905.790.2844 www.gc-architects.com

PROPOSED RESIDENTIAL DEVELOPMENT

# 25 BAKER HILL BLVD.

ROYAL PINES HOMES

STOUFFVILLE ONTARIO

| | |
|---|---|
| Project Architect: | B.GRAZIANI |
| Assistant Designer: | R.LINCOLN |
| Drawn By: | S.G. |
| Checked By: | G.COLANGELO/D.BIASE |
| Plot Date: | Nov. 7, 2017 |
| Job # | 1136.13 |

## 4th FLOOR PLAN OVERALL PLAN

1:100

A304

TITLEBLOCK SIZE: 915 x 1400

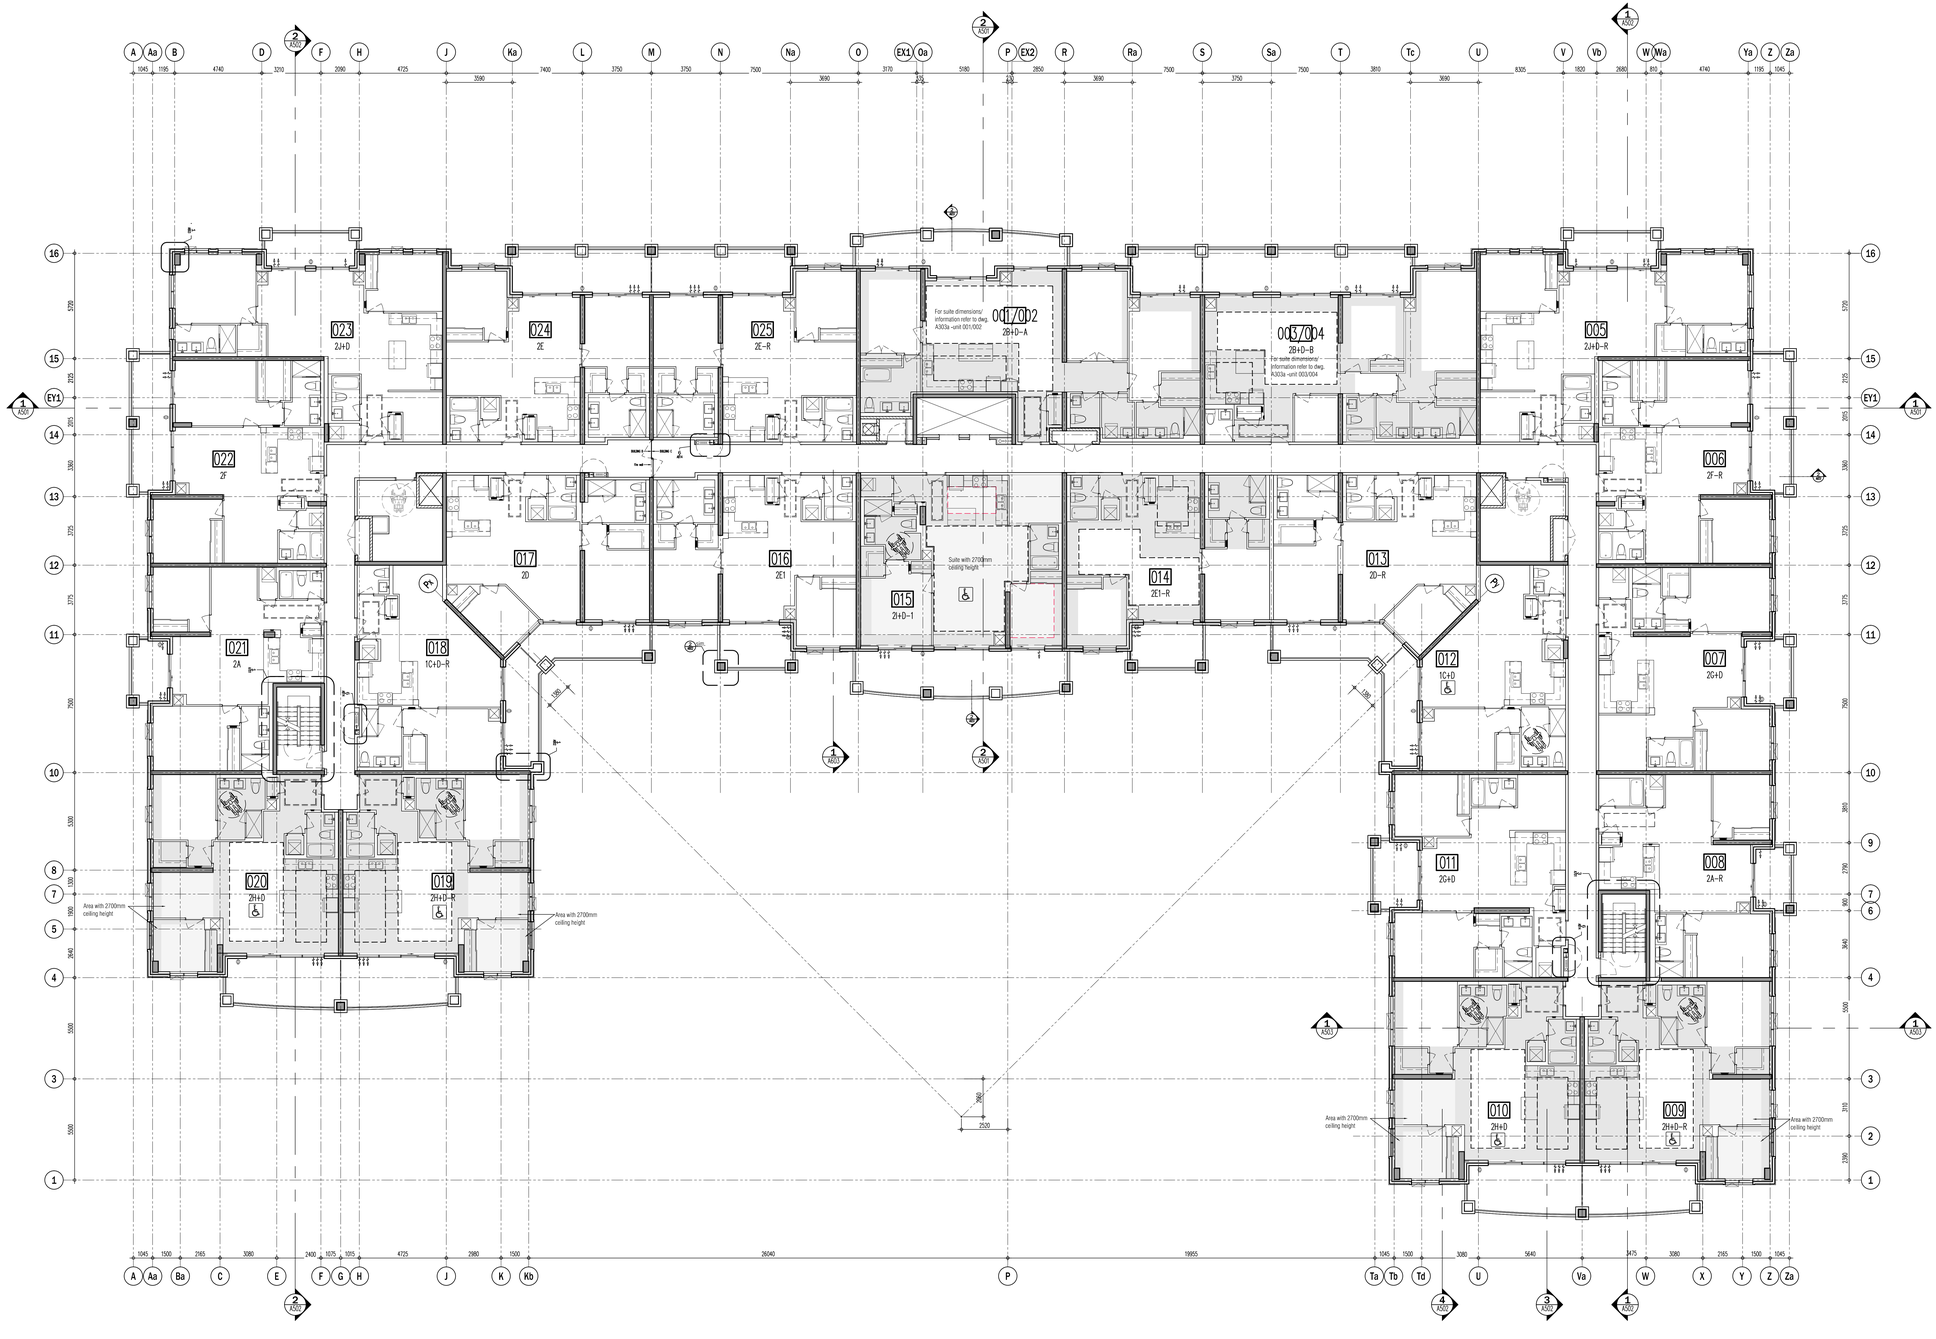


Note: Suites are the same as 2nd floor with the exception of units 001/002, 003/004 and 015. For other suite dimensions / information, please refer to dwgs A302b-d.

## CEILING HEIGHTS

| FLOOR | FOYER & KITCHEN | BULKHEADS | LIVING/ DINING/DEN/BEDROOM |
|---|---|---|---|
| GRD | 2950 | 2750 | 2950 |
| 2ND | 2600 | 2450 | SLAB AT 2750 |
| 3RD | 2600 | 2450 | SLAB AT 2750 |
| 4TH | 2600 | 2450 | SLAB AT 2750 |
| 5TH | 2600 | 2450 | SLAB AT 2750 / 2700 |
| 6TH | 2600 | 2450 | SLAB AT 2750 / 2700 |
| 7TH | 2900 | 2750 | 3050 |

This drawing, as an instrument of service, is provided by and is the property of Graziani + Corazza Architects Inc. and may not be used or reproduced without permission. All dimensions and conditions on site must be verified by Graziani + Corazza Architects Inc. of any variations from the supplied information. Graziani + Corazza Architects Inc. is not responsible for the accuracy of surveys, structural, mechanical, electrical, etc., engineering information shown on this drawing. Refer to the appropriate engineering drawings before proceeding with the work. Construction must conform to all applicable codes and requirements of the authorities having jurisdiction. Unless otherwise noted, no investigation has been undertaken or reported on by this office in regards to the environmental condition of this site.

This drawing is not to be used for construction purposes until countersigned by the Architect.

This drawing is not to be scaled. All architectural symbols indicated on this drawing are graphic representations only.

| | | | |
|---|---|---|---|
| 01. | FEB.28.2014 | issued to city for SPA | B.G. |
| 02. | JUL.9.2014 | re-issued to city for SPA | B.G. |
| 03. | SEP.11.2014 | re-issued to city for SPA | B.G. |
| 04. | JAN.15.2015 | re-issued to city for SPA | B.G. |
| 05. | MAR.15.2015 | issued for tender | B.G. |
| 06. | DEC.28.2016 | issued for building permit | B.G. |
| 07. | MAY.10.2017 | re-issued for building permit | B.G. |
| 08. | MAY.10.2017 | Issued for Footings and Foundation Permit | B.G. |
| 10. | JULY.19.2017 | Progress for Construction | B.G. |
| 11. | AUG.09.2017 | Issued for Construction | B.G. |
| 12. | OCT.25.2017 | Revision to Envelope | B.G. |

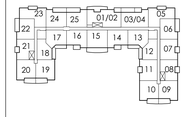


| | | | |
|---|---|---|---|
| 05. | FEB.12.2018 | S113 REVISING OPERABLE WINDOWS | BG |
| 04. | DEC.07.2017 | S110 SHOWING BARRIER-FREE SYMBOL | BG |
| 03. | DEC.07.2017 | S109 GARBAGE CHUTE PIPE SPACE | BG |
| 02. | AUG.24.2017 | S102-R1 REVISION TO SUITE NUMBERS | BG |
| 01. | AUG.18.2017 | S102 REVISION TO SUITE NUMBERS | BG |

Issued for revisions

GRAZIANI + CORAZZA ARCHITECTS INC.
1339 Dupont Ont. Suite 301 Mississauga Ontario L6B 1E3
Phone. 905.785.2601 Fax.905.785.2864 www.gc-architects.com

PROPOSED RESIDENTIAL DEVELOPMENT

# 25 BAKER HILL BLVD.

ROYAL PINES HOMES

STOUFFVILLE ONTARIO

| | |
|---|---|
| Project Architect: | B.GRAZIANI |
| Assistant Designer: | R.LINCOLN |
| Drawn By: | S.G. |
| Checked By: | G.COLANGELO/D.BIASE |
| Plot Date: | Nov. 7, 2017 |
| Job # | 1136.13 |

5th FLOOR PLAN
OVERALL PLAN

1:100 A305

TITLEBLOCK SIZE: 915 x 1400

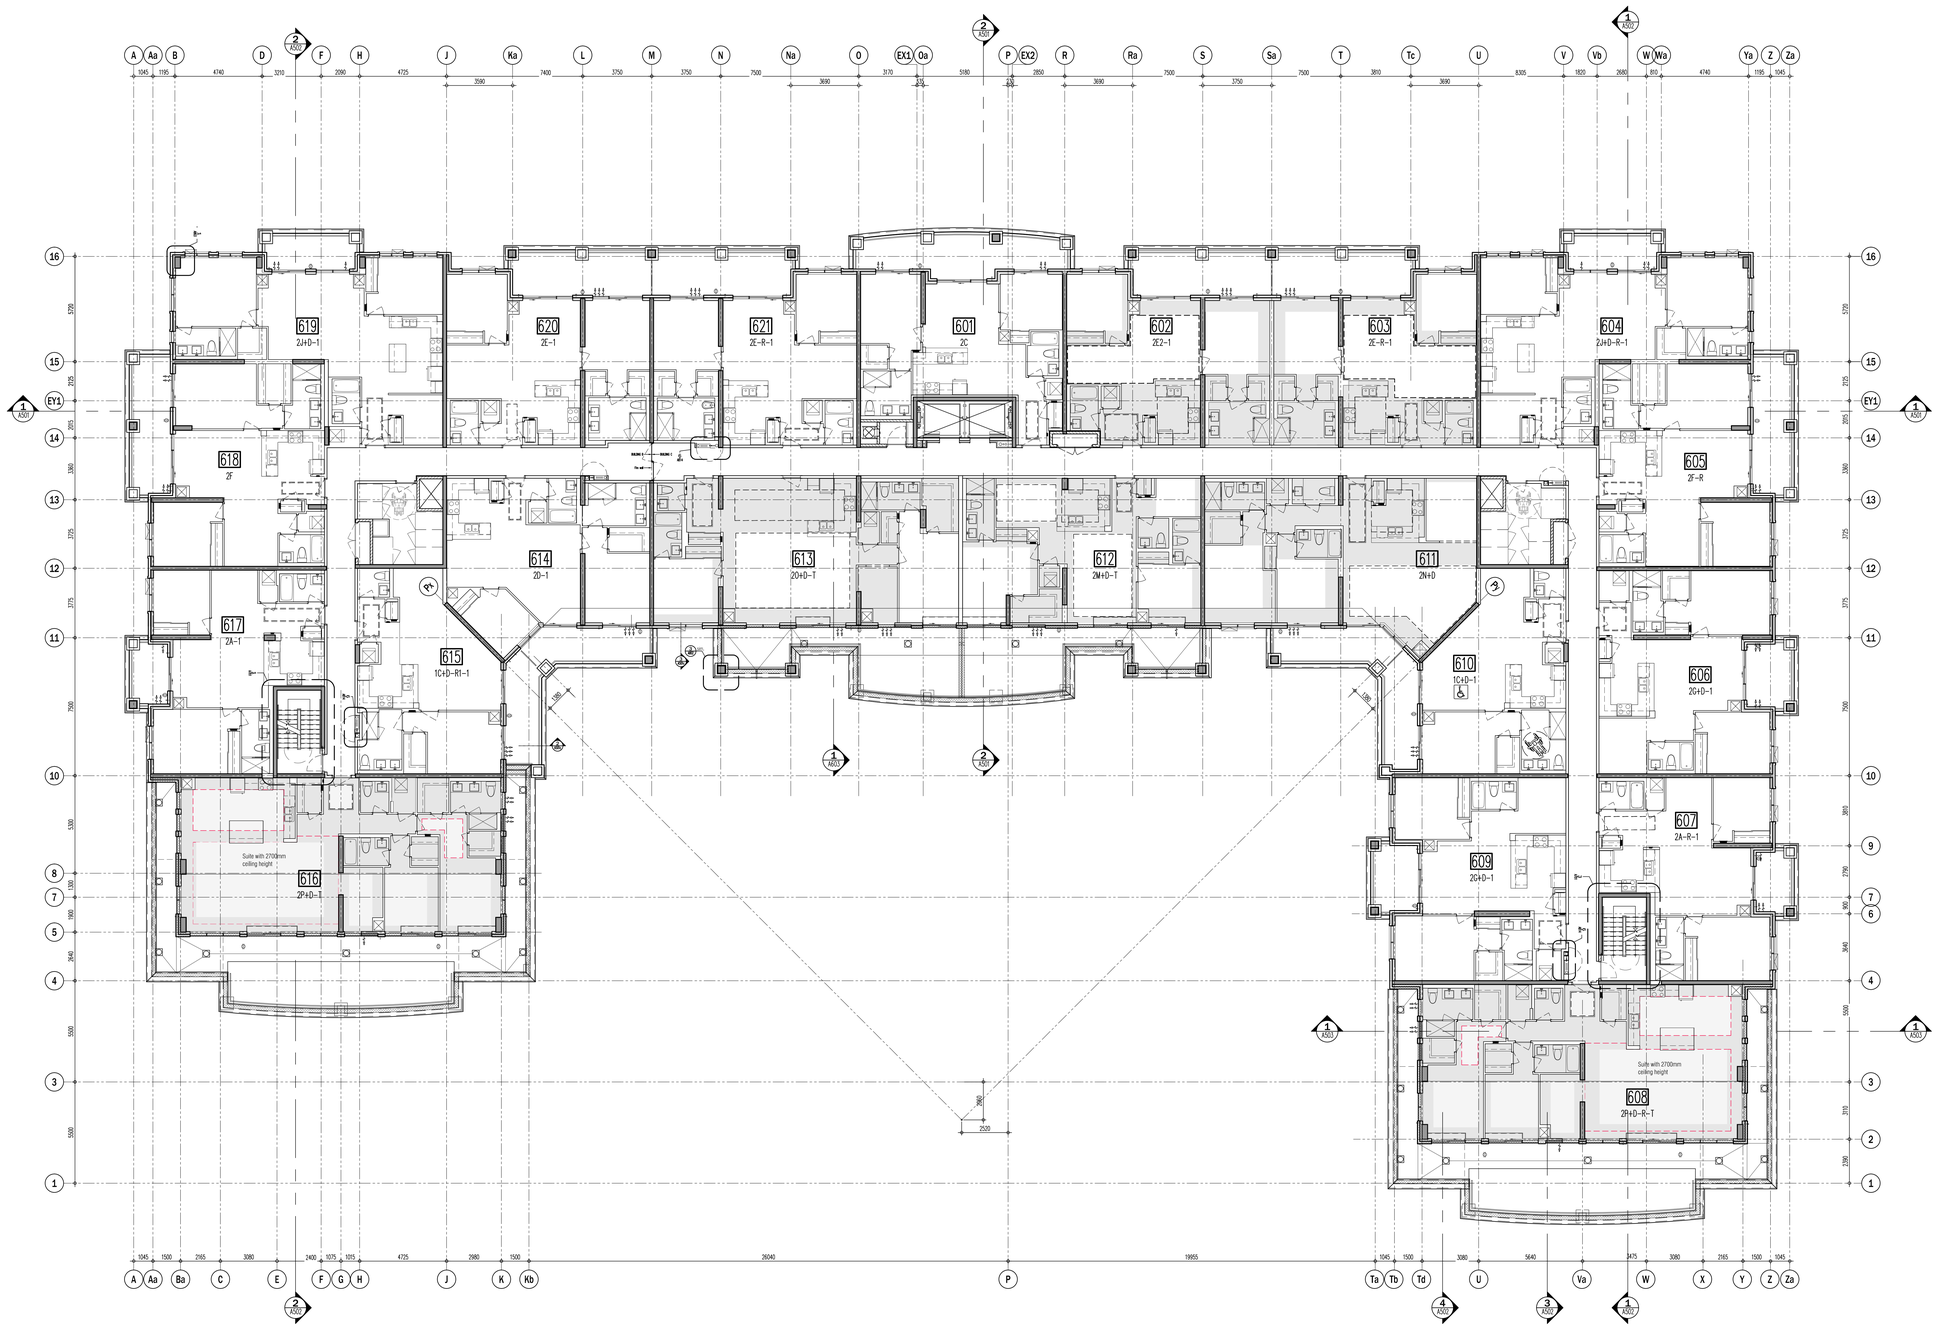


| CEILING HEIGHTS | | | |
|---|---|---|---|
| FLOOR | FOYER & KITCHEN | BULKHEADS | LIVING/ DINING/DEN/BEDROOM |
| GRD | 2950 | 2750 | 2950 |
| 2ND | 2600 | 2450 | SLAB AT 2750 |
| 3RD | 2600 | 2450 | SLAB AT 2750 |
| 4TH | 2600 | 2450 | SLAB AT 2750 |
| 5TH | 2600 | 2450 | SLAB AT 2750 / 2700 |
| 6TH | 2600 | 2450 | SLAB AT 2750 / 2700 |
| 7TH | 2900 | 2750 | 3050 |

This drawing, as an instrument of service, is provided by and is the property of Graziani + Corazza Architects Inc. and may not be used or reproduced without permission. All dimensions and conditions on site must be verified by Graziani + Corazza Architects Inc. of any variations from the supplied information. Graziani + Corazza Architects Inc. is not responsible for the accuracy of survey, structural, mechanical, electrical, etc., engineering information shown on this drawing. Refer to the appropriate engineering drawings before proceeding with the work. Construction must conform to all applicable codes and requirements of the authorities having jurisdiction. Unless otherwise noted, no investigation has been undertaken or reported on by this office in regards to the environmental condition of this site.

This drawing is not to be used for construction purposes until countersigned by the Architect.

This drawing is not to be scaled. All architectural symbols indicated on this drawing are graphic representations only.

| | | | |
|---|---|---|---|
| 01. | FEB.28.2014 | issued to city for SPA | B.G. |
| 02. | JUL.9.2014 | re-issued to city for SPA | B.G. |
| 03. | SEP.11.2014 | re-issued to city for SPA | B.G. |
| 04. | JAN.15.2015 | re-issued to city for SPA | B.G. |
| 05. | MAR.15.2015 | issued for tender | B.G. |
| 06. | DEC.28.2016 | issued for building permit | B.G. |
| 07. | MAY.10.2017 | re-issued for building permit | B.G. |
| 08. | MAY.10.2017 | Issued for Footings and Foundation Permit | B.G. |
| 10. | JULY.19.2017 | Progress for Construction | B.G. |
| 11. | AUG.09.2017 | Issued for Construction | B.G. |
| 12. | OCT.25.2017 | Revision to Envelope | B.G. |

| | | | |
|---|---|---|---|
| 03. | FEB.12.2018 | S13 REVISING OPERABLE WINDOWS | BG |
| 02. | DEC.07.2017 | S110 SHOWING BARRIER-FREE SYMBOL | BG |
| 01. | DEC.07.2017 | S109 GARBAGE CHUTE PIPE SPACE | BG |

issued for revisions

GRAZIANI + CORAZZA ARCHITECTS INC.
1229 Shawson Drive, Suite 100 Mississauga Ontario L4W 1C3
Phone 905.795.2601 Fax 905.795.2964 www.gc-architects.com

PROPOSED RESIDENTIAL DEVELOPMENT

# 25 BAKER HILL BLVD.

ROYAL PINES HOMES

STOUFFVILLE ONTARIO

| | |
|---|---|
| Project Architect: | B.GRAZIANI |
| Assistant Designer: | R.LINCOLN |
| Drawn By: | S.G. |
| Checked By: | G.COLANGELO/D.BIASE |
| Plot Date: | Nov. 7, 2017 |
| Job # | 1136.13 |

6TH FLOOR PLAN
OVERALL PLAN

1:100 A306

TITLEBLOCK SIZE: 915 x 1400

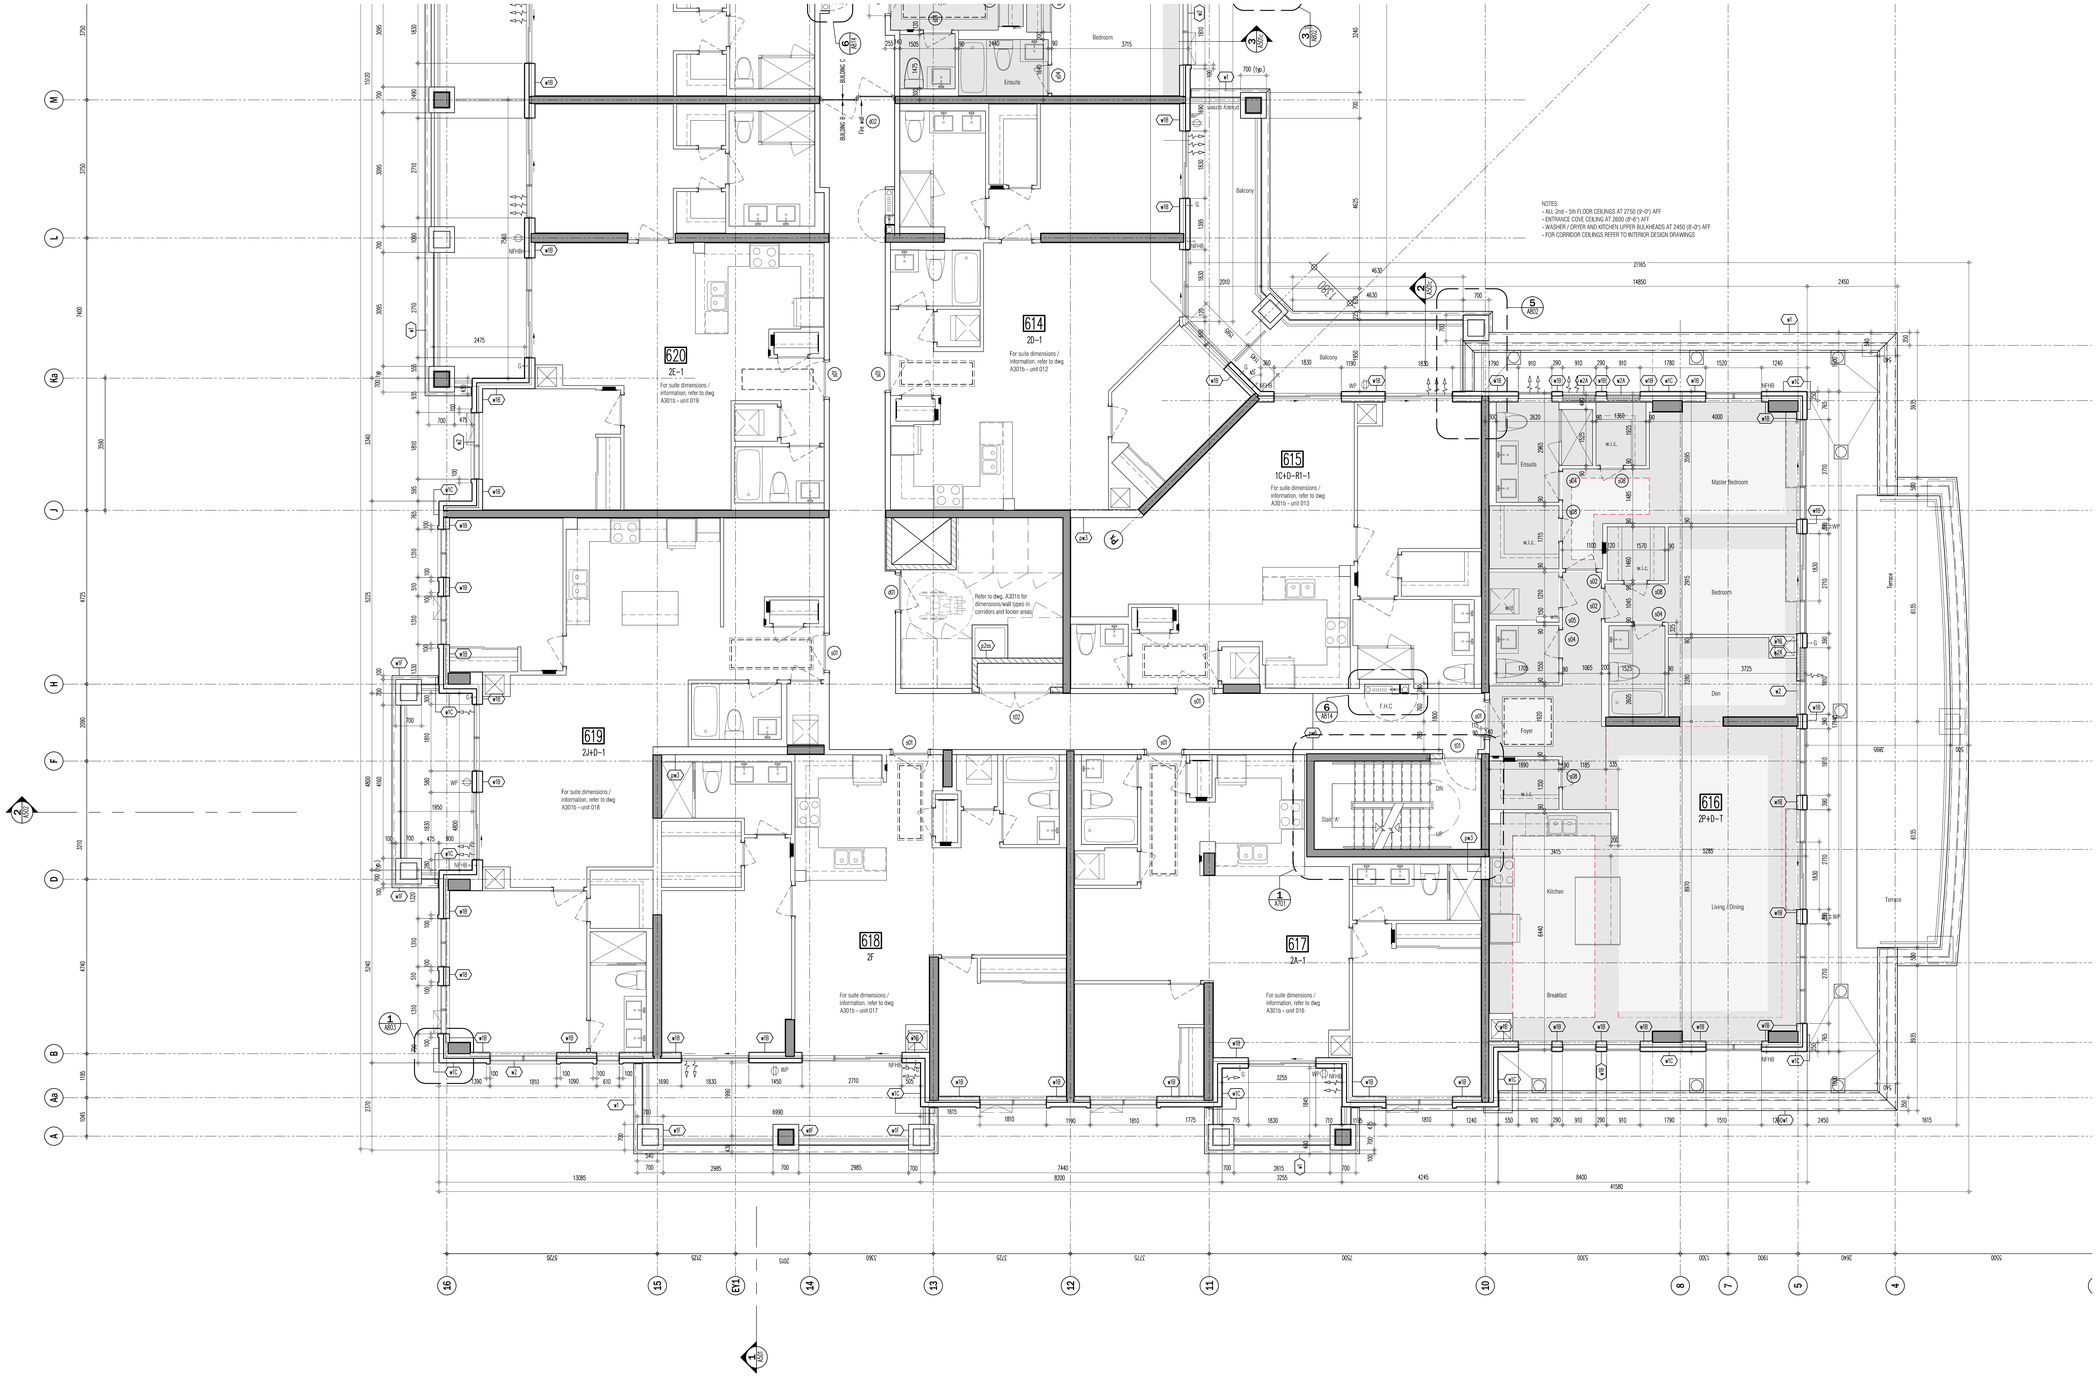


| CEILING HEIGHTS | | | |
|---|---|---|---|
| FLOOR | FOYER & KITCHEN | BULKHEADS | LIVING/ DINING/DEN/BEDROOM |
| GRD | 2950 | 2750 | 2950 |
| 2ND | 2600 | 2450 | SLAB AT 2750 |
| 3RD | 2600 | 2450 | SLAB AT 2750 |
| 4TH | 2600 | 2450 | SLAB AT 2750 |
| 5TH | 2600 | 2450 | SLAB AT 2750 / 2700 |
| 6TH | 2600 | 2450 | SLAB AT 2750 / 2700 |
| 7TH | 2900 | 2750 | 3050 |

This drawing, as an instrument of service, is provided by and is the property of Graziani + Corazza Architects Inc. and may not be used in any way without the express written consent of Graziani + Corazza Architects Inc. Graziani + Corazza Architects Inc. is not responsible for the accuracy of survey, structural, mechanical, electrical, etc., engineering information shown on this drawing. Refer to the appropriate engineering drawings before proceeding with the work. Construction must conform to all applicable codes and requirements of the authorities having jurisdiction. Unless otherwise noted, no investigation has been undertaken or reported on by this office in regards to the environmental condition of this site.

This drawing is not to be used for construction purposes until countersigned by the Architect.

This drawing is not to be scaled. All architectural symbols indicated on this drawing are graphic representations only.

| | | | |
|---|---|---|---|
| 01. | FEB.28.2014 | issued to city for SPA | B.G. |
| 02. | JUL.9.2014 | re-issued to city for SPA | B.G. |
| 03. | SEP.11.2014 | re-issued to city for SPA | B.G. |
| 04. | JAN.15.2015 | re-issued to city for SPA | B.G. |
| 05. | MAR.15.2015 | issued for tender | B.G. |
| 06. | DEC.28.2016 | issued for building permit | B.G. |
| 07. | MAY.10.2017 | re-issued for building permit | B.G. |
| 08. | MAY.10.2017 | Issued for Footings and Foundation Permit | B.G. |
| 10. | JULY.19.2017 | Progress for Construction | B.G. |
| 11. | AUG.09.2017 | Issued for Construction | B.G. |
| 12. | OCT.25.2017 | Revision to Envelope | B.G. |

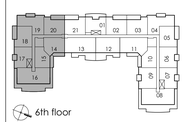


| | | | |
|---|---|---|---|
| 02. | FEB.12.2018 | S13 REVISING OPERABLE WINDOWS | BG |
| 01. | AUG.21.2017 | S103 SANDBLAST PRECAST ON BALCONIES | BG |

issued for revisions

GRAZIANI CORAZZA ARCHITECTS INC.
1229 Shawson Drive, Suite 100 Mississauga Ontario L4W 1C3
Phone 905.795.2601 Fax 905.795.2964 www.gc-architects.com

PROPOSED RESIDENTIAL DEVELOPMENT

# 25 BAKER HILL BLVD.

STOUFFVILLE ROYAL PINES HOMES ONTARIO

| | |
|---|---|
| Project Architect: | B.GRAZIANI |
| Assistant Designer: | R.LINCOLN |
| Drawn By: | S.G. |
| Checked By: | G.COLANGELO/D.BIASE |
| Plot Date: | Nov. 7, 2017 |
| Job # | 1136.13 |

## 6TH FLOOR ENLARGED PART PLAN

1:50 A306a

TITLEBLOCK SIZE: 915 x 1400

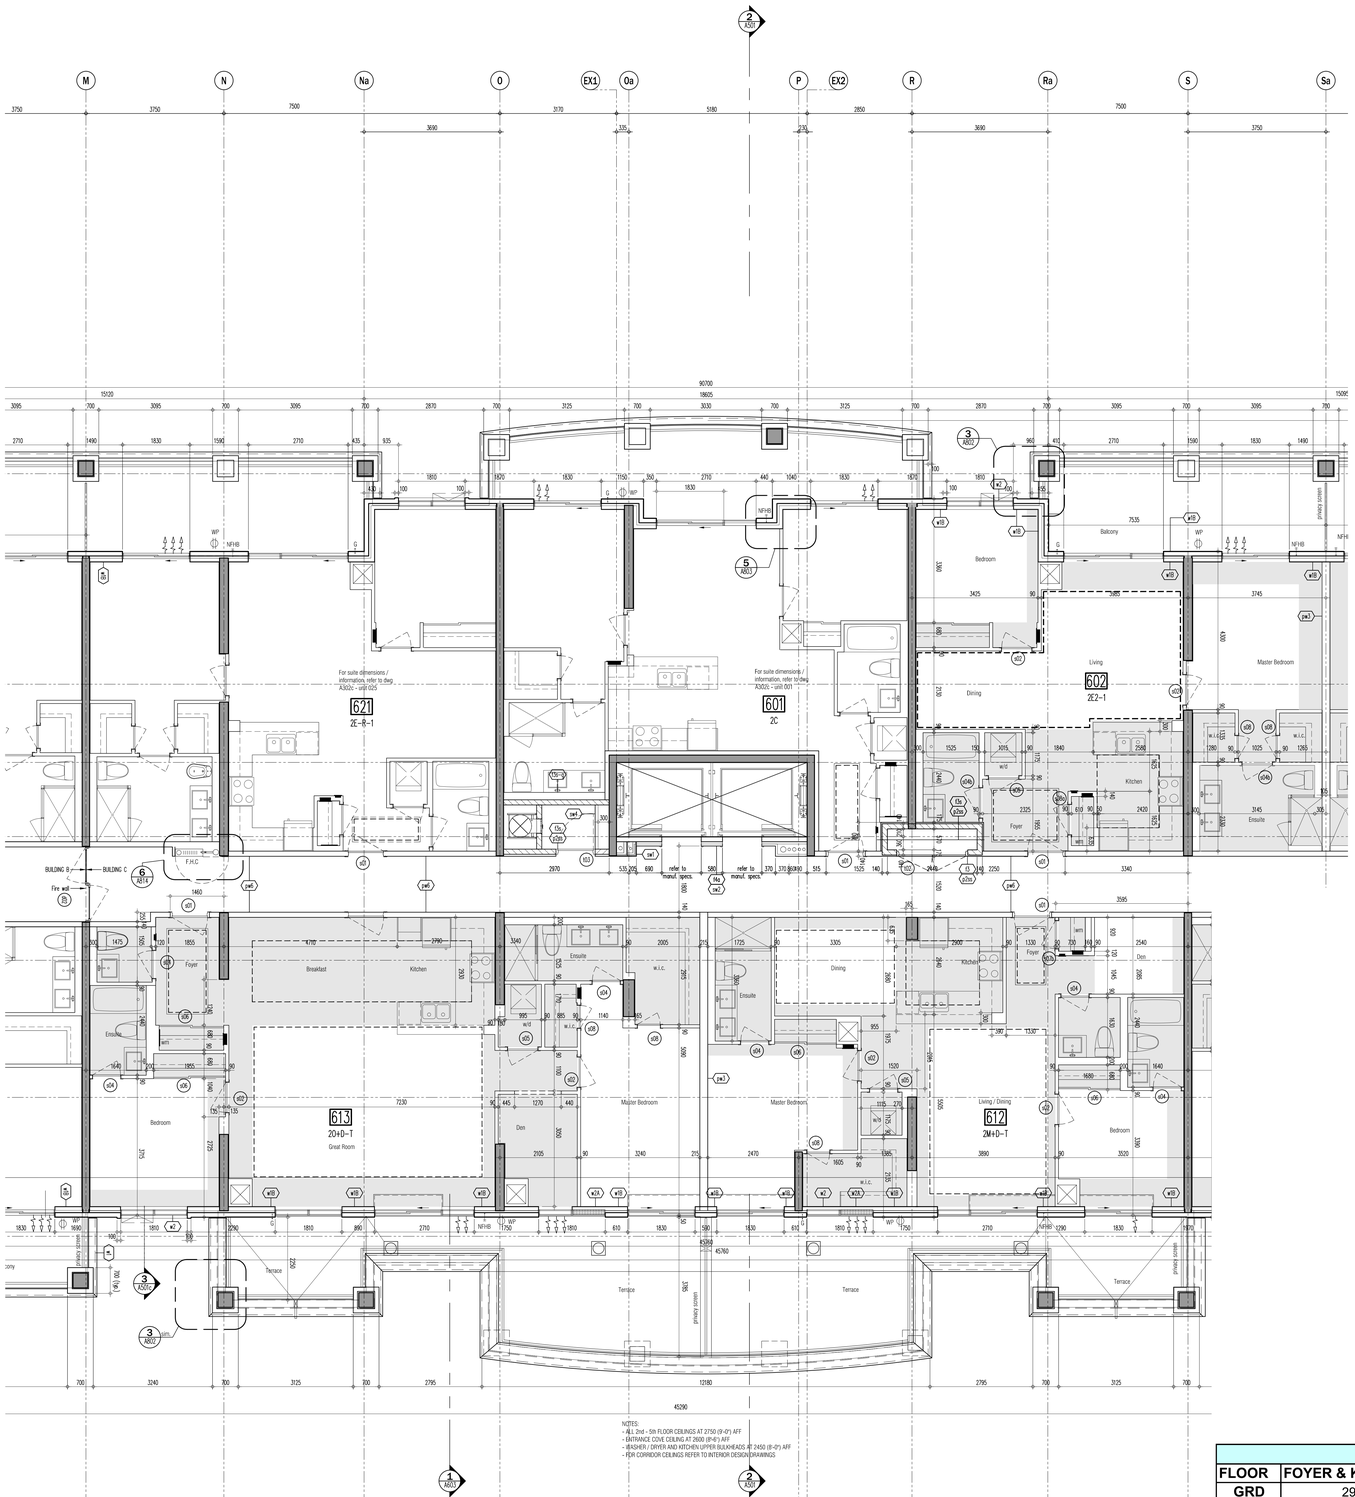


| CEILING HEIGHTS | | | |
|---|---|---|---|
| FLOOR | FOYER & KITCHEN | BULKHEADS | LIVING/ DINING/DEN/BEDROOM |
| GRD | 2950 | 2750 | 2950 |
| 2ND | 2600 | 2450 | SLAB AT 2750 |
| 3RD | 2600 | 2450 | SLAB AT 2750 |
| 4TH | 2600 | 2450 | SLAB AT 2750 |
| 5TH | 2600 | 2450 | SLAB AT 2750 / 2700 |
| 6TH | 2600 | 2450 | SLAB AT 2750 / 2700 |
| 7TH | 2900 | 2750 | 3050 |

This drawing, as an instrument of service, is provided by and is the property of Graziani + Corazza Architects Inc. and may not be used or reproduced without permission. All dimensions and conditions on site must be verified by Graziani + Corazza Architects Inc. of any variations from the supplied information. Graziani + Corazza Architects Inc. is not responsible for the accuracy of survey, structural, mechanical, electrical, etc., engineering information shown on this drawing. Refer to the appropriate engineering drawings before proceeding with the work. Construction must conform to all applicable codes and requirements of the authorities having jurisdiction. Unless otherwise noted, no investigation has been undertaken or reported on by this office in regards to the environmental condition of this site.

This drawing is not to be used for construction purposes until countersigned by the Architect.

This drawing is not to be scaled. All architectural symbols indicated on this drawing are graphic representations only.

| | | | |
|---|---|---|---|
| 01. | FEB.28.2014 | issued to city for SPA | B.G. |
| 02. | JUL.9.2014 | re-issued to city for SPA | B.G. |
| 03. | SEP.11.2014 | re-issued to city for SPA | B.G. |
| 04. | JAN.15.2015 | re-issued to city for SPA | B.G. |
| 05. | MAR.15.2015 | issued for tender | B.G. |
| 06. | DEC.28.2016 | issued for building permit | B.G. |
| 07. | MAY.10.2017 | re-issued for building permit | B.G. |
| 08. | MAY.10.2017 | Issued for Footings and Foundation Permit | B.G. |
| 10. | JULY.19.2017 | Progress for Construction | B.G. |
| 11. | AUG.09.2017 | Issued for Construction | B.G. |
| 12. | OCT.25.2017 | Revision to Envelope | B.G. |

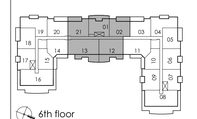


| | | | |
|---|---|---|---|
| 03. | FEB.12.2018 | S13 REVISING OPERABLE WINDOWS | BG |
| 02. | DEC.07.2017 | S109 GARBAGE CHUTE PIPE SPACE | BG |
| 01. | AUG.21.2017 | S103 SANDBLAST PRECAST ON BALCONIES | BG |

issued for revisions

GRAZIANI + CORAZZA ARCHITECTS INC.

1220 Dorsten Drive, Suite 100 Mississauga Ontario L4W 1C3
Phone 905.795.2601 Fax 905.795.2944 www.gc-architects.com

PROPOSED RESIDENTIAL DEVELOPMENT

# 25 BAKER HILL BLVD.

ROYAL PINES HOMES

STOUFFVILLE ONTARIO

| | |
|---|---|
| Project Architect: | B.GRAZIANI |
| Assistant Designer: | R.LINCOLN |
| Drawn By: | S.G. |
| Checked By: | G.COLANGELO/D.BIASE |
| Plot Date: | Nov. 7, 2017 |
| Job # | 1136.13 |

6TH FLOOR ENLARGED PART PLAN

1:50 A306b

TITLEBLOCK SIZE: 915 x 1400

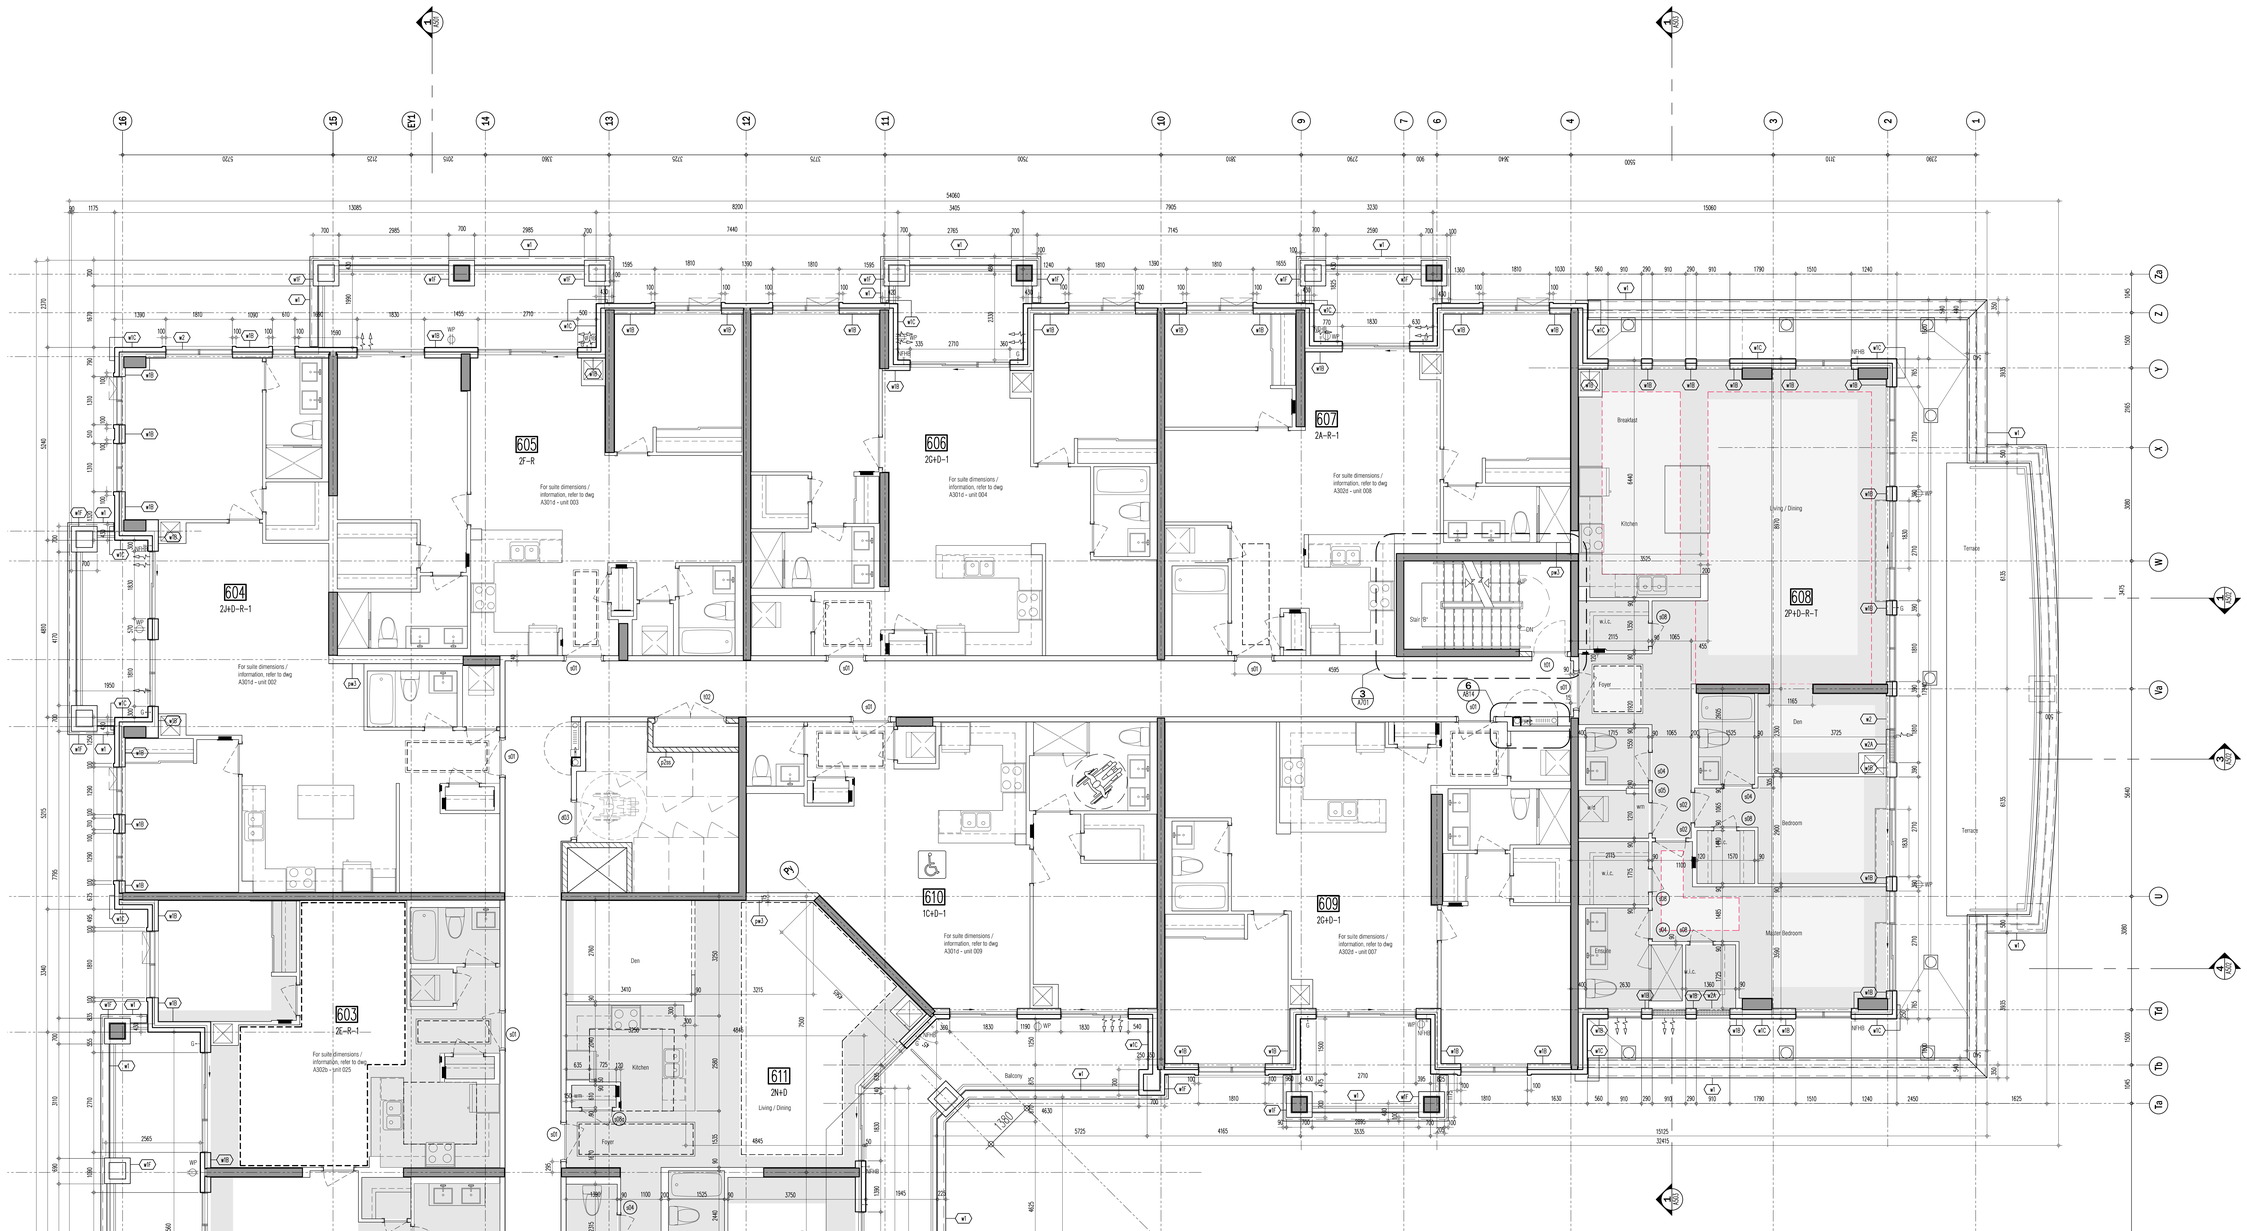


| CEILING HEIGHTS | | | |
|---|---|---|---|
| FLOOR | FOYER & KITCHEN | BULKHEADS | LIVING/ DINING/DEN/BEDROOM |
| GRD | 2950 | 2750 | 2950 |
| 2ND | 2600 | 2450 | SLAB AT 2750 |
| 3RD | 2600 | 2450 | SLAB AT 2750 |
| 4TH | 2600 | 2450 | SLAB AT 2750 |
| 5TH | 2600 | 2450 | SLAB AT 2750 / 2700 |
| 6TH | 2600 | 2450 | SLAB AT 2750 / 2700 |
| 7TH | 2900 | 2750 | 3050 |

This drawing, as an instrument of service, is provided by and is the property of Graziani + Corazza Architects Inc. and may not be used or reproduced without permission. All dimensions and conditions on site must be verified by Graziani + Corazza Architects Inc. of any variations from the supplied information. Graziani + Corazza Architects Inc. is not responsible for the accuracy of survey, structural, mechanical, electrical, etc., engineering information shown on this drawing. Refer to the appropriate engineering drawings before proceeding with the work. Construction must conform to all applicable codes and requirements of the authorities having jurisdiction. Unless otherwise noted, no investigation has been undertaken or reported on by this office in regards to the environmental condition of this site.

This drawing is not to be used for construction purposes until countersigned by the Architect.

This drawing is not to be scaled. All architectural symbols indicated on this drawing are graphic representations only.

| | | | |
|---|---|---|---|
| 01. | FEB.28.2014 | issued to city for SPA | B.G. |
| 02. | JUL.9.2014 | re-issued to city for SPA | B.G. |
| 03. | SEP.11.2014 | re-issued to city for SPA | B.G. |
| 04. | JAN.15.2015 | re-issued to city for SPA | B.G. |
| 05. | MAR.15.2015 | issued for tender | B.G. |
| 06. | DEC.28.2016 | issued for building permit | B.G. |
| 07. | MAY.10.2017 | re-issued for building permit | B.G. |
| 08. | MAY.10.2017 | Issued for Footings and Foundation Permit | B.G. |
| 10. | JULY.19.2017 | Progress for Construction | B.G. |
| 11. | AUG.09.2017 | Issued for Construction | B.G. |
| 12. | OCT.25.2017 | Revision to Envelope | B.G. |

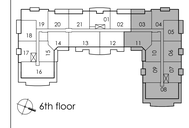


| | | | |
|---|---|---|---|
| 03. | FEB.12.2018 | S13: REVISING OPERABLE WINDOWS | BG |
| 02. | DEC.07.2017 | S110: SHOWING BARRIER-FREE SYMBOL | BG |
| 01. | AUG.21.2017 | S103: SANDBLAST PRECAST ON BALCONIES | BG |

Issued for revisions

GRAZIANI + CORAZZA ARCHITECTS INC.
1320 Sheraton Drive, Mississauga Ontario L4W 1C3
Phone 905.795.2601 Fax 905.795.2944 www.gc-architects.com

PROPOSED RESIDENTIAL DEVELOPMENT

# 25 BAKER HILL BLVD.

ROYAL PINES HOMES

STOUFFVILLE ONTARIO

| | |
|---|---|
| Project Architect: | B.GRAZIANI |
| Assistant Designer: | R.LINCOLN |
| Drawn By: | S.G. |
| Checked By: | G.COLANGELO/D.BIASE |
| Plot Date: | Nov. 7, 2017 |
| Job # | 1136.13 |

6TH FLOOR ENLARGED PART PLAN

1:50

A306c

TITLEBLOCK SIZE: 915 x 1400

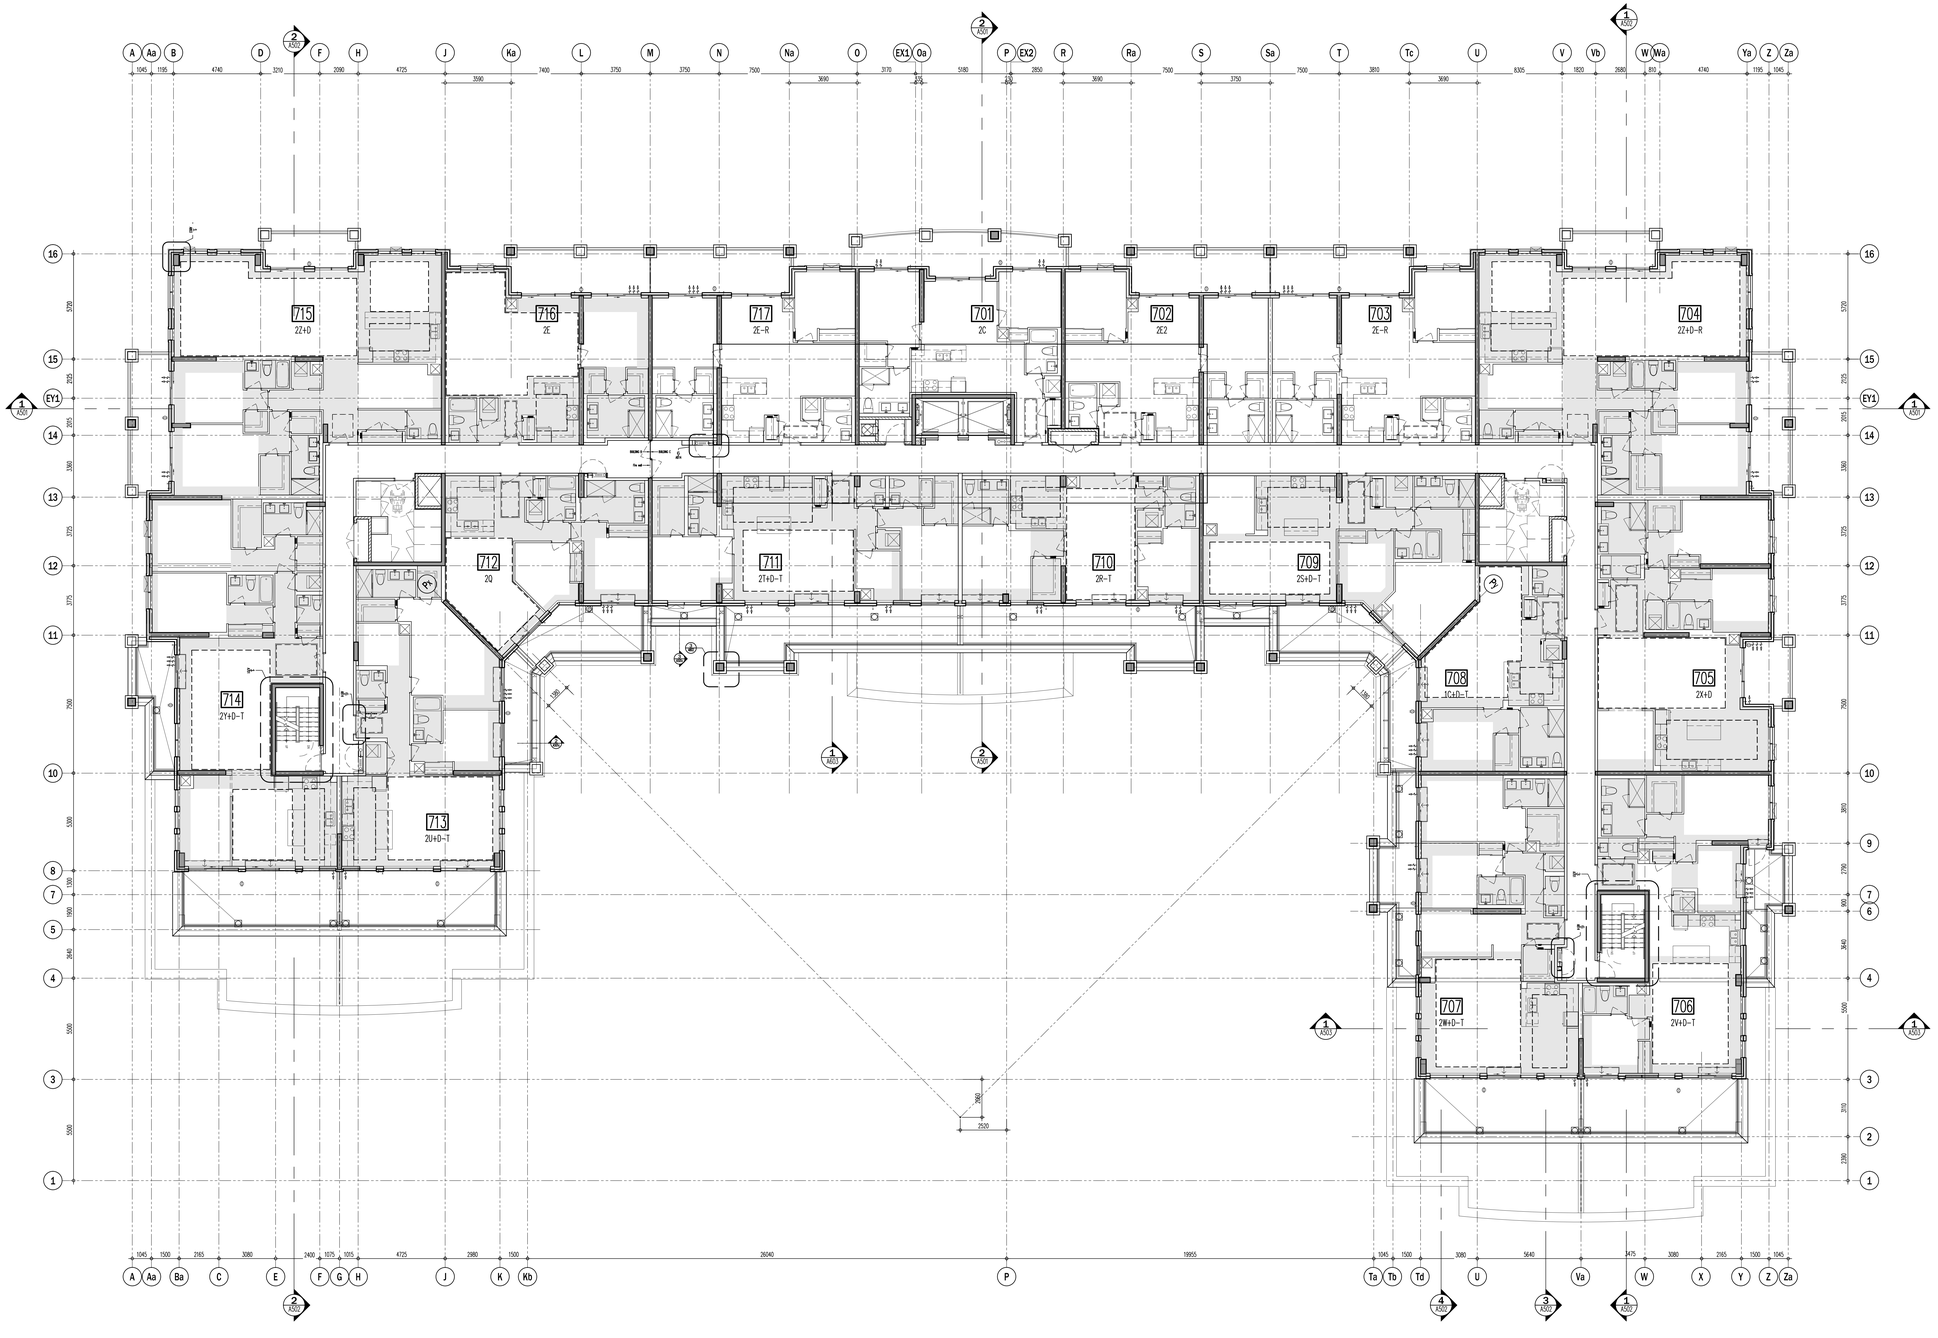


| CEILING HEIGHTS | | | |
|---|---|---|---|
| FLOOR | FOYER & KITCHEN | BULKHEADS | LIVING/ DINING/DEN/BEDROOM |
| GRD | 2950 | 2750 | 2950 |
| 2ND | 2600 | 2450 | SLAB AT 2750 |
| 3RD | 2600 | 2450 | SLAB AT 2750 |
| 4TH | 2600 | 2450 | SLAB AT 2750 |
| 5TH | 2600 | 2450 | SLAB AT 2750 / 2700 |
| 6TH | 2600 | 2450 | SLAB AT 2750 / 2700 |
| 7TH | 2900 | 2750 | 3050 |

This drawing, as an instrument of service, is provided by and is the property of Graziani + Corazza Architects Inc. and may not be used in whole or in part without the written consent of Graziani + Corazza Architects Inc. All rights reserved. Graziani + Corazza Architects Inc. is not responsible for the accuracy of survey, structural, mechanical, electrical, etc., engineering information shown on this drawing. Refer to the appropriate engineering drawings before proceeding with the work. Construction must conform to all applicable codes and requirements of the authorities having jurisdiction. Unless otherwise noted, no investigation has been undertaken or reported on by this office in regards to the environmental condition of this site.

This drawing is not to be used for construction purposes until countersigned by the Architect.

This drawing is not to be scaled. All architectural symbols indicated on this drawing are graphic representations only.

| | | | |
|---|---|---|---|
| 01. | FEB.28.2014 | issued to city for SPA | B.G. |
| 02. | JUL.9.2014 | re-issued to city for SPA | B.G. |
| 03. | SEP.11.2014 | re-issued to city for SPA | B.G. |
| 04. | JAN.15.2015 | re-issued to city for SPA | B.G. |
| 05. | MAR.15.2015 | issued for tender | B.G. |
| 06. | DEC.28.2016 | issued for building permit | B.G. |
| 07. | MAY.10.2017 | re-issued for building permit | B.G. |
| 08. | MAY.10.2017 | Issued for Footings and Foundation Permit | B.G. |
| 10. | JULY.19.2017 | Progress for Construction | B.G. |
| 11. | AUG.09.2017 | Issued for Construction | B.G. |
| 12. | OCT.25.2017 | Revision to Envelope | B.G. |
| 02. | FEB.12.2018 | S13 REVISING OPERABLE WINDOWS | BG |
| 01. | DEC.07.2017 | S109 GARBAGE CHUTE PIPE SPACE | BG |

issued for revisions

GRAZIANI
CORAZZA
ARCHITECTS INC.
1229 Shawson Drive, Suite 100 Mississauga Ontario L4W 1C3
Phone 905.795.2601 Fax 905.795.2964 www.gc-architects.com

PROPOSED RESIDENTIAL DEVELOPMENT

# 25 BAKER HILL BLVD.

ROYAL PINES HOMES

STOUFFVILLE ONTARIO

| | |
|---|---|
| Project Architect: | B.GRAZIANI |
| Assistant Designer: | R.LINCOLN |
| Drawn By: | S.G. |
| Checked By: | G.COLANGELO/D.BIASE |
| Plot Date: | Nov. 7, 2017 |
| Job # | 1136.13 |

## 7TH FLOOR PLAN
## OVERALL LAYOUT

1:100 A307

TITLEBLOCK SIZE: 915 x 1400

This drawing, as an instrument of service, is provided by and is the property of Graziani + Corazza Architects Inc. and may not be used and may not be reproduced without permission. All common law, statutory and other reserved rights, including copyright, are hereby retained by and vested in Graziani + Corazza Architects Inc. Graziani + Corazza Architects Inc. or any variations from the supplied information. Graziani + Corazza Architects Inc. is not responsible for the accuracy of survey, structural, mechanical, electrical, etc., engineering information shown on this drawing. Refer to the appropriate engineering drawings before proceeding with the work. Construction must conform to all applicable codes and requirements of the authorities having jurisdiction. Unless otherwise noted, no investigation has been undertaken or reported on by this office in regards to the environmental condition of this site.

This drawing is not to be used for construction purposes until countersigned by the Architect.

This drawing is not to be scaled. All architectural symbols indicated on this drawing are graphic representations only.

| | | | |
|---|---|---|---|
| 01. | FEB.28.2014 | issued to city for SPA | B.G. |
| 02. | JUL.9.2014 | re-issued to city for SPA | B.G. |
| 03. | SEP.11.2014 | re-issued to city for SPA | B.G. |
| 04. | JAN.15.2015 | re-issued to city for SPA | B.G. |
| 05. | MAR.15.2015 | issued for tender | B.G. |
| 06. | DEC.28.2016 | issued for building permit | B.G. |
| 07. | MAY.10.2017 | re-issued for building permit | B.G. |
| 08. | MAY.10.2017 | Issued for Footings and Foundation Permit | B.G. |
| 10. | JULY.19.2017 | Progress for Construction | B.G. |
| 11. | AUG.09.2017 | Issued for Construction | B.G. |
| 12. | OCT.25.2017 | Revision to Envelope | B.G. |

| CEILING HEIGHTS | | | |
|---|---|---|---|
| FLOOR | FOYER & KITCHEN | BULKHEADS | LIVING/ DINING/DEN/BEDROOM |
| GRD | 2950 | 2750 | 2950 |
| 2ND | 2600 | 2450 | SLAB AT 2750 |
| 3RD | 2600 | 2450 | SLAB AT 2750 |
| 4TH | 2600 | 2450 | SLAB AT 2750 |
| 5TH | 2600 | 2450 | SLAB AT 2750 / 2700 |
| 6TH | 2600 | 2450 | SLAB AT 2750 / 2700 |
| 7TH | 2900 | 2750 | 3050 |

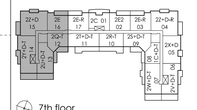


02. FEB.12.2018 S13 REVISING OPERABLE WINDOWS BG
01. AUG.21.2017 S103 SANDBLAST PRECAST ON BALCONIES BG

issued for revisions

GRAZIANI + CORAZZA ARCHITECTS INC.
1220 Sheppard Drive, Suite 100 Mississauga Ontario L4W 1K3
Phone: 905.795.2601 Fax:905.795.2844 www.gc-architects.com

PROPOSED RESIDENTIAL DEVELOPMENT

# 25 BAKER HILL BLVD.

ROYAL PINES HOMES
STOUFFVILLE ONTARIO

| | |
|---|---|
| Project Architect: | B.GRAZIANI |
| Assistant Designer: | R.LINCOLN |
| Drawn By: | S.G. |
| Checked By: | G.COLANGELO/D.BIASE |
| Plot Date: | Nov. 7, 2017 |
| Job # | 1136.13 |

7TH FLOOR ENLARGED PART PLAN

1:50 A307a



This drawing, as an instrument of service, is provided by and is the property of Graziani + Corazza Architects Inc. and may not be used or reproduced without permission. All dimensions must be verified on site by the Contractor prior to commencement of any work. Do not scale the drawing. Graziani + Corazza Architects Inc. will not be responsible for any deviations from the supplied information. Graziani + Corazza Architects Inc. is not responsible for the accuracy of survey, structural, mechanical, electrical, etc., engineering information shown on this drawing. Refer to the appropriate engineering drawings before proceeding with the work. Construction must conform to all applicable codes and requirements of the authorities having jurisdiction. Unless otherwise noted, no investigation has been undertaken or reported on by this office in regards to the environmental condition of this site.

This drawing is not to be used for construction purposes until countersigned by the Architect.

This drawing is not to be scaled. All architectural symbols indicated on this drawing are graphic representations only.

| | | | |
|---|---|---|---|
| 01. | FEB.28.2014 | issued to city for SPA | B.G. |
| 02. | JUL.9.2014 | re-issued to city for SPA | B.G. |
| 03. | SEP.11.2014 | re-issued to city for SPA | B.G. |
| 04. | JAN.15.2015 | re-issued to city for SPA | B.G. |
| 05. | MAR.15.2015 | issued for tender | B.G. |
| 06. | DEC.28.2016 | issued for building permit | B.G. |
| 07. | MAY.10.2017 | re-issued for building permit | B.G. |
| 08. | MAY.10.2017 | Issued for Footings and Foundation Permit | B.G. |
| 10. | JULY.19.2017 | Progress for Construction | B.G. |
| 11. | AUG.09.2017 | Issued for Construction | B.G. |
| 12. | OCT.25.2017 | Revision to Envelope | B.G. |

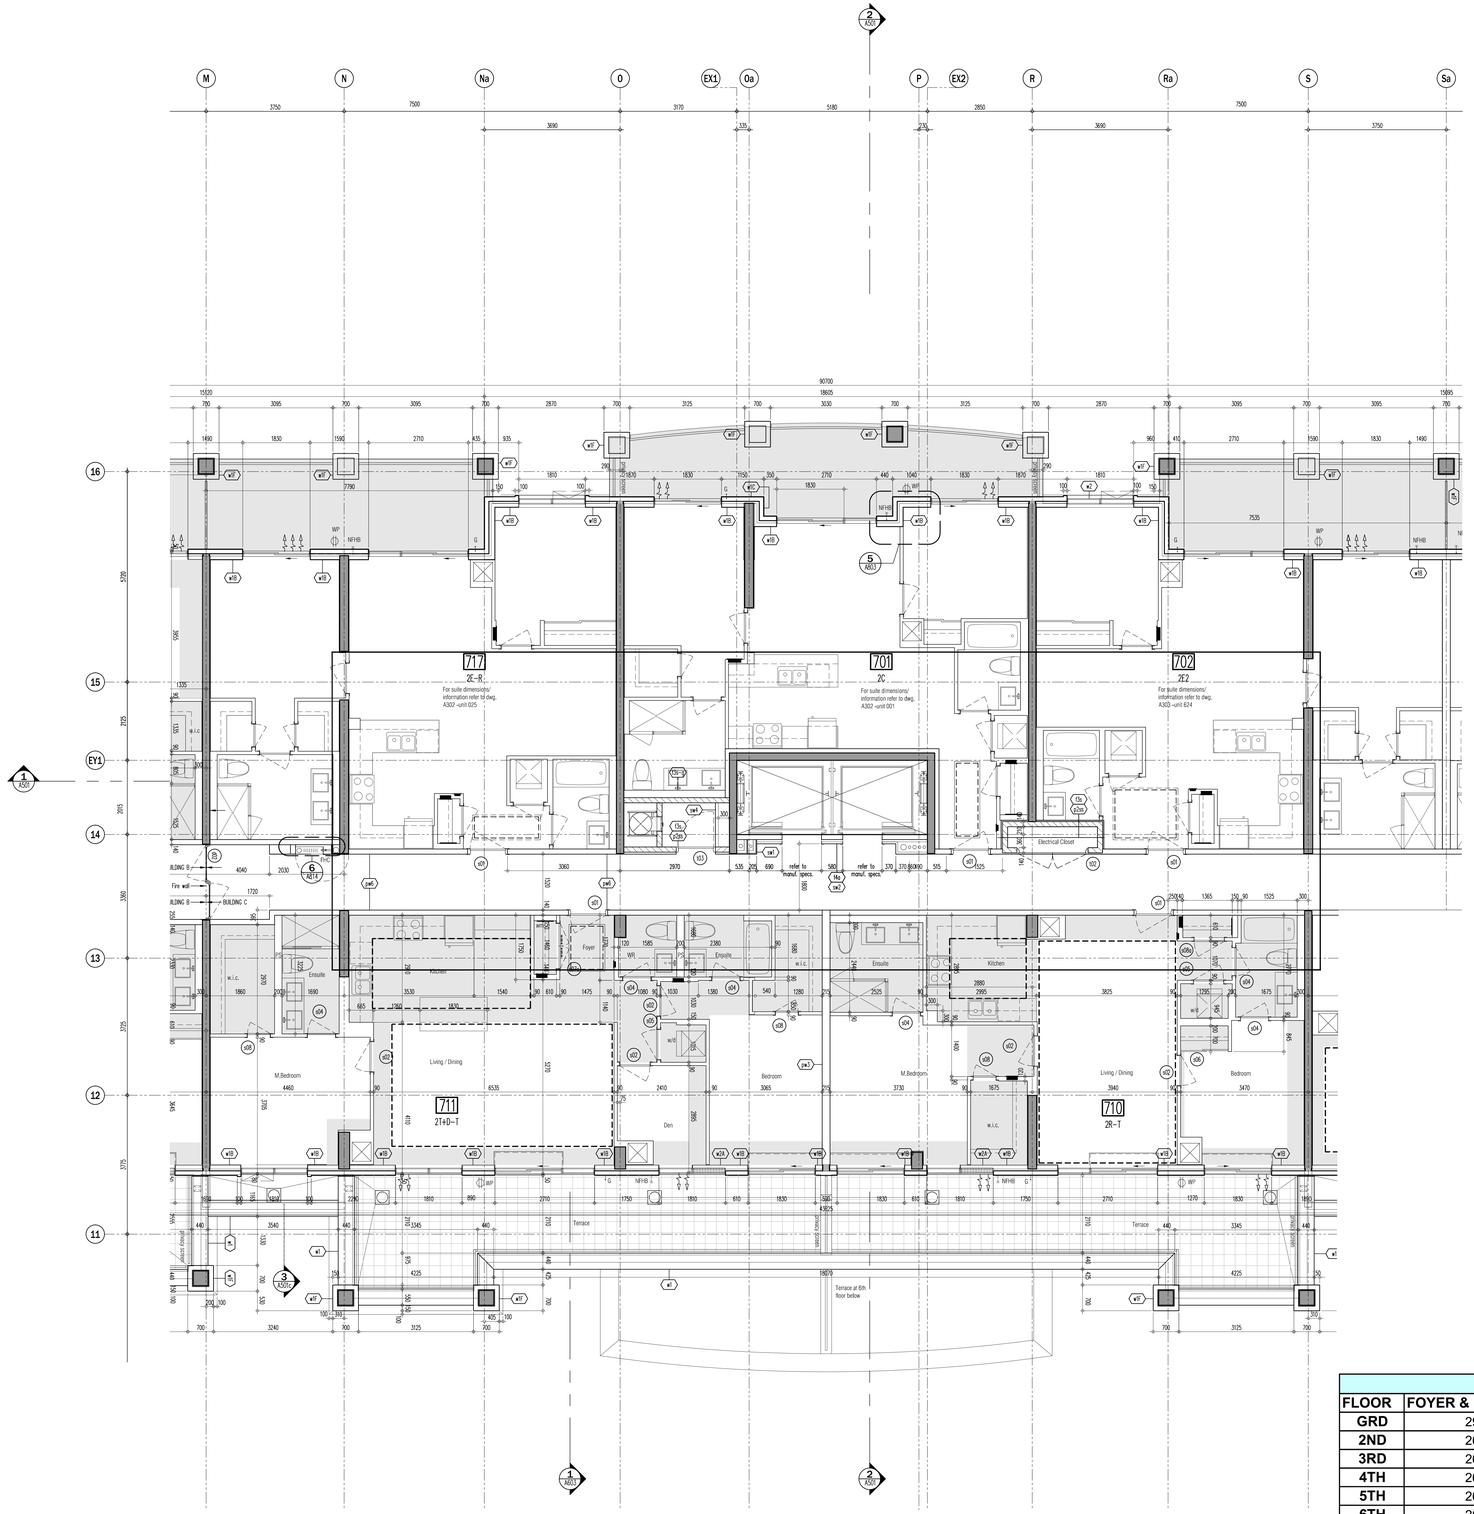


## CEILING HEIGHTS

| FLOOR | FOYER & KITCHEN | BULKHEADS | LIVING/ DINING/DEN/BEDROOM |
|---|---|---|---|
| GRD | 2950 | 2750 | 2950 |
| 2ND | 2600 | 2450 | SLAB AT 2750 |
| 3RD | 2600 | 2450 | SLAB AT 2750 |
| 4TH | 2600 | 2450 | SLAB AT 2750 |
| 5TH | 2600 | 2450 | SLAB AT 2750 / 2700 |
| 6TH | 2600 | 2450 | SLAB AT 2750 / 2700 |
| 7TH | 2900 | 2750 | 3050 |

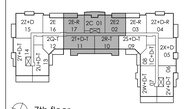


| | | | |
|---|---|---|---|
| 03. | FEB.12.2018 | S13 REVISING OPERABLE WINDOWS | BG |
| 02. | DEC.07.2017 | S109 GARBAGE CHUTE PIPE SPACE | BG |
| 01. | AUG.21.2017 | S103 SANDBLAST PRECAST ON BALCONIES | BG |

Issued for revisions

GRAZIANI + CORAZZA ARCHITECTS INC.
1501 Steeles Drive, Suite 201, Whitchurch Ontario, L4B 4J3
Phone: 905.795.2601 Fax:905.795.2994 www.gc-architects.com

PROPOSED RESIDENTIAL DEVELOPMENT

# 25 BAKER HILL BLVD.

ROYAL PINES HOMES

STOUFFVILLE ONTARIO

| | |
|---|---|
| Project Architect: | B.GRAZIANI |
| Assistant Designer: | R.LINCOLN |
| Drawn By: | S.G. |
| Checked By: | G.COLANGELO/D.BIASE |
| Plot Date: | Nov. 7, 2017 |
| Job # | 1136.13 |

7TH FLOOR ENLARGED PART PLAN

1:50

A307b

TITLEBLOCK SIZE: 915 x 1400

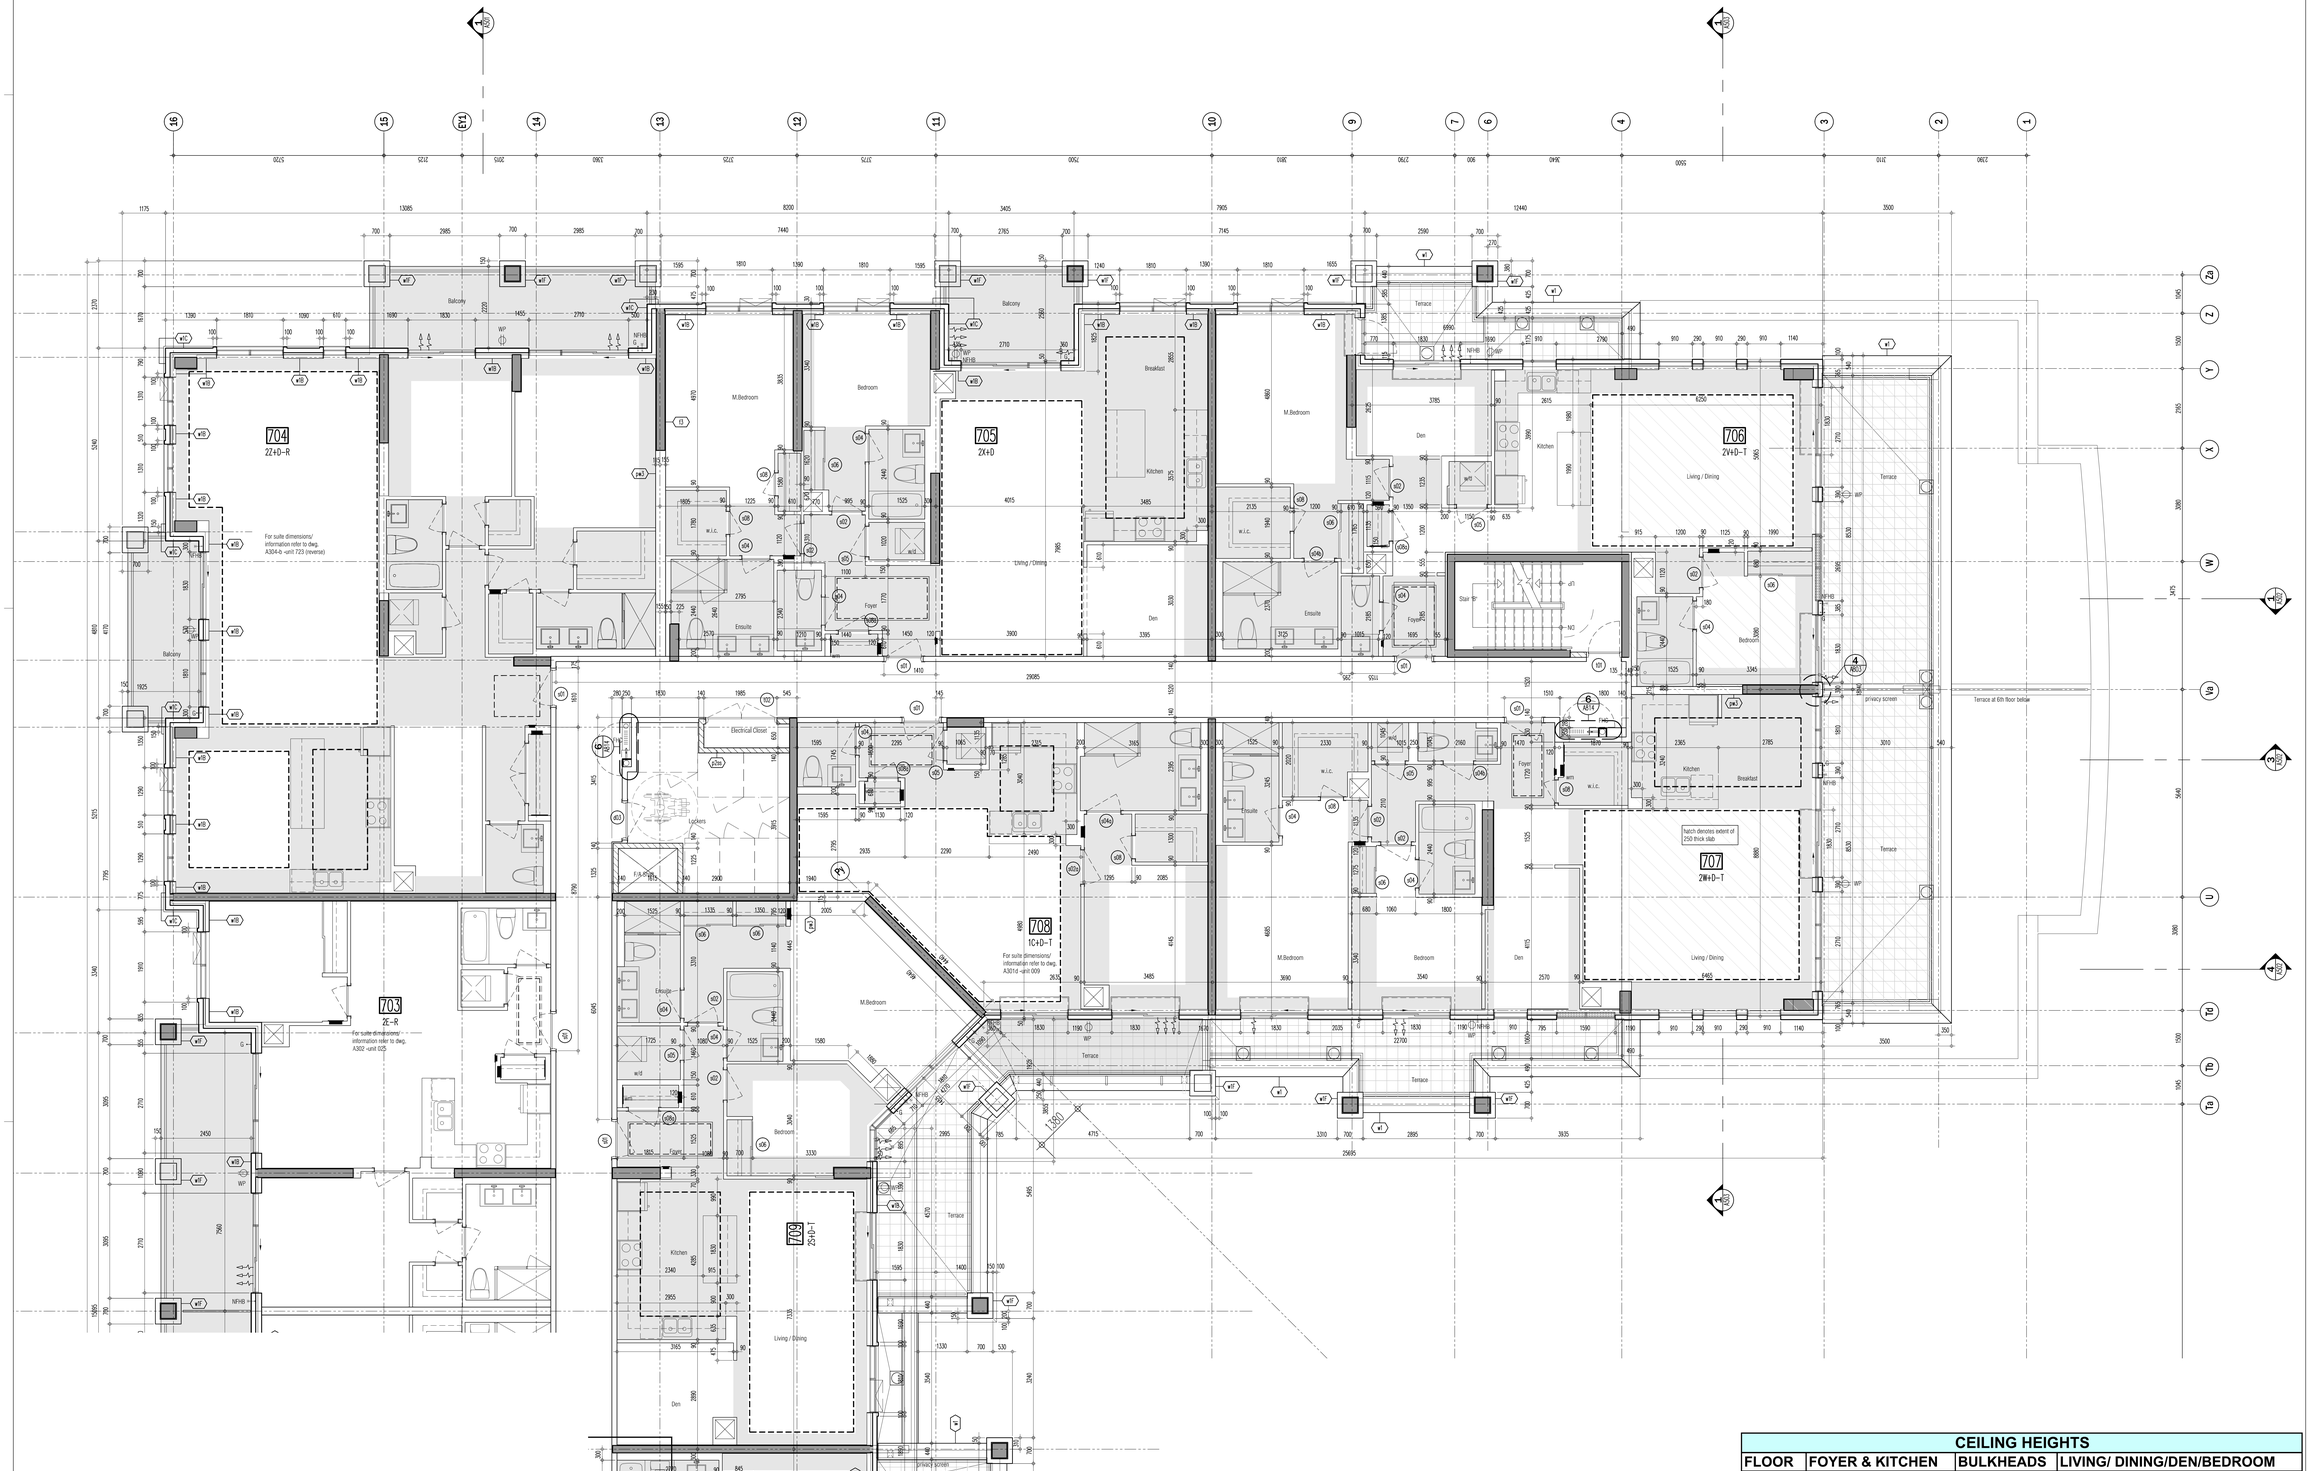


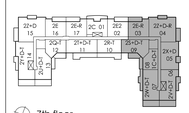


| CEILING HEIGHTS | | | |
|---|---|---|---|
| FLOOR | FOYER & KITCHEN | BULKHEADS | LIVING/ DINING/DEN/BEDROOM |
| GRD | 2950 | 2750 | 2950 |
| 2ND | 2600 | 2450 | SLAB AT 2750 |
| 3RD | 2600 | 2450 | SLAB AT 2750 |
| 4TH | 2600 | 2450 | SLAB AT 2750 |
| 5TH | 2600 | 2450 | SLAB AT 2750 / 2700 |
| 6TH | 2600 | 2450 | SLAB AT 2750 / 2700 |
| 7TH | 2900 | 2750 | 3050 |

This drawing, as an instrument of service, is provided by and is the property of Graziani + Corazza Architects Inc. and may not be used in any fashion or extension on this or any other project without the Architect's written authorization. All dimensions and conditions are to be verified on site by the contractor. Graziani + Corazza Architects Inc. will not be responsible for any variations from the supplied information. Graziani + Corazza Architects Inc. is not responsible for the accuracy of survey, structural, mechanical, electrical, etc., engineering information shown on this drawing. Refer to the appropriate engineering drawings before proceeding with the work. Construction must conform to all applicable codes and requirements of the authorities having jurisdiction. Unless otherwise noted, no investigation has been undertaken or reported on by this office in regards to the environmental condition of this site.

This drawing is not to be used for construction purposes until countersigned by the Architect.

This drawing is not to be scaled. All architectural symbols indicated on this drawing are graphic representations only.

| | | | |
|---|---|---|---|
| 01. | FEB.28.2014 | issued to city for SPA | B.G. |
| 02. | JUL.9.2014 | re-issued to city for SPA | B.G. |
| 03. | SEP.11.2014 | re-issued to city for SPA | B.G. |
| 04. | JAN.15.2015 | re-issued to city for SPA | B.G. |
| 05. | MAR.15.2015 | issued for tender | B.G. |
| 06. | DEC.28.2016 | issued for building permit | B.G. |
| 07. | MAY.10.2017 | re-issued for building permit | B.G. |
| 08. | MAY.10.2017 | Issued for Footings and Foundation Permit | B.G. |
| 10. | JULY.19.2017 | Progress for Construction | B.G. |
| 11. | AUG.09.2017 | Issued for Construction | B.G. |
| 12. | OCT.25.2017 | Revision to Envelope | B.G. |

02. FEB.12.2018 S13 REVISING OPERABLE WINDOWS BG

01. AUG.21.2017 S103 SANDBLAST PRECAST ON BALCONIES BG

issued for revisions

GRAZIANI + CORAZZA ARCHITECTS INC.
1220 Sheppard Drive, Suite 100 Mississauga Ontario L4W 1C3
Phone 905.790.2601 Fax 905.790.2944 www.gc-architects.com

PROPOSED RESIDENTIAL DEVELOPMENT

# 25 BAKER HILL BLVD.

STOUFFVILLE ROYAL PINES HOMES ONTARIO

| | |
|---|---|
| Project Architect: | B.GRAZIANI |
| Assistant Designer: | R.LINCOLN |
| Drawn By: | S.G. |
| Checked By: | G.COLANGELO/D.BIASE |
| Plot Date: | Nov. 7, 2017 |
| Job # | 1136.13 |

7TH FLOOR ENLARGED PART PLAN

1:50 A307c

TITLEBLOCK SIZE: 915 x 1400

Legend

| | | |
|---|---|---|
| | 1 | 125mm precast concrete panel **TYPE 3-c/w thin brick in-lay, Colour 2** |
| | 2 | 125mm precast concrete panel **TYPE 3-c/w thin brick in-lay, Colour 1** |
| | 3 | 125 precast panel **TYPE 4-C/W thin stone in-lay, Colour 3 (natural)** |
| | 4 | 125 precast panel **TYPE 4-C/W thin stone in-lay, Colour 3 (dressed)** |
| | 5 | Pre-cast Concrete mouldings & frames |
| | 6 | Clear Vision Glass windows |
| | 7 | Spandrel Glass windows |
| | 8 | Glass railings |
| | 9 | 125 precast panel **Sand blasted finish** |

Protection of Operable Windows (3.3.4.8. 2012 OBC)

(1) Except as provided by Sentence (2), operable windows in suites of residential occupancy shall be protected by,

(a) a guard with a minimum height of 1070 mm constructed in accordance with Article 3.3.1.7., or

(b) a mechanism capable of controlling the free swinging or sliding of the openable part of the window so as to limit any clear unobstructed opening to not more than 100 mm measured either vertically or horizontally, where the other dimension is greater than 380 mm.

(2) Windows need not be protected in accordance with Sentence (1) where,

(a) the only opening having greater dimensions than those allowed by Clause (1)(b) is located higher than 1070 mm above the finished floor, or

(b) the bottom edge of the openable portion of the window is located less than 1800 mm above the floor or ground on the other side of the window.

This drawing, as an instrument of service, is provided by and is the property of Graziani + Corazza Architects Inc. and may not be used or reproduced without our permission. All dimensions and conditions on site must be verified by Graziani + Corazza Architects Inc. of any variations from the supplied information. Graziani + Corazza Architects Inc. is not responsible for the accuracy of surveys, structural, mechanical, electrical, etc., engineering information shown on this drawing. Refer to the appropriate engineering drawings before proceeding with the work. Construction must conform to all applicable codes and requirements of the authorities having jurisdiction. Unless otherwise noted, no investigation has been undertaken or reported on by this office in regards to the environmental condition of the site.

This drawing is not to be used for construction purposes until countersigned by the Architect.

This drawing is not to be scaled. All architectural symbols indicated on this drawing are graphic representations only.

| | | | |
|---|---|---|---|
| 01. | FEB.28.2014 | issued to city for SPA | B.G. |
| 02. | JUL.9.2014 | re-issued to city for SPA | B.G. |
| 03. | SEP.11.2014 | re-issued to city for SPA | B.G. |
| 04. | JAN.15.2015 | re-issued to city for SPA | B.G. |
| 05. | MAR.15.2015 | issued for tender | B.G. |
| 06. | DEC.28.2016 | issued for building permit | B.G. |
| 07. | MAY.10.2017 | re-issued for building permit | B.G. |
| 08. | MAY.10.2017 | issued for Footings and Foundation Permit | B.G. |
| 10. | JULY.19.2017 | Progress for Construction | B.G. |
| 11. | AUG.09.2017 | Issued for Construction | B.G. |
| 12. | OCT.25.2017 | Revision to Envelope | B.G. |

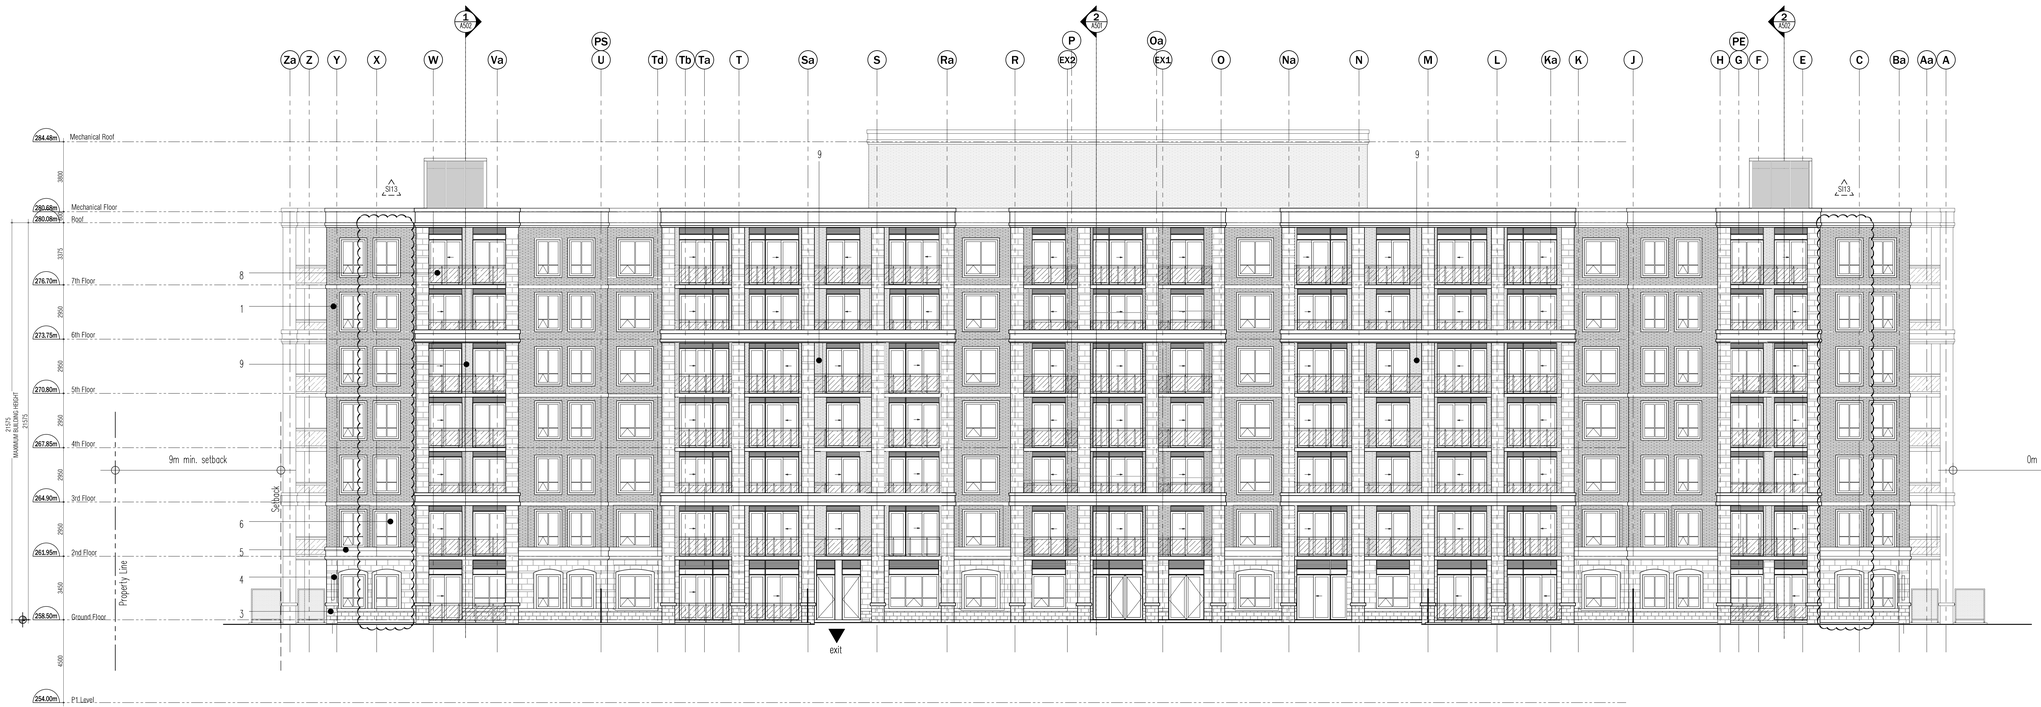


| | | | |
|---|---|---|---|
| 03. | FEB.12.2018 | S13 REVISING OPERABLE WINDOWS | BG |
| 02. | SEP1.06.2017 | S06 TRIMSOM/BULKHEADS REVISION | BG |
| 01. | AUG.21.2017 | S03 SANDBLAST PRECAST ON BALCONIES | BG |

issued for revisions

GRAZIANI CORAZZA ARCHITECTS INC.
1339 Dawson Drive, Suite 100 Mississauga Ontario L4W 1C3
Phone 905.790.2601 Fax 905.790.2944 www.gc-architects.com

PROPOSED RESIDENTIAL DEVELOPMENT

# 25 BAKER HILL BLVD.

STOUFFVILLE ROYAL PINES HOMES ONTARIO

| | |
|---|---|
| Project Architect: | B.GRAZIANI |
| Assistant Designer: | R.LINCOLN |
| Drawn By: | S.G. |
| Checked By: | G.COLANGELO/D.BIASE |
| Plot Date: | Nov. 7, 2017 |
| Job # | 1136.13 |

## ELEVATIONS EAST AND WEST

1:100 A401a

TITLEBLOCK SIZE: 915 x 1400

Legend

| | | |
|---|---|---|
| | 1 | 125mm precast concrete panel<br>**TYP. 2-c/w thin brick in-leg, Colour 2** |
| | 2 | 125mm precast concrete panel<br>**TYP. 3-c/w thin brick in-leg, Colour 1** |
| | 3 | 125 precast panel<br>**TYP. 4-C/W thin stone in-leg, Colour 3 (rocket)** |
| | 4 | 125 precast panel<br>**TYP. 4-C/W thin stone in-leg, Colour 3 (dressed)** |
| | 5 | Pre-cast Concrete<br>mouldings & frames |
| | 6 | Clear Vision Glass<br>windows |
| | 7 | Spandrel Glass<br>windows |
| | 8 | Glass railings |
| | 9 | 125 precast panel<br>**Sand blasted finish** |

Protection of Openable Windows (3.3.4.8. 2012 OBC)

(1) Except as provided by Sentence (2), openable windows in suites of residential occupancy shall be protected by,

(a) a guard with a minimum height of 1070 mm constructed in accordance with Article 3.3.1.17., or

(b) a mechanism capable of controlling the free swinging or sliding of the openable part of the window so as to limit any clear unobstructed opening to not more than 100 mm measured either vertically or horizontally, where the other dimension is greater than 200 mm.

(2) Windows need not be protected in accordance with Sentence (1) where,

(a) the only opening having greater dimensions than those allowed by Clause (1)(b) is located higher than 1070 mm above the finished floor, or

(b) the bottom edge of the openable portion of the window is located less than 1800 mm above the floor or ground on the other side of the window.

This drawing, as an instrument of service, is provided by and is the property of Graziani + Corazza Architects Inc. and may not be used in any way without the consent of Graziani + Corazza Architects Inc. Graziani + Corazza Architects Inc. will not be responsible for any variations from the supplied information. Graziani + Corazza Architects Inc. is not responsible for the accuracy of survey, structural, mechanical, electrical, etc., engineering information shown on this drawing. Refer to the appropriate engineering drawings before proceeding with the work. Construction must conform to all applicable codes and requirements of the authorities having jurisdiction. Unless otherwise noted, no investigation has been undertaken or reported on by this office in regards to the environmental condition of this site.

This drawing is not to be used for construction purposes until countersigned by the Architect.

This drawing is not to be scaled. All architectural symbols indicated on this drawing are graphic representations only.

| | | | |
|---|---|---|---|
| 01. | FEB.28.2014 | issued to city for SPA | B.G. |
| 02. | JUL.9.2014 | re-issued to city for SPA | B.G. |
| 03. | SEP.11.2014 | re-issued to city for SPA | B.G. |
| 04. | JAN.15.2015 | re-issued to city for SPA | B.G. |
| 05. | MAR.15.2015 | issued for tender | B.G. |
| 06. | DEC.28.2016 | issued for building permit | B.G. |
| 07. | MAY.10.2017 | re-issued for building permit | B.G. |
| 08. | MAY.10.2017 | Issued for Footings and Foundation Permit | B.G. |
| 10. | JULY.19.2017 | Progress for Construction | B.G. |
| 11. | AUG.09.2017 | Issued for Construction | B.G. |
| 12. | OCT.25.2017 | Revision to Envelope | B.G. |

| | | | |
|---|---|---|---|
| 03. | FEB.12.2018 | SH.1 REVISING OPERABLE WINDOWS | BG |
| 02. | SEPT.06.2017 | S006 TRANSOM/BULKHEADS REVISION | BG |
| 01. | AUG.21.2017 | S003 SANDBLAST PRECAST ON BALCONIES | BG |

issued for revisions

GRAZIANI + CORAZZA ARCHITECTS INC.
1320 Dorsoon Drive, Suite 100 Mississauga Ontario L4W 1C3
Phone. 905.790.2601 Fax.905.790.2944 www.gc-architects.com

PROPOSED RESIDENTIAL DEVELOPMENT

# 25 BAKER HILL BLVD.

STOUFFVILLE ROYAL PINES HOMES ONTARIO

| | |
|---|---|
| Project Architect: | B.GRAZIANI |
| Assistant Designer: | R.LINCOLN |
| Drawn By: | S.G. |
| Checked By: | G.COLANGELO/D.BIASE |
| Plot Date: | Nov. 7, 2017 |
| Job # | 1136.13 |

## ELEVATIONS NORTH AND SOUTH

1:100 A401b

TITLEBLOCK SIZE: 915 x 1400

Legend

| | | |
|---|---|---|
| | 1 | 125mm precast concrete panel<br>**TYPE 2-c/w thin brick tn-tay, Colour 2** |
| | 2 | 125mm precast concrete panel<br>**TYPE 3-c/w thin brick tn-tay, Colour 1** |
| | 3 | 125 precast panel<br>**TYPE 4-C/W thin stone tn-tay, Colour 3 (rocked)** |
| | 4 | 125 precast panel<br>**TYPE 4-C/W thin stone tn-tay, Colour 3 (dressed)** |
| | 5 | Pre-cast Concrete<br>moldings & frames |
| | 6 | Clear Vision Glass<br>windows |
| | 7 | Spandrel Glass<br>windows |
| | 8 | Glass railings |
| | 9 | 125 precast panel<br>**Sand blasted finish** |

Protection of Openable Windows (3.3.4.8. 2012 OBC)

(1) Except as provided by Sentence (2), openable windows in suites of residential occupancy shall be protected by,

(a) a guard with a minimum height of 1070 mm constructed in accordance with Article 3.3.1.17., or

(b) a mechanism capable of controlling the free swinging or sliding of the openable part of the window so as to limit any clear unobstructed opening to not more than 100 mm measured either vertically or horizontally, where the other dimension is greater than 260 mm.

(2) Windows need not be protected in accordance with Sentence (1) where,

(a) the only opening having greater dimensions than those allowed by Clause (1)(b) is located higher than 1070 mm above the finished floor, or

(b) the bottom edge of the openable portion of the window is located less than 1800 mm above the floor or ground on the other side of the window.

COURTYARD NORTH FACING ELEVATION 1 A401c
SCALE - 1:100

COURTYARD SOUTH FACING ELEVATION 1 A401c
SCALE - 1:100

This drawing, as an instrument of service, is provided by and is the property of Graziani + Corazza Architects Inc. and may not be used or reproduced without the consent of Graziani + Corazza Architects Inc. Graziani + Corazza Architects Inc. is not responsible for the accuracy of survey, structural, mechanical, electrical, etc., engineering information shown on this drawing. Refer to the appropriate engineering drawings before proceeding with the work. Construction must conform to all applicable codes and requirements of the authorities having jurisdiction. Unless otherwise noted, no investigation has been undertaken or reported on by this office in regards to the environmental condition of this site.

This drawing is not to be used for construction purposes until countersigned by the Architect.

This drawing is not to be scaled. All architectural symbols indicated on this drawing are graphic representations only.

| | | | |
|---|---|---|---|
| 01. | FEB.28.2014 | issued to city for SPA | B.G. |
| 02. | JUL.9.2014 | re-issued to city for SPA | B.G. |
| 03. | SEP.11.2014 | re-issued to city for SPA | B.G. |
| 04. | JAN.15.2015 | re-issued to city for SPA | B.G. |
| 05. | MAR.15.2015 | issued for tender | B.G. |
| 06. | DEC.28.2016 | issued for building permit | B.G. |
| 07. | MAY.10.2017 | re-issued for building permit | B.G. |
| 08. | MAY.10.2017 | Issued for Footings and Foundation Permit | B.G. |
| 10. | JULY.19.2017 | Progress for Construction | B.G. |
| 11. | AUG.09.2017 | Issued for Construction | B.G. |
| 12. | OCT.25.2017 | Revision to Envelope | B.G. |

| | | | |
|---|---|---|---|
| 03. | FEB.12.2018 | S11 REVISING OPERABLE WINDOWS | BG |
| 02. | SEPT.06.2017 | S06 TRANSOM/BULKHEADS REVISION | BG |
| 01. | AUG.21.2017 | S03 SANDBLAST PRECAST ON BALCONIES | BG |

issued for revisions

GRAZIANI + CORAZZA ARCHITECTS INC.
1220 Sheppard Drive, Suite 100 Mississauga Ontario L4W 1C3
Phone 905.790.2601 Fax 905.790.2944 www.gc-architects.com

PROPOSED RESIDENTIAL DEVELOPMENT

# 25 BAKER HILL BLVD.

STOUFFVILLE ROYAL PINES HOMES ONTARIO

| | |
|---|---|
| Project Architect: | B.GRAZIANI |
| Assistant Designer: | R.LINCOLN |
| Drawn By: | S.G. |
| Checked By: | G.COLANGELO/D.BIASE |
| Plot Date: | Nov. 7, 2017 |
| Job # | 1136.13 |

## COURTYARD ELEVATIONS NORTH AND SOUTH FACING

1:100 A401c

TITLEBLOCK SIZE: 915 x 1400