THE **BEECH** (38-10)

ELEVATION A
2550
SQUARE FEET
INCLUDES 11 SQ.FT. OPEN AREA

38' LOTS

INVENTORY
38-10 BEECH Walk up
EL.A
LOT 22

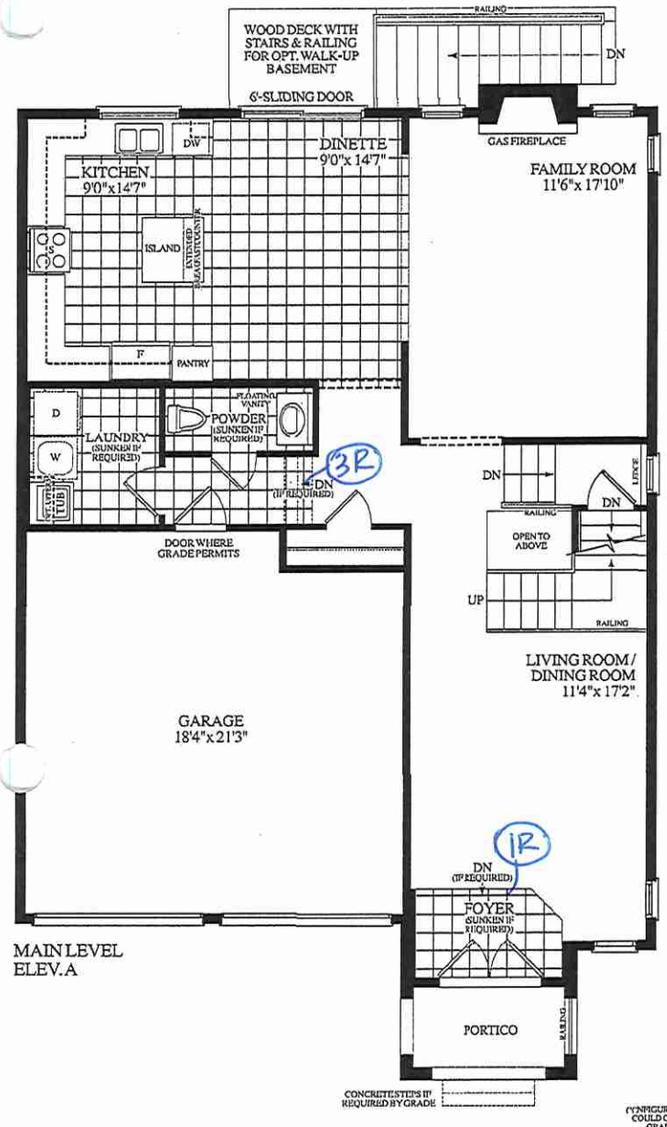

MAIN LEVEL
ELEV.A

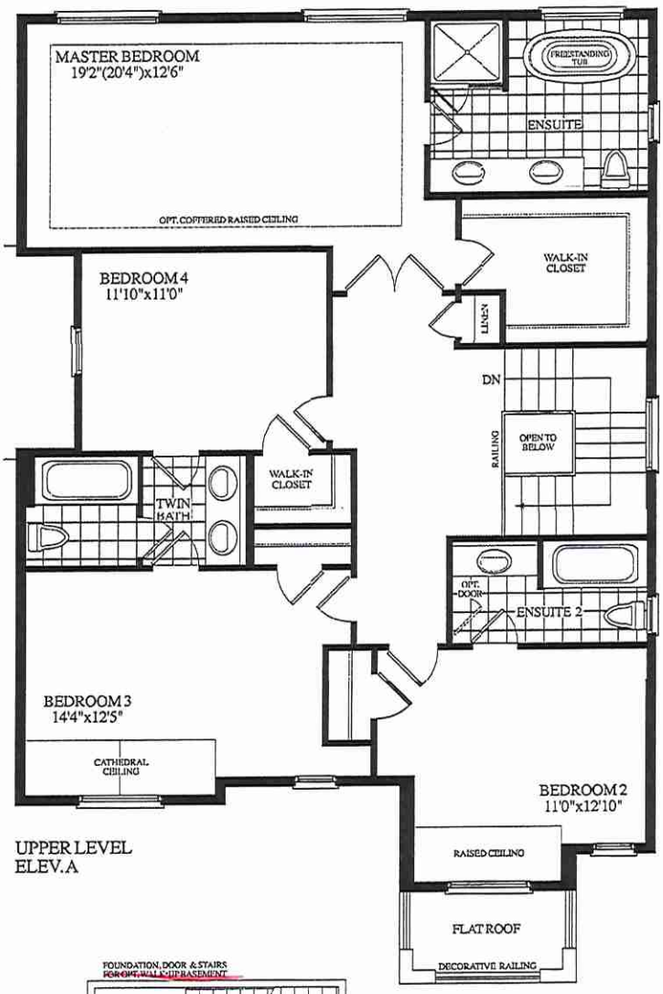

UPPER LEVEL
ELEV.A

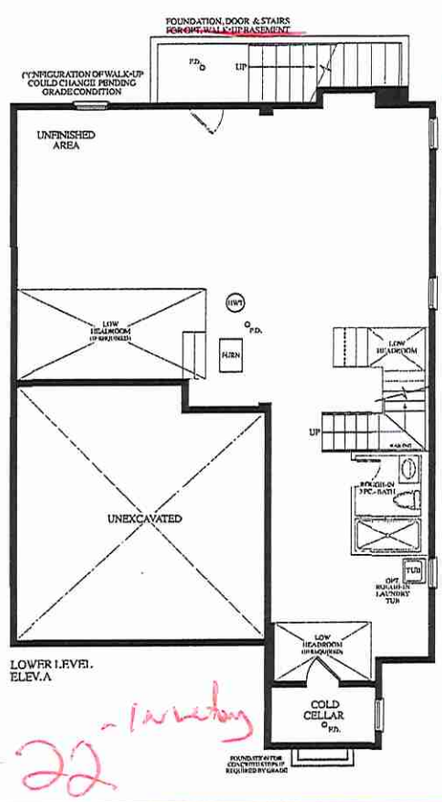

WALK UP

LOWER LEVEL
ELEV.A

ELEVATION A
2550
SQUARE FEET

LOT# 22 - Inventory

ROYAL PINE HOMES

Rights reserved. Specifications and floor plans are subject to change without notice. All renderings are artist's concept. All floor plans are approximate dimensions. Actual usable floor space may vary from the stated square footage.