



SITE INSTRUCTION

Forestside Estates
 Attmar & Palleschi Drive
 Brampton, Ontario
 Attn: **Vince Staffieri**

SI A05

PROJECT : Forestside
PROJECT # : 1331.15
DATE : Aug 18, 2021

Site instructions/memos and Addendums are issued only for the purpose of recording any clarification or interpretation of the contract documents or giving direction on problems resulting from field conditions. These memos are subject to the provisions of the contract documents and unless reviewed with and authorized by the Client, will not affect the contract. Should the Contractor require a change in the contract price or project schedule, he shall submit to the Client, prior to commencement of work outlined in this memo, an itemized proposal for approval.

Title: Revisions to plans as itemized.

Reference:		Changes:
CS301A-CS305A A301A-A305A	1st Floor to Roof Slab Edge 1 st -Floor Plans to Roof Plans	Move grid lines B3 and B4 to match Underground grid lines on Bldg. A

Reason: Revisions to plans as per architectural review of acoustical, electrical, mechanical, and structural coordination.

GRAZIANI + CORAZZA
 ARCHITECTS INC

D. Biase C.E.T.
 Principal
Distribution:

Royal Pine Homes	Vince Staffieri Cinzia Caruzo	vince@royalpinehomes.com Cinzia@royalpinehomes.com
Jablonski Engineering	Kevin Deonaraine	kdeonaraine@astint.on.ca
United Engineering	Rene Cuales Leonard Matthews Susan Pan Mark Giorgi	rene@u-eng.ca Lenard@u-eng.ca susan@u-eng.ca mark@u-eng.ca
Candevcon Limited	Diarmund Hogan Dudister Damnaraigh	dhorgan@candevcon.com dude@candevcon.com
Starfire Sprinkler Systems	Elite Novosselova Peter Adrian	elitecanada@hotmail.com Peter@starfiresystems.biz
Strybos Barron King Ltd.	Bryn Barron Kaleigh Gills Sydney Martel	bbarron@strybos.com kgillis@strybos.com smartel@strybos.com
Graziani + Corazza Architects	Domenic Biase Gino Colangelo Fernando Croatto	dbiase@gc-architects.com gcolangelo@gc-architects.com FCroatto@gc-architects.com

THIS DRAWING IS NOT TO BE SCALED. ALL ARCHITECTURAL SYMBOLS INDICATED ON THIS DRAWING ARE GRAPHIC REPRESENTATIONS ONLY.

CONDITIONS FOR ELECTRONIC INFORMATION TRANSFER:



2. TRANSMISSION OF ANY VIRUS OR DAMAGE TO THE RECEIVING ELECTRONIC SYSTEM WHEN INFORMATION IS TRANSFERRED.

01. SEPTEMBER 2019 Issued for circulation 1 [bg](#)

RESIDENTIAL

ATTMAR + PALLESCHI DRIVE

ONTARIO

PROJECT ARCHITECT: B. GRAZIANI

ASSISTANT DESIGNER: R. LINCOLN

DRAWN BY: G.C./F.C./M.B


CHECKED BY: D.BIASE/G.COLANGELO

PLOT DATE: AUG.03.2021

JOB # 1331.15

1:150 CS301-05

BLOCK SIZE: 915 x 1200

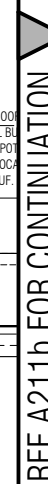

THIS DRAWING IS NOT TO BE SCALED. ALL ARCHITECTURAL SYMBOLS INDICATED ON THIS DRAWING ARE GRAPHIC REPRESENTATIONS ONLY.

CONDITIONS FOR ELECTRONIC INFORMATION TRANSFER:

ELECTRONIC INFORMATION IS SUPPLIED TO THE OTHER ASSOCIATED FIRMS TO ASSIST THEM IN THE EXECUTION OF THEIR WORK / REVIEW. THE RECIPIENT FIRMS MUST DETERMINE THE COMPLETENESS / APPROPRIATENESS / RELEVANCE OF THE INFORMATION IN RESPECT TO THEIR PARTICULAR RESPONSIBILITY.


1. ERRORS, OMISSIONS, INACCURACIES, OR INADEQUACY OF INFORMATION IN WHOLE OR PART WHEN INFORMATION IS TRANSFERRED.
2. TRANSMISSION OF ANY VIRUS OR DAMAGE TO THE RECEIVING ELECTRONIC SYSTEM WHEN INFORMATION IS TRANSFERRED.


01. SEP 13 2019 Issued for circulation 1 bg



CONCRETE SLAB EDGE
GROUND FLOOR (ENLARGE PLAN)



TITLEBLOCK SIZE: 915 x 1200

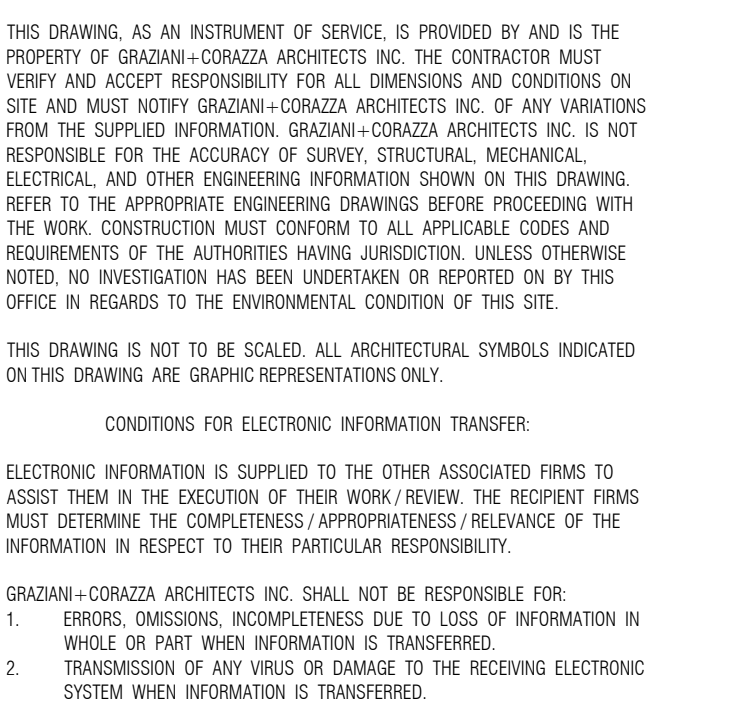


01. SEP 18 2019 Issued for circulation 1 bg



ATTMAR + PALLESCHI DRIVE

PROJECT ARCHITECT:	B.GRAZIANI
ASSISTANT DESIGNER:	R.LINCOLN
DRAWN BY:	G.C/F.C/M.B
CHECKED BY:	D.BIASE/G.COLANGELO
LOT DATE:	AUG.03.2021
DB #	1331.15

CONCRETE SLAB EDGE
GROUND FLOOR (ENLARGE PLAN)

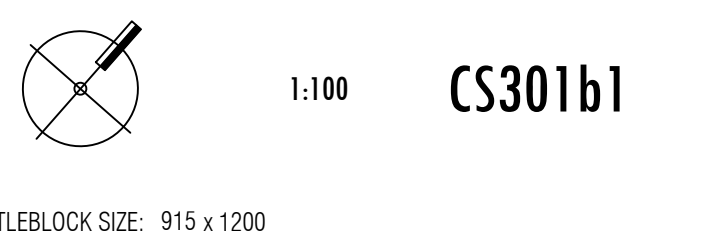

THIS DRAWING IS NOT TO BE SCALED. ALL ARCHITECTURAL SYMBOLS INDICATED ON THIS DRAWING ARE GRAPHIC REPRESENTATIONS ONLY.


CONDITIONS FOR ELECTRONIC INFORMATION TRANSFER




2. TRANSMISSION OF ANY VIRUS OR DAMAGE TO THE RECEIVING ELECTRONIC SYSTEM WHEN INFORMATION IS TRANSFERRED.

01. SEPTEMBER 2019 Issued for circulation 1 bg

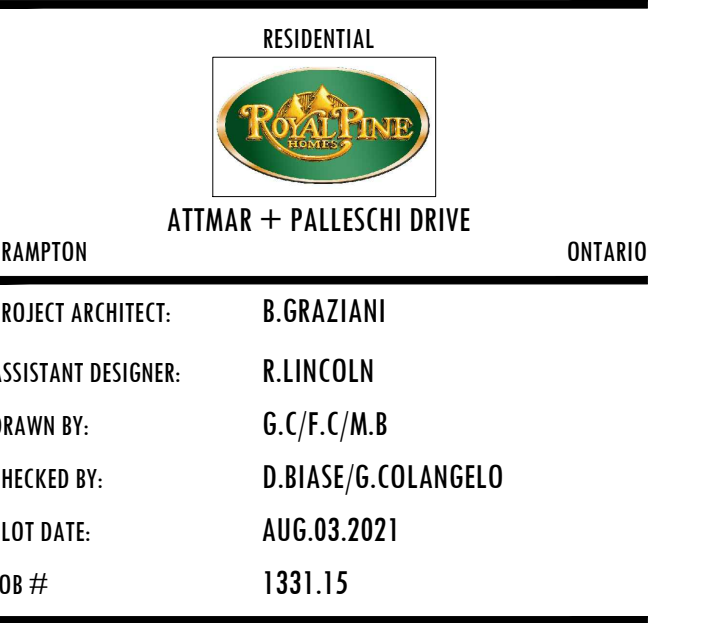

1:150 CS301-OS-G

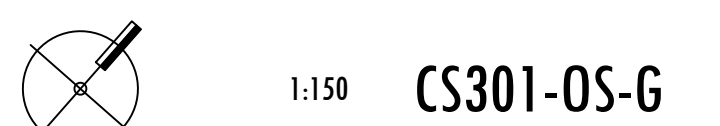

FILEBLOCK SIZE: 915 x 1200

THIS DRAWING AS AN INSTRUMENT OF SERVICE, IS PROVIDED BY AND IS THE PROPERTY OF GRAZIANI-CORAZZA ARCHITECTS INC. THE CONTRACTOR MUST VERIFY AND ACCEPT RESPONSIBILITY FOR ALL DIMENSIONS AND COORDINATE THE SITE AND MUST NOTIFY GRAZIANI-CORAZZA ARCHITECTS INC. OF ANY DISCREPANCIES FROM THE SUPPLIED INFORMATION. GRAZIANI-CORAZZA ARCHITECTS INC. IS NOT RESPONSIBLE FOR THE ACCURACY OF SURVEY, STRUCTURAL, MECHANICAL, ELECTRICAL AND OTHER ENGINEERING INFORMATION SHOWN ON THIS DRAWING. REFER TO THE APPROPRIATE ENGINEERING DRAWINGS BEFORE PROCEEDING WITH THE WORK. CONSTRUCTION MUST COMPLY TO ALL APPLICABLE CODES AND REQUIREMENTS OF THE AUTHORITIES HAVING JURISDICTION. UNLESS OTHERWISE NOTED, NO INVESTIGATION HAS BEEN UNDERTAKEN OR REPORTED ON BY THIS OFFICE IN REGARD TO THE ENVIRONMENTAL CONDITION OF THIS SITE.

THIS DRAWING IS NOT TO BE SCALED. ALL ARCHITECTURAL SYMBOLS INDICATED ON THIS DRAWING ARE GRAPHIC REPRESENTATIONS ONLY.

CONDITIONS FOR ELECTRONIC INFORMATION TRANSFER

ELECTRONIC INFORMATION IS SUPPLIED TO THE OTHER ASSOCIATED FIRMS TO ASSIST THEM IN THE EXECUTION OF THEIR WORK. REVIEW THE RECIPIENT FIRMS MUST DETERMINE THE COMPLETENESS, APPROPRIATENESS, RELIANCE OF THE INFORMATION IN RESPECT TO THEIR PARTICULAR RESPONSIBILITY.

GRAZIANI-CORAZZA ARCHITECTS INC. SHALL NOT BE RESPONSIBLE FOR:

1. ERROR, OMISSIONS, INCOMPLETENESS DUE TO LOSS OF INFORMATION IN WHOLE OR PART WHEN INFORMATION IS TRANSFERRED.
2. TRANSMISSION OF ANY VIRUS OR DAMAGE TO THE RECEIVING ELECTRONIC SYSTEM WHEN INFORMATION IS TRANSFERRED.

01. Oct.07.2019 issued for tender
02. Mar.13.2020 issued for design coordination #2
03. Mar.16.2020 issued for addendum #2
04. Mar.16.2020 issued for addendum #3
05. Aug.24.2020 issued for addendum #4
06. Sept.28.2020 issued for permit
07. Oct.20.2020 issued for addendum #5
08. Nov.23.2020 issued for addendum #6
09. Dec.14.2020 issued for addendum #7
10. Jan.15.2021 issued for addendum #8
11. Mar.2.2021 issued for permit
12. Mar.09.2021 issued for addendum #9
13. Mar.10.2021 issued for addendum #9R
14. Mar.26.2021 issued for progress
15. May.14.2021 issued for Site Instruction #1
16. June.15.2021 issued for Site Instruction #2
17. July.7.2021 re-issued for permit
18. July.15.2021 issued for Site Instruction #3
19. July.27.2021 issued for Site Instruction #4
20. Aug.3.2021 issued for Site Instruction #5

01. SEP/18/2021 issued for revisions

**GRAZIANI
CORAZZA
ARCHITECTS**

1320 SHARONDA DRIVE, SUITE 100 MISSISSAUGA, ONTARIO L4W 1C3
905.709.7201 P.905.709.7200 WWW.GC-ARCHITECTS.COM



BRAMPTON ONTARIO

PROJECT ARCHITECT: B. GRAZIANI

ASSISTANT DESIGNER: R. LINCOLN

DRAWN BY: G. C./F. C./M.B.

CHECKED BY: D. BIASE/G. COLANGELO





PLOT DATE: AUG.03.2021

JOB # 1331.15

**SECOND FLOOR OVERALL PLAN
CONCRETE SLAB EDGE**

1:150 CS302

TITLEBLOCK SIZE: 915 x 1200

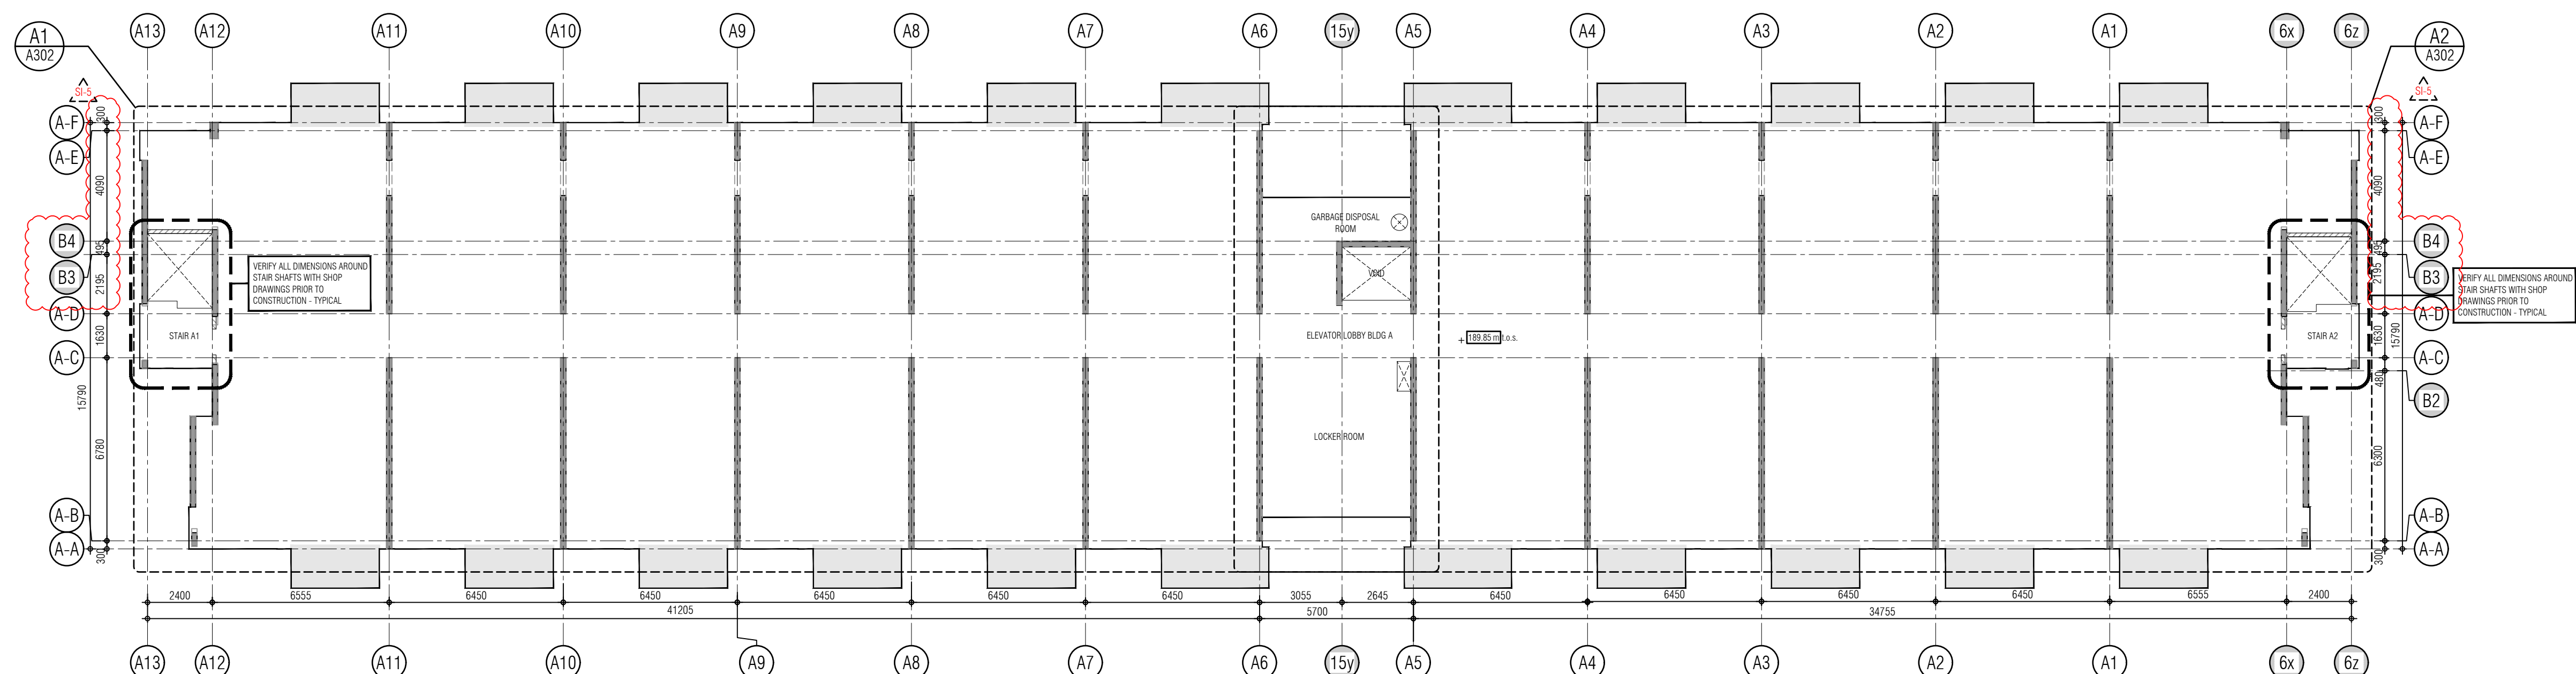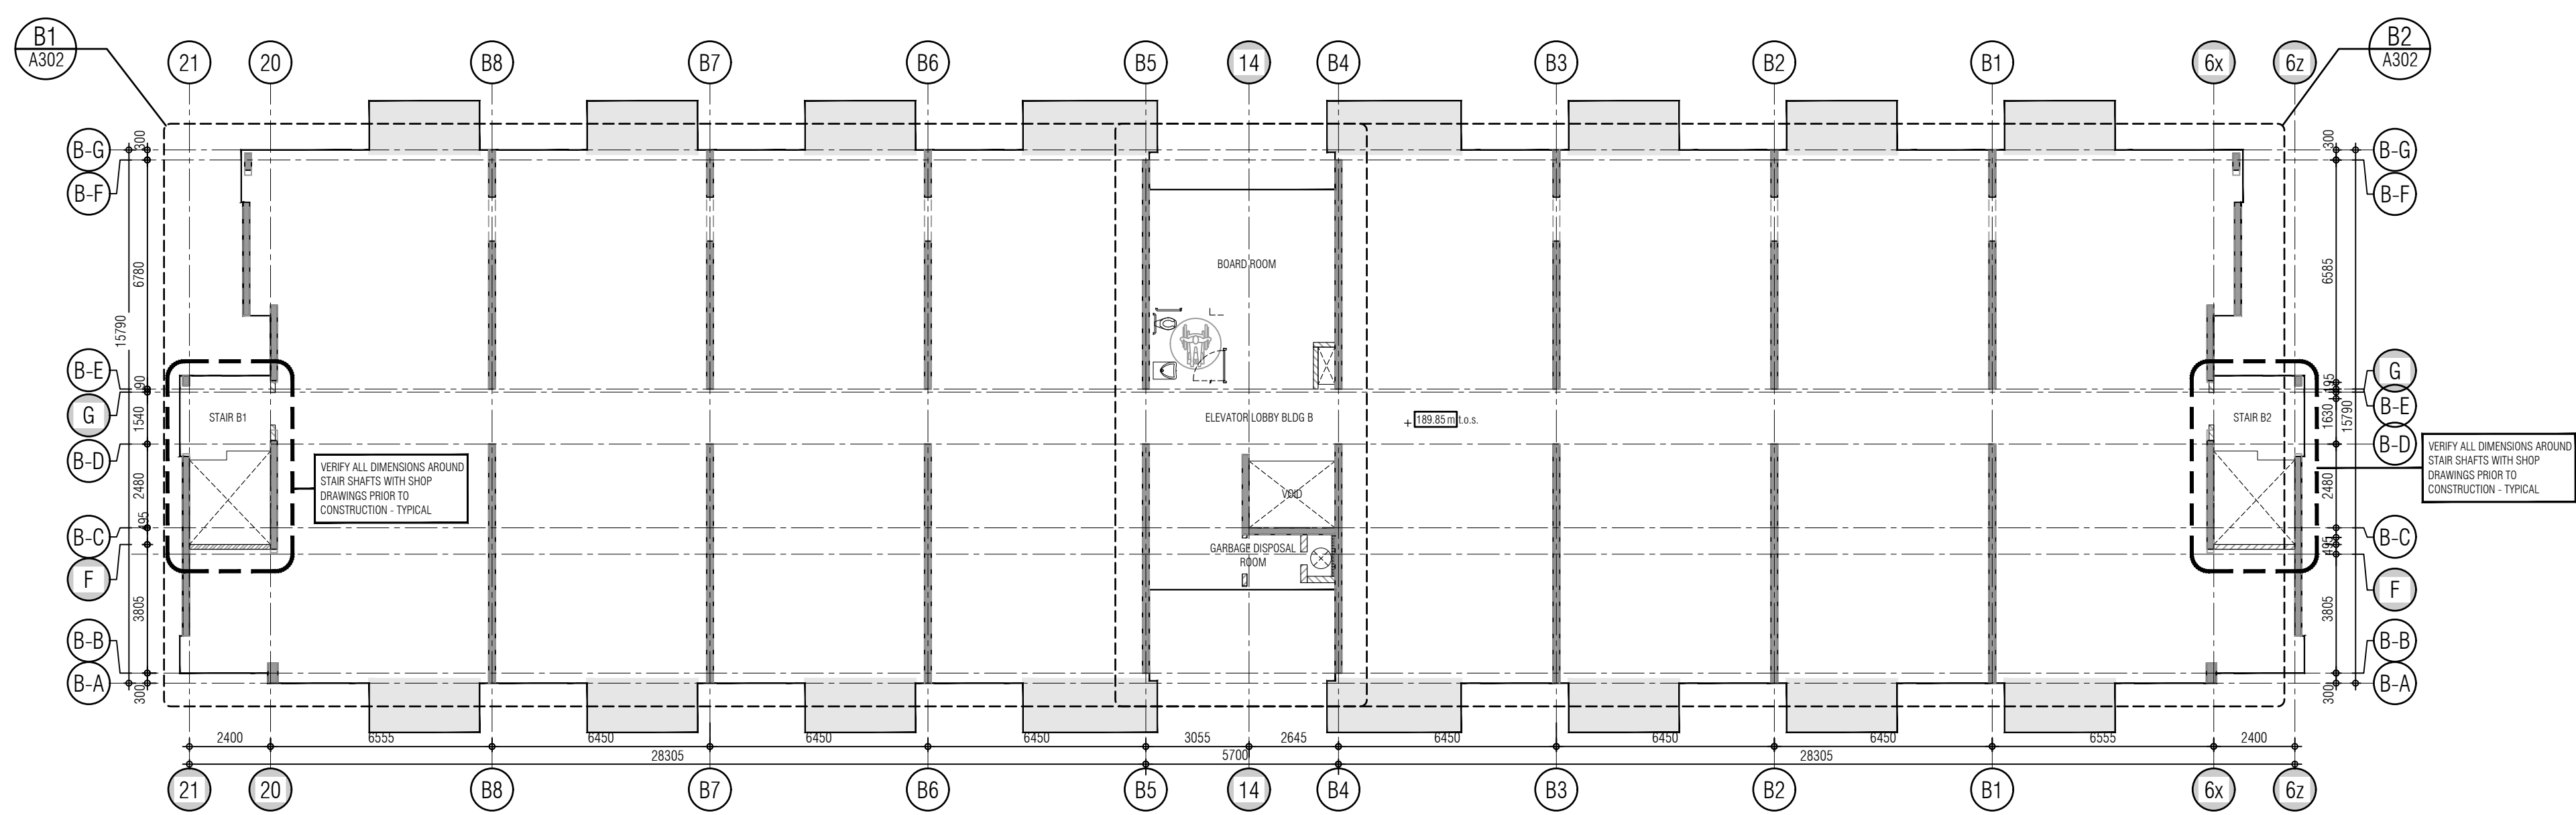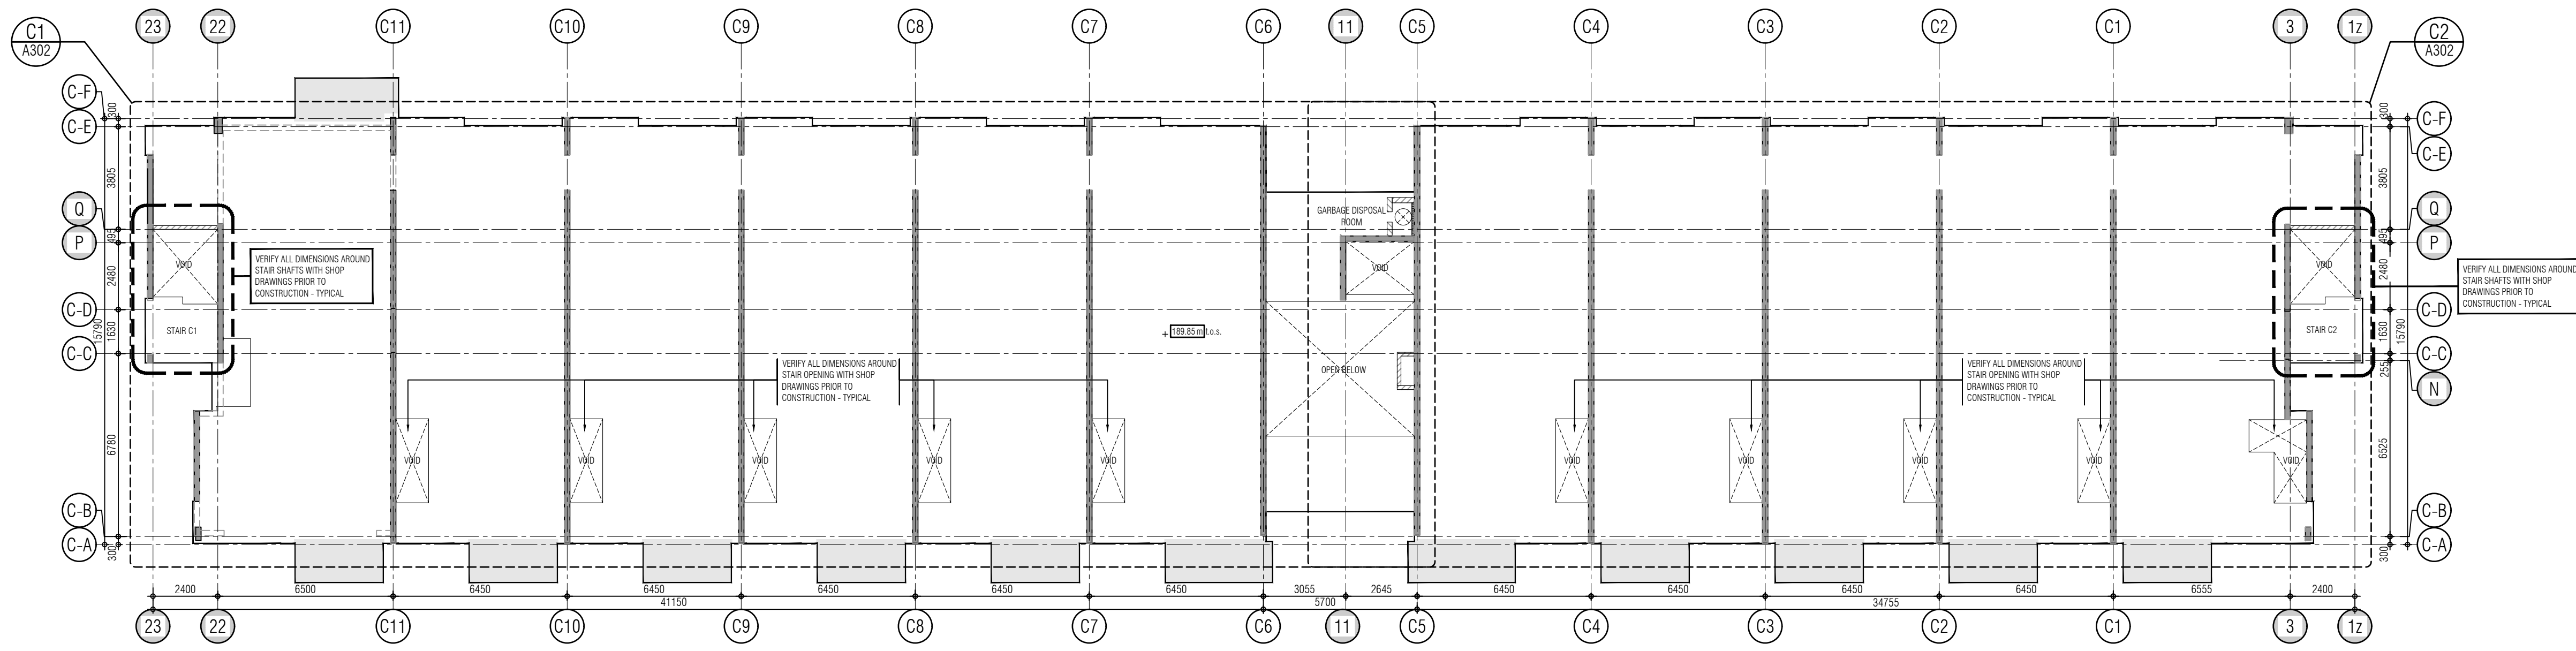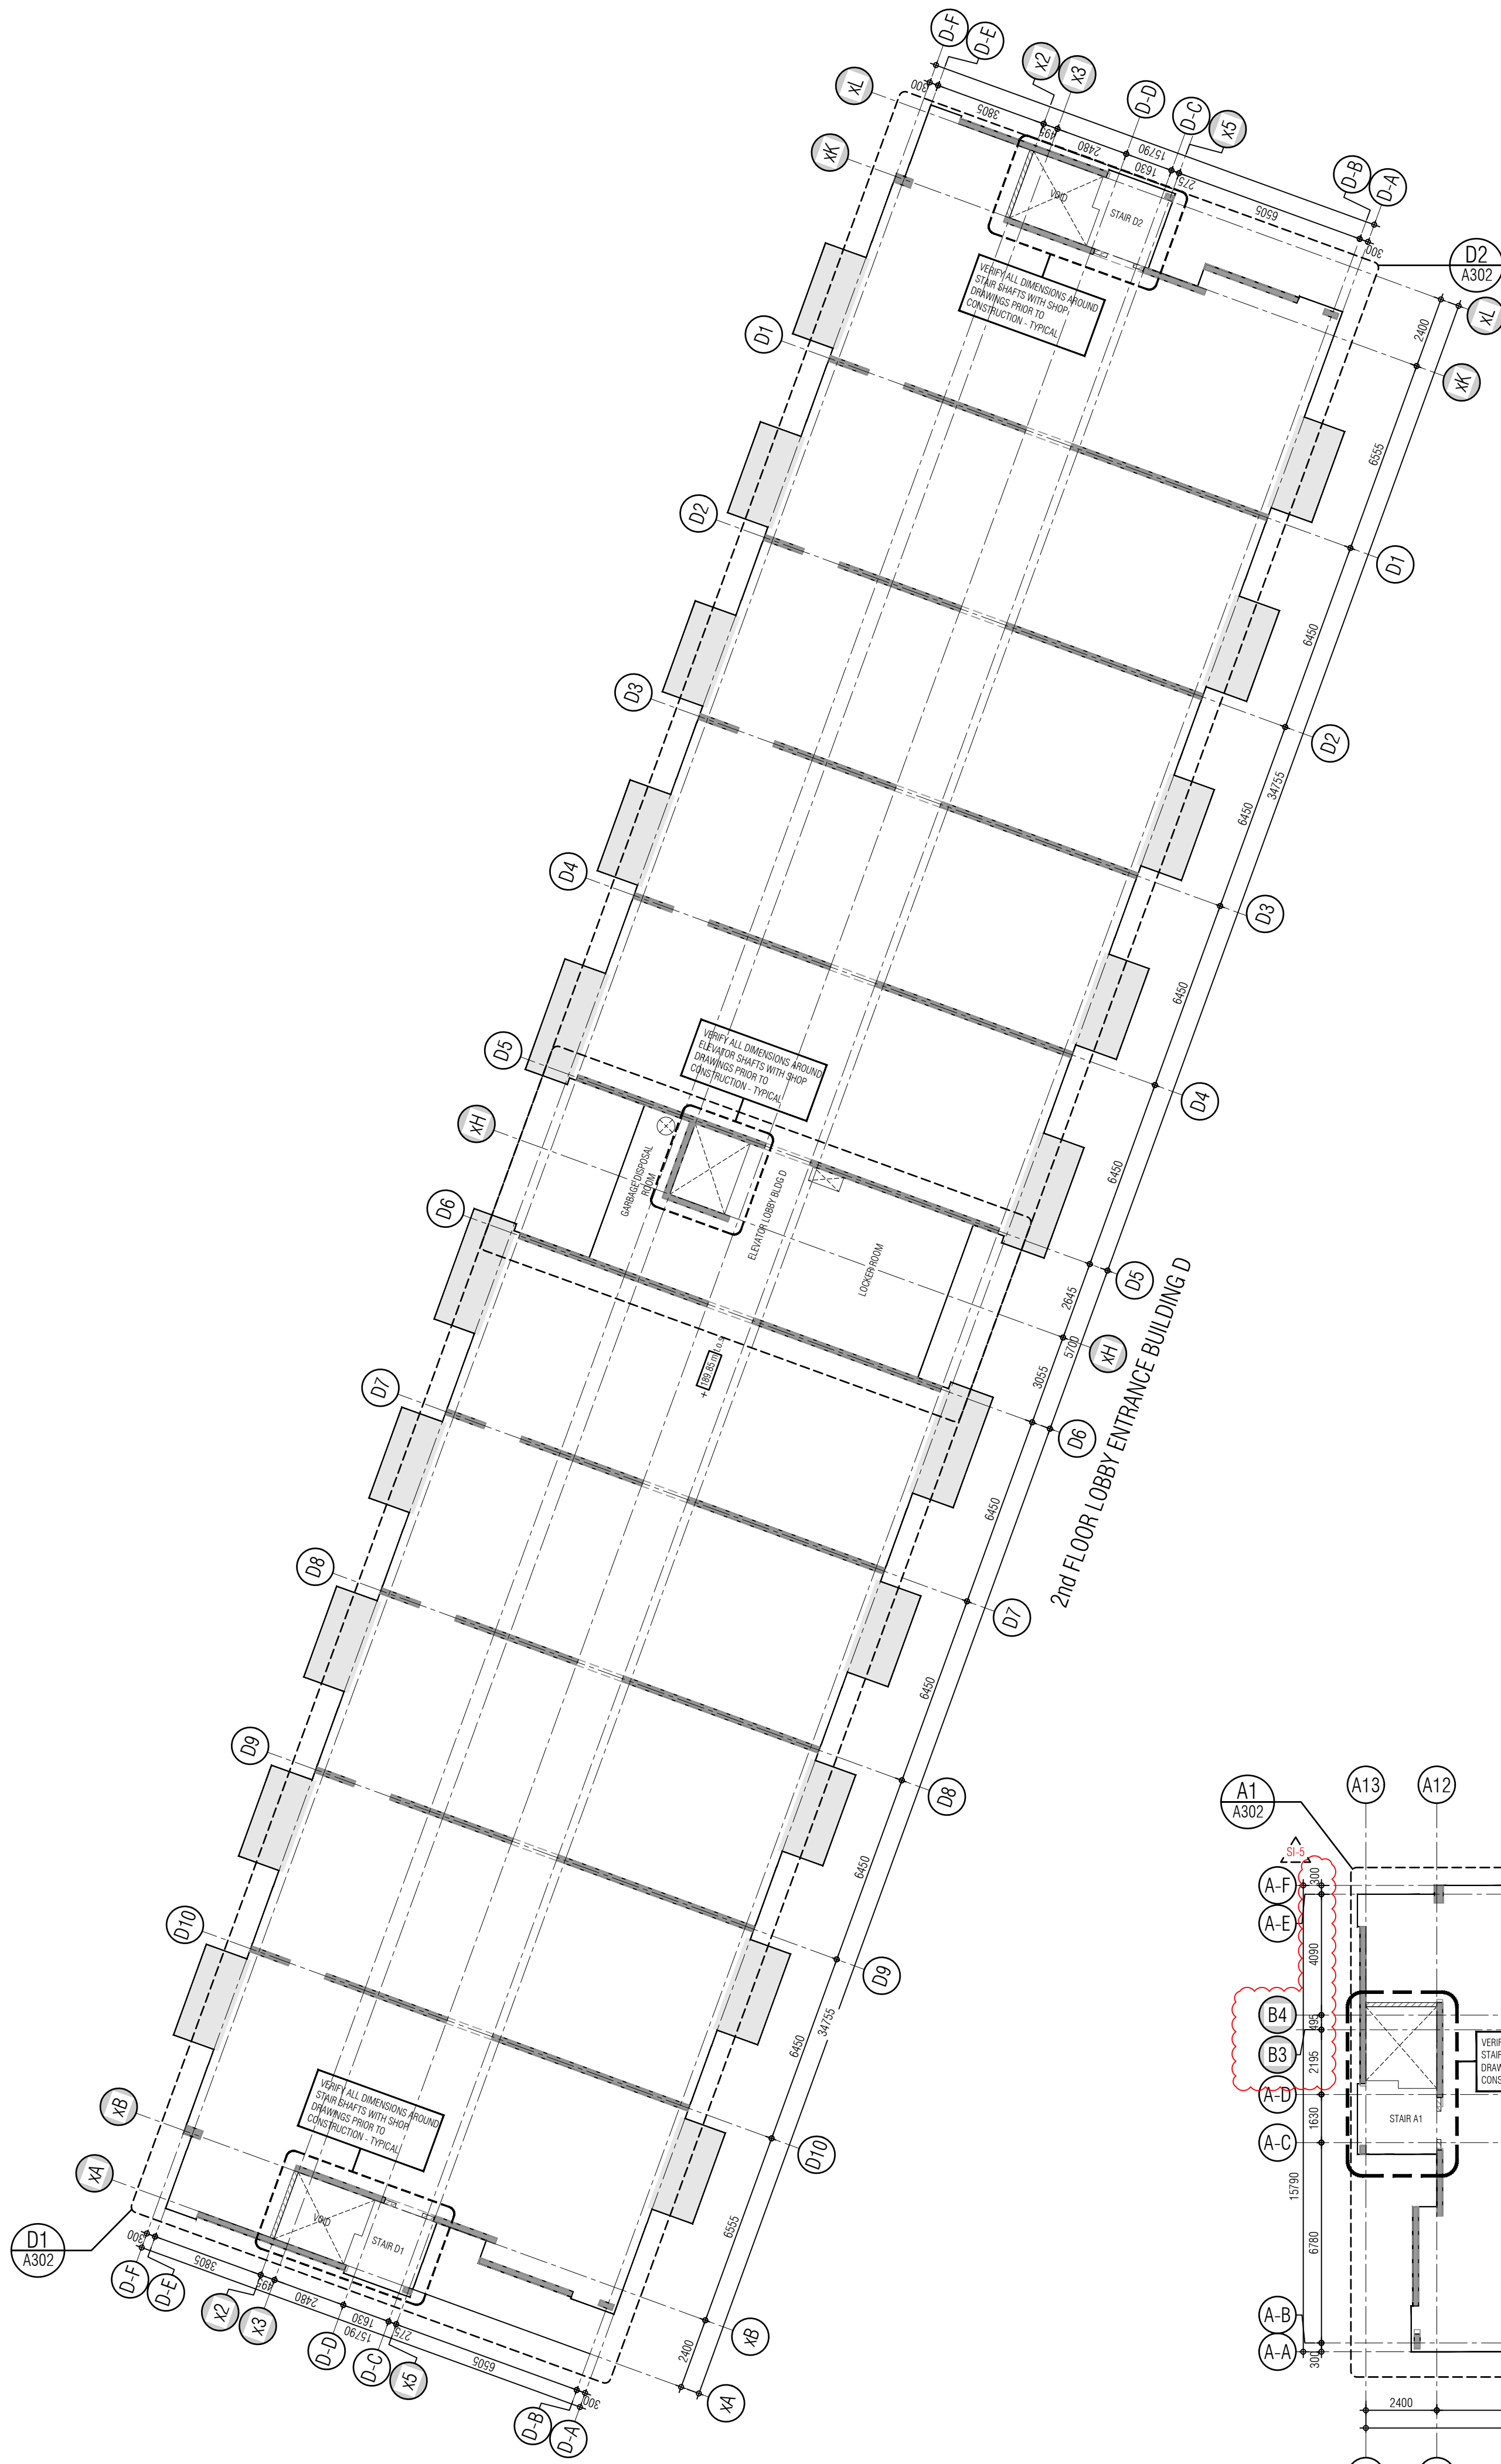

2ND FLOOR LOBBY ENTRANCE BUILDING A

2nd FLOOR LOBBY ENTRANCE BUILDING B

2nd FLOOR LOBBY ENTRANCE BUILDING C

2nd FLOOR LOBBY ENTRANCE BUILDING D

THIS DRAWING IS AN INSTRUMENT OF SERVICE. IT IS PROVIDED BY AND IS THE PROPERTY OF GRAZIANI-CORAZZA ARCHITECTS INC. THE CONTRACTOR MUST VERIFY AND ACCEPT RESPONSIBILITY FOR ALL DIMENSIONS AND COORDINATE THE SITE AND MUST NOTIFY GRAZIANI-CORAZZA ARCHITECTS INC. OF ANY VARIATIONS FROM THE SUPPLIED INFORMATION. GRAZIANI-CORAZZA ARCHITECTS INC. IS NOT RESPONSIBLE FOR THE ACCURACY OF SURVEY, STRUCTURAL, MECHANICAL, ELECTRICAL AND OTHER ENGINEERING INFORMATION SHOWN ON THIS DRAWING. REFER TO THE APPROPRIATE ENGINEERING DRAWINGS BEFORE PROCEEDING WITH THE WORK. CONSTRUCTION MUST CONFORM TO ALL APPLICABLE CODES AND REQUIREMENTS OF THE AUTHORITIES HAVING JURISDICTION. UNLESS OTHERWISE NOTED, NO INVESTIGATION HAS BEEN UNDERTAKEN OR REPORTED ON BY THIS OFFICE IN REGARDS TO THE ENVIRONMENTAL CONDITION OF THIS SITE.

THIS DRAWING IS NOT TO BE SCALED. ALL ARCHITECTURAL SYMBOLS INDICATED ON THIS DRAWING ARE GRAPHIC REPRESENTATIONS ONLY.

CONDITIONS FOR ELECTRONIC INFORMATION TRANSFER:


ELECTRONIC INFORMATION IS SUPPLIED TO THE OTHER ASSOCIATED FIRMS TO ASSIST THEM IN THE EXECUTION OF THEIR WORK. REVIEW THE RECIPIENT FIRMS MUST DETERMINE THE COMPLETENESS, APPROPRIATENESS, RELIANCE OF THE INFORMATION IN RESPECT TO THEIR PARTICULAR RESPONSIBILITY.

1. GRAZIANI-CORAZZA ARCHITECTS INC. SHALL NOT BE RESPONSIBLE FOR ERROR, OMISSION, INCOMPLETENESS DUE TO LOSS OF INFORMATION IN WHOLE OR PART WHEN INFORMATION IS TRANSMITTED.

2. TRANSMISSION OF ANY LOSS OF DAMAGE TO THE RECEIVING ELECTRONIC SYSTEM WHEN INFORMATION IS TRANSMITTED.

REF A302a2 FOR CONTINUATION

01. Oct.07.2019 issued for tender —
02. Mar.13.2020 issued for design coordination #2 —
03. Mar.16.2020 issued for addendum #2 —
04. Mar.16.2020 issued for addendum #3 —
05. Aug.24.2020 issued for addendum #4 —
06. Sept.28.2020 issued for permit bq
07. Oct.20.2020 issued for addendum #5 —
08. Nov.23.2020 issued for addendum #6 —
09. Dec.14.2020 issued for addendum #7 —
10. Jan.18.2021 issued for addendum #8 —
11. Mar.2.2021 issued for permit bq
12. Mar.09.2021 issued for addendum #9 —
13. Mar.10.2021 issued for addendum #9R —
14. Mar.26.2021 issued for progress —
15. May.14.2021 issued for Site Instruction #1 —
16. June.15.2021 issued for Site Instruction #2 —
17. July.7.2021 re-issued for permit bq
18. July.15.2021 issued for Site Instruction #3 bq
19. July.27.2021 issued for Site Instruction #4 bq
20. Aug.3.2021 issued for Site Instruction #5 bq

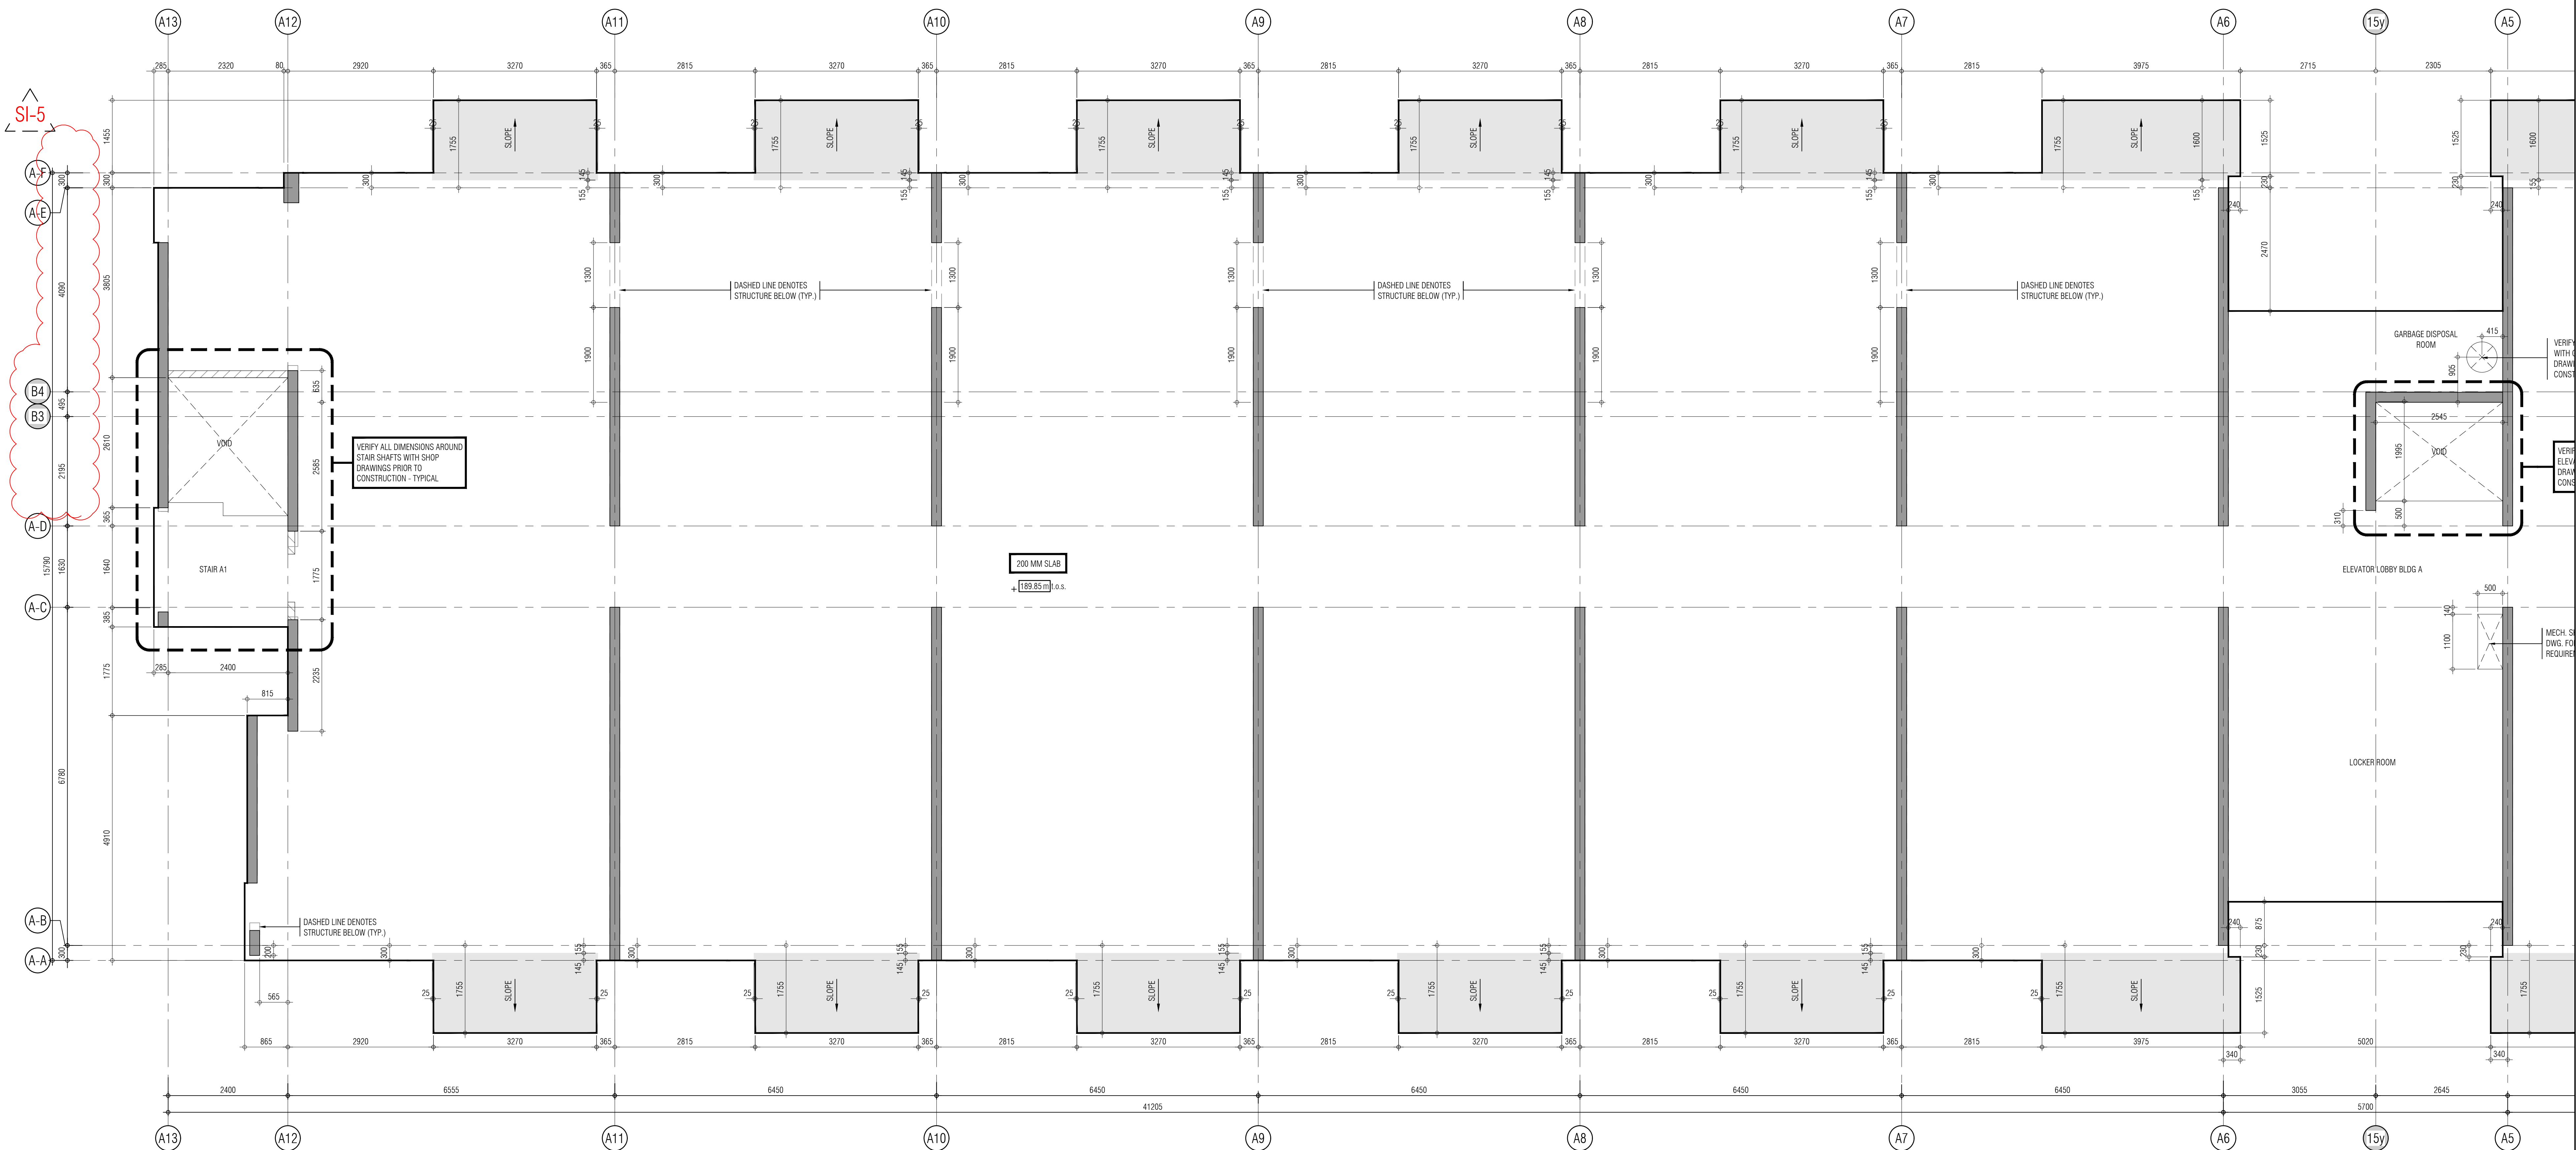

01. SEP.18.2021 issued for addendum 1 bq
- issued for revisions



1233 SHANAGHAN DRIVE, SUITE 101 MISSISSAUGA, ONTARIO L4W 1C3
905.760.2001 F.905.760.2006 WWW.GC-ARCHITECTS.COM

RESIDENTIAL



BRAMPTON ONTARIO

PROJECT ARCHITECT: B. GRAZIANI

ASSISTANT DESIGNER: R. LINCOLN

DRAWN BY: G. C./F. C./M. B.

CHECKED BY: D. BIASI/G. COLANGELO


PLANT DATE: AUG.03.2021

JOB # 1331.15


CONCRETE SLAB EDGE 2ND FLOOR PLAN
BUILDING A (PARTIAL PLAN)

1:50 CS302a1

TITLEBLOCK SIZE: 915 x 1200

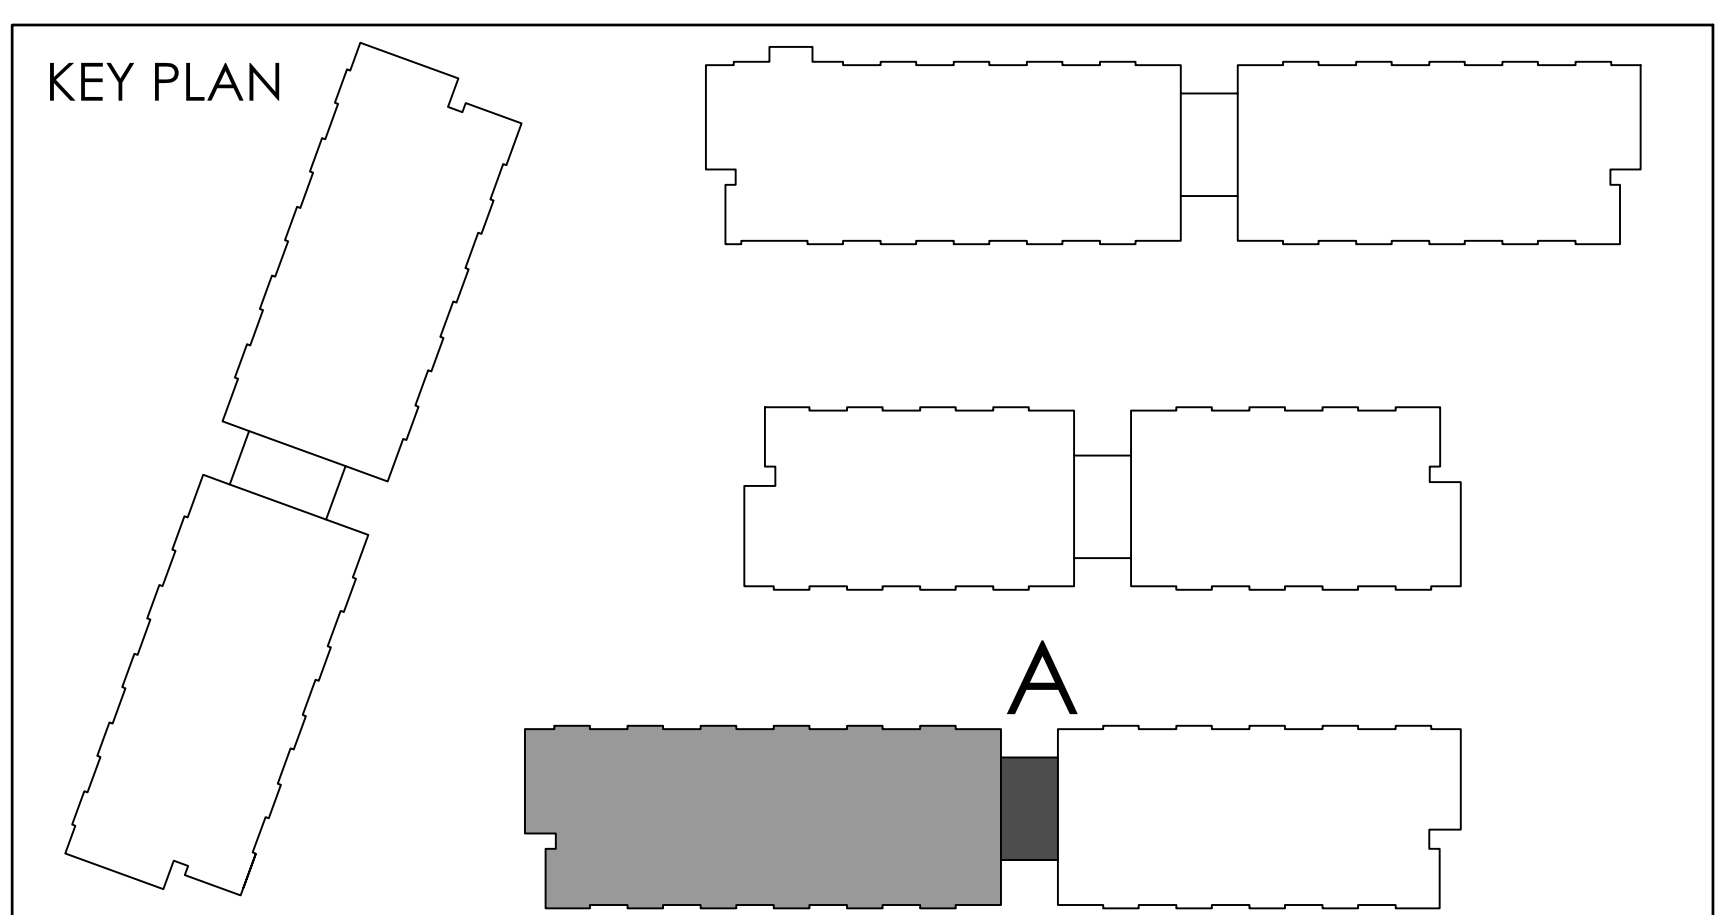

REF.A302a1 FOR CONTINUATION

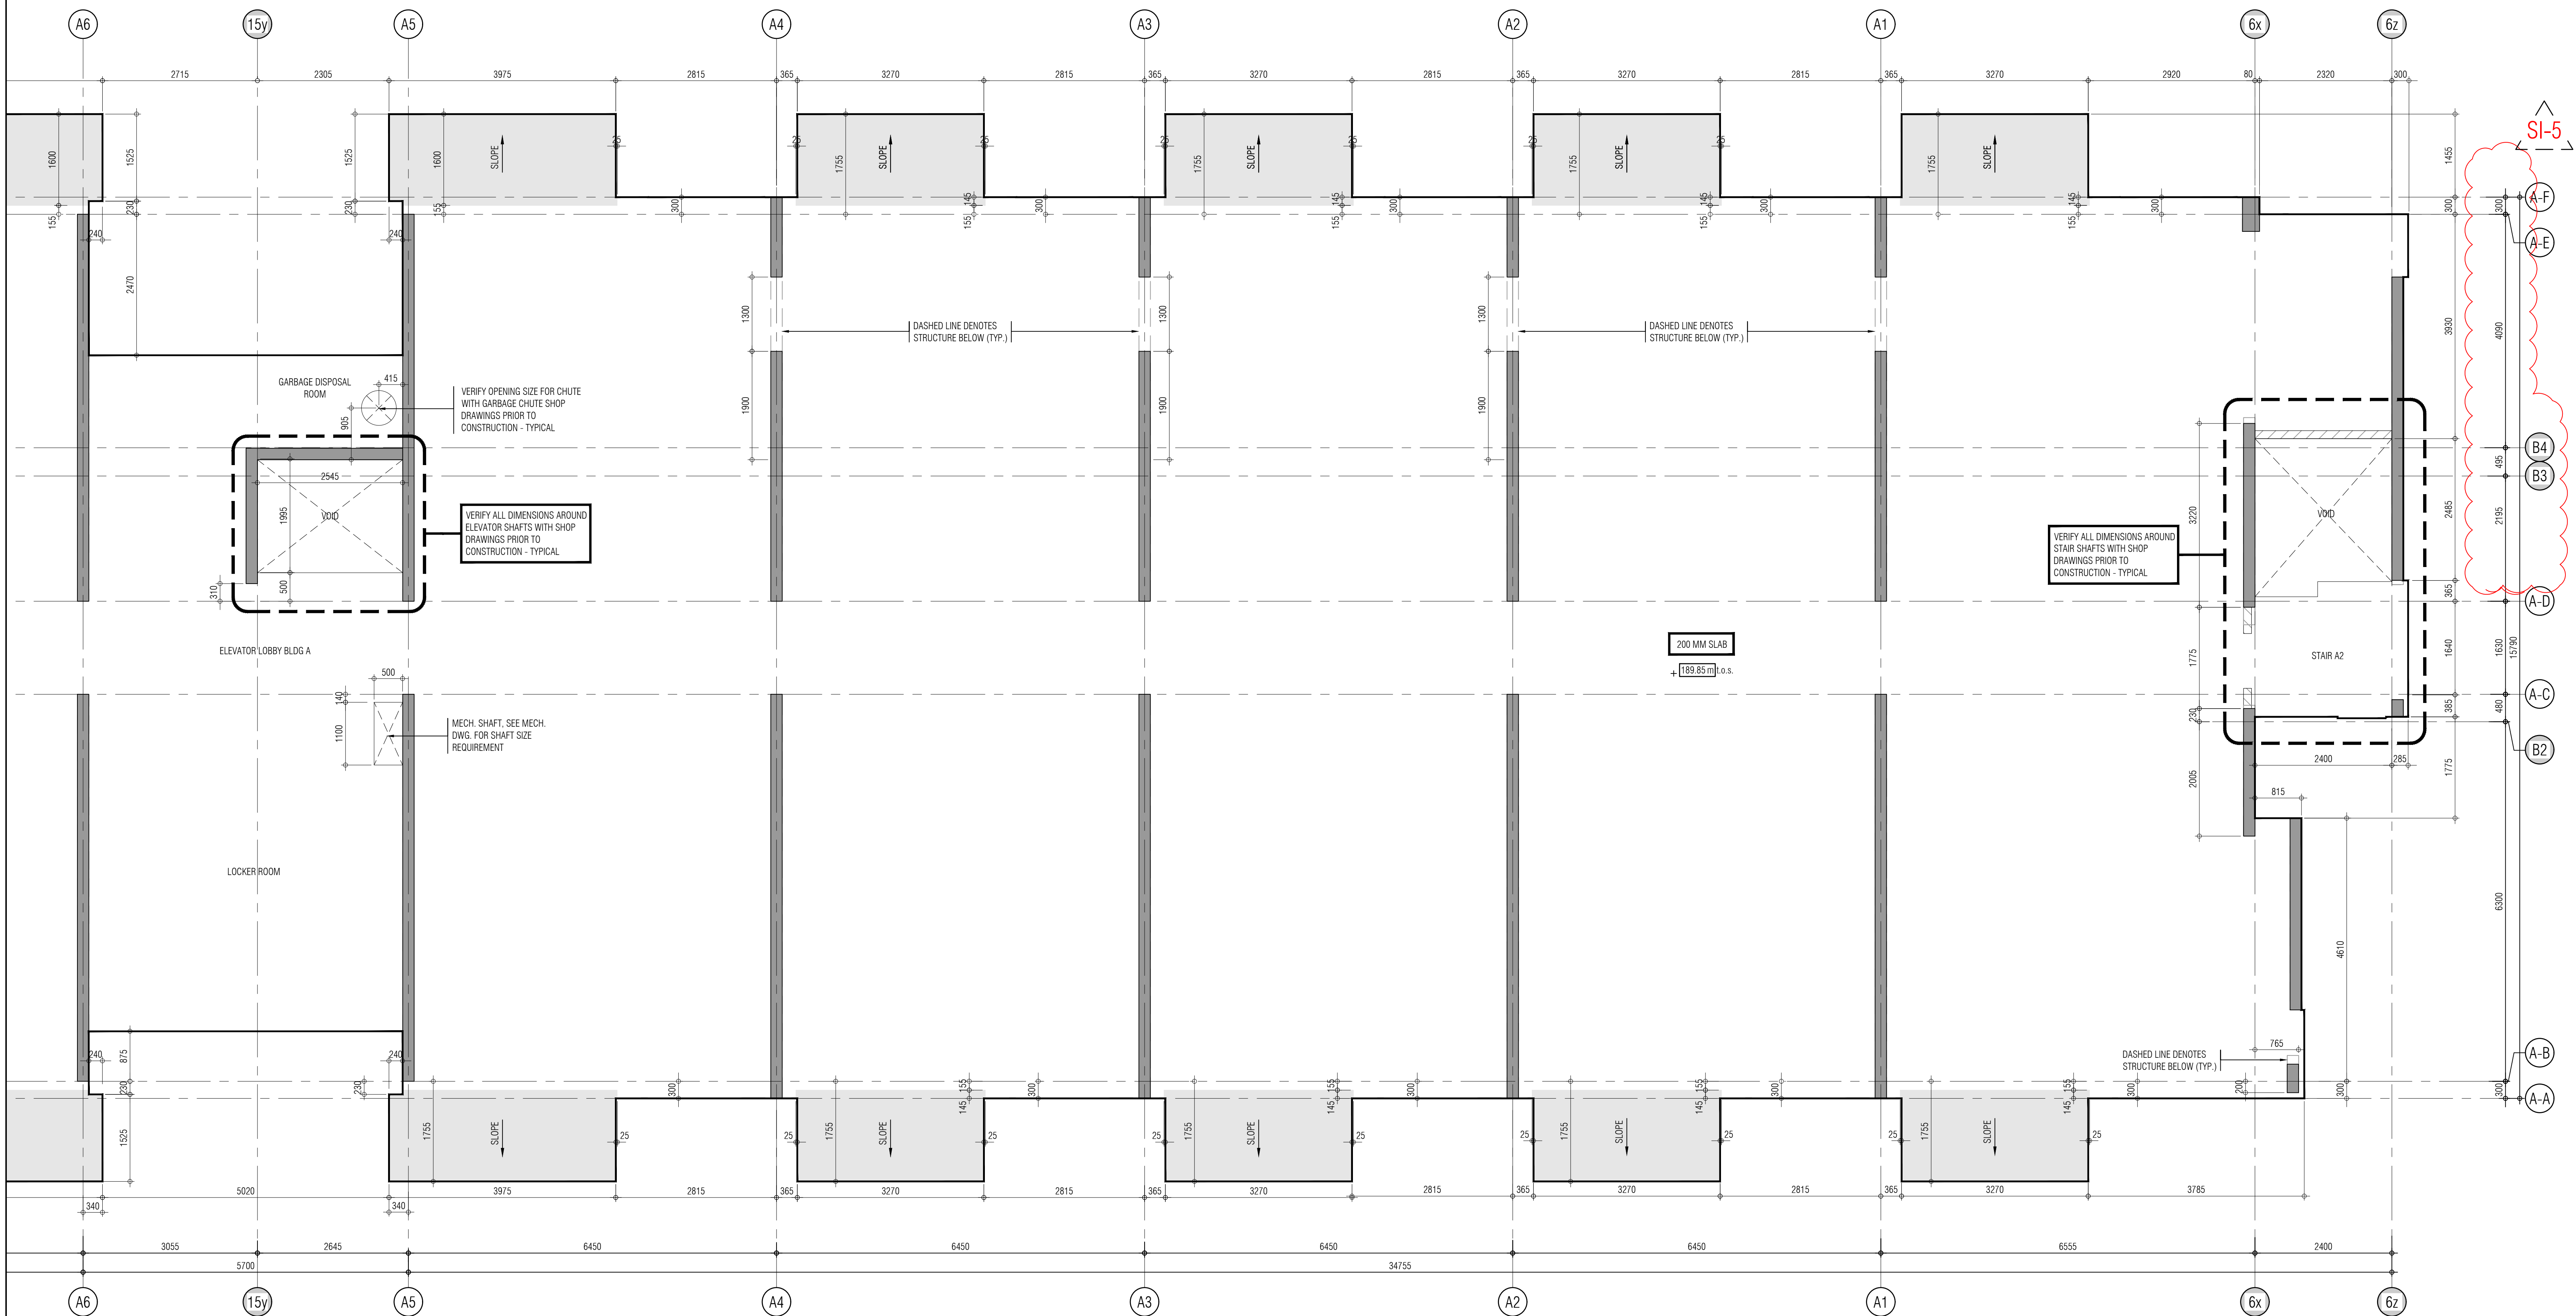

THIS DRAWING AS AN INSTRUMENT OF SERVICE, IS PROVIDED BY AND IS THE PROPERTY OF GRAZIANI-CORAZZANI ARCHITECTS INC. THE CONTRACTOR MUST VERIFY AND ACCEPT RESPONSIBILITY FOR ALL DIMENSIONS AND COORDINATE THE SITE AND MUST NOTIFY GRAZIANI-CORAZZANI ARCHITECTS INC. OF ANY VARIATIONS FROM THE SUPPLIED INFORMATION. GRAZIANI-CORAZZANI ARCHITECTS INC. IS NOT RESPONSIBLE FOR THE ACCURACY OF SURVEY, STRUCTURAL, MECHANICAL, ELECTRICAL AND OTHER ENGINEERING INFORMATION SHOWN ON THIS DRAWING. REFER TO THE APPROPRIATE ENGINEERING DRAWINGS BEFORE PROCEEDING WITH THE WORK. CONSTRUCTION MUST COMPLY TO ALL APPLICABLE CODES AND REQUIREMENTS OF THE AUTHORITIES HAVING JURISDICTION. UNLESS OTHERWISE NOTED, NO INVESTIGATION HAS BEEN UNDERTAKEN OR REPORTED IN BY THIS OFFICE IN REGARDS TO THE ENVIRONMENTAL CONDITION OF THIS SITE.

THIS DRAWING IS NOT TO BE SCALED. ALL ARCHITECTURAL SYMBOLS INDICATED ON THIS DRAWING ARE GRAPHIC REPRESENTATIONS ONLY.

CONDITIONS FOR ELECTRONIC INFORMATION TRANSFER:

ELECTRONIC INFORMATION IS SUPPLIED TO THE OTHER ASSOCIATED FIRMS TO ASSIST THEM IN THE EXECUTION OF THEIR WORK. REVIEW THE RECEIVED FIRMS MUST DETERMINE THE COMPLETENESS, APPROPRIATENESS, RELIANCE OF THE INFORMATION IN RESPECT TO THEIR PARTICULAR RESPONSIBILITY.

GRAZIANI-CORAZZANI ARCHITECTS INC. SHALL NOT BE RESPONSIBLE FOR ERRORS, OMISSIONS, INCOMPLETENESS DUE TO LOSS OF INFORMATION IN WHOLE OR PART WHEN INFORMATION IS TRANSMITTED.

1. TRANSMISSION OF ANY LOSS OF DAMAGE TO THE RECEIVING ELECTRONIC SYSTEM WHEN INFORMATION IS TRANSMITTED.

- 01. Oct.07.2019 issued for tender
- 02. Mar.13.2020 issued for design coordination #2
- 03. Mar.16.2020 issued for addendum #2
- 04. Mar.16.2020 issued for addendum #3
- 05. Aug.24.2020 issued for addendum #4
- 06. Sept.28.2020 issued for permit
- 07. Oct.20.2020 issued for addendum #5
- 08. Nov.23.2020 issued for addendum #6
- 09. Dec.14.2020 issued for addendum #7
- 10. Jan.15.2021 issued for addendum #8
- 11. Mar.2.2021 issued for permit
- 12. Mar.09.2021 issued for addendum #9
- 13. Mar.10.2021 issued for addendum #9R
- 14. Mar.26.2021 issued for progress
- 15. May.14.2021 issued for Site Instruction #1
- 16. June.15.2021 issued for Site Instruction #2
- 17. July.7.2021 re-issued for permit
- 18. July.15.2021 issued for Site Instruction #3
- 19. July.27.2021 issued for Site Instruction #4
- 20. Aug.3.2021 issued for Site Instruction #5

- 01. SEP.18.2021 issued for addendum 1
- issued for revisions

GRAZIANI CORAZZANI ARCHITECTS

1320 SHARONDAVE DRIVE, SUITE 100 MISSISSAUGA, ONTARIO L4W 1C3
905.760.2001 P.905.760.2000 WWW.GC-ARCHITECTS.COM

RESIDENTIAL

ATTMAR + PALLESCHI DRIVE

BRAMPTON ONTARIO

PROJECT ARCHITECT: B. GRAZIANI
ASSISTANT DESIGNER: R. LINCOLN
DRAWN BY: G.C./F.C./M.B.
CHECKED BY: D. BIASE/G. COLANGELO
PLOT DATE: AUG.03.2021
JOB # 1331.15

CONCRETE SLAB EDGE 2ND FLOOR PLAN
BUILDING A (PARTIAL PLAN)

1:50 CS302a2

TITLE BLOCK SIZE: 915 x 1200

THIS DRAWING IS AN INSTRUMENT OF SERVICE. IT IS PROVIDED BY AND IS THE PROPERTY OF GRAZIANI-CORAZZA ARCHITECTS INC. THE CONTRACTOR MUST VERIFY AND ACCEPT RESPONSIBILITY FOR ALL DIMENSIONS AND COORDINATE THE SITE AND MUST NOTIFY GRAZIANI-CORAZZA ARCHITECTS INC. OF ANY DISCREPANCIES FROM THE SUPPLIED INFORMATION. GRAZIANI-CORAZZA ARCHITECTS INC. IS NOT RESPONSIBLE FOR THE ACCURACY OF SURVEY, STRUCTURAL, MECHANICAL, ELECTRICAL AND OTHER ENGINEERING INFORMATION SHOWN ON THIS DRAWING. REFER TO THE APPROPRIATE ENGINEERING DRAWINGS BEFORE PROCEEDING WITH THE WORK. CONSTRUCTION MUST COMPLY TO ALL APPLICABLE CODES AND REQUIREMENTS OF THE AUTHORITIES HAVING JURISDICTION. UNLESS OTHERWISE NOTED, NO INVESTIGATION HAS BEEN UNDERTAKEN OR REPORTED ON BY THIS OFFICE IN REGARD TO THE ENVIRONMENTAL CONDITION OF THIS SITE.

THIS DRAWING IS NOT TO BE SCALED. ALL ARCHITECTURAL SYMBOLS INDICATED ON THIS DRAWING ARE GRAPHIC REPRESENTATIONS ONLY.

CONDITIONS FOR ELECTRONIC INFORMATION TRANSFER

ELECTRONIC INFORMATION IS SUPPLIED TO THE OTHER ASSOCIATED FIRMS TO ASSIST THEM IN THE EXECUTION OF THEIR WORK. REVIEW THE RECEIVING FIRMS MUST DETERMINE THE COMPLETENESS, APPROPRIATENESS, RELIANCE OF THE INFORMATION IN RESPECT TO THEIR PARTICULAR RESPONSIBILITY.

GRAZIANI-CORAZZA ARCHITECTS INC. SHALL NOT BE RESPONSIBLE FOR:

1. ERROR, OMISSIONS, INCOMPLETENESS DUE TO LOSS OF INFORMATION IN WHOLE OR PART WHEN INFORMATION IS TRANSFERRED.
2. TRANSMISSION OF ANY VIRUS OR DAMAGE TO THE RECEIVING ELECTRONIC SYSTEM WHEN INFORMATION IS TRANSFERRED.

01. Oct.07.2019 issued for tender
02. Mar.13.2020 issued for design coordination #2
03. Mar.16.2020 issued for addendum #2
04. Mar.16.2020 issued for addendum #3
05. Aug.24.2020 issued for addendum #4
06. Sept.28.2020 issued for permit
07. Oct.20.2020 issued for addendum #5
08. Nov.23.2020 issued for addendum #6
09. Dec.14.2020 issued for addendum #7
10. Jan.15.2021 issued for addendum #8
11. Mar.2.2021 issued for permit
12. Mar.09.2021 issued for addendum #9
13. Mar.10.2021 issued for addendum #9R
14. Mar.26.2021 issued for progress
15. May.14.2021 issued for Site Instruction #1
16. June.15.2021 issued for Site Instruction #2
17. July.7.2021 re-issued for permit
18. July.15.2021 issued for Site Instruction #3
19. July.27.2021 issued for Site Instruction #4
20. Aug.3.2021 issued for Site Instruction #5

01. SEP/18/2021 issued for revisions

**GRAZIANI
CORAZZA
ARCHITECTS**

1120 SHANAGHAN DRIVE, SUITE 100 MISSISSAUGA, ONTARIO L4W 1C3
905.709.7021 P.905.709.7080 WWW.GC-ARCHITECTS.COM



BRAMPTON ONTARIO

PROJECT ARCHITECT: B. GRAZIANI

ASSISTANT DESIGNER: R. LINCOLN

DRAWN BY: G. C./F. C./M. B.

CHECKED BY: D. BIASI/G. COLANGELO



PLOT DATE: AUG.03.2021

JOB #: 1331.15


CONCRETE SLAB EDGE
3RD FLOOR OVERALL

1:150 CS303


TITLEBLOCK SIZE: 915 x 1200

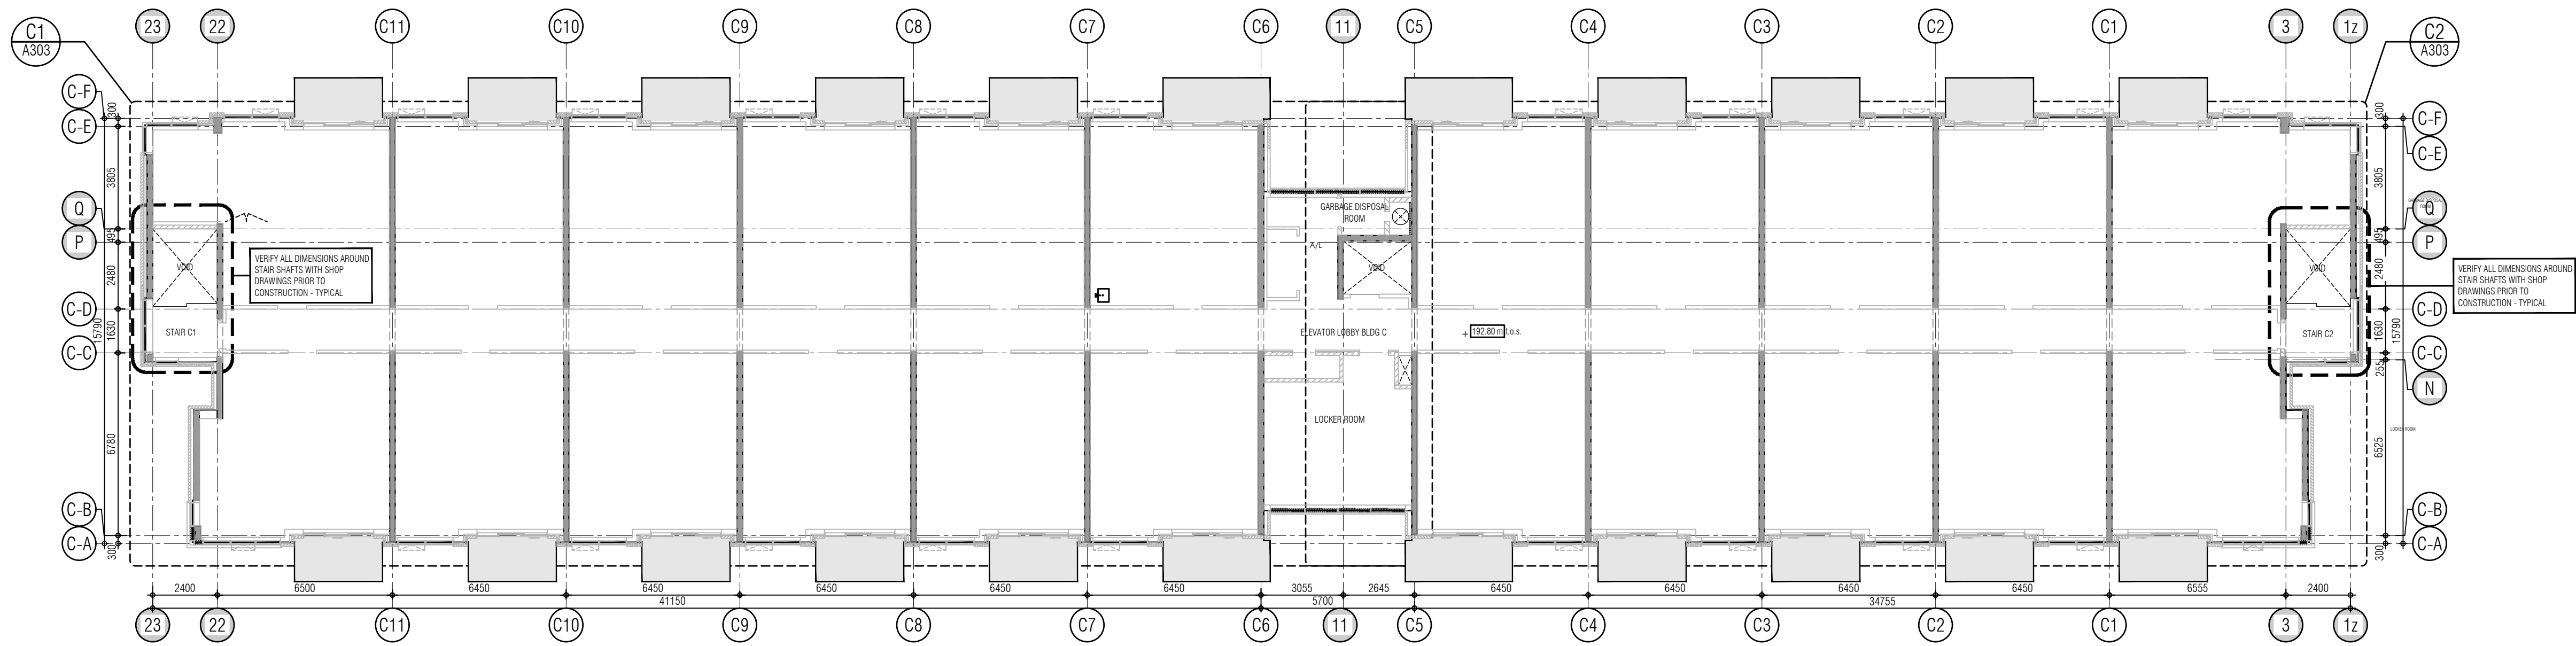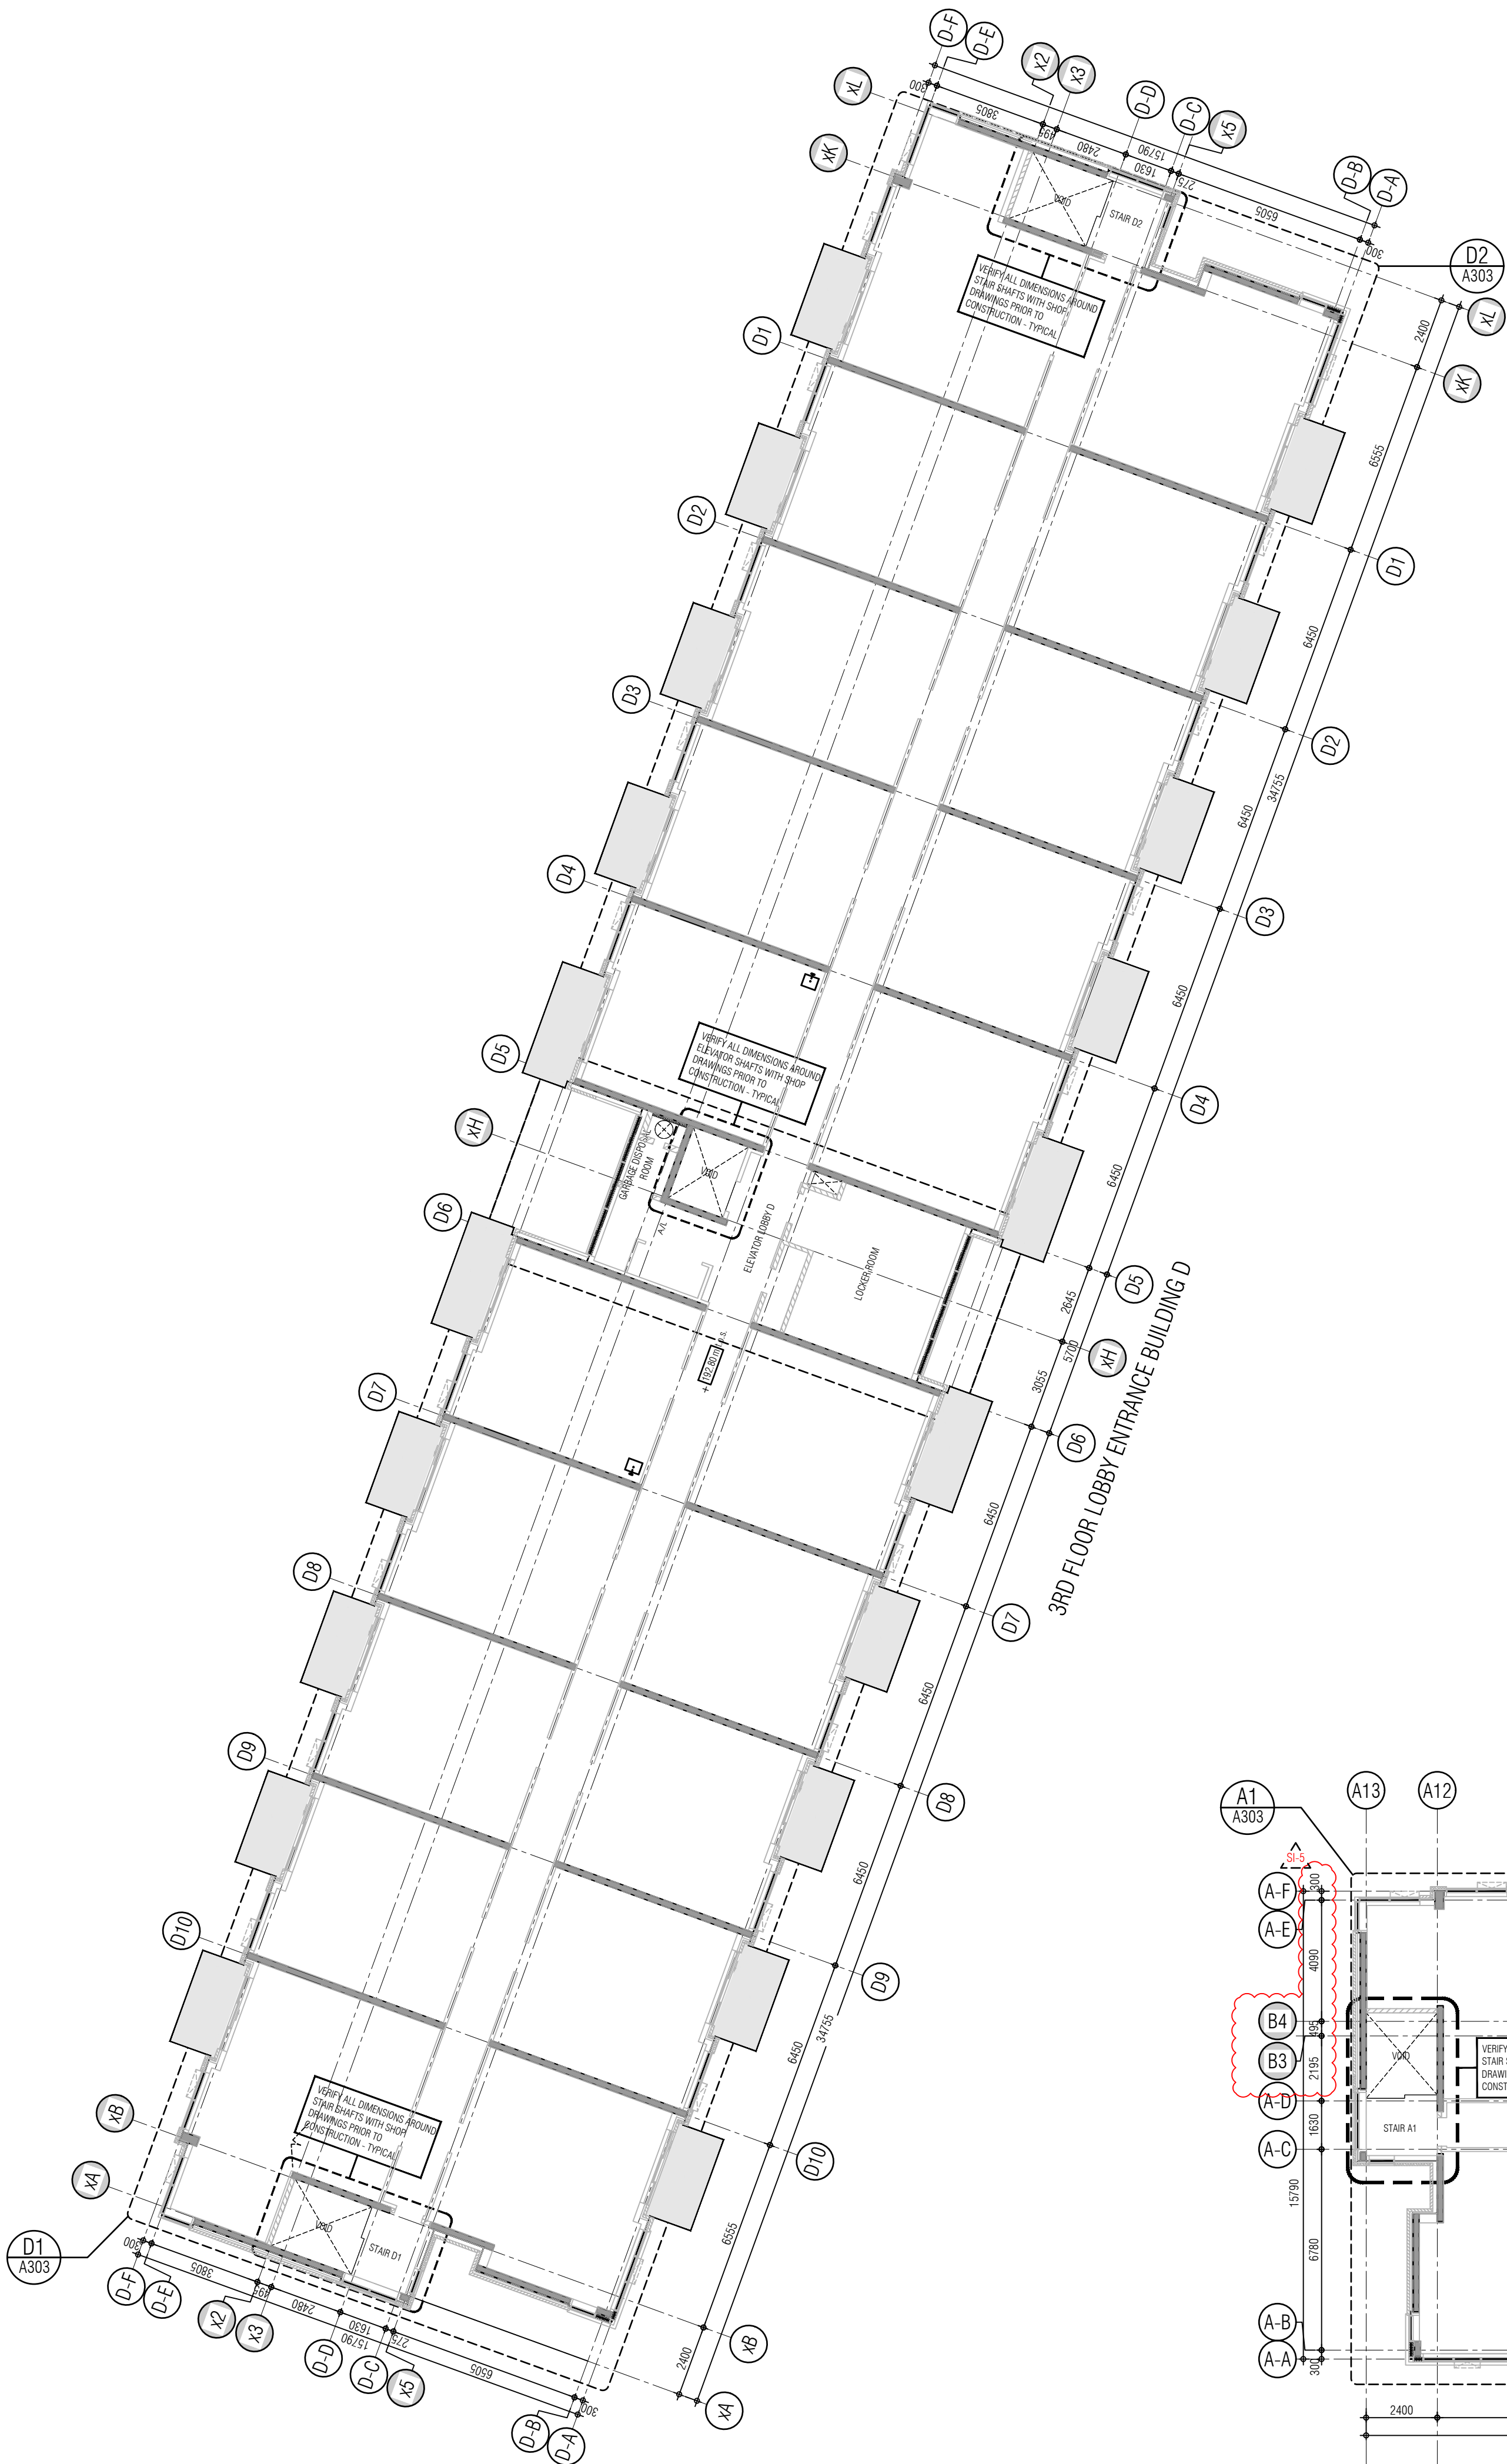


3RD FLOOR LOBBY ENTRANCE BUILDING C

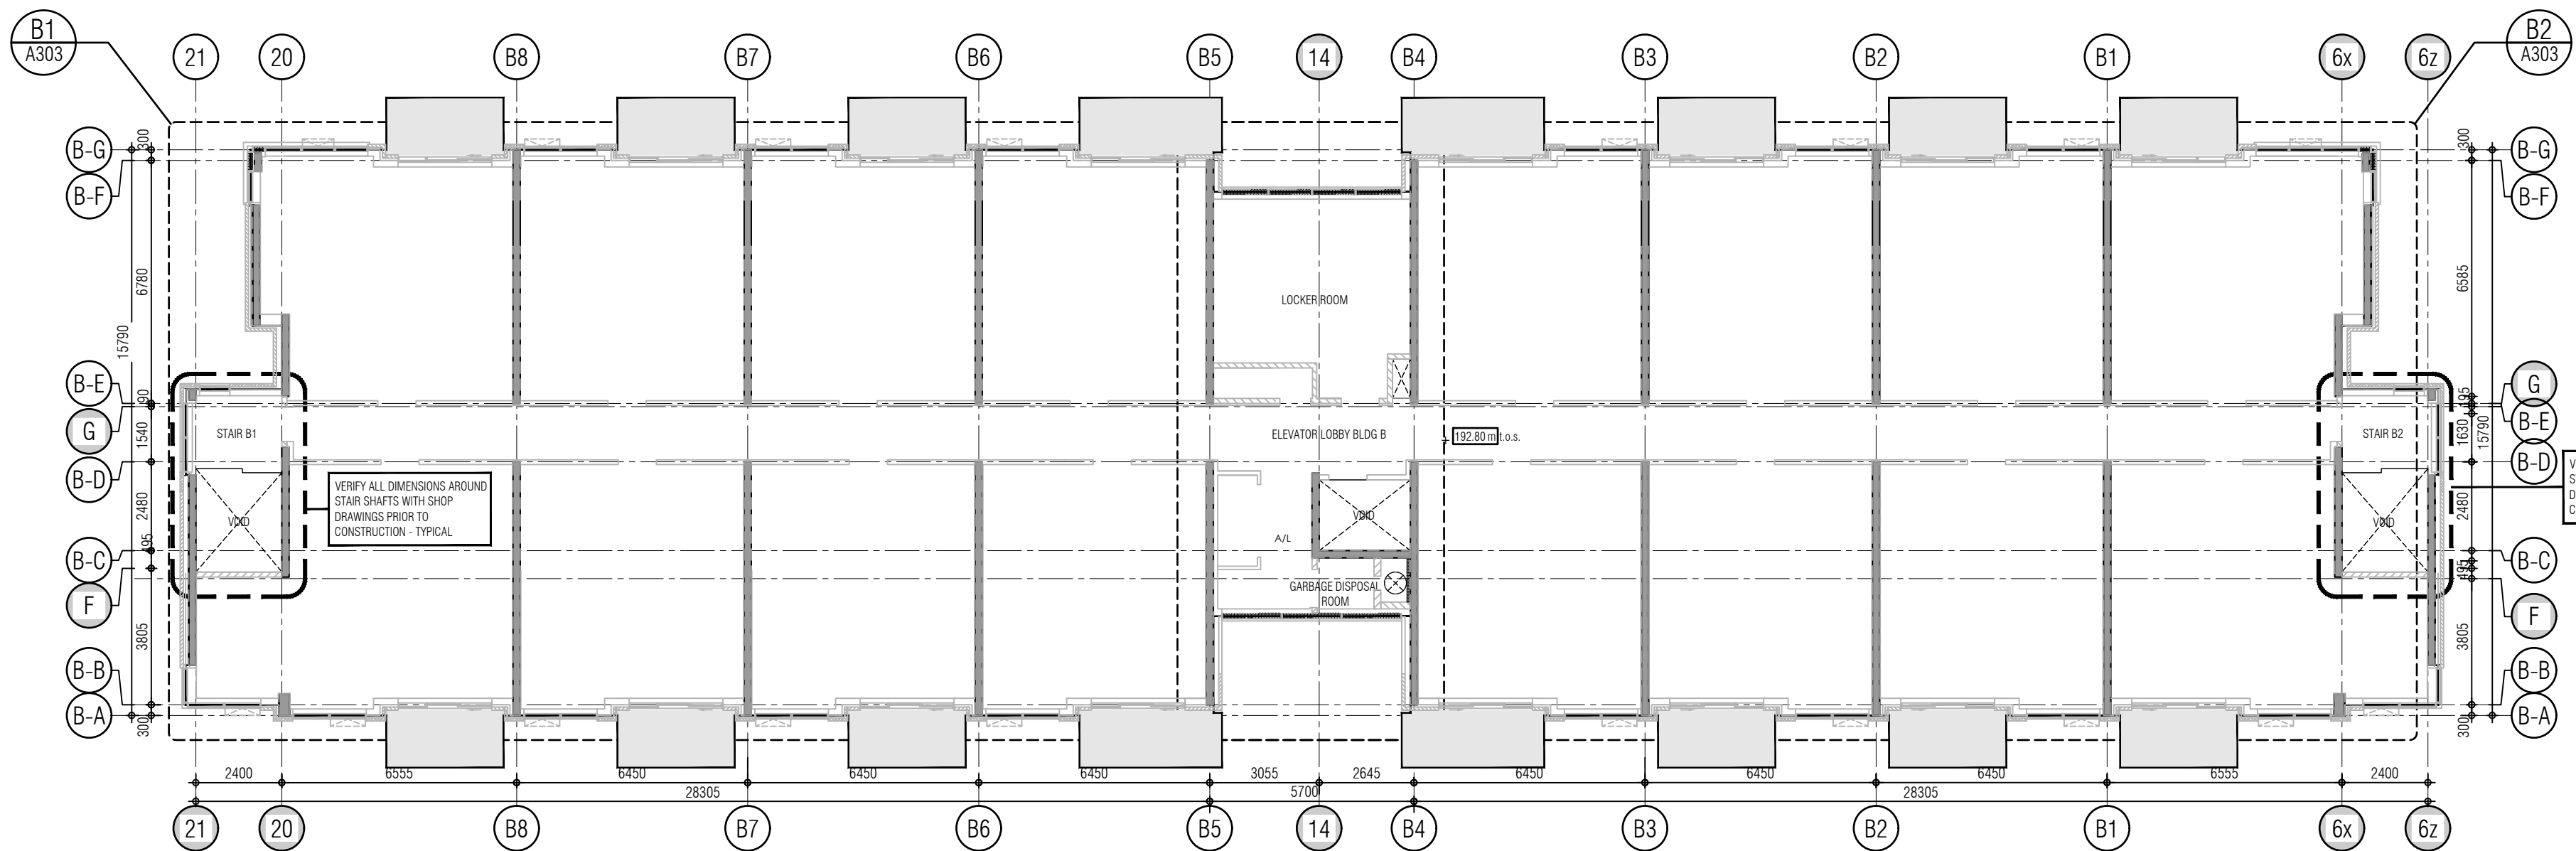

3RD FLOOR LOBBY ENTRANCE BUILDING B

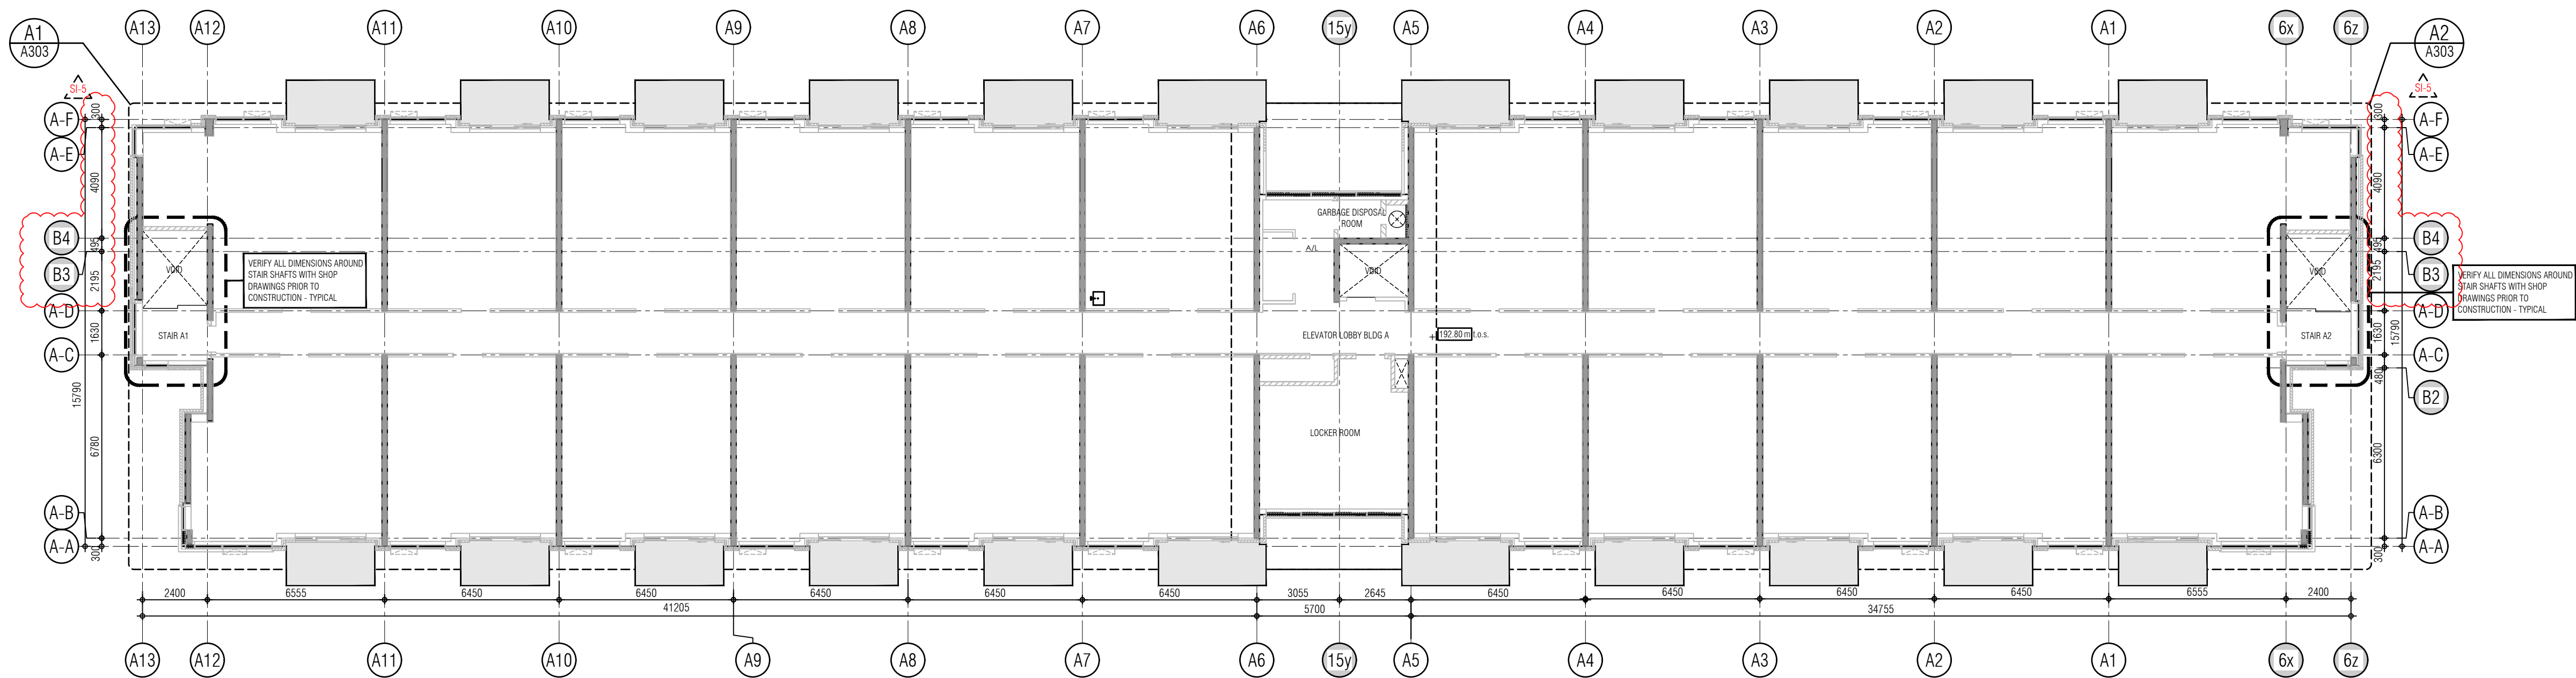

3RD FLOOR LOBBY ENTRANCE BUILDING A

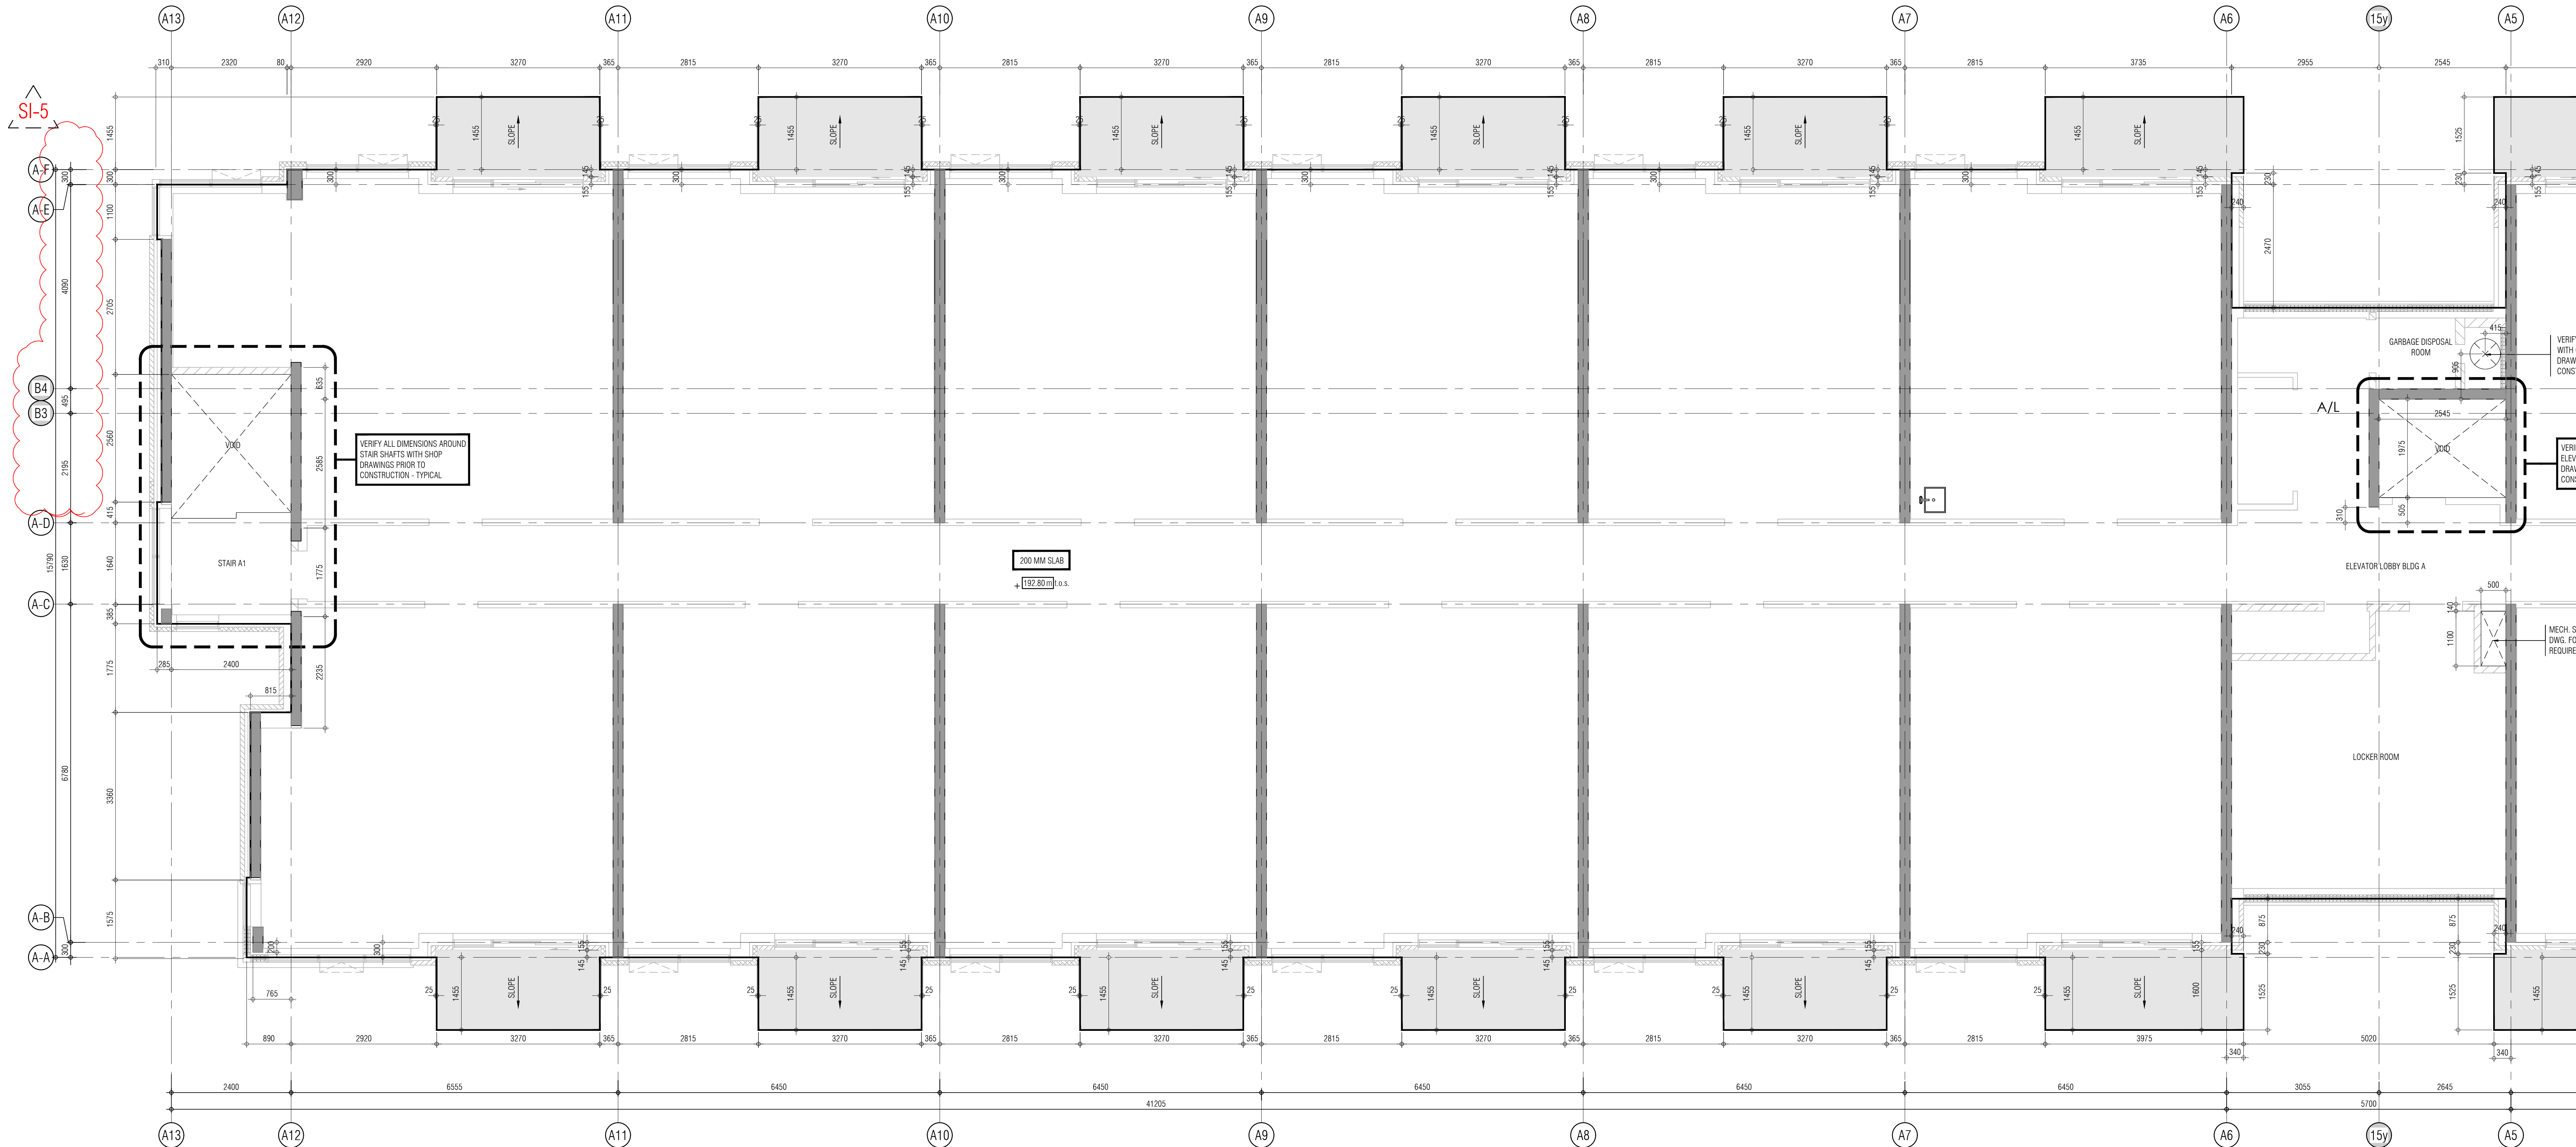

THIS DRAWING IS AN INSTRUMENT OF SERVICE, IT IS PROVIDED BY AND IS THE PROPERTY OF GRAZIANI-CORAZZA ARCHITECTS INC. THE CONTRACTOR MUST VERIFY AND ACCEPT RESPONSIBILITY FOR ALL DIMENSIONS AND COORDINATIONS. THE CONTRACTOR MUST VERIFY GRAZIANI-CORAZZA ARCHITECTS INC. OF ANY OMISSIONS OR ERRORS IN THE SUPPLIED INFORMATION. GRAZIANI-CORAZZA ARCHITECTS INC. IS NOT RESPONSIBLE FOR THE ACCURACY OF SURVEY, STRUCTURAL, MECHANICAL, ELECTRICAL AND OTHER ENGINEERING INFORMATION SHOWN ON THIS DRAWING. REFER TO THE APPROPRIATE ENGINEERING DRAWINGS BEFORE PROCEEDING WITH THE WORK. CONSTRUCTION MUST COMPLY TO ALL APPLICABLE CODES AND REQUIREMENTS OF THE AUTHORITY HAVING JURISDICTION. UNLESS OTHERWISE NOTED, NO MODIFICATION HAS BEEN MADE/MADE AS REPORTED IN BY THIS OFFICE IN REGARD TO THE ENVIRONMENTAL CONDITION OF THIS SITE.

THIS DRAWING IS NOT TO BE SCALED. ALL ARCHITECTURAL SYMBOLS INDICATED ON THIS DRAWING ARE GRAPHIC REPRESENTATIONS ONLY.

CONDITIONS FOR ELECTRONIC INFORMATION TRANSFER

ELECTRONIC INFORMATION IS SUPPLIED TO THE OTHER ASSOCIATED FIRMS TO ASSIST THEM IN THE EXECUTION OF THEIR WORK. REVIEW THE RECEIVED FIRMS MUST DETERMINE THE COMPLETENESS, APPROPRIATENESS, RELIANCE OF THE INFORMATION IN RESPECT TO THEIR PARTICULAR RESPONSIBILITY.

1. GRAZIANI-CORAZZA ARCHITECTS INC. SHALL NOT BE RESPONSIBLE FOR ERROR, OMISSIONS, INCOMPLETENESS DUE TO LOSS OF INFORMATION IN WHICH OR PART INFORMATION IS TRANSMITTED.

2. TRANSMISSION OF ANY LOSS OF DAMAGE TO THE RECEIVING ELECTRONIC SYSTEM WHEN INFORMATION IS TRANSMITTED.

01. Oct.07.2019 issued for tender
02. Mar.13.2020 issued for design coordination #2
03. Mar.16.2020 issued for addendum #2
04. Mar.16.2020 issued for addendum #3
05. Aug.24.2020 issued for addendum #4
06. Sept. 28.2020 issued for permit
07. Oct.20.2020 issued for addendum #5
08. Nov.23.2020 issued for addendum #6
09. Dec.14.2020 issued for addendum #7
10. Jan.18.2021 issued for addendum #8
11. Mar. 2. 2021 issued for permit
12. Mar.09.2021 issued for addendum #9
13. Mar.10.2021 issued for addendum #9R
14. Mar.26.2021 issued for progress
15. May.14.2021 issued for Site Instruction #1
16. June.15.2021 issued for Site Instruction #2
17. July. 7. 2021 re-issued for permit
18. July. 15. 2021 issued for Site Instruction #3
19. July. 27. 2021 issued for Site Instruction #4
20. Aug. 3. 2021 issued for Site Instruction #5

01. SEP.18.2021 issued for addendum 1
- issued for revisions

GRAZIANI CORAZZA ARCHITECTS

1100 SHANAGASSA DRIVE, SUITE 100 MISSISSAUGA, ONTARIO L4W 1C3
905.760.7001 P.905.760.7000 WWW.GC-ARCHITECTS.COM

RESIDENTIAL

ATTMAR + PALLESCHI DRIVE


BRAMPTON ONTARIO

PROJECT ARCHITECT: B. GRAZIANI
ASSISTANT DESIGNER: R. LINCOLN
DRAWN BY: G. C./F. C./M. B.
CHECKED BY: D. BIASE/G. COLANGELO
PLOT DATE: AUG.03.2021
JOB # 1331.15


**CONCRETE SLAB EDGE 3RD FLOOR
BUILDING A (PARTIAL PLAN)**

1:50 CS303a1

TITLEBLOCK SIZE: 915 x 1200

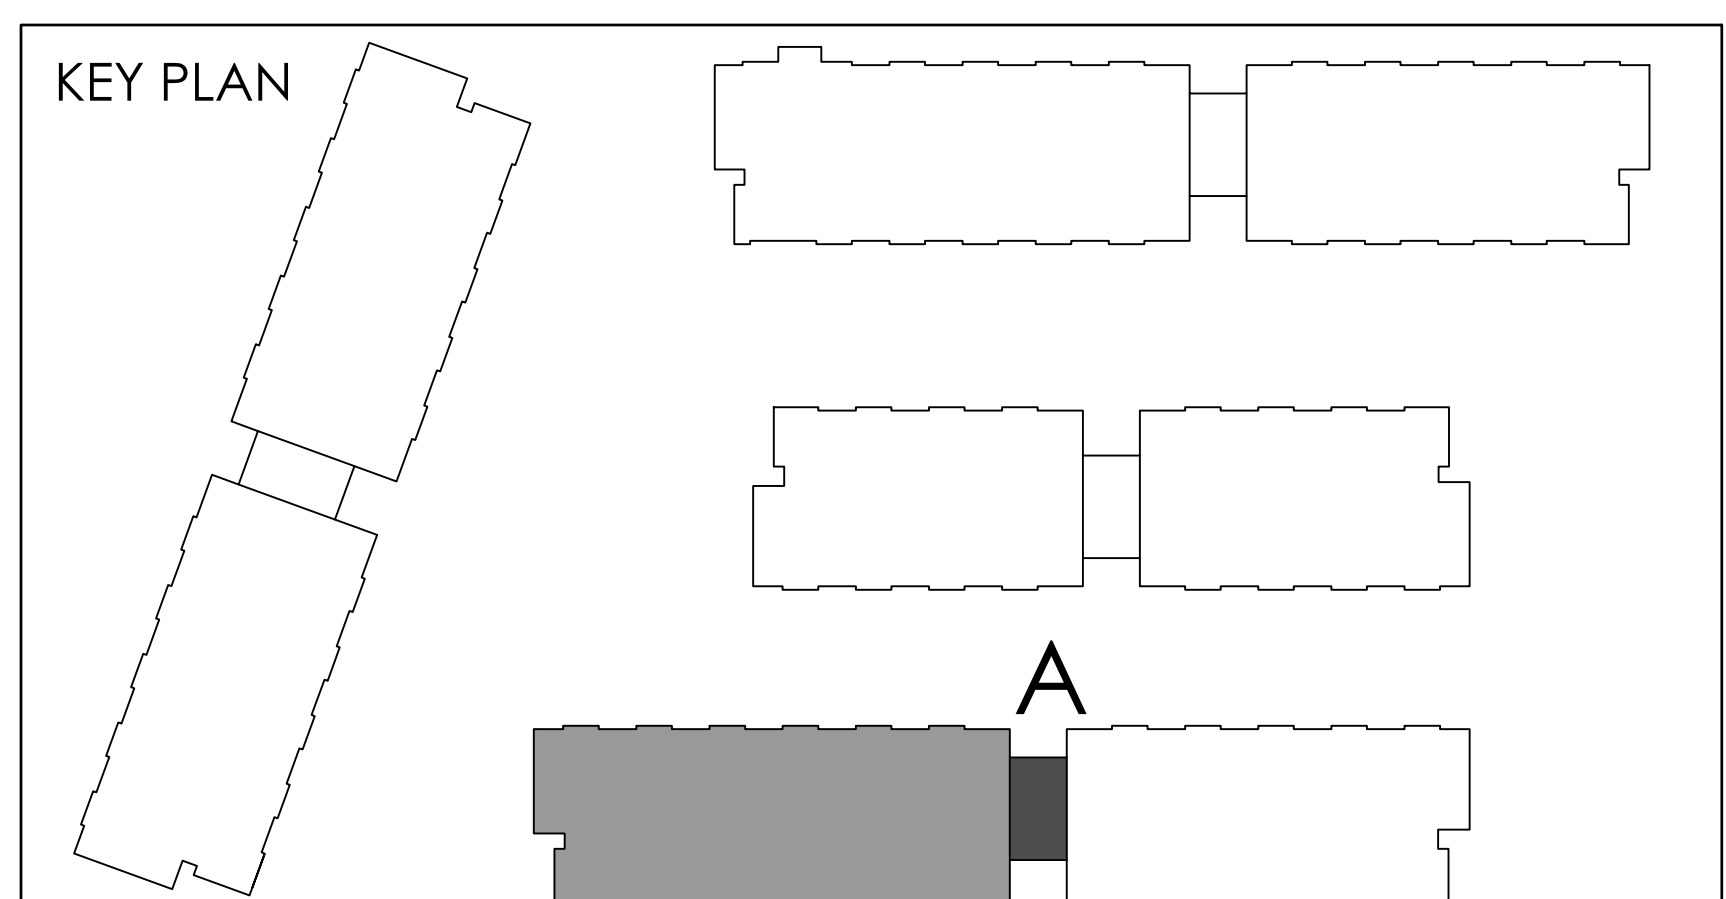

REF.A303a1 FOR CONTINUATION

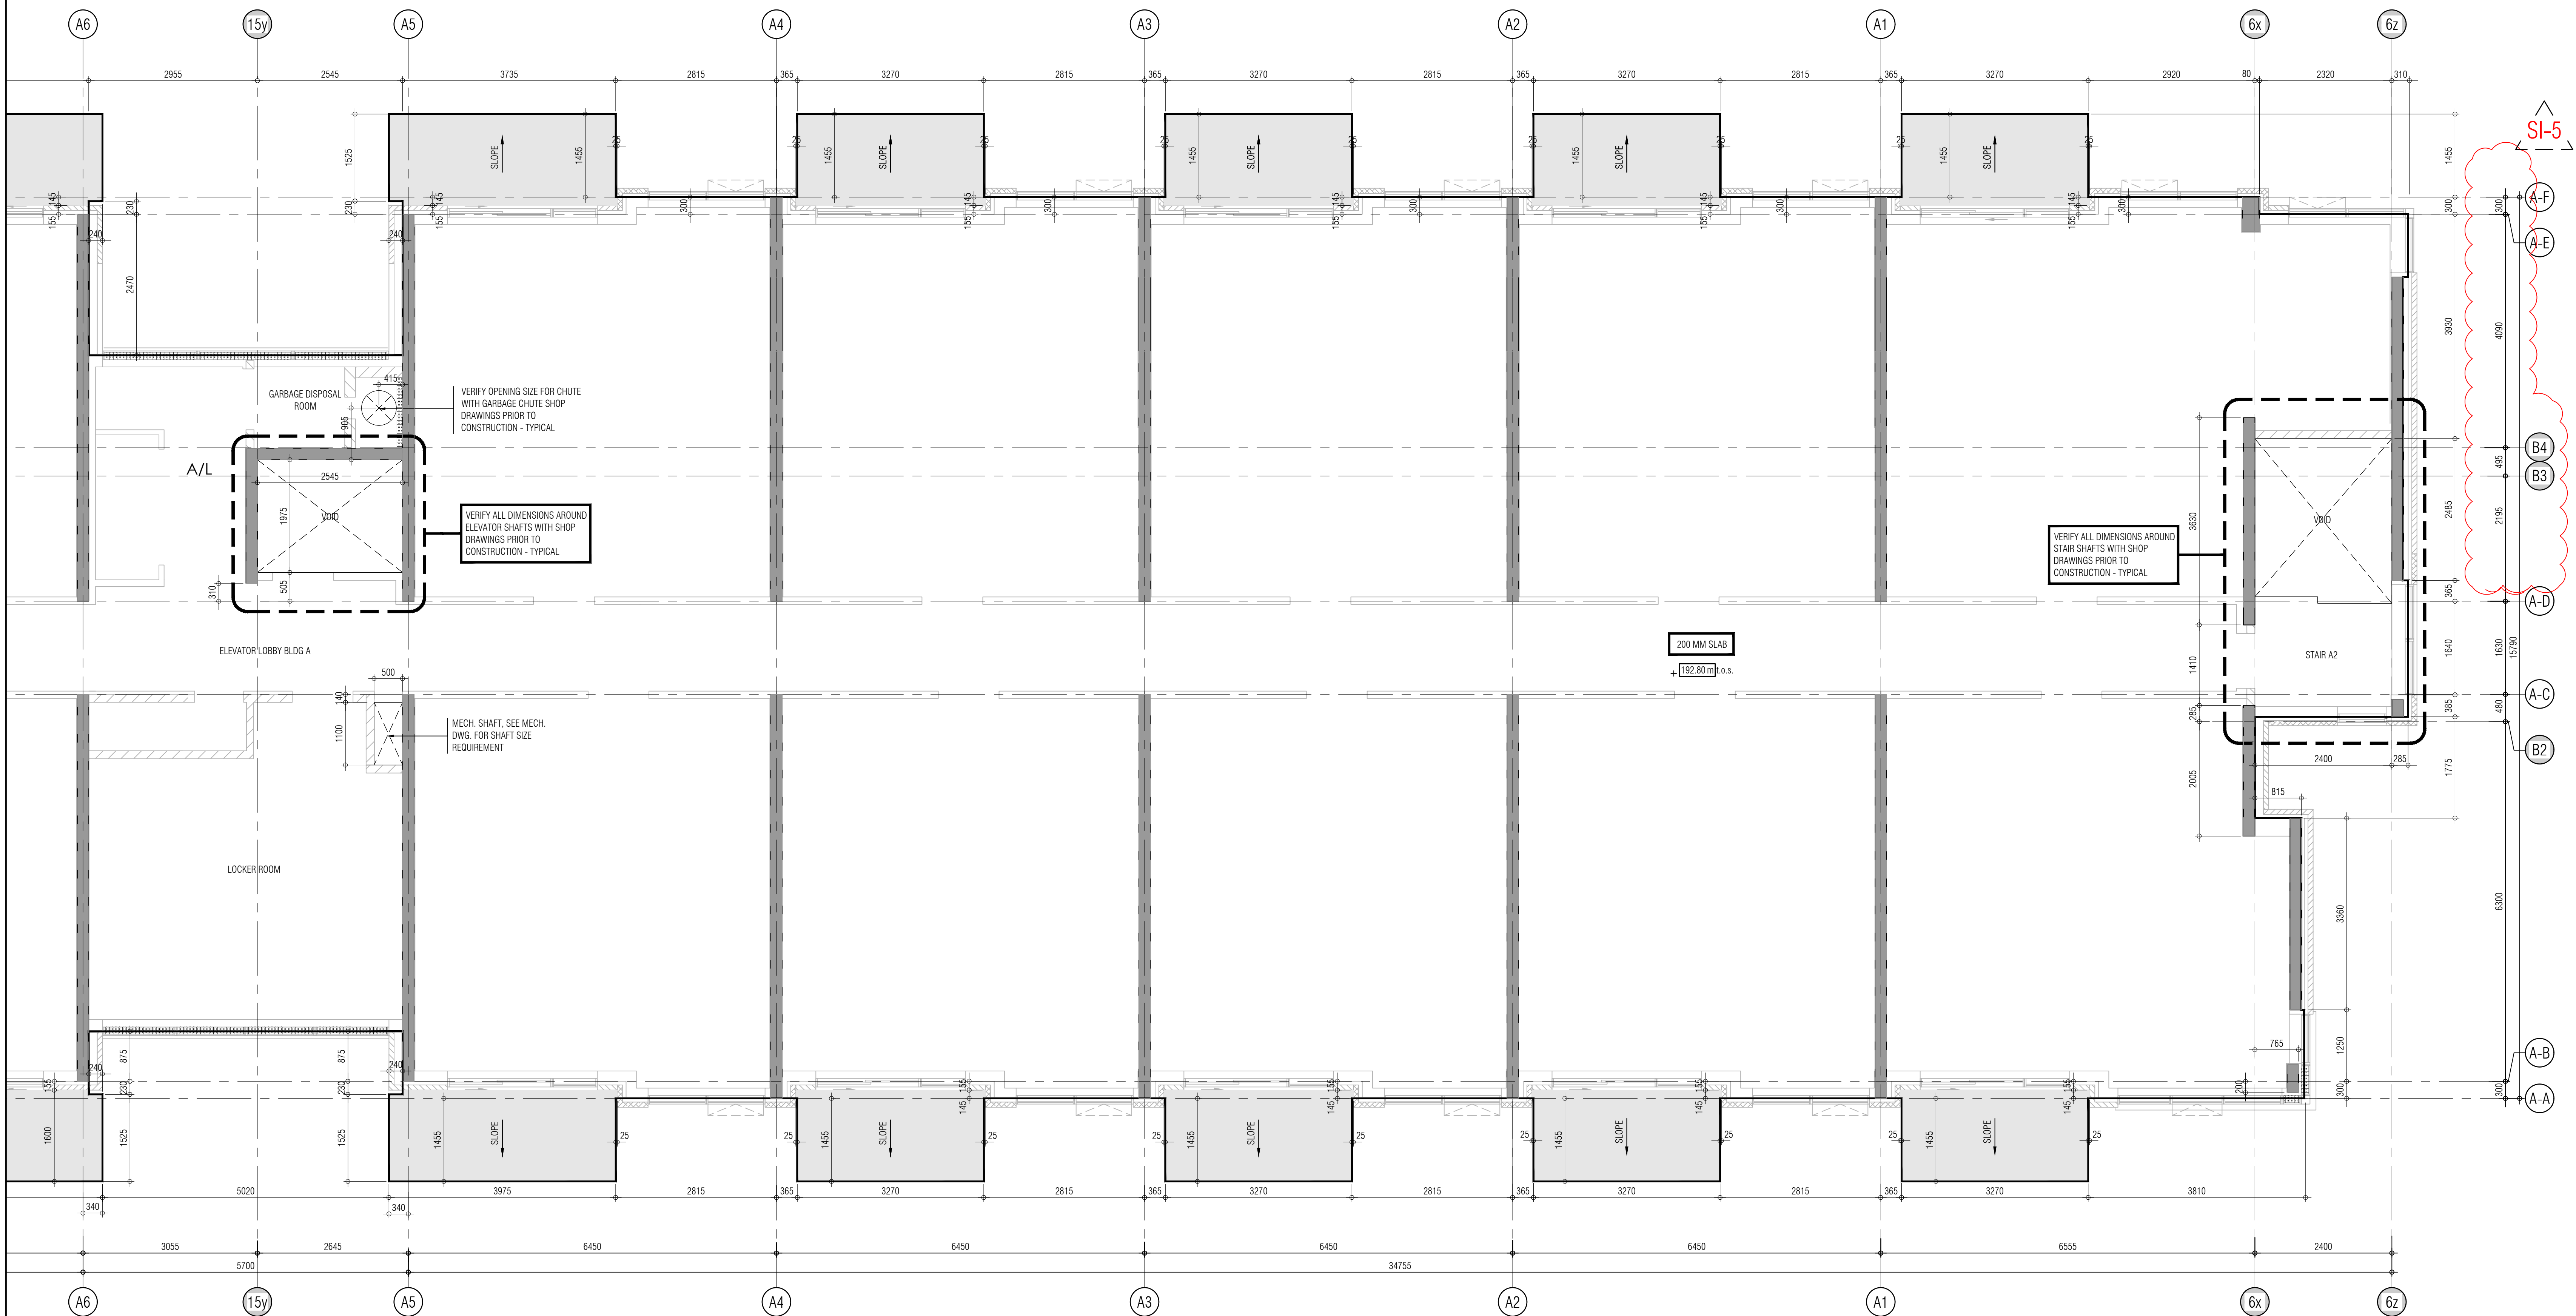

THIS DRAWING IS AN INSTRUMENT OF SERVICE, IT IS PROVIDED BY AND IS THE PROPERTY OF GRAZIANI-CORAZZA ARCHITECTS INC. THE CONTRACTOR MUST STAFF AND ACCEPT RESPONSIBILITY FOR ALL DIMENSIONS AND COORDINATIONS AND MUST NOTIFY GRAZIANI-CORAZZA ARCHITECTS INC. OF ANY OMISSIONS OR ERRORS IN THE SUPPLIED INFORMATION. GRAZIANI-CORAZZA ARCHITECTS INC. IS NOT RESPONSIBLE FOR THE ACCURACY OF SURVEY, STRUCTURAL, MECHANICAL, ELECTRICAL AND OTHER ENGINEERING INFORMATION SHOWN ON THIS DRAWING. REFER TO THE APPROPRIATE ENGINEERING DRAWINGS BEFORE PROCEEDING WITH THE WORK. CONSTRUCTION MUST COMPLY TO ALL APPLICABLE CODES AND REQUIREMENTS OF THE AUTHORITIES HAVING JURISDICTION, UNLESS OTHERWISE NOTED. NO MODIFICATION AND/OR ADDITIONS TO BE REPORTED IN BY THIS OFFICE IN REGARDS TO THE ENVIRONMENTAL CONDITION OF THIS SITE.

THIS DRAWING IS NOT TO BE SCALED. ALL ARCHITECTURAL DIMENSIONS INDICATED ON THIS DRAWING ARE GRAPHIC REPRESENTATIONS ONLY.

CONDITIONS FOR ELECTRONIC INFORMATION TRANSFER

ELECTRONIC INFORMATION IS SUPPLIED TO THE OTHER ASSOCIATED FIRMS TO ASSIST THEM IN THE EXECUTION OF THEIR WORK. REVIEW THE RECIPIENT FIRMS MUST DETERMINE THE COMPLETENESS, APPROPRIATENESS, RELIANCE OF THE INFORMATION IN RESPECT TO THEIR PARTICULAR RESPONSIBILITY.

GRAZIANI-CORAZZA ARCHITECTS INC. SHALL NOT BE RESPONSIBLE FOR ERRORS, OMISSIONS, INCOMPLETENESS DUE TO LOSS OF INFORMATION IN WHOLE OR PART WHEN INFORMATION IS TRANSMITTED.

1. TRANSMISSION OF ANY LOSS OF DAMAGE TO THE RECEIVING ELECTRONIC SYSTEM WHEN INFORMATION IS TRANSMITTED.

- 01. Oct.07.2019 issued for tender
- 02. Mar.13.2020 issued for design coordination #2
- 03. Mar.16.2020 issued for addendum #2
- 04. Mar.16.2020 issued for addendum #3
- 05. Aug.24.2020 issued for addendum #4
- 06. Sept. 28.2020 issued for permit
- 07. Oct.20.2020 issued for addendum #5
- 08. Nov.23.2020 issued for addendum #6
- 09. Dec.14.2020 issued for addendum #7
- 10. Jan.15.2021 issued for addendum #8
- 11. Mar. 2. 2021 issued for permit
- 12. Mar.09.2021 issued for addendum #9
- 13. Mar.10.2021 issued for addendum #9R
- 14. Mar.26.2021 issued for progress
- 15. May.14.2021 issued for Site Instruction #1
- 16. June.15.2021 issued for Site Instruction #2
- 17. July. 7. 2021 re-issued for permit
- 18. July. 15. 2021 issued for Site Instruction #3
- 19. July. 27. 2021 issued for Site Instruction #4
- 20. Aug. 3. 2021 issued for Site Instruction #5

- 01. SEP.18.2021 issued for addendum 1
- issued for revisions

GRAZIANI CORAZZA ARCHITECTS

1320 SHAWANIGAN DRIVE, SUITE 100 MISSISSAUGA, ONTARIO L4W 1C3
905.709.7001 P.905.709.7000 WWW.GC-ARCHITECTS.COM

RESIDENTIAL

ATTMOR + PALLESCHI DRIVE

BRAMPTON ONTARIO

PROJECT ARCHITECT: B. GRAZIANI
ASSISTANT DESIGNER: R. LINCOLN
DRAWN BY: G.C./F.C./M.B.
CHECKED BY: D. BIASE/G. COLANGELO
PLOT DATE: AUG.03.2021
JOB #: 1331.15

CONCRETE SLAB EDGE 3RD FLOOR
BUILDING A (PARTIAL PLAN)

1:50 CS303a2

TITLEBLOCK SIZE: 915 x 1200

THIS DRAWING, AS AN INSTRUMENT OF SERVICE, IS PROVIDED BY AND IS THE PROPERTY OF GRAZIANI-CORAZZA ARCHITECTS INC. THE CONTRACTOR MUST VERIFY AND ACCEPT RESPONSIBILITY FOR ALL DIMENSIONS AND COORDINATE THE SITE AND MUST NOTIFY GRAZIANI-CORAZZA ARCHITECTS INC. OF ANY DISCREPANCIES FROM THE SUPPLIED INFORMATION. GRAZIANI-CORAZZA ARCHITECTS INC. IS NOT RESPONSIBLE FOR THE ACCURACY OF SURVEY, STRUCTURAL, MECHANICAL, ELECTRICAL, AND OTHER ENGINEERING INFORMATION SHOWN ON THIS DRAWING. REFER TO THE APPROPRIATE ENGINEERING DRAWINGS BEFORE PROCEEDING WITH THE WORK. CONSTRUCTION MUST CONFORM TO ALL APPLICABLE CODES AND REQUIREMENTS OF THE AUTHORITY HAVING JURISDICTION, UNLESS OTHERWISE NOTED. NO MODIFICATION AND/OR ADDITIONS TO BE REPORTED TO THE OFFICE IN REGARDS TO THE ENVIRONMENTAL CONDITION OF THIS SITE.

THIS DRAWING IS NOT TO BE SCALED. ALL ARCHITECTURAL SYMBOLS INDICATED ON THIS DRAWING ARE GRAPHIC REPRESENTATIONS ONLY.

CONDITIONS FOR ELECTRONIC INFORMATION TRANSFER

ELECTRONIC INFORMATION IS SUPPLIED TO THE OTHER ASSOCIATED FIRMS TO ASSIST THEM IN THE EXECUTION OF THEIR WORK. REVIEW THE RECEIVED FIRMS MUST DETERMINE THE COMPLETENESS, APPROPRIATENESS, RELIANCE OF THE INFORMATION IN RESPECT TO THEIR PARTICULAR RESPONSIBILITY.

GRAZIANI-CORAZZA ARCHITECTS INC. SHALL NOT BE RESPONSIBLE FOR ERRORS, OMISSIONS, INCOMPLETENESS DUE TO LOSS OF INFORMATION IN WHOLE OR PART WHEN INFORMATION IS TRANSFERRED.

1. TRANSMISSION OF ANY LOSS OF DAMAGE TO THE RECEIVING ELECTRONIC SYSTEM WHEN INFORMATION IS TRANSFERRED.

01. Oct.07.2019 issued for tender
02. Mar.13.2020 issued for design coordination #2
03. Mar.16.2020 issued for addendum #2
04. Mar.16.2020 issued for addendum #3
05. Aug.24.2020 issued for addendum #4
06. Sept.28.2020 issued for permit
07. Oct.20.2020 issued for addendum #5
08. Nov.23.2020 issued for addendum #6
09. Dec.14.2020 issued for addendum #7
10. Jan.15.2021 issued for addendum #8
11. Mar.2.2021 issued for permit
12. Mar.09.2021 issued for addendum #9
13. Mar.10.2021 issued for addendum #9R
14. Mar.26.2021 issued for progress
15. May.14.2021 issued for Site Instruction #1
16. June.15.2021 issued for Site Instruction #2
17. July.7.2021 re-issued for permit
18. July.15.2021 issued for Site Instruction #3
19. July.27.2021 issued for Site Instruction #4
20. Aug.3.2021 issued for Site Instruction #5

01. Apr.19.2021 issued to client
- issued for revisions



1320 SHEARBRIDGE DRIVE, SUITE 100 MISSISSAUGA, ONTARIO L4W 1C3
905.709.7001 P.905.709.7000 WWW.GC-ARCHITECTS.COM

RESIDENTIAL



ATTMAAR + PALLESCHI DRIVE

BRAMPTON ONTARIO

PROJECT ARCHITECT: B.GRAZIANI

ASSISTANT DESIGNER: R.LINCOLN

DRAWN BY: G.C./F.C./M.B.

CHECKED BY: D.BIASSE/G.COLANGELO

PILOT DATE: AUG.03.2021





JOB # 1331.15

CONCRETE SLAB EDGE

4TH OVERALL PLAN

1:150 CS304

TITLEBLOCK SIZE: 915 x 1200

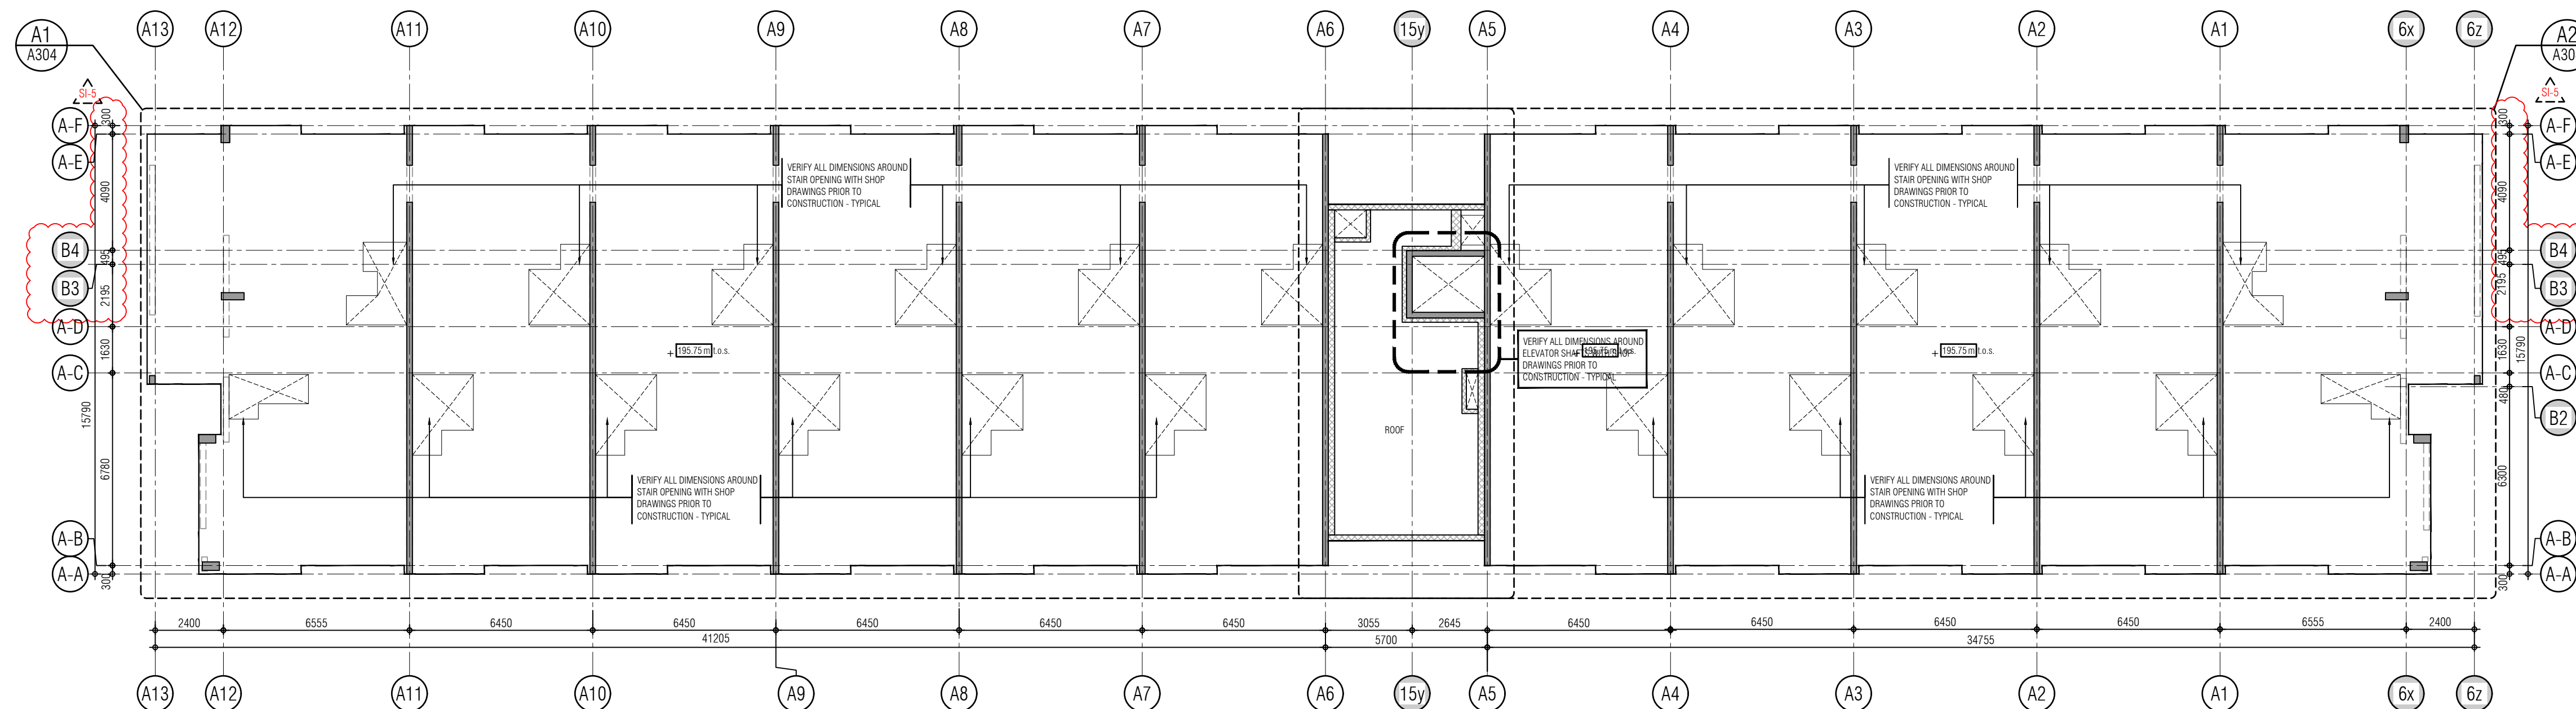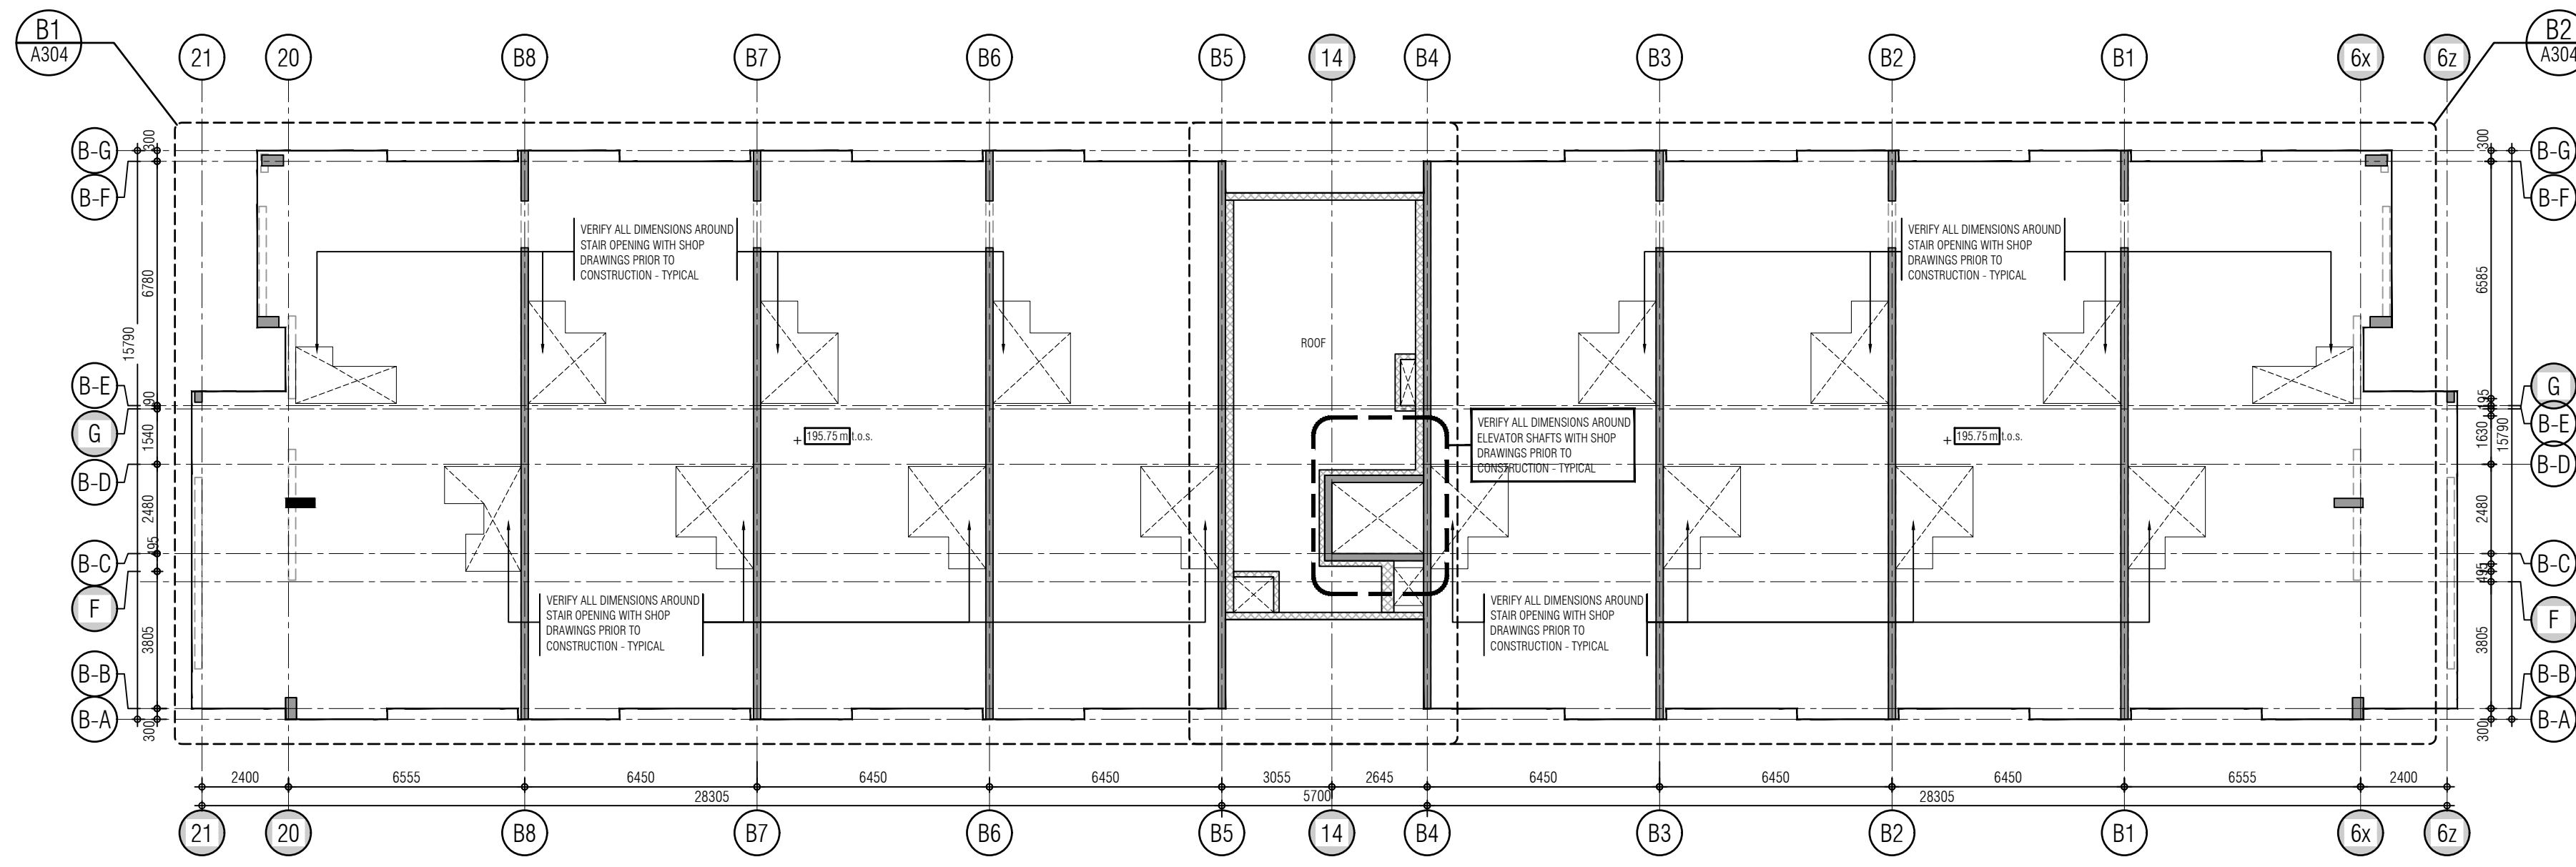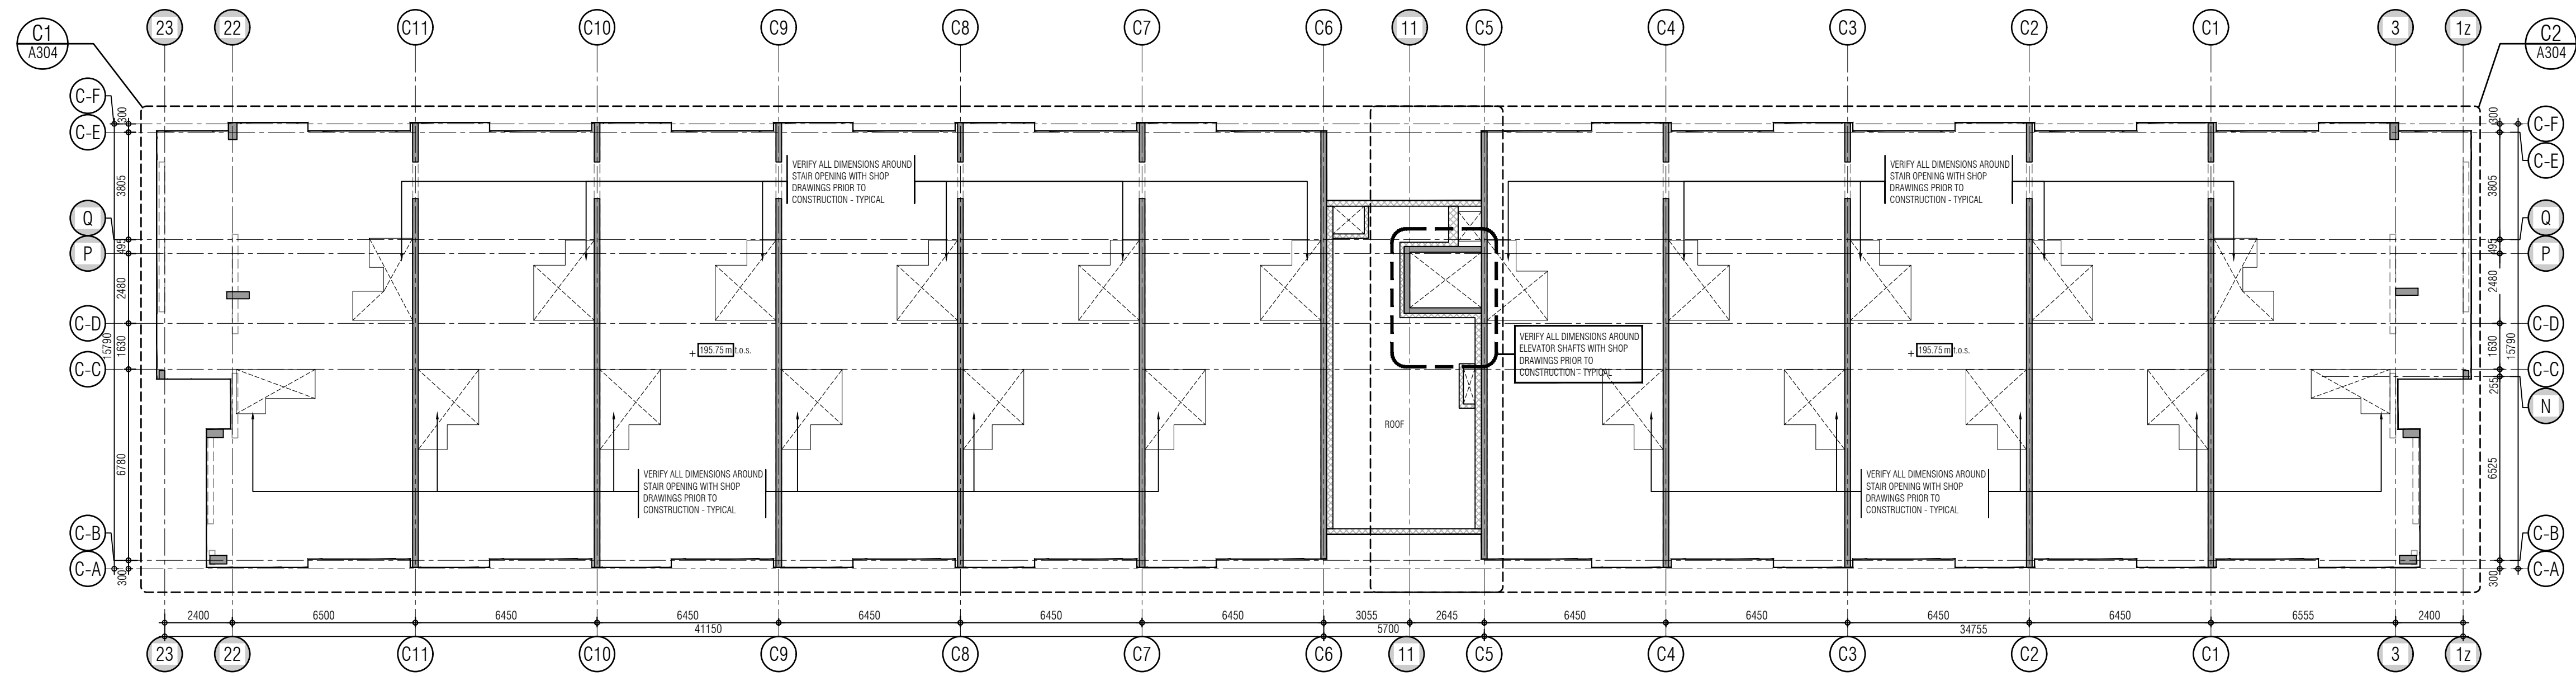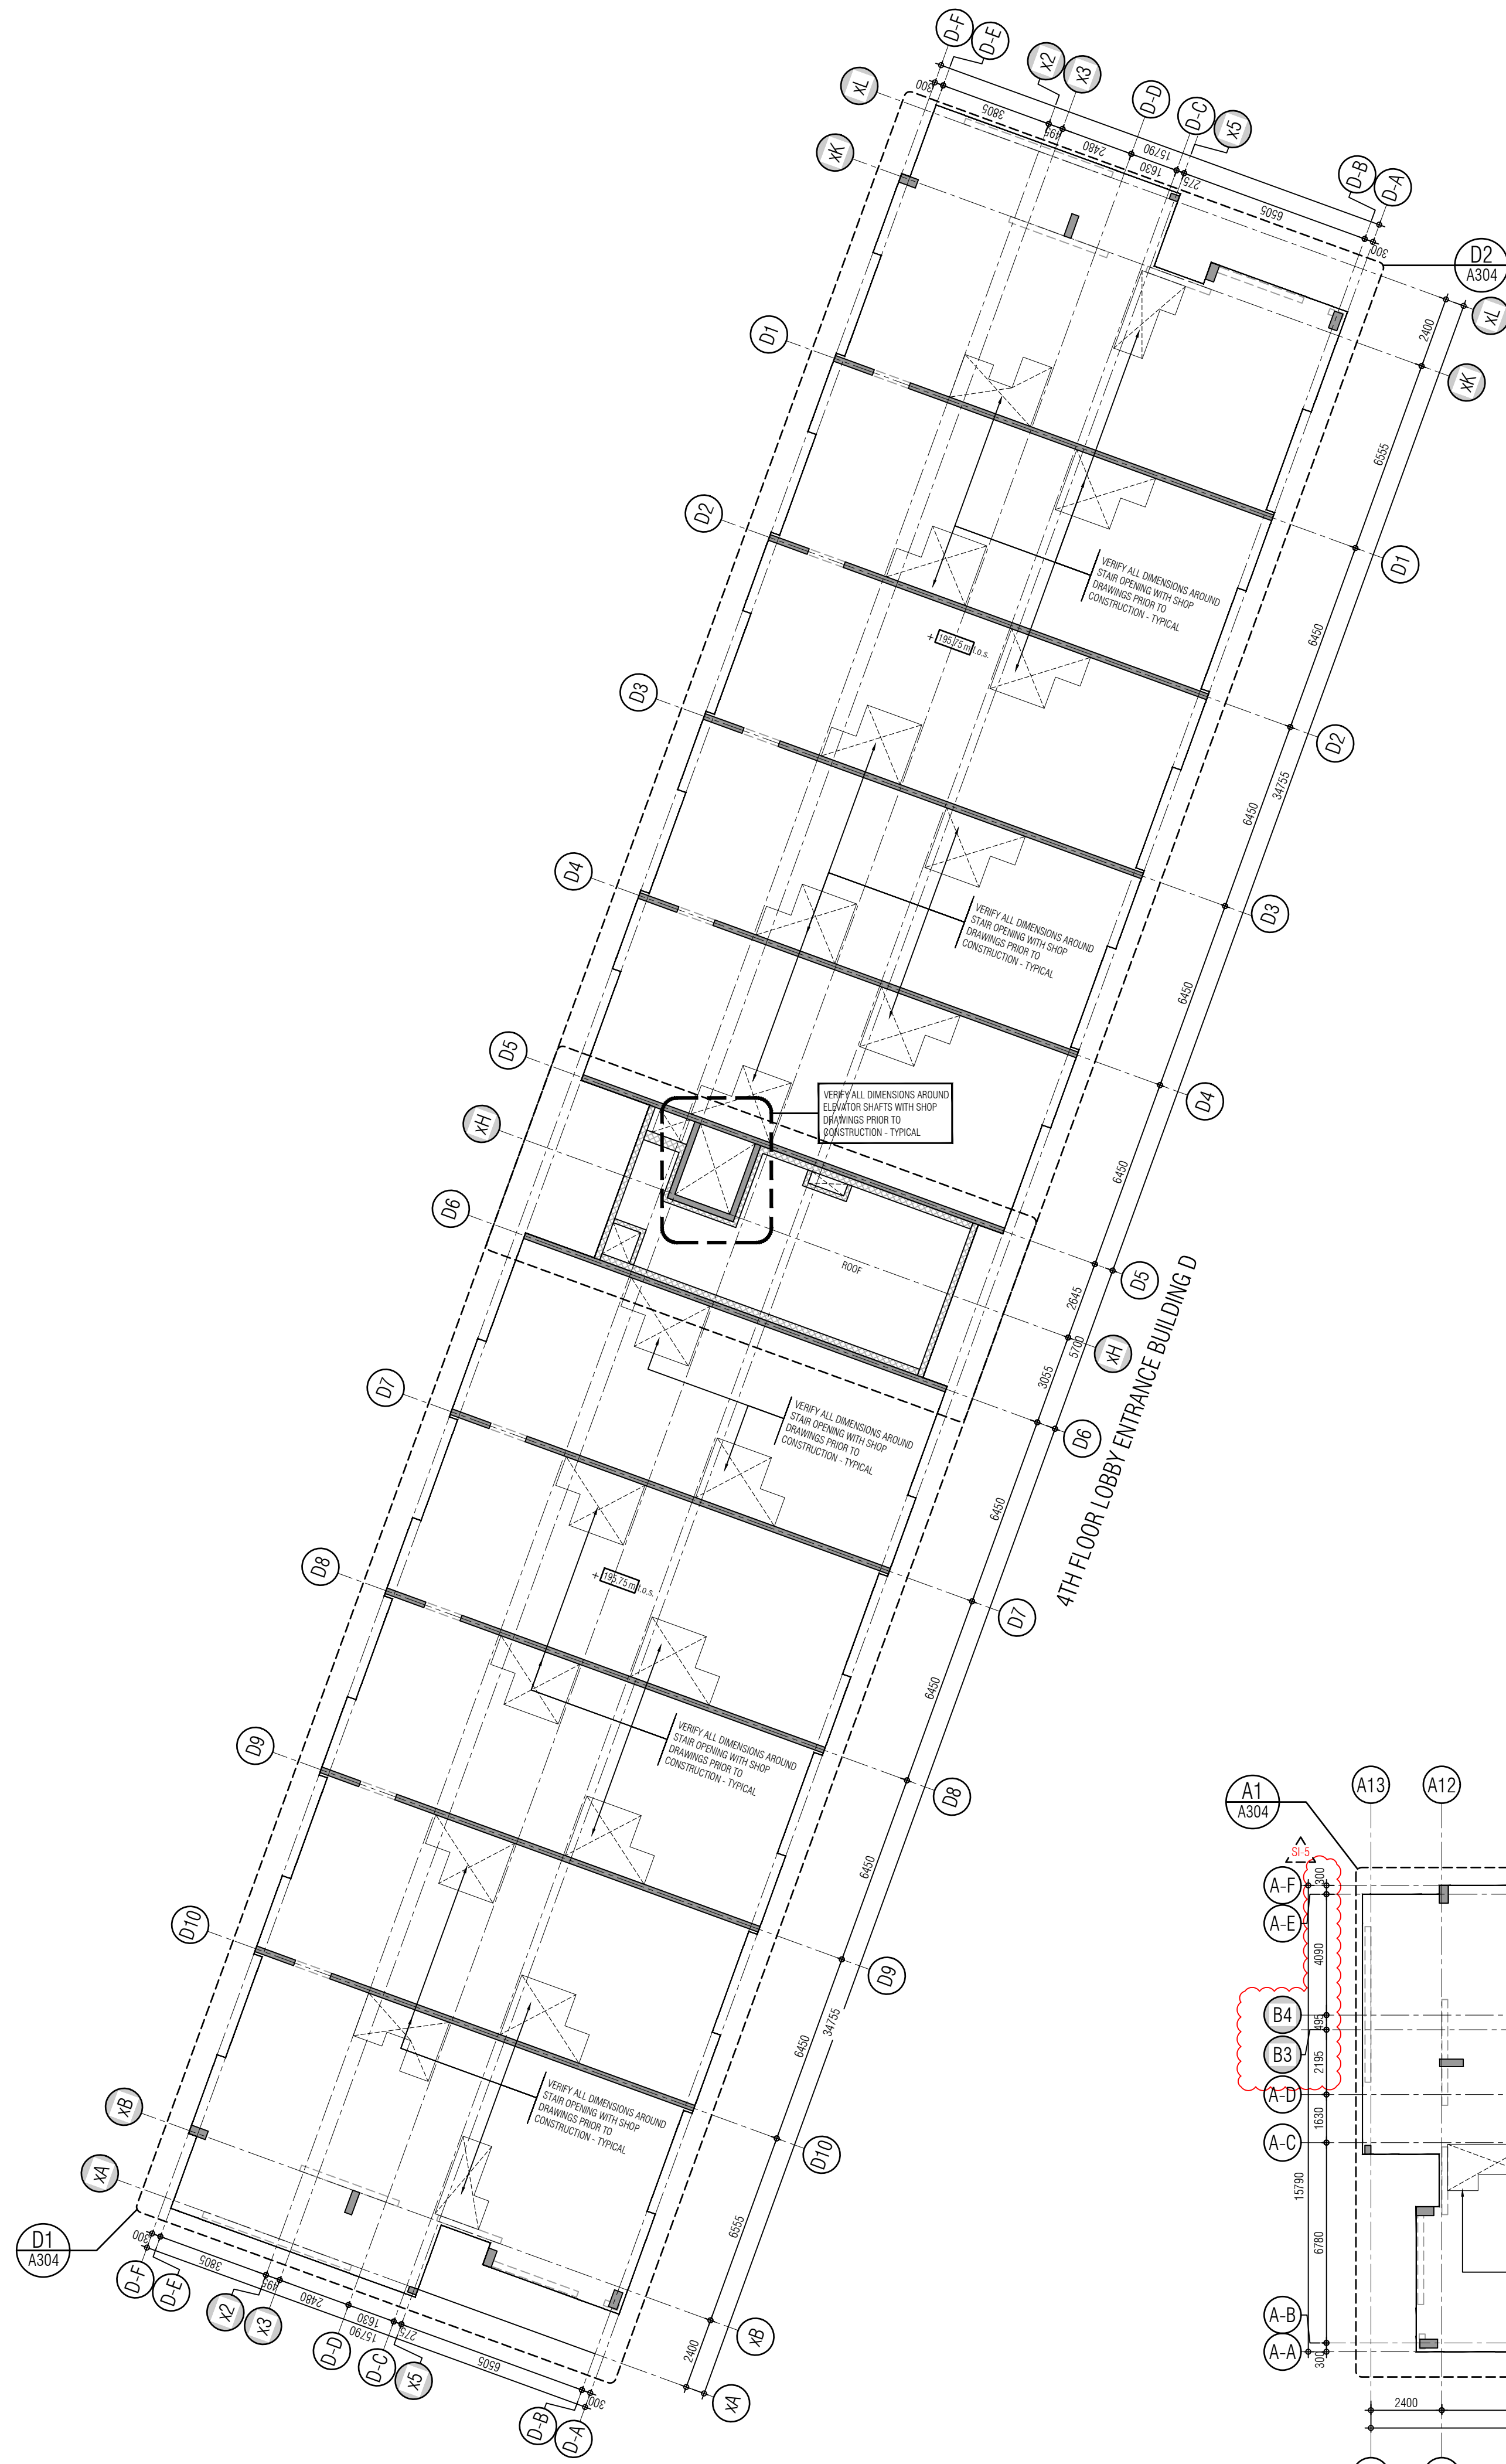

4TH FLOOR LOBBY ENTRANCE BUILDING A

4TH FLOOR LOBBY ENTRANCE BUILDING C

4TH FLOOR LOBBY ENTRANCE BUILDING B

4TH FLOOR LOBBY ENTRANCE BUILDING D

THIS DRAWING IS NOT TO BE SCALED. ALL ARCHITECTURAL SYMBOLS INDICATED ON THIS DRAWING ARE GRAPHIC REPRESENTATIONS ONLY.


CONDITIONS FOR ELECTRONIC INFORMATION TRANSFER

ELECTRONIC INFORMATION IS SUPPLIED TO THE OTHER ASSOCIATED FIRMS TO ASSIST THEM IN THE EXECUTION OF THEIR WORK; HOWEVER, THE RECIPIENT FIRMS MUST DEFEND THE COMPLETENESS, APPROPRIATENESS, RELEVANCE OF THE INFORMATION IN RESPECT TO THEIR PARTICULAR RESPONSIBILITY.

GRADUATE - GRADUATE ARCHITECTS INC. SHALL NOT BE RESPONSIBLE FOR:

1. ERRORS, OMISSIONS, INADEQUATENESS DUE TO LOSS OF INFORMATION IN WHOLE OR PART WHEN INFORMATION IS TRANSFERRED;
2. TRANSMISSION OF ANY VIRUS OR DAMAGE TO THE RECEIVING ELECTRONIC SYSTEM WHEN INFORMATION IS TRANSFERRED.

21	Oct 07 2020	Issued for tender	
22	Mar 13 2020	Issued for design coordination #2	
23	Mar 16 2020	Issued for addendum #2	
24	Mar 16 2020	Issued for addendum #3	
25	Aug 24 2020	Issued for addendum #4	
26	Sept. 28 2020	Issued for permit	bg
27	Oct 20 2020	Issued for addendum #5	
28	Nov 23 2020	Issued for addendum #6	
29	Dec 14 2020	Issued for addendum #7	
30	Jan 11 2021	Issued for addendum #8	
31	Mar 2 2021	Issued for permit	bg
32	Mar 09 2021	Issued for addendum #9	
33	Mar 16 2021	Issued for addendum #9R	
34	Mar 26 2021	Issued for progress	
35	May 14 2021	Issued for Site Instruction #1	
36	June 15 2021	Issued for Site Instruction #2	
37	July 7 2021	Re-issued for permit	
38	July 15 2021	Issued for Site Instruction #3	bg
39	July 27 2021	Issued for Site Instruction #4	
40	Aug 3 2021	Issued for Site Instruction #5	bg

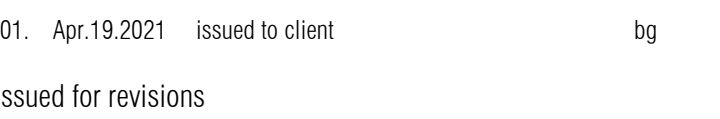

320 SHAWANON DRIVE, SUITE 100 MISSISSAUGA, ONTARIO L4W 1C3
905.795.2001 F.905.795.2844 WWW.GC-ARCHITECTS.COM




PROJECT ARCHITECT:	B. GRAZIANI
ASSISTANT DESIGNER:	R. LINCOLN
DRAWN BY:	G.C./F.C./M.B
CHECKED BY:	D. BIASI/G. COLANGELO
ISSUED DATE:	AUG. 03. 2021
DB #	1331.15

CONCRETE SLAB EDGE 4TH FLOOR
BUILDING A (PARTIAL PLAN)





CS304a1

TTLEBLOCK SIZE: 915 x 1200

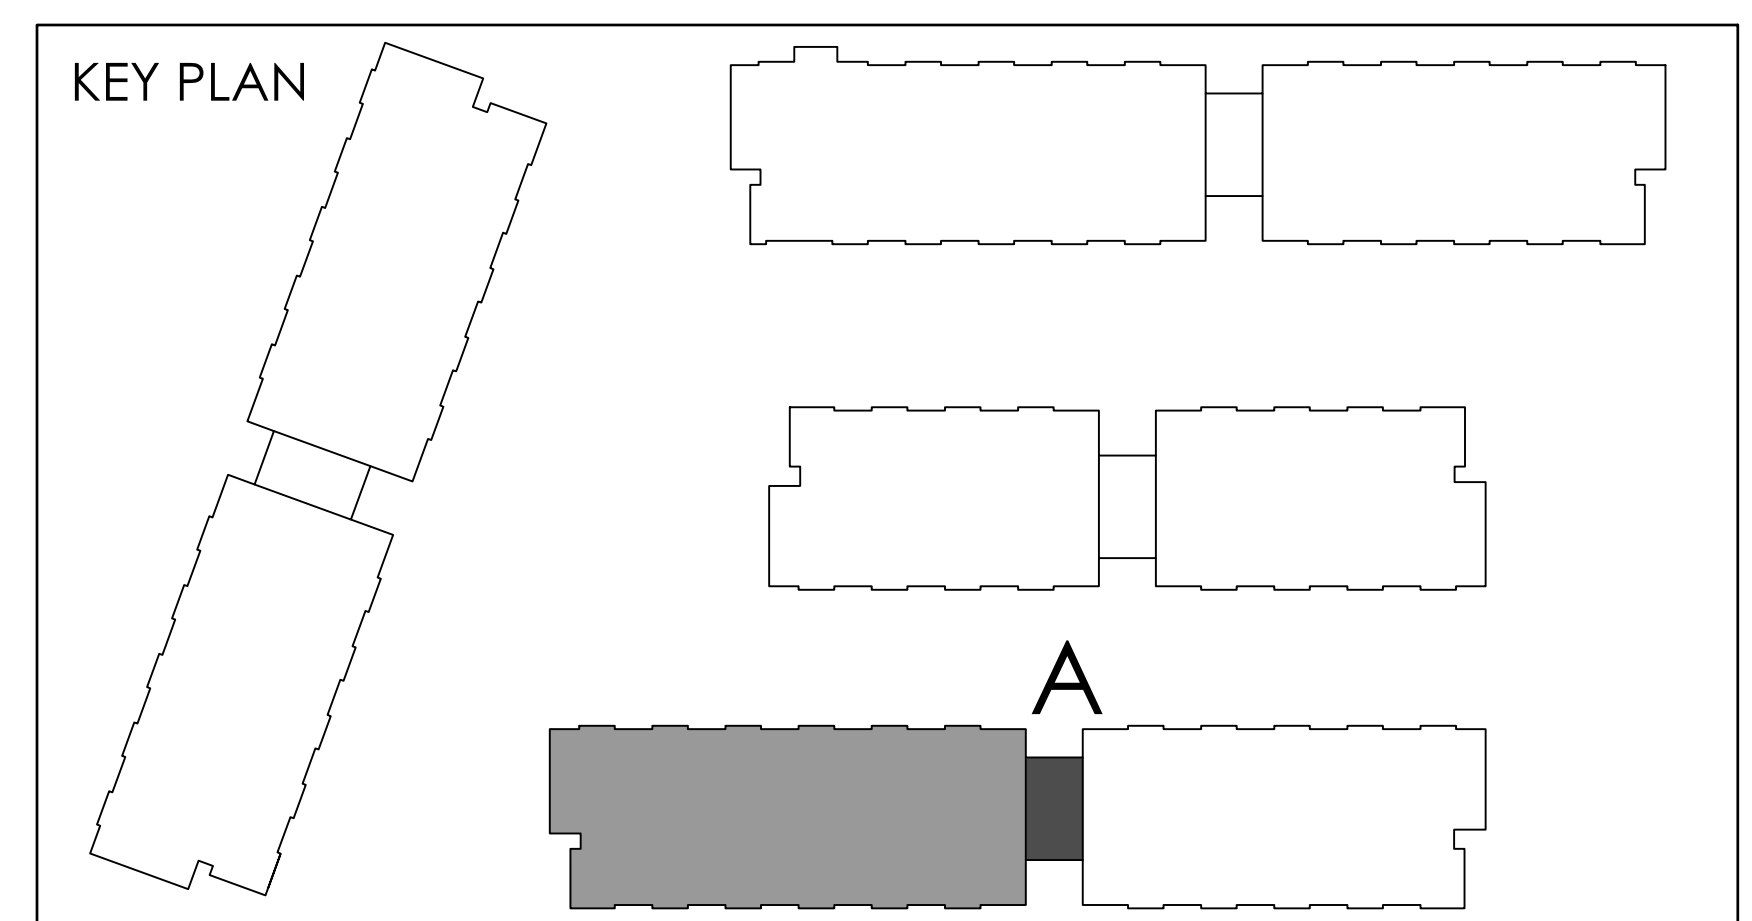

REF.A304a1 FOR CONTINUATION

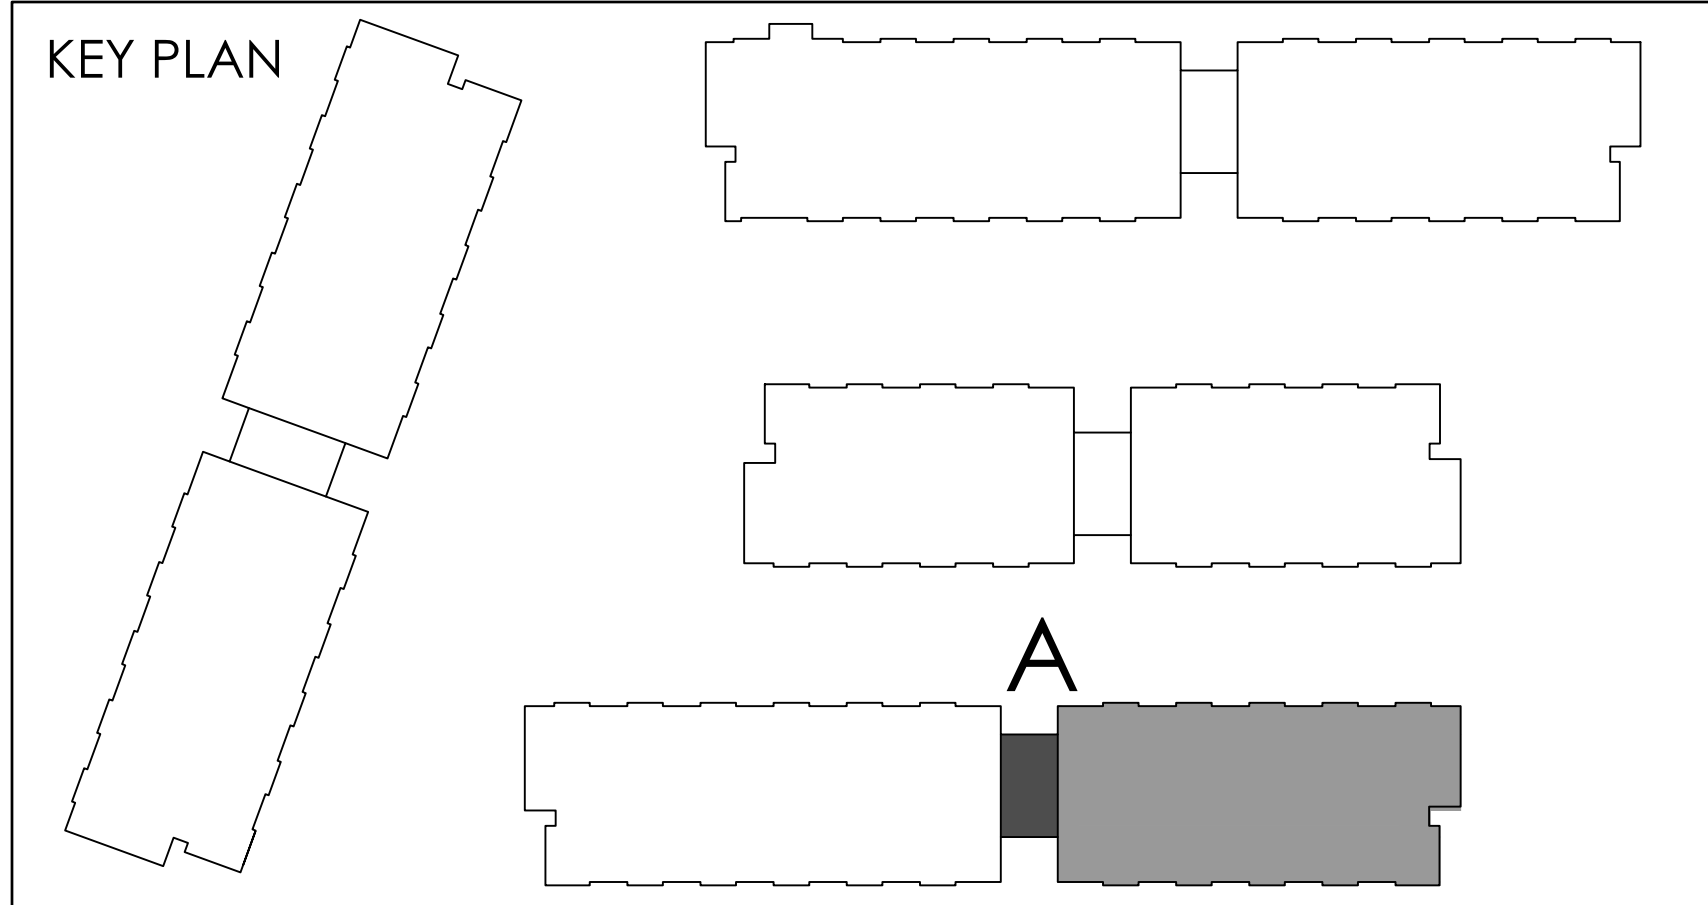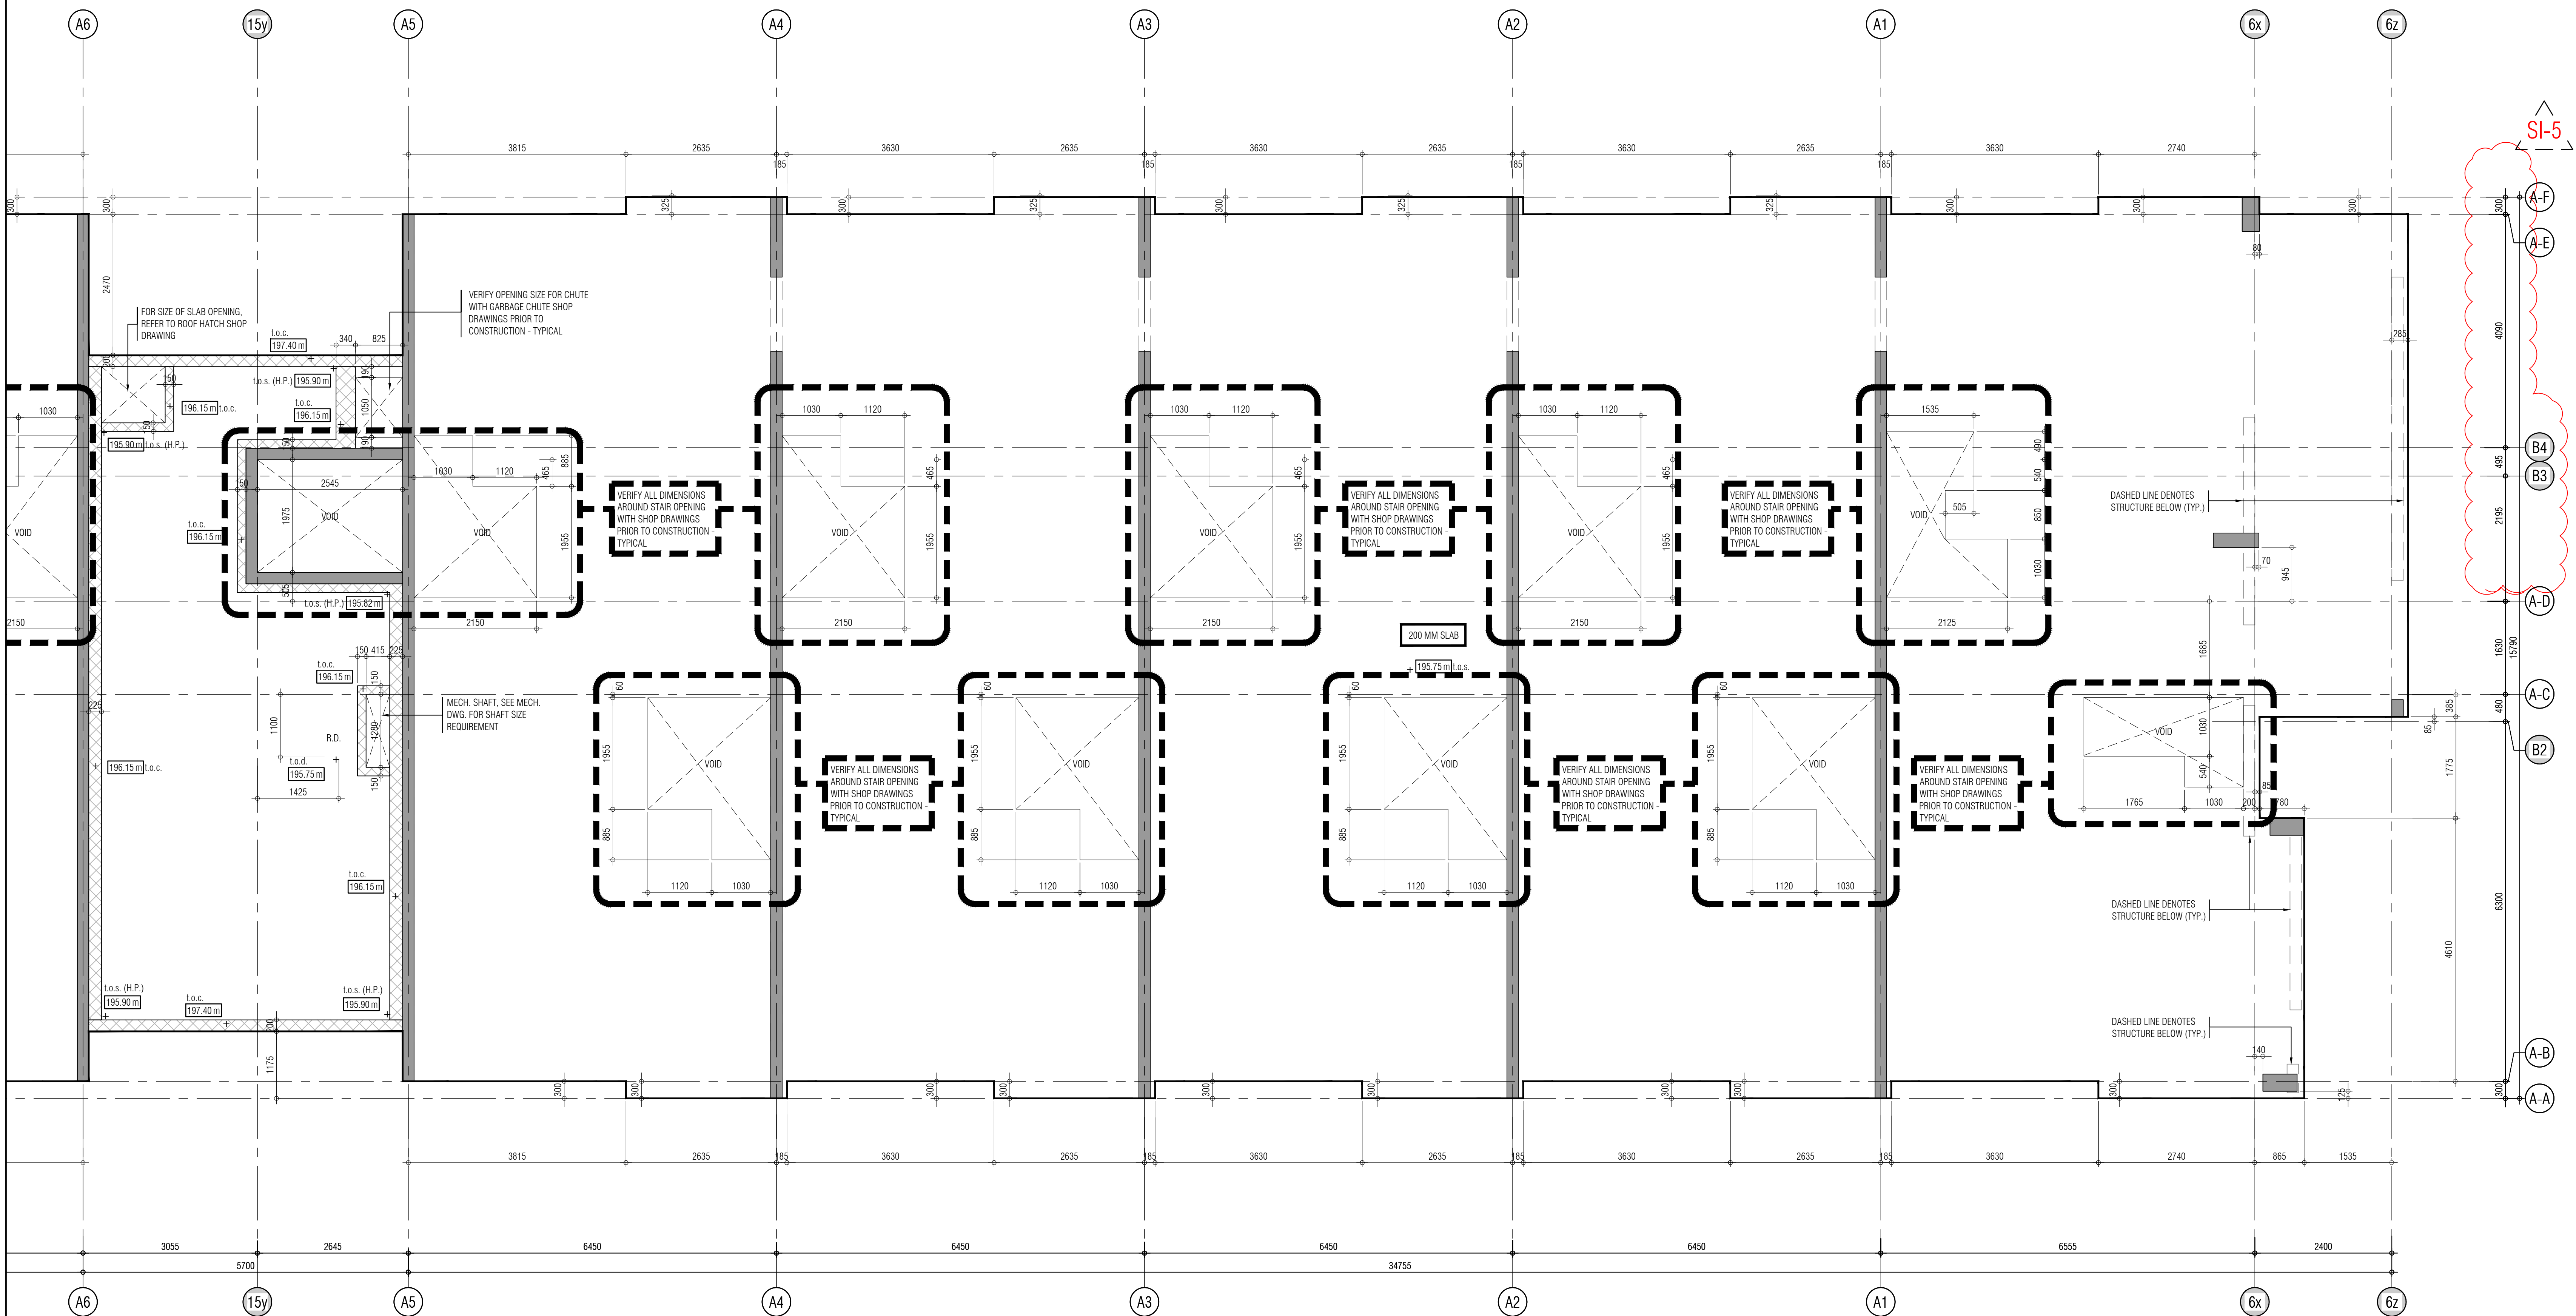

THIS DRAWING IS AN INSTRUMENT OF SERVICE. IT IS PROVIDED BY AND IS THE PROPERTY OF GRAZIANI-CORAZZA ARCHITECTS INC. THE CONTRACTOR MUST VERIFY AND ACCEPT RESPONSIBILITY FOR ALL DIMENSIONS AND COORDINATE THE WORK WITH THE SITE CONDITIONS. GRAZIANI-CORAZZA ARCHITECTS INC. IS NOT RESPONSIBLE FOR THE ACCURACY OF SURVEY, STRUCTURAL, MECHANICAL, ELECTRICAL AND OTHER ENGINEERING INFORMATION SHOWN ON THIS DRAWING. REFER TO THE APPROPRIATE ENGINEERING DRAWINGS BEFORE PROCEEDING WITH THE WORK. CONSTRUCTION MUST COMPLY TO ALL APPLICABLE CODES AND REQUIREMENTS OF THE AUTHORITIES HAVING JURISDICTION. UNLESS OTHERWISE NOTED, NO INVESTIGATION HAS BEEN UNDERTAKEN OR REPORTED ON BY THIS OFFICE IN REGARD TO THE ENVIRONMENTAL CONDITION OF THIS SITE.

THIS DRAWING IS NOT TO BE SCALED. ALL ARCHITECTURAL SYMBOLS INDICATED ON THIS DRAWING ARE GRAPHIC REPRESENTATIONS ONLY.

CONDITIONS FOR ELECTRONIC INFORMATION TRANSFER

ELECTRONIC INFORMATION IS SUPPLIED TO THE OTHER ASSOCIATED FIRMS TO ASSIST THEM IN THE EXECUTION OF THEIR WORK. REVIEW THE RECEIVED FIRMS MUST DETERMINE THE COMPLETENESS, APPROPRIATENESS, RELIANCE OF THE INFORMATION IN RESPECT TO THEIR PARTICULAR RESPONSIBILITY.

GRAZIANI-CORAZZA ARCHITECTS INC. SHALL NOT BE RESPONSIBLE FOR ERROR, OMISSION, INCOMPLETENESS DUE TO LOSS OF INFORMATION IN WHOLE OR PART WHEN INFORMATION IS TRANSFERRED.

1. TRANSMISSION OF ANY LOSS OF DAMAGE TO THE RECEIVING ELECTRONIC SYSTEM WHEN INFORMATION IS TRANSFERRED.

01. Oct.07.2019 issued for tender
02. Mar.13.2020 issued for design coordination #2
03. Mar.16.2020 issued for addendum #2
04. Mar.16.2020 issued for addendum #3
05. Aug.24.2020 issued for addendum #4
06. Sept. 28.2020 issued for permit
07. Oct.20.2020 issued for addendum #5
08. Nov.23.2020 issued for addendum #6
09. Dec.14.2020 issued for addendum #7
10. Jan.15.2021 issued for addendum #8
11. Mar. 2. 2021 issued for permit
12. Mar.09.2021 issued for addendum #9
13. Mar.10.2021 issued for addendum #9R
14. Mar.26.2021 issued for progress
15. May.14.2021 issued for Site Instruction #1
16. June.15.2021 issued for Site Instruction #2
17. July. 7. 2021 re-issued for permit
18. July. 15. 2021 issued for Site Instruction #3
19. July. 27. 2021 issued for Site Instruction #4
20. Aug. 3. 2021 issued for Site Instruction #5

01. Apr.19.2021 issued to client
- issued for revisions



RESIDENTIAL

ATTMAR + PALLESCHI DRIVE

BRAMPTON ONTARIO

PROJECT ARCHITECT: B. GRAZIANI

ASSISTANT DESIGNER: R. LINCOLN

DRAWN BY: G. C./F. C./M. B.

CHECKED BY: D. BIASSE/G. COLANGELO

PLOT DATE: AUG.03.2021

JOB # 1331.15

CONCRETE SLAB EDGE 4TH FLOOR
BUILDING A (PARTIAL PLAN)

1:50 CS304a2

TITLEBLOCK SIZE: 915 x 1200

THIS DRAWING IS AN INSTRUMENT OF SERVICE. IT IS PROVIDED BY AND IS THE PROPERTY OF GRAZIANI-CORAZZA ARCHITECTS INC. THE CONTRACTOR MUST VERIFY AND ACCEPT RESPONSIBILITY FOR ALL DIMENSIONS AND COORDINATE THE SITE AND MUST NOTIFY GRAZIANI-CORAZZA ARCHITECTS INC. OF ANY OMISSIONS FROM THE SUPPLIED INFORMATION. GRAZIANI-CORAZZA ARCHITECTS INC. IS NOT RESPONSIBLE FOR THE ACCURACY OF SURVEY, STRUCTURAL, MECHANICAL, ELECTRICAL AND OTHER ENGINEERING INFORMATION SHOWN ON THIS DRAWING. REFER TO THE APPROPRIATE ENGINEERING DRAWINGS BEFORE PROCEEDING WITH THE WORK. CONSTRUCTION MUST COMPLY TO ALL APPLICABLE CODES AND REQUIREMENTS OF THE AUTHORITY HAVING JURISDICTION. UNLESS OTHERWISE NOTED, NO INVESTIGATION HAS BEEN UNDERTAKEN OR REPORTED ON BY THIS OFFICE IN REGARD TO THE ENVIRONMENTAL CONDITION OF THIS SITE.

THIS DRAWING IS NOT TO BE SCALED. ALL ARCHITECTURAL SYMBOLS INDICATED ON THIS DRAWING ARE GRAPHIC REPRESENTATIONS ONLY.

CONDITIONS FOR ELECTRONIC INFORMATION TRANSFER

ELECTRONIC INFORMATION IS SUPPLIED TO THE OTHER ASSOCIATED FIRMS TO ASSIST THEM IN THE EXECUTION OF THEIR WORK. REVIEW THE RECEIVED FIRMS MUST DETERMINE THE COMPLETENESS, APPROPRIATENESS, RELIANCE OF THE INFORMATION IN RESPECT TO THEIR PARTICULAR RESPONSIBILITY.

GRAZIANI-CORAZZA ARCHITECTS INC. SHALL NOT BE RESPONSIBLE FOR ERROR, OMISSIONS, INCOMPLETENESS DUE TO LOSS OF INFORMATION IN WHOLE OR PART WHEN INFORMATION IS TRANSFERRED.

1. TRANSMISSION OF ANY VIRUS OR DAMAGE TO THE RECEIVING ELECTRONIC SYSTEM WHEN INFORMATION IS TRANSFERRED.

01. Oct.07.2019 issued for tender
02. Mar.13.2020 issued for design coordination #2
03. Mar.16.2020 issued for addendum #2
04. Mar.16.2020 issued for addendum #3
05. Aug.24.2020 issued for addendum #4
06. Sept. 28.2020 issued for permit
07. Oct.20.2020 issued for addendum #5
08. Nov.23.2020 issued for addendum #6
09. Dec.14.2020 issued for addendum #7
10. Jan.18.2021 issued for addendum #8
11. Mar. 2. 2021 issued for permit
12. Mar.09.2021 issued for addendum #9
13. Mar.10.2021 issued for addendum #9R
14. Mar.26.2021 issued for progress
15. May.14.2021 issued for Site Instruction #1
16. June.15.2021 issued for Site Instruction #2
17. July. 7. 2021 re-issued for permit
18. July. 15. 2021 issued for Site Instruction #3
19. July. 27. 2021 issued for Site Instruction #4
20. Aug. 3. 2021 issued for Site Instruction #5

01. Apr.19.2021 issued to client
- issued for revisions



1331 SHARON DRIVE, SUITE 101 MISSISSAUGA, ONTARIO L4W 1C3
905.760.7001 P.905.760.7000 WWW.GC-ARCHITECTS.COM



ATTMAR + PALLESCHI DRIVE

BRAMPTON ONTARIO

PROJECT ARCHITECT: B. GRAZIANI

ASSISTANT DESIGNER: R. LINCOLN


DRAWN BY: G. C./F. C./M.B.

CHECKED BY: D. BIASE/G. COLANGELO

PLLOT DATE: AUG.03.2021

JOB # 1331.15



ROOF OVERALL PLAN
CONCRETE SLAB EDGE

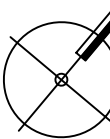


1:150

CS305


TITLEBLOCK SIZE: 915 x 1200

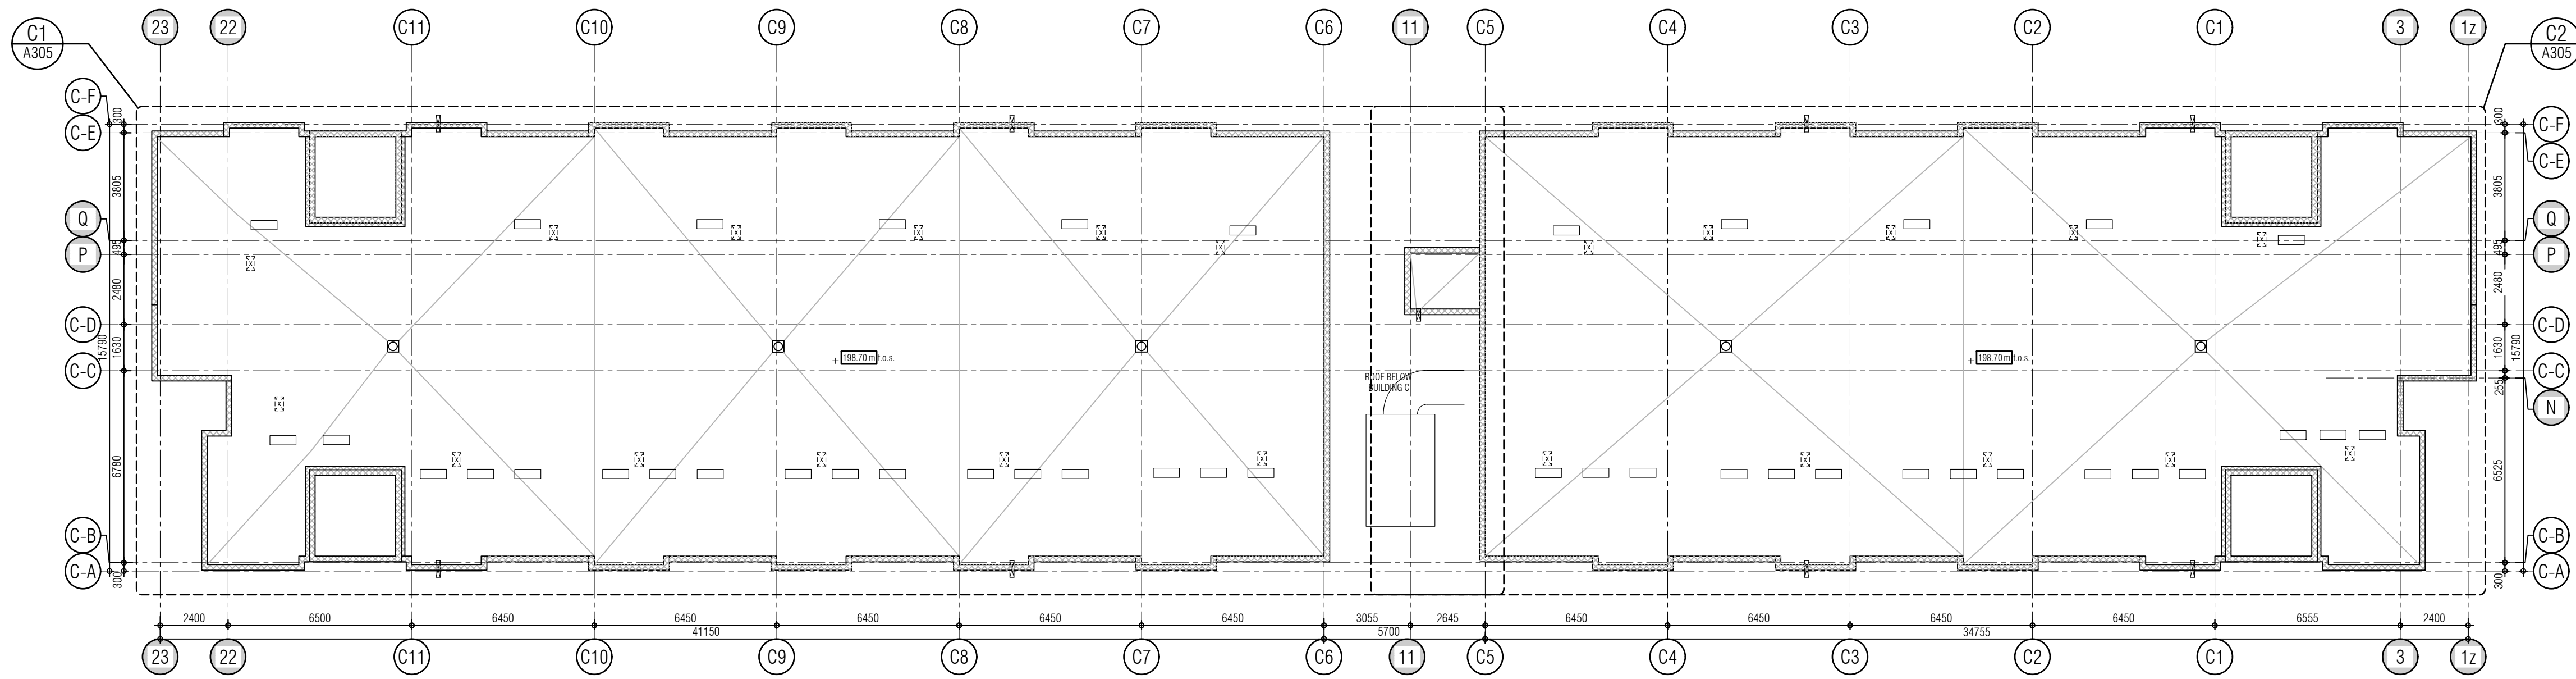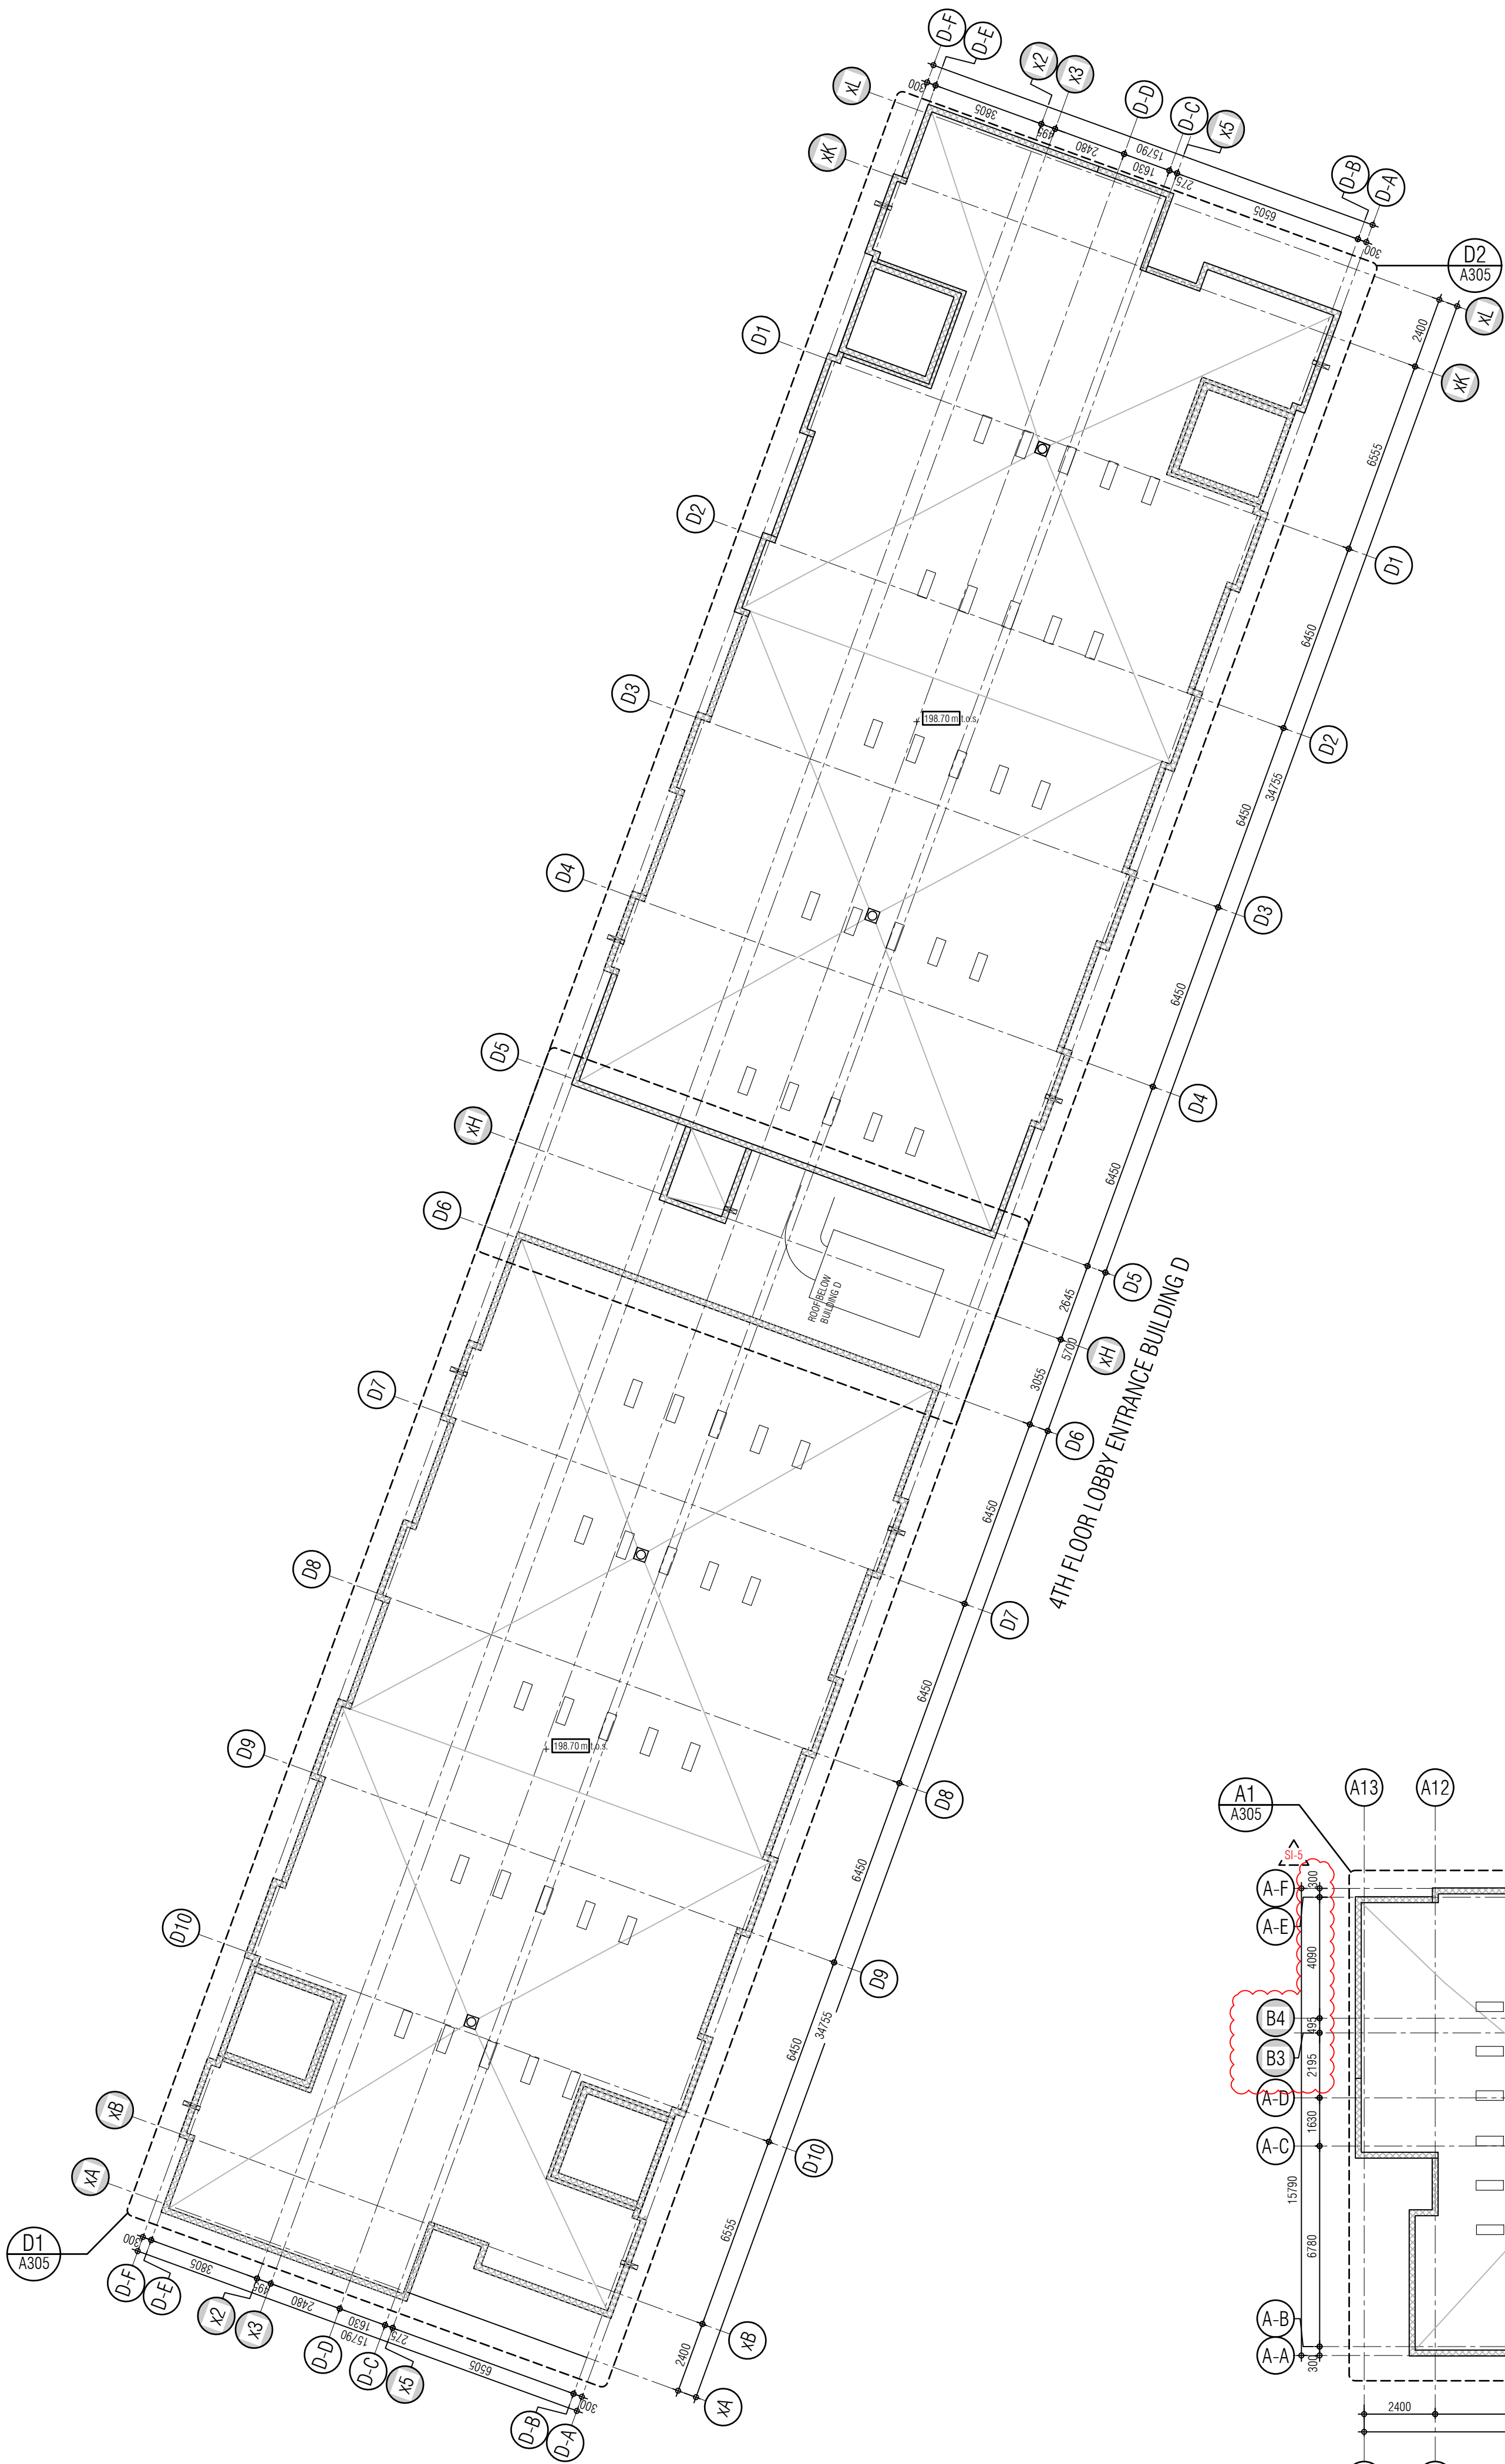

4TH FLOOR LOBBY ENTRANCE BUILDING C

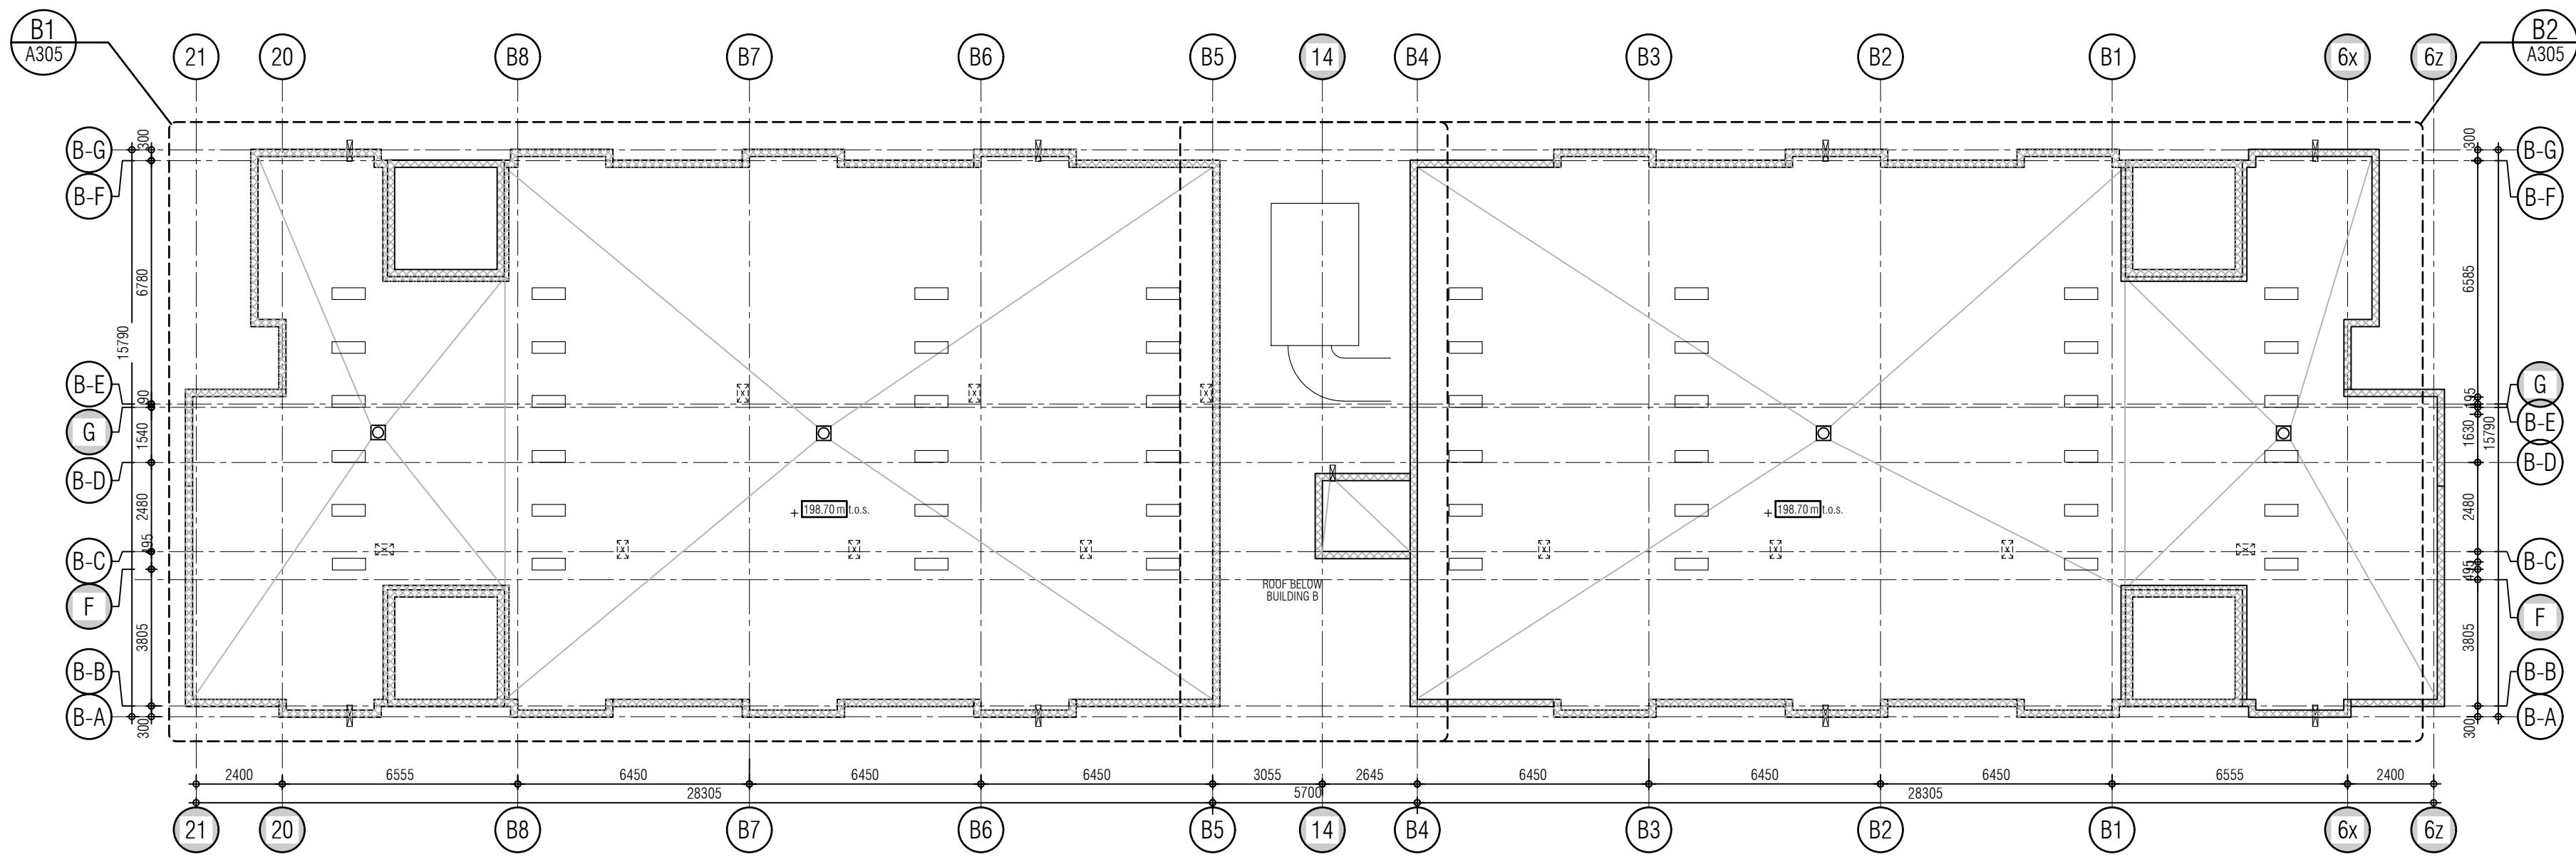

4TH FLOOR LOBBY ENTRANCE BUILDING B

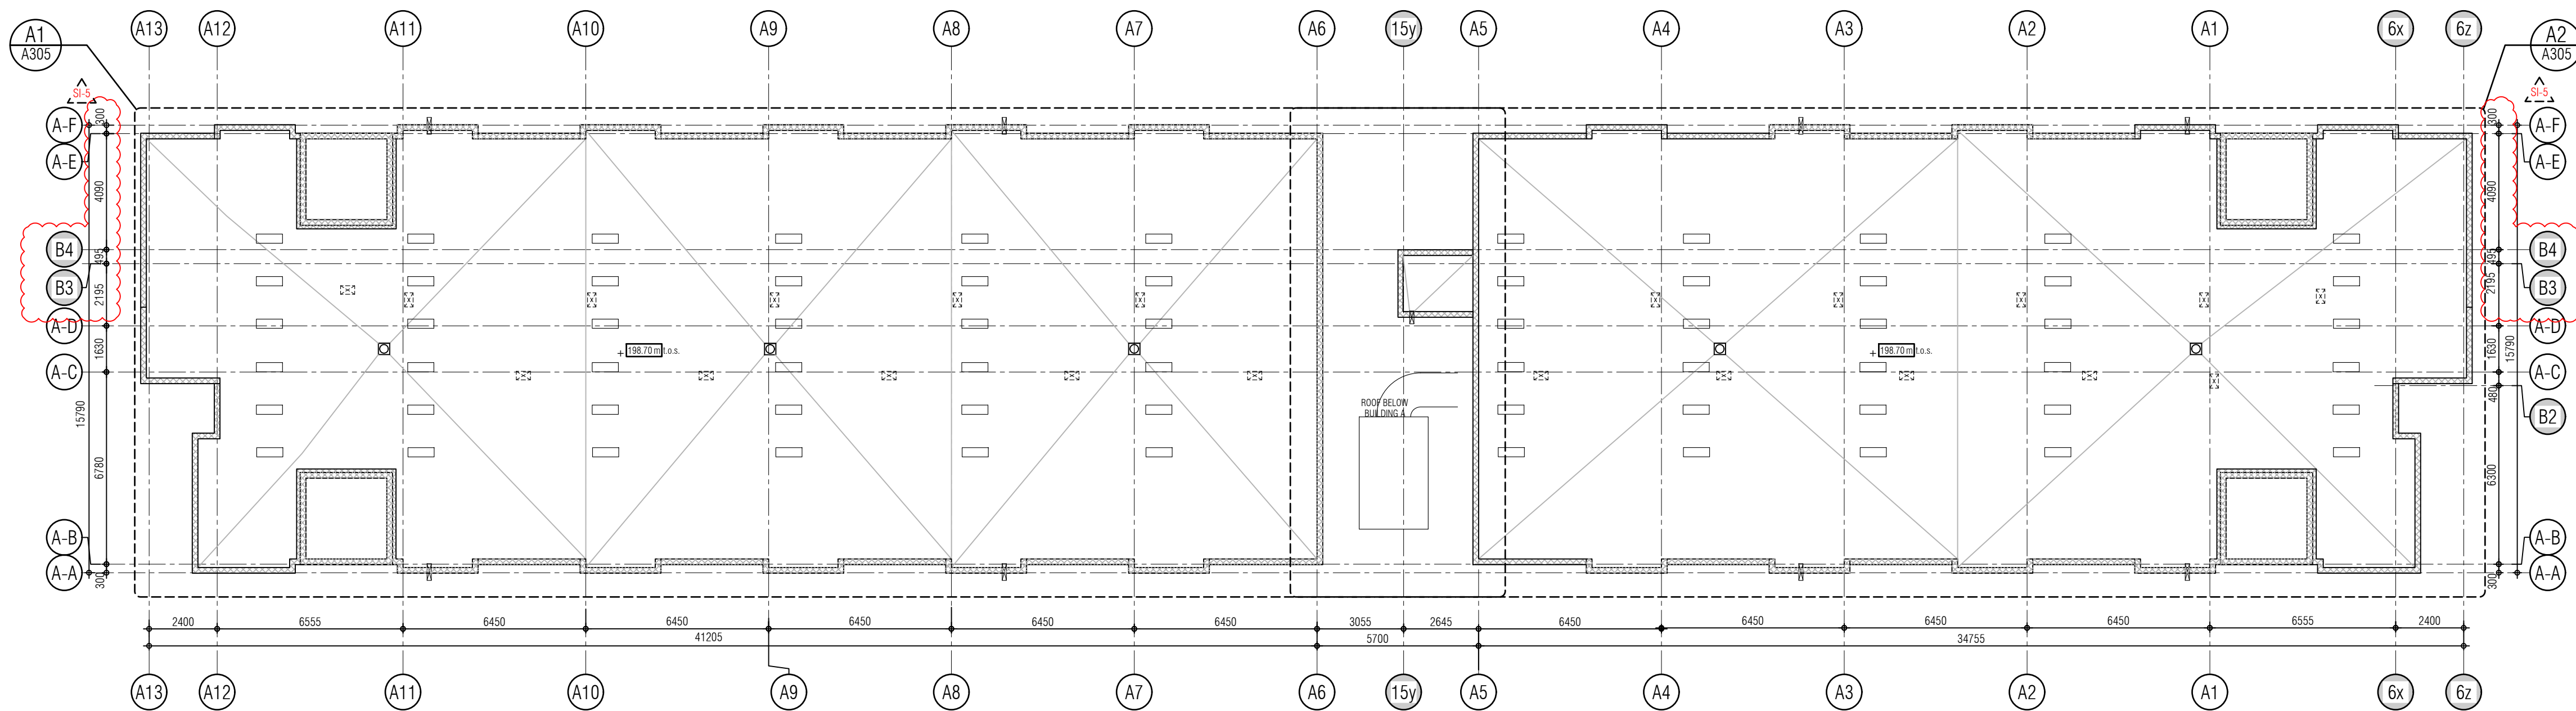

THIS DRAWING, AS AN INSTRUMENT OF SERVICE, IS PROVIDED BY AND IS THE PROPERTY OF GRAZIANI-CORAZZA ARCHITECTS INC. THE CONTRACTOR MUST VERIFY AND ACCEPT RESPONSIBILITY FOR ALL DIMENSIONS AND COORDINATES AND MUST NOTIFY GRAZIANI-CORAZZA ARCHITECTS INC. OF ANY DISCREPANCIES FROM THE SUPPLIED INFORMATION. GRAZIANI-CORAZZA ARCHITECTS INC. IS NOT RESPONSIBLE FOR THE ACCURACY OF SURVEY, STRUCTURAL, MECHANICAL, ELECTRICAL AND OTHER ENGINEERING INFORMATION SHOWN ON THIS DRAWING. REFER TO THE APPROPRIATE ENGINEERING DRAWINGS BEFORE PROCEEDING WITH THE WORK. CONSTRUCTION MUST COMPLY TO ALL APPLICABLE CODES AND REQUIREMENTS OF THE AUTHORITY HAVING JURISDICTION. UNLESS OTHERWISE NOTED, NO INVESTIGATION HAS BEEN UNDERTAKEN OR REPORTED ON BY THIS OFFICE IN REGARD TO THE ENVIRONMENTAL CONDITION OF THIS SITE.

THIS DRAWING IS NOT TO BE SCALED. ALL ARCHITECTURAL SYMBOLS INDICATED ON THIS DRAWING ARE GRAPHIC REPRESENTATIONS ONLY.

CONDITIONS FOR ELECTRONIC INFORMATION TRANSFER

ELECTRONIC INFORMATION IS SUPPLIED TO THE OTHER ASSOCIATED FIRMS TO ASSIST THEM IN THE EXECUTION OF THEIR WORK. REVIEW THE RECIPIENT FIRMS MUST DETERMINE THE COMPLETENESS, APPROPRIATENESS, RELIANCE OF THE INFORMATION IN RESPECT TO THEIR PARTICULAR RESPONSIBILITY.

1. GRAZIANI-CORAZZA ARCHITECTS INC. SHALL NOT BE RESPONSIBLE FOR BROKEN, OVERSIGHT, INCOMPLETENESS DUE TO LOSS OF INFORMATION IN WHOLE OR PART WHEN INFORMATION IS TRANSFERRED.
2. TRANSMISSION OF ANY LOSS OF DAMAGE TO THE RECEIVING ELECTRONIC SYSTEM WHEN INFORMATION IS TRANSFERRED.

REF A305a2 FOR CONTINUATION

01. Oct.07.2019 issued for tender —
02. Mar.13.2020 issued for design coordination #2 —
03. Mar.16.2020 issued for addendum #2 —
04. Mar.16.2020 issued for addendum #3 —
05. Aug.24.2020 issued for addendum #4 —
06. Sept. 28.2020 issued for permit bq
07. Oct.20.2020 issued for addendum #5 —
08. Nov.23.2020 issued for addendum #6 —
09. Dec.14.2020 issued for addendum #7 —
10. Jan.15.2021 issued for addendum #8 —
11. Mar. 2. 2021 issued for permit bq
12. Mar.09.2021 issued for addendum #9 —
13. Mar.10.2021 issued for addendum #9R —
14. Mar.26.2021 issued for progress —
15. May.14.2021 issued for Site Instruction #1 —
16. June.15.2021 issued for Site Instruction #2 —
17. July. 7. 2021 re-issued for permit bq
18. July. 15. 2021 issued for Site Instruction #3 bq
19. July. 27. 2021 issued for Site Instruction #4 bq
20. Aug. 3. 2021 issued for Site Instruction #5 bq

01. Apr.19.2021 issued to client bq
issued for revisions




**GRAZIANI
CORAZZA
ARCHITECTS**
1333 SHAWNEE DRIVE, SUITE 100 MISSISSAUGA, ONTARIO L4W 1C3
905.760.7001 P.905.760.7000 WWW.GC-ARCHITECTS.COM



BRAMPTON ATTMAR + PALLESCI DRIVE ONTARIO
PROJECT ARCHITECT: B. GRAZIANI
ASSISTANT DESIGNER: R. LINCOLN
DRAWN BY: G.C./F.C./M.B.
CHECKED BY: D. BIASE/G. COLANGELO
PLOT DATE: AUG.03.2021
JOB # 1331.15


**CONCRETE SLAB EDGE ROOF PLAN
BUILDING A (PARTIAL PLAN)**

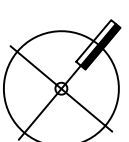


1:50

CS305a1

TITLEBLOCK SIZE: 915 x 1200

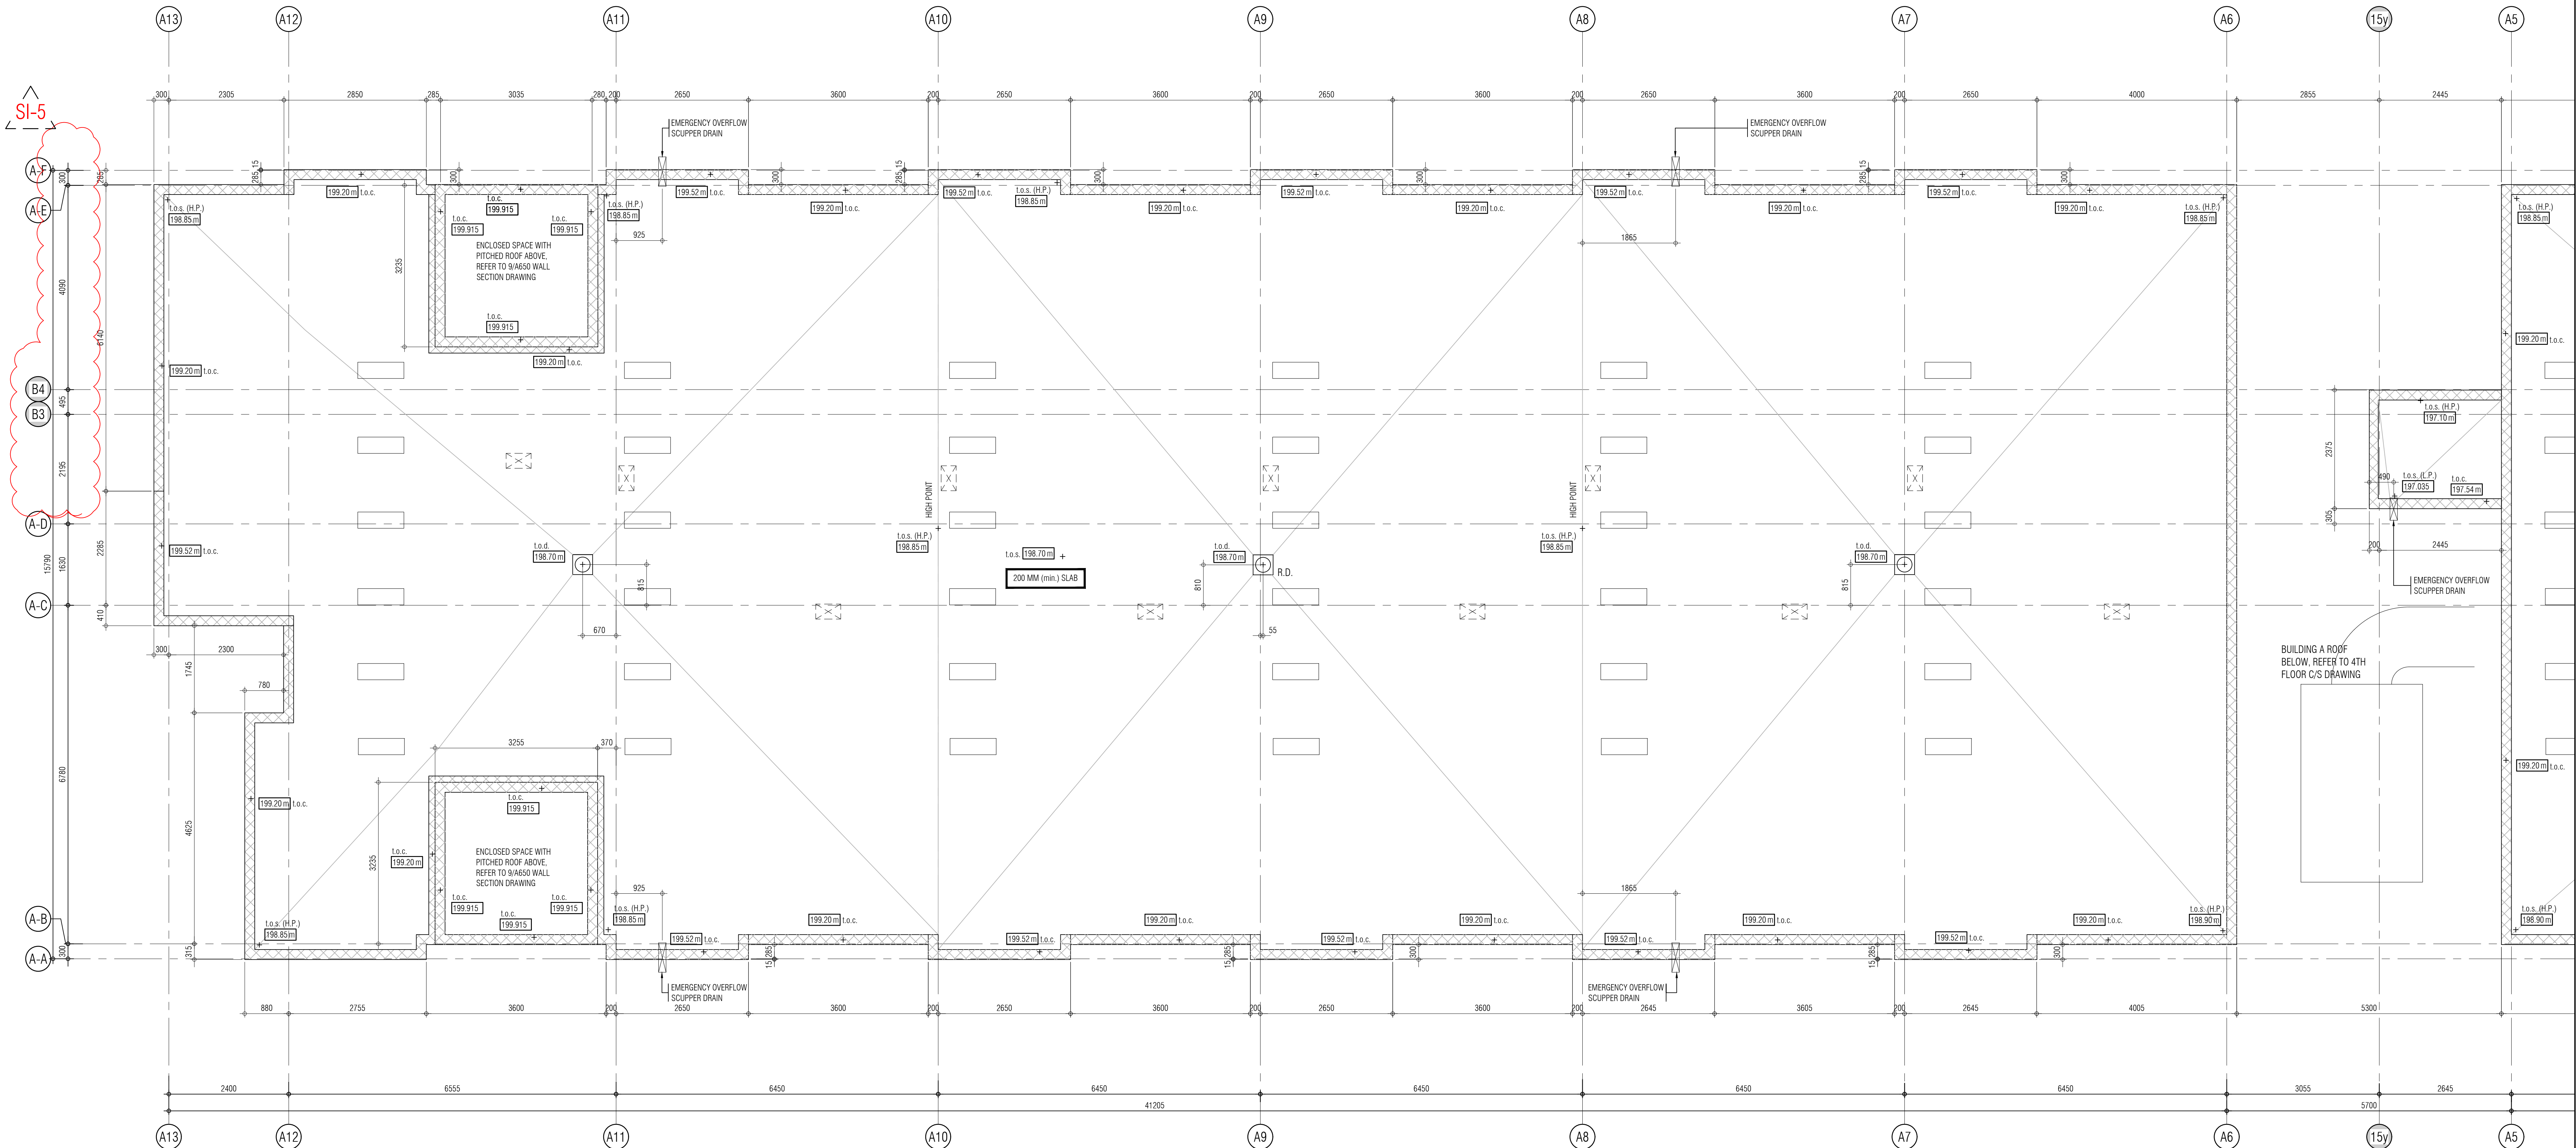

KEY PLAN

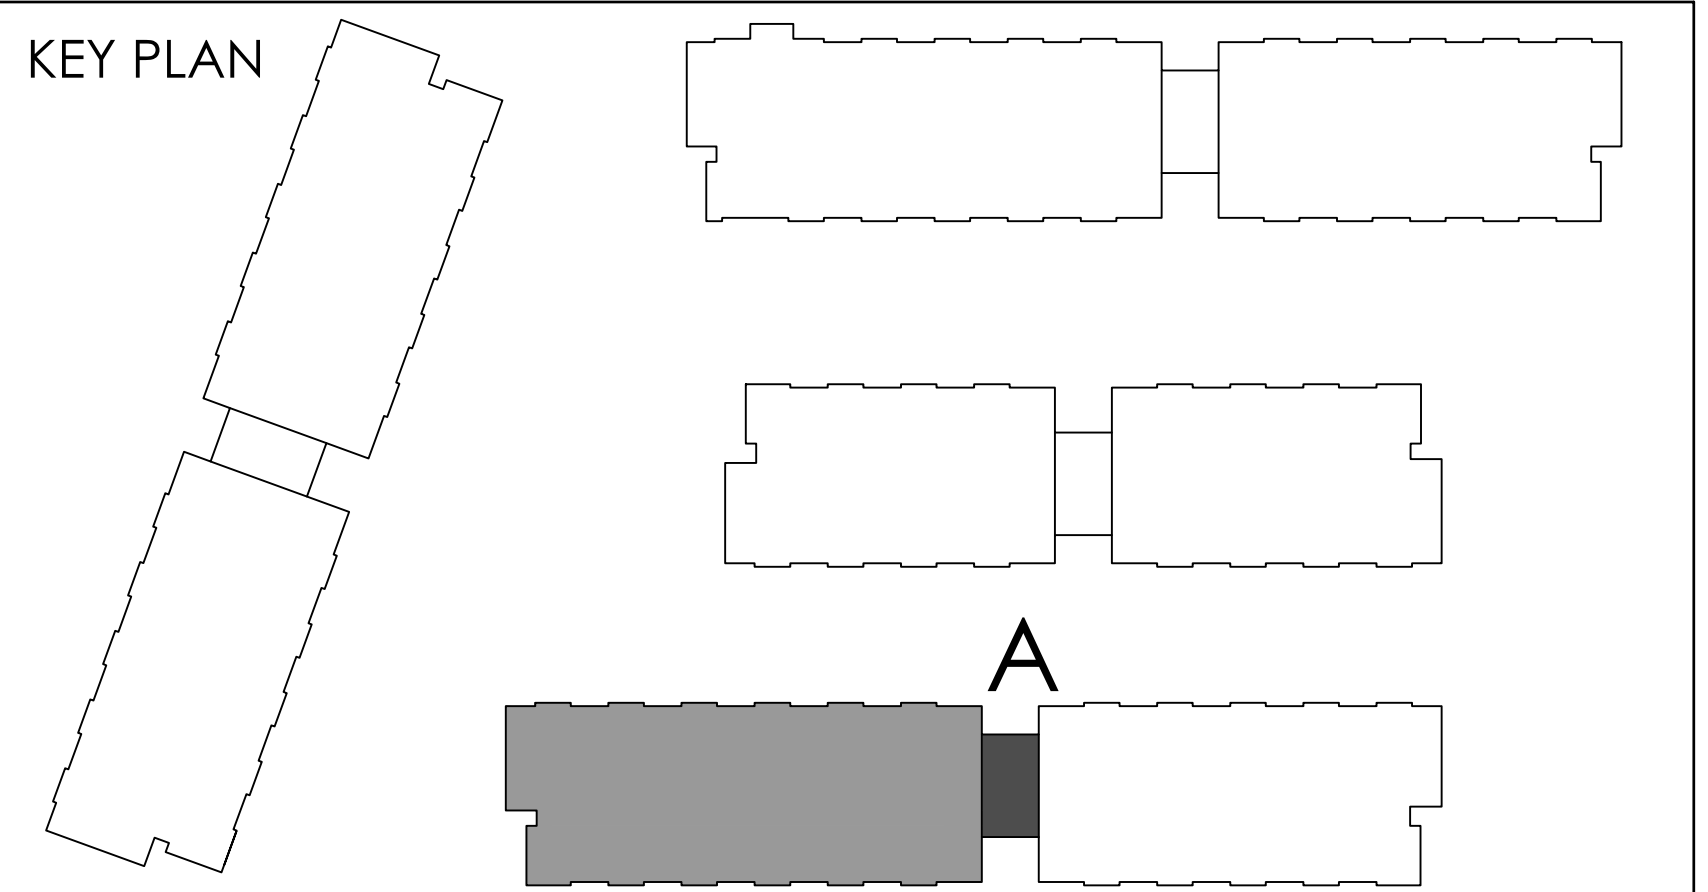

THIS DRAWING IS NOT TO BE SCALED. ALL REPRESENTATIONAL SYMBOLS INDICATED ON THIS DRAWING ARE GRAPHIC REFERENCE ONLY.

CONDITIONS FOR ELECTRONIC INFORMATION TRANSFER

ELECTRONIC INFORMATION IS SUPPLIED TO THE OTHER ASSOCIATED FIRMS TO ASSIST THEM IN THE EXECUTION OF THEIR WORK. REVIEW, THE RECIPIENT FIRMS MUST MAINTAIN THE CONFIDENTIALITY AND NON-DISSEMINATION OF THE INFORMATION IN RESPECT TO THEIR PARTICULAR RESPONSIBILITY.

GRAZIANO-CORAZZA ARCHITECTS INC. SHALL NOT BE RESPONSIBLE FOR:


1. ERRORS, OMISSIONS, INADEQUATELY, LOSS OR LOSS OF INFORMATION IN WHOLE OR PART WHEN INFORMATION IS TRANSFERRED;
2. TRANSMISSION OF ANY VIRUS OR DAMAGE TO THE RECEIVING ELECTRONIC SYSTEM WHEN INFORMATION IS TRANSFERRED.

01. Apr.19.2021 issued to client bg
issued for revisions

RESIDENTIAL

The logo for Royal Pine Realty is an oval emblem. It features a green background with a gold border. In the center, there is a gold pine tree. The words "ROYAL PINE" are written in a gold, serif font across the middle of the oval, with "REALTY" in a smaller font below it.

CONCRETE SLAB EDGE ROOF PLAN
BUILDING A (PARTIAL PLAN)

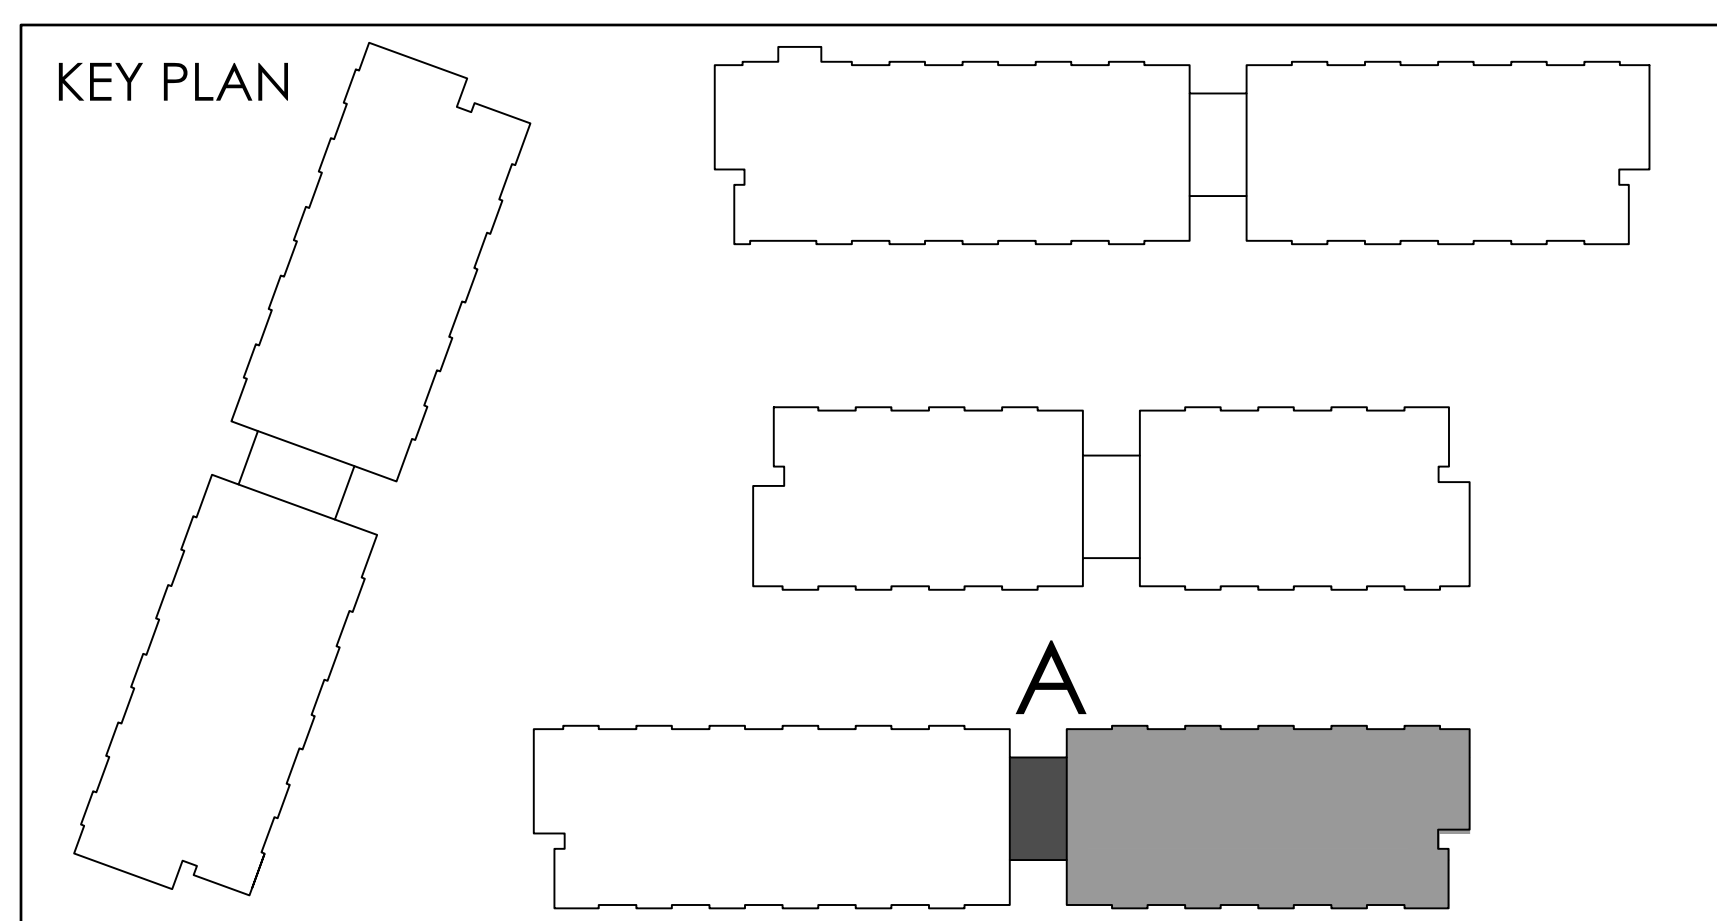

THIS DRAWING IS AN INSTRUMENT OF SERVICE, IT IS PROVIDED BY AND IS THE PROPERTY OF GRAZIANI-CORAZZA ARCHITECTS INC. THE CONTRACTOR MUST VERIFY AND ACCEPT RESPONSIBILITY FOR ALL DIMENSIONS AND COORDINATE ON SITE AND MUST NOTIFY GRAZIANI-CORAZZA ARCHITECTS INC. OF ANY VARIATIONS FROM THE SUPPLIED INFORMATION. GRAZIANI-CORAZZA ARCHITECTS INC. IS NOT RESPONSIBLE FOR THE ACCURACY OF SURVEY, STRUCTURAL, MECHANICAL, ELECTRICAL, AND OTHER ENGINEERING INFORMATION SHOWN ON THIS DRAWING. REFER TO THE APPROPRIATE ENGINEERING DRAWINGS BEFORE PROCEEDING WITH THE WORK. CONSTRUCTION MUST COMPLY TO ALL APPLICABLE CODES AND REQUIREMENTS OF THE AUTHORITIES HAVING JURISDICTION. UNLESS OTHERWISE NOTED, NO MODIFICATION HAS BEEN UNDERTAKEN OR REPORTED ON BY THIS OFFICE IN REGARDS TO THE ENVIRONMENTAL CONDITION OF THIS SITE.


THIS DRAWING IS NOT TO BE SCALED. ALL ARCHITECTURAL SYMBOLS INDICATED ON THIS DRAWING ARE GRAPHIC REPRESENTATIONS ONLY.

CONDITIONS FOR ELECTRONIC INFORMATION TRANSFER:

ELECTRONIC INFORMATION IS SUPPLIED TO THE OTHER ASSOCIATED FIRMS TO ASSIST THEM IN THE EXECUTION OF THEIR WORK/REVIEW. THE RECIPIENT FIRMS MUST DETERMINE THE COMPLETENESS, APPROPRIATENESS, RELIANCE OF THE INFORMATION IN RESPECT TO THEIR PARTICULAR RESPONSIBILITY.

GRAZIANI-CORAZZA ARCHITECTS INC. SHALL NOT BE RESPONSIBLE FOR ERRORS, OMISSIONS, INCOMPLETENESS DUE TO LOSS OF INFORMATION IN WHOLE OR PART WHEN INFORMATION IS TRANSFERRED.

1. TRANSMISSION OF ANY VIRUS OR DAMAGE TO THE RECEIVING ELECTRONIC SYSTEM WHEN INFORMATION IS TRANSFERRED.

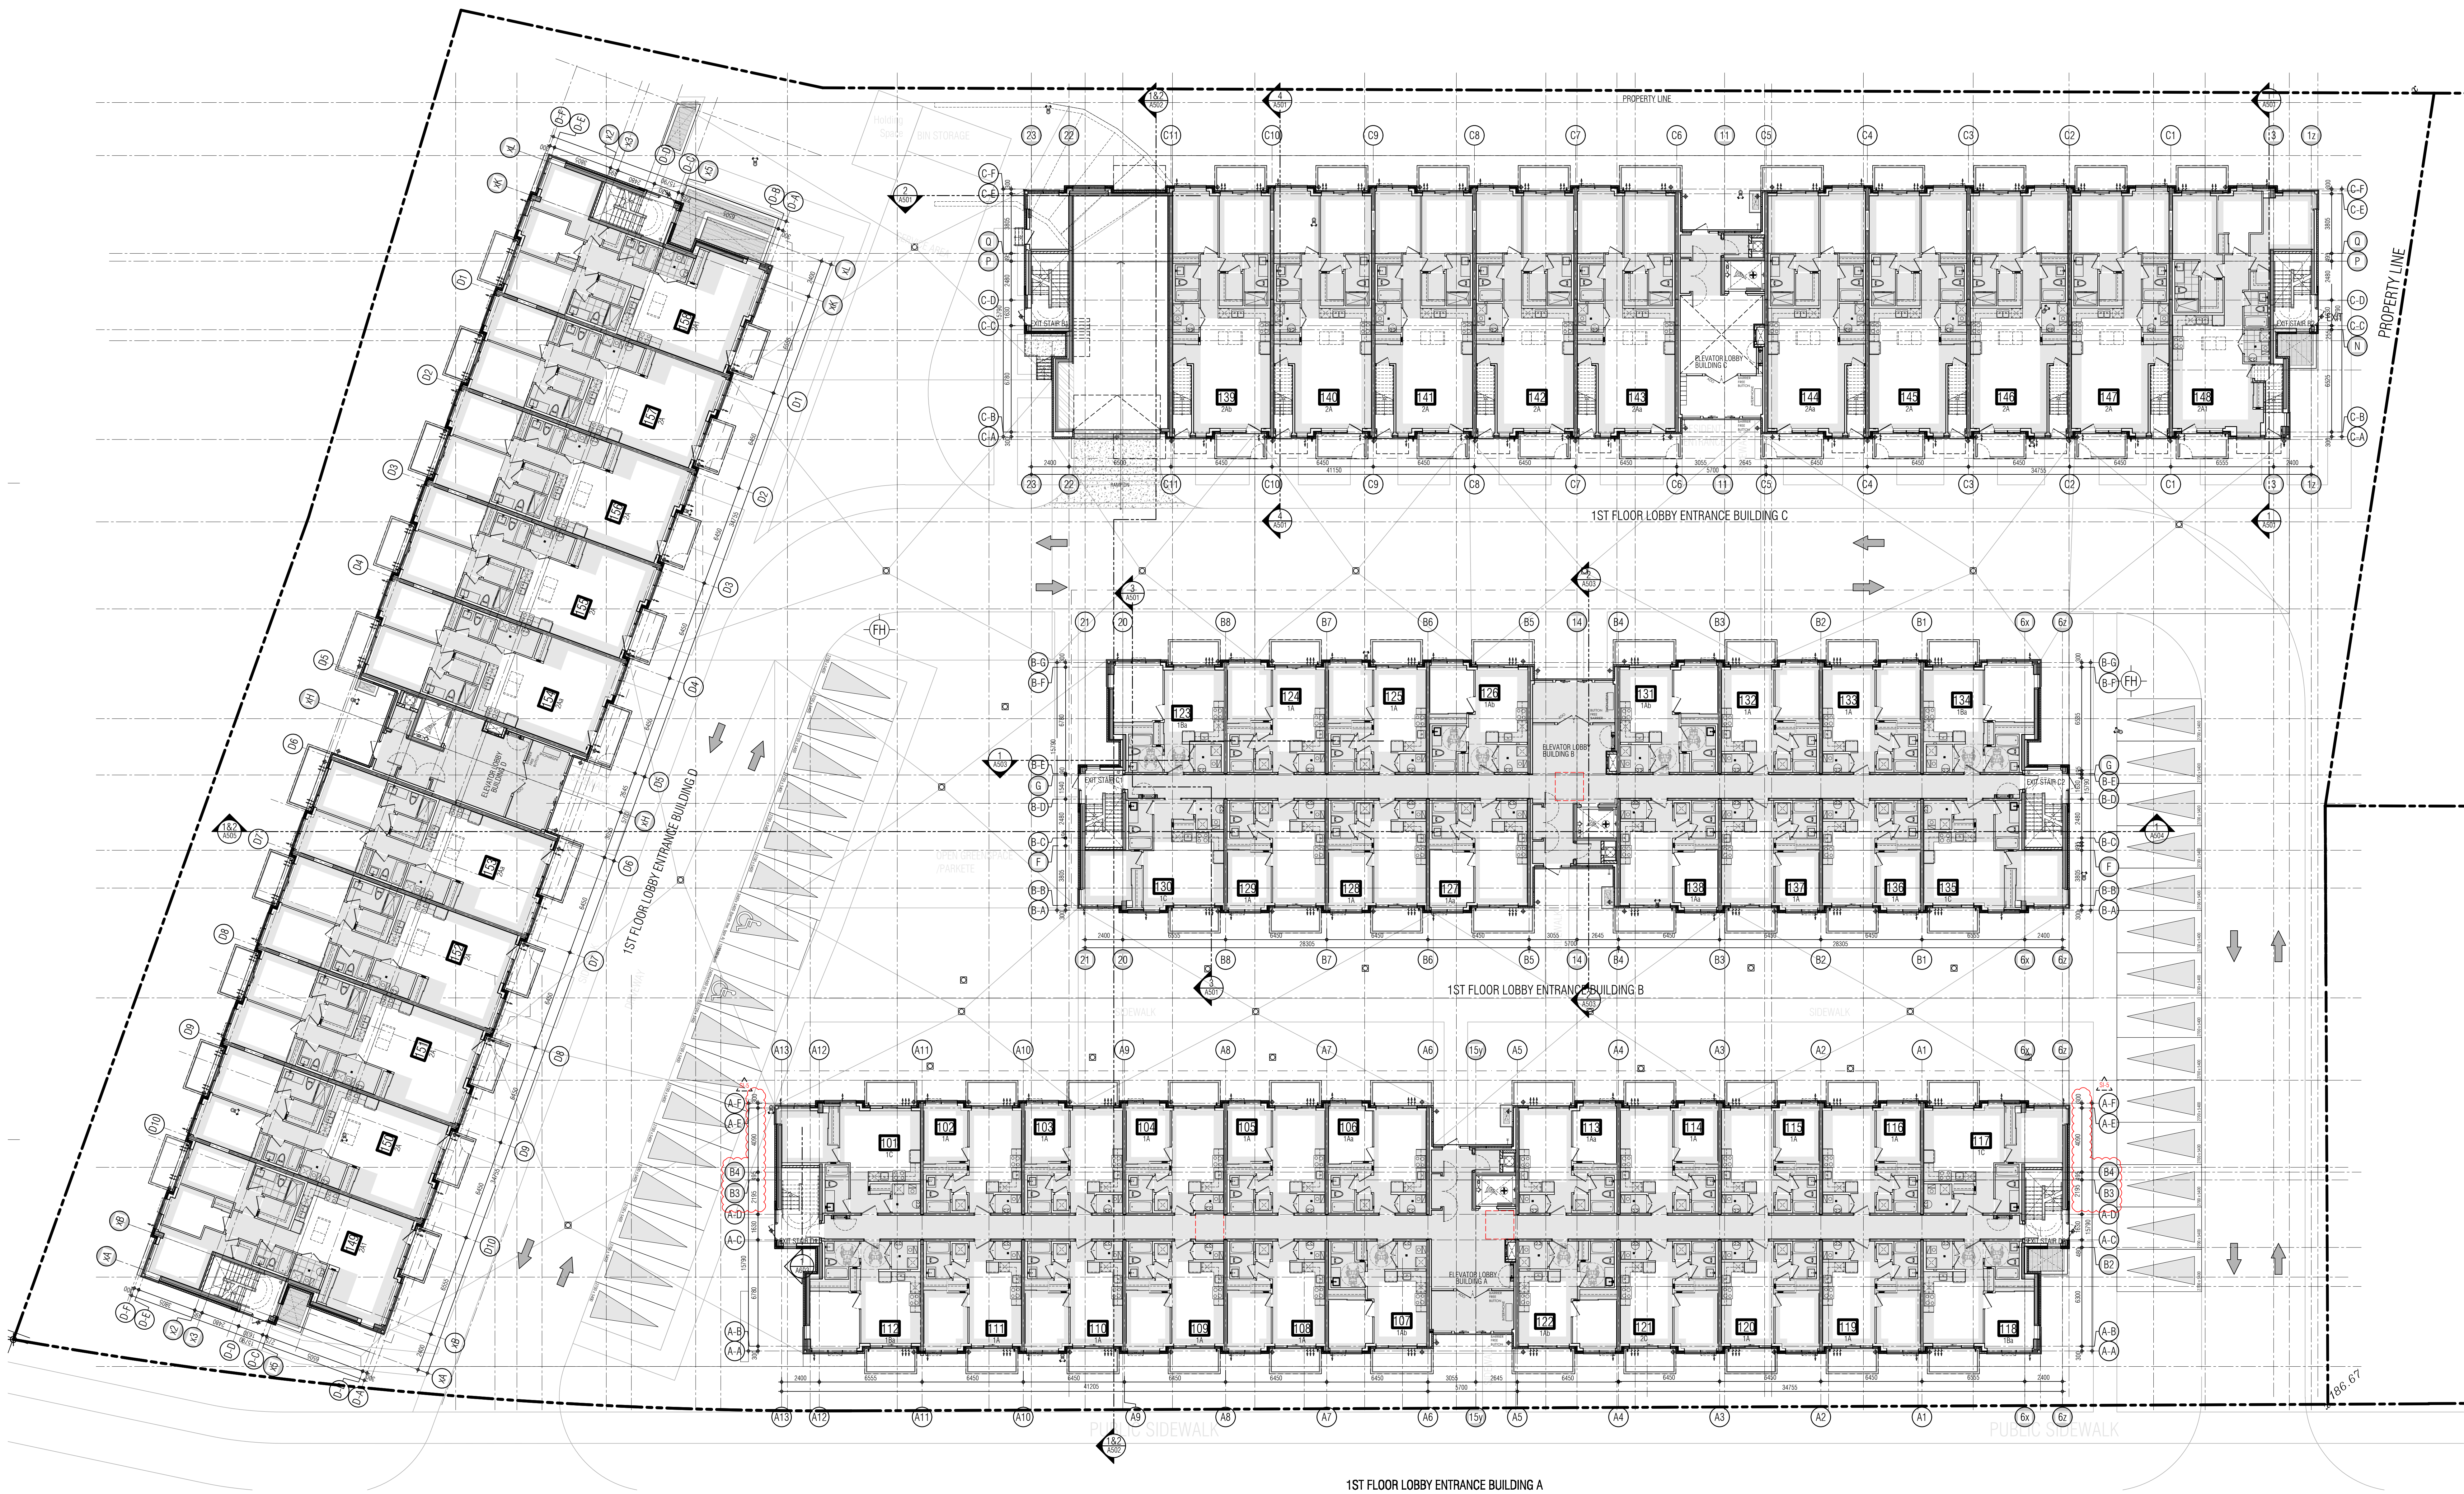

- 01. Oct.07.2019 issued for tender
- 02. Mar.13.2020 issued for design coordination #2
- 03. Mar.16.2020 issued for addendum #2
- 04. Mar.16.2020 issued for addendum #3
- 05. Aug.24.2020 issued for addendum #4
- 06. Sept.28.2020 issued for permit
- 07. Oct.20.2020 issued for addendum #5
- 08. Nov.23.2020 issued for addendum #6
- 09. Dec.14.2020 issued for addendum #7
- 10. Jan.18.2021 issued for addendum #8
- 11. Mar.2.2021 issued for permit
- 12. Mar.09.2021 issued for addendum #9
- 13. Mar.10.2021 issued for addendum #9R
- 14. Mar.26.2021 issued for progress
- 15. May.14.2021 issued for Site Instruction #1
- 16. June.15.2021 issued for Site Instruction #2
- 17. July.7.2021 re-issued for permit
- 18. July.15.2021 issued for Site Instruction #3
- 19. July.27.2021 issued for Site Instruction #4
- 20. Aug.3.2021 issued for Site Instruction #5
- 21. Aug.5.2021 issued for Site Instruction #6

- 01. SEP.18.2019 issued for Addendum 1
 - 01. Apr.19.2021 issued to client
- issued for revisions



RESIDENTIAL

ATTMAR + PALLESCI DRIVE

BRAMPTON ONTARIO

PROJECT ARCHITECT: B. GRAZIANI

ASSISTANT DESIGNER: R. LINCOLN

DRAWN BY: G.C./F.C./M.B.

CHECKED BY: D. BIASE/G. COLANGELO

PILOT DATE: AUG.18.2021

JOB # 1331.15

GROUND FLOOR OVERALL PLAN



THIS DRAWING IS AN INSTRUMENT OF SERVICE, IT IS PROVIDED BY W.D. IS THE PROPERTY OF GRAZIANI-CORAZZA ARCHITECTS INC. THE CONTRACTOR MUST VERIFY AND ACCEPT RESPONSIBILITY FOR ALL DIMENSIONS AND COORDINATIONS. GRAZIANI-CORAZZA ARCHITECTS INC. IS NOT RESPONSIBLE FOR THE ACCURACY OF SURVEY, STRUCTURAL, MECHANICAL, ELECTRICAL, AND OTHER ENGINEERING INFORMATION SHOWN ON THIS DRAWING. REFER TO THE APPROPRIATE ENGINEERING DRAWINGS BEFORE PROCEEDING WITH THE WORK. CONSTRUCTION MUST COMPLY TO ALL APPLICABLE CODES AND REQUIREMENTS OF THE AUTHORITIES HAVING JURISDICTION, UNLESS OTHERWISE NOTED. NO REVISIONS ARE BEING MADE TO THIS DRAWING IN THIS OFFICE IN RELATION TO THE ENVIRONMENTAL CONDITION OF THIS SITE.

THIS DRAWING IS NOT TO BE SCALED. ALL ARCHITECTURAL SYMBOLS INDICATED ON THIS DRAWING ARE GRAPHIC REPRESENTATIONS ONLY.

CONDITIONS FOR ELECTRONIC INFORMATION TRANSFER

ELECTRONIC INFORMATION IS SUPPLIED TO THE OTHER ASSOCIATED FIRMS TO ASSIST THEM IN THE EXECUTION OF THEIR WORK. REVIEW THE RECEIPT FORMS MUST DETERMINE THE COMPLETENESS, APPROPRIATENESS, RELIANCE OF THE INFORMATION IN RESPECT TO THEIR PARTICULAR RESPONSIBILITY.


GRAZIANI-CORAZZA ARCHITECTS INC. SHALL NOT BE RESPONSIBLE FOR ERROR, OMISSION, INCOMPLETENESS DUE TO LOSS OF INFORMATION IN WHICH OR PART WHEN INFORMATION IS TRANSMITTED.

1. TRANSMISSION OF ANY LOSS OF DAMAGE TO THE RECEIVING ELECTRONIC SYSTEM WHEN INFORMATION IS TRANSMITTED.

REF. A301d2 FOR CONTINUATION

- | | | | |
|-----|--------------|-----------------------------------|----|
| 01. | Oct.07.2019 | Issued for tender | — |
| 02. | Mar.13.2020 | Issued for design coordination #2 | — |
| 03. | Mar.16.2020 | Issued for addendum #2 | — |
| 04. | Mar.16.2020 | Issued for addendum #3 | — |
| 05. | Aug.24.2020 | Issued for addendum #4 | — |
| 06. | Sept.28.2020 | Issued for permit | bq |
| 07. | Oct.20.2020 | Issued for addendum #5 | — |
| 08. | Nov.23.2020 | Issued for addendum #6 | — |
| 09. | Dec.14.2020 | Issued for addendum #7 | — |
| 10. | Jan.15.2021 | Issued for addendum #8 | — |
| 11. | Mar.2.2021 | Issued for permit | bq |
| 12. | Mar.09.2021 | Issued for addendum #9 | — |
| 13. | Mar.10.2021 | Issued for addendum #9R | — |
| 14. | Mar.26.2021 | Issued for progress | — |
| 15. | May.14.2021 | Issued for Site Instruction #1 | — |
| 16. | June.15.2021 | Issued for Site Instruction #2 | — |
| 17. | July.7.2021 | re-issued for permit | bq |
| 18. | July.15.2021 | Issued for Site Instruction #3 | bq |
| 19. | July.27.2021 | Issued for Site Instruction #4 | bq |
| 20. | Aug.3.2021 | Issued for Site Instruction #5 | bq |
| 21. | Aug.5.2021 | Issued for Site Instruction #6 | bq |


- | | | | |
|----------------------|-------------|------------------------|----|
| 01. | SEP.18.2021 | Issued for addendum #1 | bq |
| Issued for revisions | | | + |

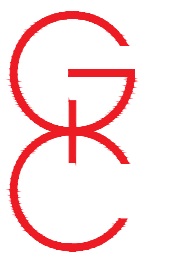
**GRAZIANI
CORAZZA
ARCHITECTS**
1333 SHAWANAGUA DRIVE, SUITE 100 MISSISSAUGA, ONTARIO L4R 1C3
905.760.7001 F.905.760.7000 WWW.GC-ARCHITECTS.COM



ATTMAR + PALLESCHI DRIVE

BRAMPTON ONTARIO
PROJECT ARCHITECT: B. GRAZIANI
ASSISTANT DESIGNER: R. LINCOLN
DRAWN BY: G.C./F.C./M.B.
CHECKED BY: D. BIASE/G. COLANGELO
PLOT DATE: AUG.18.2021
JOB #: 1331.15


**GROUND FLOOR PLAN
BUILDING A (PARTIAL PLAN)**

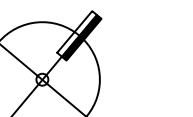 1:50 **A-301a1**

TITLEBLOCK SIZE: 915 x 1200

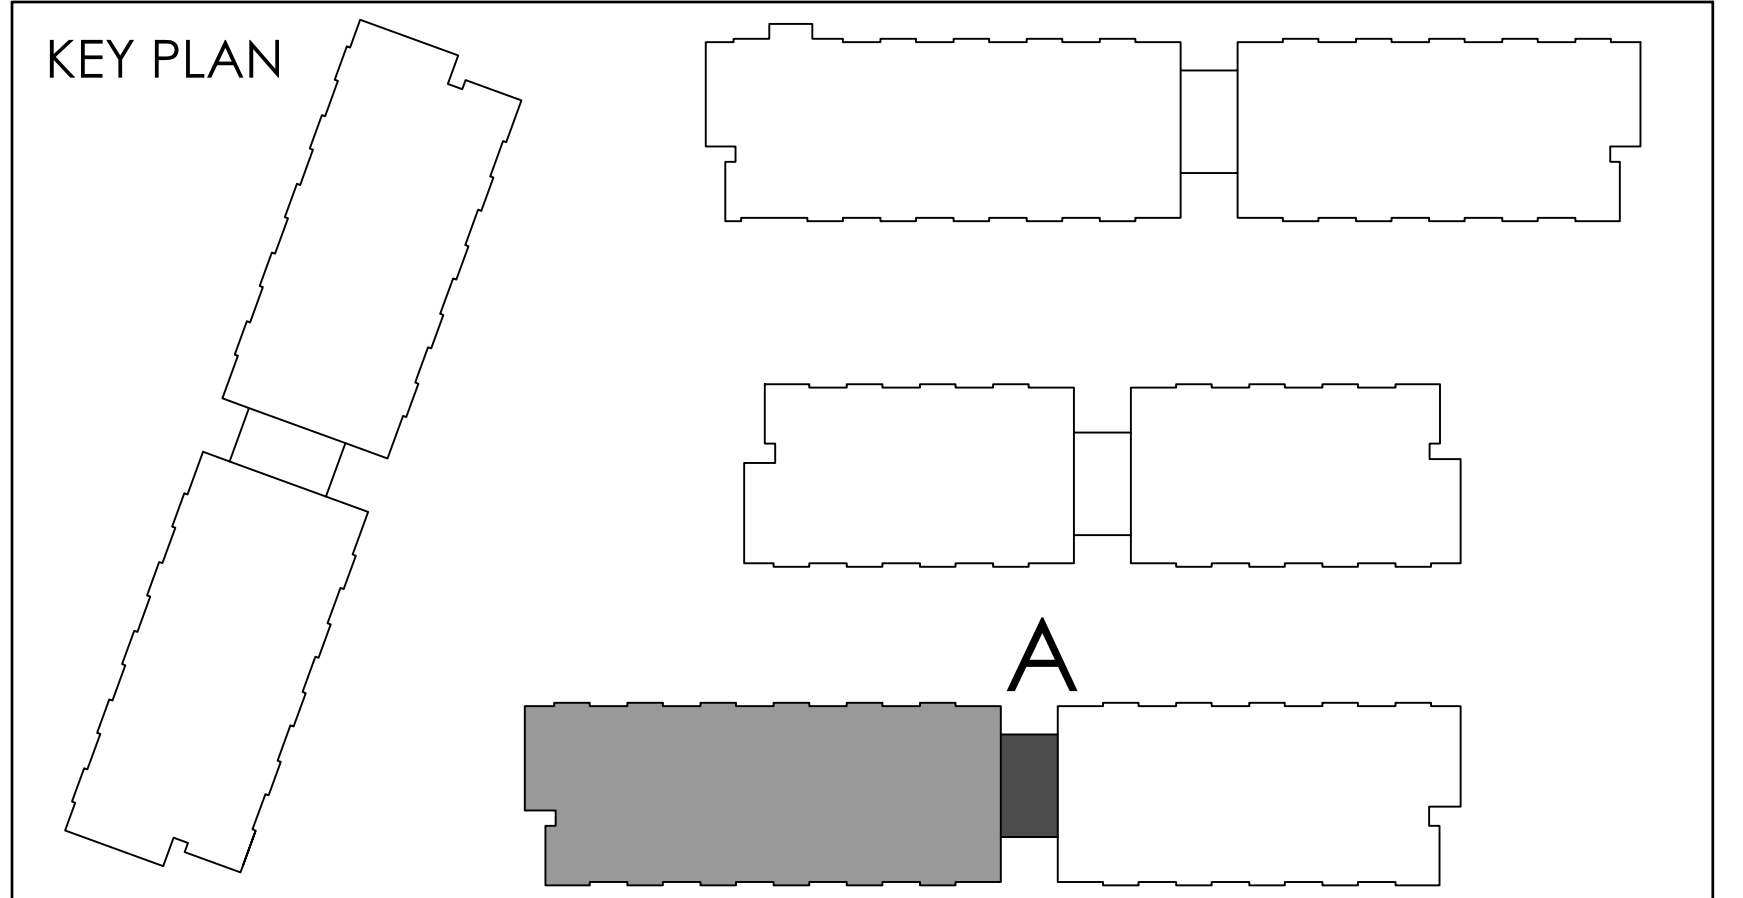


REF.A301d1 FOR CONTINUATION

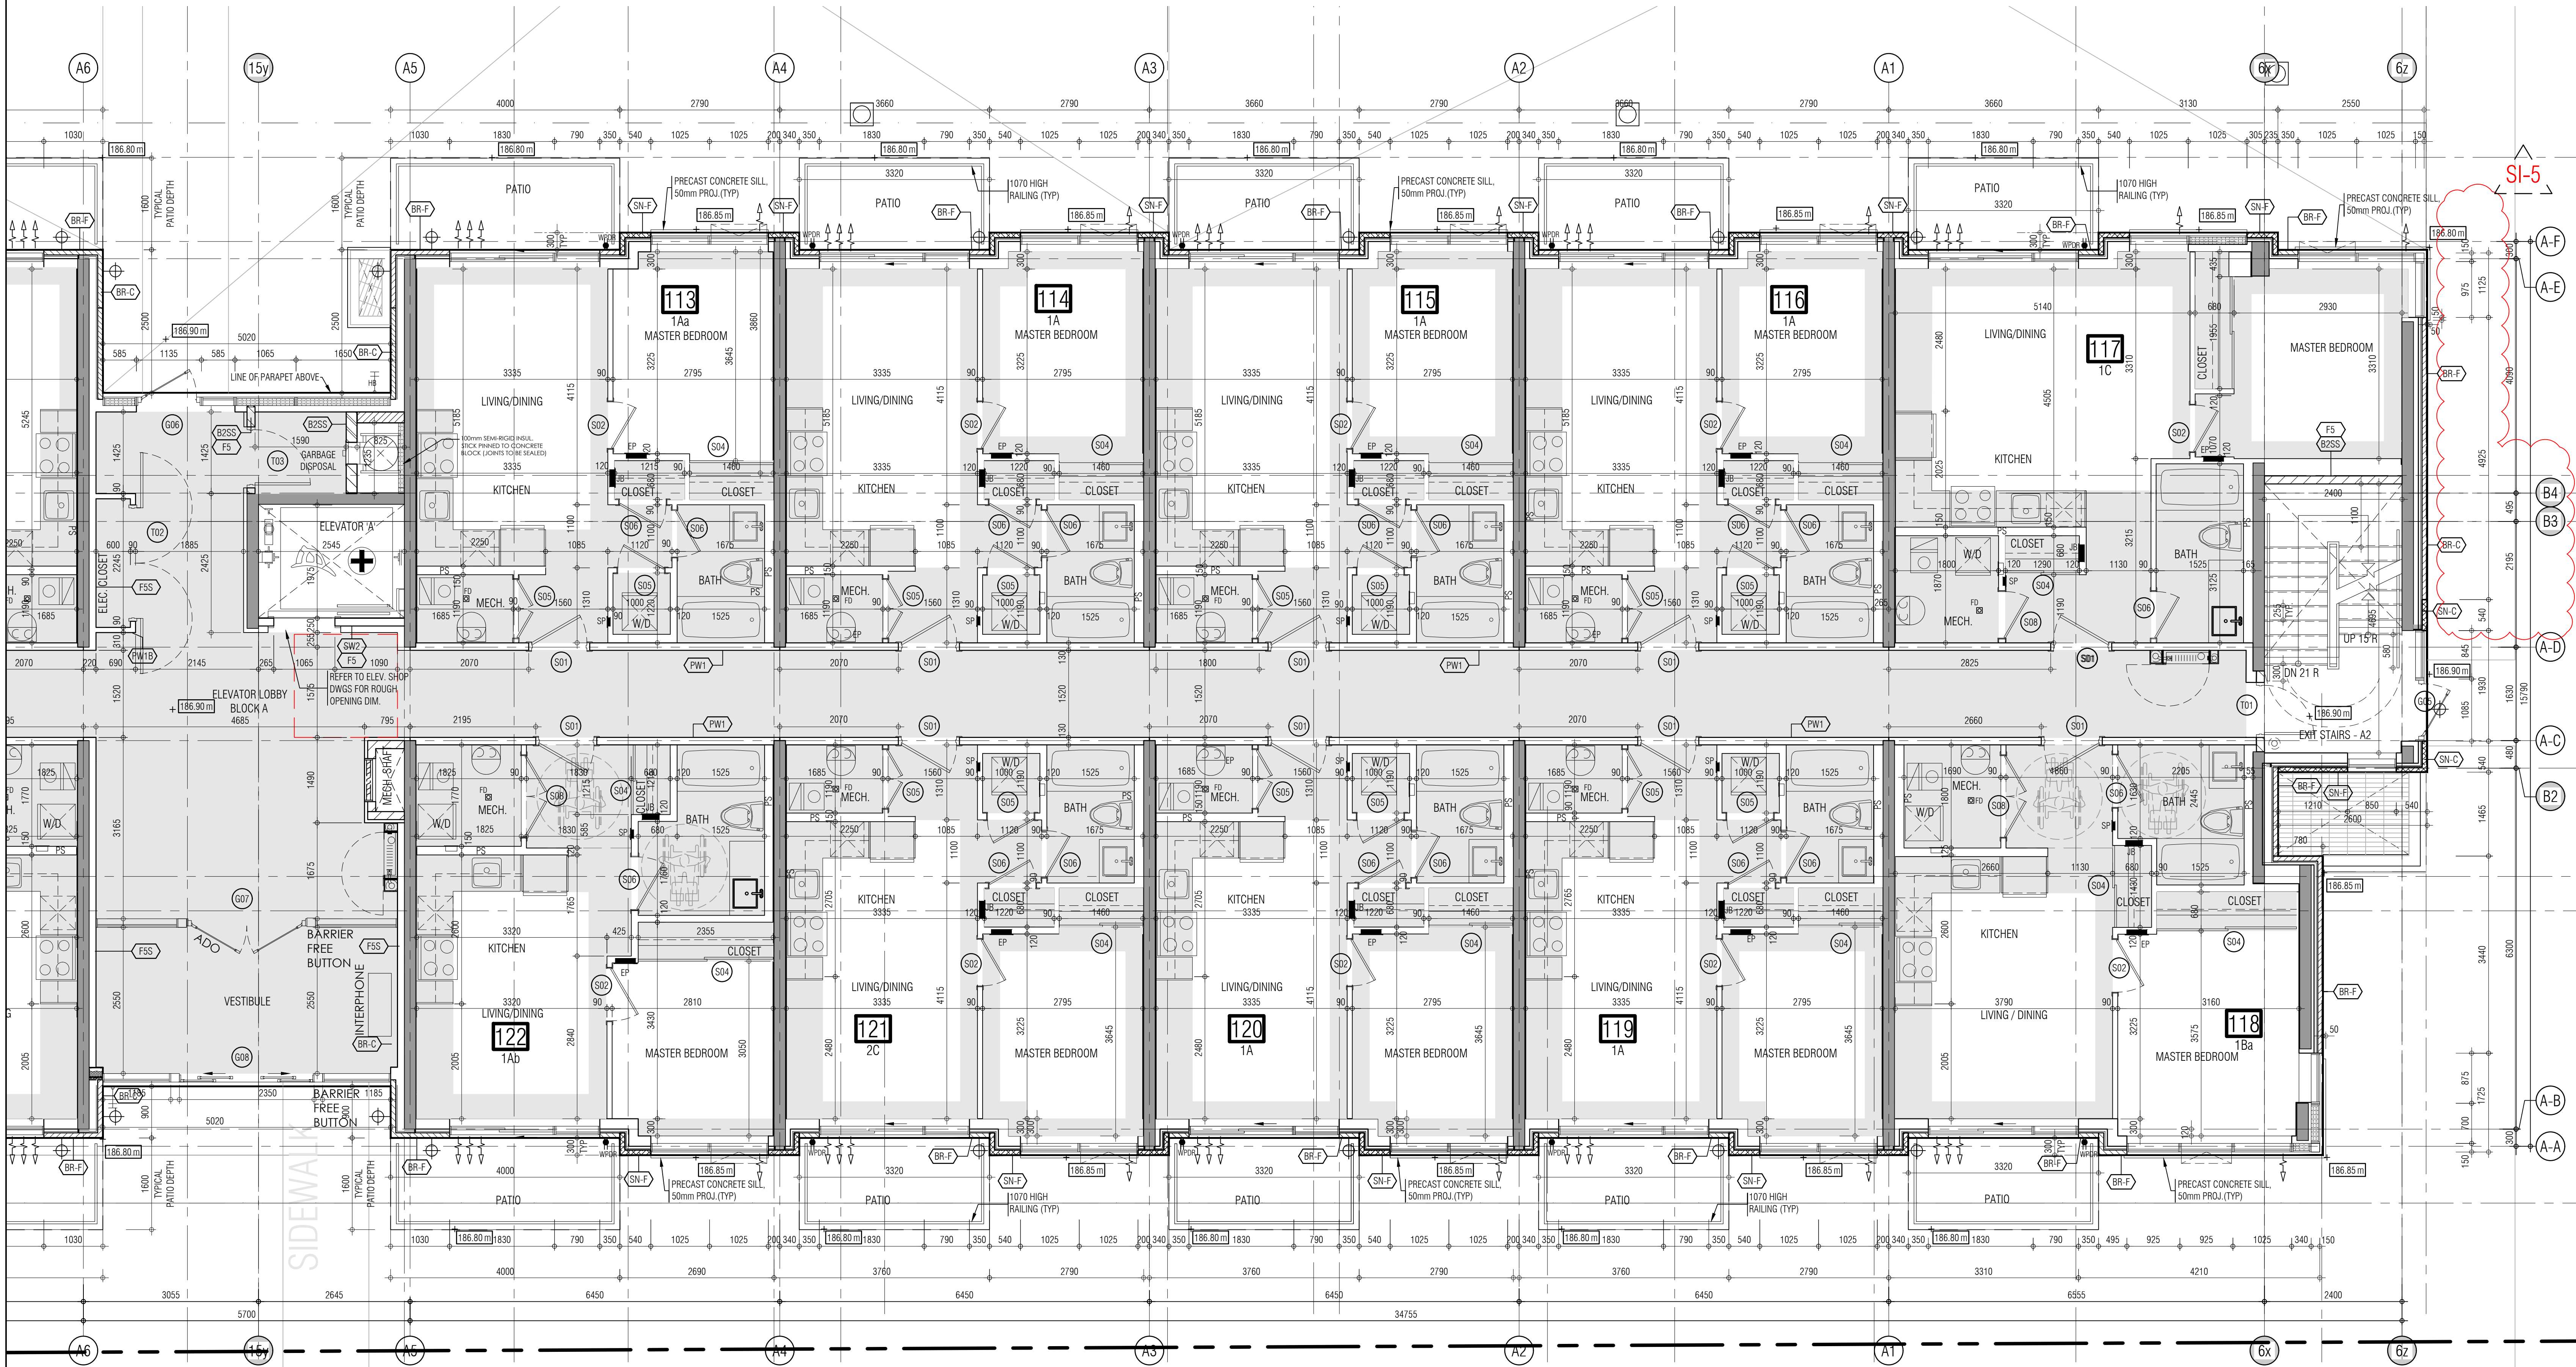

DIADI ID CIDEWAI

KEY PLAN

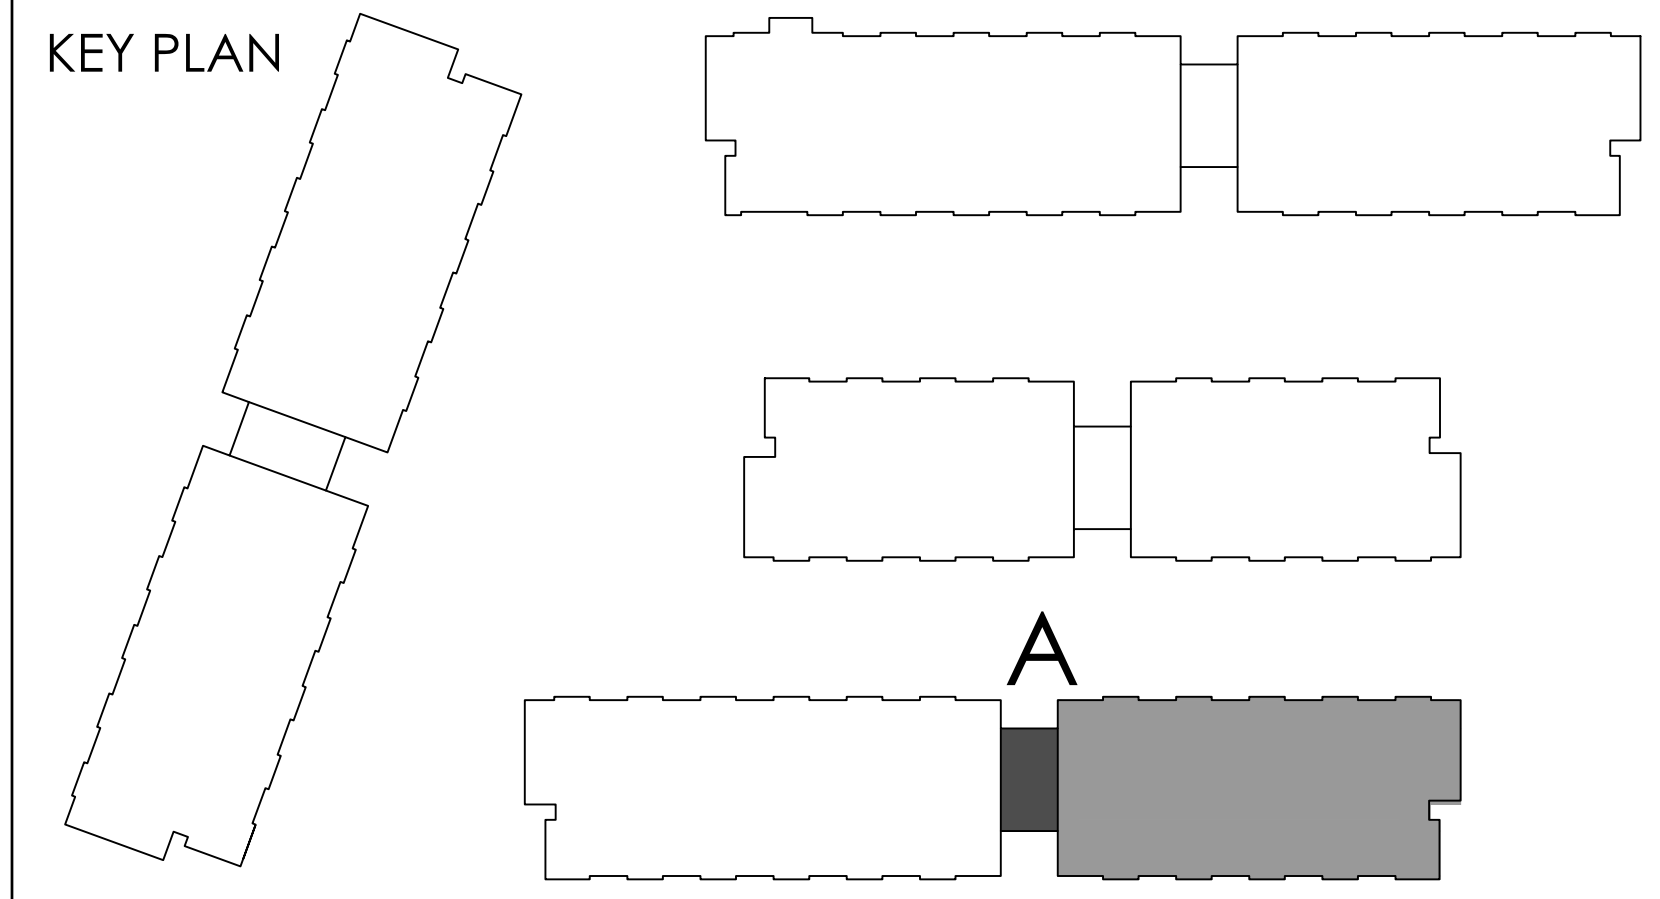

THIS DRAWING IS AN INSTRUMENT OF SERVICE, IT IS PROVIDED BY AND IS THE PROPERTY OF GRAZIANI-CORAZZA ARCHITECTS INC. THE CONTRACTOR MUST VERIFY AND ACCEPT RESPONSIBILITY FOR ALL DIMENSIONS AND COORDINATE THE SITE AND MUST NOTIFY GRAZIANI-CORAZZA ARCHITECTS INC. OF ANY OMISSIONS FROM THE SUPPLIED INFORMATION. GRAZIANI-CORAZZA ARCHITECTS INC. IS NOT RESPONSIBLE FOR THE ACCURACY OF SURVEY, STRUCTURAL, MECHANICAL, ELECTRICAL, AND OTHER ENGINEERING INFORMATION SHOWN ON THIS DRAWING. REFER TO THE APPROPRIATE ENGINEERING DRAWINGS BEFORE PROCEEDING WITH THE WORK. CONSTRUCTION MUST COMPLY TO ALL APPLICABLE CODES AND REQUIREMENTS OF THE AUTHORITIES HAVING JURISDICTION, UNLESS OTHERWISE NOTED. NO MODIFICATION HAS BEEN MADE/NOTED AS REPORTED IN BY THIS OFFICE IN REFERENCE TO THE ENVIRONMENTAL CONDITION OF THIS SITE. THIS DRAWING IS NOT TO BE SCALED. ALL ARCHITECTURAL SYMBOLS INDICATED ON THIS DRAWING ARE GRAPHIC REPRESENTATIONS ONLY.

CONDITIONS FOR ELECTRONIC INFORMATION TRANSFER

ELECTRONIC INFORMATION IS SUPPLIED TO THE OTHER ASSOCIATED FIRMS TO ASSIST THEM IN THE EXECUTION OF THEIR WORK. REVIEW THE RECEIVED FIRMS MUST DETERMINE THE COMPLETENESS, APPROPRIATENESS, RELIABILITY OF THE INFORMATION IN RESPECT TO THEIR PARTICULAR RESPONSIBILITY.

GRAZIANI-CORAZZA ARCHITECTS INC. SHALL NOT BE RESPONSIBLE FOR ERROR, OMISSIONS, INCOMPLETENESS DUE TO LOSS OF INFORMATION IN WHICH NO PART OF INFORMATION IS TRANSFERRED.

1. TRANSMISSION OF ANY LOSS OF DAMAGE TO THE RECEIVING ELECTRONIC SYSTEM WHEN INFORMATION IS TRANSFERRED.

01. Oct.07.2019 issued for tender
02. Mar.13.2020 issued for design coordination #2
03. Mar.16.2020 issued for addendum #2
04. Mar.16.2020 issued for addendum #3
05. Aug.24.2020 issued for addendum #4
06. Sept.28.2020 issued for permit
07. Oct.20.2020 issued for addendum #5
08. Nov.23.2020 issued for addendum #6
09. Dec.14.2020 issued for addendum #7
10. Jan.18.2021 issued for addendum #8
11. Mar.2.2021 issued for permit
12. Mar.09.2021 issued for addendum #9
13. Mar.10.2021 issued for addendum #9R
14. Mar.26.2021 issued for progress
15. May.14.2021 issued for Site Instruction #1
16. June.15.2021 issued for Site Instruction #2
17. July.7.2021 re-issued for permit
18. July.15.2021 issued for Site Instruction #3
19. July.27.2021 issued for Site Instruction #4
20. Aug.3.2021 issued for Site Instruction #5
21. Aug.5.2021 issued for Site Instruction #6

01. SEP.18.2021 issued for revisions

GRAZIANI CORAZZA ARCHITECTS

1333 SHANAGAR DRIVE, SUITE 100 MISSISSAUGA, ONTARIO L4W 1C3
905.765.7001 F.905.765.7006 WWW.GC-ARCHITECTS.COM

RESIDENTIAL

ATTMAR + PALLESCHI DRIVE

BRAMPTON ONTARIO

PROJECT ARCHITECT: B. GRAZIANI
ASSISTANT DESIGNER: R. LINCOLN
DRAWN BY: G.C./F.C./M.B.
CHECKED BY: D. BIASE/G. COLANGELO
PLOT DATE: AUG.18.2021
JOB #: 1331.15

**GROUND FLOOR PLAN
BUILDING A (PARTIAL PLAN)**

1:50 A-301a2

TITLEBLOCK SIZE: 915 x 1200

THIS DRAWING IS NOT TO BE SCALED. ALL ARCHITECTURAL SYMBOLS INDICATED ON THIS DRAWING ARE GRAPHIC REPRESENTATIONS ONLY.

CONDITIONS FOR ELECTRONIC INFORMATION TRANSFER

ELECTRONIC INFORMATION IS SUPPLIED TO THE OTHER ASSOCIATED FIRMS TO ASSIST THEM IN THE EXECUTION OF THEIR WORK/REVIEW. THE RECIPIENT FIRMS MUST DETERMINE THE COMPLETENESS/APPROPRIATENESS/RELEVANCE OF THE INFORMATION IN RESPECT TO THEIR PARTICULAR RESPONSIBILITY.

GRADY+CORAZZA ARCHITECTS INC. SHALL NOT BE RESPONSIBLE FOR:


- 1. ERRORS, OMISSIONS, INCOMPLETENESS DUE TO LOSS OF INFORMATION IN WHOLE OR PART WHEN INFORMATION IS TRANSFERRED.
- 2. TRANSMISSION OF ANY INFORMATION ON DISK TO THE RECEIVING ELECTRONIC SYSTEM WHEN INFORMATION IS TRANSFERRED.

01. SEP 18, 2019 Issued for Addendum 1
01. Apr.19.2021 issued to client
issued for revisions

RESIDENTIAL


SECOND FLOOR OVERALL PLAN

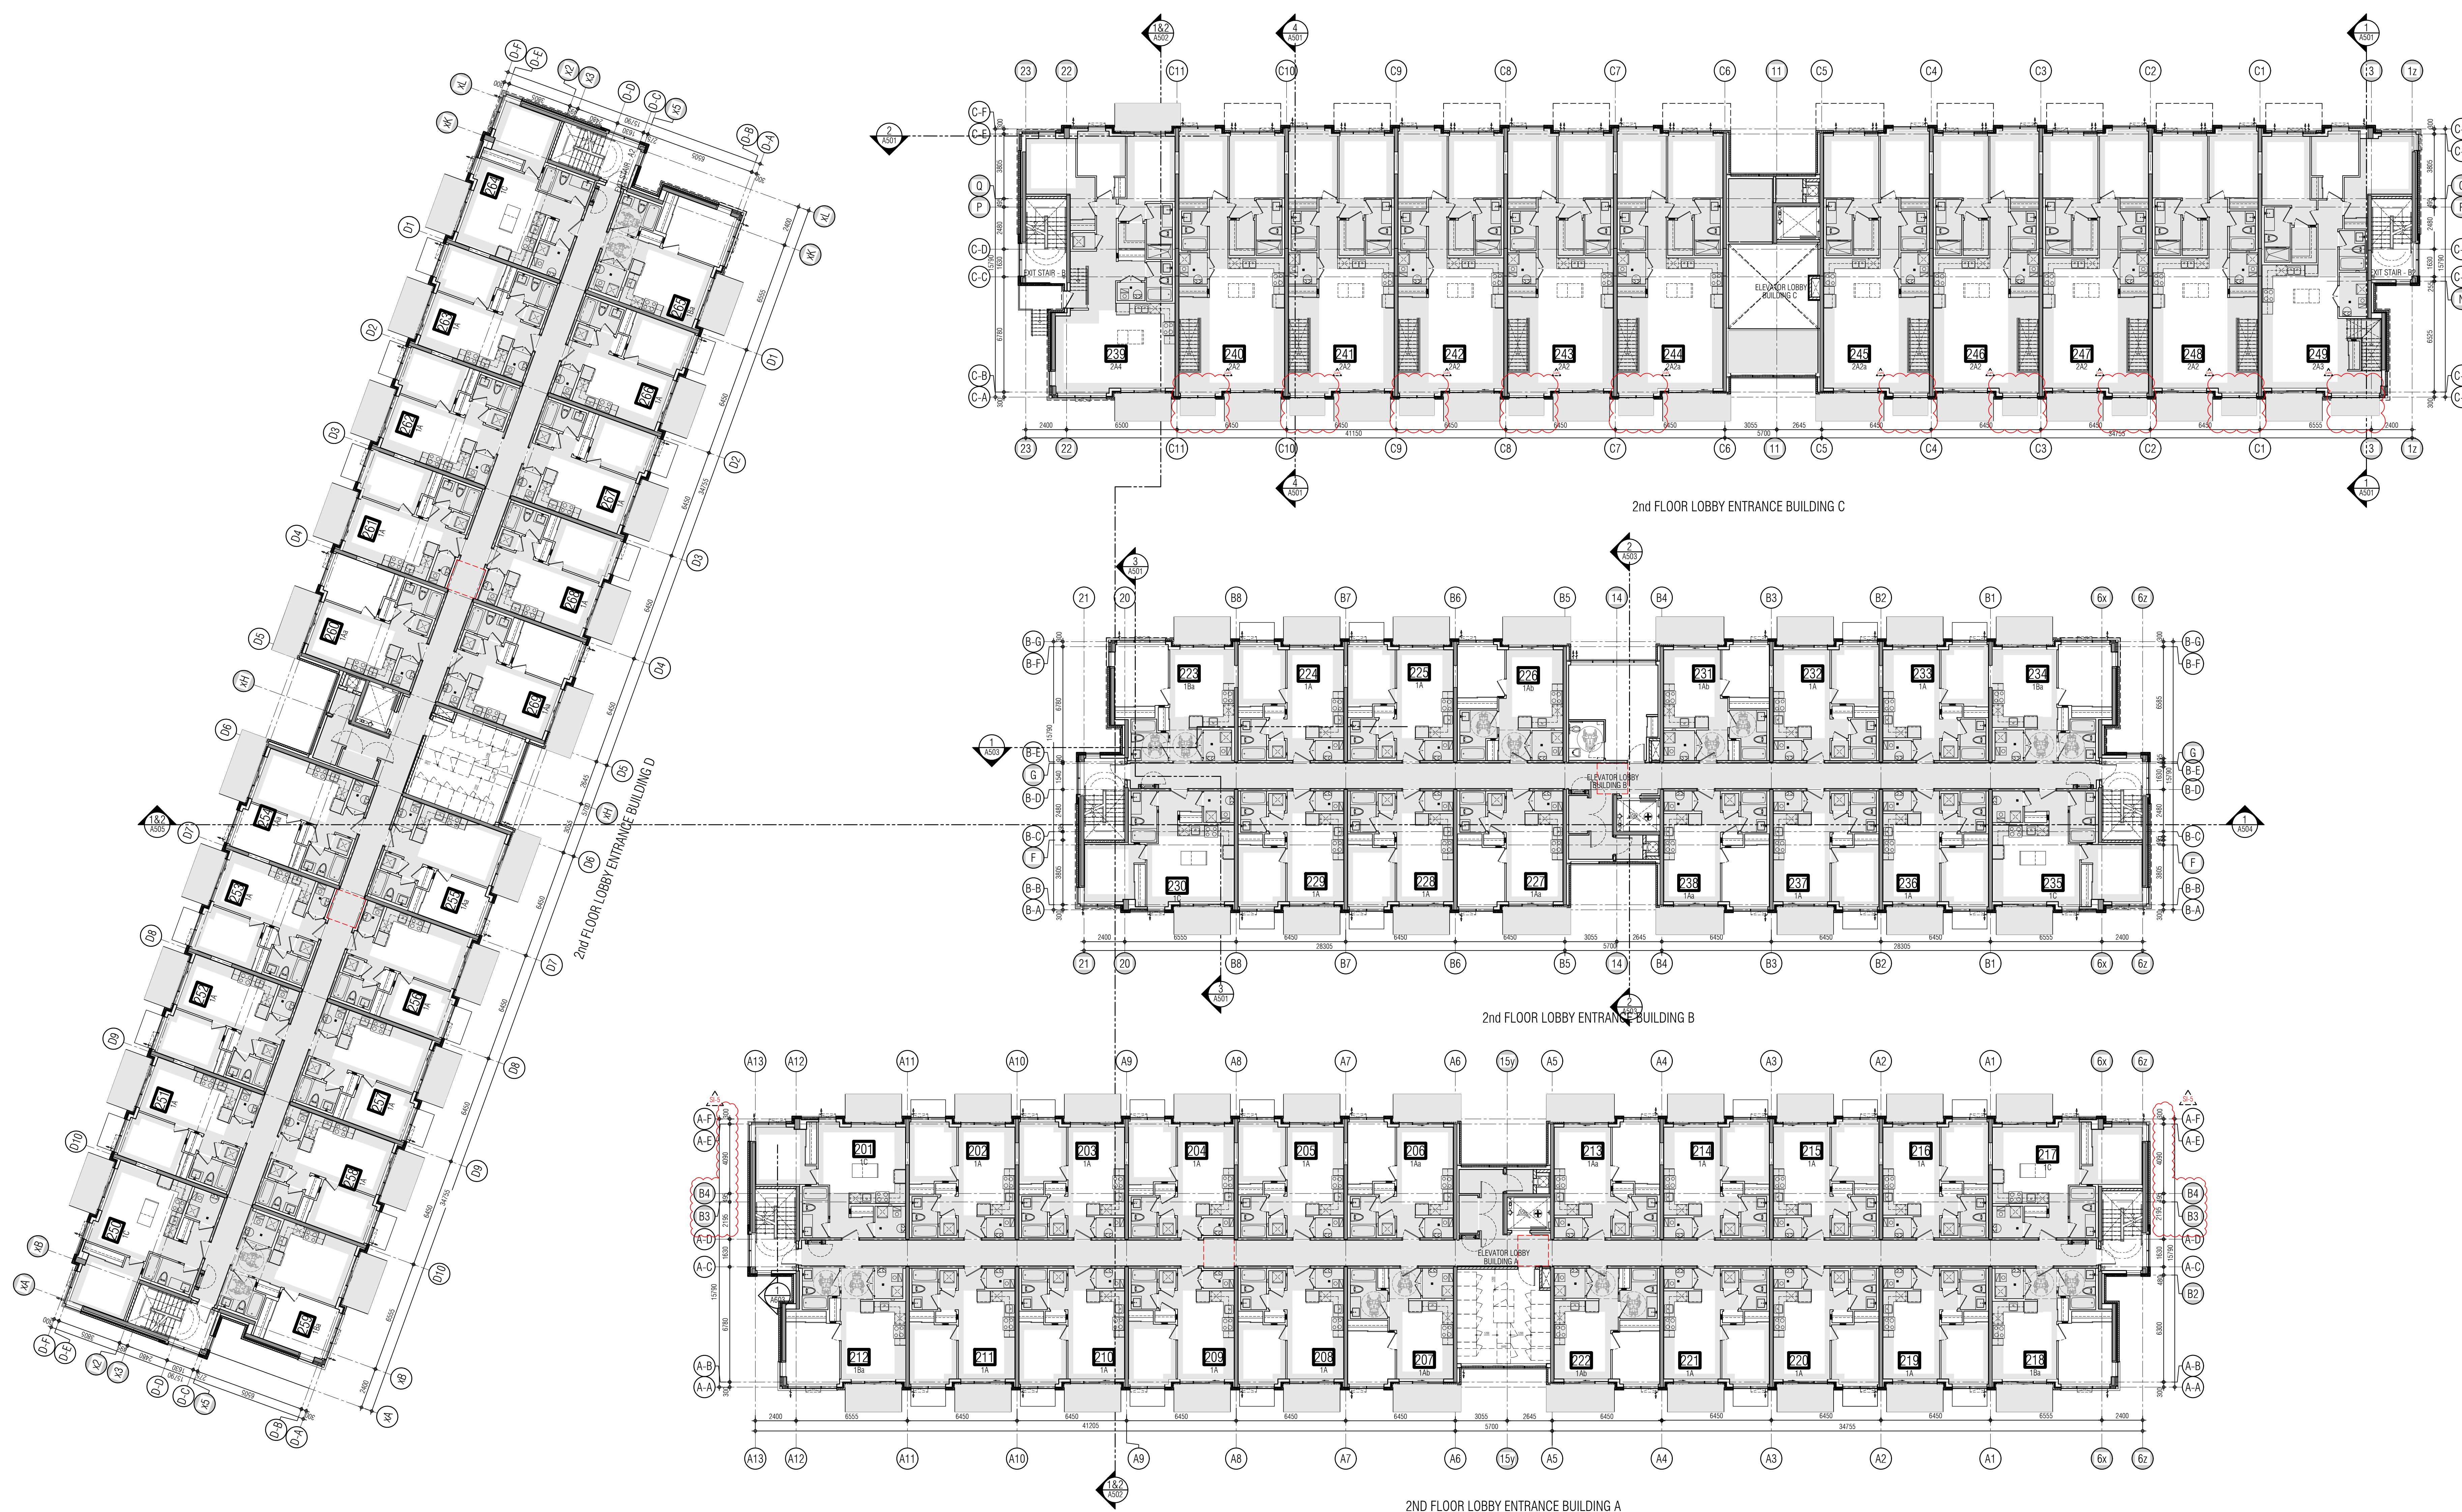

THIS DRAWING IS AN INSTRUMENT OF SERVICE, IT IS PROVIDED BY W&O IS THE PROPERTY OF GRAZIANI-CORAZZA ARCHITECTS INC. THE CONTRACTOR MUST VERIFY AND ACCEPT RESPONSIBILITY FOR ALL DIMENSIONS AND COORDINATE ON SITE AND MUST NOTIFY GRAZIANI-CORAZZA ARCHITECTS INC. OF ANY OMISSIONS FROM THE SUPPLIED INFORMATION. GRAZIANI-CORAZZA ARCHITECTS INC. IS NOT RESPONSIBLE FOR THE ACCURACY OF SURVEY, STRUCTURAL, MECHANICAL, ELECTRICAL AND OTHER ENGINEERING INFORMATION SHOWN ON THIS DRAWING. REFER TO THE APPROPRIATE ENGINEERING DRAWINGS BEFORE PROCEEDING WITH THE WORK. CONSTRUCTION MUST COMPLY TO ALL APPLICABLE CODES AND REQUIREMENTS OF THE AUTHORITIES HAVING JURISDICTION, UNLESS OTHERWISE NOTED. NO INVESTIGATION HAS BEEN UNDERTAKEN OR REPORTED IN BY THIS OFFICE IN REFERENCE TO THE ENVIRONMENTAL CONDITION OF THIS SITE.

THIS DRAWING IS NOT TO BE SCALED. ALL ARCHITECTURAL SYMBOLS INDICATED ON THIS DRAWING ARE GRAPHIC REPRESENTATIONS ONLY.

CONDITIONS FOR ELECTRONIC INFORMATION TRANSFER:

ELECTRONIC INFORMATION IS SUPPLIED TO THE OTHER ASSOCIATED FIRMS TO ASSIST THEM IN THE EXECUTION OF THEIR WORK. REVIEW THE RECEIPT FROM MUST DETERMINE THE COMPLETENESS, APPROPRIATENESS, RELIANCE OF THE INFORMATION IN RESPECT TO THEIR PARTICULAR RESPONSIBILITY.

GRAZIANI-CORAZZA ARCHITECTS INC. SHALL NOT BE RESPONSIBLE FOR ERRORS, OMISSIONS, INCOMPLETENESS DUE TO LOSS OF INFORMATION IN WHOLE OR PART WHEN INFORMATION IS TRANSMITTED.

1. TRANSMISSION OF ANY LOSS OF DAMAGE TO THE RECEIVING ELECTRONIC SYSTEM WHEN INFORMATION IS TRANSMITTED.

REF. A302a2 FOR CONTINUATION

01. Oct.07.2019 issued for tender
02. Mar.13.2020 issued for design coordination #2
03. Mar.16.2020 issued for addendum #2
04. Mar.16.2020 issued for addendum #3
05. Aug.24.2020 issued for addendum #4
06. Sept.28.2020 issued for permit
07. Oct.20.2020 issued for addendum #5
08. Nov.23.2020 issued for addendum #6
09. Dec.14.2020 issued for addendum #7
10. Jan.18.2021 issued for addendum #8
11. Mar.2.2021 issued for permit
12. Mar.09.2021 issued for addendum #9
13. Mar.10.2021 issued for addendum #9R
14. May.26.2021 issued for progress
15. May.14.2021 issued for Site Instruction #1
16. June.15.2021 issued for Site Instruction #2
17. July.7.2021 re-issued for permit
18. July.15.2021 issued for Site Instruction #3
19. July.27.2021 issued for Site Instruction #4
20. Aug.3.2021 issued for Site Instruction #5
21. Aug.5.2021 issued for Site Instruction #6

01. SEP.18.2021 issued for addendum 1

issued for revisions

GRAZIANI CORAZZA ARCHITECTS

1333 SANDWICH DRIVE, SUITE 100 MISSISSAUGA, ONTARIO L4W 1C3
905.760.2001 F.905.760.2000 WWW.GC-ARCHITECTS.COM

RESIDENTIAL

ATTMARR + PALLESCHI DRIVE

BRAMPTON ONTARIO

PROJECT ARCHITECT: B. GRAZIANI

ASSISTANT DESIGNER: R. LINCOLN

DRAWN BY: G.C./F.C./M.B.

CHECKED BY: D. BIASE/G. COLANGELO


PILOT DATE: AUG.18.2021

JOB # 1331.15

SECOND FLOOR PLAN
BUILDING A (PARTIAL PLAN)

1:50 A-302a1

TITLE BLOCK SIZE: 915 x 1200

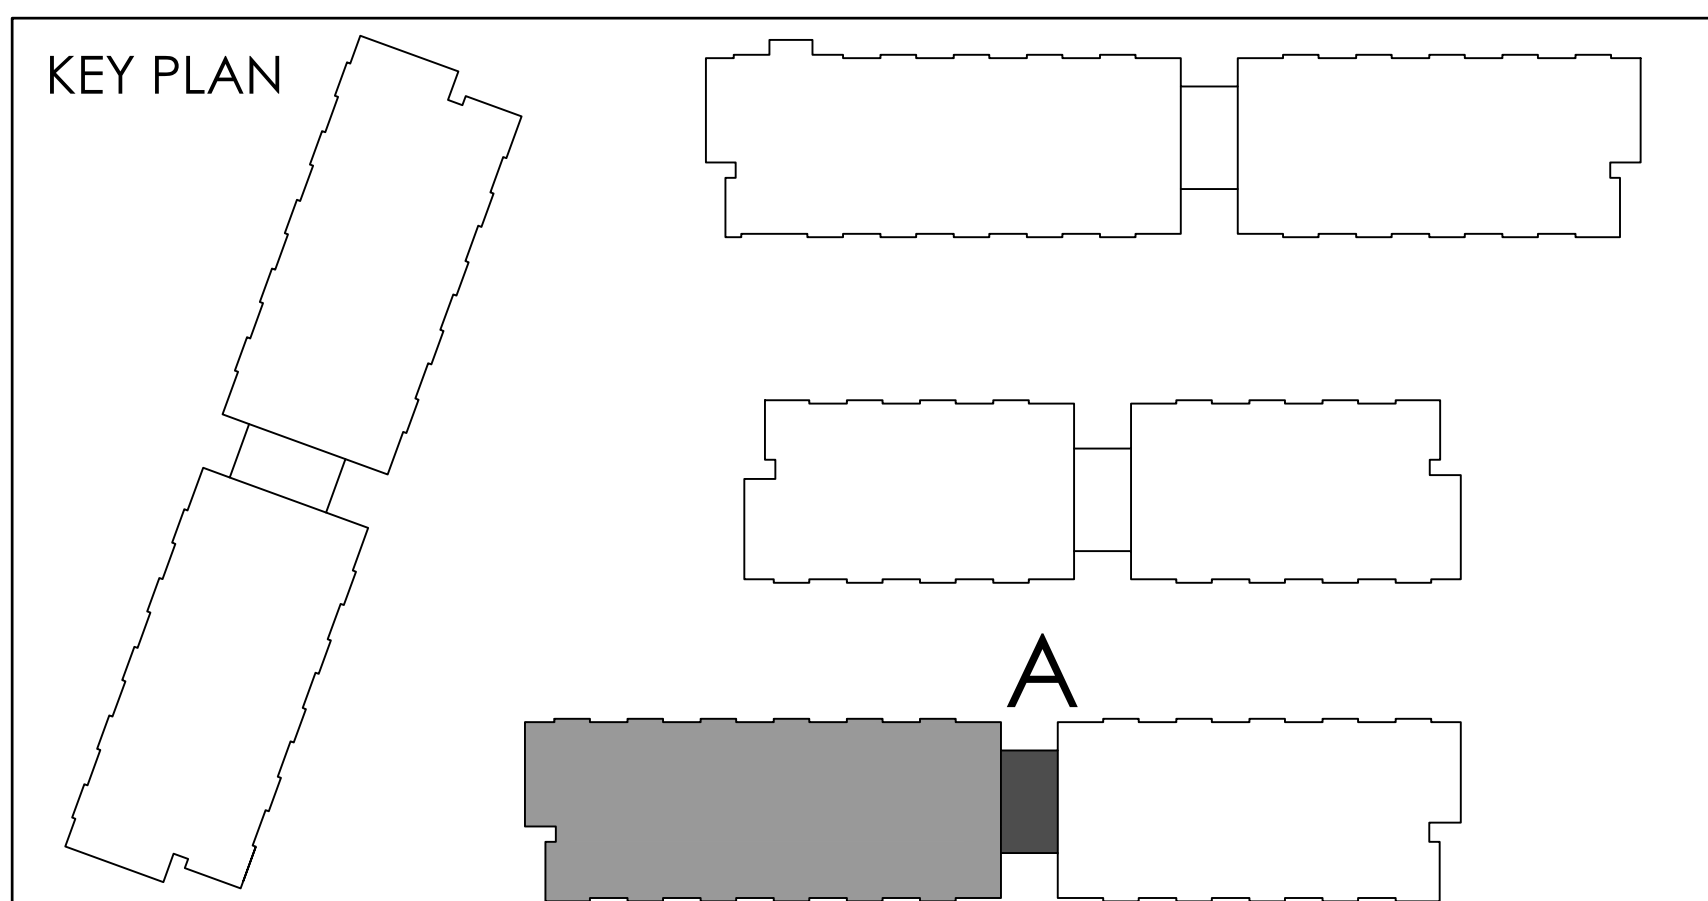

REF.A302d1 FOR CONTINUATION



THIS DRAWING IS AN INSTRUMENT OF SERVICE, IT IS PROVIDED BY AND IS THE PROPERTY OF GRAZIANI-CORAZZA ARCHITECTS INC. THE CONTRACTOR MUST VERIFY AND ACCEPT RESPONSIBILITY FOR ALL DIMENSIONS AND CONDITIONS AND SHALL BE RESPONSIBLE FOR ANY DIMENSIONS AND CONDITIONS NOT SHOWN ON THE DRAWING. GRAZIANI-CORAZZA ARCHITECTS INC. IS NOT RESPONSIBLE FOR THE ACCURACY OF SURVEY, STRUCTURAL, MECHANICAL, ELECTRICAL, AND OTHER ENGINEERING INFORMATION SHOWN ON THIS DRAWING. REFER TO THE APPROPRIATE ENGINEERING DRAWINGS BEFORE PROCEEDING WITH THE WORK. CONSTRUCTION MUST COMPLY TO ALL APPLICABLE CODES AND REQUIREMENTS OF THE AUTHORITY HAVING JURISDICTION. UNLESS OTHERWISE NOTED, NO MODIFICATION HAS BEEN MADE TO THE INFORMATION IN THIS OFFICE IN REGARD TO THE ENVIRONMENTAL CONDITION OF THIS SITE. THIS DRAWING IS NOT TO BE SCALED. ALL ARCHITECTURAL SYMBOLS INDICATED ON THIS DRAWING ARE GRAPHIC REPRESENTATIONS ONLY.

CONDITIONS FOR ELECTRONIC INFORMATION TRANSFER:

ELECTRONIC INFORMATION IS SUPPLIED TO THE OTHER ASSOCIATED FIRMS TO ASSIST THEM IN THE EXECUTION OF THEIR WORK. REVIEW THE RECEIVED FIRMS MUST DETERMINE THE COMPLETENESS, APPROPRIATENESS, RELIABILITY OF THE INFORMATION IN RESPECT TO THEIR PARTICULAR RESPONSIBILITY.

GRAZIANI-CORAZZA ARCHITECTS INC. SHALL NOT BE RESPONSIBLE FOR: 1. ERROR, OMISSION, INCOMPLETENESS DUE TO LOSS OF INFORMATION IN WHICH NO PART OF INFORMATION IS TRANSMITTED. 2. TRANSMISSION OF ANY LOSS OR DAMAGE TO THE RECEIVING ELECTRONIC SYSTEM WHEN INFORMATION IS TRANSMITTED.

- 01. Oct.07.2019 issued for tender
- 02. Mar.13.2020 issued for design coordination #2
- 03. Mar.16.2020 issued for addendum #2
- 04. Mar.16.2020 issued for addendum #3
- 05. Aug.24.2020 issued for addendum #4
- 06. Sept. 28.2020 issued for permit
- 07. Oct.20.2020 issued for addendum #5
- 08. Nov.23.2020 issued for addendum #6
- 09. Dec.14.2020 issued for addendum #7
- 10. Jan.18.2021 issued for addendum #8
- 11. Mar. 2. 2021 issued for permit
- 12. Mar.09.2021 issued for addendum #9
- 13. Mar.10.2021 issued for addendum #9R
- 14. Mar.26.2021 issued for progress
- 15. May.14.2021 issued for Site Instruction #1
- 16. June.15.2021 issued for Site Instruction #2
- 17. July. 7. 2021 re-issued for permit
- 18. July.15.2021 issued for Site Instruction #3
- 19. July. 27. 2021 issued for Site Instruction #4
- 20. Aug. 3. 2021 issued for Site Instruction #5
- 21. Aug. 5. 2021 issued for Site Instruction #6

- 01. SEP.18/2021 issued for revisions



ATTMAR + PALLESCCHI DRIVE

BRAMPTON ONTARIO

PROJECT ARCHITECT: B. GRAZIANI

ASSISTANT DESIGNER: R. LINCOLN

DRAWN BY: G.C./F.C./M.B.

CHECKED BY: D. BIASE/G. COLANGELO


PLANT DATE: AUG.18.2021

JOB # 1331.15

SECOND FLOOR PLAN
BUILDING A (PARTIAL PLAN)

1:50 A-302a2

TITLEBLOCK SIZE: 915 x 1200

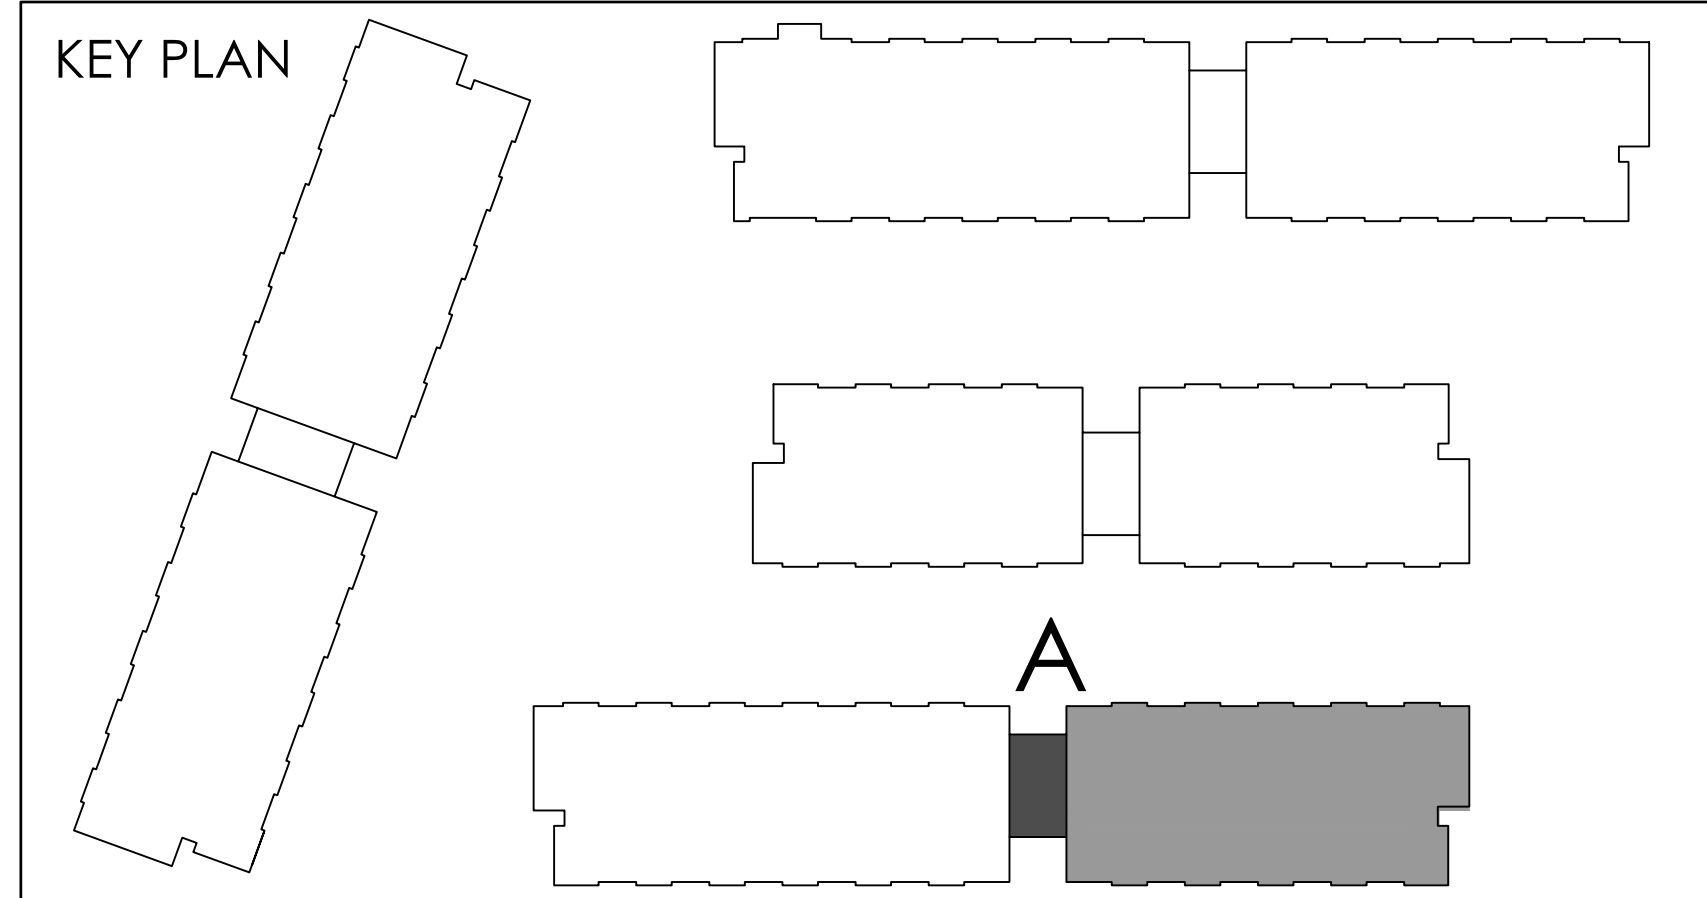

THIS DRAWING IS AN INSTRUMENT OF SERVICE, IT IS PROVIDED BY AND IS THE PROPERTY OF GRAZIANI-CORAZZA ARCHITECTS INC. THE CONTRACTOR MUST VERIFY AND ACCEPT RESPONSIBILITY FOR ALL DIMENSIONS AND COORDINATIONS. THE CONTRACTOR MUST NOT REPRODUCE OR TRANSMIT THIS DRAWING OR ANY INFORMATION HEREIN TO ANY OTHER PARTY WITHOUT THE WRITTEN PERMISSION OF GRAZIANI-CORAZZA ARCHITECTS INC. IT IS NOT RESPONSIBLE FOR THE ACCURACY OF SURVEY, STRUCTURAL, MECHANICAL, ELECTRICAL, AND OTHER ENGINEERING INFORMATION SHOWN ON THIS DRAWING. REFER TO THE APPROPRIATE ENGINEERING DRAWINGS BEFORE PROCEEDING WITH THE WORK. CONSTRUCTION MUST COMPLY TO ALL APPLICABLE CODES AND REQUIREMENTS OF THE AUTHORITY HAVING JURISDICTION. UNLESS OTHERWISE NOTED, NO MODIFICATION HAS BEEN MADE TO THE INFORMATION IN THIS OFFICE IN REGARDS TO THE ENVIRONMENTAL CONDITION OF THIS SITE.


THIS DRAWING IS NOT TO BE SCALED. ALL ARCHITECTURAL SYMBOLS INDICATED ON THIS DRAWING ARE GRAPHIC REPRESENTATIONS ONLY.

CONDITIONS FOR ELECTRONIC INFORMATION TRANSFER

ELECTRONIC INFORMATION IS SUPPLIED TO THE OTHER ASSOCIATED FIRMS TO ASSIST THEM IN THE EXECUTION OF THEIR WORK. REVIEW THE RECIPIENT FIRMS MUST DETERMINE THE COMPLETENESS, APPROPRIATENESS, RELIANCE OF THE INFORMATION IN RESPECT TO THEIR PARTICULAR RESPONSIBILITY.

GRAZIANI-CORAZZA ARCHITECTS INC. SHALL NOT BE RESPONSIBLE FOR ERRORS, OMISSIONS, INCOMPLETENESS DUE TO LOSS OF INFORMATION IN WHOLE OR PART WHEN INFORMATION IS TRANSMITTED.

1. TRANSMISSION OF ANY VIRUS OR DAMAGE TO THE RECEIVING ELECTRONIC SYSTEM WHEN INFORMATION IS TRANSMITTED.

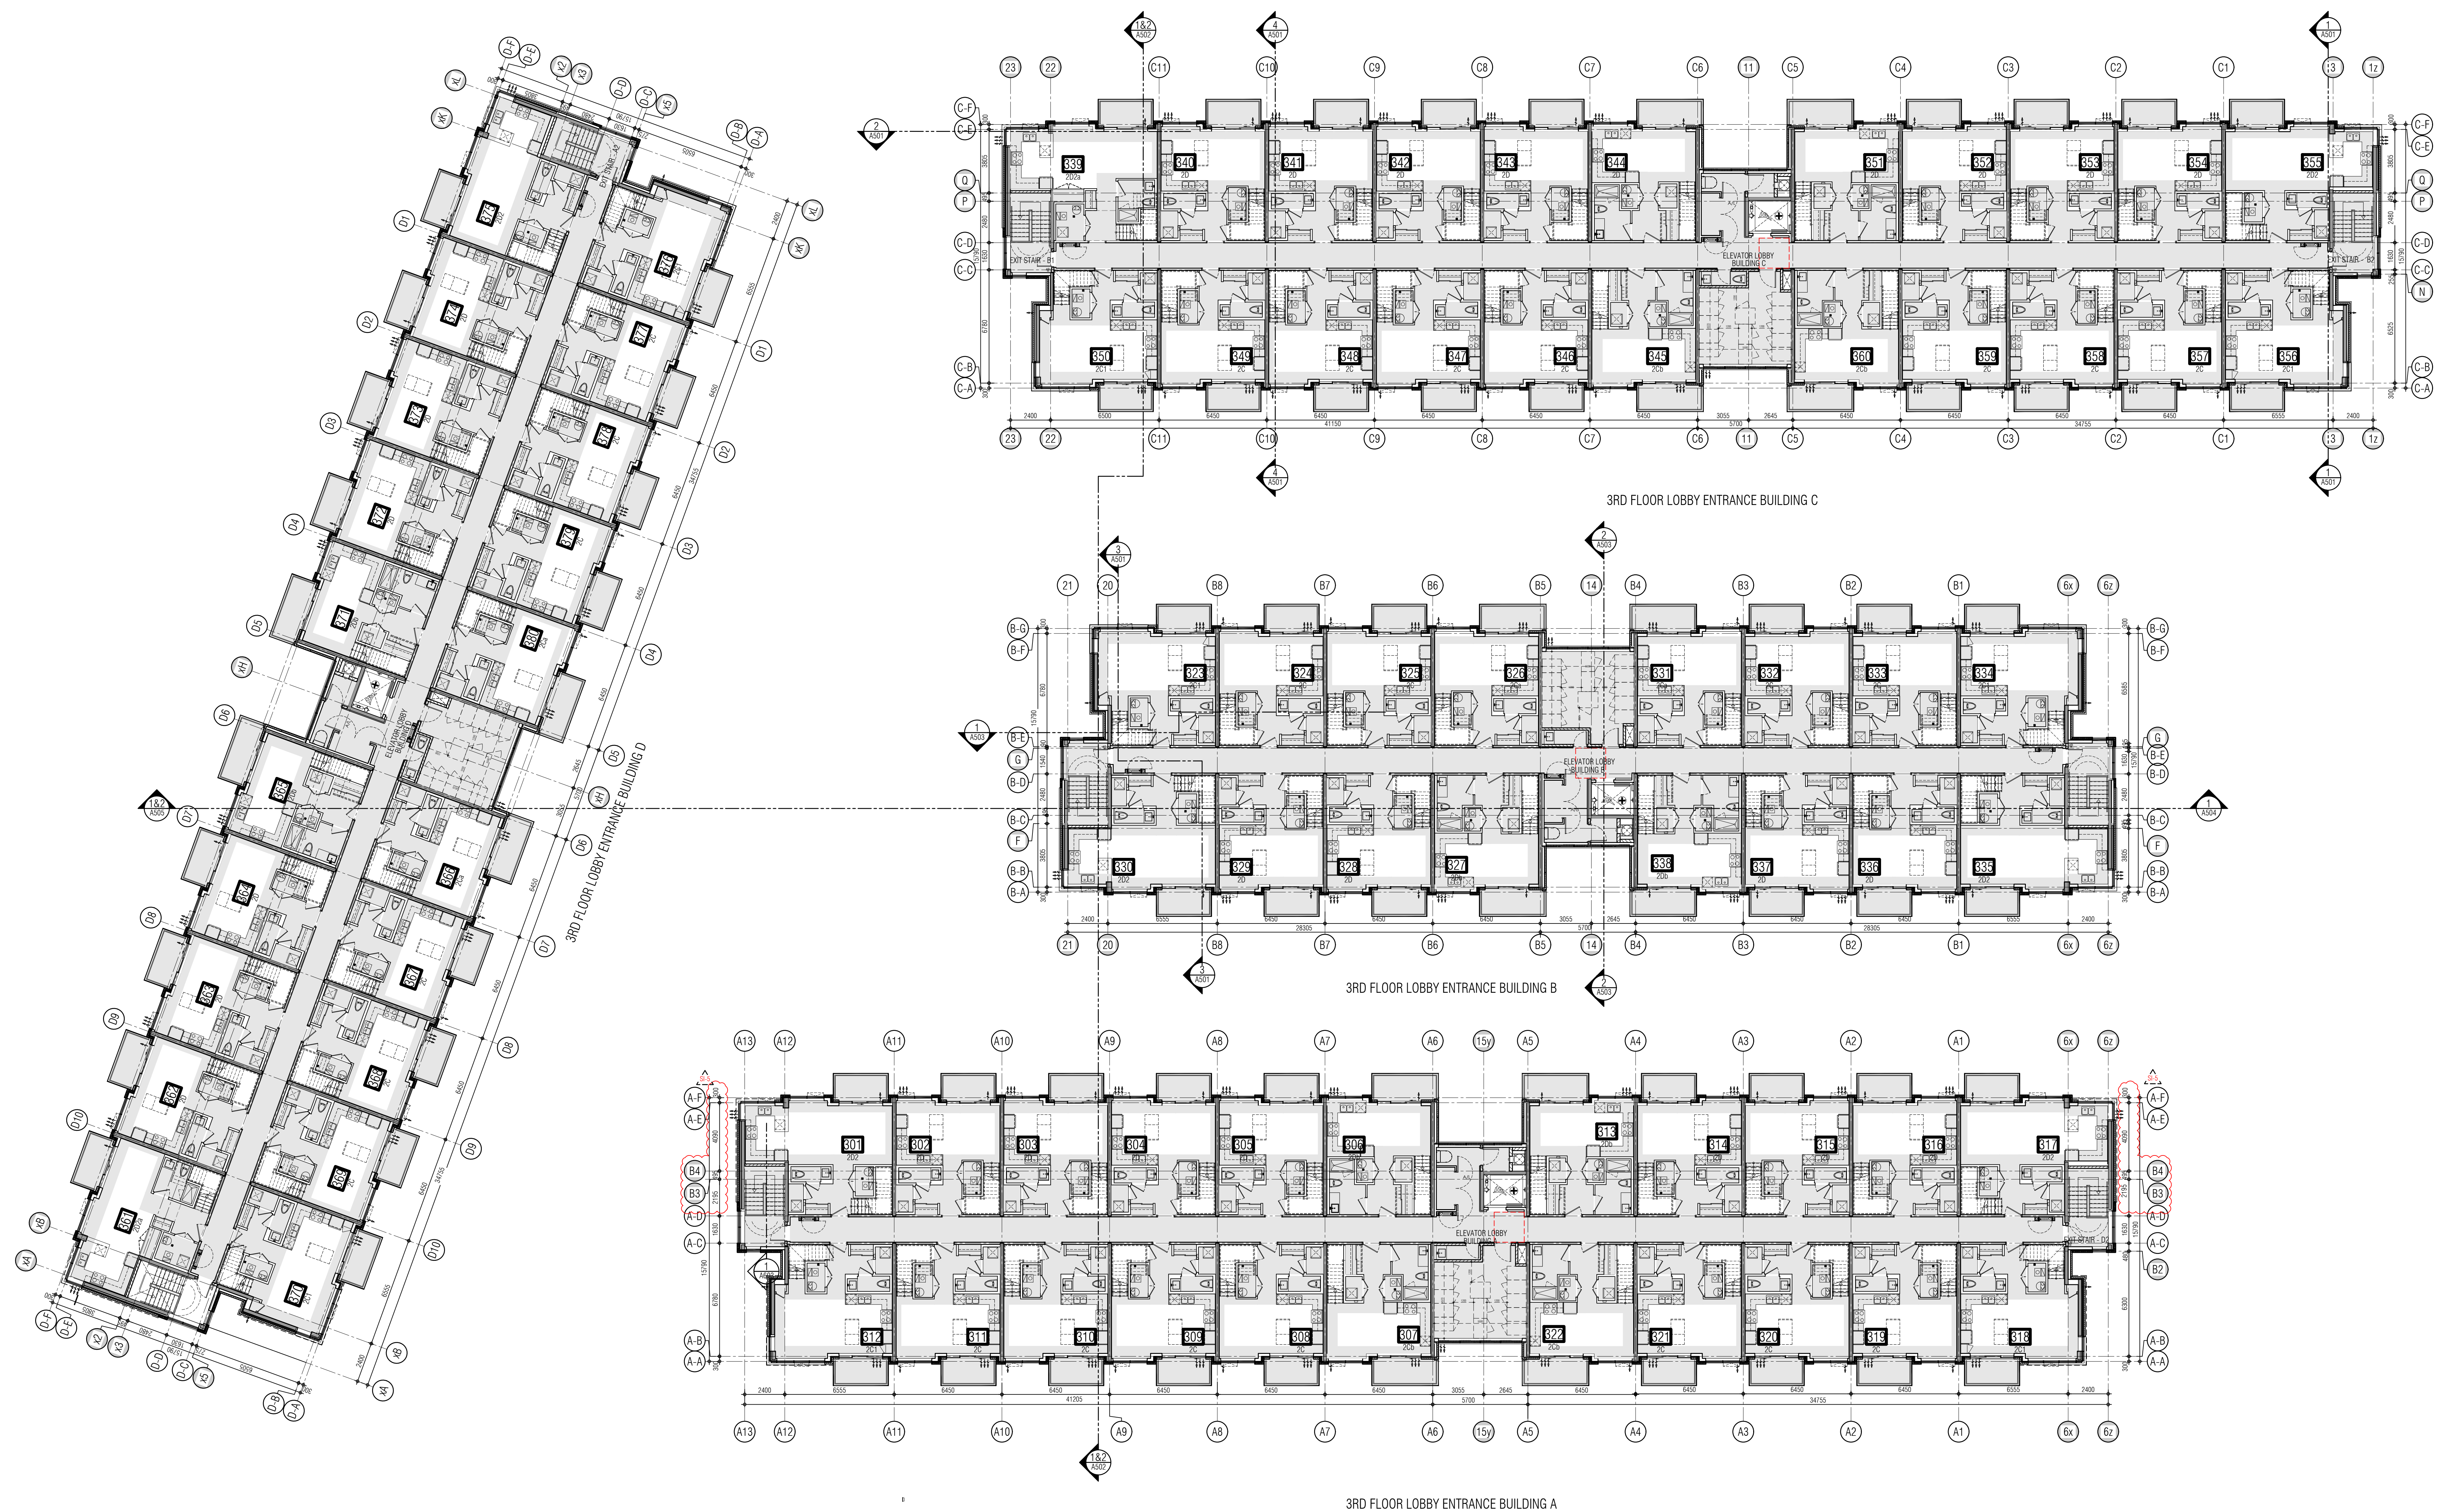

- 01. Oct.07.2019 issued for tender
- 02. Mar.13.2020 issued for design coordination #2
- 03. Mar.16.2020 issued for addendum #2
- 04. Mar.16.2020 issued for addendum #3
- 05. Aug.24.2020 issued for addendum #4
- 06. Sept.28.2020 issued for permit
- 07. Oct.20.2020 issued for addendum #5
- 08. Nov.23.2020 issued for addendum #6
- 09. Dec.14.2020 issued for addendum #7
- 10. Jan.15.2021 issued for addendum #8
- 11. Mar.2.2021 issued for permit
- 12. Mar.09.2021 issued for addendum #9
- 13. Mar.10.2021 issued for addendum #9R
- 14. Mar.26.2021 issued for progress
- 15. May.14.2021 issued for Site Instruction #1
- 16. June.15.2021 issued for Site Instruction #2
- 17. July.7.2021 re-issued for permit
- 18. July.15.2021 issued for Site Instruction #3
- 19. July.27.2021 issued for Site Instruction #4
- 20. Aug.3.2021 issued for Site Instruction #5
- 21. Aug.5.2021 issued for Site Instruction #6

- 01. SEP.18.2019 issued for Addendum 1
 - 01. Apr.19.2021 issued to client
- issued for revisions

GRAZIANI CORAZZA ARCHITECTS

1330 SHEARBRIDGE DRIVE, SUITE 100 MISSISSAUGA, ONTARIO L4B 1C3
905.760.7001 P.905.760.7000 WWW.GC-ARCHITECTS.COM

ATTMAR + PALLESCHI DRIVE

BRAMPTON ONTARIO

PROJECT ARCHITECT: B.GRAZIANI
ASSISTANT DESIGNER: R.LINCOLN
DRAWN BY: G.C./F.C./M.B.
CHECKED BY: D.BIASSE/G.COLANGELO
PLOT DATE: AUG.18.2021
JOB #1331.15

THIRD FLOOR OVERALL PLAN

THIS DRAWING IS NOT TO BE SCALED. ALL ARCHITECTURAL SYMBOLS INDICATED ON THIS DRAWING ARE GRAPHIC REPRESENTATIONS ONLY.


CONDITIONS FOR ELECTRONIC INFORMATION TRANSFER:




2. TRANSMISSION OF ANY VIRUS OR DAMAGE TO THE RECEIVING ELECTRONIC SYSTEM WHEN INFORMATION IS TRANSFERRED.


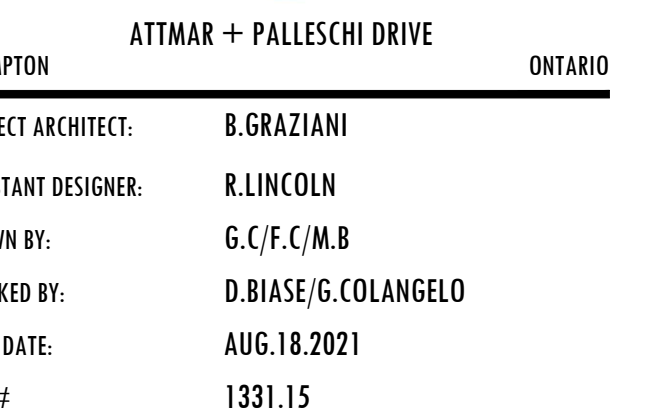

1:50 **A-303a1**

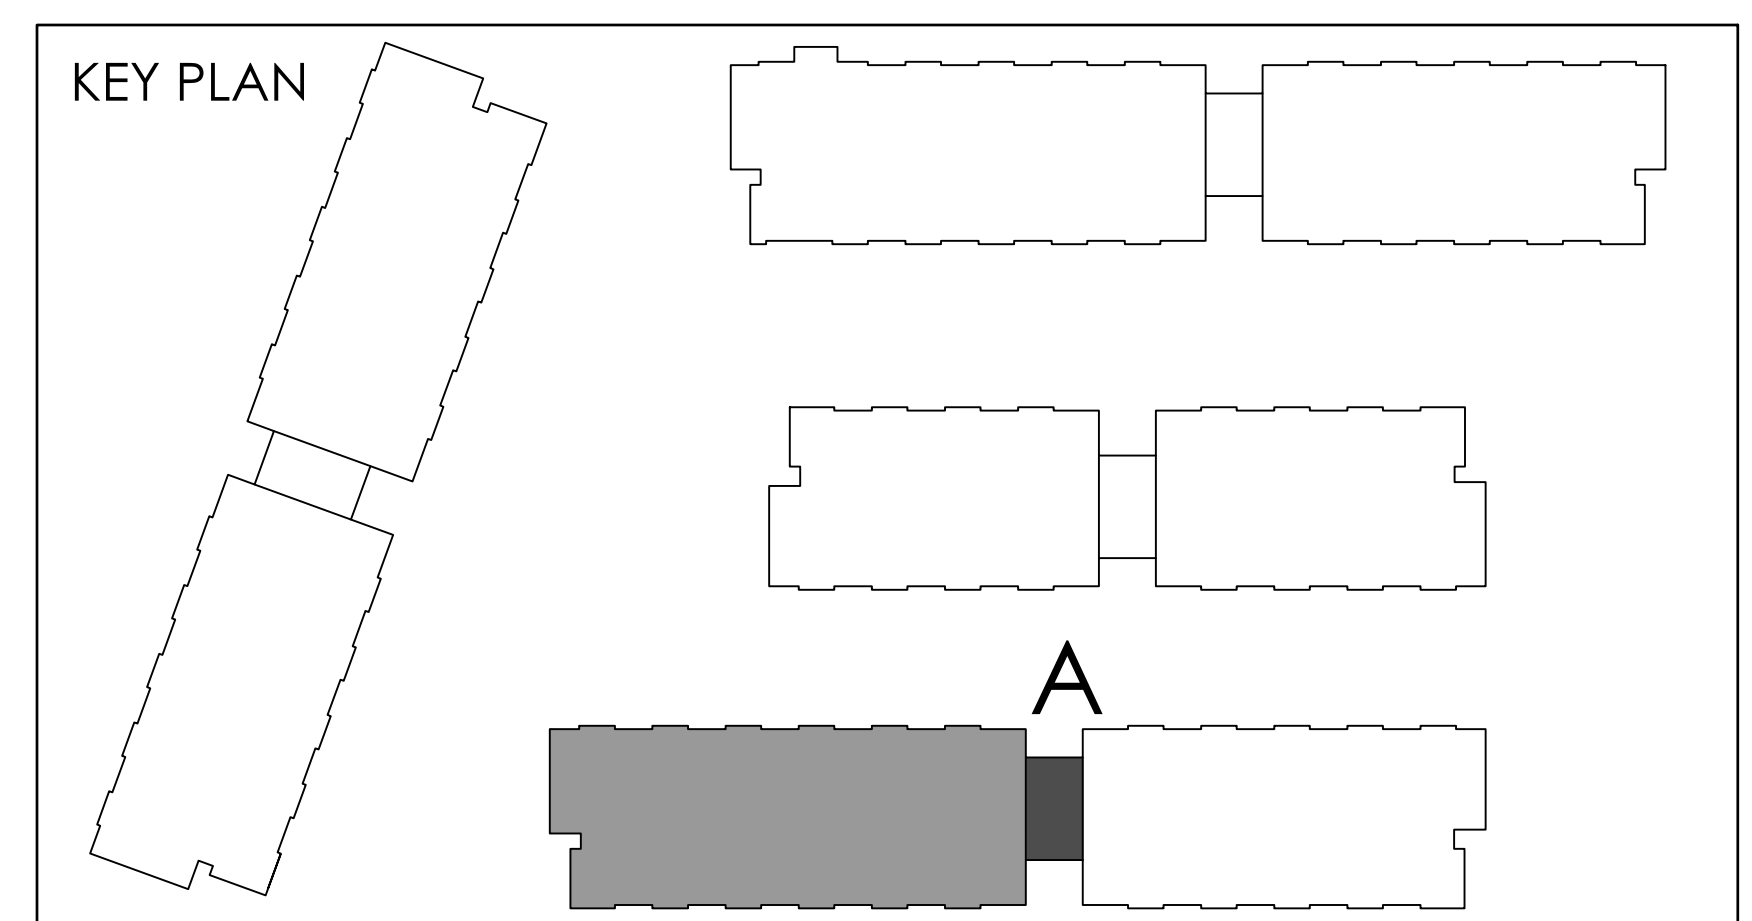

REF.A303d1 FOR CONTINUATION



01. Oct.07.2019 issued for tender
02. Mar.13.2020 issued for design coordination #2
03. Mar.16.2020 issued for addendum #2
04. Mar.16.2020 issued for addendum #3
05. Aug.24.2020 issued for addendum #4
06. Sept.28.2020 issued for permit
07. Oct.20.2020 issued for addendum #5
08. Nov.23.2020 issued for addendum #6
09. Dec.14.2020 issued for addendum #7
10. Jan.15.2021 issued for addendum #8
11. Mar.2.2021 issued for permit
12. Mar.09.2021 issued for addendum #9
13. Mar.10.2021 issued for addendum #9R
14. Mar.26.2021 issued for progress
15. May.14.2021 issued for Site Instruction #1
16. June.15.2021 issued for Site Instruction #2
17. July.7.2021 re-issued for permit
18. July.15.2021 issued for Site Instruction #3
19. July.27.2021 issued for Site Instruction #4
20. Aug.3.2021 issued for Site Instruction #5
21. Aug.5.2021 issued for Site Instruction #6

01. SEP.18.2021 issued for addendum 1
- issued for revisions

GRAZIANI CORAZZA ARCHITECTS

1333 SHAWANAGUA DRIVE, SUITE 100 MISSISSAUGA, ONTARIO L4W 1C3
905.709.7001 P.905.709.7000 WWW.GC-ARCHITECTS.COM

ATTMAR + PALLESCI DRIVE

BRAMPTON ONTARIO

PROJECT ARCHITECT: B. GRAZIANI

ASSISTANT DESIGNER: R. LINCOLN

DRAWN BY: G.C./F.C./M.B.

CHECKED BY: D. BIASE/G. COLANGELO

PLOT DATE: AUG.18.2021

JOB #: 1331.15

THIRD FLOOR PLAN

BUILDING A (PARTIAL PLAN)

1:50 A-303a2

TITLEBLOCK SIZE: 915 x 1200

THIS DRAWING AS AN INSTRUMENT OF SERVICE, IS PROVIDED BY AND IS THE PROPERTY OF GRAZIANI-CORAZZA ARCHITECTS INC. THE CONTRACTOR MUST VERIFY AND ACCEPT RESPONSIBILITY FOR ALL DIMENSIONS AND COORDINATE THE SITE AND MUST NOTIFY GRAZIANI-CORAZZA ARCHITECTS INC. OF ANY VARIATIONS FROM THE SUPPLIED INFORMATION. GRAZIANI-CORAZZA ARCHITECTS INC. IS NOT RESPONSIBLE FOR THE ACCURACY OF SURVEY, STRUCTURAL, MECHANICAL, ELECTRICAL, AND OTHER ENGINEERING INFORMATION SHOWN ON THIS DRAWING. REFER TO THE APPROPRIATE ENGINEERING DRAWINGS BEFORE PROCEEDING WITH THE WORK. CONSTRUCTION MUST COMPLY TO ALL APPLICABLE CODES AND REQUIREMENTS OF THE AUTHORITY HAVING JURISDICTION, UNLESS OTHERWISE NOTED. NO MODIFICATION AND NO ADDITIONS TO BE MADE BY THIS OFFICE IN REGARDS TO THE ENVIRONMENTAL CONDITION OF THIS SITE.


THIS DRAWING IS NOT TO BE SCALED. ALL ARCHITECTURAL SYMBOLS INDICATED ON THIS DRAWING ARE GRAPHIC REPRESENTATIONS ONLY.

CONDITIONS FOR ELECTRONIC INFORMATION TRANSFER

ELECTRONIC INFORMATION IS SUPPLIED TO THE OTHER ASSOCIATED FIRMS TO ASSIST THEM IN THE EXECUTION OF THEIR WORK. REVIEW THE RECEIVING FIRMS MUST DETERMINE THE COMPLETENESS, APPROPRIATENESS, RELIANCE OF THE INFORMATION IN RESPECT TO THEIR PARTICULAR RESPONSIBILITY.

GRAZIANI-CORAZZA ARCHITECTS INC. SHALL NOT BE RESPONSIBLE FOR ERROR, OMISSIONS, INCOMPLETENESS DUE TO LOSS OF INFORMATION IN WHOLE OR PART WHEN INFORMATION IS TRANSMITTED.

1. TRANSMISSION OF ANY VIRUS OR DAMAGE TO THE RECEIVING ELECTRONIC SYSTEM WHEN INFORMATION IS TRANSMITTED.

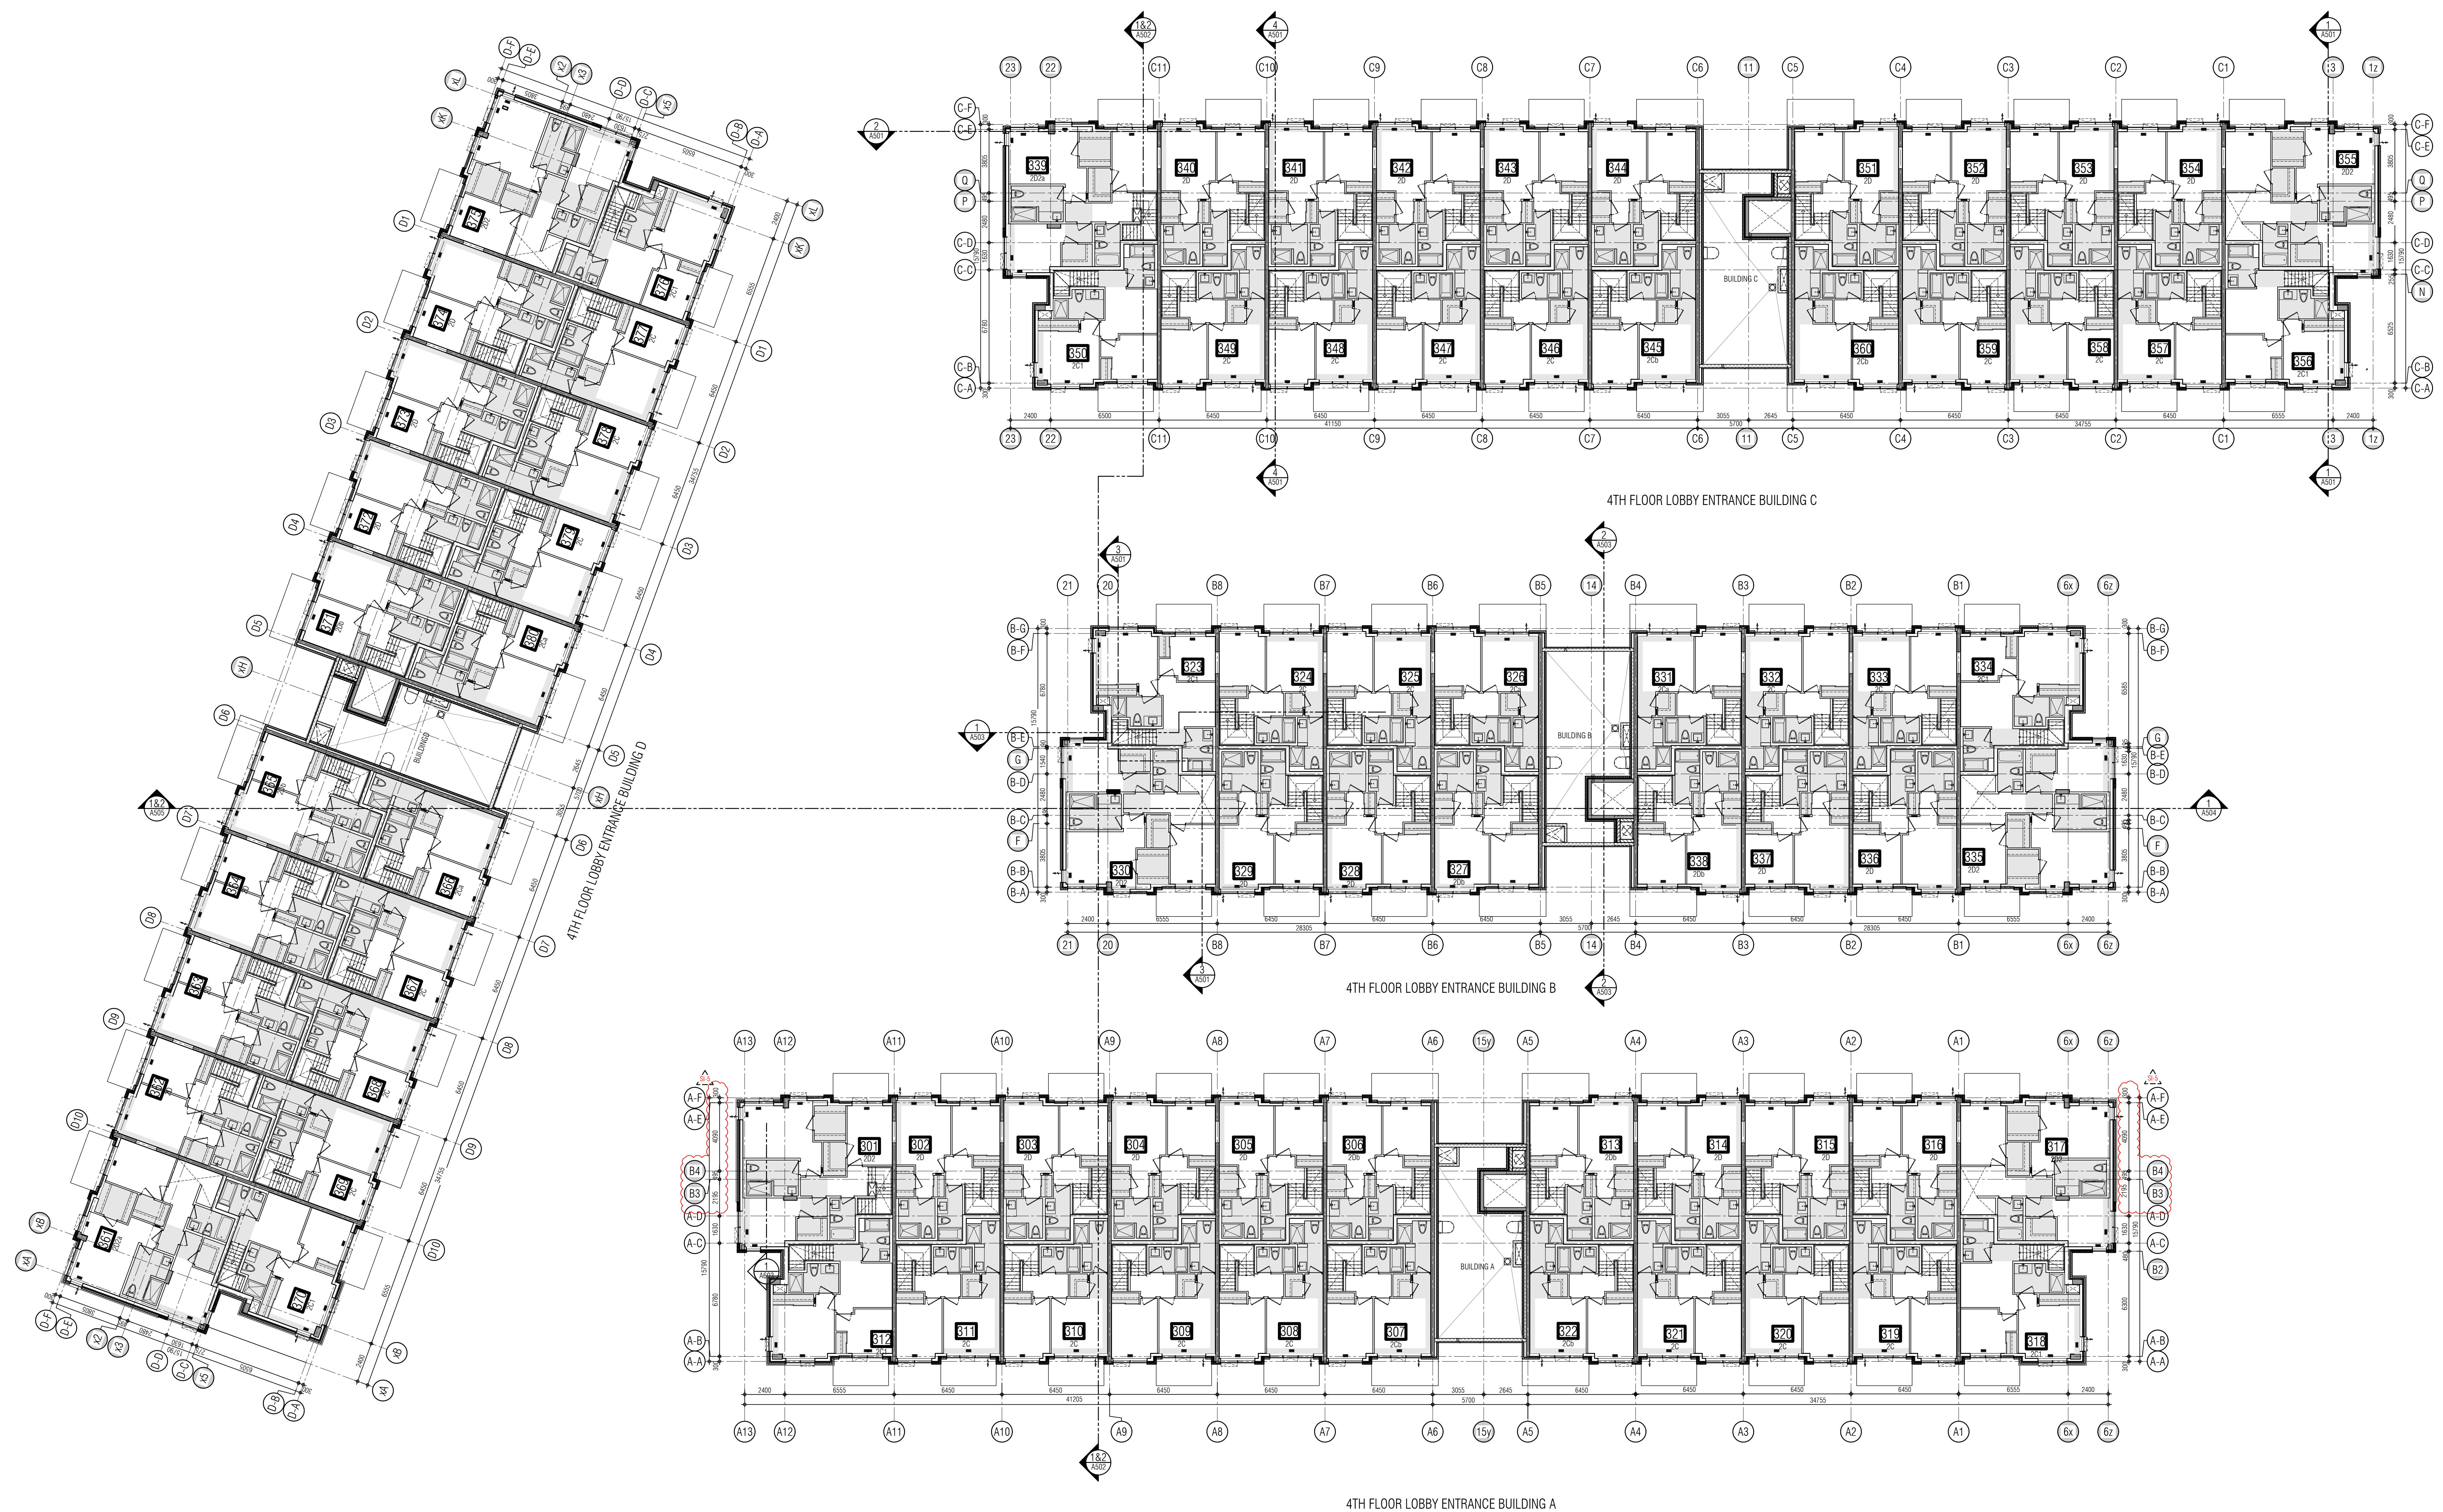

- 01. Oct.07.2019 issued for tender
- 02. Mar.13.2020 issued for design coordination #2
- 03. Mar.16.2020 issued for addendum #2
- 04. Mar.16.2020 issued for addendum #3
- 05. Aug.24.2020 issued for addendum #4
- 06. Sept.28.2020 issued for permit
- 07. Oct.20.2020 issued for addendum #5
- 08. Nov.23.2020 issued for addendum #6
- 09. Dec.14.2020 issued for addendum #7
- 10. Jan.15.2021 issued for addendum #8
- 11. Mar.2.2021 issued for permit
- 12. Mar.09.2021 issued for addendum #9
- 13. Mar.10.2021 issued for addendum #9R
- 14. Mar.26.2021 issued for progress
- 15. May.14.2021 issued for Site Instruction #1
- 16. June.15.2021 issued for Site Instruction #2
- 17. July.7.2021 re-issued for permit
- 18. July.15.2021 issued for Site Instruction #3
- 19. July.27.2021 issued for Site Instruction #4
- 20. Aug.3.2021 issued for Site Instruction #5
- 21. Aug.5.2021 issued for Site Instruction #6

- 01. Apr.19.2021 issued to client
- issued for revisions

GRAZIANI CORAZZA ARCHITECTS

1333 SHARON DRIVE, SUITE 101 MISSISSAUGA, ONTARIO L4B 1C3
905.709.7021 P.905.709.7080 WWW.GC-ARCHITECTS.COM

ATTMAR + PALLESCHI DRIVE

BRAMPTON ONTARIO

PROJECT ARCHITECT: B. GRAZIANI
ASSISTANT DESIGNER: R. LINCOLN
DRAWN BY: G. C./F. C./M. B.
CHECKED BY: D. BIASE/G. COLANGELO
PLOT DATE: AUG.18.2021
JOB # 1331.15

FORTH FLOOR OVERALL PLAN

THIS DRAWING IS AN INSTRUMENT OF SERVICE, IT IS PROVIDED BY AND IS THE PROPERTY OF GRAZIANI-CORAZZA ARCHITECTS INC. THE CONTRACTOR MUST VERIFY AND ACCEPT RESPONSIBILITY FOR ALL DIMENSIONS AND COORDINATE THE SAME WITH THE SURVEY INFORMATION. GRAZIANI-CORAZZA ARCHITECTS INC. IS NOT RESPONSIBLE FOR THE ACCURACY OF SURVEY, STRUCTURAL, MECHANICAL, ELECTRICAL AND OTHER ENGINEERING INFORMATION SHOWN ON THIS DRAWING. REFER TO THE APPROPRIATE ENGINEERING DRAWINGS BEFORE PROCEEDING WITH THE WORK. CONSTRUCTION MUST COMPLY TO ALL APPLICABLE CODES AND REQUIREMENTS OF THE AUTHORITIES HAVING JURISDICTION. UNLESS OTHERWISE NOTED, NO INVESTIGATION HAS BEEN UNDERTAKEN OR REPORTED ON BY THIS OFFICE IN REGARD TO THE ENVIRONMENTAL CONDITION OF THIS SITE.


THIS DRAWING IS NOT TO BE SCALED. ALL ARCHITECTURAL SYMBOLS INDICATED ON THIS DRAWING ARE GRAPHIC REPRESENTATIONS ONLY.

CONDITIONS FOR ELECTRONIC INFORMATION TRANSFER
ELECTRONIC INFORMATION IS SUPPLIED TO THE OTHER ASSOCIATED FIRMS TO ASSIST THEM IN THE EXECUTION OF THEIR WORK. REVIEW THE RECIPIENT FIRMS MUST DETERMINE THE COMPLETENESS, APPROPRIATENESS, RELIANCE OF THE INFORMATION IN RESPECT TO THEIR PARTICULAR RESPONSIBILITY.

GRAZIANI-CORAZZA ARCHITECTS INC. SHALL NOT BE RESPONSIBLE FOR
1. ERROR, OMISSION, INCOMPLETENESS DUE TO LOSS OF INFORMATION IN WHOLE OR PART WHEN INFORMATION IS TRANSMITTED.
2. TRANSMISSION OF ANY LOSS OR DAMAGE TO THE RECEIVING ELECTRONIC SYSTEM WHEN INFORMATION IS TRANSMITTED.

REF. A304d2 FOR CONTINUATION

01. Oct.07.2019 issued for tender
02. Mar.13.2020 issued for design coordination #2
03. Mar.16.2020 issued for addendum #2
04. Mar.16.2020 issued for addendum #3
05. Aug.24.2020 issued for addendum #4
06. Sept.28.2020 issued for permit
07. Oct.20.2020 issued for addendum #5
08. Nov.23.2020 issued for addendum #6
09. Dec.14.2020 issued for addendum #7
10. Jan.15.2021 issued for addendum #8
11. Mar.2.2021 issued for permit
12. Mar.09.2021 issued for addendum #9
13. Mar.10.2021 issued for addendum #9R
14. Mar.26.2021 issued for progress
15. May.14.2021 issued for Site Instruction #1
16. June.15.2021 issued for Site Instruction #2
17. July.7.2021 re-issued for permit
18. July.15.2021 issued for Site Instruction #3
19. July.27.2021 issued for Site Instruction #4
20. Aug.3.2021 issued for Site Instruction #5
21. Aug.5.2021 issued for Site Instruction #6

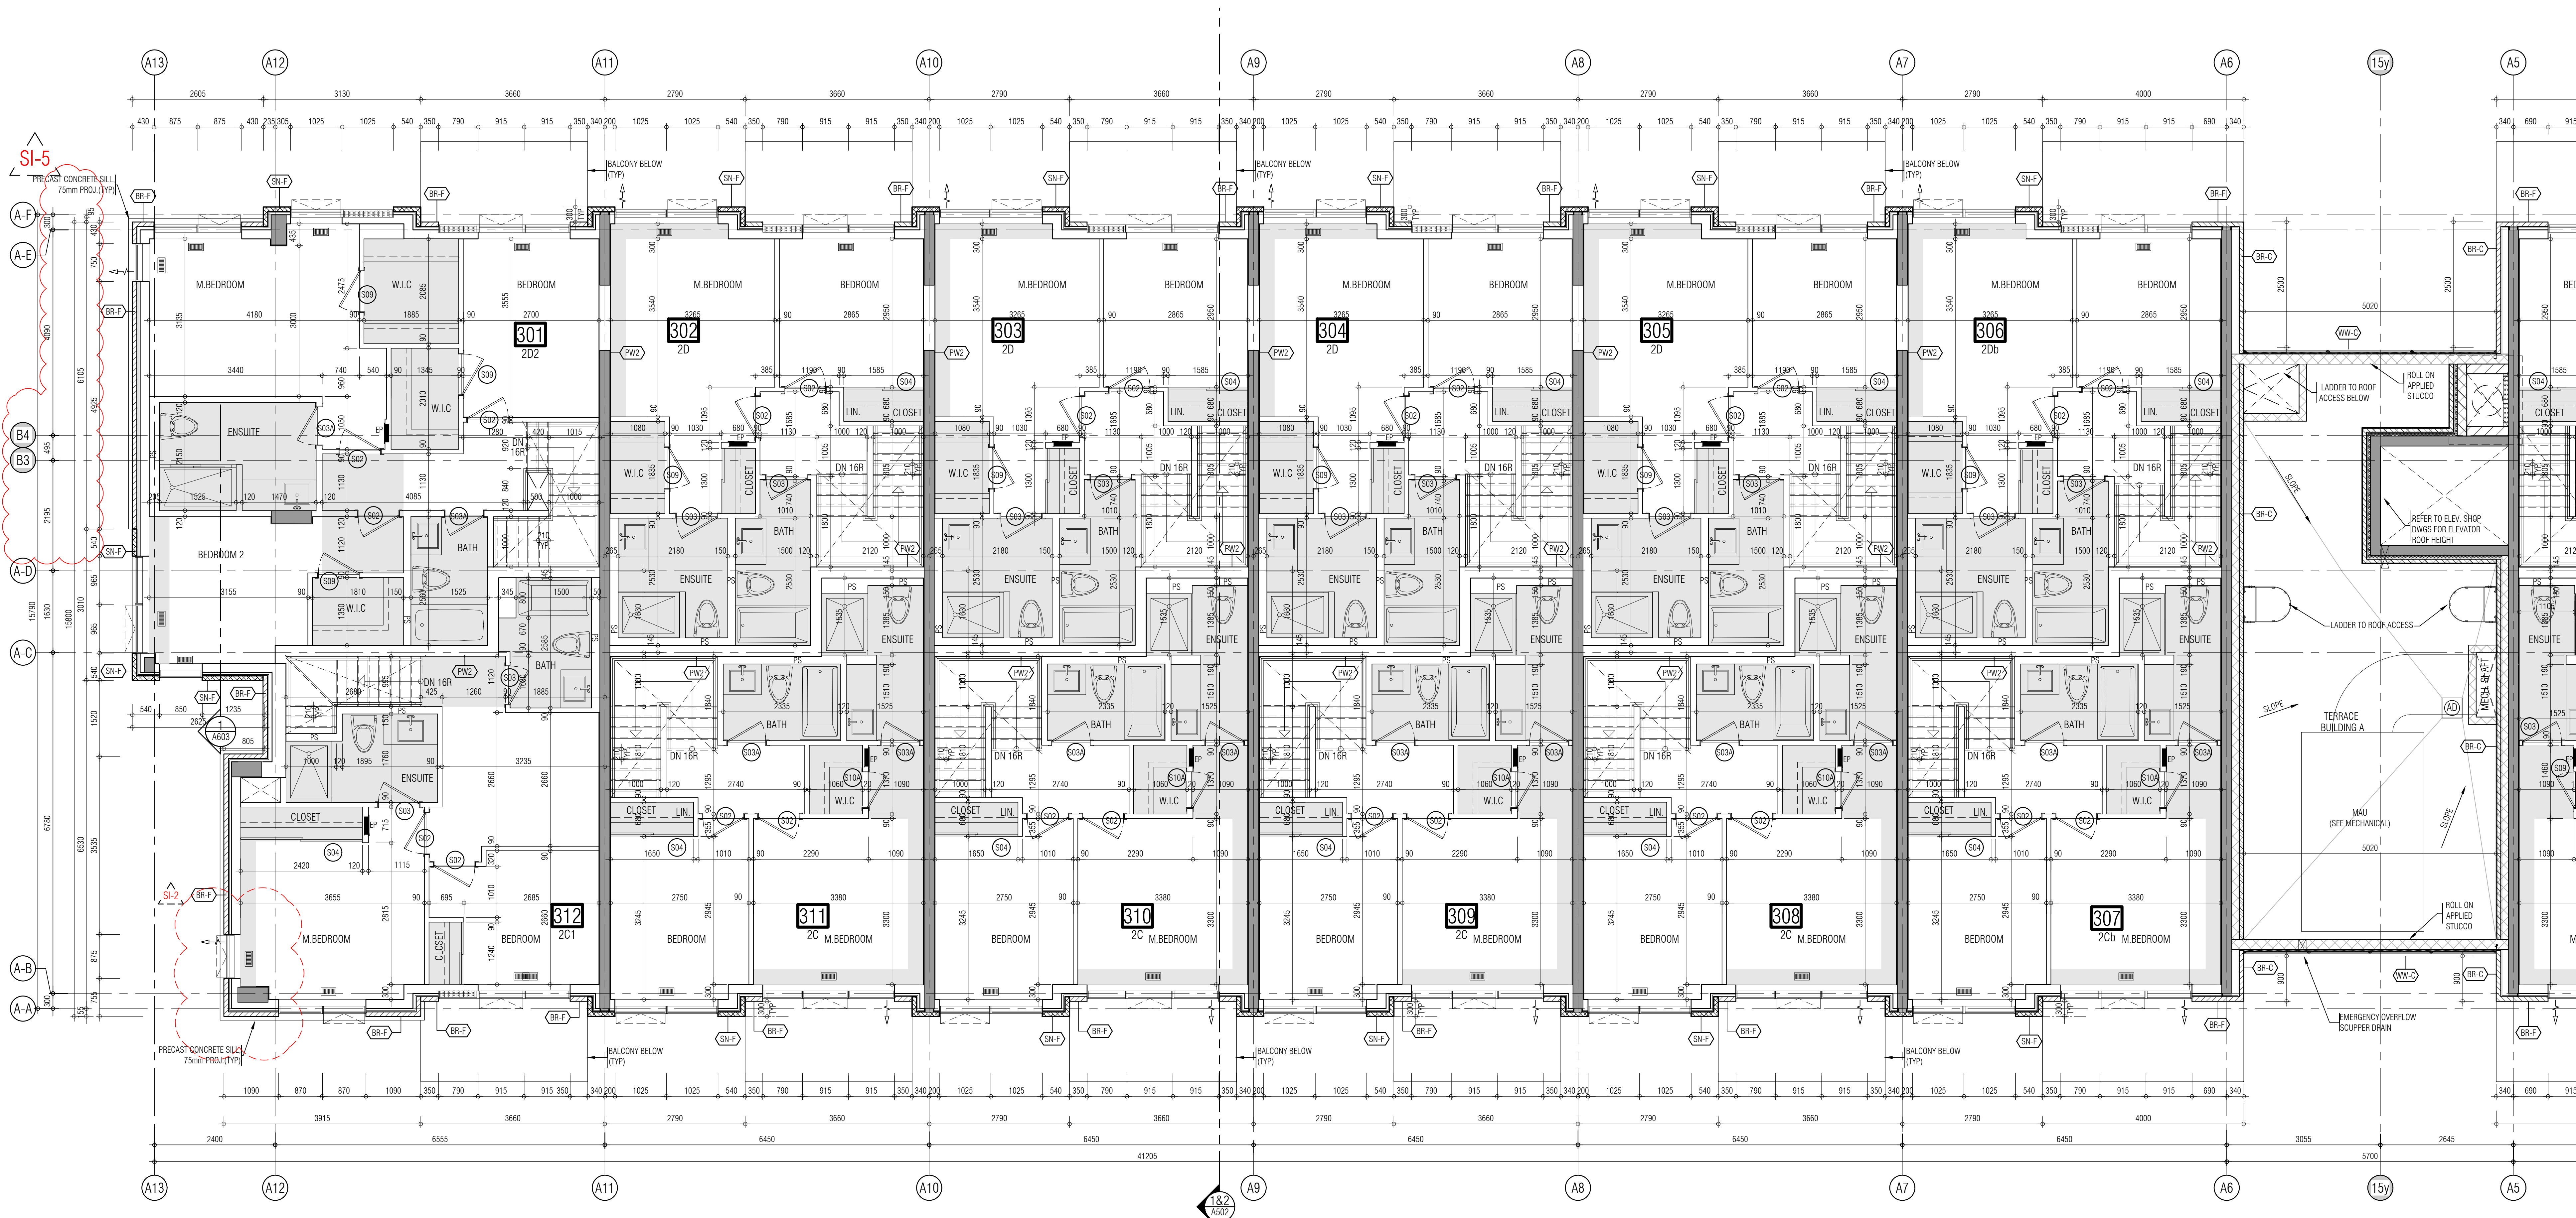

01. Apr.19.2021 issued to client
issued for revisions

**GRAZIANI
CORAZZA
ARCHITECTS**

1333 SHANAGHAN DRIVE, SUITE 103 MISSISSAUGA, ONTARIO L4W 1C3
905.763.7021 WWW.GC-ARCHITECTS.COM

ATTMAY + PALLESCI DRIVE
PROJECT ARCHITECT: B. GRAZIANI
ASSISTANT DESIGNER: R. LINCOLN
DRAWN BY: G.C./F.C./M.B.
CHECKED BY: D. BIASI/G. COLANGELO
PLOT DATE: AUG.18.2021
JOB #: 1331.15

**FORTH FLOOR PLAN
BUILDING A (PARTIAL PLAN)**

1:50 A-304a1
TITLEBLOCK SIZE: 915 x 1200

THIS DRAWING IS AN INSTRUMENT OF SERVICE. IT IS PROVIDED BY AND IS THE PROPERTY OF GRAZIANI-CORAZZA ARCHITECTS INC. THE CONTRACTOR MUST VERIFY AND ACCEPT RESPONSIBILITY FOR ALL DIMENSIONS AND COORDINATE THE SITE AND MUST NOTIFY GRAZIANI-CORAZZA ARCHITECTS INC. OF ANY OMISSIONS FROM THE SUPPLIED INFORMATION. GRAZIANI-CORAZZA ARCHITECTS INC. IS NOT RESPONSIBLE FOR THE ACCURACY OF SURVEY, STRUCTURAL, MECHANICAL, ELECTRICAL AND OTHER ENGINEERING INFORMATION SHOWN ON THIS DRAWING. REFER TO THE APPROPRIATE ENGINEERING DRAWINGS BEFORE PROCEEDING WITH THE WORK. CONSTRUCTION MUST COMPLY TO ALL APPLICABLE CODES AND REQUIREMENTS OF THE AUTHORITIES HAVING JURISDICTION. UNLESS OTHERWISE NOTED, NO INVESTIGATION HAS BEEN UNDERTAKEN OR REPORTED ON BY THIS OFFICE IN REGARD TO THE ENVIRONMENTAL CONDITION OF THIS SITE.

THIS DRAWING IS NOT TO BE SCALED. ALL ARCHITECTURAL SYMBOLS INDICATED ON THIS DRAWING ARE GRAPHIC REPRESENTATIONS ONLY.

CONDITIONS FOR ELECTRONIC INFORMATION TRANSFER

ELECTRONIC INFORMATION IS SUPPLIED TO THE OTHER ASSOCIATED FIRMS TO ASSIST THEM IN THE EXECUTION OF THEIR WORK. REVIEW THE RECEIVED FIRMS MUST DETERMINE THE COMPLETENESS, APPROPRIATENESS, RELIANCE OF THE INFORMATION IN RESPECT TO THEIR PARTICULAR RESPONSIBILITY.

GRAZIANI-CORAZZA ARCHITECTS INC. SHALL NOT BE RESPONSIBLE FOR ERROR, OMISSIONS, INCOMPLETENESS DUE TO USE OF INFORMATION IN WHOLE OR PART WHEN INFORMATION IS TRANSMITTED.

1. TRANSMISSION OF ANY VIRUS OR DAMAGE TO THE RECEIVING ELECTRONIC SYSTEM WHEN INFORMATION IS TRANSMITTED.

01. Oct.07.2019 issued for tender
02. Mar.13.2020 issued for design coordination #2
03. Mar.16.2020 issued for addendum #2
04. Mar.16.2020 issued for addendum #3
05. Aug.24.2020 issued for addendum #4
06. Sept.28.2020 issued for permit
07. Oct.20.2020 issued for addendum #5
08. Nov.23.2020 issued for addendum #6
09. Dec.14.2020 issued for addendum #7
10. Jan.15.2021 issued for addendum #8
11. Mar.2.2021 issued for permit
12. Mar.09.2021 issued for addendum #9
13. Mar.10.2021 issued for addendum #9R
14. Mar.26.2021 issued for progress
15. May.14.2021 issued for Site Instruction #1
16. June.15.2021 issued for Site Instruction #2
17. July.7.2021 re-issued for permit
18. July.15.2021 issued for Site Instruction #3
19. July.27.2021 issued for Site Instruction #4
20. Aug.3.2021 issued for Site Instruction #5
21. Aug.5.2021 issued for Site Instruction #6

01. Apr.19.2021 issued to client
- issued for revisions

GRAZIANI CORAZZA ARCHITECTS

1320 SHEARWATER DRIVE, SUITE 100 MISSISSAUGA, ONTARIO L4R 1C3
905.760.0201 F.905.760.3388 WWW.GC-ARCHITECTS.COM



ATTMA + PALLESCHI DRIVE

PROJECT ARCHITECT: B. GRAZIANI

ASSISTANT DESIGNER: R. LINCOLN


DRAWN BY: G.C./F.C./M.B.

CHECKED BY: D. BIASE/G. COLANGELO

PLAT DATE: AUG.18.2021

JOB # 1331.15


FORTH FLOOR PLAN
BUILDING A (PARTIAL PLAN)

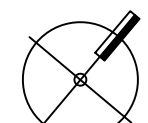


1:50 A-304a2

TITLEBLOCK SIZE: 915 x 1200

REF. A304d1 FOR CONTINUATION

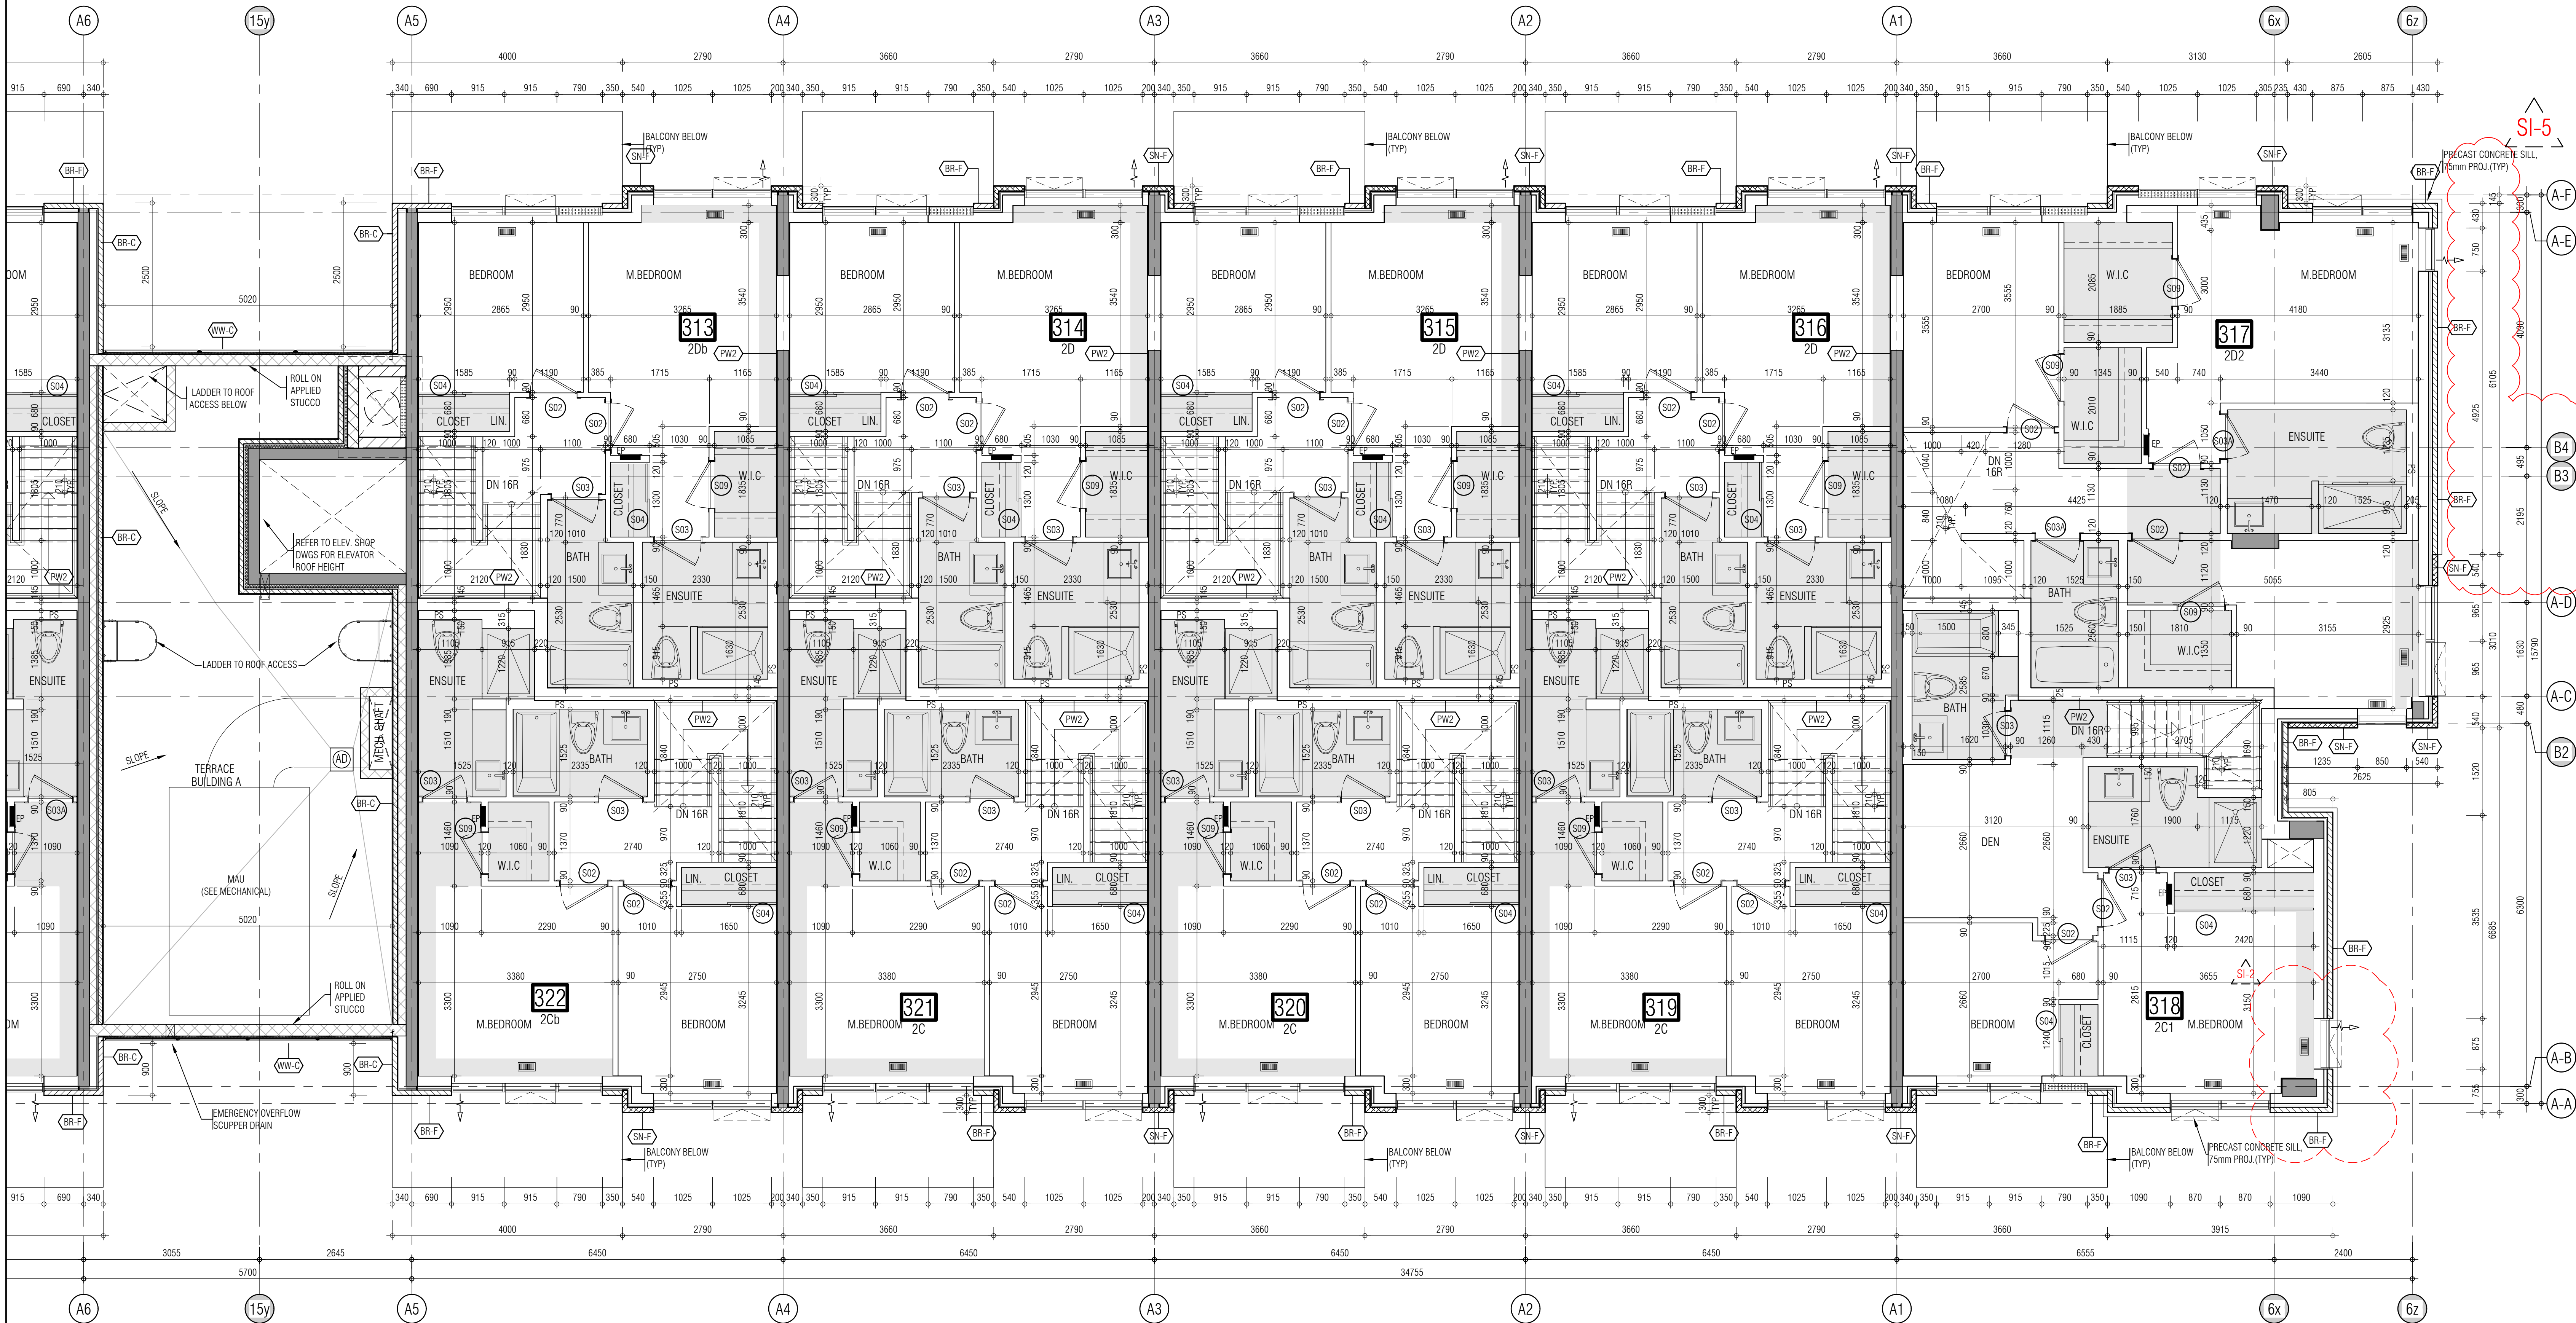

KEY PLAN

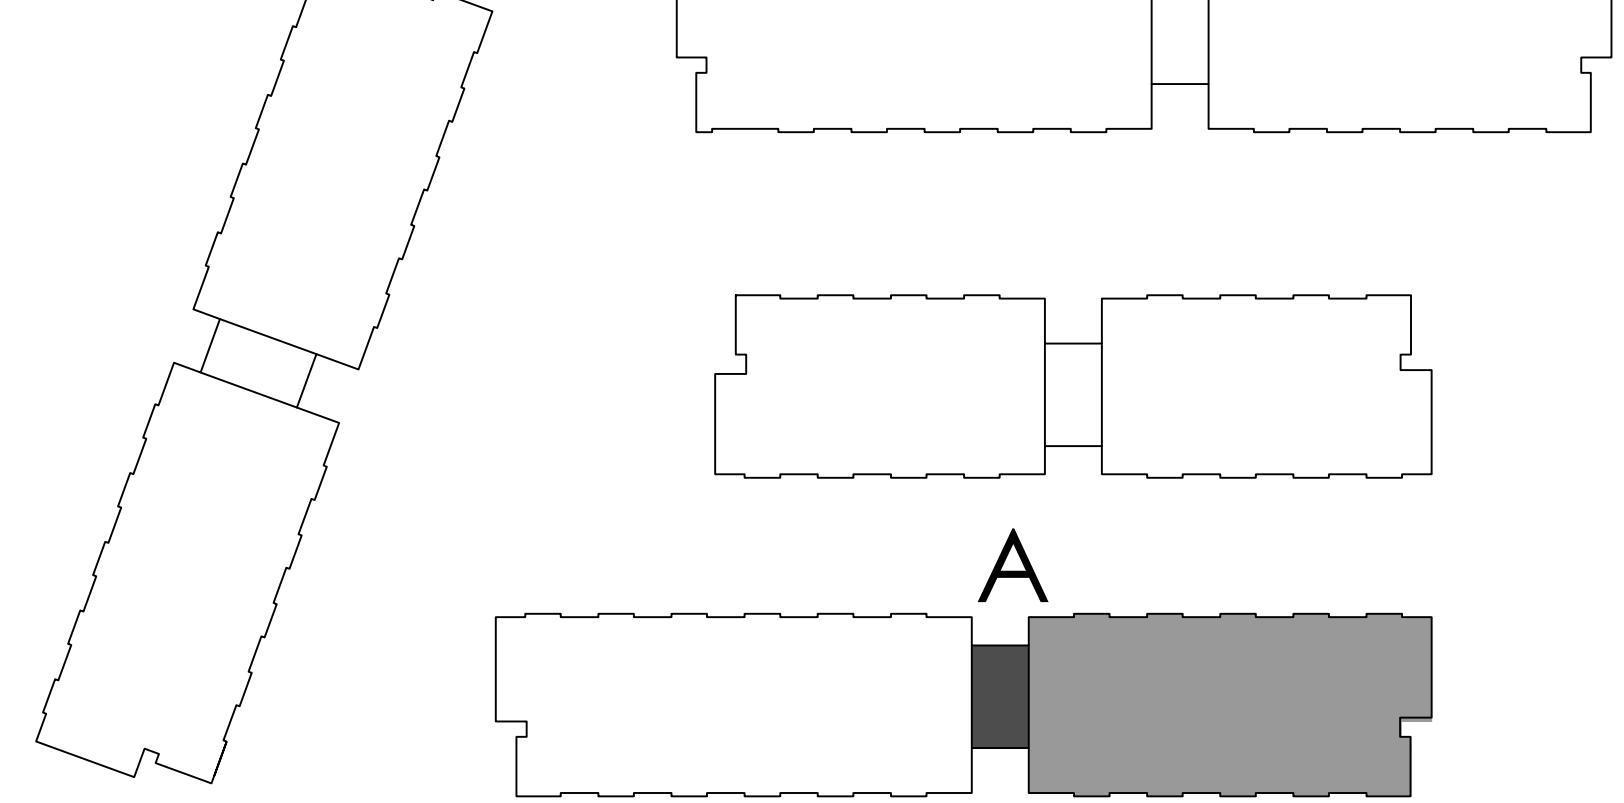

THIS DRAWING, AS AN INSTRUMENT OF SERVICE, IS PROVIDED BY AND IS THE PROPERTY OF GRAZIANI-CORAZZA ARCHITECTS INC. THE CONTRACTOR MUST VERIFY AND ACCEPT RESPONSIBILITY FOR ALL DIMENSIONS AND COORDINATE THE SITE AND MUST NOTIFY GRAZIANI-CORAZZA ARCHITECTS INC. OF ANY DISCREPANCIES FROM THE SUPPLIED INFORMATION. GRAZIANI-CORAZZA ARCHITECTS INC. IS NOT RESPONSIBLE FOR THE ACCURACY OF SURVEY, STRUCTURAL, MECHANICAL, ELECTRICAL, AND OTHER ENGINEERING INFORMATION SHOWN ON THIS DRAWING. REFER TO THE APPROPRIATE ENGINEERING DRAWINGS BEFORE PROCEEDING WITH THE WORK. CONSTRUCTION MUST CONFORM TO ALL APPLICABLE CODES AND REQUIREMENTS OF THE AUTHORITIES HAVING JURISDICTION. UNLESS OTHERWISE NOTED, NO MODIFICATION HAS BEEN MADE/MADE AS REPORTED BY THIS OFFICE IN REGARDS TO THE ENVIRONMENTAL CONDITION OF THIS SITE.


THIS DRAWING IS NOT TO BE SCALED. ALL ARCHITECTURAL SYMBOLS INDICATED ON THIS DRAWING ARE GRAPHIC REPRESENTATIONS ONLY.

CONDITIONS FOR ELECTRONIC INFORMATION TRANSFER

ELECTRONIC INFORMATION IS SUPPLIED TO THE OTHER ASSOCIATED FIRMS TO ASSIST THEM IN THE EXECUTION OF THEIR WORK. REVIEW THE RECIPIENT FIRMS MUST DETERMINE THE COMPLETENESS, APPROPRIATENESS, RELIANCE OF THE INFORMATION IN RESPECT TO THEIR PARTICULAR RESPONSIBILITY.

GRAZIANI-CORAZZA ARCHITECTS INC. SHALL NOT BE RESPONSIBLE FOR ERROR, OMISSIONS, INCOMPLETENESS DUE TO LOSS OF INFORMATION IN WHOLE OR PART WHEN INFORMATION IS TRANSMITTED.

1. TRANSMISSION OF ANY LOSS OF DAMAGE TO THE RECEIVING ELECTRONIC SYSTEM WHEN INFORMATION IS TRANSMITTED.

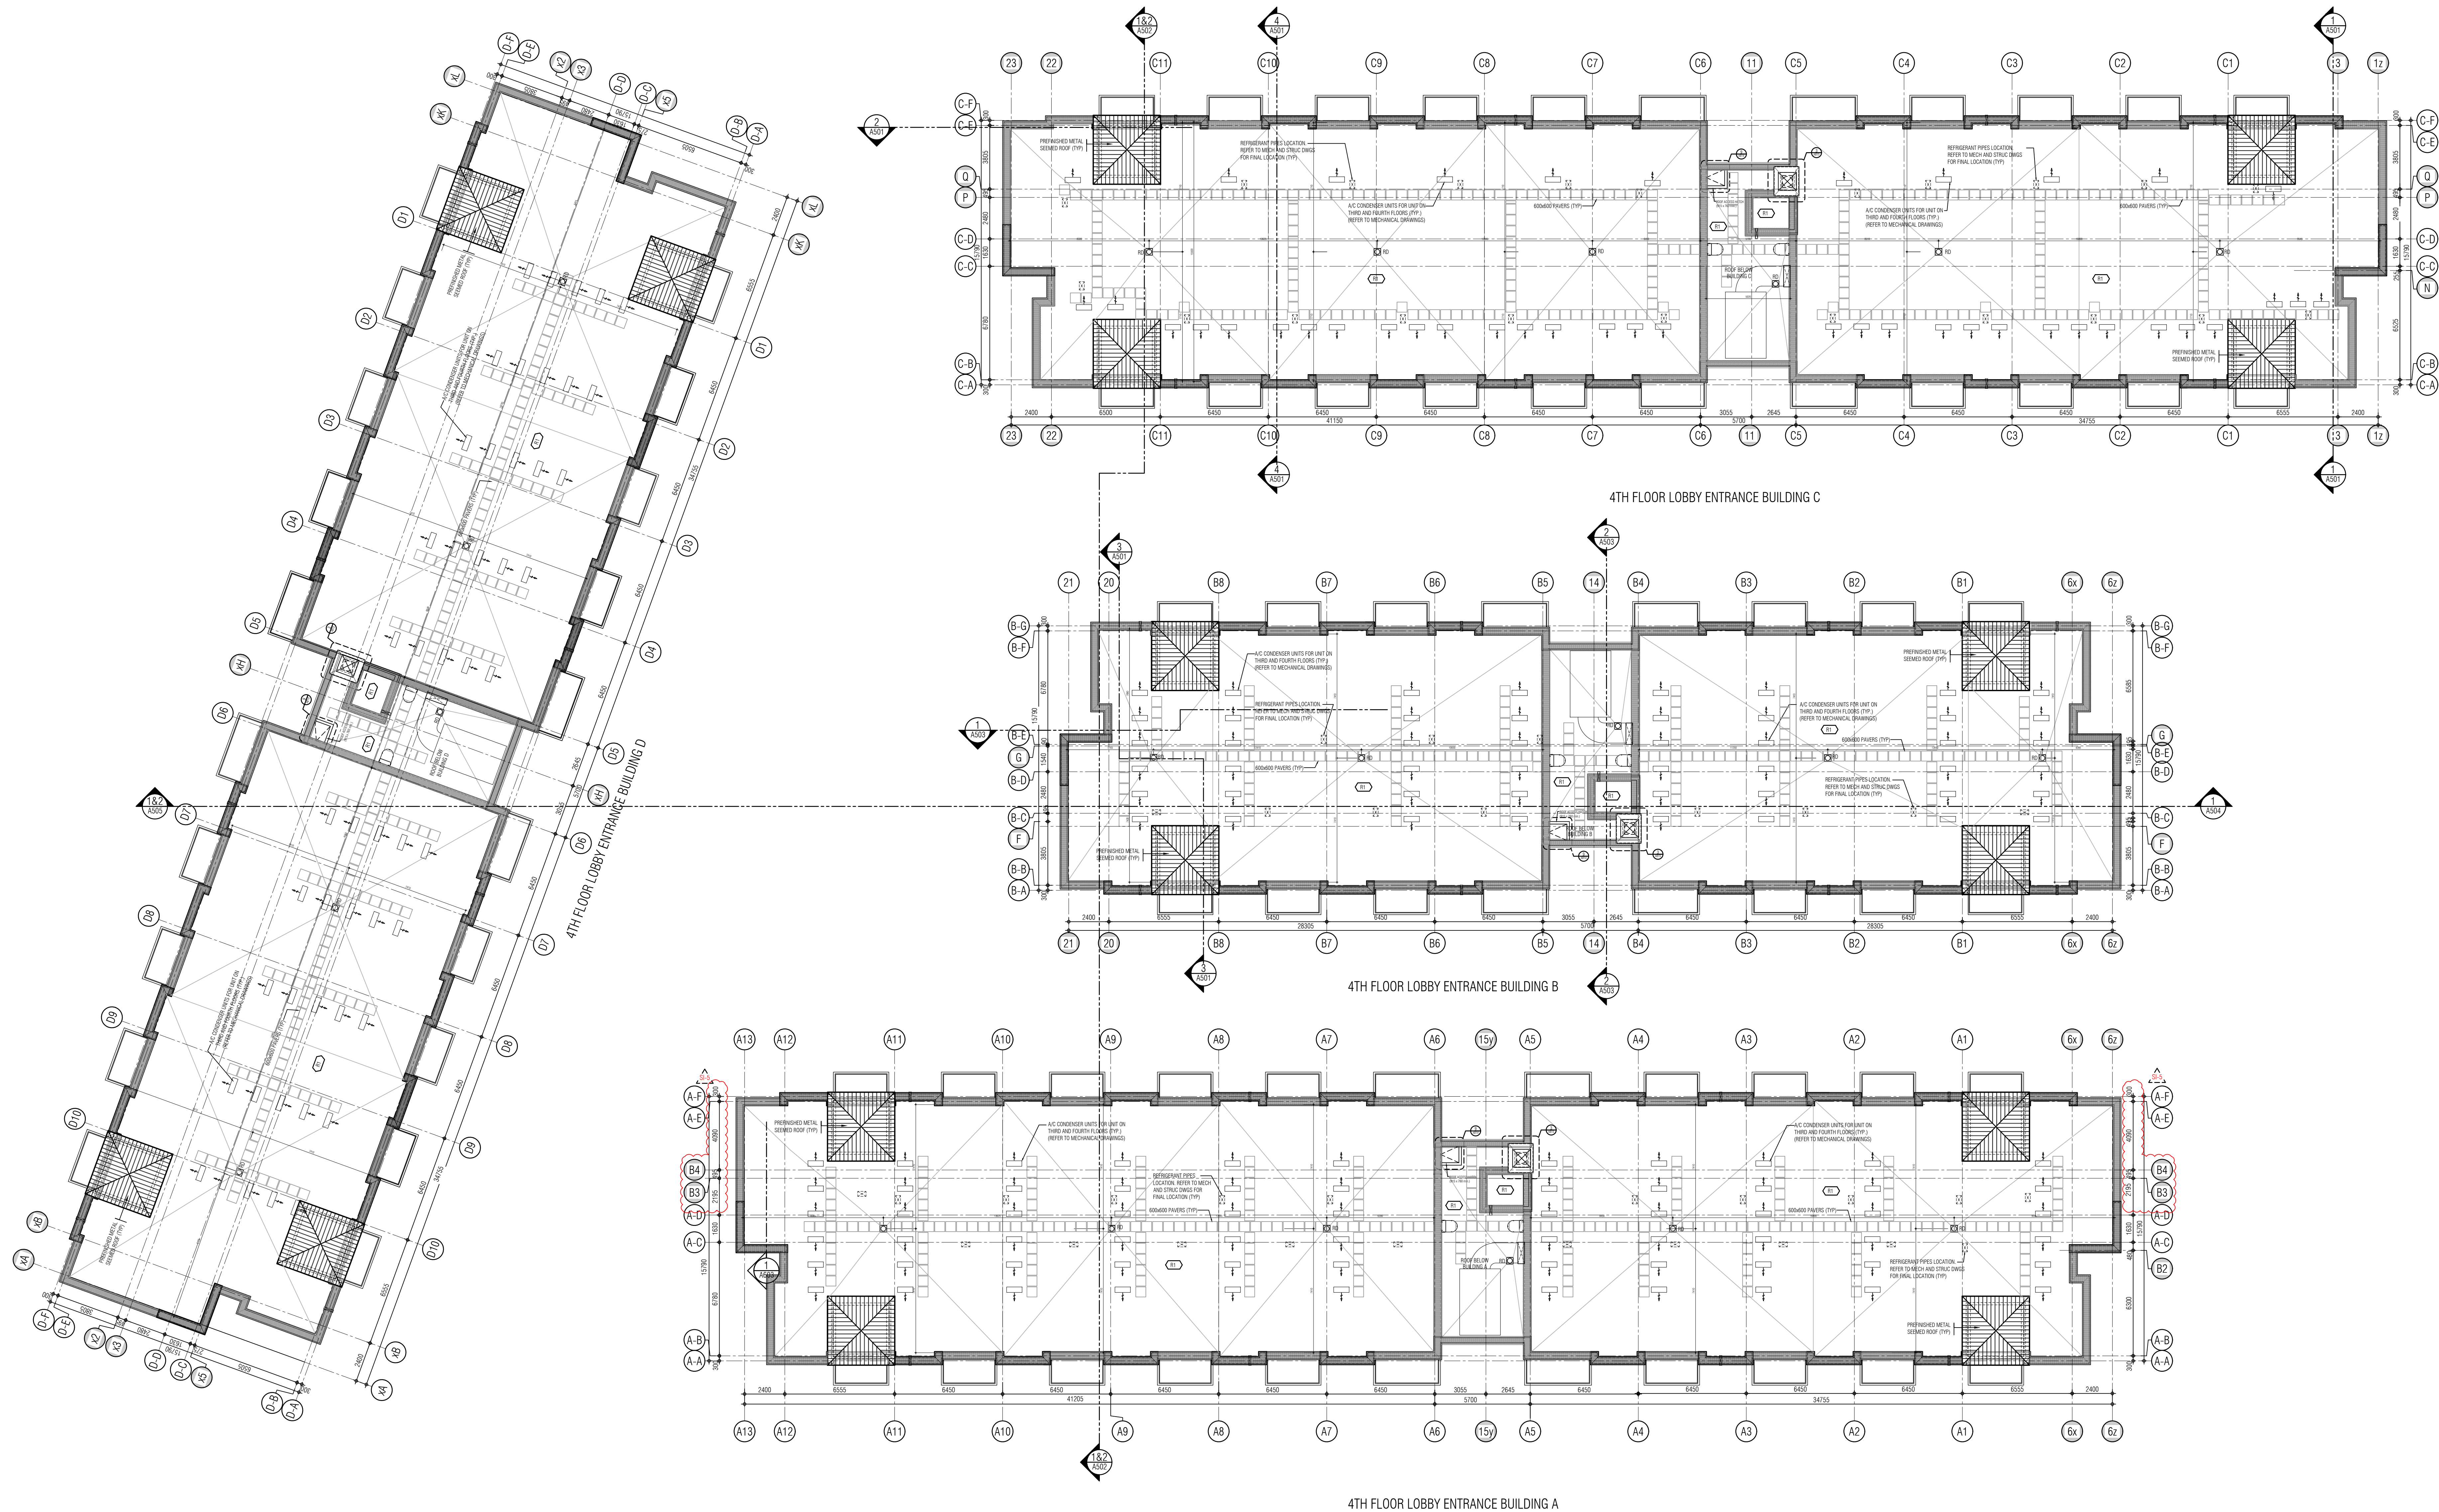

- 01. Oct.07.2019 issued for tender
- 02. Mar.13.2020 issued for design coordination #2
- 03. Mar.16.2020 issued for addendum #2
- 04. Mar.16.2020 issued for addendum #3
- 05. Aug.24.2020 issued for addendum #4
- 06. Sept. 28.2020 issued for permit
- 07. Oct.20.2020 issued for addendum #5
- 08. Nov.23.2020 issued for addendum #6
- 09. Dec.14.2020 issued for addendum #7
- 10. Jan.15.2021 issued for addendum #8
- 11. Mar. 2. 2021 issued for permit
- 12. Mar.09.2021 issued for addendum #9
- 13. Mar.10.2021 issued for addendum #9R
- 14. Mar.26.2021 issued for progress
- 15. May.14. 2021 issued for Site Instruction #1
- 16. June.15. 2021 issued for Site Instruction #2
- 17. July. 7. 2021 re-issued for permit
- 18. July. 15. 2021 issued for Site Instruction #3
- 19. July. 27. 2021 issued for Site Instruction #4
- 20. Aug. 3. 2021 issued for Site Instruction #5
- 21. Aug. 5. 2021 issued for Site Instruction #6

01. Apr.19.2021 issued to client

issued for revisions



RESIDENTIAL

ATTMAR + PALLESCHI DRIVE

BRAMPTON ONTARIO

PROJECT ARCHITECT: B.GRAZIANI

ASSISTANT DESIGNER: R.LINCOLN

DRAWN BY: G.C./F.C./M.B.

CHECKED BY: D.BIASE/G.COLANGELO

PLOT DATE: AUG.18.2021

JOB # 1331.15

ROOF OVERALL PLAN

THIS DRAWING IS AN INSTRUMENT OF SERVICE. IT IS PROVIDED BY AND IS THE PROPERTY OF GRAZIANI-CORAZZA ARCHITECTS INC. THE CONTRACTOR MUST VERIFY AND ACCEPT RESPONSIBILITY FOR ALL DIMENSIONS AND COORDINATE THE SITE AND MUST NOTIFY GRAZIANI-CORAZZA ARCHITECTS INC. OF ANY OMISSIONS FROM THE SUPPLIED INFORMATION. GRAZIANI-CORAZZA ARCHITECTS INC. IS NOT RESPONSIBLE FOR THE ACCURACY OF SURVEY, STRUCTURAL, MECHANICAL, ELECTRICAL, AND OTHER ENGINEERING INFORMATION SHOWN ON THIS DRAWING. REFER TO THE APPROPRIATE ENGINEERING DRAWINGS BEFORE PROCEEDING WITH THE WORK. CONSTRUCTION MUST COMPLY TO ALL APPLICABLE CODES AND REQUIREMENTS OF THE AUTHORITIES HAVING JURISDICTION. UNLESS OTHERWISE NOTED, NO INVESTIGATION HAS BEEN UNDERTAKEN OR REPORTED ON BY THIS OFFICE IN REGARD TO THE ENVIRONMENTAL CONDITION OF THIS SITE.


THIS DRAWING IS NOT TO BE SCALED. ALL ARCHITECTURAL SYMBOLS INDICATED ON THIS DRAWING ARE GRAPHIC REPRESENTATIONS ONLY.

CONDITIONS FOR ELECTRONIC INFORMATION TRANSFER:
ELECTRONIC INFORMATION IS SUPPLIED TO THE OTHER ASSOCIATED FIRMS TO ASSIST THEM IN THE EXECUTION OF THEIR WORK. REVIEW THE RECEIVED FIRMS MUST DETERMINE THE COMPLETENESS, APPROPRIATENESS, RELIANCE OF THE INFORMATION IN RESPECT TO THEIR PARTICULAR RESPONSIBILITY.

GRAZIANI-CORAZZA ARCHITECTS INC. SHALL NOT BE RESPONSIBLE FOR ERRORS, OMISSIONS, INCOMPLETENESS DUE TO LOSS OF INFORMATION IN WHOLE OR PART WHEN INFORMATION IS TRANSMITTED.
1. TRANSMISSION OF ANY LOSS OF DAMAGE TO THE RECEIVING ELECTRONIC SYSTEM WHEN INFORMATION IS TRANSMITTED.

REF. A305d2 FOR CONTINUATION

- | | | | |
|-----|----------------|-----------------------------------|----|
| 01. | Oct.07.2019 | issued for tender | — |
| 02. | Mar.13.2020 | issued for design coordination #2 | — |
| 03. | Mar.16.2020 | issued for addendum #2 | — |
| 04. | Mar.16.2020 | issued for addendum #3 | — |
| 05. | Aug.24.2020 | issued for addendum #4 | — |
| 06. | Sept. 28.2020 | issued for permit | bg |
| 07. | Oct.20.2020 | issued for addendum #5 | — |
| 08. | Nov.23.2020 | issued for addendum #6 | — |
| 09. | Dec.14.2020 | issued for addendum #7 | — |
| 10. | Jan.15.2021 | issued for addendum #8 | — |
| 11. | Mar. 2. 2021 | issued for permit | bg |
| 12. | Mar.09.2021 | issued for addendum #9 | — |
| 13. | Mar.10.2021 | issued for addendum #9R | — |
| 14. | Mar.26.2021 | issued for progress | — |
| 15. | May.14. 2021 | issued for Site Instruction #1 | — |
| 16. | June.15. 2021 | issued for Site Instruction #2 | — |
| 17. | July. 7. 2021 | re-issued for permit | bg |
| 18. | July. 15. 2021 | issued for Site Instruction #3 | bg |
| 19. | July. 27. 2021 | issued for Site Instruction #4 | bg |
| 20. | Aug. 3. 2021 | issued for Site Instruction #5 | bg |
| 21. | Aug. 5. 2021 | issued for Site Instruction #6 | bg |

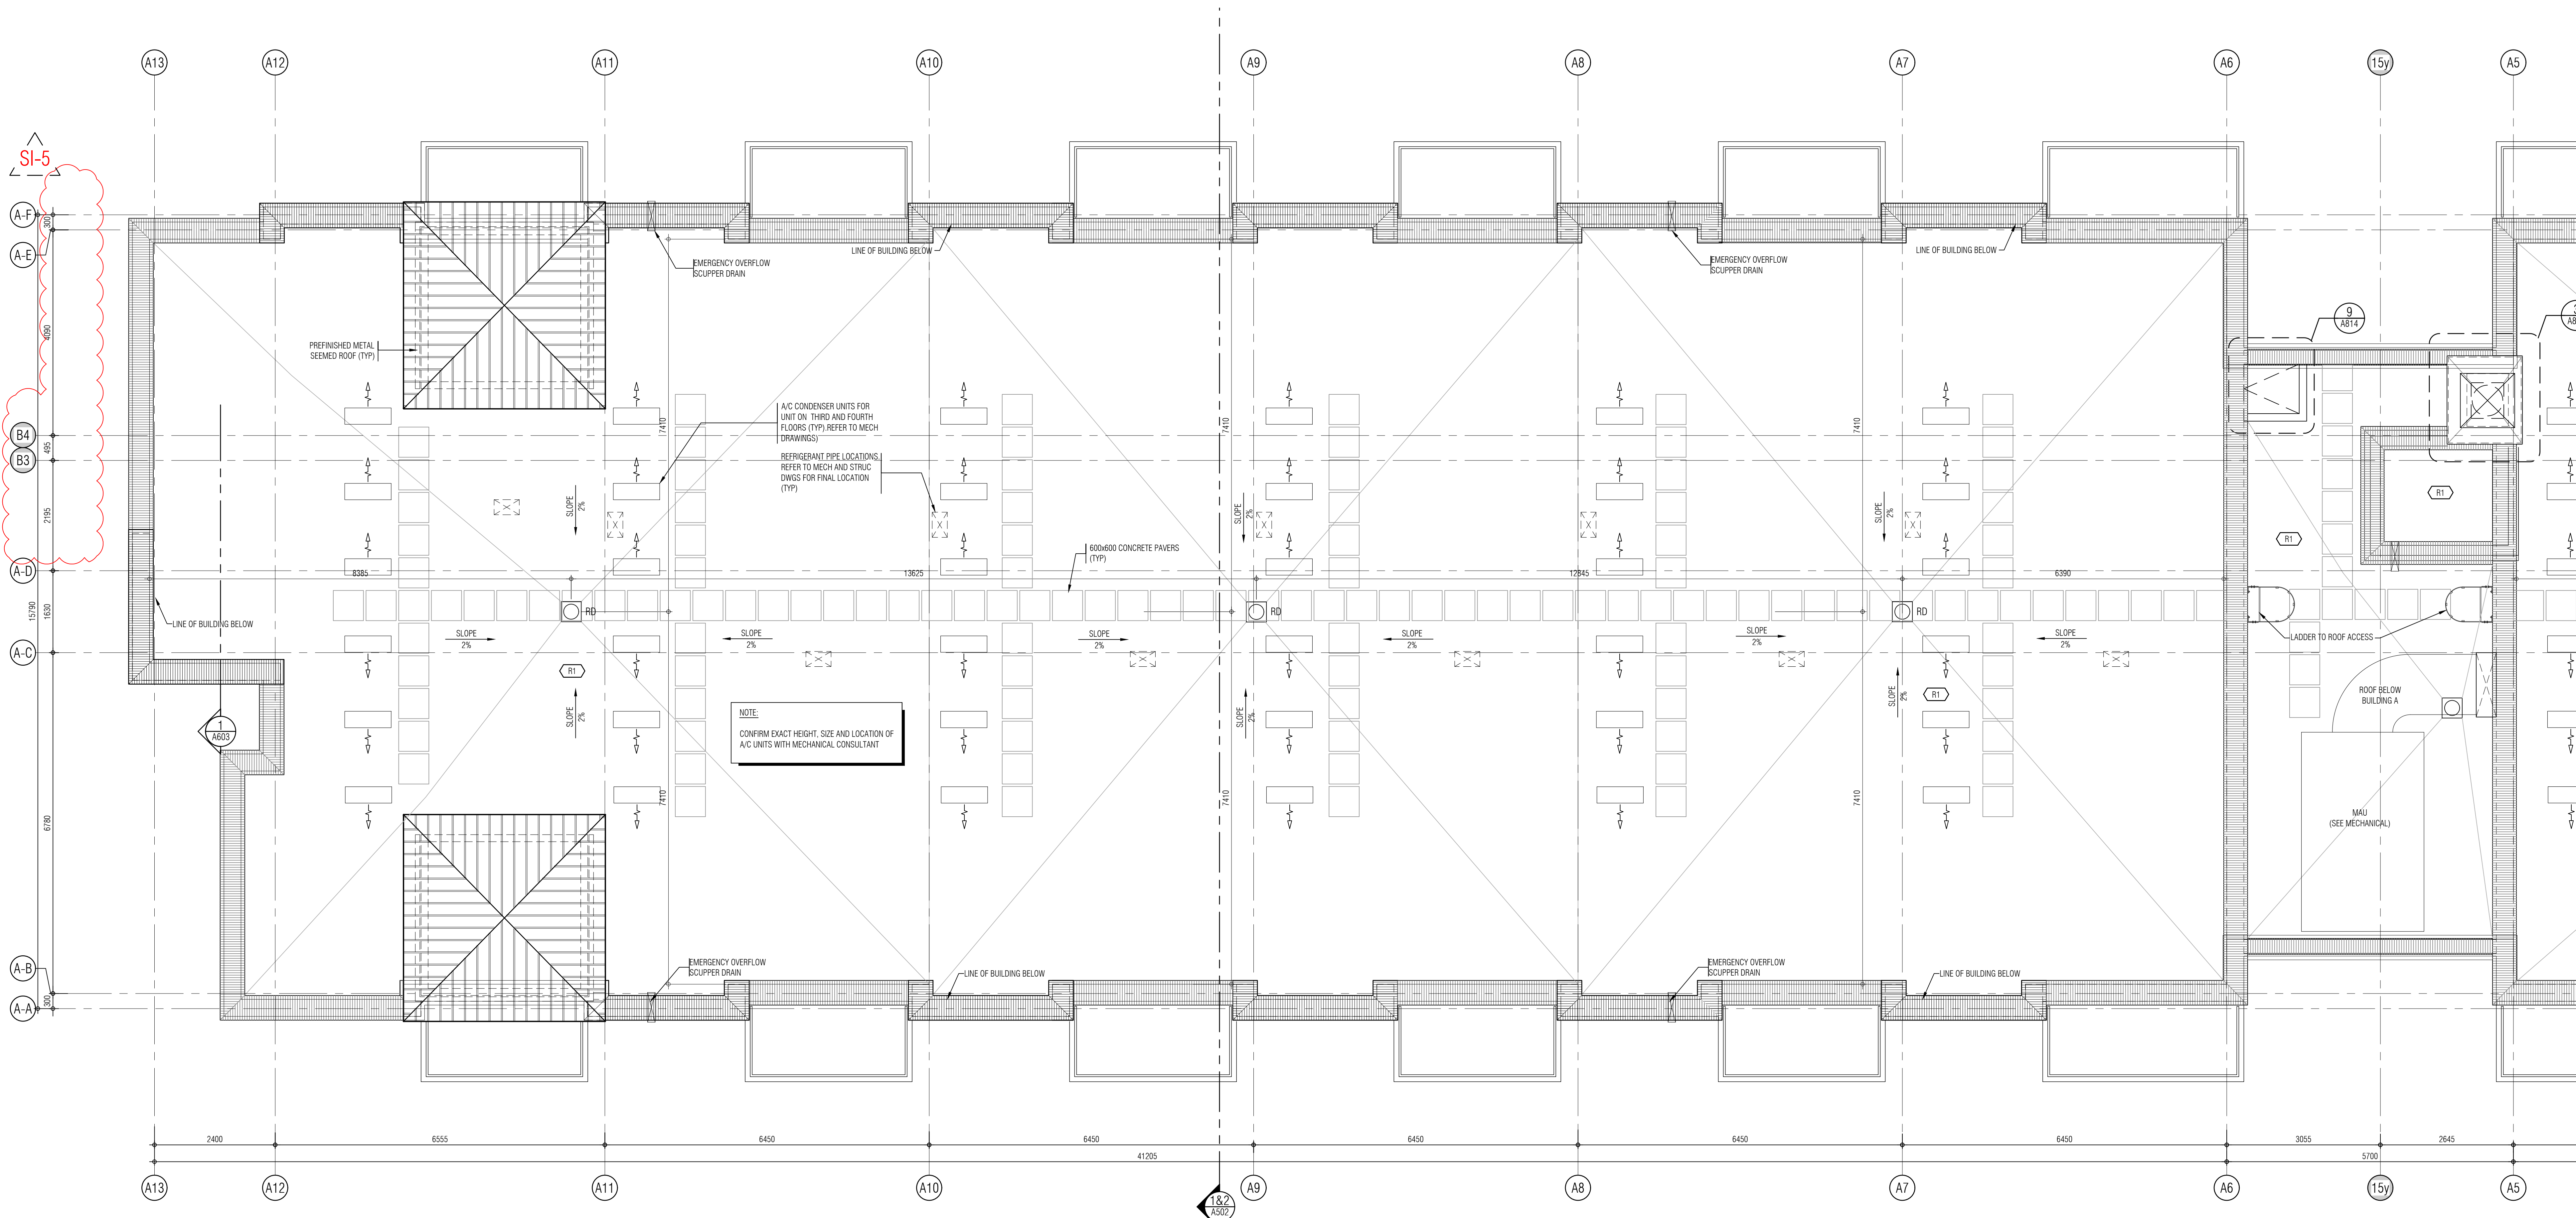

- | | | | |
|----------------------|-------------|------------------|----|
| 01. | Apr.19.2021 | issued to client | bg |
| issued for revisions | | | + |

GRAZIANI CORAZZA ARCHITECTS
1333 SHARONDAVE DRIVE, SUITE 101 MISSISSAUGA, ONTARIO L4B 1C3
905.709.7001 P.905.709.7000 WWW.GC-ARCHITECTS.COM


RESIDENTIAL
ATTMOR + PALLESCHI DRIVE
BRAMPTON ONTARIO
PROJECT ARCHITECT: B. GRAZIANI
ASSISTANT DESIGNER: R. LINCOLN
DRAWN BY: G.C./F.C./M.B.
CHECKED BY: D. BIASE/G. COLANGELO
PLOT DATE: AUG.18.2021
JOB # 1331.15

ROOF PLAN
BUILDING A (PARTIAL PLAN)

1:50 A-305a1

TITLEBLOCK SIZE: 915 x 1200

REF.A305d1 FOR CONTINUATION

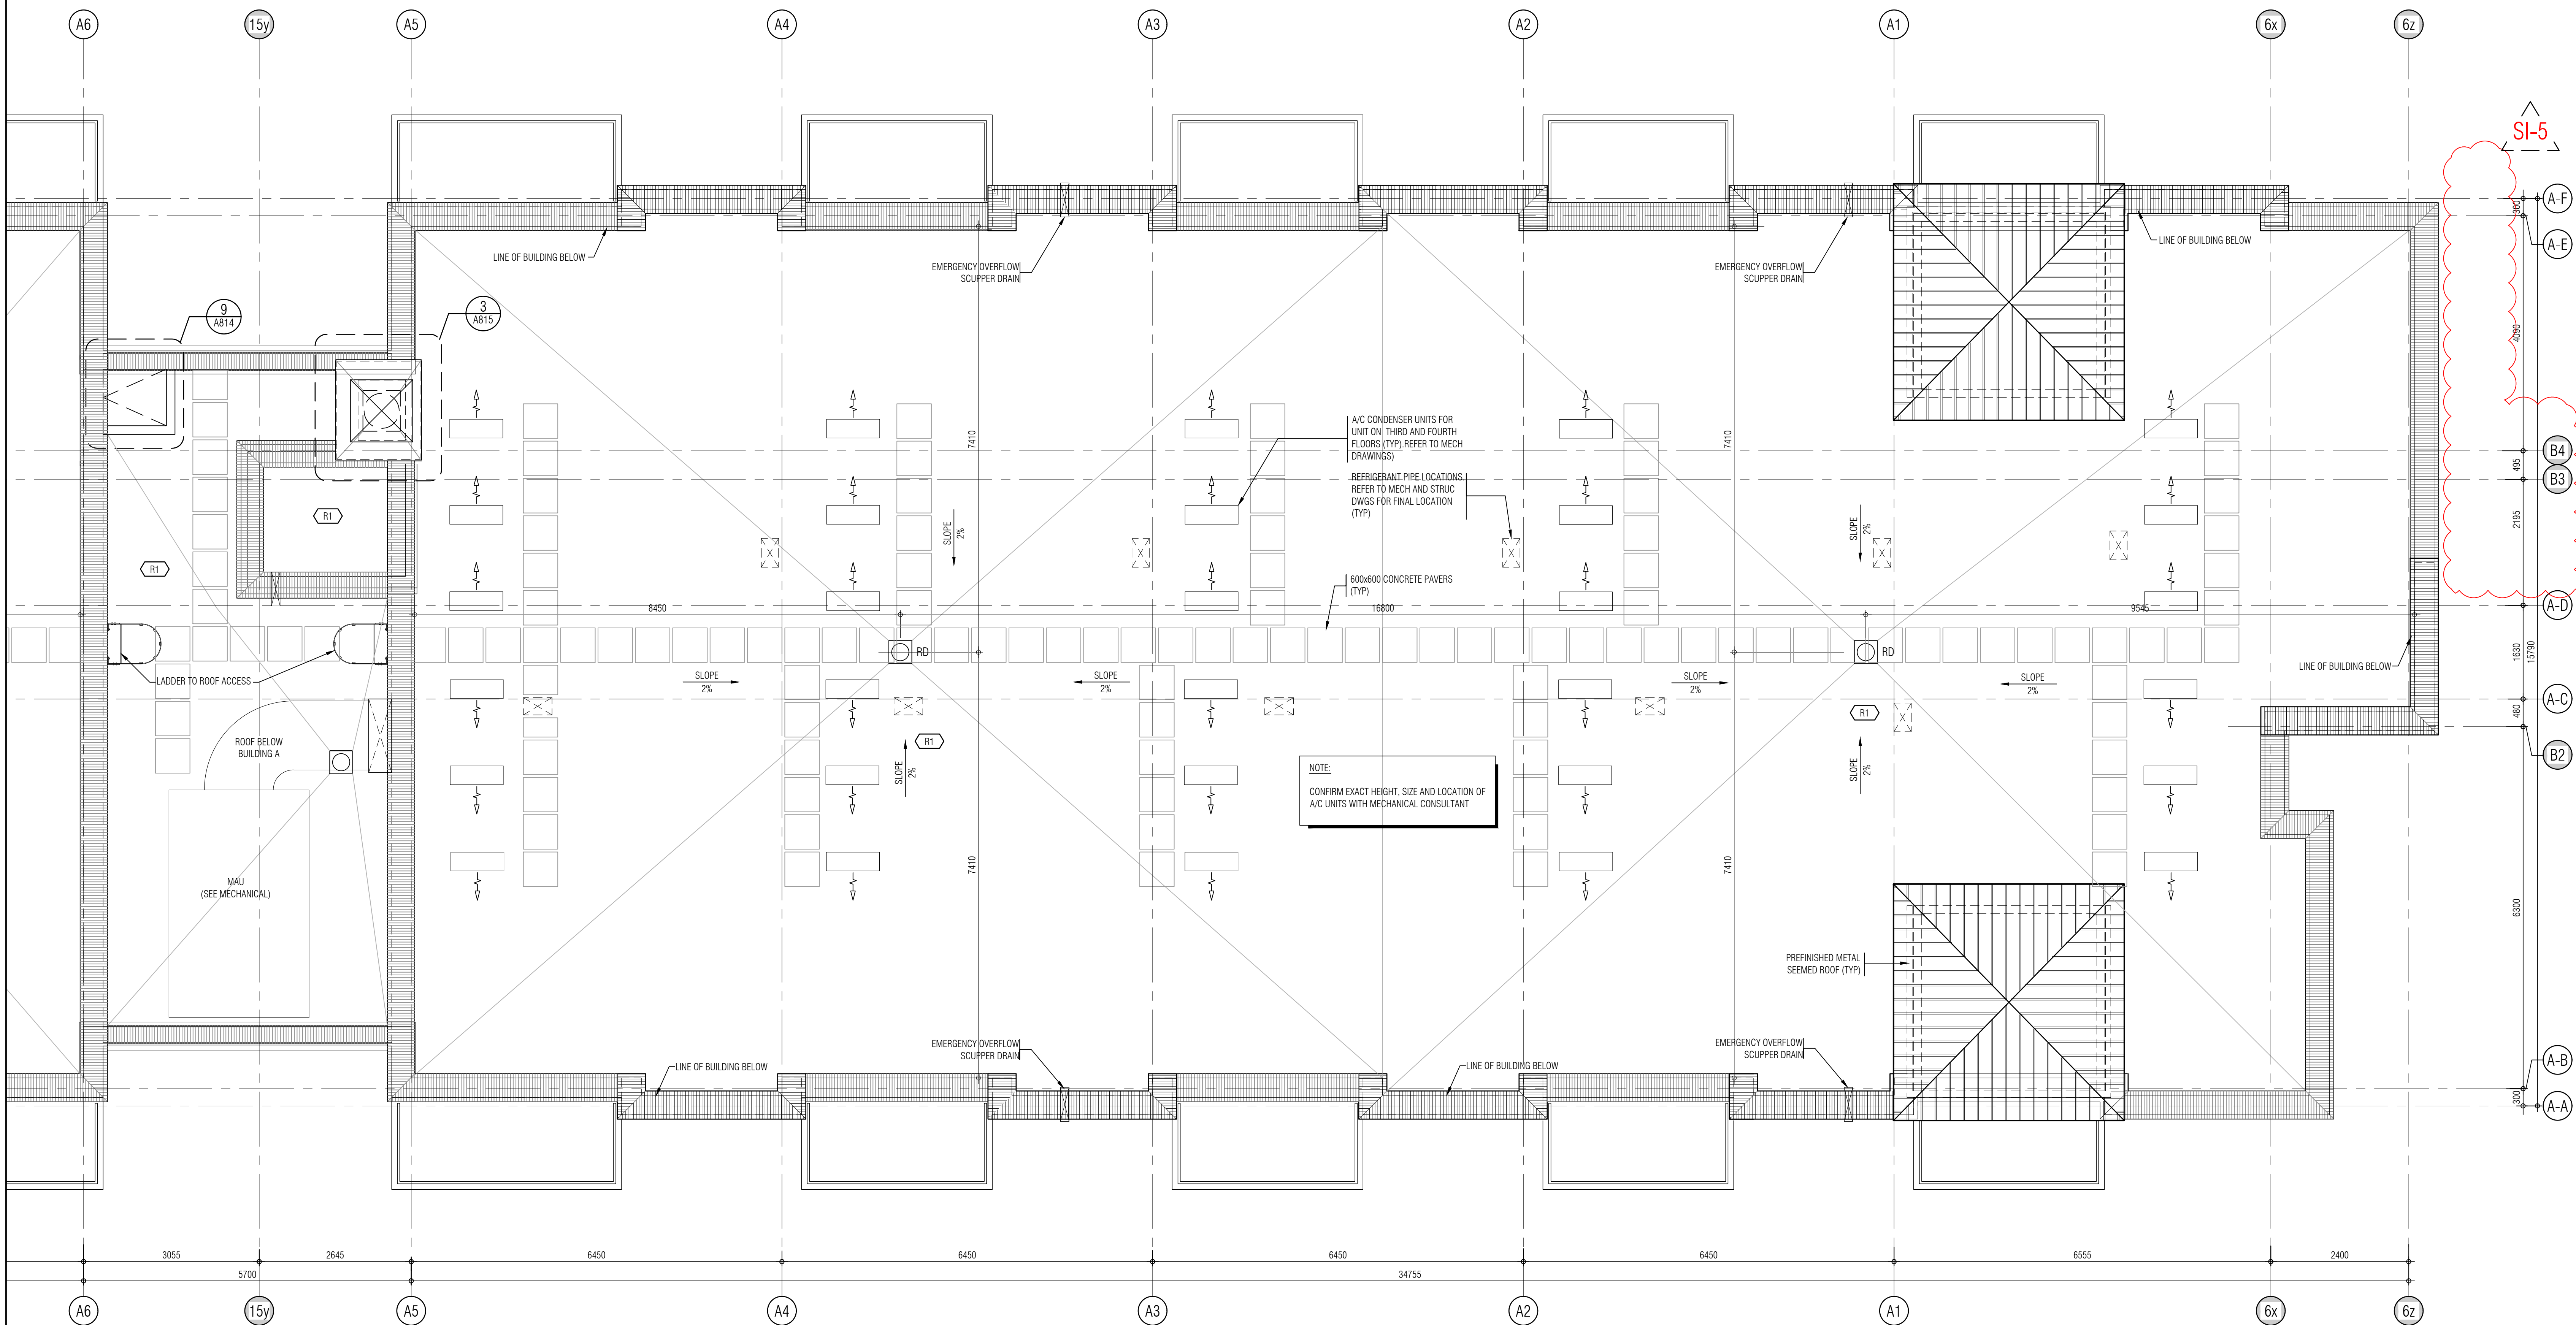

THIS DRAWING, AS AN INSTRUMENT OF SERVICE, IS PROVIDED BY AND IS THE PROPERTY OF GRAZIANI-CORAZZA ARCHITECTS INC. THE CONTRACTOR MUST VERIFY AND ACCEPT RESPONSIBILITY FOR ALL DIMENSIONS AND COORDINATE THE SITE AND MUST NOTIFY GRAZIANI-CORAZZA ARCHITECTS INC. OF ANY DISCREPANCIES FROM THE SUPPLIED INFORMATION. GRAZIANI-CORAZZA ARCHITECTS INC. IS NOT RESPONSIBLE FOR THE ACCURACY OF SURVEY, STRUCTURAL, MECHANICAL, ELECTRICAL, AND OTHER ENGINEERING INFORMATION SHOWN ON THIS DRAWING. REFER TO THE APPROPRIATE ENGINEERING DRAWINGS BEFORE PROCEEDING WITH THE WORK. CONSTRUCTION MUST COMPLY TO ALL APPLICABLE CODES AND REQUIREMENTS OF THE AUTHORITIES HAVING JURISDICTION. UNLESS OTHERWISE NOTED, NO INVESTIGATION HAS BEEN UNDERTAKEN OR REPORTED ON BY THIS OFFICE IN REGARD TO THE ENVIRONMENTAL CONDITION OF THIS SITE.

THIS DRAWING IS NOT TO BE SCALED. ALL ARCHITECTURAL SYMBOLS INDICATED ON THIS DRAWING ARE GRAPHIC REPRESENTATIONS ONLY.

CONDITIONS FOR ELECTRONIC INFORMATION TRANSFER:

ELECTRONIC INFORMATION IS SUPPLIED TO THE OTHER ASSOCIATED FIRMS TO ASSIST THEM IN THE EXECUTION OF THEIR WORK. REVIEW THE RECIPIENT FIRMS MUST DETERMINE THE COMPLETENESS, APPROPRIATENESS, RELIANCE OF THE INFORMATION IN RESPECT TO THEIR PARTICULAR RESPONSIBILITY.

GRAZIANI-CORAZZA ARCHITECTS INC. SHALL NOT BE RESPONSIBLE FOR ERRORS, OMISSIONS, INCOMPLETENESS DUE TO LOSS OF INFORMATION IN WHOLE OR PART WHEN INFORMATION IS TRANSMITTED.

1. TRANSMISSION OF ANY VIRUS OR DAMAGE TO THE RECEIVING ELECTRONIC SYSTEM WHEN INFORMATION IS TRANSMITTED.

- 01. Oct.07.2019 issued for tender
- 02. Mar.13.2020 issued for design coordination #2
- 03. Mar.16.2020 issued for addendum #2
- 04. Mar.16.2020 issued for addendum #3
- 05. Aug.24.2020 issued for addendum #4
- 06. Sept. 28.2020 issued for permit
- 07. Oct.20.2020 issued for addendum #5
- 08. Nov.23.2020 issued for addendum #6
- 09. Dec.14.2020 issued for addendum #7
- 10. Jan.15.2021 issued for addendum #8
- 11. Mar. 2. 2021 issued for permit
- 12. Mar.09.2021 issued for addendum #9
- 13. Mar.10.2021 issued for addendum #9R
- 14. Mar.26.2021 issued for progress
- 15. May.14. 2021 issued for Site Instruction #1
- 16. June.15. 2021 issued for Site Instruction #2
- 17. July. 7. 2021 re-issued for permit
- 18. July. 15. 2021 issued for Site Instruction #3
- 19. July. 27. 2021 issued for Site Instruction #4
- 20. Aug. 3. 2021 issued for Site Instruction #5
- 21. Aug. 5. 2021 issued for Site Instruction #6

- 01. Apr.19.2021 issued to client
- issued for revisions

GRAZIANI CORAZZA ARCHITECTS

1333 SHAWNEE DRIVE, SUITE 100 MISSISSAUGA, ONTARIO L4W 1C3
905.709.1201 P.905.709.1200 WWW.GC-ARCHITECTS.COM

ATTMAR + PALLESCHI DRIVE

BRAMPTON ONTARIO

PROJECT ARCHITECT: B. GRAZIANI
ASSISTANT DESIGNER: R. LINCOLN
DRAWN BY: G.C./F.C./M.B.
CHECKED BY: D. BIASSE/G. COLANGELO
PLOT DATE: AUG.18.2021
JOB #: 1331.15

**ROOF PLAN
BUILDING A (PARTIAL PLAN)**

1:50 **A-305a2**

TITLEBLOCK SIZE: 915 x 1200

