THE MACKENZIE (20-09)

INVENTORY

20-09 The MACKENZIE EL. A
BLK. 59 TH-23

ELEVATION A
1670
SQUARE FEET
INCLUDES 8.0SQ.FT. GRILL AREA

TOWN HOME

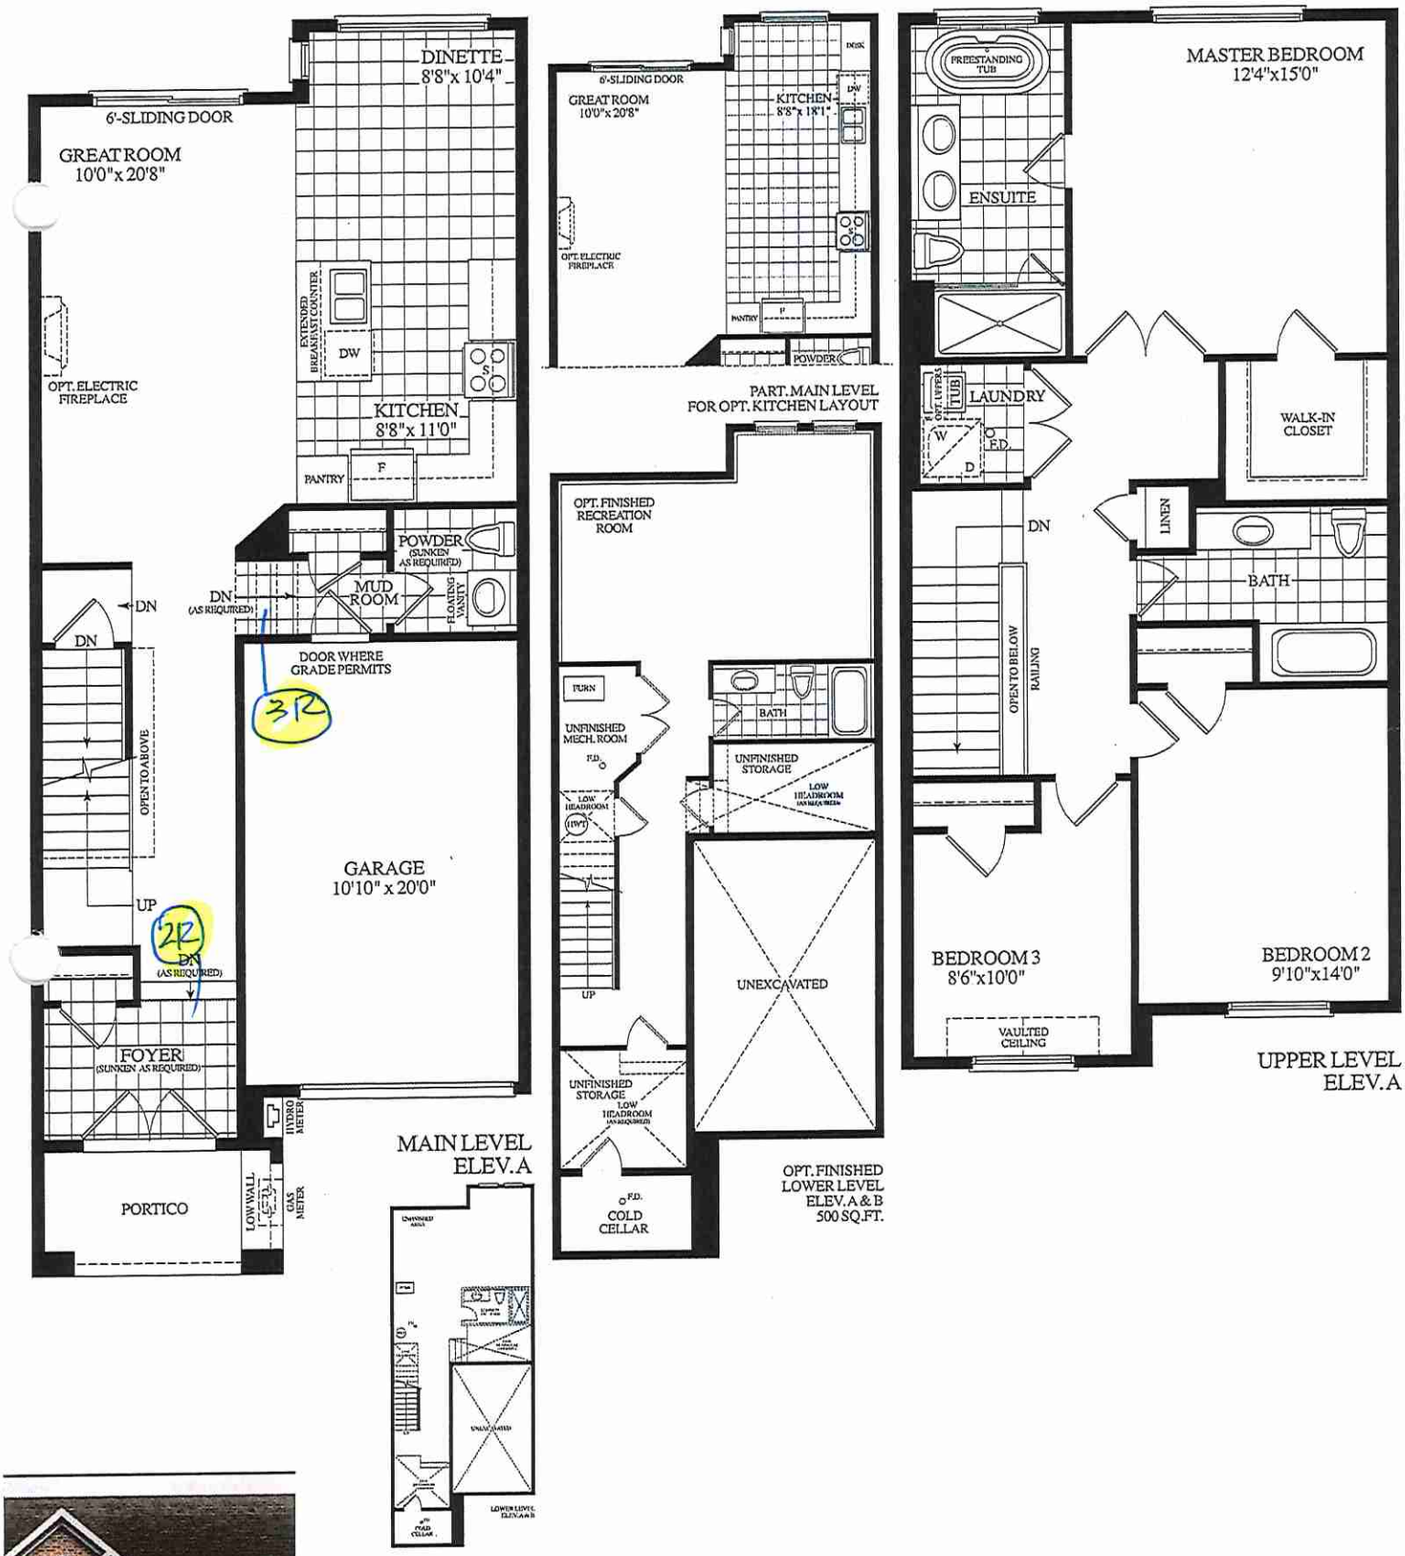

ELEV. A

1670
SQUARE FEET

BLK 59 - TH -23
Inventory

ROYAL PINE HOMES