
DocuSign Envelope ID: BFDBD3G8-7B71-4927-9808-65C131FBAF5D



34 GLASS CURRENT AND UNAVAILABLE

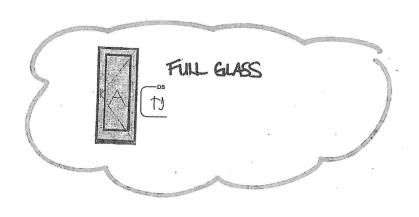





PURCHASER'S EXTRAS (PE)

Oak Ridge Meadows - Grovetrail Developments Inc.

PURCHASER: THOMAS JIN

TEL:

LOT NU		PHASE 1	HOUSE TYPE LAWRENCE Elev A	1	REG. PLAN # 65M-4696		
Item	QTY		Descript	ion		Addition to Purchase Price	
1	pane from Note: *	nt door, R *See atta	RIOR DOUBLE DOOR- Due to the poss eplacement substitute model of FULL GL ched picture for reference** Purchase door is available at time of constructitalled.	ASS pane, for the r is aware that	the front double door entry. if the original 3/4 glass		
2	SIGNIN	G THIS P	AWARE AND ACCEPTS THAT ANY OUTCHASERS EXTRA FORM ARE SUITED FEE OF \$1,000 PLUS A 10% HOLD	BJECT TO A MI		R \$ 0.00	
	0					\$0.00 \$0.00 \$0.00	Sub Total HST Total
 In the event the work on the house has progressed beyond the point where the items covered by this extra cannot be installed without entailing any unusual expense, then this order is to be cancelled and any deposit paid in connection with the same is to be refunded to the Purchaser. The Vendor will undertake to incorporate the work covered by the sales extra in the construction of the house but will not be liable to the purchaser in any way, if for any reason the work covered by the extra is not carried out. In that event, any monies paid in connection with the same shall be returned to the Purchaser. It is understood and agreed that if for any reason whatsoever the transaction of Purchase and Sale is not completed, the total cost of extras ordered are not refundable to the Purchaser(s). Extras or changes will not be processed unless signed by the Vendor. These extras may not be amended without the written consent of Grovetrail Developments Inc The Purchaser(s) and the Vendor acknowledge and agree that this form shall not be deemed to be part of the Agreement of Purchase and Sale entered into between them, nor an addendum thereto. No Estimates or orders will be accepted once construction has commenced. Prices are estimates only and guaranteed for a period of 5 days only. Any cancellations to this order, providing they can be cancelled, are subject to a \$500 minimum administration charge and a 10% cancellation charge for the total amount being cancelled. For Visa, Mastercard and Debit paments, transactions are identified on you statement as "SHERWAY CONSTRUCTION LTD", an Authorized Visa /Mastercard/Debit Merchant and authorized Royal Pine Homes company. 							
Paid B Bonus		ary	Amount Detail \$0.00 \$0.00				
PURCHA	SER:	THO	MAS JIN	22-Sep-21 DATE	CONSULTANT:		lelissa Di Marin etrail Developments In

Decor Builder Purchaser Printed: 22-Sep-21 at 10:47 am