


09/03/2021

RECEIVED

Per: jocelyn.aguilar**Schedule 1: Designer Information**

Use one form for each individual who reviews and takes responsibility for design activities with respect to the project.

<b>A. Project Information</b>			
Building number, street name		Unit no.	Lot/con.
Municipality RICHMOND HILL	Postal code	Plan number/ other description	
<b>B. Individual who reviews and takes responsibility for design activities</b>			
Name <b>MICHAEL O'ROURKE</b>		Firm <b>HVAC DESIGNS LTD.</b>	
Street address <b>375 FINLEY AVE</b>		Unit no. <b>202</b>	Lot/con. <b>N/A</b>
Municipality <b>AJAX</b>	Postal code <b>L1S 2E2</b>	Province <b>ONTARIO</b>	E-mail <b>info@hvacdesigns.ca</b>
Telephone number <b>(905) 619-2300</b>	Fax number <b>(905) 619-2375</b>	Cell number ( )	
<b>C. Design activities undertaken by individual identified in Section B. [Building Code Table 3.5.2.1 OF Division C]</b>			
<input type="checkbox"/> House <input type="checkbox"/> Small Buildings <input type="checkbox"/> Large Buildings <input type="checkbox"/> Complex Buildings <input checked="" type="checkbox"/> HVAC – House <input type="checkbox"/> Building Services <input type="checkbox"/> Detection, Lighting and Power <input type="checkbox"/> Fire Protection <input type="checkbox"/> Building Structural <input type="checkbox"/> Plumbing – House <input type="checkbox"/> Plumbing – All Buildings <input type="checkbox"/> On-site Sewage Systems			
Description of designer's work <b>HEAT LOSS / GAIN CALCULATIONS DUCT SIZING RESIDENTIAL MECHANICAL VENTILATION DESIGN SUMMARY RESIDENTIAL SYSTEM DESIGN per CSA-F280-12</b>		<b>Model:</b> 2010 <b>Mill Pond</b> <b>Project:</b> CENTREFIELD (WEST GORMLEY)	
<b>D. Declaration of Designer</b>			
I, <u>MICHAEL O'ROURKE</u> (print name)		declare that (choose one as appropriate):	
<input type="checkbox"/> I review and take responsibility for the design work on behalf of a firm registered under subsection 3.2.4. of Division C, of the Building Code. I am qualified, and the firm is registered, in the classes/categories. Individual BCIN: _____ Firm BCIN: _____		<input type="checkbox"/> I review and take responsibility for the design and am qualified in the appropriate category as an "other designer" under subsection 3.2.5. of Division C, of the Building Code. Individual BCIN: <u>19669</u> Basis for exemption from registration and qualification: _____ O.B.C. SENTENCE 3.2.4.1 (4)	
<input type="checkbox"/> The design work is exempt from the registration and qualification requirements of the Building Code. Basis for exemption from registration and qualification: _____			
I certify that:			
1. The information contained in this schedule is true to the best of my knowledge. 2. I have submitted this application with the knowledge and consent of the firm.			
April 21, 2021 Date		 Signature of Designer	

## NOTE:

- For the purposes of this form, "individual" means the "person" referred to in Clause 3.2.4.7(1) d) of Division C, Article 3.2.5.1. of Division C, and all other persons who are exempt from qualification under Subsections 3.2.4. and 3.2.5. of Division C.
- Schedule 1 is not required to be completed by a holder of a license, temporary license, or a certificate of authorization, issued by the Ontario Association of Architects. Schedule 1 is also not required to be completed by a holder of a license to practise, a limited license to practise, or a certificate of authorization, issued by the Association of Professional Engineers of Ontario.

Application for a Permit Construct or Demolish – Effective January 1, 2015

09/03/2021

RECEIVED  
Per: jocelyn.aquilar

## HVAC REVIEWED

Initials: PXV

ROOM USE					K/B/G		LAUND		PWD		FOY								BAS		
EXP. WALL					49		7		12		36								120		
CLG. HT.					10		9		10		11								10		
FACTORS																					
GRS.WALL AREA	LOSS	GAIN			495		63		121		382								1200		
GLAZING					LOSS GAIN		LOSS GAIN		LOSS GAIN		LOSS GAIN								LOSS GAIN		
NORTH	21.8	16.0	0	0	0		0	0	0	0	0	0	0	0					0	0	0
EAST	21.8	41.6	0	0	0		0	0	0	0	0	20	436	831					0	0	0
SOUTH	21.8	24.9	71	1547	1768		33	719	822	0	0	0	65	1416	1618				3	65	75
WEST	21.8	41.6	80	1743	3324		0	0	0	0	0	0	0	0	0				7	152	291
SKYLT.	35.8	101.2	0	0	0		0	0	0	0	0	0	0	0	0				0	0	0
DOORS	25.8	4.3	0	0	0		0	0	0	20	517	85	50	1292	213				20	517	85
NET EXPOSED WALL	4.2	0.7	344	1446	238		30	126	21	101	426	70	247	1037	171				0	0	0
NET EXPOSED BSMT WALL ABOVE GR	3.7	0.6	0	0	0		0	0	0	0	0	0	0	0	0				0	0	0
EXPOSED CLG	1.3	0.6	0	0	0		56	74	33	0	0	0	0	0	0				0	0	0
NO ATTIC EXPOSED CLG	2.8	1.3	31	87	39		0	0	0	0	0	0	0	0	0				0	0	0
EXPOSED FLOOR	2.6	0.4	0	0	0		0	0	0	0	0	0	0	0	0				0	0	0
BASEMENT/CRAWL HEAT LOSS				0				0					0								
SLAB ON GRADE HEAT LOSS				0				0					0								
SUBTOTAL HT LOSS				4823				919		943			4181						4679		
SUB TOTAL HT GAIN					5369				875		155		2833							451	
LEVEL FACTOR / MULTIPLIER			0.30	0.24			0.20	0.17		0.30	0.24		0.30	0.24					0.50	0.86	
AIR CHANGE HEAT LOSS				1168				152			228			1013						4016	
AIR CHANGE HEAT GAIN					194				32		6			103							16
DUCT LOSS				0				0			0			0						0	
DUCT GAIN					0				0		0			0							0
HEAT GAIN PEOPLE	240			0	0			0	0	0	0	0		0	0				0		0
HEAT GAIN APPLIANCES/LIGHTS					643				643		0			0					0		0
TOTAL HT LOSS BTU/H				5991				1071		1171			5194							8695	
TOTAL HT GAIN x 1.3 BTU/H					8068				2015		209			3816							6070

19.73  
btu/ft2

TOTAL HEAT GAIN BTU/H:	29592	TONS: 2.47	LOSS DUE TO VENTILATION LOAD BTU/H: 1336	STRUCTURAL HEAT LOSS: 33038	TOTAL COMBINED HEAT LOSS BTU/H: 34374
------------------------	-------	------------	--	-----------------------------	---------------------------------------

33.29  
btu/ft2

CITY OF RICHMOND HILL  
BUILDING DIVISION  
09/03/2021

SITE NAME: CENTREFIELD (WEST GORMLEY)  
BUILDER: ROYAL PINE HOMES

TYPE: 2010

DATE: Apr-21

GFA: 1742 LO# 87540

HEATING CFM 875 COOLING CFM 875  
TOTAL HEAT LOSS 33,038 TOTAL HEAT GAIN 29,372  
AIR FLOW RATE CFM 26.48 AIR FLOW RATE CFM 29.79

furnace pressure 0.6  
furnace filter 0.05  
a/c coil pressure 0.2  
available pressure for s/a & r/a 0.35

**\*\*CARRIER** AFUE = 97 %  
**59TN6A-060-14V** INPUT (BTU/H) = 60,000  
FAN SPEED **60** OUTPUT (BTU/H) = **58,000**  
LOW 820  
MEDLOW 875  
MEDIUM 0  
MEDIUM HIGH 0  
HIGH 1520  
DESIGN CFM = **875**  
CFM @ .6" E.S.P.

RUN COUNT	4th	3rd	2nd	1st	Bas
S/A	0	0	8	6	3
R/A	0	0	4	2	1

All S/A diffusers 4"x10" unless noted otherwise on layout.

All S/A runs 5"Ø unless noted otherwise on layout.

RUN #	1	2	4	5	6	7	10	13	14	15	17	18	19	20	21	22
ROOM NAME	MBR	ENS	BED-2	BED-3	BED-3	BATH	MBR	K/B/G	K/B/G	K/B/G	LAUND	PWD	FOY	FOY	BAS	BAS
RM LOSS MBH.	0.86	1.79	2.00	2.56	2.56	0.29	0.86	2.00	2.00	2.00	1.07	1.17	2.60	2.60	2.90	2.90
CFM PER RUN HEAT	23	47	53	68	68	8	23	53	53	53	28	31	69	69	77	77
RM GAIN MBH.	1.79	1.51	3.32	3.08	3.08	0.09	1.79	2.69	2.69	2.69	2.02	0.21	1.91	1.91	0.20	0.20
CFM PER RUN COOLING	53	45	99	92	92	3	53	80	80	80	60	6	57	57	6	6
ADJUSTED PRESSURE	0.17	0.17	0.16	0.16	0.16	0.17	0.17	0.17	0.17	0.17	0.17	0.17	0.17	0.17	0.17	0.17
ACTUAL DUCT LGH.	40	25	48	55	46	29	33	4	19	24	41	22	34	36	24	13
EQUIVALENT LENGTH	110	130	130	190	170	150	110	150	150	170	190	160	110	130	160	160
TOTAL EFFECTIVE LENGTH	150	155	178	245	216	179	143	154	169	194	231	182	144	166	184	173
ADJUSTED PRESSURE	0.11	0.11	0.09	0.07	0.08	0.1	0.12	0.11	0.1	0.09	0.07	0.09	0.12	0.1	0.09	0.1
ROUND DUCT SIZE	5	4	6	6	6	4	5	5	5	5	5	4	5	5	5	5
HEATING VELOCITY (ft/min)	169	539	270	347	347	92	169	389	389	389	206	356	507	507	565	565
COOLING VELOCITY (ft/min)	389	516	505	469	469	34	389	587	587	587	441	69	419	419	44	44
OUTLET GRILL SIZE	3X10	3X10	4X10	4X10	4X10	3X10	3X10	3X10	3X10	3X10	3X10	3X10	3X10	3X10	3X10	3X10
TRUNK	C	C	B	A	A	B	C	B	C	C	B	B	A	A	C	C

RUN #	25
ROOM NAME	BAS
RM LOSS MBH.	2.90
CFM PER RUN HEAT	77
RM GAIN MBH.	0.20
CFM PER RUN COOLING	6
ADJUSTED PRESSURE	0.17
ACTUAL DUCT LGH.	35
EQUIVALENT LENGTH	120
TOTAL EFFECTIVE LENGTH	155
ADJUSTED PRESSURE	0.11
ROUND DUCT SIZE	5
HEATING VELOCITY (ft/min)	565
COOLING VELOCITY (ft/min)	44
OUTLET GRILL SIZE	3X10
TRUNK	A

SUPPLY AIR TRUNK SIZE														RETURN AIR TRUNK SIZE									
	TRUNK	STATIC	ROUND	RECT			VELOCITY		TRUNK	STATIC	ROUND	RECT		VELOCITY		TRUNK	STATIC	ROUND	RECT			VELOCITY	
	CFM	PRESS.	DUCT	DUCT			(ft/min)		CFM	PRESS.	DUCT	DUCT		(ft/min)		CFM	PRESS.	DUCT	DUCT			(ft/min)	
TRUNK A	351	0.07	9.8	12	x	8	527	TRUNK G	0	0.00	0	0	x	8	0	TRUNK O	0	0.05	0	0	x	8	0
TRUNK B	524	0.07	11.4	16	x	8	590	TRUNK H	0	0.00	0	0	x	8	0	TRUNK P	0	0.05	0	0	x	8	0
TRUNK C	353	0.09	9.2	10	x	8	635	TRUNK I	0	0.00	0	0	x	8	0	TRUNK Q	0	0.05	0	0	x	8	0
TRUNK D	0	0.00	0	0	x	8	0	TRUNK J	0	0.00	0	0	x	8	0	TRUNK R	0	0.05	0	0	x	8	0
TRUNK E	0	0.00	0	0	x	8	0	TRUNK K	0	0.00	0	0	x	8	0	TRUNK S	0	0.05	0	0	x	8	0
TRUNK F	0	0.00	0	0	x	8	0	TRUNK L	0	0.00	0	0	x	8	0	TRUNK T	0	0.05	0	0	x	8	0

RETURN AIR #	1	2	3	4	5	6	0	0	0	0	0	0	0	0	0	BR
AIR VOLUME	95	85	85	75	330	105	0	0	0	0	0	0	0	0	0	100
PLENUM PRESSURE	0.15	0.15	0.15	0.15	0.15	0.15	0.15	0.15	0.15	0.15	0.15	0.15	0.15	0.15	0.15	0.15
ACTUAL DUCT LGH.	57	46	56	55	18	35	1	1	1	1	1	1	1	1	1	14
EQUIVALENT LENGTH	165	205	175	215	190	155	0	0	0	0	0	0	0	0	0	150
TOTAL EFFECTIVE LH	222	251	231	270	208	190	1	1	1	1	1	1	1	1	1	164
ADJUSTED PRESSURE	0.07	0.06	0.06	0.05	0.07	0.08	14.80	14.80	14.80	14.80	14.80	14.80	14.80	14.80	14.80	0.09
ROUND DUCT SIZE	6	6	6	6	9.6	6	0	0	0	0	0	0	0	0	0	5.7
INLET GRILL SIZE	8	8	8	8	6	6	0	0	0	0	0	0	0	0	0	8
INLET GRILL SIZE	X	X	X	X	X	X	X	X	X	X	X	X	X	X	X	X
INLET GRILL SIZE	14	14	14	14	24	10	0	0	0	0	0	0	0	0	0	14

TYPE: 2010  
SITE NAME: CENTREFIELD (WEST GORMLEY)

LO # 87540

09/03/2021

**RESIDENTIAL MECHANICAL VENTILATION DESIGN SUMMARY**

COMBUSTION APPLIANCES		9.32.3.1(1)
a)	<input checked="" type="checkbox"/> Direct vent (sealed combustion) only	
b)	<input type="checkbox"/> Positive venting induced draft (except fireplaces)	
c)	<input type="checkbox"/> Natural draft, B-vent or induced draft gas fireplace	
d)	<input type="checkbox"/> Solid Fuel (including fireplaces)	
e)	<input type="checkbox"/> No Combustion Appliances	

HEATING SYSTEM	
<input checked="" type="checkbox"/> Forced Air	<input type="checkbox"/> Non Forced Air
<input type="checkbox"/> Electric Space Heat	

HOUSE TYPE		9.32.1(2)
<input checked="" type="checkbox"/> I	Type a) or b) appliance only, no solid fuel	
<input type="checkbox"/> II	Type I except with solid fuel (including fireplaces)	
<input type="checkbox"/> III	Any Type c) appliance	
<input type="checkbox"/> IV	Type I, or II with electric space heat	
<input type="checkbox"/> Other:	Type I, II or IV no forced air	

SYSTEM DESIGN OPTIONS		O.N.H.W.P.
<input type="checkbox"/> 1	Exhaust only/Forced Air System	
<input type="checkbox"/> 2	HRV with Ducting/Forced Air System	
<input checked="" type="checkbox"/> 3	HRV Simplified/connected to forced air system	
<input type="checkbox"/> 4	HRV with Ducting/non forced air system	
<input type="checkbox"/>	Part 6 Design	

TOTAL VENTILATION CAPACITY		9.32.3.3(1)
Basement + Master Bedroom	<u>2</u> @ 21.2 cfm	<u>42.4</u> cfm
Other Bedrooms	<u>2</u> @ 10.6 cfm	<u>21.2</u> cfm
Kitchen & Bathrooms	<u>4</u> @ 10.6 cfm	<u>42.4</u> cfm
Other Rooms	<u>1</u> @ 10.6 cfm	<u>10.6</u> cfm
Table 9.32.3.A. TOTAL		<u>116.6</u> cfm

PRINCIPAL VENTILATION CAPACITY REQUIRED		9.32.3.4.(1)
1 Bedroom	31.8	cfm
2 Bedroom	47.7	cfm
3 Bedroom	63.6	cfm
4 Bedroom	79.5	cfm
5 Bedroom	95.4	cfm
TOTAL		<u>63.6</u> cfm

SUPPLEMENTAL VENTILATION CAPACITY		9.32.3.5.
Total Ventilation Capacity	<u>63.6</u>	cfm
Less Principal Ventil. Capacity	<u>63.6</u>	cfm
Required Supplemental Capacity	<u>53.0</u>	cfm

PRINCIPAL EXHAUST FAN CAPACITY	
Model:	VANEE 65H
Location:	BSMT
<u>63.6</u> cfm	<input checked="" type="checkbox"/> HVI Approved

PRINCIPAL EXHAUST HEAT LOSS CALCULATION				
CFM	$\Delta T$ °F	FACTOR	% LOSS	
63.6 CFM	X 78 F	X 1.08	X	0.25

SUPPLEMENTAL FANS		BY INSTALLING CONTRACTOR		
Location	Model	cfm	HVI	Sones
ENS	BY INSTALLING CONTRACTOR	50	<input checked="" type="checkbox"/>	3.5
BATH	BY INSTALLING CONTRACTOR	50	<input checked="" type="checkbox"/>	3.5
PWD	BY INSTALLING CONTRACTOR	50	<input checked="" type="checkbox"/>	3.5

HEAT RECOVERY VENTILATOR		9.32.3.11.
Model:	VANEE 65H	
<u>155</u> cfm high	<u>64</u> cfm low	
<u>75</u> % Sensible Efficiency @ 32 deg F (0 deg C)	<input checked="" type="checkbox"/> HVI Approved	

LOCATION OF INSTALLATION		Richmond Hill City of Richmond Hill Concession Building Division
Lot:		<b>HVAC REVIEWED</b> Initials: <u>PXV</u>
Township		
Address		
Roll #		

BUILDER:		ROYAL PINE HOMES
Name:		
Address:		
City:		
Telephone #:	Fax #:	

INSTALLING CONTRACTOR	
Name:	
Address:	
City:	
Telephone #:	Fax #:

DESIGNER CERTIFICATION	
I hereby certify that this ventilation system has been designed in accordance with the Ontario Building Code.	
Name:	HVAC Designs Ltd.
Signature:	<i>Michael O'Rourke</i>
HRAI #	001820
Date:	April-21

09/03/2021

RECEIVED

 Per: jocelyn.aguilar

CSA F280-12 Residential Heat Loss and Heat Gain Calculations	
Formula Sheet (For Air Leakage / Ventilation Calculation)	
LO#: 87540	Model: 2010	Builder: ROYAL PINE HOMES	Date: 4/21/2021	
<b>Volume Calculation</b>			<b>Air Change &amp; Delta T Data</b>	
<b>House Volume</b> <table border="1" style="width:100%; border-collapse: collapse;"> <thead> <tr> <th>Level</th> <th>Floor Area (ft²)</th> <th>Floor Height (ft)</th> <th>Volume (ft³)</th> </tr> </thead> <tbody> <tr><td>Bsmt</td><td>777</td><td>10</td><td>7770</td></tr> <tr><td>First</td><td>777</td><td>10</td><td>7847.7</td></tr> <tr><td>Second</td><td>978</td><td>9</td><td>8802</td></tr> <tr><td>Third</td><td>0</td><td>9</td><td>0</td></tr> <tr><td>Fourth</td><td>0</td><td>9</td><td>0</td></tr> <tr><td colspan="3" style="text-align: right;">Total:</td><td>24,419.7 ft³</td></tr> <tr><td colspan="3" style="text-align: right;">Total:</td><td>691.5 m³</td></tr> </tbody> </table>			Level	Floor Area (ft²)	Floor Height (ft)	Volume (ft³)	Bsmt	777	10	7770	First	777	10	7847.7	Second	978	9	8802	Third	0	9	0	Fourth	0	9	0	Total:			24,419.7 ft³	Total:			691.5 m³	<table border="1" style="width:100%; border-collapse: collapse;"> <tr> <td style="width: 80%;">WINTER NATURAL AIR CHANGE RATE</td> <td style="width: 20%;">0.236</td> </tr> <tr> <td>SUMMER NATURAL AIR CHANGE RATE</td> <td>0.072</td> </tr> </table> <table border="1" style="width:100%; border-collapse: collapse;"> <tr> <th colspan="5" style="text-align: center;">Design Temperature Difference</th> </tr> <tr> <th></th> <th>Tin °C</th> <th>Tout °C</th> <th>ΔT °C</th> <th>ΔT °F</th> </tr> <tr> <td>Winter DTDh</td> <td>22</td> <td>-21</td> <td>43</td> <td>78</td> </tr> <tr> <td>Summer DTDc</td> <td>24</td> <td>31</td> <td>7</td> <td>13</td> </tr> </table>		WINTER NATURAL AIR CHANGE RATE	0.236	SUMMER NATURAL AIR CHANGE RATE	0.072	Design Temperature Difference						Tin °C	Tout °C	ΔT °C	ΔT °F	Winter DTDh	22	-21	43	78	Summer DTDc	24	31	7	13
Level	Floor Area (ft²)	Floor Height (ft)	Volume (ft³)	
Bsmt	777	10	7770	
First	777	10	7847.7	
Second	978	9	8802	
Third	0	9	0	
Fourth	0	9	0	
Total:			24,419.7 ft³	
Total:			691.5 m³	
WINTER NATURAL AIR CHANGE RATE	0.236	
SUMMER NATURAL AIR CHANGE RATE	0.072	
Design Temperature Difference	
	Tin °C	Tout °C	ΔT °C	ΔT °F	
Winter DTDh	22	-21	43	78	
Summer DTDc	24	31	7	13	
<b>5.2.3.1 Heat Loss due to Air Leakage</b>			<b>6.2.6 Sensible Gain due to Air Leakage</b>	
$HL_{airb} = LR_{airh} \times \frac{V_b}{3.6} \times DTD_h \times 1.2$ <p>0.236 x 192.08 x 43 °C x 1.2 = 2354 W</p> <p>= 8032 Btu/h</p>			$HG_{salb} = LR_{airc} \times \frac{V_b}{3.6} \times DTD_c \times 1.2$ <p>= 0.072 x 192.08 x 7 °C x 1.2 = 117 W</p> <p>= 401 Btu/h</p>	
<b>5.2.3.2 Heat Loss due to Mechanical Ventilation</b>			<b>6.2.7 Sensible heat Gain due to Ventilation</b>	
$HL_{vairb} = PVC \times DTD_h \times 1.08 \times (1 - E)$ <p>64 CFM x 78 °F x 1.08 x 0.25 = 1336 Btu/h</p>			$HL_{vairb} = PVC \times DTD_h \times 1.08 \times (1 - E)$ <p>64 CFM x 13 °F x 1.08 x 0.25 = 220 Btu/h</p>	
<b>5.2.3.3 Calculation of Air Change Heat Loss for Each Room (Floor Multiplier Section)</b>	
$HL_{airr} = Level\ Factor \times HL_{airbv} \times \{(HL_{agcr} + HL_{bgcr}) \div (HL_{agclevel} + HL_{bgclevel})\}$ <table border="1" style="width:100%; border-collapse: collapse;"> <thead> <tr> <th>Level</th> <th>Level Factor (LF)</th> <th>HLairve Air Leakage + Ventilation Heat Loss (Btu/h)</th> <th>Level Conductive Heat Loss: (HL<sub>clevel</sub>)</th> <th>Air Leakage Heat Loss Multiplier (LF x HLairbv / HL<sub>clevel</sub>)</th> </tr> </thead> <tbody> <tr><td>1</td><td>0.5</td><td rowspan="5">8,032</td><td>4,679</td><td>0.858</td></tr> <tr><td>2</td><td>0.3</td><td>9,946</td><td>0.242</td></tr> <tr><td>3</td><td>0.2</td><td>9,708</td><td>0.165</td></tr> <tr><td>4</td><td>0</td><td>0</td><td>0.000</td></tr> <tr><td>5</td><td>0</td><td>0</td><td>0.000</td></tr> </tbody> </table>					Level	Level Factor (LF)	HLairve Air Leakage + Ventilation Heat Loss (Btu/h)	Level Conductive Heat Loss: (HL <sub>clevel</sub> )	Air Leakage Heat Loss Multiplier (LF x HLairbv / HL <sub>clevel</sub> )	1	0.5	8,032	4,679	0.858	2	0.3	9,946	0.242	3	0.2	9,708	0.165	4	0	0	0.000	5	0	0	0.000																														
Level	Level Factor (LF)	HLairve Air Leakage + Ventilation Heat Loss (Btu/h)	Level Conductive Heat Loss: (HL <sub>clevel</sub> )	Air Leakage Heat Loss Multiplier (LF x HLairbv / HL <sub>clevel</sub> )	
1	0.5	8,032	4,679	0.858	
2	0.3		9,946	0.242	
3	0.2		9,708	0.165	
4	0		0	0.000	
5	0		0	0.000	
<p>*HLairbv = Air leakage heat loss + ventilation heat loss</p> <p>*For a balanced or supply only ventilation system HLairve = 0</p>	

 City of Richmond Hill  
 Building Division

HVAC REVIEWED

 Initials: PXV

**HEAT LOSS AND GAIN SUMMARY SHEET**

09/03/2021

**MODEL:** 2010

**BUILDER:** ROYAL PINE HOMES

**SFQT:** 1742

**LO#** 87540

**SITE:** CENTREFIELD (WEST GORMLEY)

**DESIGN ASSUMPTIONS**

HEATING	°F	COOLING	°F
OUTDOOR DESIGN TEMP.	-6	OUTDOOR DESIGN TEMP.	88
INDOOR DESIGN TEMP.	72	INDOOR DESIGN TEMP. (MAX 75°F)	75

**BUILDING DATA**

ATTACHMENT:	ATTACHED	# OF STORIES (+BASEMENT):	3
FRONT FACES:	EAST	ASSUMED (Y/N):	Y
AIR CHANGES PER HOUR:	2.50	ASSUMED (Y/N):	Y
AIR TIGHTNESS CATEGORY:	TIGHT	ASSUMED (Y/N):	Y
WIND EXPOSURE:	SHELTERED	ASSUMED (Y/N):	Y
HOUSE VOLUME (ft³):	24419.7	ASSUMED (Y/N):	Y
INTERNAL SHADING:	BLINDS/CURTAINS	ASSUMED OCCUPANTS:	4
INTERIOR LIGHTING LOAD (Btu/h/ft²):	1.27	DC BRUSHLESS MOTOR (Y/N):	Y
FOUNDATION CONFIGURATION	BCIN_1	DEPTH BELOW GRADE:	7.0 ft
LENGTH: 52.0 ft	WIDTH: 22.0 ft	EXPOSED PERIMETER:	120.0 ft

3 ach/hr to be used

**2012 OBC - COMPLIANCE PACKAGE**
**Component**
**Compliance Package  
SB-12 PERFORMANCE**
**Nominal Min. Eff.**

Ceiling with Attic Space Minimum RSI (R)-Value	60	59.20
Ceiling Without Attic Space Minimum RSI (R)-Value	31	27.70
Exposed Floor Minimum RSI (R)-Value	31	29.80
Walls Above Grade Minimum RSI (R)-Value	22+1.5	18.50
Basement Walls Minimum RSI (R)-Value	20	21.12
Below Grade Slab Entire surface > 600 mm below grade Minimum RSI (R)-Value	-	-
Edge of Below Grade Slab ≤ 600 mm Below Grade Minimum RSI (R)-Value	10	10
Heated Slab or Slab ≤ 600 mm below grade Minimum RSI (R)-Value	10	11.13
Windows and Sliding Glass Doors Maximum U-Value	1.6	-
Skylights Maximum U-Value	2.6	-
Space Heating Equipment Minimum AFUE	0.96	-
HRV Minimum Efficiency	75%	-
Domestic Hot Water Heater Minimum EF	TE=94%	-

INDIVIDUAL BCIN: 19669

MICHAEL O'ROURKE


*Michael O'Rourke*

RECEIVED

Per: [Signature]

**Residential Foundation Thermal Load Calculator**

Supplemental tool for CAN/CSA-F280

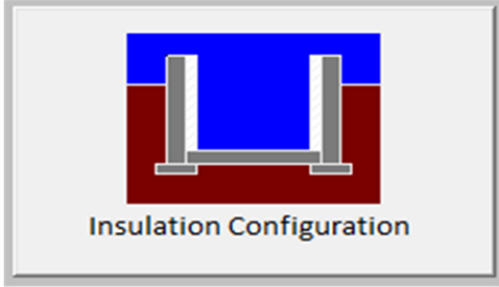Weather Station Description		
Province:	Ontario	
Region:	Richmond Hill	
Site Description		
Soil Conductivity:	Normal conductivity: dry sand, loam, clay	
Water Table:	Normal (7-10 m, 23-33 ft)	
Foundation Dimensions		
Floor Length (m):	15.8	 Insulation Configuration
Floor Width (m):	6.7	
Exposed Perimeter (m):	36.6	
Wall Height (m):	3.0	
Depth Below Grade (m):	2.13	
Window Area (m <sup>2</sup> ):	0.9	
Door Area (m <sup>2</sup> ):	1.9	
Radiant Slab		
Heated Fraction of the Slab:	0	
Fluid Temperature (°C):	33	
Design Months		
Heating Month	1	
Foundation Loads		
Heating Load (Watts):		1156

TYPE: 2010

LO# 87540

RECEIVED  
Per: jocelyn.aguilar

# Air Infiltration Residential Load Calculator

Supplemental tool for CAN/CSA-F280

Weather Station Description			
Province:	Ontario		
Region:	Richmond Hill		
Weather Station Location:	Open flat terrain, grass		
Anemometer height (m):	10		
Local Shielding			
Building Site:	Suburban, forest		
Walls:	Heavy		
Flue:	Heavy		
Highest Ceiling Height (m):	6.74		
Building Configuration			
Type:	Semi		
Number of Stories:	Two		
Foundation:	Full		
House Volume (m <sup>3</sup> ):	691.5		
Air Leakage/Ventilation			
Air Tightness Type:	Energy Star Detached (2.5 ACH)		
Custom BDT Data:	ELA @ 10 Pa. 2.50	645.5 cm <sup>2</sup> ACH @ 50 Pa	
Mechanical Ventilation (L/s):	Total Supply 30.0	Total Exhaust 30.0	
Flue Size			
Flue #:	#1	#2	#3
Diameter (mm):	0	0	0
Natural Infiltration Rates			
Heating Air Leakage Rate (ACH/H):	0.236		
Cooling Air Leakage Rate (ACH/H):	0.072		

TYPE: 2010  
LO# 87540

3 ach to be used

Exterior insulation effective R-Value for wall, roof or exposed floor shall be maintained at the respective location where duct or sanitary pipes are routed inside exterior envelope.

Ensure that R-Values and U-Values used for heat loss and heat gain calculations are consistent with the values specified by SB-12 Performance Compliance: Energy Modeling/air leak test and the values used for architectural design.

Minimum R-12 Insulation Value required for ducts installed at unheated or exposed condition (OBC 2012 Div.B 6.2.4.3(10) and seal the ducts as per 6.2.4.3(11) & HRAI Digest 2005, Clause 4.5.

Penetration of Air Barrier System by ducts, wires, conduits or building materials shall be sealed as per OBC 2012, Div.B 9.25.3.3.(9) & (10).

HRV Unit shall be energy qualified complete with sealed and insulated connection to outdoor vent hoods per Energy Star Technical Specification 4.7.1.2. When HRV is used as principal fan, the controller shall be wired to the HRV Unit and interconnected to the furnace fan. HRV shall be designed for operation at outside temperature of -25°C and a flow of minimum 30 L/s (64 CFM)

This review does not exempt the owner, designer and the builder from complying with all applicable regulations and by-laws of the City of Richmond Hill and the Ontario Building Code.

Volume control dampers to all branches to be installed per OBC 2012, Div.B, 6.2.4.5.

Space between studs and joists used as return ducts shall be separated from unused portion as per OBC 2012 Div.B 6.2.4.7(6)

Combustion air supply shall be provided to the furnace and hot water tank.

HRV duct connection shall be in compliance with OBC 2012 Div.B 9.32.3.6(3) & 9.32.3.4(7).

HRV installation, testing, startup and commissioning shall be in compliance with OBC 2012, Div.B 9.32.3.11, 9.32.3.11(7)&(10)

Supply air grill at finished basement shall be at low level. Return air grill for finished or unfinished basement shall be at low level. HRAI digest 2005, clause 7.7(3).

Air supply outlet shall not be installed on a furnace plenum or trunk duct. (HRAI Digest 2005, 4.6)

Exterior insulation effective R-Value for wall, roof or exposed floor shall be maintained at the respective location where duct or sanitary pipes are routed inside exterior envelope.



City of Richmond Hill  
Building Division

**REVIEWED**

By: **PxV** Date: **SEPT 8/2021**


Building Permit #: **BP#-2021-50734**

All construction shall comply with the Ontario Building Code and all other applicable statutory regulations. The reviewed documents must be kept on site at all times.

Building inspection line: 905-771-5465 (24 hr)  
[buildinginspections@richmondhill.ca](mailto:buildinginspections@richmondhill.ca)  
Building inquiry line 905-771-8810  
[building@richmondhill.ca](mailto:building@richmondhill.ca)

I MICHAEL O'ROURKE HAVE REVIEWED AND TAKE RESPONSIBILITY FOR THE DESIGN WORK AND AM QUALIFIED UNDER DIVISION C, 3.2.5 OF THE BUILDING CODE.



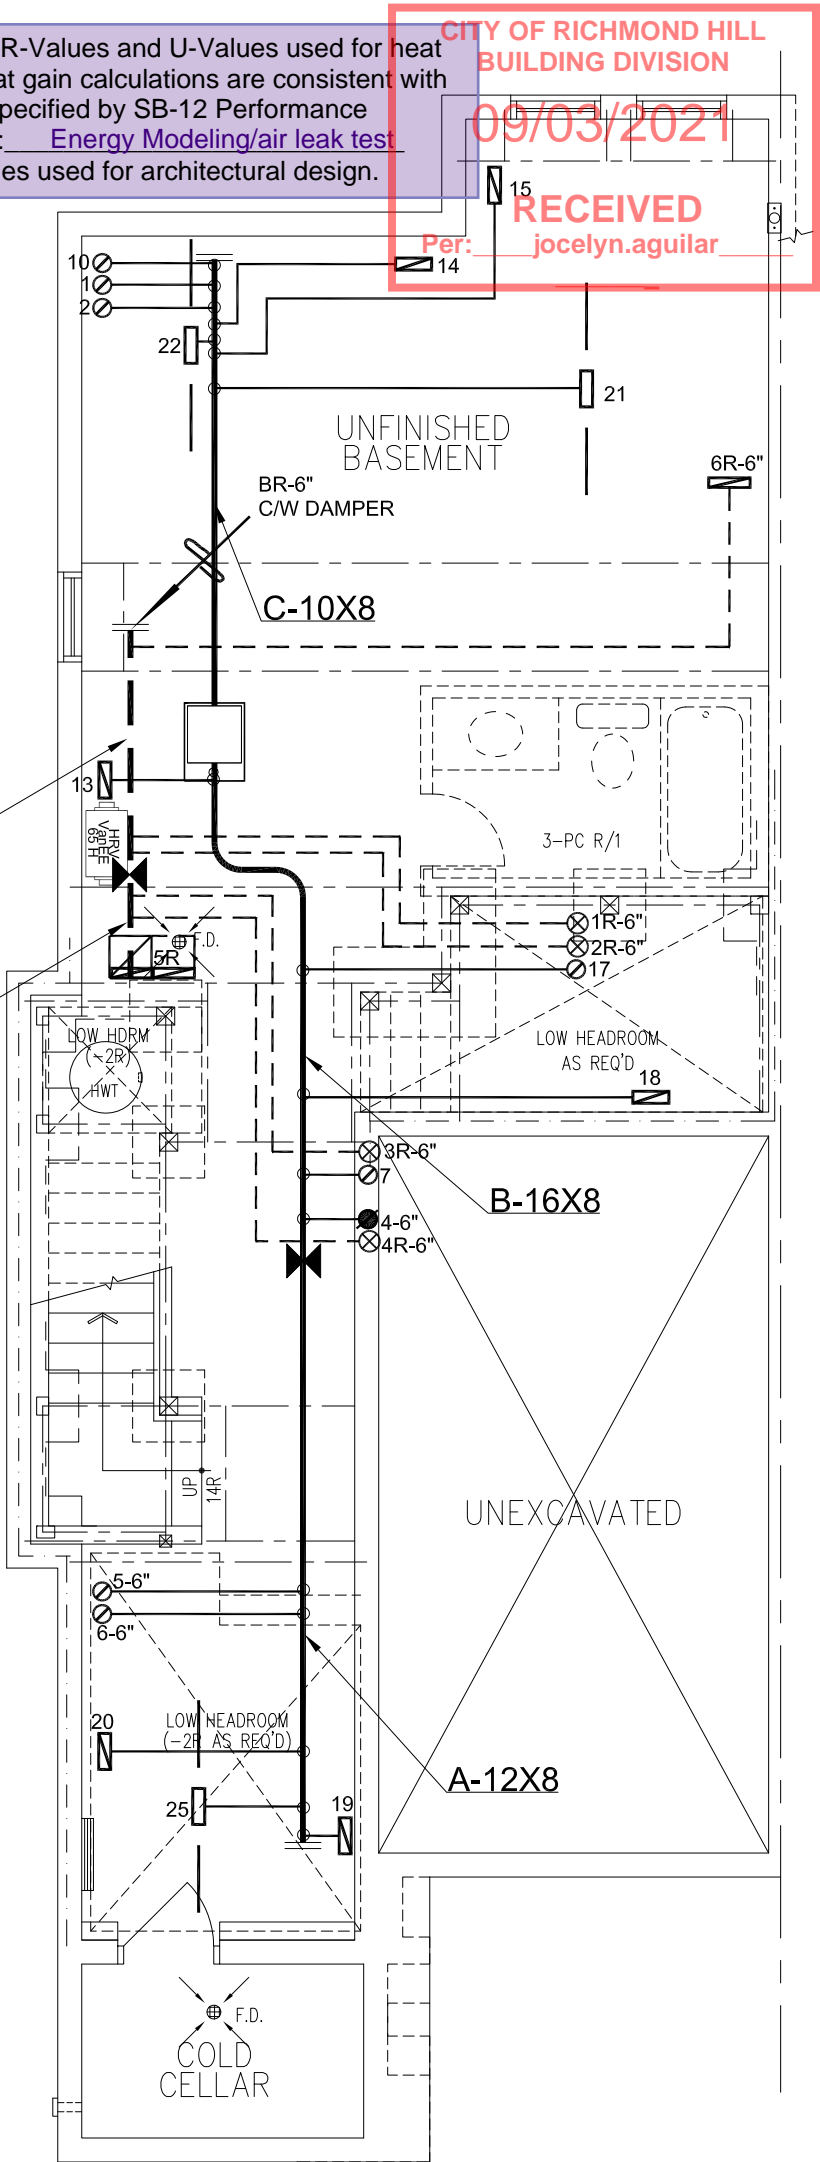









*Michael O'Rourke*  
Michael O'Rourke, BCIN# 19669  
HVAC DESIGNS LTD.



BASEMENT PLAN, EL. 'A' & 'B'


CSA-F280-12

SB-12 PERFORMANCE

HVAC LEGEND								3.		
SYMBOL	DESCRIPTION	SYMBOL	DESCRIPTION	SYMBOL	DESCRIPTION	SYMBOL	DESCRIPTION	2.	REVISED AS PER ARCHITECTURALS	APR/2021
	SUPPLY AIR GRILLE		6" SUPPLY AIR BOOT ABOVE		14"x8" RETURN AIR GRILLE		RETURN AIR STACK ABOVE	1.	REVISED TO PERFORMANCE	SEPT/2020
	SUPPLY AIR GRILLE 6" BOOT		SUPPLY AIR STACK FROM 2nd FLOOR		30"x8" RETURN AIR GRILLE		RETURN AIR STACK 2nd FLOOR	No.	Description	Date
	SUPPLY AIR BOOT ABOVE		6" SUPPLY AIR STACK 2nd FLOOR		FRA- FLOOR RETURN AIR GRILLE		REDUCER	REVISIONS		

ALL DRAWINGS, CALCULATIONS AND SPECIFICATIONS ARE THE PROPERTY OF HVAC DESIGNS LTD.© AND MAY NOT BE REPRODUCED, MODIFIED OR ALTERED WITHOUT EXPRESSED WRITTEN CONSENT. THE DRAWINGS ARE DATED AND USE OF THESE DRAWINGS AFTER ONE YEAR FROM THE DATED NOTED IS NOT AUTHORIZED. CONTRACTOR SHALL CHECK ALL CONDITIONS BEFORE PROCEEDING WITH WORK. LATEST MUNICIPAL APPROVED DRAWINGS ONLY TO BE USED DURING INSTALLATION OF HEATING SYSTEM. HVAC DESIGNS LTD. IS NOT LIABLE FOR ANY CLAIMS ARISING FROM UNAUTHORIZED USE OF THE DRAWINGS OR FROM ANY CHANGES TO ACCEPTED STANDARDS AND/OR THE ONTARIO BUILDING CODE.

Client		<div><p>375 Finley Ave. Suite 202 - Ajax, Ontario L1S 2E2 Tel. 905.619.2300 - 905.420.5300 Fax 905.619.2375 Email: info@hvacdesigns.ca Web: www.hvacdesigns.ca Specializing in Residential Mechanical Design Services</p></div>	HEAT LOSS 34374 BTU/H UNIT DATA		# OF RUNS S/A R/A FANS				Sheet Title	
ROYAL PINE HOMES			MAKE CARRIER		3RD FLOOR				BASEMENT HEATING LAYOUT	
Project Name CENTREFIELD (WEST GORMLEY) RICHMOND HILL, ONTARIO			MODEL 59TN6A-060-14V		2ND FLOOR	8	4	2		
			INPUT 60 MBTU/H		1ST FLOOR	6	2	2	Date	SEPT/2020
			OUTPUT 58 MBTU/H		ALL S/A DIFFUSERS 4 "x10" UNLESS NOTED OTHERWISE ON LAYOUT. ALL S/A RUNS 5"Ø UNLESS NOTED OTHERWISE ON LAYOUT. UNDERCUT DOORS 1" min. FOR R/A				Scale	3/16" = 1'-0"
		COOLING 2.5 TONS		BCIN# 19669						
2010 1742 sqft		FAN SPEED 875 cfm @ 0.6" w.c.		LO# 87540						

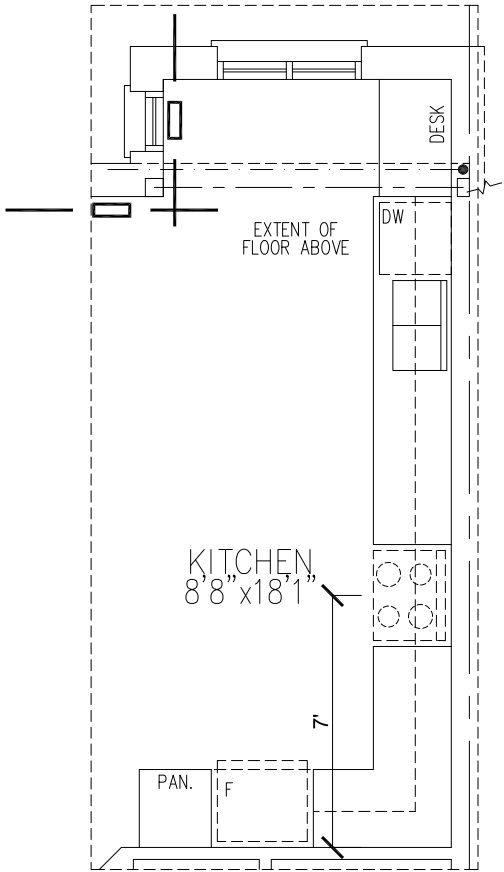


PART. GROUND FLOOR PLAN  
- OPT. KITCHEN LAYOUT


Space between studs and joists used as return ducts shall be separated from unused portion as per OBC 2012 Div.B 6.2.4.7(6)

Exterior insulation effective R-Value for wall, roof or exposed floor shall be maintained at the respective location where duct or sanitary pipes are routed inside exterior envelope.


Kitchen hood exhaust duct shall be provided as per OBC 2012, Div.B 9.32.3.10, 9.32.3.5(2).

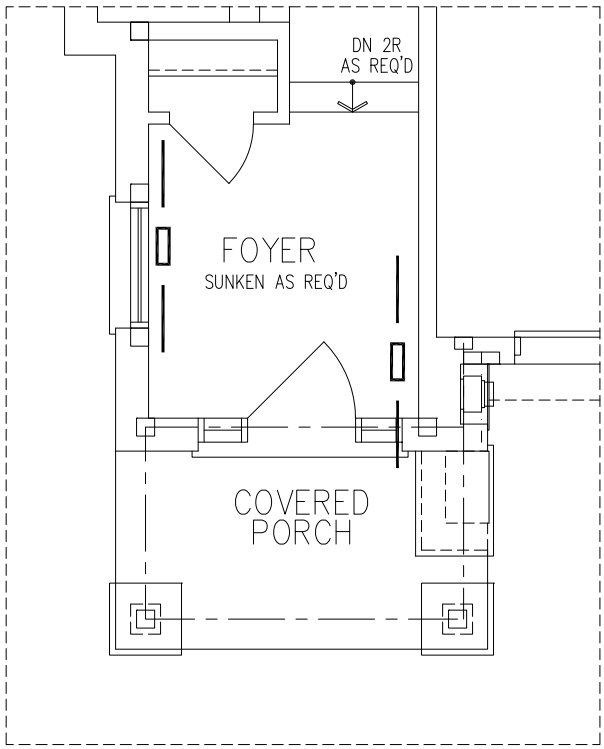

GROUND FLOOR PLAN, EL. 'B'

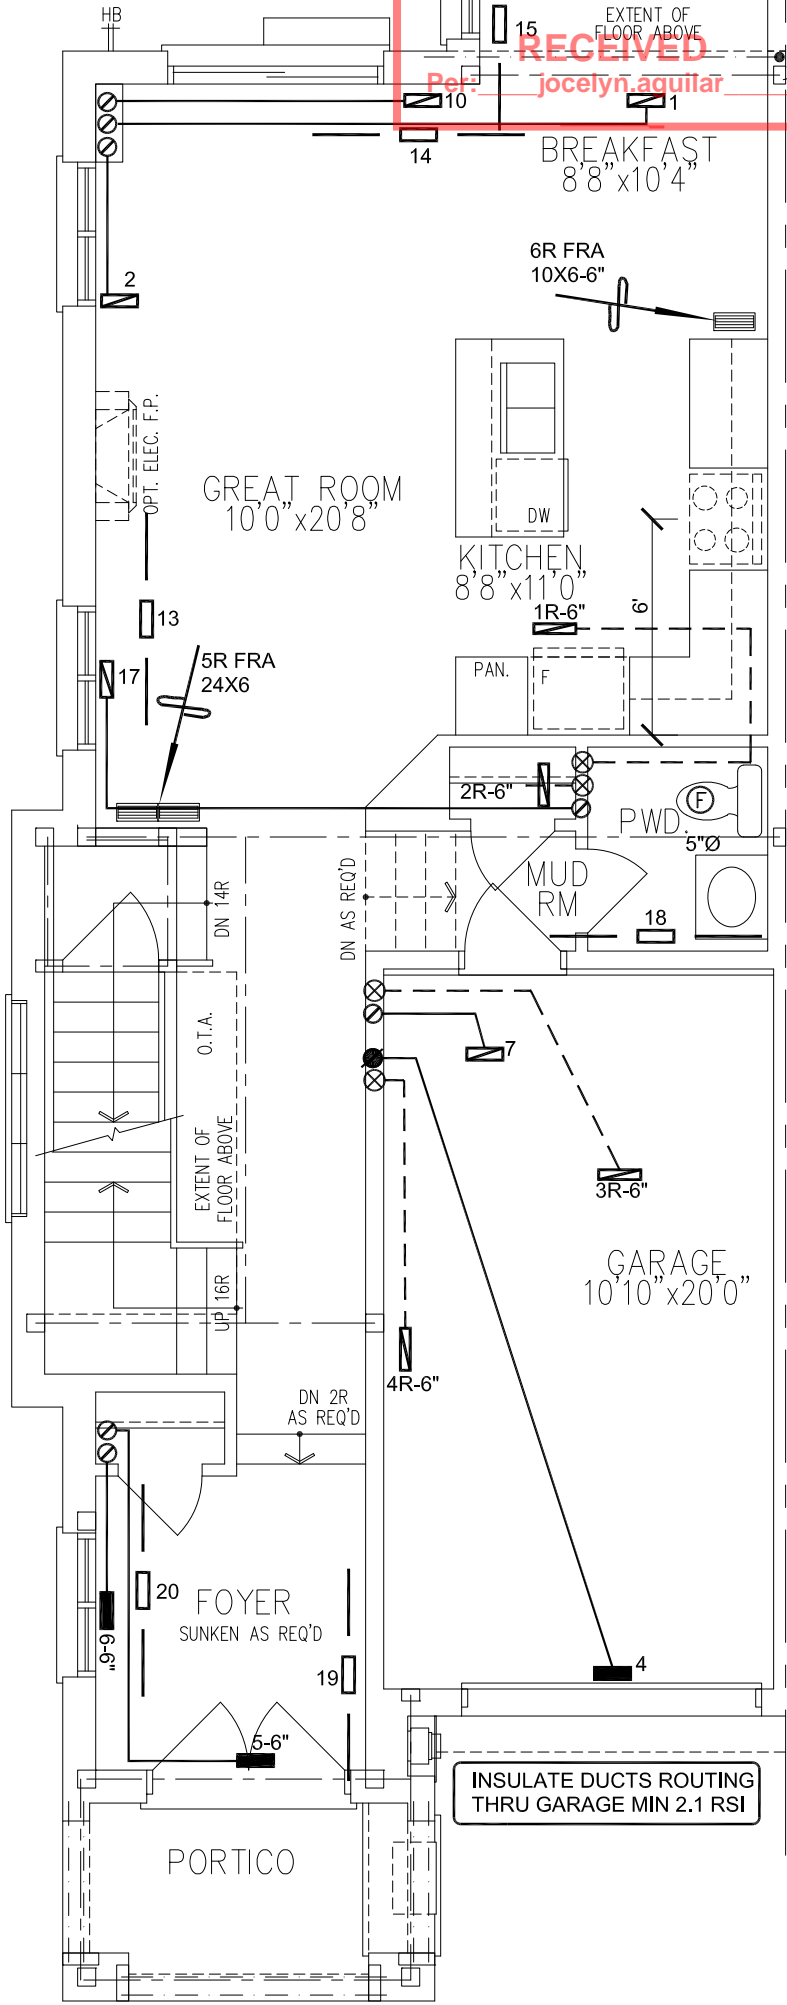

GROUND FLOOR PLAN, EL. 'A'

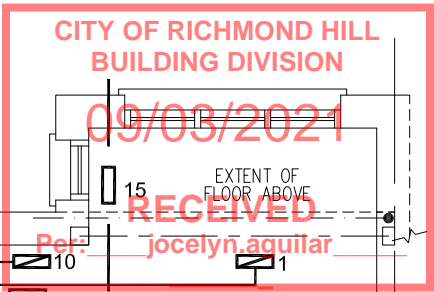

I MICHAEL O'ROURKE HAVE REVIEWED AND TAKE RESPONSIBILITY FOR THE DESIGN WORK AND AM QUALIFIED UNDER DIVISION C, 3.2.5 OF THE BUILDING CODE.  
*Michael O'Rourke*  
Michael O'Rourke, BCIN# 19669  
HVAC DESIGNS LTD.

CSA-F280-12


SB-12 PERFORMANCE

HVAC LEGEND								3.		
SYMBOL	DESCRIPTION	SYMBOL	DESCRIPTION	SYMBOL	DESCRIPTION	SYMBOL	DESCRIPTION	2.	REVISED AS PER ARCHITECTURALS	APR/2021
	SUPPLY AIR GRILLE		6" SUPPLY AIR BOOT ABOVE		14"x8" RETURN AIR GRILLE		RETURN AIR STACK ABOVE	1.	REVISED TO PERFORMANCE	SEPT/2020
	SUPPLY AIR GRILLE 6" BOOT		SUPPLY AIR STACK FROM 2nd FLOOR		30"x8" RETURN AIR GRILLE		RETURN AIR STACK 2nd FLOOR	No.	Description	Date
	SUPPLY AIR BOOT ABOVE		6" SUPPLY AIR STACK 2nd FLOOR		FRA- FLOOR RETURN AIR GRILLE		REDUCER	REVISIONS		

ALL DRAWINGS, CALCULATIONS AND SPECIFICATIONS ARE THE PROPERTY OF HVAC DESIGNS LTD.© AND MAY NOT BE REPRODUCED, MODIFIED OR ALTERED WITHOUT EXPRESSED WRITTEN CONSENT. THE DRAWINGS ARE DATED AND USE OF THESE DRAWINGS AFTER ONE YEAR FROM THE DATED NOTED IS NOT AUTHORIZED. CONTRACTOR SHALL CHECK ALL CONDITIONS BEFORE PROCEEDING WITH WORK. LATEST MUNICIPAL APPROVED DRAWINGS ONLY TO BE USED DURING INSTALLATION OF HEATING SYSTEM. HVAC DESIGNS LTD. IS NOT LIABLE FOR ANY CLAIMS ARISING FROM UNAUTHORIZED USE OF THE DRAWINGS OR FROM ANY CHANGES TO ACCEPTED STANDARDS AND/OR THE ONTARIO BUILDING CODE.

Client		<div></div> <div>375 Finley Ave. Suite 202 - Ajax, Ontario L1S 2E2 Tel. 905.619.2300 - 905.420.5300 Fax 905.619.2375 Email: info@hvacdesigns.ca Web: www.hvacdesigns.ca Specializing in Residential Mechanical Design Services</div>	Sheet Title	
ROYAL PINE HOMES			FIRST FLOOR HEATING LAYOUT	
Project Name			Date	SEPT/2020
CENTREFIELD (WEST GORMLEY) RICHMOND HILL, ONTARIO			Scale	3/16" = 1'-0"
		BCIN# 19669		
2010		LO# 87540		
1742 sqft				


CITY OF RICHMOND HILL  
BUILDING DIVISION  
09/03/2021  
RECEIVED  
Per: Jocelyn Aguilar

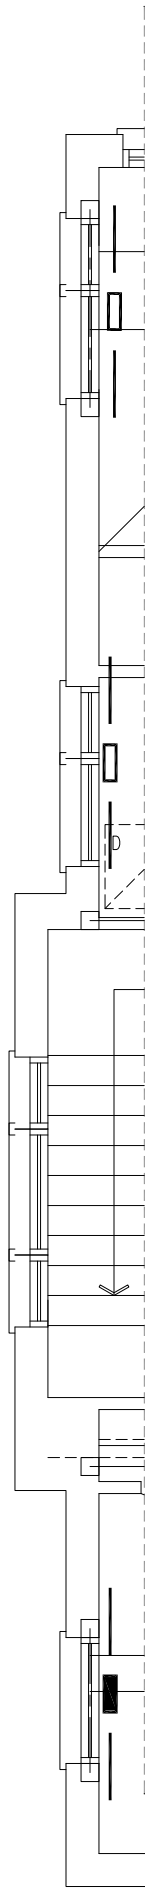

SECOND FLOOR PLAN, EL. 'B'

Space between studs and joists used as return ducts shall be separated from unused portion as per OBC 2012 Div.B 6.2.4.7(6)

Laundry dryer exhaust duct shall be provided as per OBC 2012 Div.B 6.2.3.8(7).

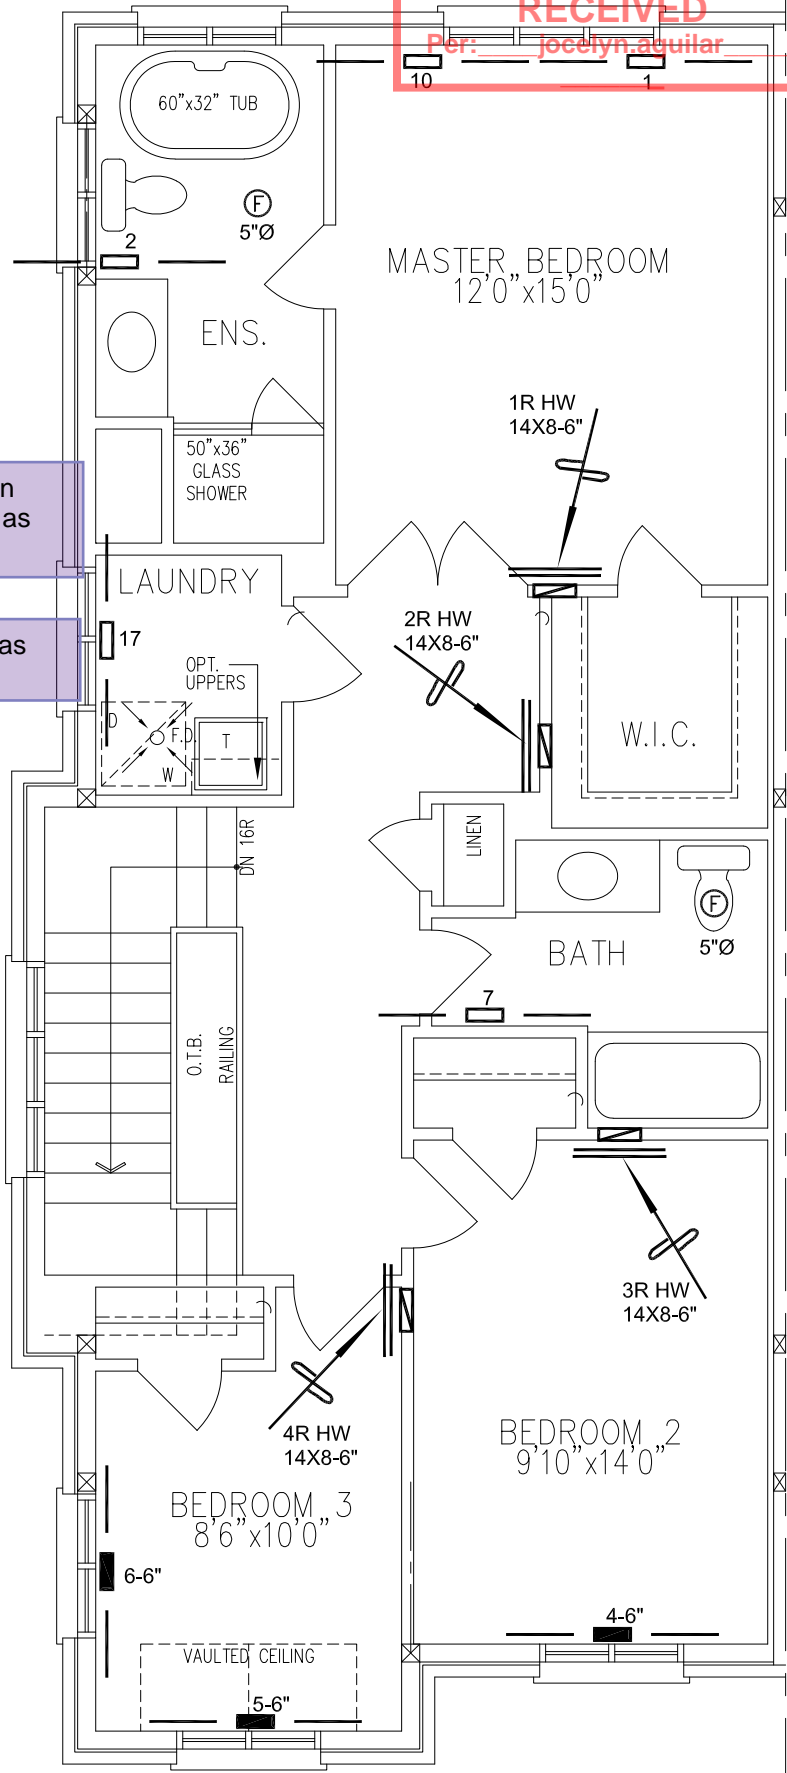

SECOND FLOOR PLAN, EL. 'A'

SECOND FLOOR PLAN, EL. 'A'

I MICHAEL O'ROURKE HAVE REVIEWED AND TAKE RESPONSIBILITY FOR THE DESIGN WORK AND AM QUALIFIED UNDER DIVISION C, 3.2.5 OF THE BUILDING CODE.  
*Michael O'Rourke*  
Michael O'Rourke, BCIN# 19669  
HVAC DESIGNS LTD.

CSA-F280-12

SB-12 PERFORMANCE

HVAC LEGEND								3.		
SYMBOL	DESCRIPTION	SYMBOL	DESCRIPTION	SYMBOL	DESCRIPTION	SYMBOL	DESCRIPTION	2.	REVISED AS PER ARCHITECTURALS	APR/2021
	SUPPLY AIR GRILLE		6" SUPPLY AIR BOOT ABOVE		14"x8" RETURN AIR GRILLE		RETURN AIR STACK ABOVE	1.	REVISED TO PERFORMANCE	SEPT/2020
	SUPPLY AIR GRILLE 6" BOOT		SUPPLY AIR STACK FROM 2nd FLOOR		30"x8" RETURN AIR GRILLE		RETURN AIR STACK 2nd FLOOR	No.	Description	Date
	SUPPLY AIR BOOT ABOVE		6" SUPPLY AIR STACK 2nd FLOOR		FRA- FLOOR RETURN AIR GRILLE		REDUCER	REVISIONS		

ALL DRAWINGS, CALCULATIONS AND SPECIFICATIONS ARE THE PROPERTY OF HVAC DESIGNS LTD.© AND MAY NOT BE REPRODUCED, MODIFIED OR ALTERED WITHOUT EXPRESSED WRITTEN CONSENT. THE DRAWINGS ARE DATED AND USE OF THESE DRAWINGS AFTER ONE YEAR FROM THE DATED NOTED IS NOT AUTHORIZED. CONTRACTOR SHALL CHECK ALL CONDITIONS BEFORE PROCEEDING WITH WORK. LATEST MUNICIPAL APPROVED DRAWINGS ONLY TO BE USED DURING INSTALLATION OF HEATING SYSTEM. HVAC DESIGNS LTD. IS NOT LIABLE FOR ANY CLAIMS ARISING FROM UNAUTHORIZED USE OF THE DRAWINGS OR FROM ANY CHANGES TO ACCEPTED STANDARDS AND/OR THE ONTARIO BUILDING CODE.

Client		<div></div> <div>375 Finley Ave. Suite 202 - Ajax, Ontario L1S 2E2 Tel. 905.619.2300 - 905.420.5300 Fax 905.619.2375 Email: info@hvacdesigns.ca Web: www.hvacdesigns.ca Specializing in Residential Mechanical Design Services</div>	Sheet Title	
ROYAL PINE HOMES			SECOND FLOOR HEATING LAYOUT	
Project Name			Date	SEPT/2020
CENTREFIELD (WEST GORMLEY) RICHMOND HILL, ONTARIO			Scale	3/16" = 1'-0"
			BCIN# 19669	
2010	1742 sqft	LO# 87540		