



CLARIFICATION TO STRUCTURALS

PURCHASER'S EXTRAS QUOTATION
The Estates of West River - Phase 1 2185715 Ontario Inc.

LOT NUMBER	PHASE	HOUSE TYPE
005	1	JOHANNA-STD MAIN-4 BEDROOM-ELEVATION A

ITEM	EXTRA / CHANGE	QTY	UNIT PRICE	EXTENDED
*1 19877 220432	CLARIFICATION TO STRUCTURALS - GREAT ROOM - WAFFLE CEILING - REVISION TO DRAWING ATTACHMENT OF DETAILED WAFFLE CEILING LAYOUT *ELIMINATE 9 WAFFLE* to be 6 WAFFLE LAYOUT AS PER ITEM 7 OF Purchasers Extra Sheet 7783. with 6 pots (see attached revised) **information only**	1		
*2 20080 220433	PURCHASER AWARE AND ACCEPTS THAT ANY CHANGES MADE TO UPGRADES AFTER SIGNING THIS PURCHASERS EXTRA FORM ARE SUBJECT TO A MINIMUM ADMINISTRATION FEE OF \$1000. PLUS A 10% HOLDBACK FEE.	1		
*3 20081 220434	PURCHASER HAS ATTENDED A STRUCTURAL AND COLOR APPOINTMENT AT THE DECOR CENTRE AND HAS DECLINED ANY ADDITIONAL UPGRADES.	1		



	Sub Total
	HST
	Total

- 1. In the event the work on the house has progressed beyond the point where the items covered by this extra cannot be installed without entailing any unusual expense, then this order is to be cancelled and any deposit paid in connection with the same is to be refunded to the Purchaser.
- 2. The Vendor will undertake to incorporate the work covered by the sales extra in the construction of the house but will not be liable to the purchaser in any way, if for any reason the work covered by the extra is not carried out. In that event, any monies paid in connection with the same shall be returned to the Purchaser.
- 3. It is understood and agreed that if for any reason whatsoever the transaction of Purchase and Sale is not completed, the total cost of extras ordered are not refundable to the Purchaser(s).
- 4. Extras or changes will not be processed unless signed by the Vendor.
- 5. These extras may not be amended without the written consent of 2185715 Ontario Inc..
- 6. The Purchaser(s) and the Vendor acknowledge and agree that this form shall not be deemed to be part of the Agreement of Purchase and Sale entered into between them, nor an addendum thereto.
- 7. No Estimates or orders will be accepted once construction has commenced.
- 8. Prices are estimates only and guaranteed for a period of 5 days only.
- 9. Any cancellations to this order, providing they can be cancelled, are subject to a \$500 minimum administration charge and a 10% cancellation charge for the total amount being cancelled.
- 10. For Visa, Mastercard and Debit payments, transactions are identified on you statement as "SHERWAY CONSTRUCTION LTD", an Authorized Visa /Mastercard/Debit Merchant and authorized Royal Pine Homes company.

Payment Summary	
<u>Paid By</u>	<u>Amount</u>
<u>Total Payment:</u>	

Bonus Summary		
Bonus Package offering (includes taxes) from Royal Pine Homes Décor Centre is being applied to this order.		
Any remaining balance(s) will be applied accordingly to extras purchased.		
Bonus Package Offering		
<u>Invoice Number</u>	<u>Date</u>	<u>Amount</u>
Total Bonus Used:		
Remaining Balance:		

PURCHASER:

DocuSigned by:
SARBJIT SINGH THANDI

10-Jan-23
DATE

VENDOR:

PER: 2185715 Ontario Inc.

PURCHASER:

DocuSigned by:
HARPREET KAUR THANDI


10-Jan-23
DATE

TAX#:1

PREPARED BY: Lisa Renzetti
PRINTED: 10-Jan-23 at 3:55 pm
RoyInvoiceSQL.rpt 07aug20

CONSTRUCTION SCHEDULING APPROVAL	
PER:	
DATE:	

GREAT ROOM. WAFFLE CEILING. 45-04. TIC164

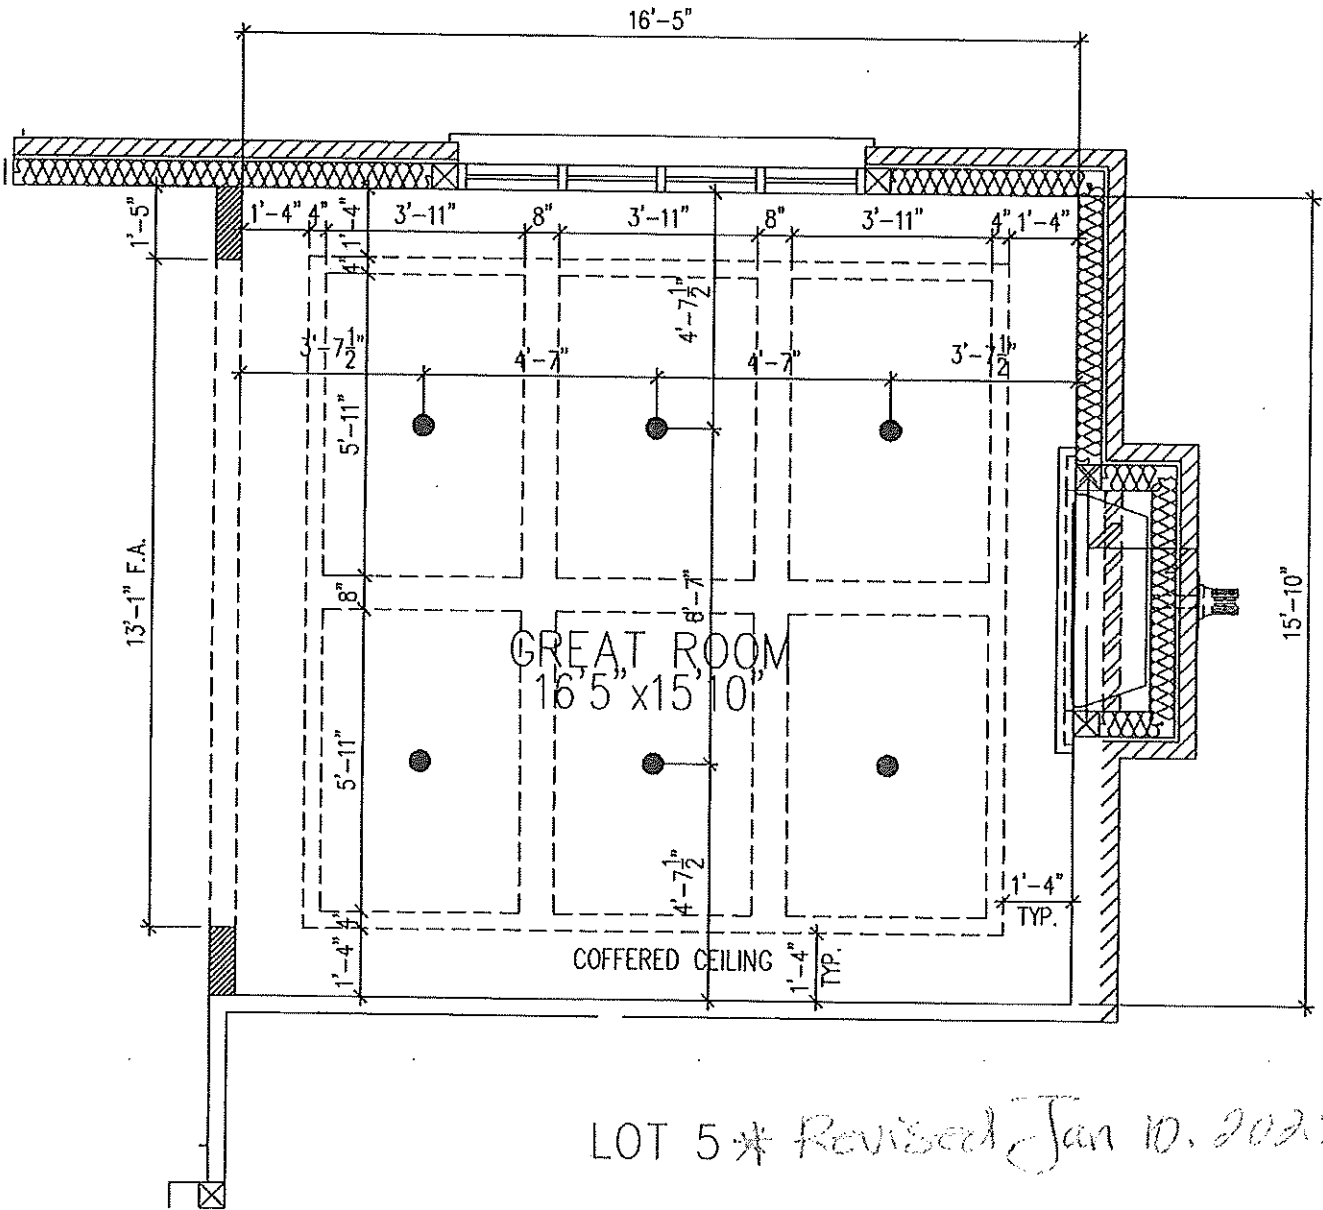

DS
H
T

Lot 5



TIC-033

TRIMROC™
Interior Plaster Mouldings


Ceiling Trim
TIC 033



5 3/4"

5 3/4"

6 1/8"

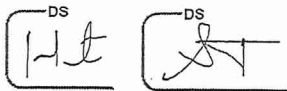

DEN ⊕ DINING ROOM ⊕ SIDE HALL ⊕ FRONT ENTRY ⊕
UPPER HALL / STAIRCASE ⊕ POWDER ROOM HALL

Lot 5. Great Room.




TIC-164

TRIMROC™
INTERIOR PLASTER MOULDINGS

Ceiling Trim
TIC 164

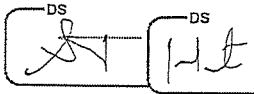

DS DS


Specifications




JADE42IN-B

MAJESTIC


Please consult the manufacturer's installation manual for all details and requirements before making a final design layout decision.

JADE 42
Direct Vent Gas Fireplace

MODEL	FRONT WIDTH		BACK WIDTH		HEIGHT		DEPTH		GLASS SIZE
JADE42IN-B 25,250 BTU (NG) 23,500 BTU (LP)	ACTUAL	FRAMING	ACTUAL	FRAMING	ACTUAL	FRAMING	ACTUAL	FRAMING	39-1/16" x 15-1/4" (992 x 387)
	48" (1219)	49" (1245)	37-3/4" (959)	49" (1245)	33-11/16" (856)	32-3/4" (832)	17-3/4" (451)	17-3/4" (451)	

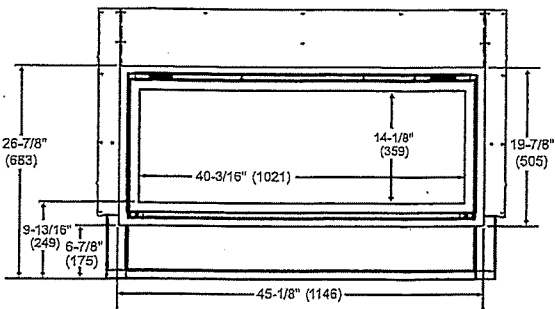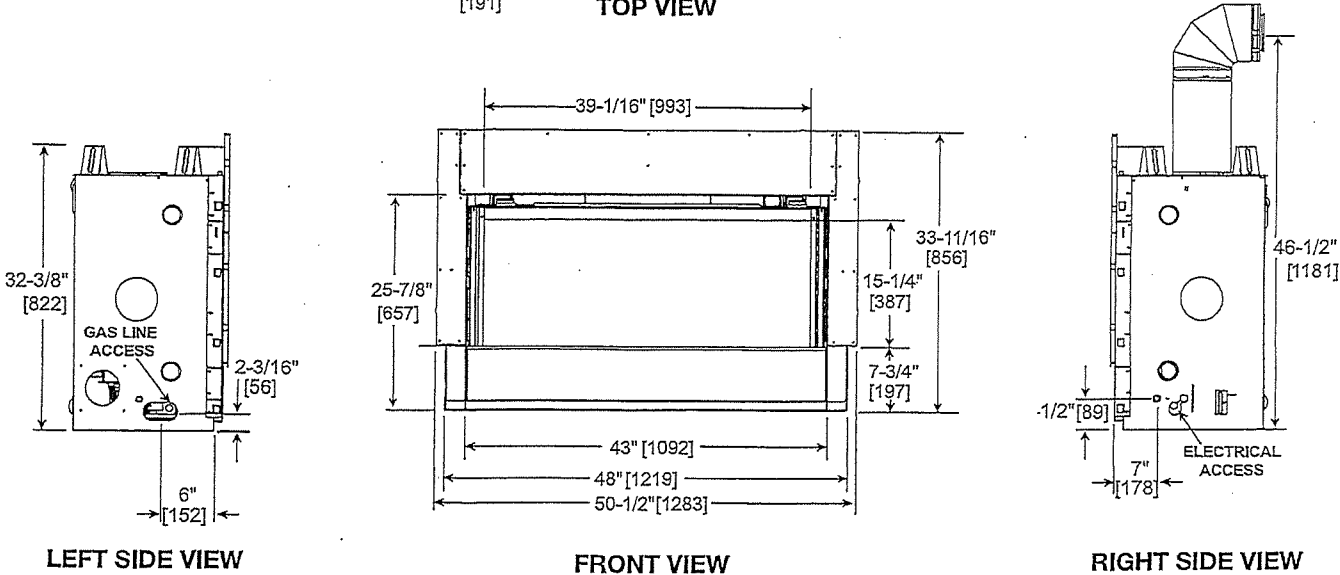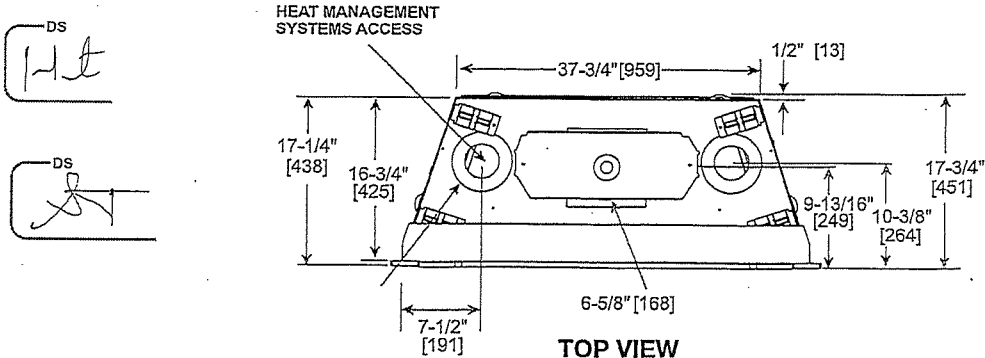

CLEAN FACE TRIM

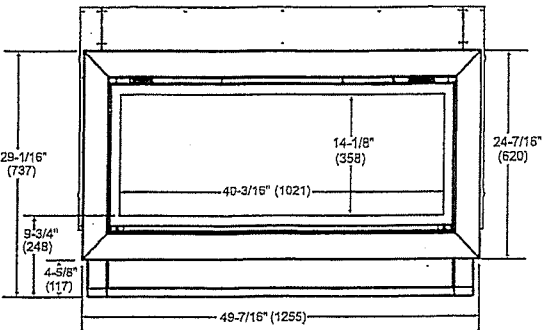

PICTURE FRAME FRONT


LOT 5

Specifications


JADE42IN-B

MINIMUM FIREPLACE CLEARANCES /
CLEARANCES TO COMBUSTIBLES


AREA	TO COMBUSTIBLES
CLEARANCE TO CEILING	31" [787]
NON-COMBUSTIBLE FLOOR	0" [0]
COMBUSTIBLE FLOORING	0" [0]
BEHIND APPLIANCE	1/2" [13]
SIDES OF APPLIANCE	1/2" [13]
FRONT OF APPLIANCE	36" [914]

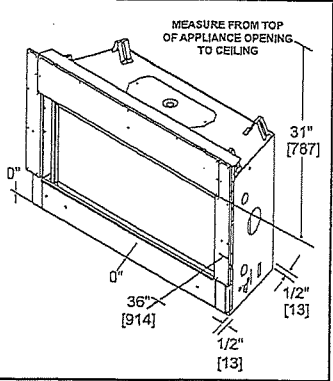


FRAMING DIMENSIONS

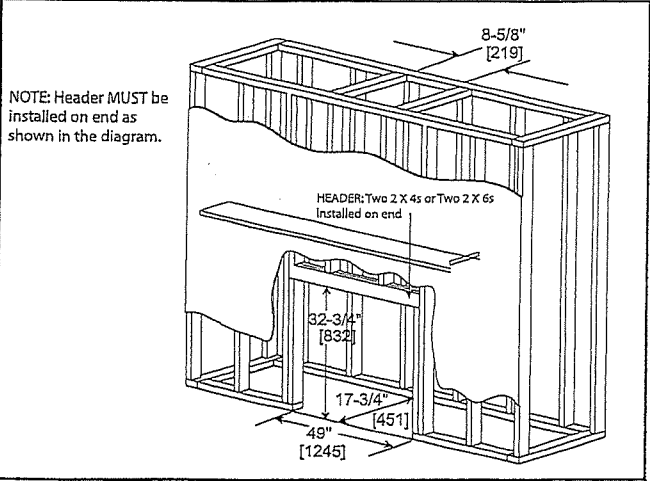


APPLIANCE LOCATION

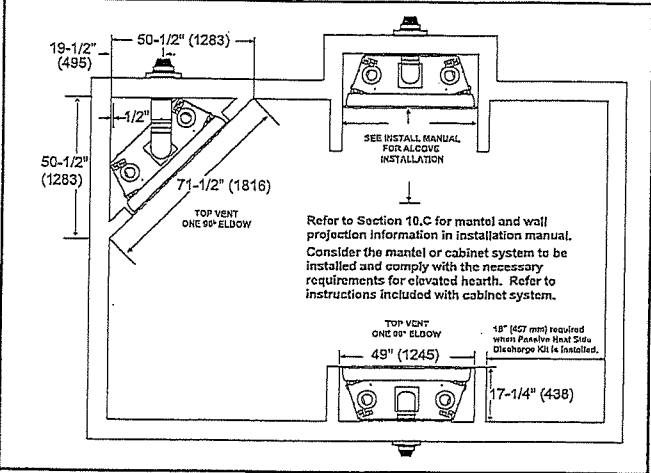


NON-COMBUSTIBLE MANTEL PROJECTIONS
(or other materials above appliance)

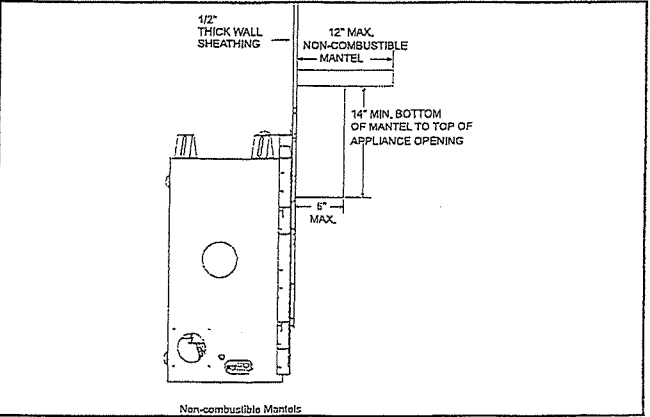


WALL PENETRATION

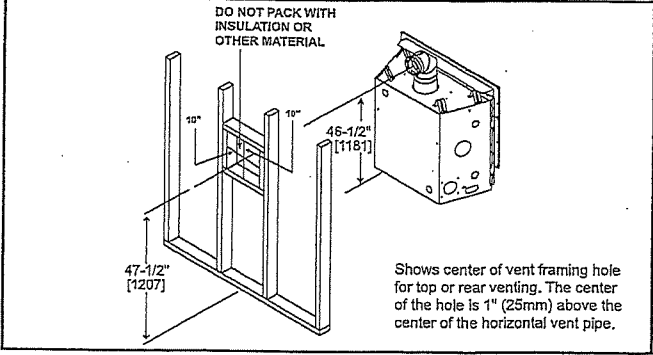

MANTEL PROJECTIONS
(or other materials above appliance)

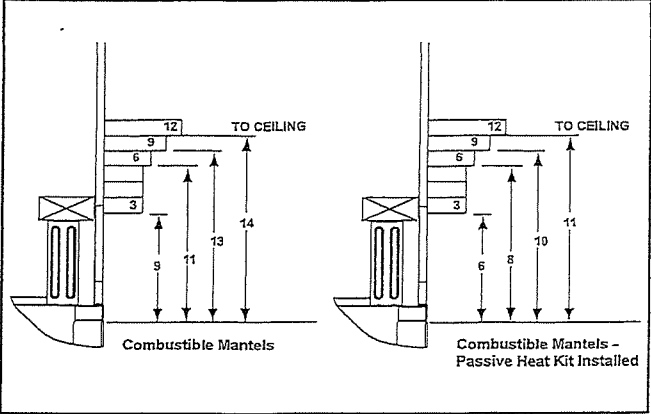

MANTEL LEG/WALL PROJECTIONS

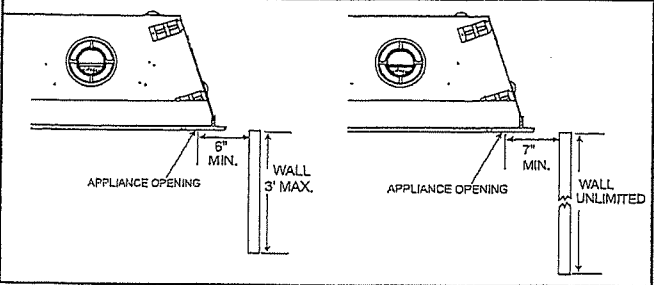

PRODUCT LISTING CODES	
US	ANSI Z21.88-2017
CAN	CSA 2.23-2017
UL LISTED	UL307B

Product information provided is not complete and is subject to change without notice. Product installation must adhere strictly to instructions accompanying product to avoid risk of fire and potential injury.

MAJESTIC

Majestic — A Brand of Hearth & Home Technologies
7571 215th Street West | Lakeville, MN 55044
877-486-9123 | majesticproducts.com

UL LISTED



MAJ_JADE42IN-B_0220

DS
[Signature]

LOT 5

Sarbjit Thandi LOT 5

Café™ 42" Built-in Side-by-Side Refrigerator
CSB42WP2NS1

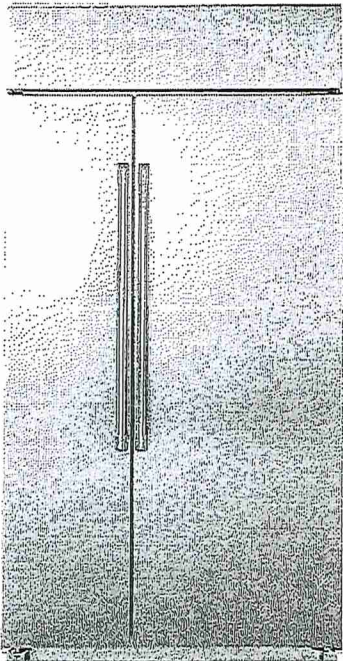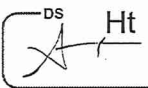

CSB42WP2NS1
Stainless Steel with
Brushed Stainless handles



FEATURES & BENEFITS

Display groceries like a gallery with **showcase LED lighting** positioned throughout the interior to spotlight your favorite foods and containers

Enjoy peace of mind with **WiFi Connect** technology that provides a helpful alert when there's an unexpected change in performance, like a drop in temperature if the door is left open or power is lost

Spills happen, but cleanup is stress-free thanks to **adjustable slide-out spillproof glass shelves** that easily shift and lock, and have raised edges to contain mess.

Enjoy water and ice from the refrigerator with total peace of mind, thanks to an **advanced water filtration system** that uses MWF replacement filters to remove 98% of certain pharmaceuticals*

Whether you're refrigerating an appetizer or dessert, ensure a consistent temperature with an **advanced temperature management system** perfect for any course

Free up valuable shelf space with **large door bins**, perfect for storing the small foods and containers that can add up and deprive you of room for heftier items

APPEARANCE

Installation	Built-in installation
Finish	Flat doors
Style	Café™
Door swing	Yes

FEATURES

WiFi connect	Built-in
Connected capabilities	Amazon Alexa; The Google Assistant; IFTTT
Temperature management features	Multi-shelf air management tower; independent temperature; controls
Defrost type	Automatic defrost
Control type	Upfront electronic digital; Temperature display
Dispenser	Non-dispenser
Icemaker	Factory-installed
Water filtration	GE water filtration 6 month; Water filter indicator light
Filter location	Upper right corner
Fresh food cabinet shelves	4 total; 3 adjustable
Fresh food door bins	5 adjustable; 1 with gallon storage
Fresh food features	Door alarm
Fresh food cabinet shelf features	3 adjustable, spillproof glass; 1 spillproof glass
Top drawer	Snack drawer
Middle drawer	Sealed
Bottom drawer	Select Temp
Clear Lexan bins and pans	Yes
Interior lighting	LED
Freezer door bins	5 total
Freezer cabinet shelves	4 total; wire; 4 adjustable
Freezer baskets	2 wire (full-extension)
Adjustable freezer shelves (wire)	Yes
Exterior style	Built-in
Leveling system	4 point front adjustable

CAPACITY


Total capacity (cubic feet)	25.1 cu. ft.
Fresh food capacity	15.80 cu. ft.
Freezer capacity	9.40 cu. ft.

WEIGHTS & DIMENSIONS

Overall depth	28-1/2 in.
Overall height	84 in.
Overall width	42 in.
Case depth without door	23-1/2 in.
Depth with fresh food door open 90°	50-1/4 in.
Depth without handle	25-3/4 in.
Height to top of case	83-1/2 in.
Width w/doors open 90° incl. handle	43-1/4 in.
Width w/doors open 90° less handle	42-5/8 in.
Approximate shipping weight	725 lb.
Net weight	688 lb.


LOT 5

Café™ 42" Built-in Side-by-Side Refrigerator
CSB42WP2NS1

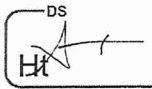

WARRANTY	
Parts Warranty	Limited 1-year entire appliance Limited 5-year sealed refrigerating system
Labor Warranty	Limited 1-year entire appliance Limited 5-year sealed refrigerating system
Warranty Notes	See written warranty for full details

DIMENSIONS AND INSTALLATION

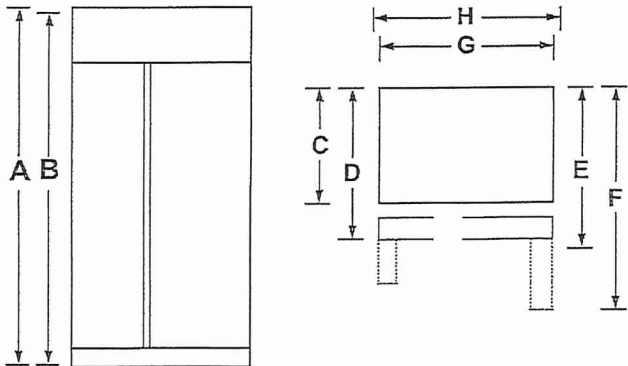


Overall Dimensions	Height to top of grill (in.) A	84
	Height to top of case (in.) B	83-1/2
	Case depth without door (in.) C	23-1/2
	Case depth less door handle (in.) D	25-3/4
	Case depth with door handle (in.) E	28-1/2
	Depth with fresh food door open 90° (in.) F	50-1/4
	Width (in.) G	42
	Width with doors open 90° inc. handle (in.) H	48-1/4

PRODUCT CLEARANCES

These refrigerators are equipped with a 3-position door stop. The factory set 115° door swing can be adjusted to 90° if clearance to adjacent cabinets or walls is restricted.

Allow minimum clearances for Freezer door (Dimension A) and Fresh Food door (Dimension B) for a full 130° door swing and to allow for drawer removal.

4-5/8" minimum clearance is required when door swing is adjusted to 90°. If the 90° door stop position is used, drawer access is maintained, but drawer removal is restricted.

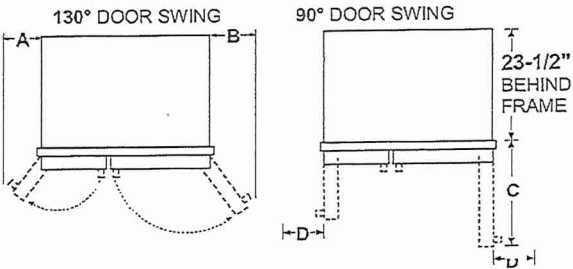

Models	A	B	C	D
42"	11-1/4"	17-5/8"	26-9/16"	4-5/8"

GROUNDING THE REFRIGERATOR

IMPORTANT—PLEASE READ CAREFULLY

FOR PERSONAL SAFETY, THIS APPLIANCE MUST BE PROPERLY GROUNDED.

The power supply cord of this appliance is equipped with a three-prong (grounding) plug which mates with a standard three-prong (grounding) wall receptacle to minimize the possibility of electric shock hazard from this appliance.


Have the wall outlet and circuit checked by a qualified electrician to make sure the outlet is properly grounded.

Where a standard 2-prong wall outlet is encountered, it is your personal responsibility and obligation to have it replaced with a properly grounded 3-prong wall outlet.

DONOT UNDER ANY CIRCUMSTANCES, CUT OR REMOVE THE THIRD (GROUND) PRONG FROM THE POWER CORD.

DONOT USE AN ADAPTER PLUG TO CONNECT THE REFRIGERATOR TO A 2-PRONG OUTLET.


DONOT USE AN EXTENSION CORD WITH THIS APPLIANCE.

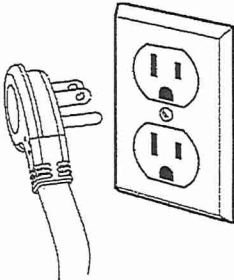

NOTES

Café™ 42" Built-in Side-by-Side Refrigerator

CSB42WP2NS1

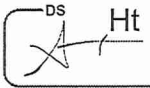

DIMENSIONS AND INSTALLATION

SIDE PANELS

Side panels (not supplied) must be used whenever the sides of the refrigerator will be exposed. The 1/4" side panels will slip into the side case trim. Order side panels from your cabinet manufacturer.
*Depending on installation height.

FLOORING

For proper installation, this refrigerator must be placed on a level surface of hard material that is at the same height as the rest of the flooring. This surface should be strong enough to support a fully loaded refrigerator, or approximately 1500 lbs.


NOTE: Protect the finish of the flooring. Cut a large section of the cardboard carton and place under the refrigerator where you are working.

WATER AND ELECTRICAL LOCATIONS

The opening must be prepared with the electrical and water supply located as shown.

THE CUTOUT DEPTH MUST BE 24"


The refrigerator will project forward, slightly beyond adjacent cabinets, depending on your installation.

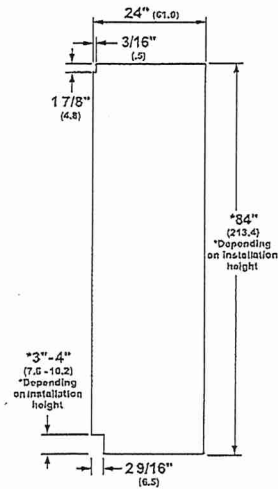

SIDE PANEL

ADDITIONAL SPECIFICATIONS

A 120 volt, 60Hz, 15 or 20 amp power supply is required. An individual properly grounded branch circuit or circuit breaker is recommended. Install a properly grounded 3-prong electrical receptacle recessed into the back wall. Electrical must be located on rear wall as shown.

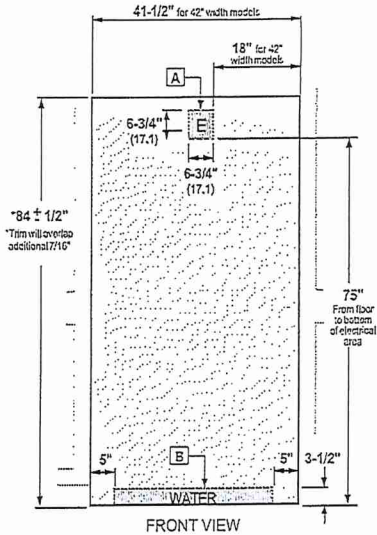

A – Mounting the junction in this location will also allow for front accessibility through access panel.
B – Water supply area.

NOTE: GFI (ground fault interrupter) is not recommended. Water line can enter the opening through the floor or rear wall. The water line installed should be 1/4" O.D. copper tubing or GE SmartConnect™ tubing between the cold water line and water connection location. The line should be long enough to extend to the front of the refrigerator. Installation of an easily accessible shutoff valve in the water line is required.

ADDITIONAL ACCESSORIES



CXSS2H2PMBZ
Brushed Bronze
2 handles




CXSS2H2PMBT
Brushed Black
2 handles





CXSS2H2PMCU
Brushed Copper
2 handles

LOT 5

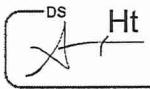

ELN136S2
36" Professional Wall Mount Hood

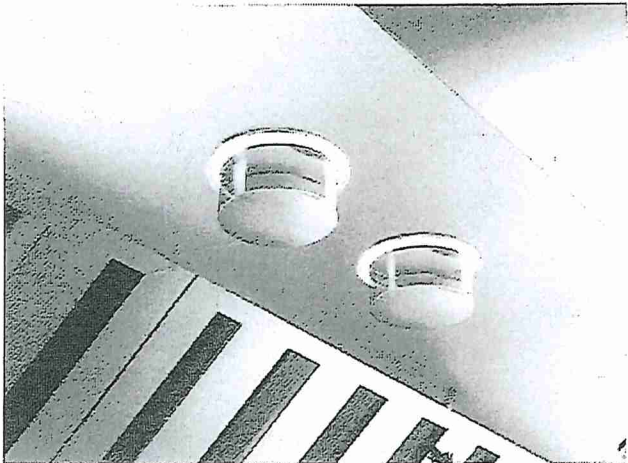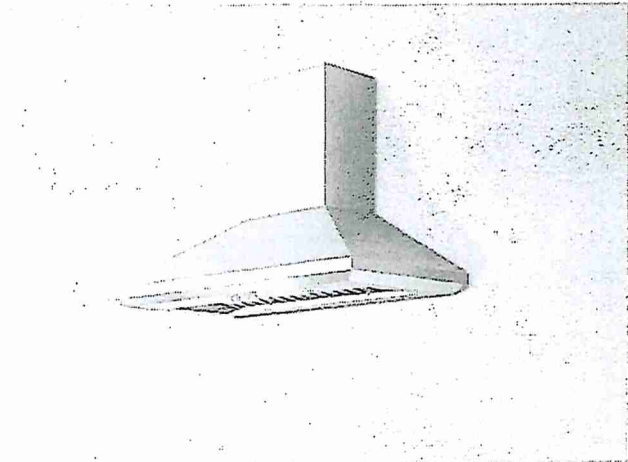


Selected Model	
Model number	ELN630S2
Color	Stainless Steel
Dimensions	
Dimensions	36" (W) X 24" (D) X 12 1/8" (H)
Features	
Controls	Fully recessing stainless rotating knobs with illumination
Illumination	2 2.5W Premium LED lamps, 1 intensity (bulbs included)
Blower Type	Hush Silence System 1200 CFM, 4-speed
Blower Performance	Speed 2, 640 CFM, 4.7 Sones
	Speed 3, 940 CFM, 8.1 Sones
	Speed 4, 1200 CFM, 7.7 Sones
	Speed 1, 375 CFM, 3.2 Sones
Filter Type	Stainless Steel Baffle filters (3X)
Ducting	Ducted Installation Only
Duct transition	8" round with Back Draft Damper included
Chimney (ducted out)	For ceiling height 7'6" to 9'11" (elect cooking) & 8'0" to 9'11" (gas cooking)
Accessories (optional)	
Chimney extension kit	KIT02785 (Ceiling 9'3" - 13'0" (electric cooking) 9'9"-13'0" (gas cooking)
External Blower Kit	KIT0153054 (1200 CFM compatible 8" & 10" duct transition)
Inline blower kit	KIT0154387 (1200 CFM compatible 8" &10" duct transition)
Warranty	
Complete 2 years warranty	Entire Appliance; In-Home; Parts & Labour

The information contained herein is based on sources that we believe to be reliable, but is not guaranteed by us, may be incomplete or may change without notice


NOT 5

ELN630/136/142S2

Dimensions

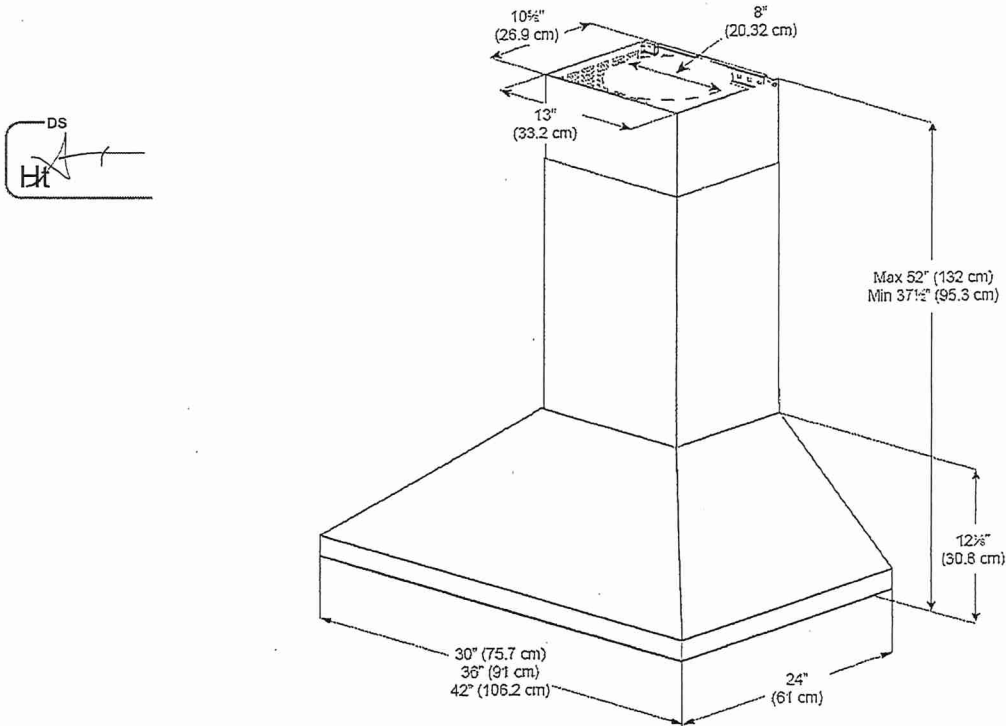


Installation

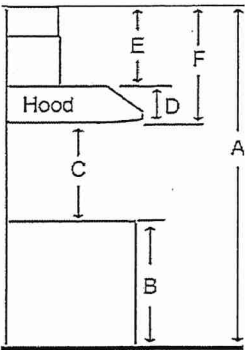

A	Floor to ceiling Height	TBD
B	Floor to counter Top Height (standard)	36"
C	Recommended Height between cooking surface and bottom of the hood	27" min. - 30" max
D	Hood Height	12 1/8"
E	Chimney Height	25 3/8" to 39 7/8"

Duct transition

8" Round (Top)

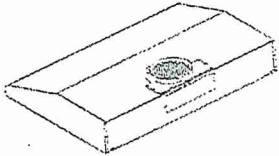


The information contained herein is based on sources that we believe to be reliable, but is not guaranteed by us, may be incomplete or may change without notice

Need technical assistance ? 1(888) 651-2534

LOTS

Café™ 36" Built-In Gas Cooktop
CGP95363MS2 / CGP95362MS1

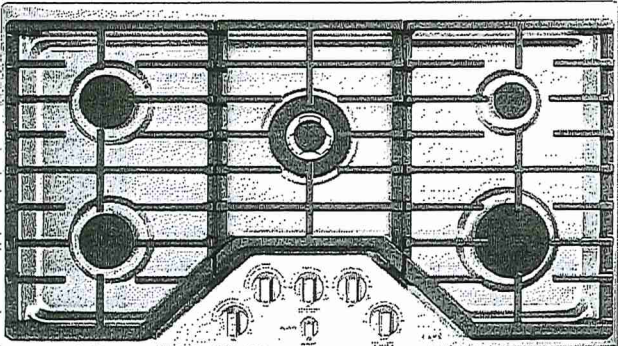

ALSO
AVAILABLE IN
CGP95362MS1
Stainless Steel with
Brushed Stainless
knobs

FEATURES & BENEFITS

Sear, fry and sautee on a **20,000 BTU triple ring burner**

Give your kitchen a little glimmer with **white LED knob lighting**.

Get the most from your cooktop and eliminate the need for extra cookware with an **extra-large, integrated cooktop griddle**.

When you're updating your kitchen, attention to detail is a priority. That's why Café cooktops are guaranteed for an exact fit for an easy and seamless replacement.

Always get your hollandaise just right with a **simmer burner** that provides low, even heat.

Easily move heavy cookware across the surface without worry, thanks to **continuous, cast-iron burners**.

Keep your kitchen sparkling, even when there's a spill with **sealed cooktop burners** that contain messes for easy cleanup.

Prevent unintended burner activation with **control lock capability**.

Enjoy the party without worrying about clean up, thanks to **dishwasher-safe grates**.

APPEARANCE

Control Knobs	Dishwasher Safe White LED Backlit
Cooktop Burner Grate Color	Matte Black

FEATURES

Cooktop Burner Type	5 Sealed
Cooktop Surface	Deep Stainless Steel
Ignition System	Electronic
Burner - Left Front	9,500 BTU
Burner - Left Rear	9,500 BTU
Burner - Right Front	15,000 BTU Power Boil
Burner - Right Rear	5,000 BTU
Burner - Center	20,000 BTU Tri-ring Power Boil
Control Type	Knob
Cooktop Control Features	Child Lock
Control Location	Front Center
Cooktop Burner Grate Features	Continuous Grates Dishwasher Safe Edge-to-Edge Grates
Cooktop Burner Grate Material	Heavy Cast
Fuel Type	Natural Gas (factory set)
Valves (Degree of Turn)	270

POWER/RATINGS


Burner BTU Ratings (000's/BTU) - LP Gas	(1) 18.0 (1) 15.0 (2) 9.5 (1) 5.0
Burner BTU Ratings (000's/BTU) - Natural Gas	(1) 20.0 (1) 15.0 (2) 9.5 (1) 5.0
Volts/Hertz/Amps	120V 60Hz 5A

WEIGHTS & DIMENSIONS

Approximate Shipping Weight	57 lb
Cabinet Width	36 in
Cutout Dimensions Width x Depth (in.)	33-7/8 x 19-1/8
Net Weight	51 lb
Overall Depth	21 in
Overall Height	5 1/2 in
Overall Width	36 in


ACCESSORIES

Stainless Steel Cleaner	Included
Griddle	JXGRIDL236 (Included) Cast Iron Included
LP Conversion Kit	Included

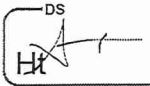

LOT 5

Café™ 36" Built-In Gas Cooktop
CGP95363MS2 / CGP95362MS1

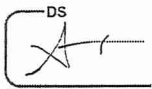

WARRANTY	
Perts warranty	Limited 1-year entire appliance
Labor warranty	Limited 1-year entire appliance
Warranty notes	See written warranty for full details

DIMENSIONS AND INSTALLATION



AGA Requirement: All gas cooktop models require 7/16" free area below cooktop height to combustible material. Requires 18" minimum from countertop to adjacent overhead cabinets.

Note: If installing with a GE Profile™ Telescopic Downdraft System, consult both cooktop and downdraft installation instructions packed with product before installing. Cooktop gas/electric supply may need to be re-routed to install downdraft.


Electrical Rating: 120V, 60Hz, 5A

Installation With Single Wall Oven Information: 30" Gas Cooktops are approved for use over select GE 27" and 30" Wall Ovens and Warming Drawers. 30" and 36" Gas cooktops are approved for use over select 30" Wall Ovens and Warming Drawers. Refer to cooktop and wall oven/warming drawer installation instructions packed with product for current dimensional data.


Installation Information: Before installing, consult installation instructions, packed with product, for current dimensional data.

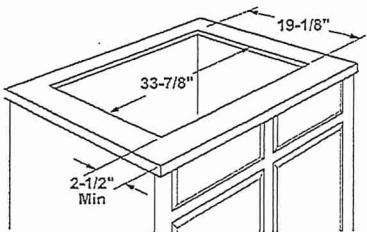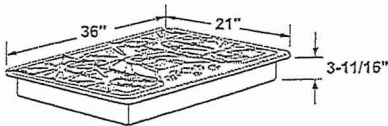

Installation above a wall oven

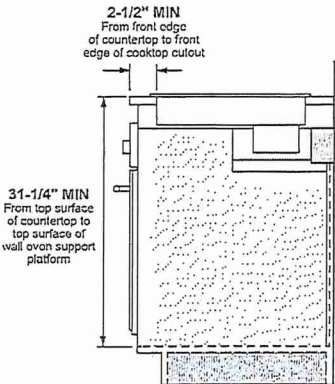

Dimension and installation information are shown in inches.
*Allow 5-3/4" depth at rear for electrical and gas connections

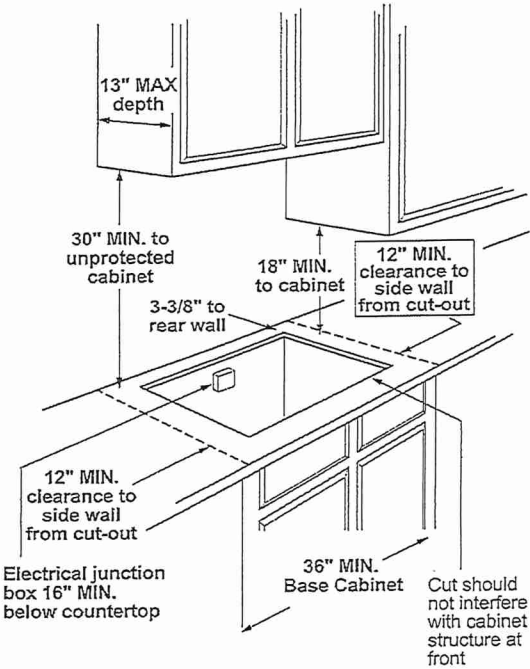

ADDITIONAL ACCESSORIES



CXCG1K0PMBZ
Brushed Bronze
Knobs



CXCG1K0PMSS
Brushed Stainless
Knobs




CXCG1K0PMBT
Brushed Black
Knobs



CXCG1K0PMCU
Brushed Copper
Knobs

LOT 5

Café™ Stainless Interior Built-In Dishwasher
with Hidden Controls
CDT845P4NW2 / CDT845P3ND1 / CDT845P2NS1

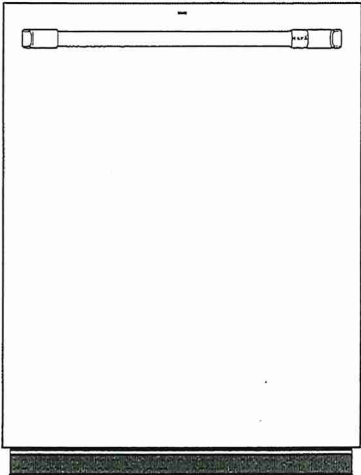

CDT845P4NW2
Matte White with Brushed
Bronze handle



ALSO
AVAILABLE IN



CDT845P3ND1
Matte Black with
Brushed Stainless
handle



CDT845P2NS1
Stainless Steel with
Brushed Stainless
handle

FEATURES & BENEFITS

Ultra-Wash & Dry – Unload sparkling clean, table-ready dishes thanks to our 100+ cleaning jets and an Ultra-Dry system that deliver excellent results

Loading Flexibility – Load the dishes your way. Our lower wash arm provides excellent coverage for the largest of loads. The fold down tines accommodate wide or oddly shaped items and our third rack provides extra space for your silverware and kitchen utensils

Adjustable Upper Racks – You'll have room for your finest stemware and space for tall bakeware with a rack that can be moved two inches up or down, creating ultimate loading flexibility

Wash Zones – Save time and use less water when you don't have a full dish load with a fully customizable cycle that lets you wash a true half load in the upper or lower rack

Create a look that matches your personal style – Select any combination of premium finishes and hardware options to create a stunning look customized to any owner's taste

APPEARANCE

Door Style	Long Door with Top Controls
Installation	Side Installation or Top Installation Included; Built-Up Floor Capable; Flush Cabinet Installation
Door Appearance	Full-Length flat door

FEATURES Ht

Style	Built-In
Tub and Door Liner	Stainless Steel
Tub Type	Tall Tub
Control Type	Cap Touch Controls; 12 Touchpads
Dishwasher Control Features	Cycle Countdown with Bi-Color LED Status Light on door; 1 "Clean" Light; 1 "Sanitized" Light; 1 "Low Rinse Aid" Light; Last Cycle Memory; Audible End-of-Cycle Signal
Wash System	3-Level; 800 Series
Wash System Features	Dual Pumps and Motors; Automatic Temperature Control; Drain Pump; Hard Food Disposer with removable filter; Reversing Quad Blade Lower Wash Arm; Quad Blade Middle Wash Arm; 100+ Spray Jet Wash System; Deep Clean Silverware Jets; Automatic HotStart; Bottle Jets (4)
Sensor	Clean Sensor
Wash Arms	3 Wash Levels; Lower- Reversing Quad Blade; Middle - Quad Blade; Bottle Jets; Deep Clean Silverware Jets
Water Filtration System	100% Filtration with Hard Food Disposer and Removable Filter
Dispenser	Rinse Aid with Indicator and Adjustment
Number of Cycles	5
Dishwasher Cycles	Auto; Pots; Normal; China; Express
Number of Options	10
Dishwasher Options	Delay Start 1-12 Hr.; Lock Controls; Ultra Dry; Normal Dry; Heated Dry Off; Presoak + Sanitize (NSF Certified); Hi-Temp Wash; Wash Zone Upper Only; Wash Zone Lower Only; Start/Reset; Bottle Jets
Rack Features	Ball-Tipped Tines; Adjustable Upper Rack; 3-Piece Silverware Basket with Cell Covers; Full Extension Slides - Upper; 2 short articulating plastic utility shelves w/Stemsafe and chop-stick slots
Racking Material	Nylon
Racking System	Full 3rd rack
Rack Color	Black Pearl
Number of Place Settings	Up to 16
Upper Rack	Premium Height Adjustable; Ball-Tip Tines; 1/2 fixed tines, 1/2 fold down tines; Fixed tines with Bottle Jets; 1 Rack handle; 2 Stem Safe Shelves; Chop stick slots
Lower Rack	Ball-Tip Tines; 1/2 fixed tines, 1/2 fold down tines
Dishwasher Drying Features	Multi-Wattage Wash & Dry Element; Heated Dry - Ultra-On/Off; Fan Assist Dry
Leveling System	4 Leveling Legs
Latch	Pull with Handle
WiFi Connect	Optional (Requires part no. PBX10W00Y0)
Exterior Style	Traditional

ECONOMICAL/QUIET

Quiet Package	45 dBA
Quiet Features	Quiet Water Valve; Sealed Toe Kick; Tub Collar Trim
Motor Type	Single Speed
Outer Wrap	Full-wrap Blanket; Bitumen
Door Insulation	Insulation; Mastic

WEIGHTS & DIMENSIONS

Cabinet Width	24 in
Approximate Shipping Weight	112 lb
Net Weight	105 lb
Overall Height	34 in
Height w/ Legs Retracted - Minimum Height	33-3/8 in
Height w/Legs Extended - Maximum Height	34-5/8 in
Overall Depth	24 in
Overall Width	23-3/4 in

LOT 5


Café™ Stainless Interior Built-In Dishwasher
with Hidden Controls

CDT845P4NW2 / CDT845P3ND1 / CDT845P2NS1




TECHNICAL DETAILS	
Calrod Heater Watts	800/500
Power Connection	Optional cord kit (GPFCD - WX09X70910, WX09X70911)
Volts/Hz/Amps	120v, 60Hz, 7.2A

WARRANTY	
Parts warranty	Limited 1-year entire appliance
Labor warranty	Limited 1-year entire appliance
Warranty notes	See written warranty for full details

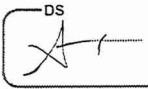


Ht

DIMENSIONS

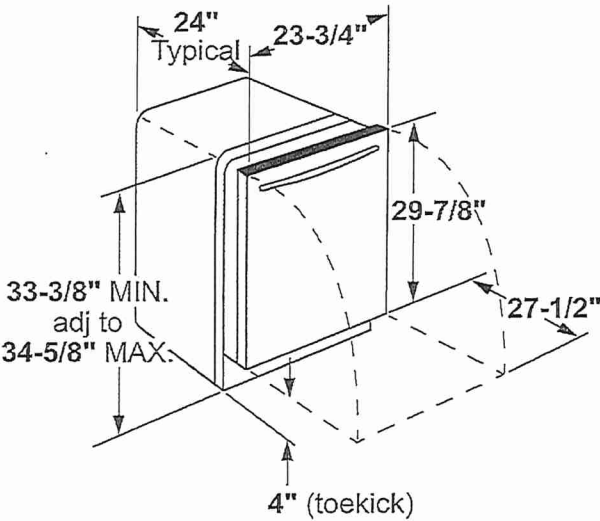


INSTALLATION DIMENSIONS

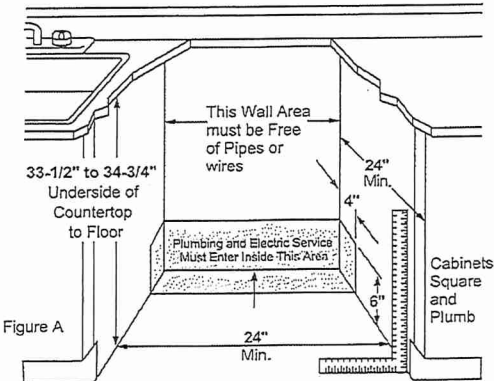


ADDITIONAL ACCESSORIES




Brushed Bronze
CXADTH1PMBZ
(Standard on Matte White)



Brushed Stainless
CXADTH1PMSS
(Standard on Matte Black)



Brushed Black
CXADTH1PMBT




Brushed Copper
CXADTH1PMCUC

LOTS

Café™ Stainless Interior Built-In Dishwasher
with Hidden Controls

CDT845P4NW2 / CDT845P3ND1 / CDT845P2NS1

Ht

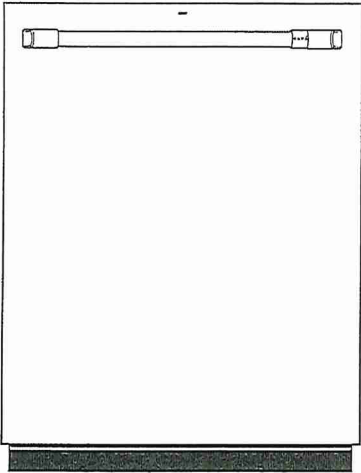

CDT845P4NW2
Matte White with Brushed
Bronze handle



ALSO
AVAILABLE IN



CDT845P3ND1
Matte Black with
Brushed Stainless
handle



CDT845P2NS1
Stainless Steel with
Brushed Stainless
handle

FEATURES & BENEFITS

Ultra-Wash & Dry – Unload sparkling clean, table-ready dishes thanks to our 100+ cleaning jets and an Ultra-Dry system that deliver excellent results

Loading Flexibility – Load the dishes your way. Our lower wash arm provides excellent coverage for the largest of loads. The fold down tines accommodate wide or oddly shaped items and our third rack provides extra space for your silverware and kitchen utensils

Adjustable Upper Racks – You'll have room for your finest stemware and space for tall bakeware with a rack that can be moved two inches up or down, creating ultimate loading flexibility

Wash Zones – Save time and use less water when you don't have a full dish load with a fully customizable cycle that lets you wash a true half load in the upper or lower rack

Create a look that matches your personal style – Select any combination of premium finishes and hardware options to create a stunning look customized to any owner's taste

APPEARANCE

Door Style	Long Door with Top Controls
Installation	Side Installation or Top Installation Included; Built-Up Floor Capable; Flush Cabinet Installation
Door Appearance	Full-length flat door

FEATURES

Style	Built-In
Tub and Door Liner	Stainless Steel
Tub Type	Tall Tub
Control Type	Cap Touch Controls; 12 Touchpads
Dishwasher Control Features	Cycle Countdown with Bi-Color LED Status Light on door; 1 "Clean" Light; 1 "Sanitized" Light; 1 "Low Rinse Aid" Light; Last Cycle Memory; Audible End-of-Cycle Signal
Wash System	3-Level; 800 Series
Wash System Features	Dual Pumps and Motors; Automatic Temperature Control; Drain Pump; Hard Food Disposer with removable filter; Reversing Quad Blade Lower Wash Arm; Quad Blade Middle Wash Arm; 100+ Spray Jet Wash System; Deep Clean Silverware Jets; Automatic HotStart; Bottle Jets (4)
Sensor	Clean Sensor
Wash Arms	3 Wash Levels; Lower-Reversing Quad Blade; Middle - Quad Blade; Bottle Jets; Deep Clean Silverware Jets
Water Filtration System	100% Filtration with Hard Food Disposer and Removable Filter
Dispenser	Rinse Aid with Indicator and Adjustment
Number of Cycles	5
Dishwasher Cycles	Auto; Pots; Normal; China; Express
Number of Options	10
Dishwasher Options	Delay Start 1-12 Hr.; Lock Controls; Ultra Dry; Normal Dry; Heated Dry Off; Presoak + Sanitize (NSF Certified); Hi-Temp Wash; Wash Zone Upper Only; Wash Zone Lower Only; Start/Reset; Bottle Jets
Rack Features	Ball-Tipped Tines; Adjustable Upper Rack; 3-Piece Silverware Basket with Cell Covers; Full Extension Slides - Upper; 2 short articulating plastic utility shelves w/Stemsafe and chop-stick slots
Racking Material	Nylon
Racking System	Full 3rd rack
Rack Color	Black Pearl
Number of Place Settings	Up to 16
Upper Rack	Premium Height Adjustable; Ball-Tip Tines; 1/2 fixed tines, 1/2 fold down tines; Fixed tines with Bottle Jets; 1 Rack handle; 2 Stern Safe Shelves; Chop stick slots
Lower Rack	Ball-Tip Tines; 1/2 fixed tines, 1/2 fold down tines
Dishwasher Drying Features	Multi-Wattage Wash & Dry Element Heated Dry - Ultra/On/Off; Fan Assist Dry
Leveling System	4 Leveling Legs
Latch	Pull with Handle
WiFi Connect	Optional (Requires part no. PBX10W00Y0)
Exterior Style	Traditional

ECONOMICAL/QUIET

Quiet Package	45 dBA
Quiet Features	Quiet Water Valve; Sealed Toe Kick; Tub Collar Trim
Motor Type	Single Speed
Outer Wrap	Full-wrap Blanket; Bitumen
Door Insulation	Insulation; Mastic

WEIGHTS & DIMENSIONS

Cabinet Width	24 in
Approximate Shipping Weight	118 lb
Net Weight	105 lb
Overall Height	34 in
Height w/ Legs Retracted - Minimum Height	33-3/8 in
Height w/ Legs Extended - Maximum Height	34-5/8 in
Overall Depth	24 in
Overall Width	23-3/4 in

LOTS


Café™ Stainless Interior Built-In Dishwasher
with Hidden Controls

CDT845P4NW2 / CDT845P3ND1 / CDT845P2NS1




TECHNICAL DETAILS	
Calrod Heater Watts	800/500
Power Connection	Optional cord kit (GPFCORD - W×O9X70910, W×O9X70911)
Volls/Hertz/Amps	120v; 60Hz; 7.2A

WARRANTY	
Parts warranty	Limited 1-year entire appliance
Labor warranty	Limited 1-year entire appliance
Warranty notes	See written warranty for full details

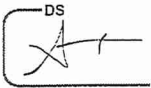


Ht

DIMENSIONS

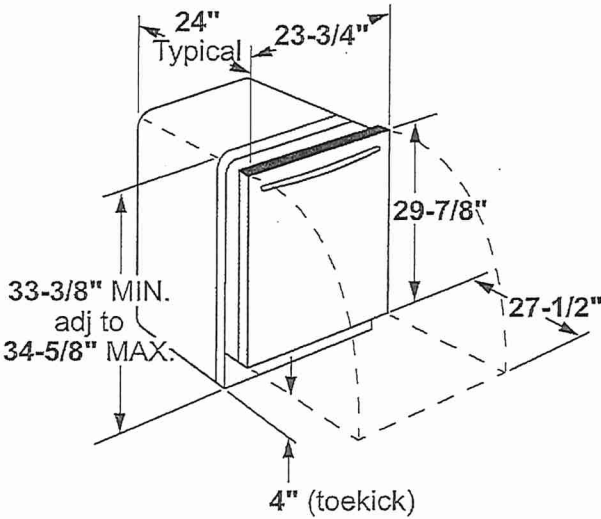

INSTALLATION DIMENSIONS

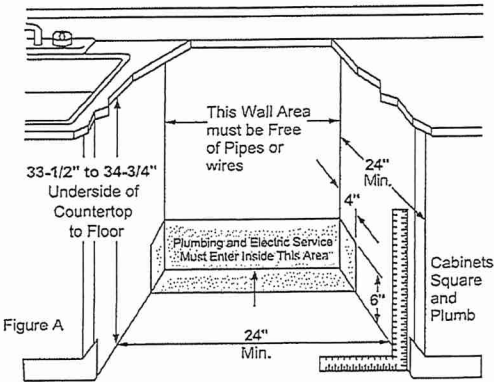

ADDITIONAL ACCESSORIES



Brushed Bronze
CXADTH1PMBZ
(Standard on Matte White)



Brushed Stainless
CXADTH1PMSS
(Standard on Matte Black)




Brushed Black
CXADTH1PMBT



Brushed Copper
CXADTH1PMCU

LOTS

Café™ 30" Combination Double Wall Oven
with Convection and Advantium® Technology
CTC912P2NS1

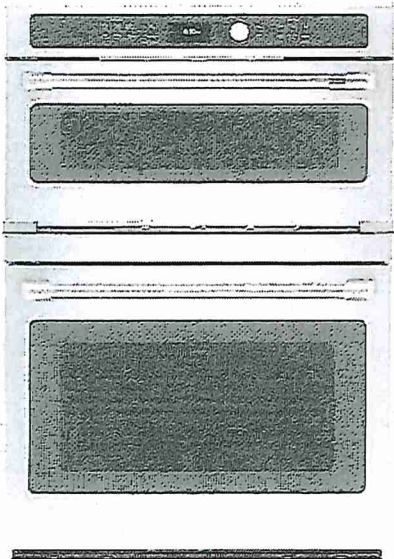

FEATURES & BENEFITS

Unmatched versatility to unleash your imagination - Enjoy a whole new level of cooking flexibility with a single oven that can be used in five different ways. Use it as a Convection Oven, Microwave, Toaster Oven, Warming/Proofing Oven, and Precision Cook Oven with Advantium Technology (upper oven).

The perfect marriage of quality and speed - Eliminate the need for preheating and cook your favorite foods two- to four-times faster than a conventional oven (upper oven)


The perfect bake is now perfectly easy - Achieve unrivaled performance with the only system that delivers top-down true convection for consistent results on special occasion favorites like roasts, chicken, turkey and more (lower oven)

The oven rack that handles it all - Easily remove heavy dishes with a roller rack that is specially designed to glide smoothly and stay in the oven during the self-clean cycle, so you never have to handle cumbersome racks again (lower oven)

The perfect fit you've always dreamed of - When you're updating your kitchen, attention to detail is a priority. That's why Café wall ovens are guaranteed for an exact fit or Café Appliances will pay up to \$300 toward modifications.

APPEARANCE

Color Appearance	Stainless Steel
Handle	Brushed Stainless
Handle Design	Café Pro
Installation	Above Warming Drawer

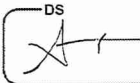

Ht

FEATURES	
Configuration	Double Oven
	Convection Bake (Upper)
	Microwave (Upper)
	Proof (Upper)
	Speedcook (Upper)
	Warm (Upper)
Advantium Cooking Modes	
Cooking System	True European Convection (Lower)
Oven Cleaning Type	Self-Clean with Steam Clean Option (Lower)
Style	Built-In
Cleaning Time	Variable with Delay Clean Option (Lower)
Program Cooking	Over 175 Programmed Menu Selections
	Convection Bake (Lower)
	Convection Bake Multi/Single Rack (Lower)
	Convection Broil (Lower)
	Convection Roast (Lower)
Oven Cooking Modes	
Self-Clean Oven Door Lock	Automatic (Lower)
Baking/Speed Cook Pan	Porcelain (Upper)
	Dial
Control Type	Glass Touch
Oven Features	10-Pass Bake Element
	8-Pass Broil Element
	1 Self-Clean Heavy-Duty Roller Rack
	2 Self-Clean Heavy-Duty Oven Racks
	6 Ladder-Rack Positions (Lower)
Oven Rack Features	
Product Type	Double Oven
	Microwave Oven Combination
	Audible Preheat Signal
	Auto Recipe Conversion
	Sabbath Mode
	Control Lock Capability
	C° or F° Programmable
	Defrost Mode
	Delay Clean Option
	Delay Start
	Electronic Clock & Kitchen Timer (Lower)
	Hi / Low Broil
	Proof Mode
	Temperature Probe
	Warm Mode
Oven Control Features	
	Cook
	Defrost
	Express
	Reheat
Microwave Sensor Cooking Controls	
Microwave Watts (IEC-705)	1000.0
Power Levels	10
Turntable Size	16.0
Cooking Technology	Advantium
Fuel Type	Electric
	1 Halogen Interior Oven Light (Upper)
	2 Halogen Interior Oven Lights (Lower)
Oven Interior	Hidden Bake
CAPACITY	
Capacity (Cu. Ft.)	1.7 Upper / 5.0 Lower
POWER / RATINGS	
Amp Rating at 208V	30
Amp Rating at 240V	30
Bake Wattage	2650W
Broiler Wattage	3400W
Convection Wattage	2400W
Electrical Input - 120V Amperage	15
Electrical Input - 120V Watts	1800
KW Rating at 208V	5.4
KW Rating at 240V	7.2

LOTS

Café™ 30" Combination Double Wall Oven
with Convection and Advantium® Technology
CTC912P2NS1



WEIGHTS & DIMENSIONS


Approximate Shipping Weight	235
Net Weight	215
Overall Height	42 3/8
Overall Width	29 3/4
Overall Depth	26 3/4
Cabinet Width	30
Cutout Dimensions (w x h x d) (in.)	28-5/8 x 42-1/4 x 23-1/2
Oven Interior Dimensions (lower)	25 x 17-3/8 x 20-1/4
Oven Interior Dimensions (upper)	20-1/16 x 8-1/2 x 17

ACCESSORIES

Cookbook	Yes (Advantium)
----------	-----------------

WARRANTY

Parts warranty	Limited 1-year entire appliance
Labor warranty	Limited 1-year entire appliance
Warranty notes	See written warranty for full details

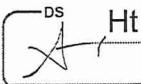

DIMENSIONS AND INSTALLATION INFORMATION

Note: Cabinets installed adjacent to wall ovens must have an adhesion spec of at least a 194°F temperature rating.

Installation Information: Before installing, consult installation instructions packed with product for current dimensional data.

Door handle protrudes 3" from door face. Cabinets and drawers on adjacent 45° and 90° walls should be placed to avoid interference with the handle.

Electric wall ovens are not approved for installation with a plug and receptacle. They must be hard wired in accordance with installation instructions.

Note: These ovens are not approved for stackable or side-by-side installations.

ATTENTION INSTALLER: All electric wall ovens must be hard-wired (direct-wired) into an approved junction box. A plug and receptacle is NOT permitted on these products.


CT9800
PT9800
PT7800
JT3800

NOTE: If the cabinet does not have a solid bottom, two braces or runners must be installed to support the weight of the oven. For single ovens, the runners and braces must support 200 lbs (91 kg). For double ovens, the runners and braces must support 375 lbs. (170 kg).

NOTE: If marks, blemishes or the cutout opening are visible above the installed oven, it may be necessary to add wood shims under the runners and front trim until the marks or opening are covered.

NOTE: If the cabinet does not have a front frame and the sides are less than 3/4" (1.9 cm) thick, shim both sides equally to establish the cutout width.

CABINET	30"
A—Overlap of oven at top of cutout	1"
B—Overlap of oven over side of edges of cutout	3/4"
C—Overlap of oven at bottom of cutout	1"
OVEN	
D—Install depth	23-1/2"
E—Overall height with trim	42-3/8"
F—Overall width	29-3/4"

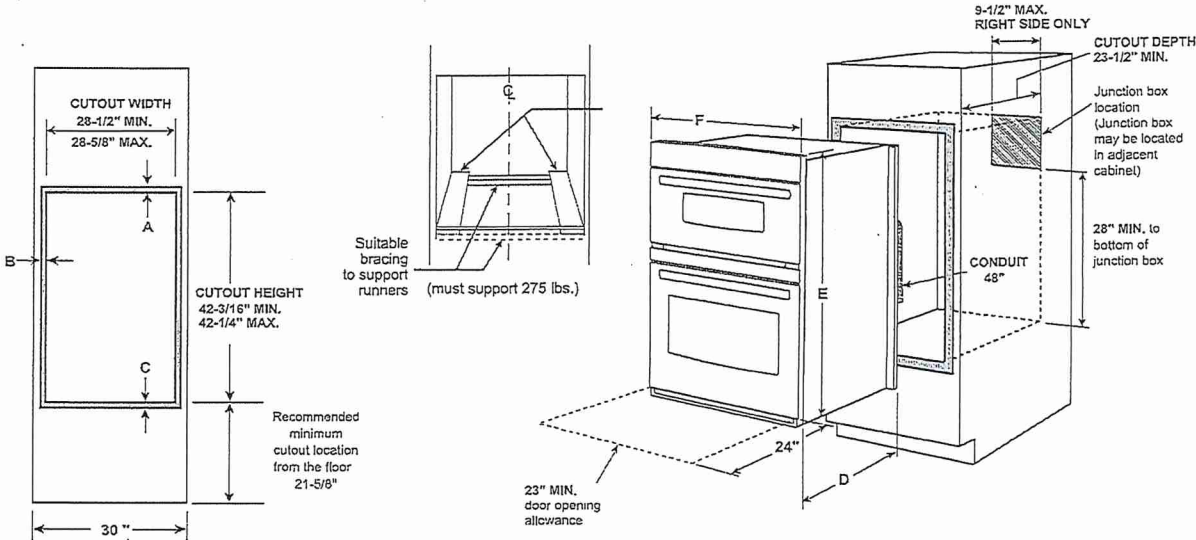

ADDITIONAL ACCESSORIES



CXWD0H0PMBZ
Brushed Bronze
2 handles



CXWD0H0PMSS
Brushed Stainless
2 handles



CXWD0H0PMBT
Brushed Black
2 handles



CXWD0H0PMCU
Brushed Copper
2 handles

For answers to your Café™ product questions, visit our website at cafeappliances.com.

© 2022 GE Appliances PC96509 01/22

LOTS



SITE COPY

CONSTRUCTION SUMMARY

2185715 Ontario Inc.

PURCHASERS: SARBJIT,SINGH THANDI and HARPREET,KAUR THANDI

TEL: RES.: 416-716-7246

LOT NUMBER	PHASE	HOUSE TYPE	CLOSING DATE
005	1	JOHANNA-STD MAIN-4 BEDROOM-ELEVATION A	

Date Added: 26-Aug-22

Invoice Number: 8343

1 - MAIN FLOOR - HARDWOOD FLOORING - COLOUR UPGRADE - Great room, Dining room/main hall, Powder hall, Den, Upper landing - upgrade to colour "Titanium" - Pioneer Solid Collection, Select V Pearl, Red Oak 3 1/4" Note:
1 - KITCHEN - FAUCET - install Builders standard Faucet METHOD PULL (Single hole) OUT CHROME MODEL NO. 7585C - INFO ONLY Note:
1 - KITCHEN - KITCHEN SINK - install builders standard sink blanco 401022 - INFO ONLY Note:
1 - KITCHEN - COUNTERTOP - Install UPGRADE EDGE PROFILE "L" , 1 1/2" THICK. Note:
1 - KITCHEN - COUNTERTOP - install cut out for drop in cooktop (see plan) Note:
1 - DISCLAIMER - STONE COUNTERTOP: KITCHEN - Stone slabs vary in size & all seams are visible - the fabricator reserves the right to position the seams as necessary Note:
1 - KITCHEN BATHROOMS & LAUNDRY - SEE QUALITY TOPS & KITCHENS FOR ALL KITCHEN/BATHROOMS & LAUNDRY ROOM UPGRADES/LAOUTS (See attached QTK paperwork) Note:
1 - ALL BATHROOMS (INCLUDING MASTER AND POWDER); Install builder standard towel bar and toilet paper holder, Info Only Note:
1 - DISCLAIMER - GARAGE DOOR - purchaser declined garage door openers at time of colour charts - purchaser accepts and acknowledges that garage doors will be installed with builder standard garaged door handle with lock -INFO ONLY Note:
1 - MAIN STAIRCASE - MAIN TO SECOND LEVEL - Install upgrade railing package #3. tudor handrail, steel pickets 1/2" sqature (plain/single collar/plain) with shoe, 3 1/2" post square IRP-1 with cap PC1 Note:
1 - STAIRCASE VS FLOORING STAINING DIFFERENCE STAIRCASE: The purchaser was advised and therefore accepts and acknowledges that the stain of the staircase and the flooring chosen do not match. This difference might result in an undersirable colour variance Note: The purchaser agrees that the vendor is to be exempt from any and all claims by the purchaser regarding this colour variance (hardwood is shop finished, and railing is site finished).
1 - UPPER HALL - FLOORING - intstall UPGRADED 3 1/4" RED OAK HARDWOOD, PIONEERED SOLID COLLECTION SELECT V-PEARL COL. TITANIUM Note:
1 - MASTER ENSUITE - SHOWER CEILING - Install STANDARD WALL TILE 8 X 10 CINQ WHITE. Lay straight (SEE PLAN) Note:
1 - MASTER ENSUITE - Install the Moen Chateau Toe Tester for the shower stall of MASTER Ensuite Model #TL183EP/62380 Note:
1 - TWIN BATH - SHOWER CEILING - Install standard wall tile 8 x 10 Uniwall White Glossy (align grout lines best possible) (see sketch) Note:



SITE COPY

CONSTRUCTION SUMMARY
2185715 Ontario Inc.

PURCHASERS: SARBJIT,SINGH THANDI and HARPREET,KAUR THANDI TEL: RES.: 416-716-7246

LOT NUMBER	PHASE	HOUSE TYPE	CLOSING DATE	
005	1	JOHANNA-STD MAIN-4 BEDROOM-ELEVATION A		

Date Added: 26-Aug-22 Invoice Number: 8343

1 - TWIN BATH - Install the Moen Chateau Toe Tester for the shower stall of Twin bath Model #TL183EP/62380

Note:

1 - ENSUITE 2 - SHOWER CEILING - Install standard wall tile 8 x 10 Malena Ice (align grout lines best possible) (see sketch)

Note:

1 - ENSUITE 2 - Install the Moen Chateau Toe Tester for the shower stall of Ensuite 2 Model #TL183EP/62380

Note:

4 - ALL BEDROOMS - DOORS - ADD PRIVACY LOCK to standard levers - See plan

Note:

1 - PURCHASER AWARE AND ACCEPTS THAT ANY CHANGES MADE TO UPGRADES AFTER SIGNING THIS PURCHASERS EXTRA FORM ARE SUBJECT TO A MINIMUM ADMINISTRATION FEE OF \$1000. PLUS A 10% HOLDBACK FEE.

Note:

1 - PURCHASER HAS ATTENDED A COLOR APPOINTMENT AT THE DECOR CENTRE AND HAS DECLINED ANY ADDITIONAL UPGRADES. Purchaser accepts and acknowledges that there will be no futher changes/additions/delections to be made upon signing herein.

Note:

Date Added: 26-Apr-22 Invoice Number: 8258

1 - ADD EXTERIOR SIDE DOOR FROM MUD ROOM TO EXTERIOR - included applicable exterior coach light***IN LIEU OF WINDOW.***

Note:

5 - BASEMENT - UPGRADE FIVE (5) BASEMENT WINDOWS FROM 30 IN X 16 IN TO - 36 IN (W) X 24 IN (H) - with possible window wells

Note:

1 - KITCHEN EXHAUST DUCTING - 8 INCH - UPGRADED DUCT OPENING**DELETE STANDARD BUILDER HOOD FAN**

Note:

2 - TWIN BATH & BATH "ENSUITE 2" CONVERT TUB TO SHOWER INCLUDES 2 IN X 2 FLOOR TILES, 6 IN WHITE QUARTZ CURB PLUS SHOWER POT LIGHT AND U CHANEL ENCLOSURE "KAMELEON"

Note:

1 - KITCHEN - GAS COOKTOP - ADD ROUGH IN GAS LINE FOR STOVE includes applicable electrical

Note:

1 - GREAT ROOM - ADD COFFER CEILING (SEE PLAN)

Note:

1 - GREAT ROOM - ADD WAFFLE CEILING (INSIDE COFFER) (SEE PLAN) - 6 WAFFLE DESIGN TYPE "A" USING TIC 164 \$2800 PLUS PAINT \$1000. PLUS SIX (6) POTS GIFTED (6 OUT OF 10)

Note:

1 - DEN - DELETE SINGLE FRENCH DOOR - ADD DOUBLE FRENCH DOOR

Note:

1 - DEN - ADD CROWN MOULDING (SEE PLAN) 8" IN SERIES TIC-033 (INCLUDES PAINT)

Note:



SITE COPY

CONSTRUCTION SUMMARY

2185715 Ontario Inc.

PURCHASERS: SARBJIT,SINGH THANDI and HARPREET,KAUR THANDI

TEL: RES.: 416-716-7246

LOT NUMBER	PHASE	HOUSE TYPE	CLOSING DATE
005	1	JOHANNA-STD MAIN-4 BEDROOM-ELEVATION A	

Date Added: 26-Apr-22 Invoice Number: 8258

1 - DINING/SIDE HALL/POWDER HALL/FRONT ENTRY/UPPER HALL & STAIRCASE - INSTALL CROWN MOULDING TIC 033 8" SERIIES (SEE PLAN) INCLUDES PAINT Note:
1 - KITCHEN - ADD WATER LINE ROUGH IN TO FRIDGE Note:
13 - KITCHEN - INSTALL THIRTEEN (13) POT LIGHTS (SEE PLAN) (KEEP STND LIGHT OVER ISLAND) *** DELETE STANDARD LIGHT OVER DINETTE) Note:
1 - UPGRADE MANTEL- ** DELETE STANDARD VILLA NOVA MANTLE** - ADD WOOD FLOOR TO CEILING WHITE (SEE SKETCH) WOOD WALL CABINET WITH REVEAL, AIR VENT, NATIONAL HOME COMFORT, BLACK GRANITE 4 PIECE SURROUND, WHITE. Note:
1 - GREAT ROOM - GAS FIREPLACE - **DELETE STANDARD GAS FP UNIT** - ADD GAS FP MAJESTIC JADE 42" LINEAR. Note:
1 - GREAT ROOM - RAISE TV OUTLETT 60" AFF (ABOVE FIREPLACE). ADD ROUGH IN CONDUIT FROM TV TO OUTLET LEFT SIDE OF FIREPLACE. Note:
1 - DEN - POT LIGHTS - ADD FOUR POT LIGHTS (ALL 10 GIFTED POTS NOW COMPLETED) (SEE SKETCH) *DELETE BUILDER STANDARD LIGHT* Note:
15 - FOYER/FRONT HALL/DINING/SIDE HALL - **DELETE ALL BUILDER STANDARD LIGHTS**** ADD POT LIGHTS: TWO (2) AT FOYER, TWO (2) AT FRONT HALL, NINE (9) AT DINING RM. TWO (2) AT SIDE HALL (SEE PLAN) Note:
1 - KITCHEN: ADD ELECTRICAL ROUGH IN FOR BUILT IN WALL OVEN AND MICRO COMBO ADJACENT TO FRIDGE Note:
1 - PURCHASER IS AWARE AND ACCEPTS THAT ANY CHANGES MADE TO UPGRADES AFTER SIGNING THIS PURCHASERS EXTRA FORM ARE SUBJECT TO A MINIMUM ADMINISTRATION FEE OF \$1000. PLUS A 10% HOLDBACK FEE. Note:
1 - PURCHASER HAS ATTENDED A STRUCTURAL APPOINTMENT AT THE DECOR CENTRE AND HAS DECLINED ANY ADDITIONAL UPGRADES. Note:
1 - BONUS PACKAGE - PURCHASER HAS APPLIED \$20,000 UPGRADE PROMOTIONAL PACKAGE TOWARDS THE PURCHASE PURCHASE OF UPGRADES IN THIS AGREEMENT. Note:

This Document is Extremely Time Sensitive - Printed 6 Sep 22 at 14:04



* INTERIOR COLOUR SCHEME *

Purchasers	Decor Consultant	Model and Elevation	Telephone Res. / Bus	Project	Closing Date	Property
SARBjit,SINGH THANDI & HARPREET,KAUR THANDI	Lisa Renzetti	JOHANNA-STD MAIN-4 BEDROOM-ELEVATION A	(416) 716-7246 /	2185715 Ontario Inc.		005

Page 1 of 3

	Flooring	Wall Tile				Plumbing	
	Description	Main	Accent/Insert	Border / Listello	Pattern		
Master Ensuite	✓ 13 X 13 CINQ White (STD)	✓ 13 X 13 CINQ White (STD)	N/A	N/A	NONE	WHITE	
Twin Bath	✓ 13 X 13 Costa White (STD)	✓ 8 x 10 Uniwall White Glossy (STD)	N/A	N/A	NONE	WHITE	
Ensuite 2	✓ 13 x 13 Malena Ice (STD)	✓ 8 x 10 Malena Ice (STD)	N/A	N/A	NONE	WHITE	
Laundry	✓ 13 X 13 Keaton Ice (STD)	N/A	N/A	N/A	NONE	STD	
Kitchen	✓ 18 x 18 Livorno Gris (STD)	NONE	N/A	N/A	NONE	See Notes	
Powder Room	✓ 18 x 18 Livorno Gris (STD)	N/A	N/A	N/A	NONE	See Notes	
Foyer	✓ 18 x 18 Livorno Gris (STD)	N/A	N/A	N/A	NONE	N/A	
Mud Room	✓ 18 x 18 Livorno Gris (STD)	N/A	N/A	N/A	NONE	N/A	
Powder Hall	✓ 3 1/4" Red Oak Titanium (COL UPG)	<div>Railings and Stairs</div> <div>Railings ✓ Tudor</div> <div>Pickets ✓ steel 1/2" sq. (plain/single collar/plain) w.shoe</div> <div>Posts ✓ 3 1/2" square IRP-1 w cap PC1</div> <div>Stringers ✓ STD - Red Oak Titanium</div> <div>Treads ✓ STD - Red Oak Titanium</div> <div>Risers ✓ STD - Red Oak Titanium</div> <div>Runner NONE</div> <div>Trim</div> <div>Baseboard & Casing ✓ STEP BEVEL STND PKG</div> <div>Front Door Glass ✓ STD</div> <div>Interior Doors ✓ STD</div> <div>Knobs STD</div> <div>Hinges STD</div> <div>Grip Set STD</div> <div>Notes</div> <div>MASTER ENSUITE - SHOWER CEILING Install 8 X 10 cinq white. MASTER ENSUITE - SHOWER FLOOR Install 2x2 gray standard mosaic and white quartz curb. TWIN BATH - SHOWER CEILING 8 X 10 Uniwall White Glossy. TWIN BATH - SHOWER FLOOR install 2x2white standard mosaic and white quartz curb. ALL BEDRMS: privacy locks</div>				<div>Cornice Moulding / Medallion</div> <div>✓ Foyer TIC033 - 8 INCH</div> <div>✓ Living Room N/A</div> <div>✓ Dining Room TIC033 - 8 INCH</div> <div>✓ Family Room WAFFLE TIC164</div> <div>✓ Main Hall TIC033 - 8 INCH</div> <div>✓ Kitchen NONE</div> <div>✓ 2nd Floor Hall TIC033 - 8 INCH</div> <div>✓ DEN TIC033 - 8 INCH</div> <div>✓ POWDER HALL TIC033 - 8 INCH</div> <div>✓ MUD LANDING TIC033 - 8 INCH</div>	
Great Room	✓ 3 1/4" Red Oak Titanium (COL UPG)						
Den	✓ 3 1/4" Red Oak Titanium (COL UPG)						
Dining Rm/Main Hall	✓ 3 1/4" Red Oak Titanium (COL UPG)						
2nd Floor Hall	✓ 3 1/4" Red Oak Titanium (COL UPG)						
Master Bedroom	✓ BROADLOOM - Opening Night - 4002-03 (STD)						
Bedroom 2	✓ BROADLOOM - Opening Night - 4002-03 (STD)						
Bedroom 3	✓ BROADLOOM - Opening Night - 4002-03 (STD)						
Bedroom 4	✓ BROADLOOM - Opening Night - 4002-03 (STD)						
Basement Landing							


Page 1 of 3

DocuSigned by:


DocuSigned by:

Page 1 of 3

Consultant: 
Lisa Renzetti

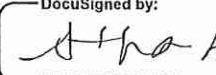Purchaser: 
SARBjit,SINGH THANDI

Purchaser: 
HARPREET,KAUR THANDI

Vendor: 
2185715 Ontario Inc.

CH = Crown molding, TIC-633(8"series)

• = POT LIGHTS


8" EXHAUST DUCT (FUTURE CHIMNEY HOOD FAN)

GL = Gas line


WL = Water line

⊕ = pendant (STND.)

CH = Conduit chase

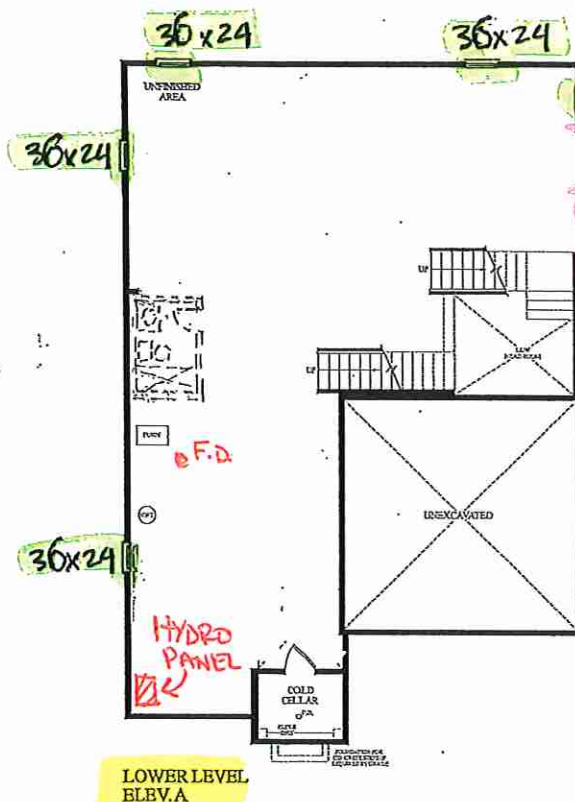

LOWER LEVEL
ELEV.A

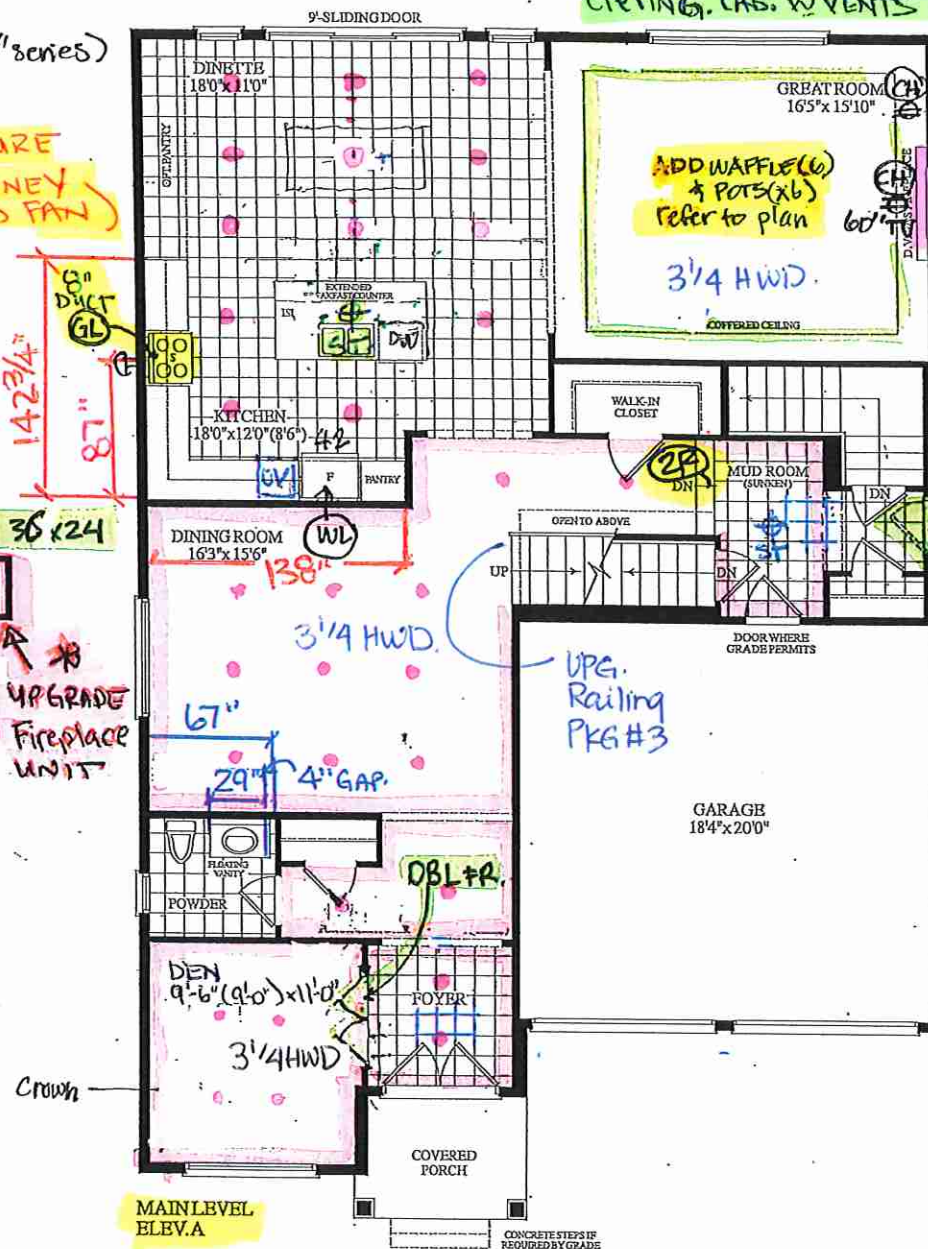


MAIN LEVEL
ELEV.A

GAS.
JADE 42" FIREPLACE
R.O 53" WIDE x 18" DEEP
WHITE WOOD FLOOR to
CIRCLING CAB. w VENTS

FALSE WALL = 50" x 20"

13' x 16"
tile ceiling + toe tester

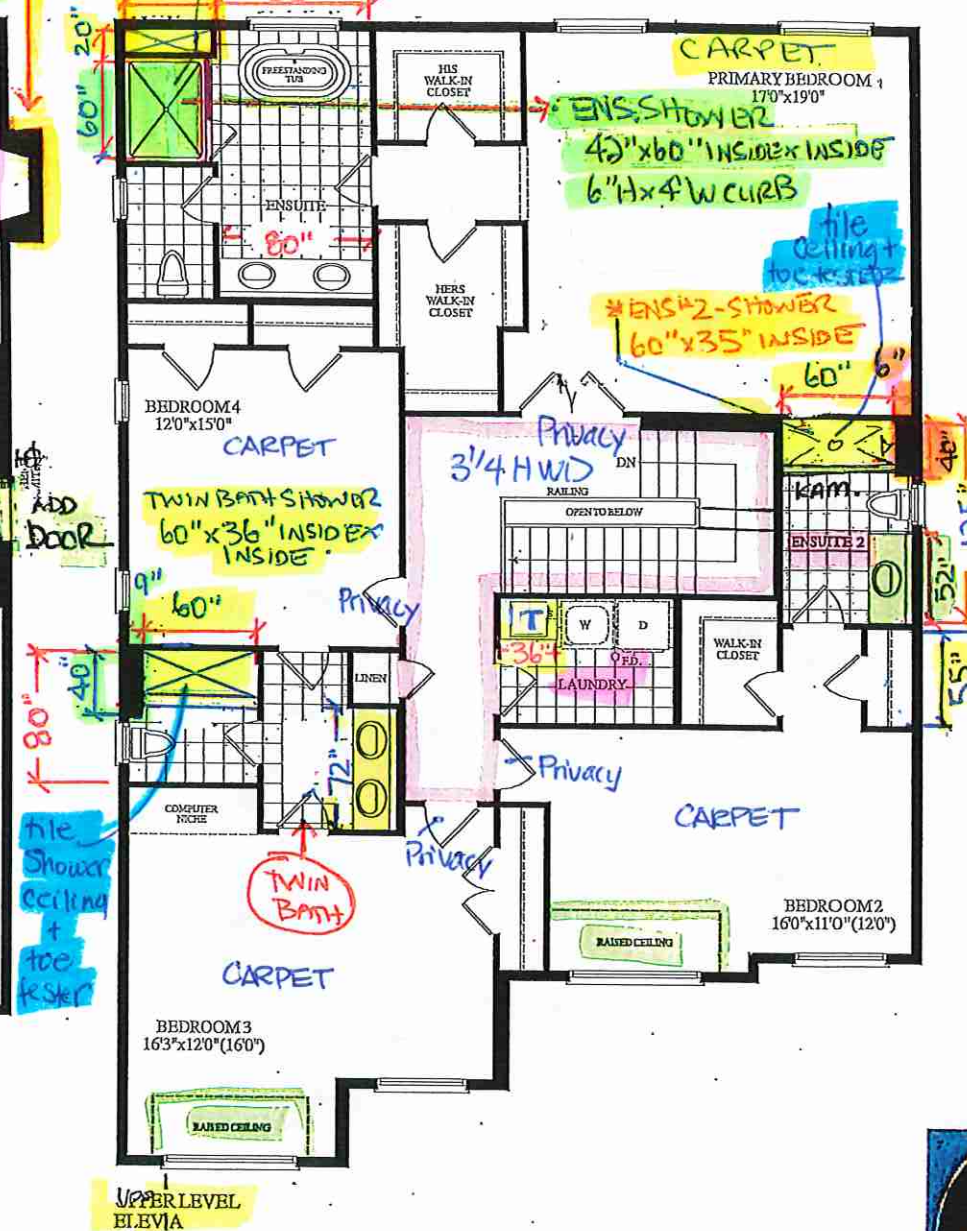

UPPER LEVEL
ELEV.A

RECEIVED
12/23/22



LOT5 . AUG 24.22

your kitchen. your taste.

PURCHASE AGREEMENT FORM

Quality Tops & Kitchens Ltd.

80 Sante Drive, Vaughan, ON L4K 3C4

T 416.746.1811

F 905.761.5901

www.QTK.ca

info@qtk.ca

PURCHASER:	SARBJIT SINGH THANDI HARPREET KAUR	CONTRACTOR:	2185715 ONTARIO INC.
ADDRESS:		SITE:	WEST RIVER VALLEY PH1, BRAMPTON
EMAIL:	tsarbjit@yahoo.com	MODEL TYPE:	45-04 A
PHONE #:	4167167246	LOT #:	5 WRV
PHONE #:	6477844108	DATE:	Aug 22, 2022 Q9410

The purchaser agrees to buy and Quality Tops & Kitchens Ltd. (QTK) agrees to sell and provide for the purchaser the following articles listed herein and with attached drawing in accordance to the terms and conditions described on the reverse of this agreement form.

ROOM	DESCRIPTION	CATEGORY
KITCHEN	DOOR STYLE: QT 4801 NONE FINISH: CLOUD WHITE SPECIES: FIBERBOARD DOOR HARDWARE: DRW HARDWARE: COUNTER TOP: Counter Top by Others	Category 3

ITEM #	QTY	DESCRIPTION	PRICE
3M-CPG	6	CLEAR GLASS, CLEAN CUT (PER DOOR)	
BMO2496	1	BUILT-IN MICRO & WALL OVEN w/ WOOD DRAWER(S) BELOW - 24" D x 95-1/2"H	
CK-3PD	1	DROP IN COOK-TOP w/ POT DRWS w/ BLUM ANTARO WHITE - P/D 3 (1 SMALL, 2 BIG DRW)	
CUST-2	1	PROFESSIONAL SERIES FRIDGE	
CUST-4	1	52" HIGH EXTENDED HEIGHT STACKED UPpers (36" 16") w/ J 82-MLD 700 CROWN MOULDING TO THE CEILING 108" OVERALL - 120" HIGH MOUNTING HEIGHT	
CUST-5	1	UPGRADE TO CATEGORY 3 HARDWARE: DH10280	
CUST-6	1	MIX AND MATCH HANDLES: STACKED UPpers: DH13030	
CUST-7	1	DELETE UPPER ABOVE STOVE	
CUST-8	1	UPGRADE TO CATEGORY 3 DOORSTYLE: QTF 3801 - CLOUD WHITE	
ROOM SUMMARY:			

ROOM	DESCRIPTION	CATEGORY
ENSUITE VANITY	DOOR STYLE: QT 1022 NONE FINISH: TUNDRA SPECIES: LP LAMINATE DOOR HARDWARE: DRW HARDWARE: COUNTER TOP: Counter Top by Others	Category 1

ITEM #	QTY	DESCRIPTION	PRICE
VB-RAISE8	1	RAISE VANITY HEIGHT TO 34-1/2" - PER VANITY (>61" LONG)	
CUST-2	1	CATEGORY 1 HARDWARE: DH00010	
ROOM SUMMARY:			

ROOM	DESCRIPTION	CATEGORY
TWIN VANITY	DOOR STYLE: QT 1022 NONE FINISH: FROSTING SPECIES: LP LAMINATE DOOR HARDWARE: DRW HARDWARE: COUNTER TOP: Counter Top by Others	Category 1

ITEM #	QTY	DESCRIPTION	PRICE
VB-RAISE8	1	RAISE VANITY HEIGHT TO 34-1/2" - PER VANITY (>61" LONG)	
CUST-2	1	CATEGORY 1 HARDWARE: DH00010	
ROOM SUMMARY:			

AT

HT



Quality Tops & Kitchens Ltd.
80 Sante Drive, Vaughan, ON L4K 3C4
T 416.746.1811 F 905.761.5901
www.QTK.ca info@qtk.ca

PURCHASE AGREEMENT FORM

PURCHASER:	SARBJIT SINGH THANDI HARPREET KAUR	CONTRACTOR:	2185715 ONTARIO INC.
ADDRESS:		SITE:	WEST RIVER VALLEY PH1, BRAMPTON
EMAIL:	tsarbjit@yahoo.com	MODEL TYPE:	45-04 A
PHONE #:	4167167246	LOT #:	5 WRV
PHONE #:	6477844108	DATE:	Aug 22, 2022 Q9410

ROOM	DESCRIPTION	CATEGORY
BATH # 2 VANITY	DOOR STYLE: QT 1022 NONE FINISH: WILLOW GREY SUPERMATTE SPECIES: LP LAMINATE DOOR HARDWARE: DRW HARDWARE: COUNTER TOP: Counter Top by Others	Category 1

ITEM #	QTY	DESCRIPTION	PRICE
VB-RAISE4	1	RAISE VANITY HEIGHT TO 34-1/2" - PER VANITY (<60" LONG)	
CUST-2	1	CATEGORY 1 HARDWARE: DH00010	
ROOM SUMMARY:			

ROOM	DESCRIPTION	CATEGORY
POWDER ROOM VANITY	DOOR STYLE: QT 1022 NONE FINISH: TUNDRA SPECIES: LP LAMINATE DOOR HARDWARE: DRW HARDWARE: COUNTER TOP: Counter Top by Others	Category 1

ITEM #	QTY	DESCRIPTION	PRICE
CUST-3	1	CATEGORY 1 HARDWARE: DH00010	
CUST-4	1	FLOATING VANITY w/ FALSE PANEL ABOVE & DRAWER BELOW - 10 1/2" FFL (OPTION PAID FOR BY BUILDER)	
ROOM SUMMARY:			

ROOM	DESCRIPTION	CATEGORY
LAUNDRY ROOM	DOOR STYLE: QT 1022 NONE FINISH: CANVAS SPECIES: LP LAMINATE DOOR HARDWARE: DRW HARDWARE: COUNTER TOP: Laminate Top by QTK D354-60	Category 1

ITEM #	QTY	DESCRIPTION	PRICE
CUST-2	1	CATEGORY 1 HARDWARE: DH00010	
ROOM SUMMARY:			

AT

HT



Quality Tops & Kitchens Ltd.
80 Sante Drive, Vaughan, ON L4K 3C4
T 416.746.1811 F 905.761.5901
www.QTK.ca info@qtk.ca

PURCHASE AGREEMENT FORM

PURCHASER:	SARBJIT SINGH THANDI HARPREET KAUR	CONTRACTOR:	2185715 ONTARIO INC.
ADDRESS:		SITE:	WEST RIVER VALLEY PH1, BRAMPTON
EMAIL:	tsarbjit@yahoo.com	MODEL TYPE:	45-04 A
PHONE #:	4167167246	LOT #:	5 WRV
PHONE #:	6477844108	DATE:	Aug 22, 2022 Q9410

EXPECTED DELIVERY DATE	TBD	SUB-TOTAL:	
Customers please note all garbage bins, spice baskets, magic corner baskets and other accessories will only be delivered AFTER you move in the house. Please call us to request delivery of these items after you move in. Thank you. ALL CHANGES FINAL UPON SIGNING PLEASE READ ALL THE TERMS AND CONDITIONS ON THE ACCOMPANYING QTK TERMS & CONDITIONS DOCUMENT. BY SIGNING BELOW YOU AGREE TO RECEIVE THE ITEMS LISTED HEREIN AND PAY (ACCORDING TO QTK'S PAYMENT POLICY), AND HAVE READ AND UNDERSTOOD THE TERMS & CONDITIONS AS OUTLINED IN THE QTK TERMS & CONDITIONS DOCUMENT.		TOTAL:	
		HST	
		GRAND TOTAL:	
DEPOSIT 1 DATE: _____		DEPOSIT 1:	
DEPOSIT 2 DATE: _____		DEPOSIT 2:	
BALANCE TO BE PAID IN FULL BY DATE: _____		CUSTOMER INITIAL(S): _____	

CUSTOMER SIGNATURE: Harpreet Kaur

DATE: _____

CUSTOMER SIGNATURE: H Thandi

DATE: _____

SALES REP NAME: Mohafizali Merali QTK AUTHORIZED SIGNATURE: _____



80 Sante Drive, Vaughan, ON L4K 3C4
T 416.746.1811 F 905.761.5901
www.QTK.ca info@qtk.ca


CLIENT: ROYAL PINE HOMES	JOB NAME: LOT 5 WRV	ROOM: KITCHEN	DRAWN BY: AA
SITE: WEST RIVER VALLEY LOT 45FT	DOOR STYLE: —	DOOR HANDLE: —	SCALE: 1/2" = 1'-0"
PHONE: —	FINISH: —	DRW HANDLE: —	DATE: MAY 11 2022
EMAIL: —	SPECIES: —	TOP: —	PAGE:

COMMENTS:

Customer Agrees and Accepts the following conditions: 1. The Drawing is a representation only and the installed cabinetry may vary AAightly in product size, measurements, handle appearance and location and other details. Although Quality Tops & Kitchens Ltd. (QTK) does it's best to manufacture exactly what is shown here outside factors may prevent that and some variance is to be expected and accepted by the customer. 2. These drawings represent the intellectual property of QTK and as such the customer understands and accepts that all deposits given by the customer to QTK are non-refundable after QTK has supplied drawings (either physically or electronically) to the customer. If the customer decides to cancel the order after QTK has submitted drawings to the customer, the deposit will then be considered a design fee and no money will be returned to the customer.

KITCHEN PLAN

HT Akhanda

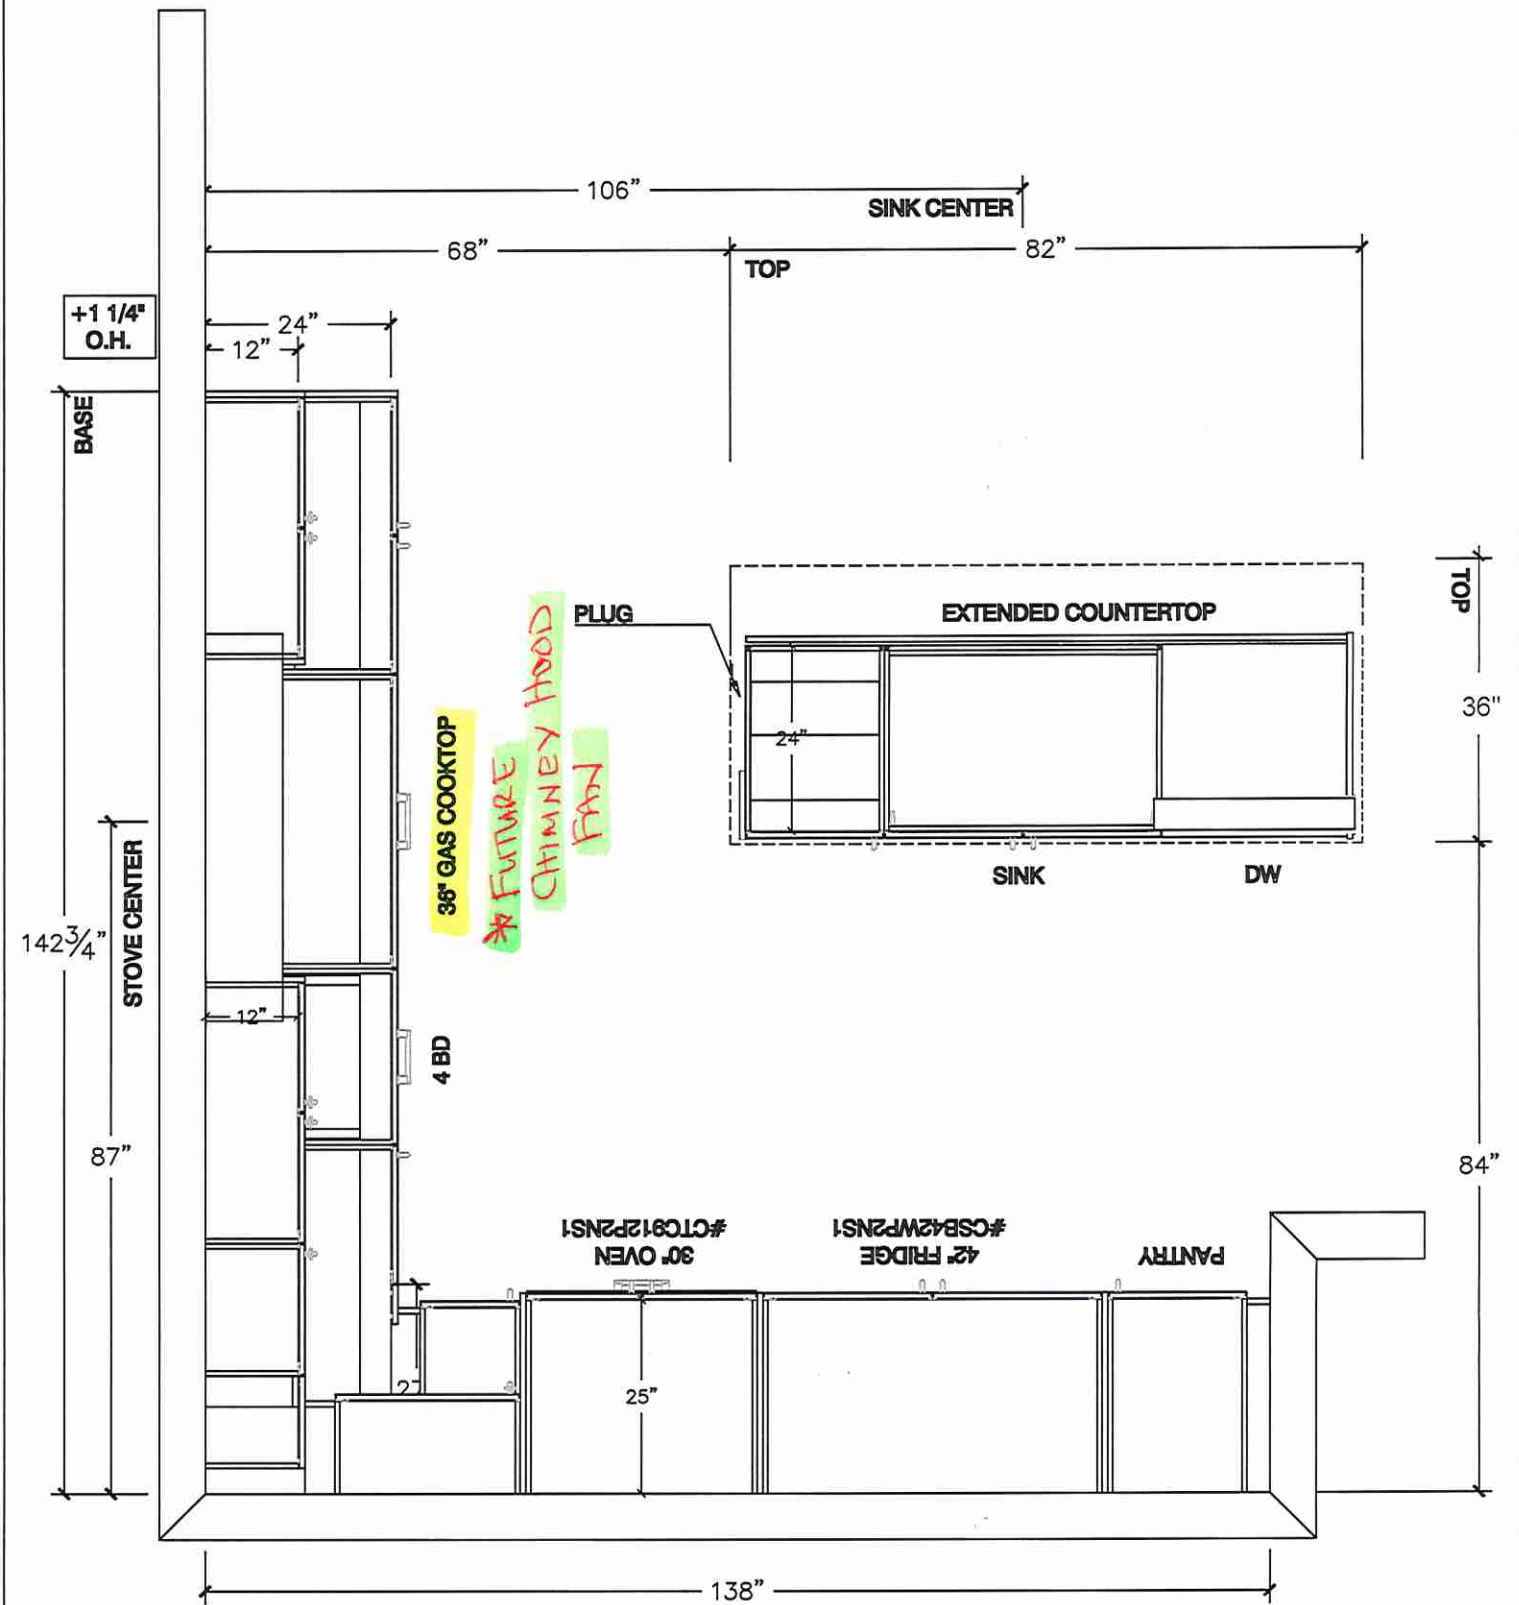



80 Sante Drive, Vaughan, ON L4K 3C4
T 416.746.1811 F 905.761.5901
www.QTK.ca info@qtk.ca


your kitchen. your taste.

CLIENT: ROYAL PINE HOMES	JOB NAME: LOT 5 WRV	ROOM: KITCHEN	DRAWN BY: AA
SITE: WEST RIVER VALLEY LOT 45FT	DOOR STYLE: —	DOOR HANDLE: —	SCALE: 1/2" = 1'-0"
PHONE: —	FINISH: —	DRW HANDLE: —	DATE: MAY 11 2022
EMAIL: —	SPECIES: —	TOP: —	PAGE:

COMMENTS:

Customer Agrees and Accepts the following conditions: 1. The Drawing is a representation only and the installed cabinetry may vary slightly in product size, measurements, handle appearance and location and other details. Although Quality Tops & Kitchens Ltd. (QTK) does it's best to manufacture exactly what is shown here outside factors may prevent that and some variance is to be expected and accepted by the customer. 2. These drawings represent the intellectual property of QTK and as such the customer understands and accepts that all deposits given by the customer to QTK are non-refundable after QTK has supplied drawings (either physically or electronically) to the customer. If the customer decides to cancel the order after QTK has submitted drawings to the customer, the deposit will then be considered a design fee and no money will be returned to the customer.

STOVE WALL ELEVATION

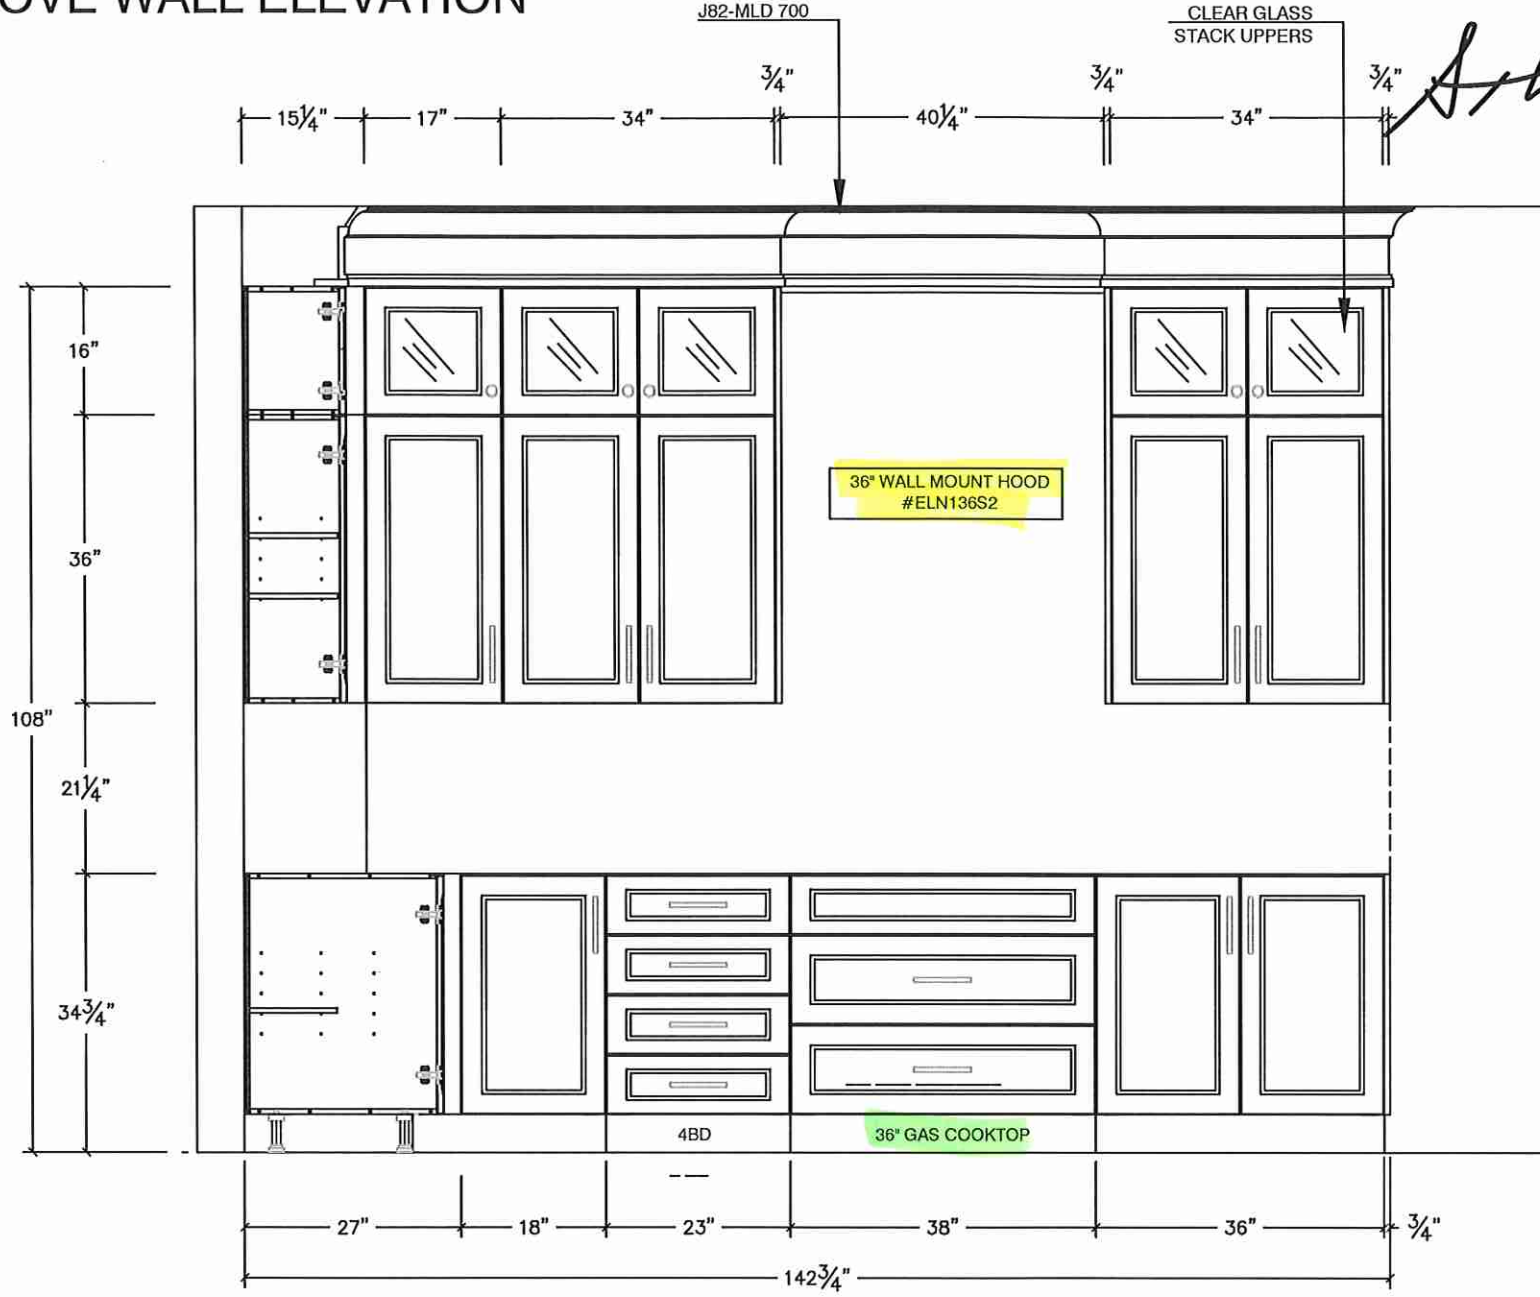

HT



80 Sante Drive, Vaughan, ON L4K 3C4
T 416.746.1811 F 905.761.5901
www.QTK.ca info@qtk.ca


your kitchen. your taste.


CLIENT: ROYAL PINE HOMES	JOB NAME: LOT 5 WRV	ROOM: KITCHEN	DRAWN BY: AA
SITE: WEST RIVER VALLEY LOT 45FT	DOOR STYLE: —	DOOR HANDLE: —	SCALE: 1/2" = 1'-0"
PHONE: —	FINISH: —	DRW HANDLE: —	DATE: MAY 11 2022
EMAIL: —	SPECIES: —	TOP: —	PAGE:

COMMENTS:

Customer Agrees and Accepts the following conditions: 1. The Drawing is a representation only and the installed cabinetry may vary slightly in product size, measurements, handle appearance and location and other details. Although Quality Tops & Kitchens Ltd. (QTK) does it's best to manufacture exactly what is shown here outside factors may prevent that and some variance is to be expected and accepted by the customer. 2. These drawings represent the intellectual property of QTK and as such the customer understands and accepts that all deposits given by the customer to QTK are non-refundable after QTK has supplied drawings (either physically or electronically) to the customer. If the customer decides to cancel the order after QTK has submitted drawings to the customer, the deposit will then be considered a design fee and no money will be returned to the customer.

FRIDGE WALL ELEVATION

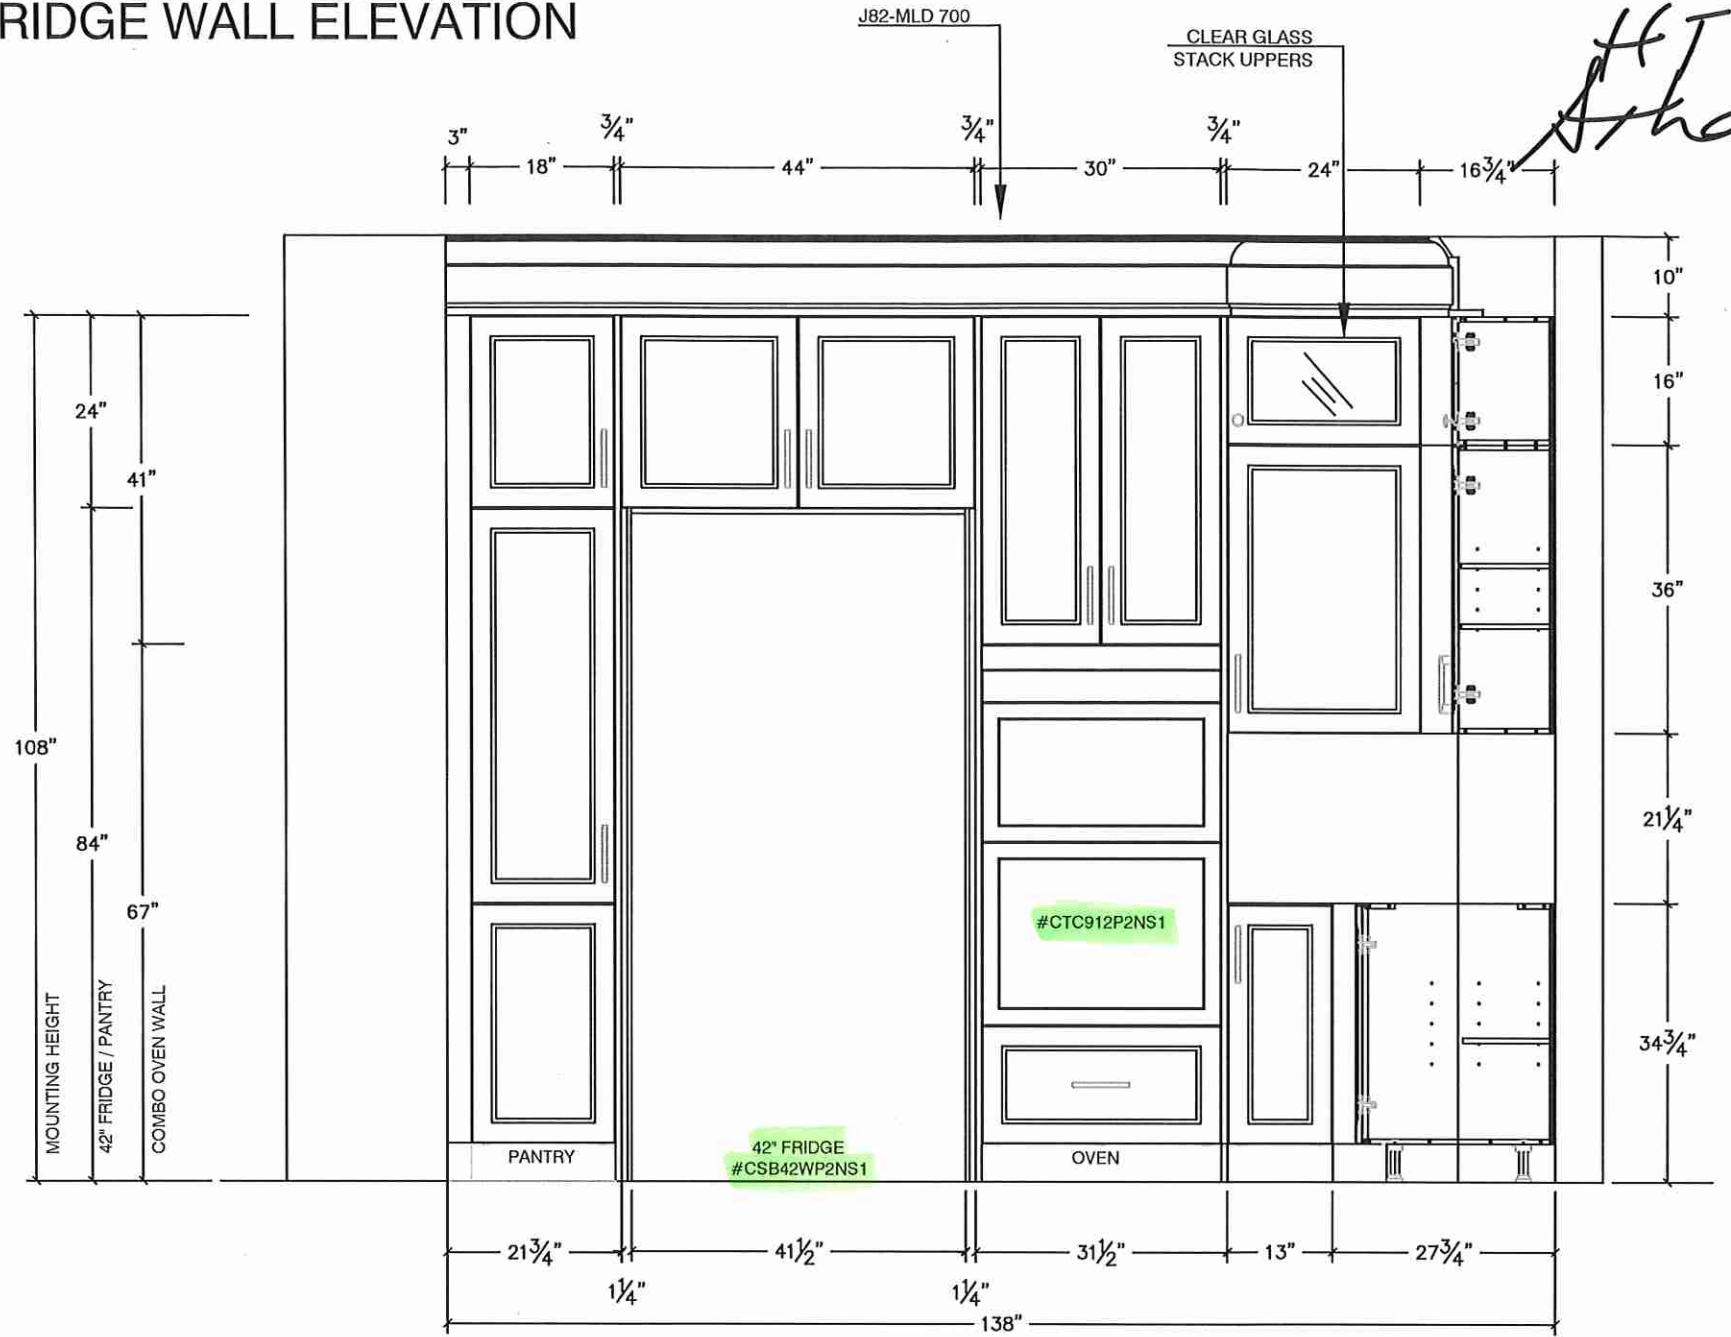

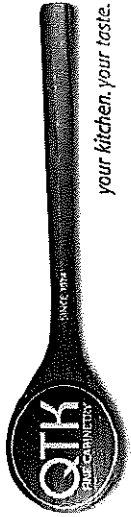


80 Sante Drive, Vaughan, ON L4K 3C4
T 416.746.1811 F 905.761.5901
www.QTK.ca info@qtk.ca

CLIENT: ROYAL PINE HOMES	JOB NAME: LOT 5 WRV	ROOM: KITCHEN	DRAWN BY: AA
SITE: WEST RIVER VALLEY LOT 45FT	DOOR STYLE: —	DOOR HANDLE: —	SCALE: 1/2" = 1'-0"
PHONE: —	FINISH: —	DRW HANDLE: —	DATE: MAY 11 2022
EMAIL: —	SPECIES: —	TOP: —	PAGE:


COMMENTS:

Customer Agrees and Accepts the following conditions: 1. The Drawing is a representation only and the installed cabinetry may vary slightly in product size, measurements, handle appearance and location and other details. Although Quality Tops & Kitchens Ltd. (QTK) does its best to manufacture exactly what is shown here outside factors may prevent that and some variance is to be expected and accepted by the customer. 2. These drawings represent the intellectual property of QTK and as such the customer understands and accepts that all deposits given by the customer to QTK are non-refundable after QTK has supplied drawings (either physically or electronically) to the customer. If the customer decides to cancel the order after QTK has submitted drawings to the customer, the deposit will then be considered a design fee and no money will be returned to the customer.


ISLAND BACK ELEVATION

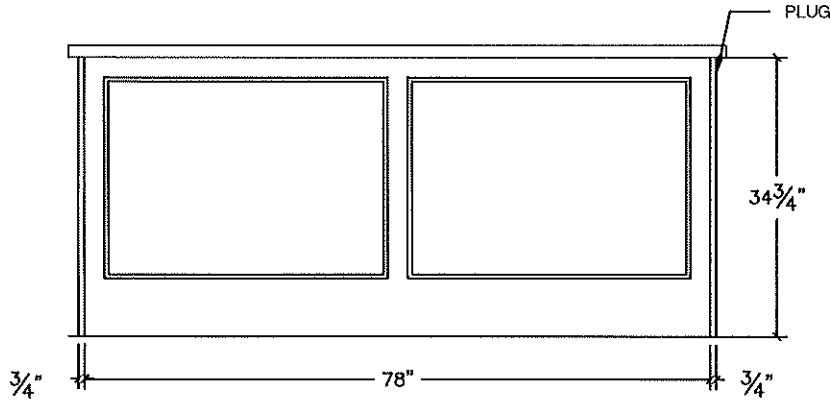

ISLAND FRONT ELEVATION

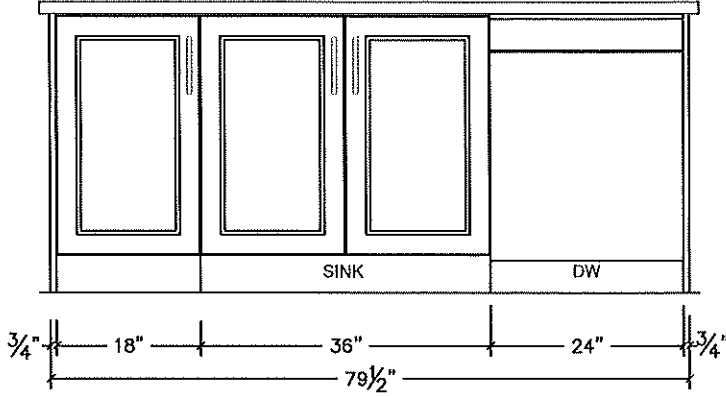


ISLAND SIDE ELEVATION

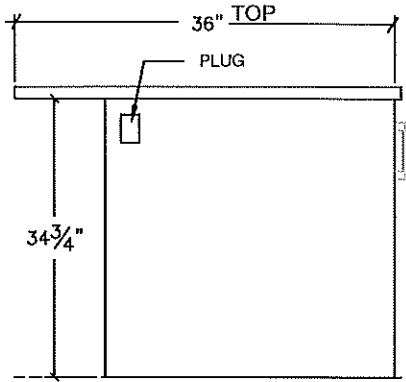

HT

Athar L.

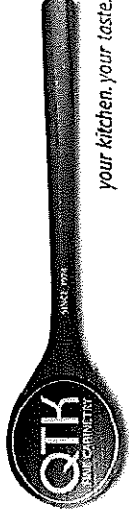


80 Sante Drive, Vaughan, ON L4K 3C4
T 416.746.1811 F 905.761.5901
www.QTK.ca info@qtk.ca

CLIENT: ROYAL PINE HOMES	JOB NAME: LOT 5 WRV	ROOM: KITCHEN	DRAWN BY: AA
SITE: WEST RIVER VALLEY LOT 45FT	DOOR STYLE: —	DOOR HANDLE: —	SCALE: 1/2" = 1'-0"
PHONE: —	FINISH: —	DRW HANDLE: —	DATE: MAY 11 2022
EMAIL: —	SPECIES: —	TOP: —	PAGE:

COMMENTS:

Customer Agrees and Accepts the following conditions: 1. The Drawing is a representation only and the installed cabinetry may vary slightly in product size, measurements, handle appearance and location and other details. Although Quality Tops & Kitchens Ltd. (QTK) does it's best to manufacture exactly what is shown here outside factors may prevent that and some variance is to be expected and accepted by the customer. 2. These drawings represent the intellectual property of QTK and as such the customer understands and accepts that all deposits given by the customer to QTK are non-refundable after QTK has supplied drawings (either physically or electronically) to the customer. If the customer decides to cancel the order after QTK has submitted drawings to the customer, the deposit will then be considered a design fee and no money will be returned to the customer.

KITCHEN VIEW

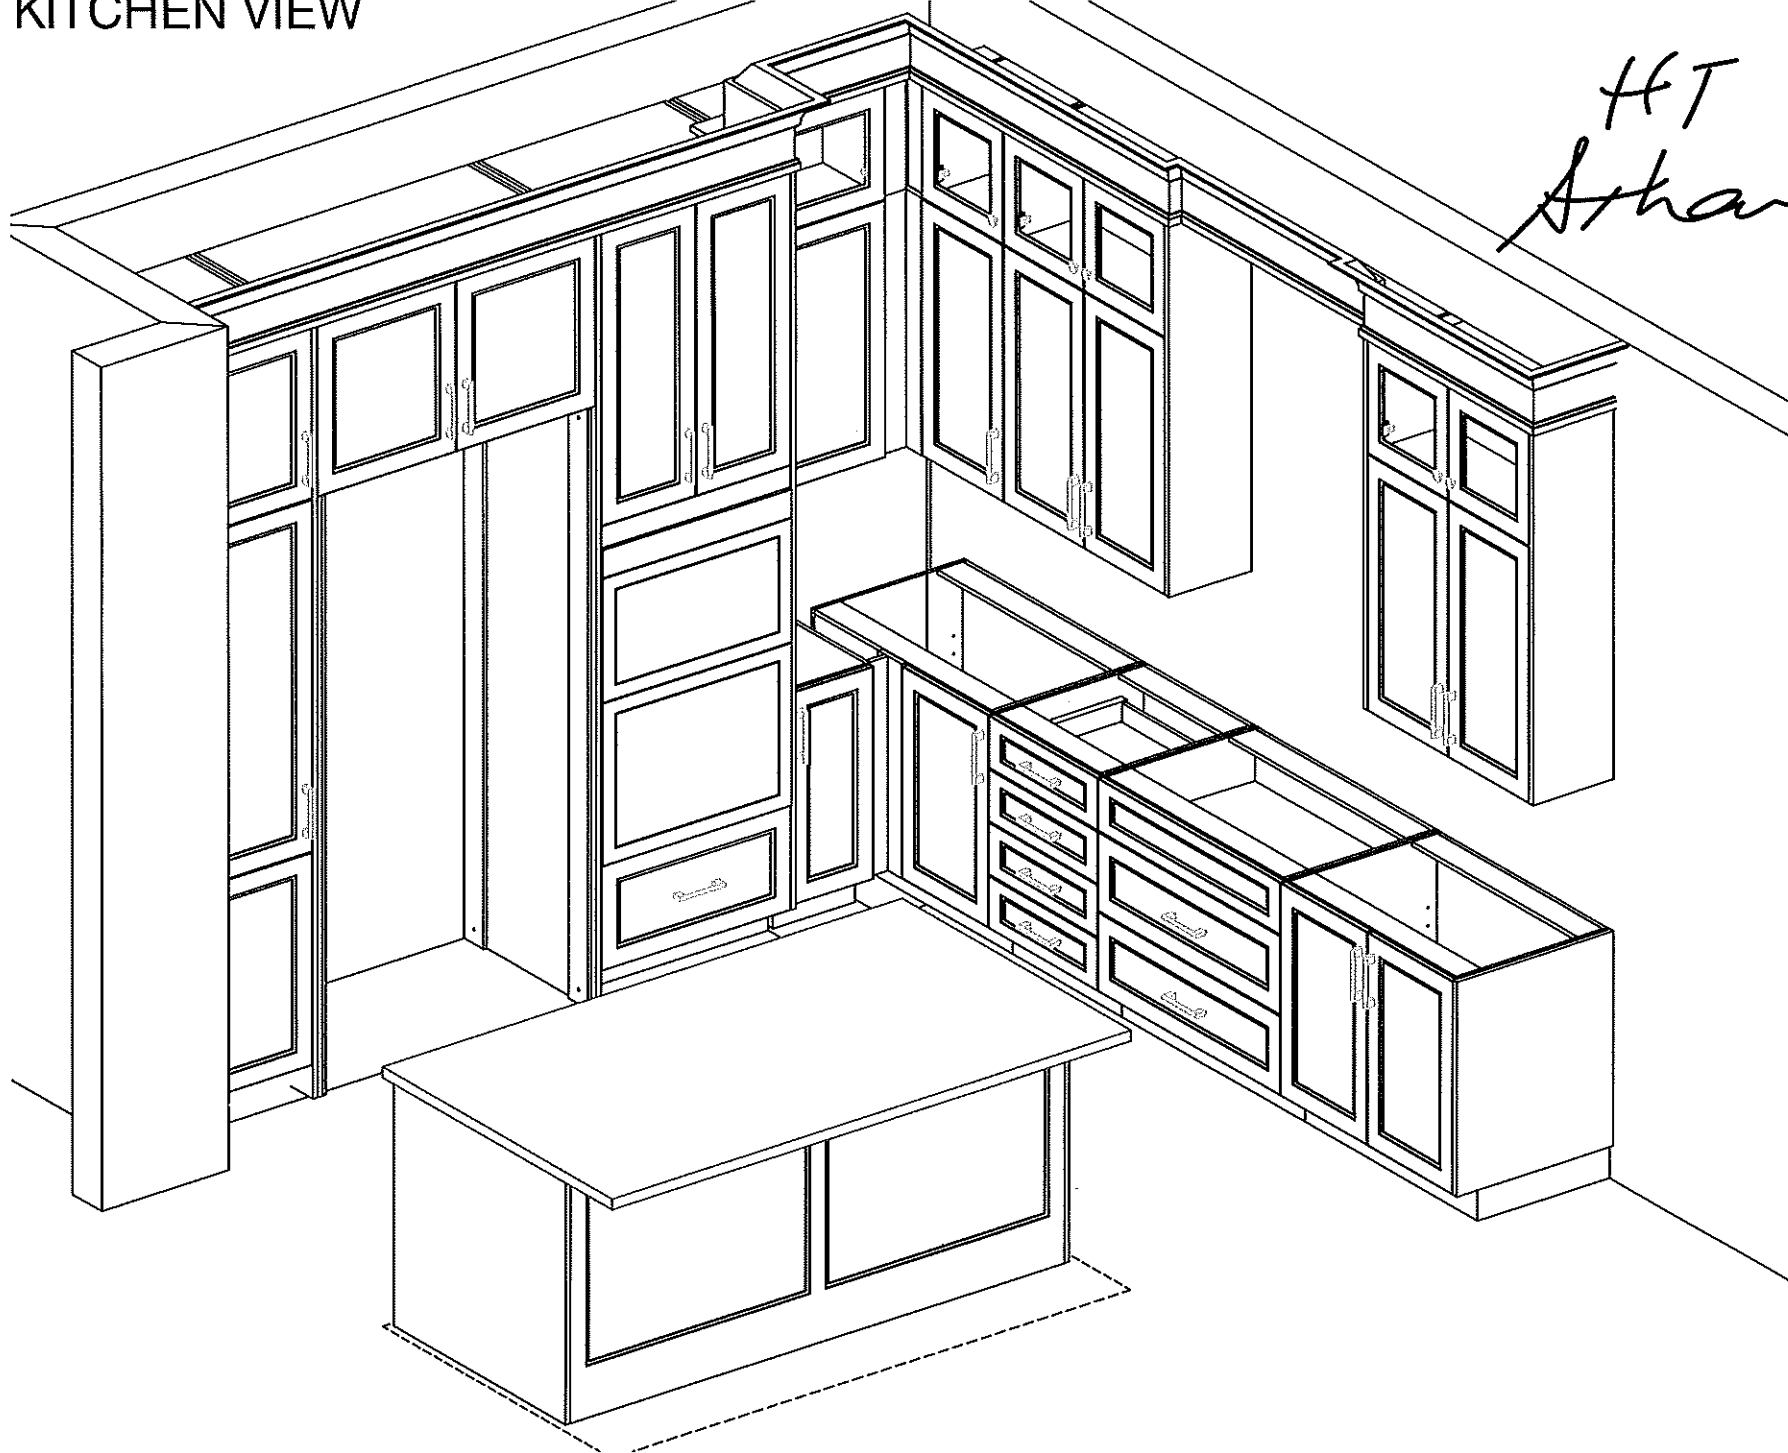



your kitchen, your taste.



80 Sante Drive, Vaughan, ON L4K 3C4
T 416.746.1811 F 905.761.5901
www.QTK.ca info@qtk.ca

CLIENT: ROYAL PINE HOMES	JOB NAME: LOT 5 WRV	ROOM: VANITY	DRAWN BY: SL
SITE: WEST RIVER VALLEY LOT 45FT	DOOR STYLE: —	DOOR HANDLE: —	SCALE: 1/2" = 1'-0"
PHONE: —	FINISH: —	DRW HANDLE: —	DATE: FEB 17, 2022
EMAIL: —	SPECIES: —	TOP: —	PAGE: —


COMMENTS:

Customer Agrees and Accepts the following conditions: 1. The Drawing is a representation only and the installed cabinetry may vary slightly in product size, measurements handle appearance and location and other details. Although Quality Tops & Kitchens Ltd. (QTK) does its best to manufacture exactly what is shown here outside factors may prevent that and some variance is to be expected and accepted by the customer. 2. These drawings represent the intellectual property of QTK and as such the customer understands and accepts that all deposits given by the customer to QTK are non-refundable after QTK has supplied drawings (either physically or electronically) to the customer. If the customer decides to cancel the order after QTK has submitted drawings to the customer, the deposit will then be considered a design fee and no money will be returned to the customer.


MASTER ENSUITE RAISED VANITY

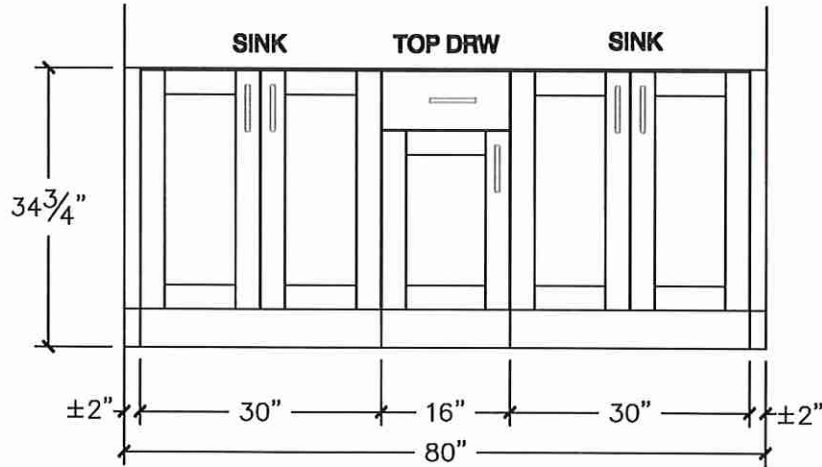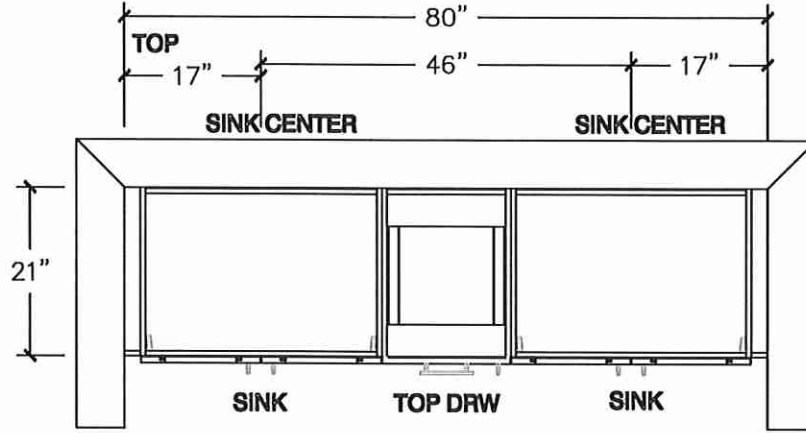

HT ENSUITE 2 RAISED VANITY

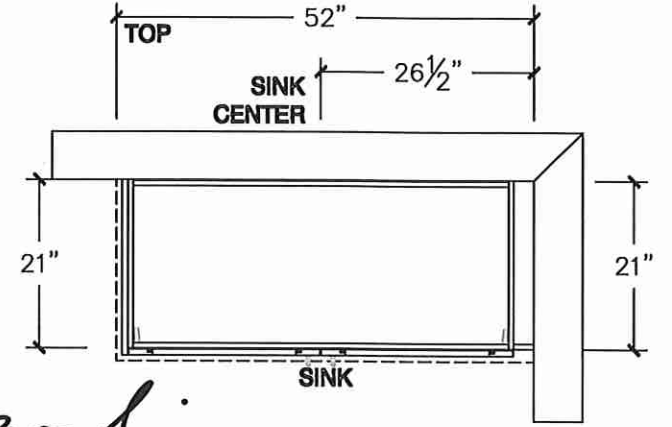

Arhan d.

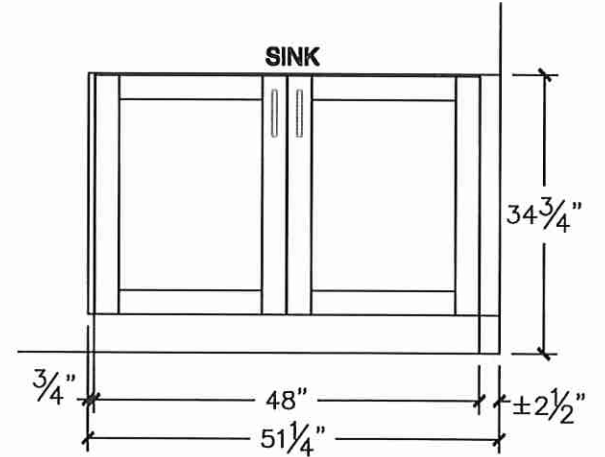



80 Sante Drive, Vaughan, ON L4K 3C4
T 416.746.1811 F 905.761.5901
www.QTK.ca info@qtk.ca



CLIENT: ROYAL PINE HOMES	JOB NAME: LOT 5 WRV	ROOM: VANITY	DRAWN BY: SL
SITE: WEST RIVER VALLEY LOT 45FT	DOOR STYLE: —	DOOR HANDLE: —	SCALE: 1/2" = 1'-0"
PHONE: —	FINISH: —	DRW HANDLE: —	DATE: FEB 17, 2022
EMAIL: —	SPECIES: —	TOP: —	PAGE: —

COMMENTS:



Customer Agrees and Accepts the following conditions: 1. The Drawing is a representation only and the installed cabinetry may vary slightly in product size, measurements, handle appearance and location and other details. Although Quality Tops & Kitchens Ltd. (QTK) does it's best to manufacture exactly what is shown here outside factors may prevent that and some variance is to be expected and accepted by the customer. 2. These drawings represent the intellectual property of QTK and as such the customer understands and accepts that all deposits given by the customer to QTK are non-refundable after QTK has supplied drawings (either physically or electronically) to the customer. If the customer decides to cancel the order after QTK has submitted drawings to the customer, the deposit will then be considered a design fee and no money will be returned to the customer.

TWIN BATH

RAISED VANITY

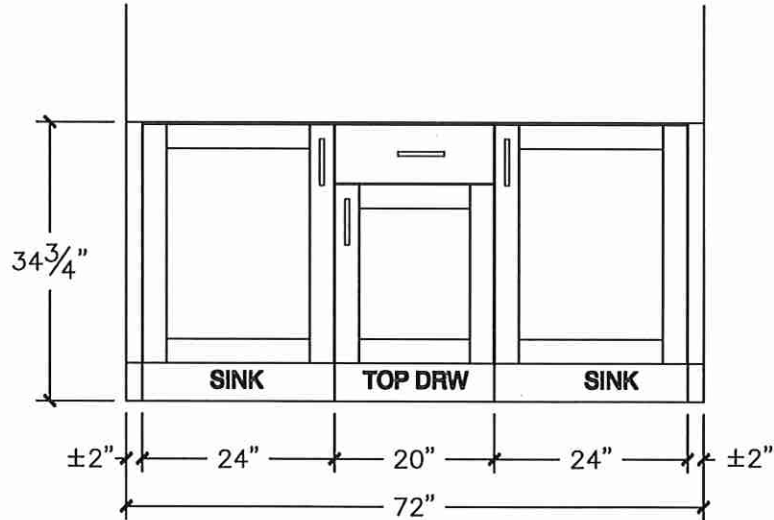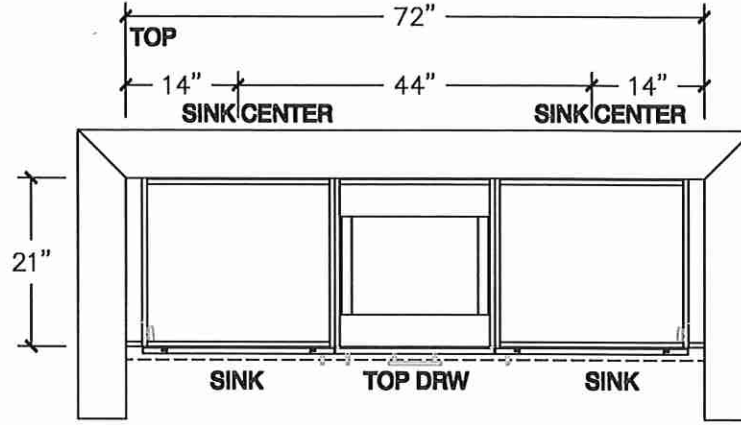

POWDER ROOM

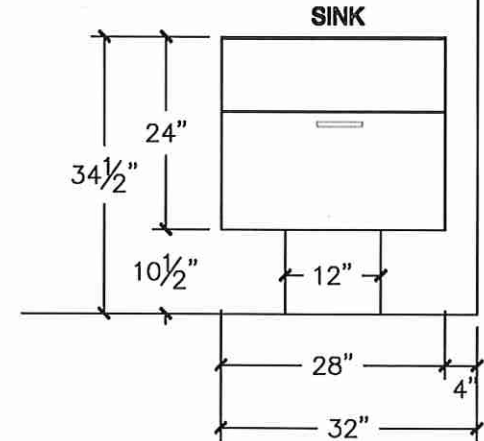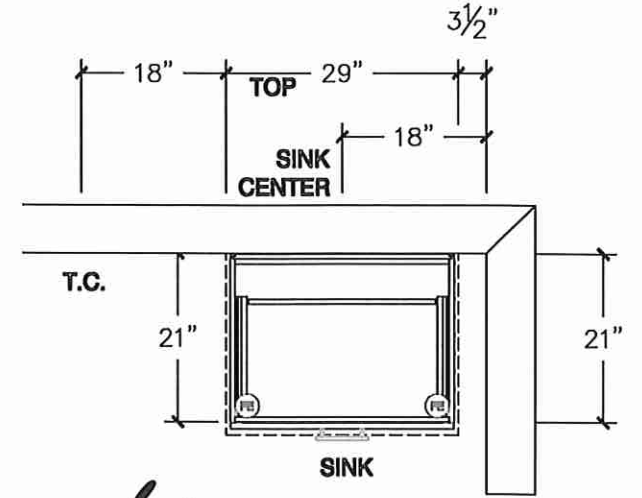

Arhan d.



your kitchen. your taste.


80 Sante Drive, Vaughan, ON L4K 3C4
T 416.746.1811 F 905.761.5901
www.QTK.ca info@qtk.ca

CLIENT: ROYAL PINE HOMES	JOB NAME: LOT 5 WRV	ROOM: LAUNDRY	DRAWN BY: SL
SITE: WEST RIVER VALLEY LOT 45FT	DOOR STYLE: __	DOOR HANDLE: __	SCALE: 1/2" = 1'-0"
PHONE: __	FINISH: __	DRW HANDLE: __	DATE: FEB 17 2022
EMAIL: __	SPECIES: __	TOP: __	PAGE:

COMMENTS:


Customer Agrees and Accepts the following conditions: 1. The Drawing is a representation only and the installed cabinetry may vary AAightly in product size, measurements, handle appearance and location and other details. Although Quality Tops & Kitchens Ltd. (QTK) does it's best to manufacture exactly what is shown here outside factors may prevent that and some variance is to be expected and accepted by the customer. 2. These drawings represent the intellectual property of QTK and as such the customer understands and accepts that all deposits given by the customer to QTK are non-refundable after QTK has supplied drawings (either physically or electronically) to the customer. If the customer decides to cancel the order after QTK has submitted drawings to the customer, the deposit will then be considered a design fee and no money will be returned to the customer.

LAUNDRY

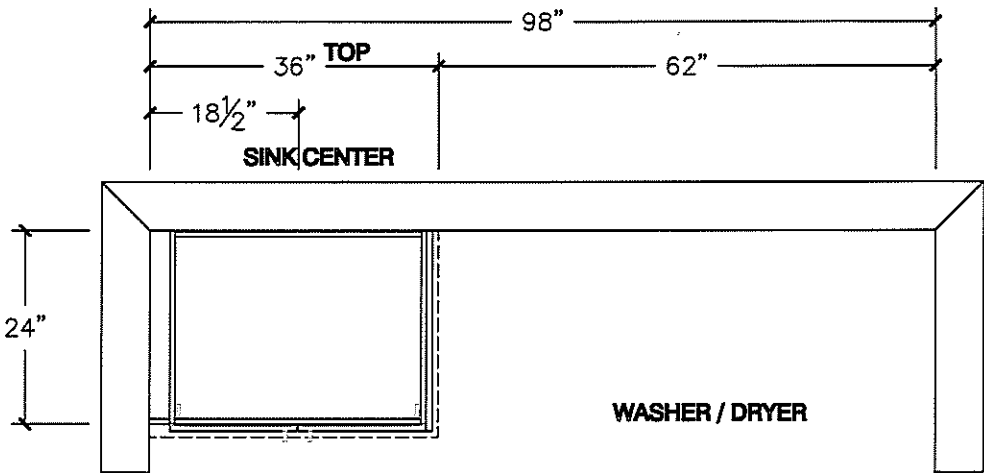

HT

Sketch

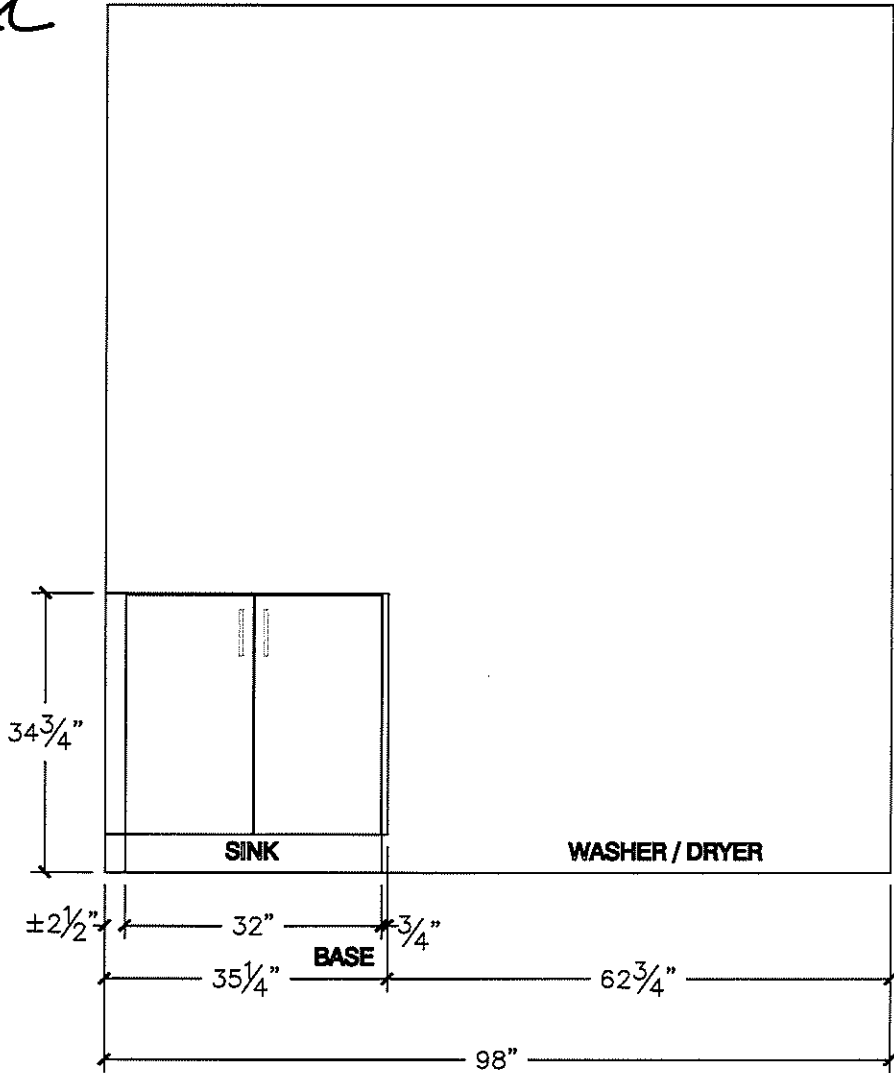


Sarbjit Thandi LUT

Café™ 42" Built-in Side-by-Side Refrigerator

CSB42WP2NS1

CAFE

DISTINCT BY DESIGN™

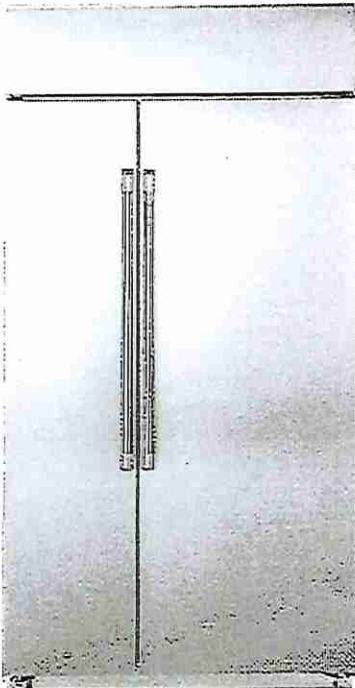

CSB42WP2NS1
Stainless Steel with
Brushed Stainless handles



FEATURES & BENEFITS

Display groceries like a gallery with **showcase LED lighting** positioned throughout the interior to spotlight your favorite foods and containers

Enjoy peace of mind with **WiFi Connect technology** that provides a helpful alert when there's an unexpected change in performance, like a drop in temperature if the door is left open or power is lost

Spills happen, but cleanup is stress-free thanks to **adjustable slide-out spillproof glass shelves** that easily shift and lock, and have raised edges to contain mess.

Enjoy water and ice from the refrigerator with total peace of mind, thanks to an **advanced water filtration system** that uses MWF replacement filters to remove 98% of certain pharmaceuticals*

*Removes 98% of ibuprofen, atenolol, fluoxetine, progesterone and trimethoprim. These pharmaceuticals are not necessarily in all users' water.

Whether you're refrigerating an appetizer or dessert, ensure a consistent temperature with an **advanced temperature management system** perfect for any course

Free up valuable shelf space with **large door bins**, perfect for storing the small foods and containers that can add up and deprive you of room for heftier items

APPEARANCE

Installation	Built-in installation
Exterior design	Flat doors
Handle design	Café™
Hidden door hinge(s)	Yes

FEATURES

WiFi connect	Built-in
Connected capabilities	Amazon Alexa; The Google Assistant; IFTTT
Temperature management features	Multi-shelf air management tower; Independent temperature; controls
Defrost type	Automatic defrost
Control type	Upfront electronic digital; Temperature display
Dispenser	Non-dispenser
Icemaker	Factory-installed
Water filtration	GE water filtration 6 month; Water filter indicator light
Filter location	Upper right corner
Fresh food cabinet shelves	4 total; 3 adjustable
Fresh food door bins	5 adjustable; 1 with gallon storage
Fresh food features	Door alarm
Fresh food cabinet shelf features	3 adjustable, spillproof glass; 1 spillproof glass
Top drawer	Snack drawer
Middle drawer	Sealed
Bottom drawer	Select Temp
Clear Lexan bins and pans	Yes
Interior lighting	LED
Freezer door bins	5 total
Freezer cabinet shelves	4 total; wire; 4 adjustable
Freezer baskets	2 wire (full-extension)
Adjustable freezer shelves (wire)	Yes
Exterior style	Built-in
Leveling system	4 point front adjustable

CAPACITY

Total capacity (cubic feet)	25.1 cu. ft.
Fresh food capacity	15.80 cu. ft.
Freezer capacity	9.40 cu. ft.

WEIGHTS & DIMENSIONS

Overall depth	28-1/2 in.
Overall height	84 in.
Overall width	42 in.
Case depth without door	23-1/2 in.
Depth with fresh food door open 90°	50-1/4 in.
Depth without handle	25-3/4 in.
Height to top of case	83-1/2 in.
Width w/doors open 90° incl. handle	48-1/4 in.
Width w/doors open 90° less handle	42-5/8 in.
Approximate shipping weight	725 lb.
Net weight	688 lb.

LOT 5 WRV

DS DS
[Signature]


Café™ 42" Built-in Side-by-Side Refrigerator
CSB42WP2NS1



WARRANTY

Parts Warranty	Limited 1-year entire appliance Limited 5-year sealed refrigerating system
Labor Warranty	Limited 1-year entire appliance Limited 5-year sealed refrigerating system
Warranty Notes	See written warranty for full details

DIMENSIONS AND INSTALLATION

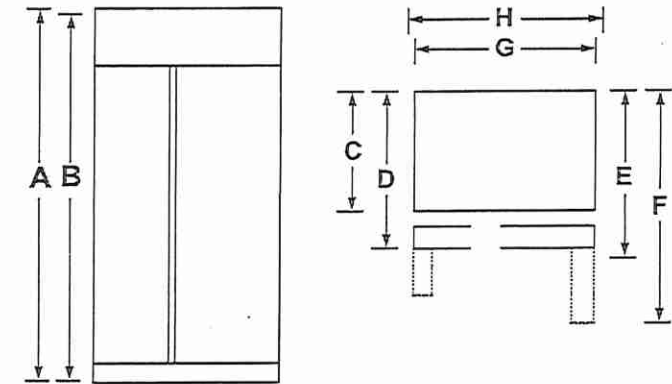


Overall Dimensions	Height to top of grill (in.) A	84
	Height to top of case (in.) B	83-1/2
	Case depth without door (in.) C	23-1/2
	Case depth less door handle (in.) D	25-3/4
	Case depth with door handle (in.) E	28-1/2
	Depth with fresh food door open 90° (in.) F	50-1/4
	Width (in.) G	42
	Width with doors open 90° inc. handle (in.) H	48-1/4

PRODUCT CLEARANCES

These refrigerators are equipped with a 3-position door stop. The factory set 115° door swing can be adjusted to 90° if clearance to adjacent cabinets or walls is restricted.

Allow minimum clearances for Freezer door (Dimension A) and Fresh Food door (Dimension B) for a full 130° door swing and to allow for drawer removal.

4-5/8" minimum clearance is required when door swing is adjusted to 90°. If the 90° door stop position is used, drawer access is maintained, but drawer removal is restricted.

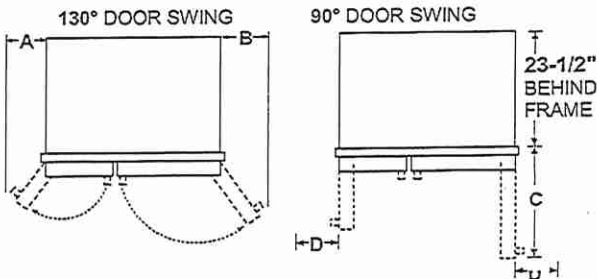

Models	A	B	C	D
42"	11-1/4"	17-5/8"	26-9/15"	4-5/8"

GROUNDING THE REFRIGERATOR

IMPORTANT—PLEASE READ CAREFULLY

FOR PERSONAL SAFETY, THIS APPLIANCE MUST BE PROPERLY GROUNDING.

The power supply cord of this appliance is equipped with a three-prong (grounding) plug which mates with a standard three-prong (grounding) wall receptacle to minimize the possibility of electric shock hazard from this appliance.


Have the wall outlet and circuit checked by a qualified electrician to make sure the outlet is properly grounded.

Where a standard 2-prong wall outlet is encountered, it is your personal responsibility and obligation to have it replaced with a properly grounded 3-prong wall outlet.

DO NOT UNDER ANY CIRCUMSTANCES, CUT OR REMOVE THE THIRD (GROUND) PRONG FROM THE POWER CORD.

DO NOT USE AN ADAPTER PLUG TO CONNECT THE REFRIGERATOR TO A 2-PRONG OUTLET.

DO NOT USE AN EXTENSION CORD WITH THIS APPLIANCE.

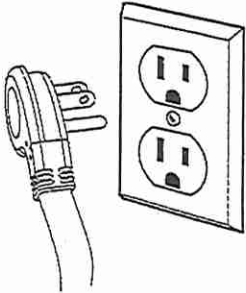

LOTS WRV

DS DS
NOT

Café™ 42" Built-in Side-by-Side Refrigerator
Refrigerator
CSB42WP2NS1



DIMENSIONS AND INSTALLATION

SIDE PANELS

Side panels (not supplied) must be used whenever the sides of the refrigerator will be exposed. The 1/4" side panels will slip into the side case trim. Order side panels from your cabinet manufacturer.
*Depending on installation height.

FLOORING

For proper installation, this refrigerator must be placed on a level surface of hard material that is at the same height as the rest of the flooring. This surface should be strong enough to support a fully loaded refrigerator, or approximately 1500 lbs.


NOTE: Protect the finish of the flooring. Cut a large section of the cardboard carton and place under the refrigerator where you are working.

WATER AND ELECTRICAL LOCATIONS

The opening must be prepared with the electrical and water supply located as shown.

THE CUTOUT DEPTH MUST BE 24"


The refrigerator will project forward, slightly beyond adjacent cabinets, depending on your installation.

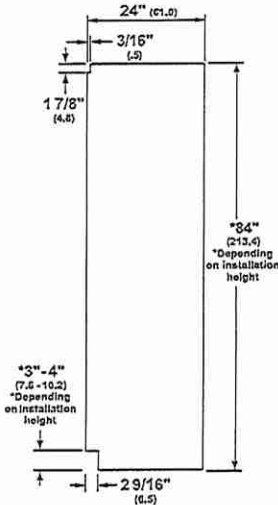

SIDE PANEL

ADDITIONAL SPECIFICATIONS

A 120 volt, 60Hz, 15 or 20 amp power supply is required. An individual properly grounded branch circuit or circuit breaker is recommended. Install a properly grounded 3-prong electrical receptacle recessed into the back wall. Electrical must be located on rear wall as shown.

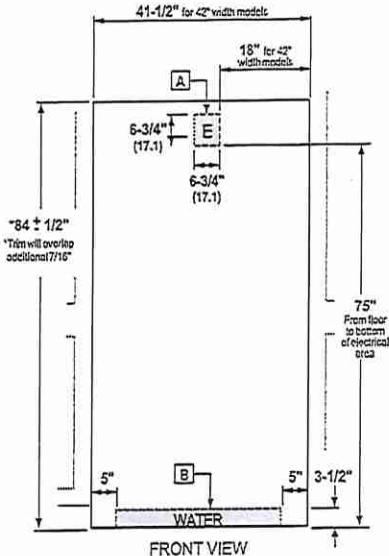

A – Mounting the junction in this location will also allow for front accessibility through access panel.
B – Water supply area.

NOTE: GFI (ground fault interrupter) is not recommended. Water line can enter the opening through the floor or rear wall. The water line installed should be 1/4" O.D. copper tubing or GE SmartConnect™ tubing between the cold water line and water connection location. The line should be long enough to extend to the front of the refrigerator. Installation of an easily accessible shutoff valve in the water line is required.

ADDITIONAL ACCESSORIES



CXSS2H2PMBZ
Brushed Bronze
2 handles



CXSS2H2PMBT
Brushed Black
2 handles





CXSS2H2PMCUC
Brushed Copper
2 handles

LOT 5
WRV

DS DS
[Signature]



ELN136S2
36" Professional Wall Mount Hood

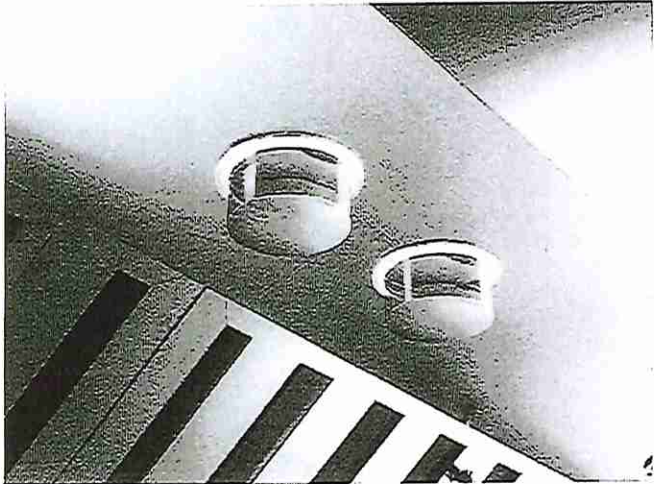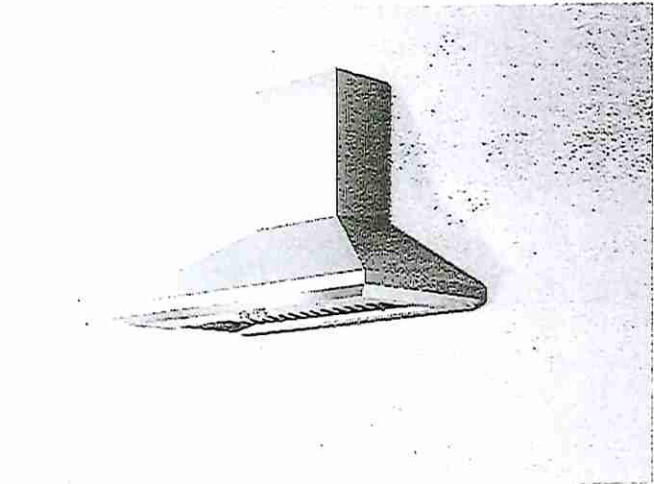


Selected Model	
Model number	ELN630S2
Color	Stainless Steel
Dimensions	
Dimensions	36" (W) X 24" (D) X 12 1/8" (H)
Features	
Controls	Fully recessing stainless rotating knobs with illumination
Illumination	2 2.5W Premium LED lamps, 1 intensity (bulbs included)
Blower Type	Hush Silence System 1200 CFM, 4-speed
Blower Performance	Speed 2, 640 CFM, 4.7 Sones
	Speed 3, 940 CFM, 8.1 Sones
	Speed 4, 1200 CFM, 7.7 Sones
	Speed 1, 375 CFM, 3.2 Sones
Filter Type	Stainless Steel Baffle filters (3X)
Ducting	Ducted Installation Only
Duct transition	8" round with Back Draft Damper included
Chimney (ducted out)	For ceiling height 7'6" to 9'11" (elect cooking) & 8'0" to 9'11" (gas cooking)
Accessories (optionnal)	
Chimney extension kit	KIT02785 (Ceiling 9'3" - 13'0" (electric cooking) 9'9"-13'0" (gas cooking)
External Blower Kit	KIT0153054 (1200 CFM compatible 8" & 10" duct transition)
Inline blower kit	KIT0154387 (1200 CFM compatible 8" &10" duct transition)
Warranty	
Complete 2 years warranty	Entire Appliance; In-Home; Parts & Labour

LOT 5
WRV


The information contained herein is based on sources that we believe to be reliable, but is not guaranteed by us, may be incomplete or may change without notice

DS DS
[Signature]

Dimensions

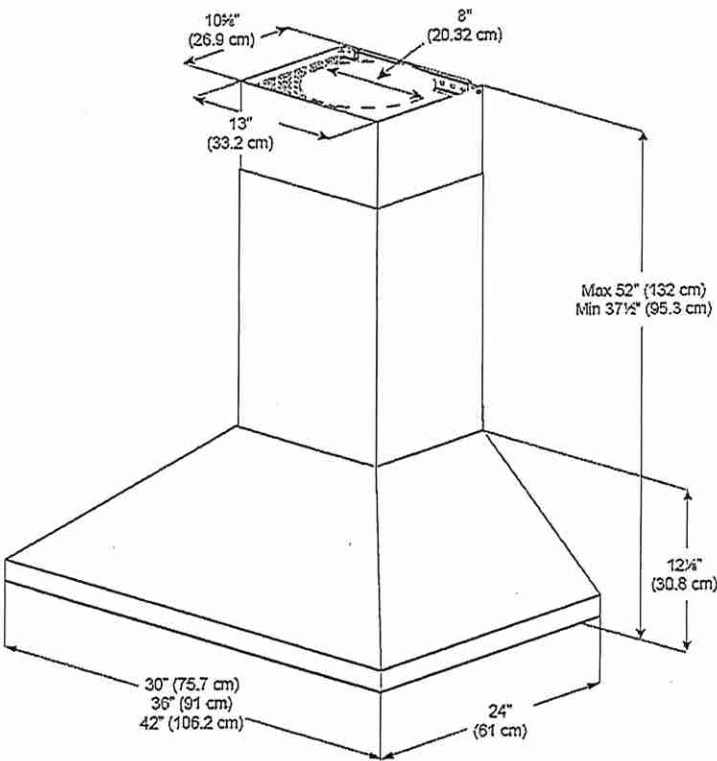


Installation

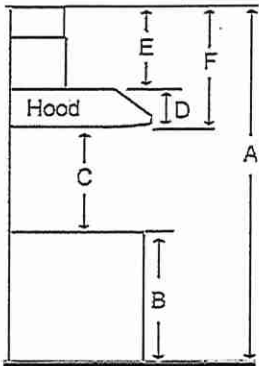

- | | | |
|---|---|--------------------|
| A | Floor to ceiling Height | TBD |
| B | Floor to counter Top Height (standard) | 36" |
| C | Recommended Height between cooking surface and bottom of the hood | 27" min. - 30" max |
| D | Hood Height | 12 1/8" |
| E | Chimney Height | 25 3/8" to 39 7/8" |

Duct transition

8" Round (Top)

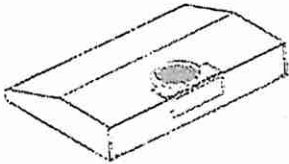

LOTS
WRV



The information contained herein is based on sources that we believe to be reliable, but is not guaranteed by us, may be incomplete or may change without notice

Need technical assistance ? 1(888) 651-2534

DS DS
JH T

Café™ 36" Built-In Gas Cooktop
CGP95363MS2 / CGP95362MS1

C A F É

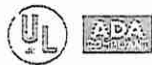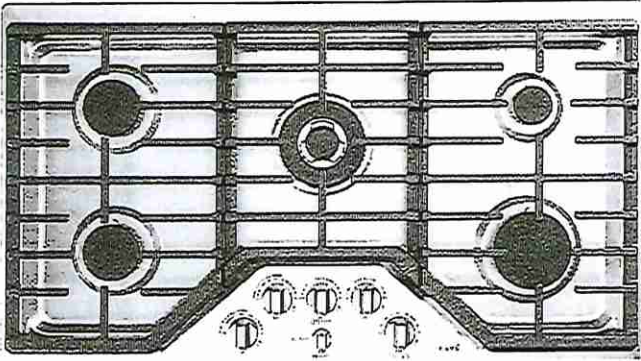

ALSO
AVAILABLE IN CGP95362MS1
Stainless Steel with
Brushed Stainless
knobs

FEATURES & BENEFITS

- Sear, fry and sautee on a 20,000 BTU triple ring burner
- Give your kitchen a little glimmer with white LED knob lighting.
- Get the most from your cooktop and eliminate the need for extra cookware with an extra-large, integrated cooktop griddle.
- When you're updating your kitchen, attention to detail is a priority. That's why Café cooktops are guaranteed for an exact fit for an easy and seamless replacement.
- Always get your hollandaise just right with a simmer burner that provides low, even heat.
- Easily move heavy cookware across the surface without worry, thanks to continuous, cast-iron burners.
- Keep your kitchen sparkling, even when there's a spill with sealed cooktop burners that contain messes for easy cleanup.
- Prevent unintended burner activation with control lock capability.
- Enjoy the party without worrying about clean up, thanks to dishwasher-safe grates.

APPEARANCE

Control Knobs	Dishwasher Safe White LED Backlit
Cooktop Burner Grate Color	Matte Black

FEATURES

Cooktop Burner Type	5 Sealed
Cooktop Surface	Deep Stainless Steel
Ignition System	Electronic
Burner - Left Front	9,500 BTU
Burner - Left Rear	9,500 BTU
Burner - Right Front	15,000 BTU Power Boil
Burner - Right Rear	5,000 BTU
Burner - Center	20,000 BTU Tri-ring Power Boil
Control Type	Knob
Cooktop Control Features	Child Lock
Control Location	Front Center
Cooktop Burner Grate Features	Continuous Grates Dishwasher Safe Edge-to-Edge Grates
Cooktop Burner Grate Material	Heavy Cast
Fuel Type	Natural Gas (factory set)
Valves (Degree of Turn)	270

POWER/RATINGS

Burner BTU Ratings (000's/BTU) - LP Gas	(1) 18.0 (1) 15.0 (2) 9.5 (1) 5.0
Burner BTU Ratings (000's/BTU) - Natural Gas	(1) 20.0 (1) 15.0 (2) 9.5 (1) 5.0
Volts/Hertz/Amps	120V 60Hz 5A

WEIGHTS & DIMENSIONS

Approximate Shipping Weight	57 lb
Cabinet Width	36 in
Cutout Dimensions Width x Depth (in.)	33-7/8 x 19-1/8
Net Weight	51 lb
Overall Depth	21 in
Overall Height	5 1/2 in
Overall Width	36 in

ACCESSORIES

Stainless Steel Cleaner	Included
Griddle	JXGRIDL236 (Included) Cast Iron Included
LP Conversion Kit	Included

LOT 5
WPRV

DS DS
[Signature]

Café™ 36" Built-In Gas Cooktop
CGP95363MS2 / CGP95362MS1

C A F E

WARRANTY

Parts warranty	Limited 1-year entire appliance
Labor warranty	Limited 1-year entire appliance
Warranty notes	See written warranty for full details

DIMENSIONS AND INSTALLATION

AGA Requirement: All gas cooktop models require 7/16" free area below cooktop height to combustible material. Requires 18" minimum from countertop to adjacent overhead cabinets.


Note: If installing with a GE Profile™ Telescopic Downdraft System, consult both cooktop and downdraft installation instructions packed with product before installing. Cooktop gas/electric supply may need to be re-routed to install downdraft.

Electrical Rating: 120V, 60Hz, 5A




Installation With Single Wall Oven Information: 30" Gas Cooktops are approved for use over select GE 27" and 30" Wall Ovens and Warming Drawers. 30" and 36" Gas cooktops are approved for use over select 30" Wall Ovens and Warming Drawers. Refer to cooktop and wall oven/warming drawer installation instructions packed with product for current dimensional data.

Installation Information: Before installing, consult installation instructions, packed with product, for current dimensional data.

Installation above a wall oven

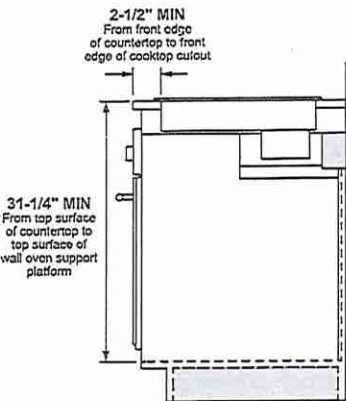

Dimension and installation information are shown in inches.
*Allow 5-3/4" depth at rear for electrical and gas connections

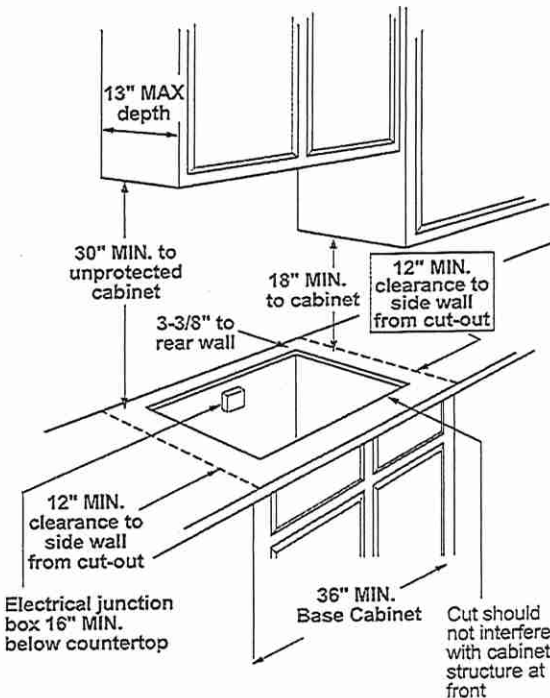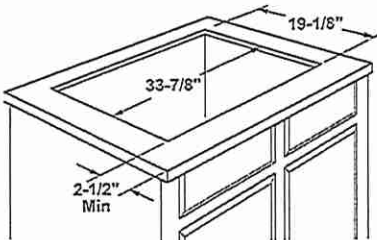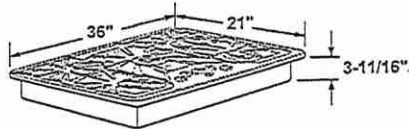

ADDITIONAL ACCESSORIES



CXCG1K0PMBZ
Brushed Bronze
Knobs



CXCG1K0PMSS
Brushed Stainless
Knobs



CXCG1K0PMBT
Brushed Black
Knobs



CXCG1K0PMCU
Brushed Copper
Knobs

LOT 5
WRV

For answers to your Café™ product questions, visit our website at cafeappliances.com.


© 2012 GE Appliances PC9023S 05/12

DS DS
T

Café™ Stainless Interior Built-In Dishwasher
with Hidden Controls

CAFE

CDT845P4NW2 / CDT845P3ND1 / CDT845P2NS1

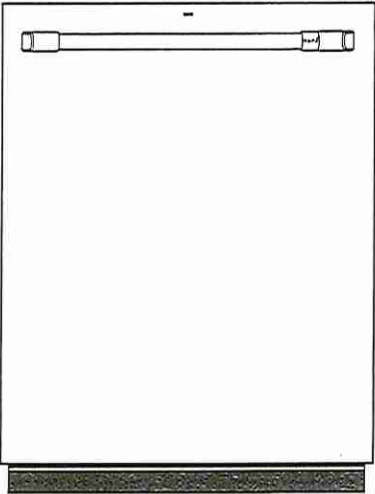

ALSO
AVAILABLE IN



CDT845P3ND1
Matte Black with
Brushed Stainless
handle

CDT845P4NW2
Matte White with Brushed
Bronze handle



CDT845P2NS1
Stainless Steel with
Brushed Stainless
handle

FEATURES & BENEFITS

Ultra-Wash & Dry – Unload sparkling clean, table-ready dishes thanks to our 100+ cleaning jets and an Ultra-Dry system that deliver excellent results

Loading Flexibility – Load the dishes your way. Our lower wash arm provides excellent coverage for the largest of loads. The fold down tines accommodate wide or oddly shaped items and our third rack provides extra space for your silverware and kitchen utensils

Adjustable Upper Racks – You'll have room for your finest stemware and space for tall bakeware with a rack that can be moved two inches up or down, creating ultimate loading flexibility

Wash Zones – Save time and use less water when you don't have a full dish load with a fully customizable cycle that lets you wash a true half load in the upper or lower rack

Create a look that matches your personal style – Select any combination of premium finishes and hardware options to create a stunning look customized to any owner's taste

APPEARANCE

Door Style	Long Door with Top Controls
Installation	Side Installation or Top Installation Included; Built-Up Floor Capable; Flush Cabinet Installation
Door Appearance	Full-length flat door

FEATURES

Style	Built-In
Tub and Door Liner	Stainless Steel
Tub Type	Tall Tub
Control Type	Cap Touch Controls; 12 Touchpads
Dishwasher Control Features	Cycle Countdown with Bi-Color LED Status Light on door; 1 "Clean" Light; 1 "Sanitized" Light; 1 "Low Rinse Aid" Light; Last Cycle Memory; Audible End-of-Cycle Signal
Wash System	3-Level; 900 Series
Wash System Features	Dual Pumps and Motors; Automatic Temperature Control; Drain Pump; Hard Food Disposer with removable filter; Reversing Quad Blade Lower Wash Arm; Quad Blade Middle Wash Arm; 100+ Spray Jet Wash System; Deep Clean Silverware Jets; Automatic HotStart; Bottle Jets (4)
Sensor	Clean Sensor
Wash Arms	3 Wash Levels; Lower- Reversing Quad Blade; Middle - Quad Blade; Bottle Jets; Deep Clean Silverware Jets
Water Filtration System	100% Filtration with Hard Food Disposer and Removable Filter
Dispenser	Rinse Aid with Indicator and Adjustment
Number of Cycles	5
Dishwasher Cycles	Auto; Pots; Normal; China; Express
Number of Options	10
Dishwasher Options	Delay Start 1-12 Hr.; Lock Controls; Ultra Dry; Normal Dry; Heated Dry Off; Presoak + Sanitize (NSF Certified); Hi-Temp Wash; Wash Zone Upper Only; Wash Zone Lower Only; Start/Reset; Bottle Jets
Rack Features	Ball-Tipped Tines; Adjustable Upper Rack; 3-Piece Silverware Basket with Cell Covers; Full Extension Slides - Upper; 2 short articulating plastic utility shelves w/Stemsafe and chop-stick slots
Racking Material	Nylon
Racking System	Full 3rd rack
Rack Color	Black Pearl
Number of Place Settings	Up to 16
Upper Rack	Premium Height Adjustable; Ball-Tip Tines; 1/2 fixed tines, 1/2 fold down tines; Fixed tines with Bottle Jets; 1 Rack handle; 2 Stern Safe Shelves; Chop stick slots
Lower Rack	Ball-Tip Tines; 1/2 fixed tines, 1/2 fold down tines
Dishwasher Drying Features	Multi-Wettage Wash & Dry Element; Heated Dry - Ultra/On/Off; Fan Assist Dry
Leveling System	4 Leveling Legs
Latch	Pull with Handle
WiFi Connect	Optional (Requires part no. PBX10W00Y0)
Exterior Style	Traditional


ECONOMICAL/QUIET

Quiet Package	45 dBA
Quiet Features	Quiet Water Valve; Sealed Toe Kick; Tub Collar Trim
Motor Type	Single Speed
Outer Wrap	Full-wrap Blanket; Bitumen
Door Insulation	Insulation; Mastic

WEIGHTS & DIMENSIONS

Cabinet Width	24 in
Approximate Shipping Weight	118 lb
Net Weight	105 lb
Overall Height	34 in
Height w/ Legs Retracted - Minimum Height	33-3/8 in
Height w/Legs Extended - Maximum Height	34-5/8 in
Overall Depth	24 in
Overall Width	23-3/4 in

LOTS WRV

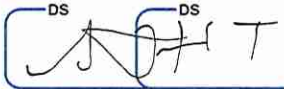

Café™ Stainless Interior Built-In Dishwasher
with Hidden Controls

CDT845P4NW2 / CDT845P3ND1 / CDT845P2NS1

C A F É


TECHNICAL DETAILS

Calrod Heater Watts	800/500
Power Connection	Optional cord kit (GPFCD - WX09X70910. WX09X70911)
Volts/Hz/Amps	120v; 60Hz; 7.2A


WARRANTY

Parts warranty	Limited 1-year entire appliance
Labor warranty	Limited 1-year entire appliance
Warranty notes	See written warranty for full details

DIMENSIONS

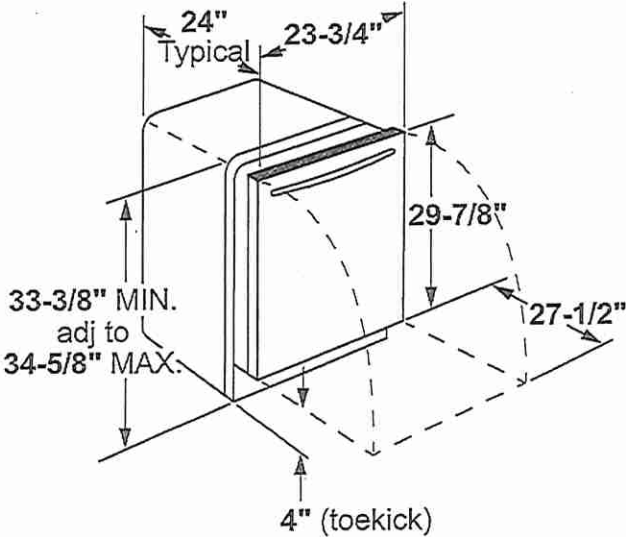

INSTALLATION DIMENSIONS

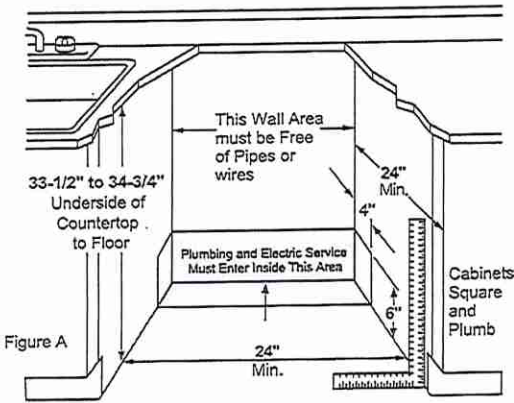

ADDITIONAL ACCESSORIES



Brushed Bronze
CXADTH1PMBZ
(Standard on Matte White)



Brushed Stainless
CXADTH1PMSS
(Standard on Matte Black)



Brushed Black
CXADTH1PMBT




Brushed Copper
CXADTH1PMCJ

LOT 5
WRV

For answers to your Café™ product questions, visit our website at cafeappliances.com.


© 2019 GE Appliances 01/19

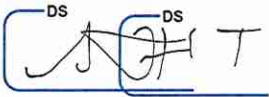

Café™ Stainless Interior Built-In Dishwasher
with Hidden Controls

C A F E

CDT845P4NW2 / CDT845P3ND1 / CDT845P2NS1

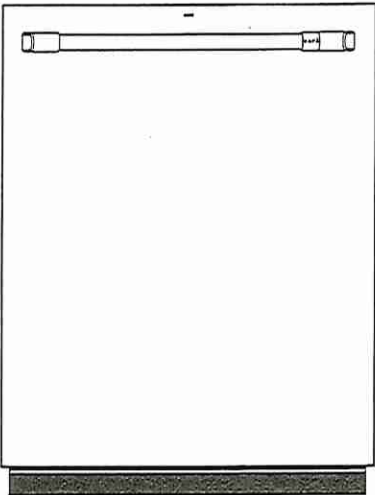

CDT845P4NW2
Matte White with Brushed
Bronze handle



ALSO
AVAILABLE IN



CDT845P3ND1
Matte Black with
Brushed Stainless
handle

CDT845P2NS1
Stainless Steel with
Brushed Stainless
handle

FEATURES & BENEFITS

Ultra-Wash & Dry – Unload sparkling clean, table-ready dishes thanks to our 100+ cleaning jets and an Ultra-Dry system that deliver excellent results

Loading Flexibility – Load the dishes your way. Our lower wash arm provides excellent coverage for the largest of loads. The fold down tines accommodate wide or oddly shaped items and our third rack provides extra space for your silverware and kitchen utensils

Adjustable Upper Racks – You'll have room for your finest stemware and space for tall bakeware with a rack that can be moved two inches up or down, creating ultimate loading flexibility

Wash Zones – Save time and use less water when you don't have a full dish load with a fully customizable cycle that lets you wash a true half load in the upper or lower rack

Create a look that matches your personal style – Select any combination of premium finishes and hardware options to create a stunning look customized to any owner's taste

APPEARANCE

Door Style	Long Door with Top Controls
Installation	Side Installation or Top Installation Included; Built-Up Floor Capable; Flush Cabinet Installation
Door Appearance	Full-length flat door

FEATURES

Style	Built-In
Tub and Door Liner	Stainless Steel
Tub Type	Tall Tub
Control Type	Cap Touch Controls; 12 Touchpads
Dishwasher Control Features	Cycle Countdown with Bi-Color LED Status Light on door; 1 "Clean" Light; 1 "Sanitized" Light; 1 "Low Rinse Aid" Light; Last Cycle Memory; Audible End-of-Cycle Signal
Wash System	3-Level; 800 Series
Wash System Features	Dual Pumps and Motors; Automatic Temperature Control; Drain Pump; Hard Food Disposer with removable filter; Reversing Quad Blade Lower Wash Arm; Quad Blade Middle Wash Arm; 100+ Spray Jet Wash System; Deep Clean Silverware Jets; Automatic HotStart; Bottle Jets (4)
Sensor	Clean Sensor
Wash Arms	3 Wash Levels; Lower- Reversing Quad Blade; Middle - Quad Blade; Bottle Jets; Deep Clean Silverware Jets
Water Filtration System	100% Filtration with Hard Food Disposer and Removable Filter
Dispenser	Rinse Aid with Indicator and Adjustment
Number of Cycles	5
Dishwasher Cycles	Auto; Pots; Normal; China; Express
Number of Options	10
Dishwasher Options	Delay Start 1-12 Hr.; Lock Controls; Ultra Dry; Normal Dry; Heated Dry Off; Presoak + Sanitize (NSF Certified); Hi-Temp Wash; Wash Zone Upper Only; Wash Zone Lower Only; Start/Reset; Bottle Jets
Rack Features	Ball-Tipped Tines; Adjustable Upper Rack; 3-Piece Silverware Basket with Cell Covers; Full Extension Slides - Upper; 2 short articulating plastic utility shelves w/Stemsafe and chop-stick slots
Racking Material	Nylon
Racking System	Full 3rd rack
Rack Color	Black Pearl
Number of Place Settings	Up to 16
Upper Rack	Premium Height Adjustable; Ball-Tip Tines; 1/2 fixed tines, 1/2 fold down tines; Fixed tines with Bottle Jets; 1 Rack handle; 2 Stem Safe Shelves; Chop stick slots
Lower Rack	Ball-Tip Tines; 1/2 fixed tines, 1/2 fold down tines
Dishwasher Drying Features	Multi-Wettage Wash & Dry Element; Heated Dry - Ultra/On/Off; Fan Assist Dry
Leveling System	4 Leveling Legs
Latch	Pull with Handle
WiFi Connect	Optional (Requires part no. PBX10W00Y0)
Exterior Style	Traditional

ECONOMICAL/QUIET

Quiet Package	45 dBA
Quiet Features	Quiet Water Valve; Sealed Toe Kick; Tub Collar Trim
Motor Type	Single Speed
Outer Wrap	Full-wrap Blanket; Bitumen
Door Insulation	Insulation; Mastic

WEIGHTS & DIMENSIONS

Cabinet Width	24 in
Approximate Shipping Weight	118 lb
Net Weight	105 lb
Overall Height	34 in
Height w/ Legs Retracted - Minimum Height	33-3/8 in
Height w/Legs Extended - Maximum Height	34-5/8 in
Overall Depth	24 in
Overall Width	23-3/4 in

LOT 5
WRV

DS DS
T

Café™ Stainless Interior Built-In Dishwasher
with Hidden Controls



CDT845P4NW2 / CDT845P3ND1 / CDT845P2NS1


TECHNICAL DETAILS

Calrod Heater Watts	800/500
Power Connection	Optional cord kit (GPFCORD - WX09X70910, WX09X70911)
Volts/Hertz/Amps	120V; 60Hz; 7.2A


WARRANTY

Parts warranty	Limited 1-year entire appliance
Labor warranty	Limited 1-year entire appliance
Warranty notes	See written warranty for full details

DIMENSIONS

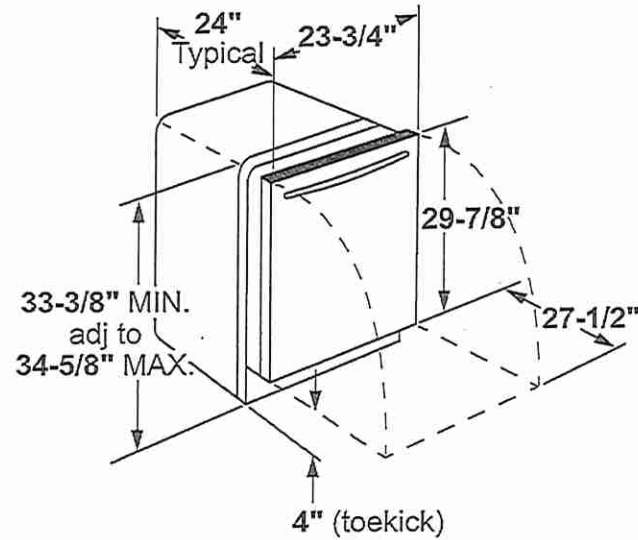

INSTALLATION DIMENSIONS

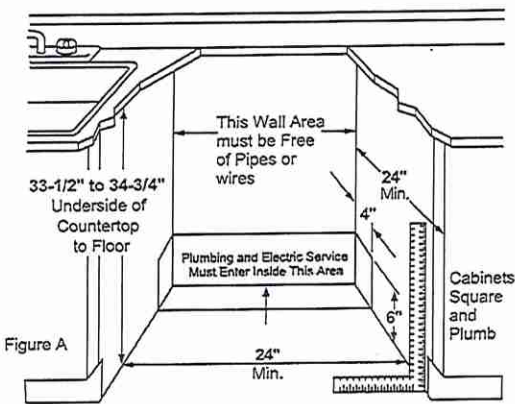

ADDITIONAL ACCESSORIES



Brushed Bronze
CXADTH1PMBZ
(Standard on Matte White)



Brushed Stainless
CXADTH1PMSS
(Standard on Matte Black)



Brushed Black
CXADTH1PMBT




Brushed Copper
CXADTH1PMCU

LOT 5
WAV

For answers to your Café™ product questions, visit our website at cafeappliances.com.

DS DS
T

Café™ 30" Combination Double Wall Oven
with Convection and Advantium® Technology
CTC912P2NS1

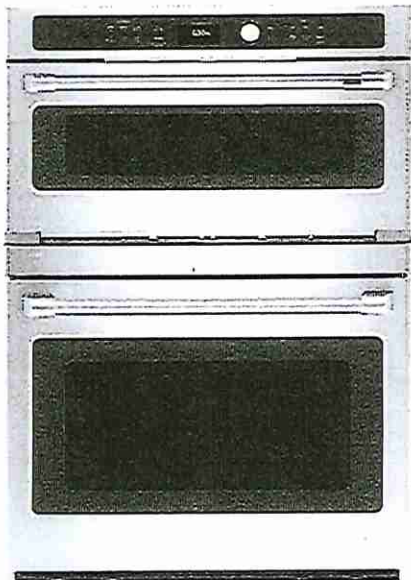

FEATURES & BENEFITS

Unmatched versatility to unleash your imagination - Enjoy a whole new level of cooking flexibility with a single oven that can be used in five different ways. Use it as a Convection Oven, Microwave, Toaster Oven, Warming/Proofing Oven, and Precision Cook Oven with Advantium Technology (upper oven).

The perfect marriage of quality and speed - Eliminate the need for preheating and cook your favorite foods two- to four-times faster than a conventional oven (upper oven)

The perfect bake is now perfectly easy - Achieve unrivaled performance with the only system that delivers top-down true convection for consistent results on special occasion favorites like roasts, chicken, turkey and more (lower oven)

The oven rack that handles it all - Easily remove heavy dishes with a roller rack that is specially designed to glide smoothly and stay in the oven during the self-clean cycle, so you never have to handle cumbersome racks again (lower oven)

The perfect fit you've always dreamed of - When you're updating your kitchen, attention to detail is a priority. That's why Café wall ovens are guaranteed for an exact fit or Café Appliances will pay up to \$300 toward modifications.

APPEARANCE

Color Appearance	Stainless Steel
Handle	Brushed Stainless
Handle Design	Café Pro
Installation	Above Warming Drawer

FEATURES	
Configuration	Double Oven
	Convection Bake (Upper)
	Microwave (Upper)
	Proof (Upper)
	Speedcook (Upper)
	Warm (Upper)
Advantium Cooking Modes	
Cooking System	True European Convection (Lower)
Oven Cleaning Type	Self-Clean with Steam Clean Option (Lower)
Style	Built-In
Cleaning Time	Variable with Delay Clean Option (Lower)
Program Cooking	Over 175 Programmed Menu Selections
	Convection Bake (Lower)
	Convection Bake Multi/Single Rack (Lower)
	Convection Broil (Lower)
	Convection Roast (Lower)
Oven Cooking Modes	
Self-Clean Oven Door Lock	Automatic (Lower)
Baking/Speed Cook Pan	Porcelain (Upper)
Control Type	Dial
	Glass Touch
Oven Features	10-Pass Bake Element
	8-Pass Broil Element
Oven Rack Features	1 Self-Clean Heavy-Duty Roller Rack
	2 Self-Clean Heavy-Duty Oven Racks
	6 Ladder-Rack Positions (Lower)
Product Type	Double Oven
	Microwave Oven Combination
	Audible Preheat Signal
	Auto Recipe Conversion
	Sabbath Mode
	Control Lock Capability
	C or F Programmable
	Defrost Mode
	Delay Clean Option
	Delay Start
	Electronic Clock & Kitchen Timer (Lower)
	Hi / Low Broil
	Proof Mode
	Temperature Probe
	Warm Mode
Oven Control Features	
	Cook
	Defrost
	Express
	Reheat
Microwave Sensor Cooking Controls	
Microwave Watts (IEC-705)	1000.0
Power Levels	10
Turntable Size	16.0
Cooking Technology	Advantium
Fuel Type	Electric
Oven Interior	1 Halogen Interior Oven Light (Upper)
	2 Halogen Interior Oven Lights (Lower)
	Hidden Bake

CAPACITY	
Capacity (Cu. Ft.)	17 Upper / 5.0 Lower

POWER / RATINGS	
Amp Rating at 208V	30
Amp Rating at 240V	30
Bake Wattage	2850W
Broiler Wattage	3400W
Convection Wattage	2400W
Electrical Input - 120V Amperage	15
Electrical Input - 120V Watts	1800
KW Rating at 208V	5.4
KW Rating at 240V	7.2

DS DS
[Signature]

LOTS
WRV

Café™ 30" Combination Double Wall Oven
with Convection and Advantium® Technology

CTC912P2NS1

WEIGHTS & DIMENSIONS

Approximate Shipping Weight	235
Net Weight	215
Overall Height	42 3/8
Overall Width	29 3/4
Overall Depth	26 3/4
Cabinet Width	30
Cutout Dimensions (w x h x d) (in.)	28-5/8 x 42-1/4 x 23-1/2
Oven Interior Dimensions (lower)	25 x 17-3/8 x 20-1/4
Oven Interior Dimensions (upper)	20-1/16 x 8-1/2 x 17

ACCESSORIES

Cookbook	Yes (Advantium)
----------	-----------------

WARRANTY

Parts warranty	Limited 1-year entire appliance
Labor warranty	Limited 1-year entire appliance
Warranty notes	See written warranty for full details

DIMENSIONS AND INSTALLATION INFORMATION

Note: Cabinets installed adjacent to wall ovens must have an adhesion spec of at least a 194°F temperature rating.

Installation Information: Before installing, consult installation instructions packed with product for current dimensional data.

Door handle protrudes 3" from door face. Cabinets and drawers on adjacent 45° and 90° walls should be placed to avoid interference with the handle.

Electric wall ovens are not approved for installation with a plug and receptacle. They must be hard wired in accordance with installation instructions.

Note: These ovens are not approved for stackable or side-by-side installations.

ATTENTION INSTALLER: All electric wall ovens must be hard-wired (direct-wired) into an approved junction box. A plug and receptacle is NOT permitted on these products.


NOTE: If the cabinet does not have a solid bottom, two broom or runners must be installed to support the weight of the oven. For single ovens, the runners and braces must support 200 lbs (91 kg). For double ovens, the runners and braces must support 375 lbs. (170 kg).

NOTE: If marks, blemishes or the cutout opening are visible above the installed oven, it may be necessary to add wood shims under the runners and front trim until the marks or opening are covered.

NOTE: If the cabinet does not have a front frame and the sides are less than 3/4" (1.9 cm) thick, shim both sides equally to establish the cutout width.

CT9800
PT9800
PT7800
JT3800

CABINET	30"
A—Overlap of oven at top of cutout	1"
B—Overlap of oven over side of edges of cutout	3/4"
C—Overlap of oven at bottom of cutout	1"
OVEN	
D—Install depth	23-1/2"
E—Overall height with trim	42-3/8"
F—Overall width	29-3/4"

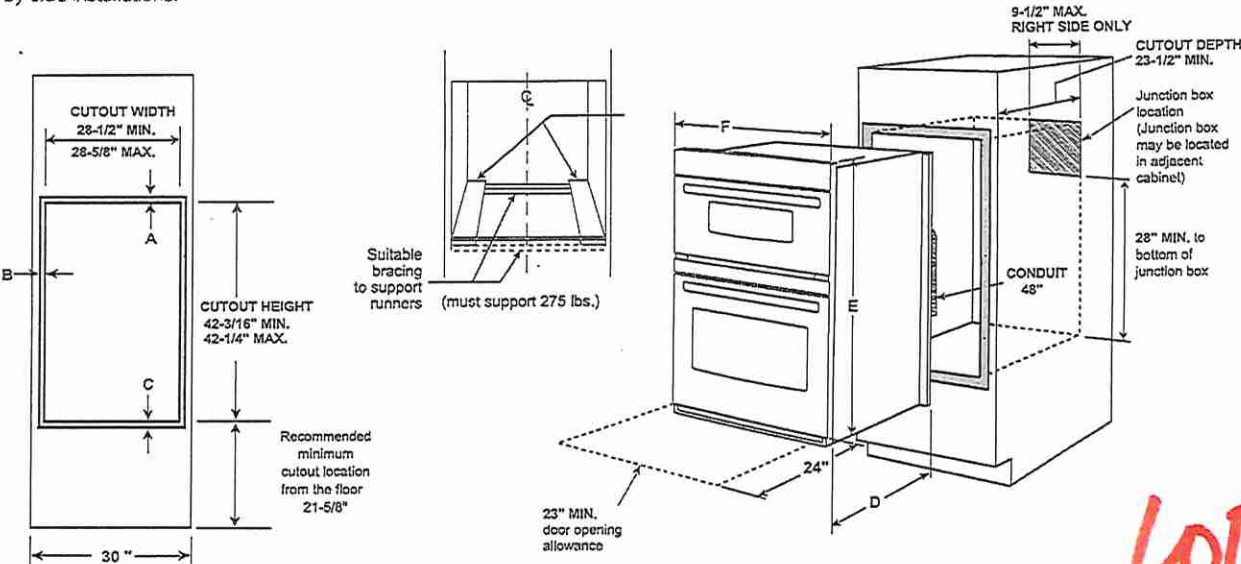

LOTS
WRV

ADDITIONAL ACCESSORIES



CXWD0H0PMBZ
Brushed Bronze
2 handles



CXWD0H0PMSS
Brushed Stainless
2 handles



CXWD0H0PMBT
Brushed Black
2 handles




CXWD0H0PMCUC
Brushed Copper
2 handles


For answers to your Café™ product questions, visit our website at cafeappliances.com.

© 2022 GE Appliances PC96509 01/22

DS
DS
T

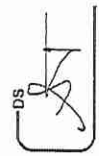


GREAT ROOM. WAFFLE CEILING. 45-04. TIC164

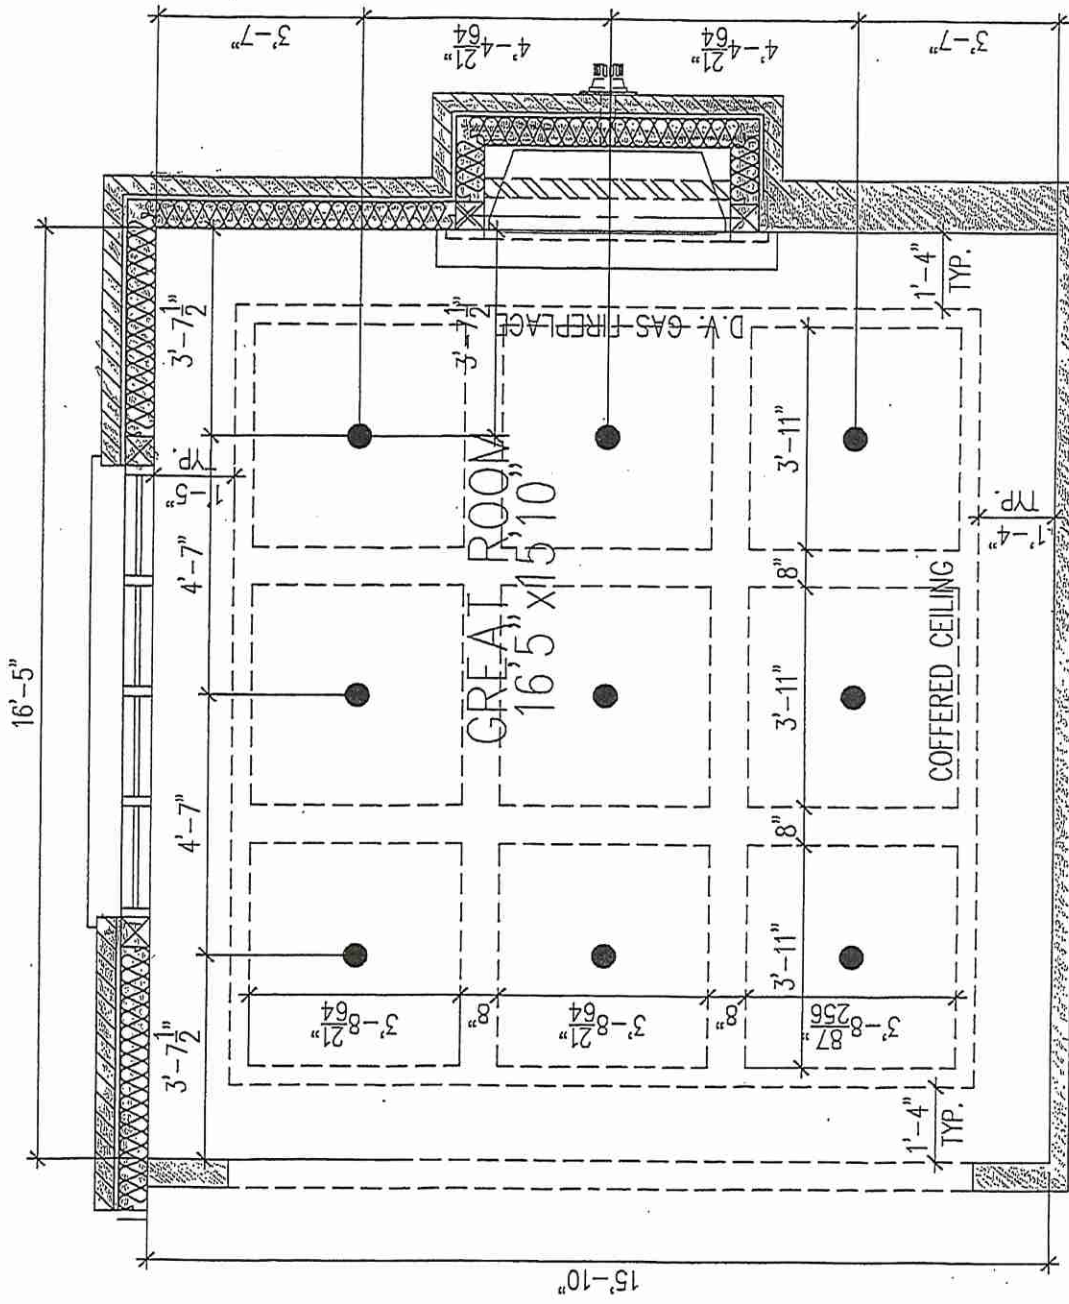

LOT 5

LOT# 5 - GREAT ROOM

LOT 5

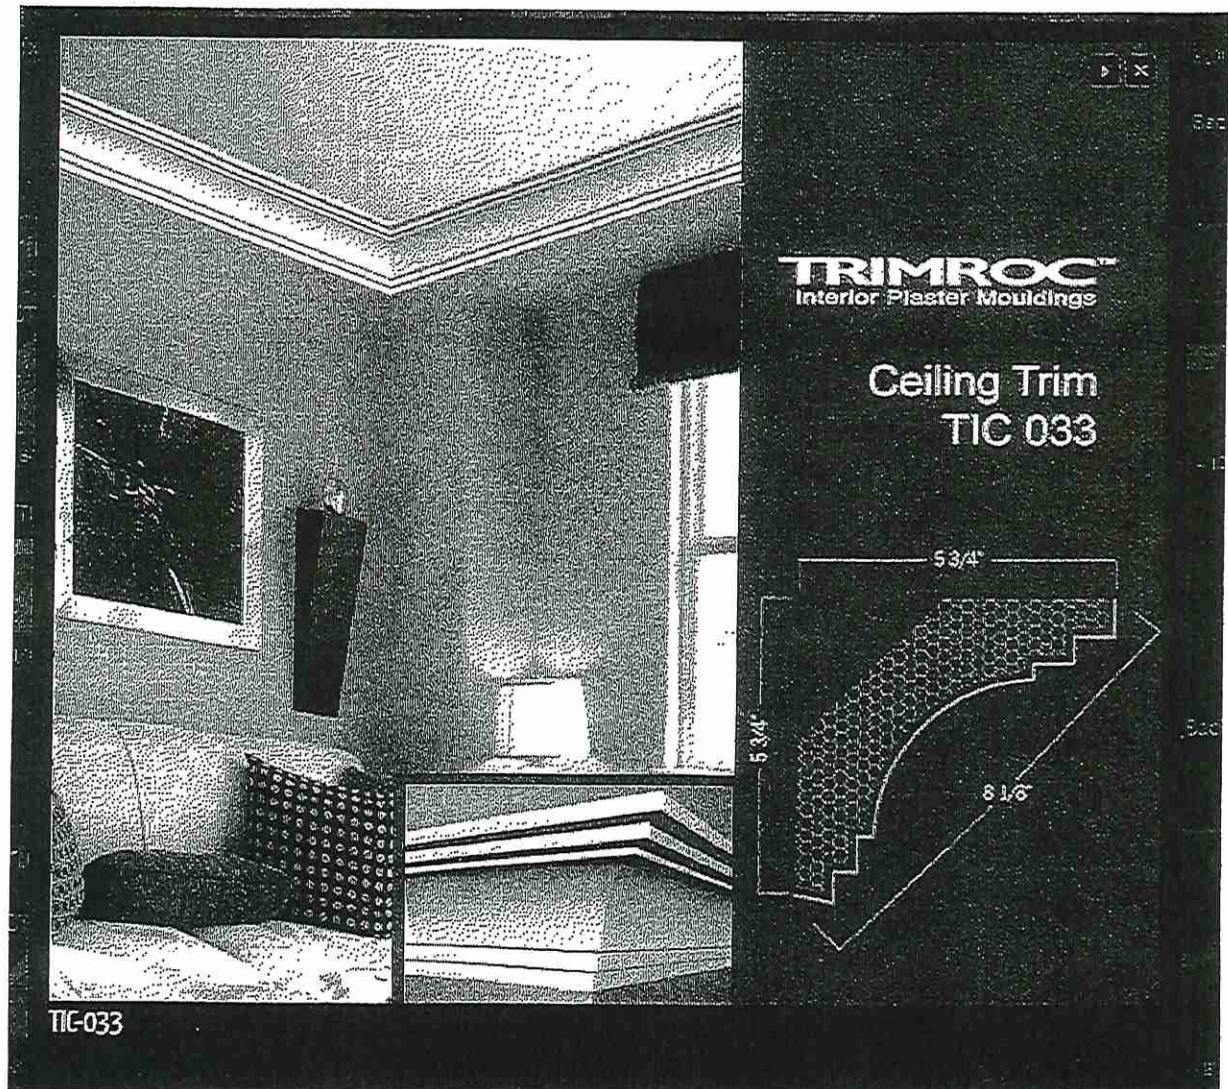

^{DS} [Signature] ^{DS} [Signature]

DEN ⊕ DINING Room ⊕ SIDE HALL ⊕ FRONT ENTRY ⊕
UPPER HALL / STAIRCASE ⊕ POWDER ROOM HALL

Lot 5. Great Room.





TIC-164

TRIMROC
INTERIOR PLASTER MOULDINGS

Ceiling Trim
TIC 164

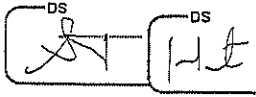

DS DS

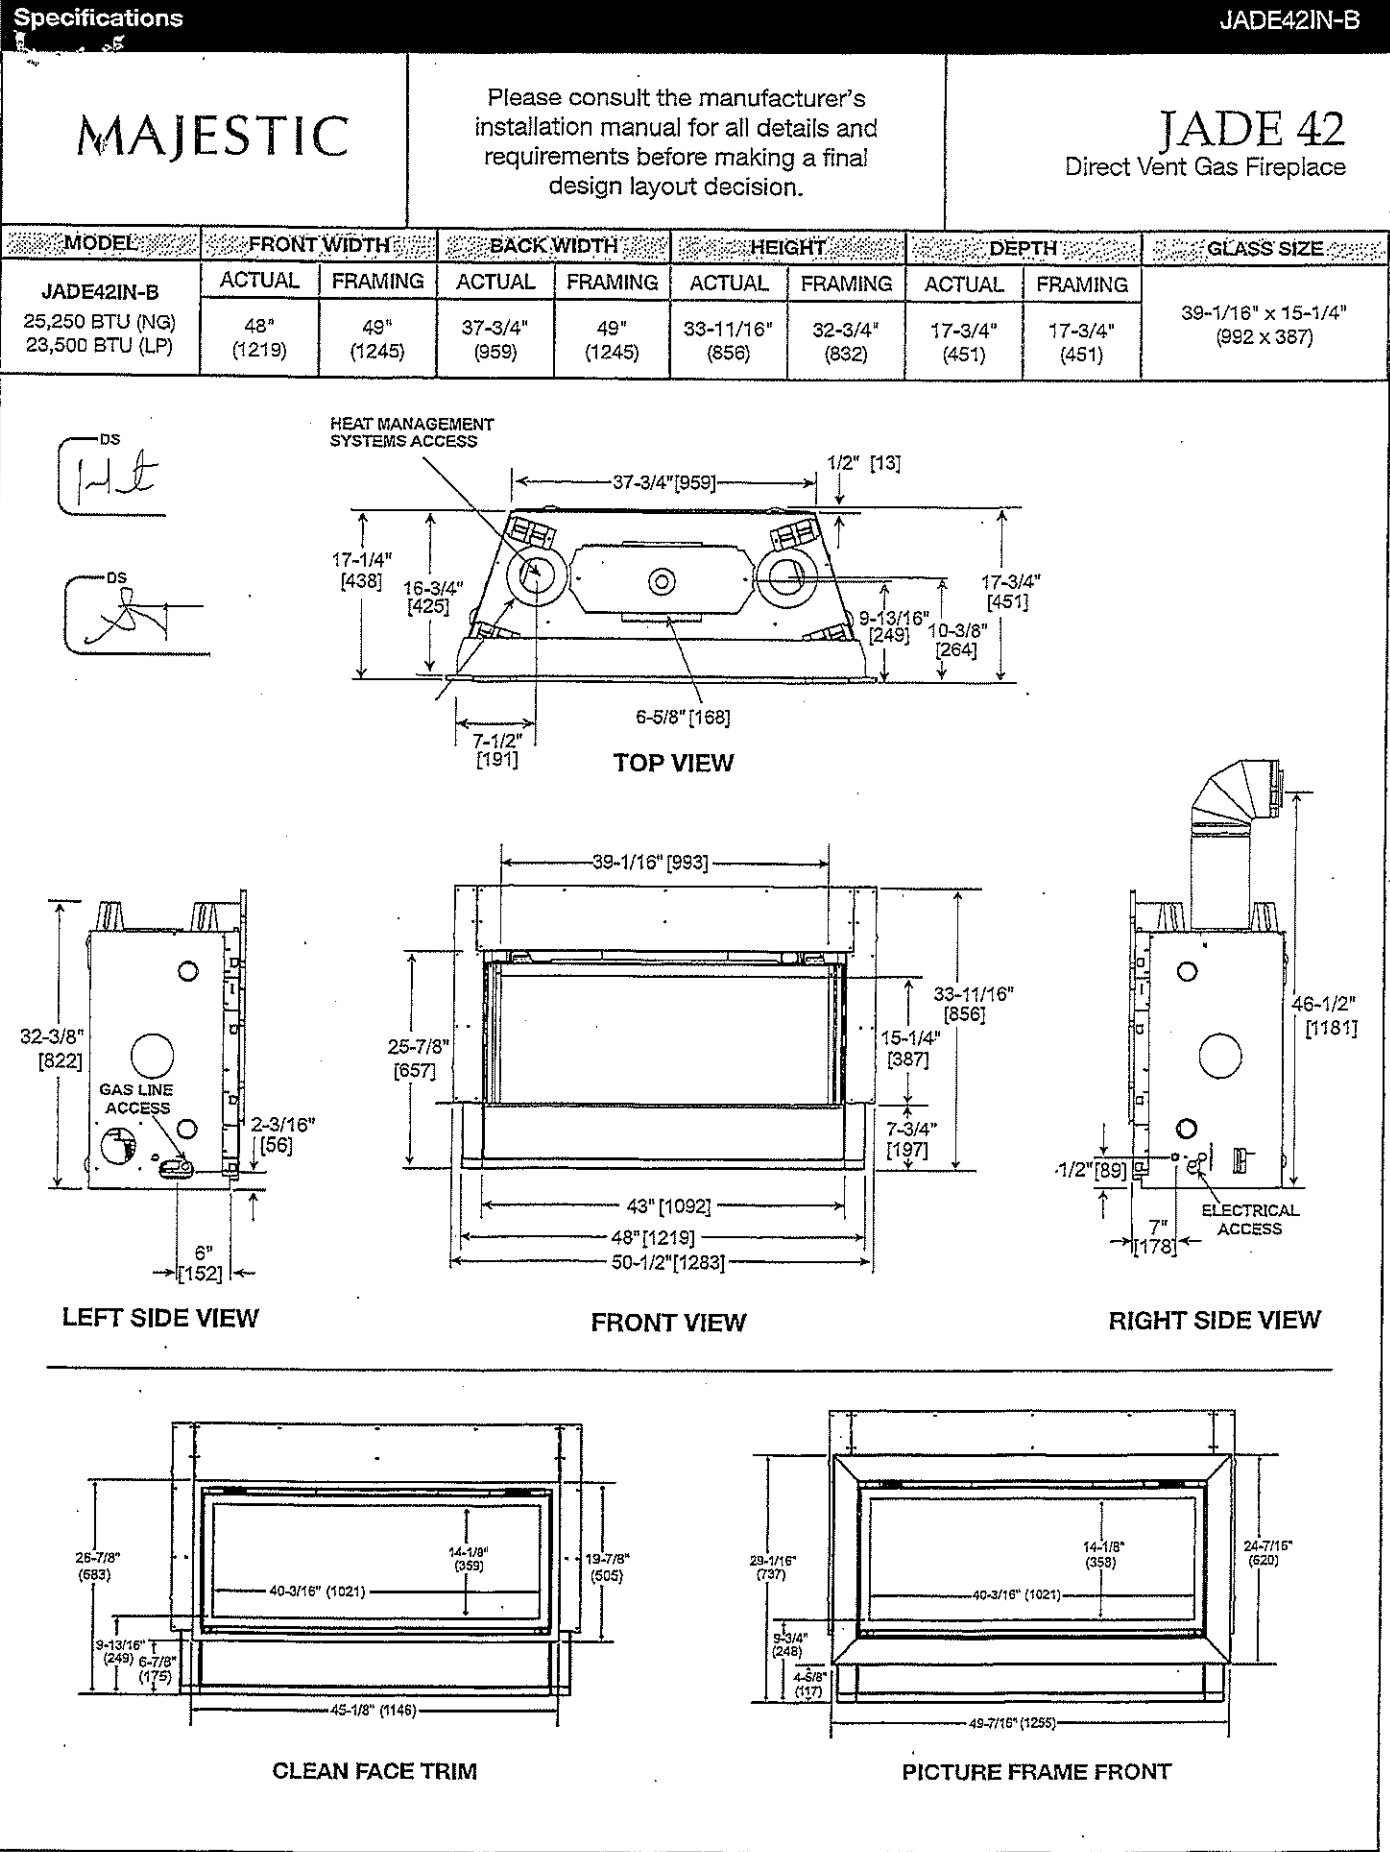
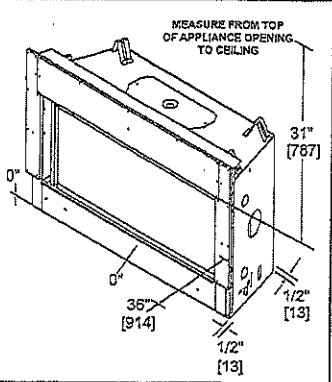


Specifications


JADE42IN-B

MINIMUM FIREPLACE CLEARANCES /
CLEARANCES TO COMBUSTIBLES


AREA	TO COMBUSTIBLES
CLEARANCE TO CEILING	31" [787]
NON-COMBUSTIBLE FLOOR	0" [0]
COMBUSTIBLE FLOORING	0" [0]
BEHIND APPLIANCE	1/2" [13]
SIDES OF APPLIANCE	1/2" [13]
FRONT OF APPLIANCE	36" [914]




APPLIANCE LOCATION

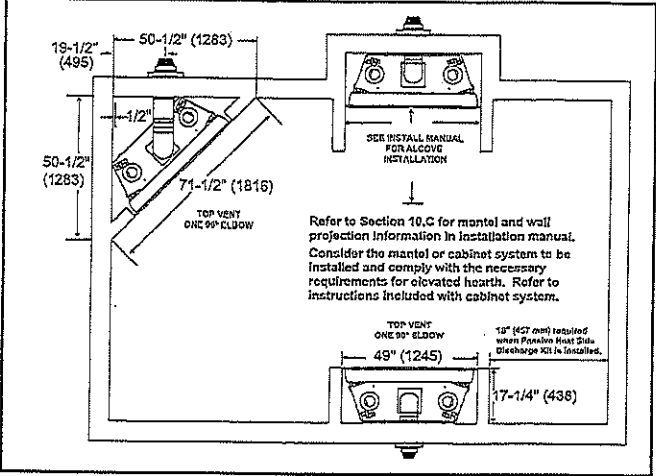


WALL PENETRATION

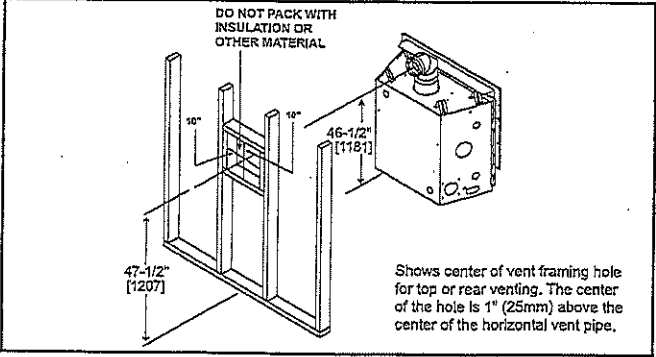


MANTEL LEG/WALL PROJECTIONS

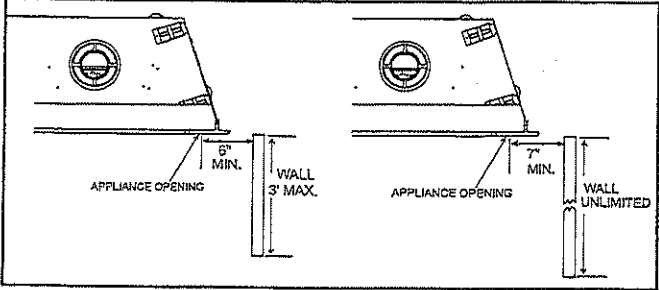


FRAMING DIMENSIONS

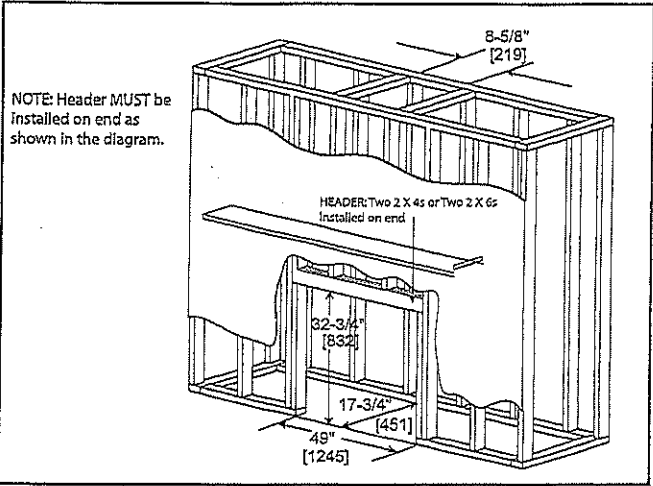

NON-COMBUSTIBLE MANTEL PROJECTIONS
(or other materials above appliance)

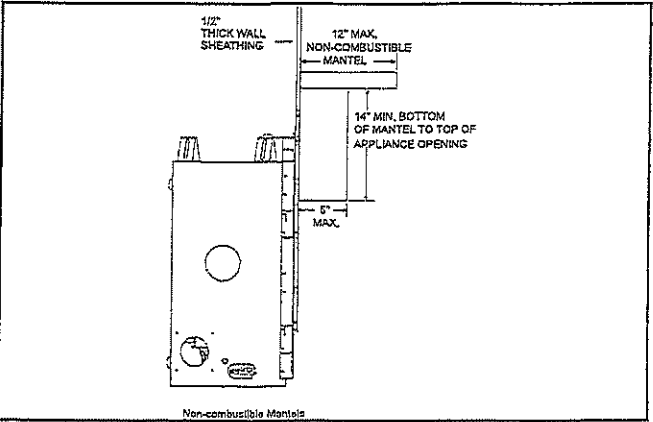

MANTEL PROJECTIONS
(or other materials above appliance)

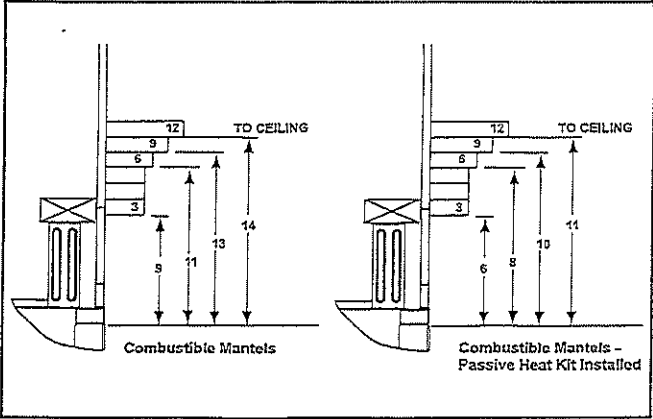

PRODUCT LISTING CODES	
US	ANSI Z21.88-2017
CAN	CSA 2.33-2017
UL LISTED	UL307B

Product information provided is not complete and is subject to change without notice. Product installation must adhere strictly to instructions accompanying product to avoid risk of fire and potential injury.

MAJESTIC

Majestic — A Brand of Hearth & Home Technologies
7571 215th Street West | Lakeville, MN 55044
877-486-9123 | majesticproducts.com

UL LISTED

MAJ-JADE42IN-B_0220

DS
[Signature]

LOT 5