



SITE INSTRUCTION

Forestside Estates
 Attmar & Palleschi Drive
 Brampton, Ontario
 Attn: **Vince Staffieri**

SI #24

PROJECT : Forestside
PROJECT # : 1331.15
DATE : Oct.12, 2022

Site instructions/memos and Addendums are issued only for the purpose of recording any clarification or interpretation of the contract documents or giving direction on problems resulting from field conditions. These memos are subject to the provisions of the contract documents and unless reviewed with and authorized by the Client, will not affect the contract. Should the Contractor require a change in the contract price or project schedule, he shall submit to the Client, prior to commencement of work outlined in this memo, an itemized proposal for approval.

Title: Revisions to plans as itemized.

	Reference:	Changes:
A301d1, A301d2	Ground Floor Plan	Updated column size from 500mm to 650mm on building 'D' ground floor only.
A304d1, A304d2	4 th Floor Plan	Move window to Line up with window from 3rd floor.
A404, A404d3	Building 'D' Elevations	Update window widths and line up window from 3rd floor.
CS301-OS, CS301a1	1 st Floor Plan	Updated column size from 500mm to 650mm on building 'D' ground floor only.

Reason: Revisions to window and columns for building D as per plan coordination.

GRAZIANI + CORAZZA
 ARCHITECTS INC

D. Biase C.E.T.
 Principal

**Distribution:**

Royal Pine Homes	Vince Staffieri Cinzia Caruzo	vince@royalpinehomes.com Cinzia@royalpinehomes.com
Jablonski Engineering	Kevin Deonaraine	kdeonaraine@astint.on.ca
United Engineering	Rene Cuales Leonard Matthews Susan Pan Mark Giorgi	rene@u-eng.ca Lenard@u-eng.ca susan@u-eng.ca mark@u-eng.ca
Candevcon Limited	Diarmund Hogan Dudister Damnaraigh	dhorgan@candevcon.com dude@candevcon.com
Starfire Sprinkler Systems	Elite Novosselova Peter Adrian	elitecanada@hotmail.com Peter@starfiresystems.biz
Strybos Barron King Ltd.	Bryn Barron Kaleigh Gills Sydney Martel	bbarron@strybos.com kgillis@strybos.com smartel@strybos.com
Graziani + Corazza Architects	Domenic Biase Gino Colangelo Fernando Croatto	dbiase@gc-architects.com gcolangelo@gc-architects.com FCroatto@gc-architects.com

THIS DRAWING IS AN INSTRUMENT OF SERVICE, IT IS PROVIDED BY AND IS THE PROPERTY OF GRAZIANI-CORAZZA ARCHITECTS INC. THE CONTRACTOR MUST VERIFY AND ACCEPT RESPONSIBILITY FOR ALL DIMENSIONS AND COORDINATIONS AND MUST NOTIFY GRAZIANI-CORAZZA ARCHITECTS INC. OF ANY DISCREPANCIES FROM THE SUPPLIED INFORMATION. GRAZIANI-CORAZZA ARCHITECTS INC. IS NOT RESPONSIBLE FOR THE ACCURACY OF SURVEY, STRUCTURAL, MECHANICAL, ELECTRICAL, AND OTHER ENGINEERING INFORMATION SHOWN ON THIS DRAWING. REFER TO THE APPROPRIATE ENGINEERING DRAWINGS BEFORE PROCEEDING WITH THE WORK. CONSTRUCTION MUST COMPLY TO ALL APPLICABLE CODES AND REQUIREMENTS OF THE AUTHORITIES HAVING JURISDICTION. UNLESS OTHERWISE NOTED, NO MODIFICATION HAS BEEN MADE/NOTED OR REPORTED ON BY THIS OFFICE IN REFERENCE TO THE ENVIRONMENTAL CONDITION OF THIS SITE.

THIS DRAWING IS NOT TO BE SCALED. ALL ARCHITECTURAL SYMBOLS INDICATED ON THIS DRAWING ARE GRAPHIC REPRESENTATIONS ONLY.


CONDITIONS FOR ELECTRONIC INFORMATION TRANSFER

ELECTRONIC INFORMATION IS SUPPLIED TO THE OTHER ASSOCIATED FIRMS TO ASSIST THEM IN THE EXECUTION OF THEIR WORK. REVIEW THE RECEIVED FIRMS MUST DETERMINE THE COMPLETENESS, APPROPRIATENESS, RELIANCE OF THE INFORMATION IN RESPECT TO THEIR PARTICULAR RESPONSIBILITY.

GRAZIANI-CORAZZA ARCHITECTS INC. SHALL NOT BE RESPONSIBLE FOR ERRORS, OMISSIONS, INCOMPLETENESS DUE TO LOSS OF INFORMATION IN WHOLE OR PART WHEN INFORMATION IS TRANSMITTED.

1. TRANSMISSION OF ANY LOSS OF DAMAGE TO THE RECEIVING ELECTRONIC SYSTEM WHEN INFORMATION IS TRANSMITTED.

REF-A301a2 FOR CONTINUATION

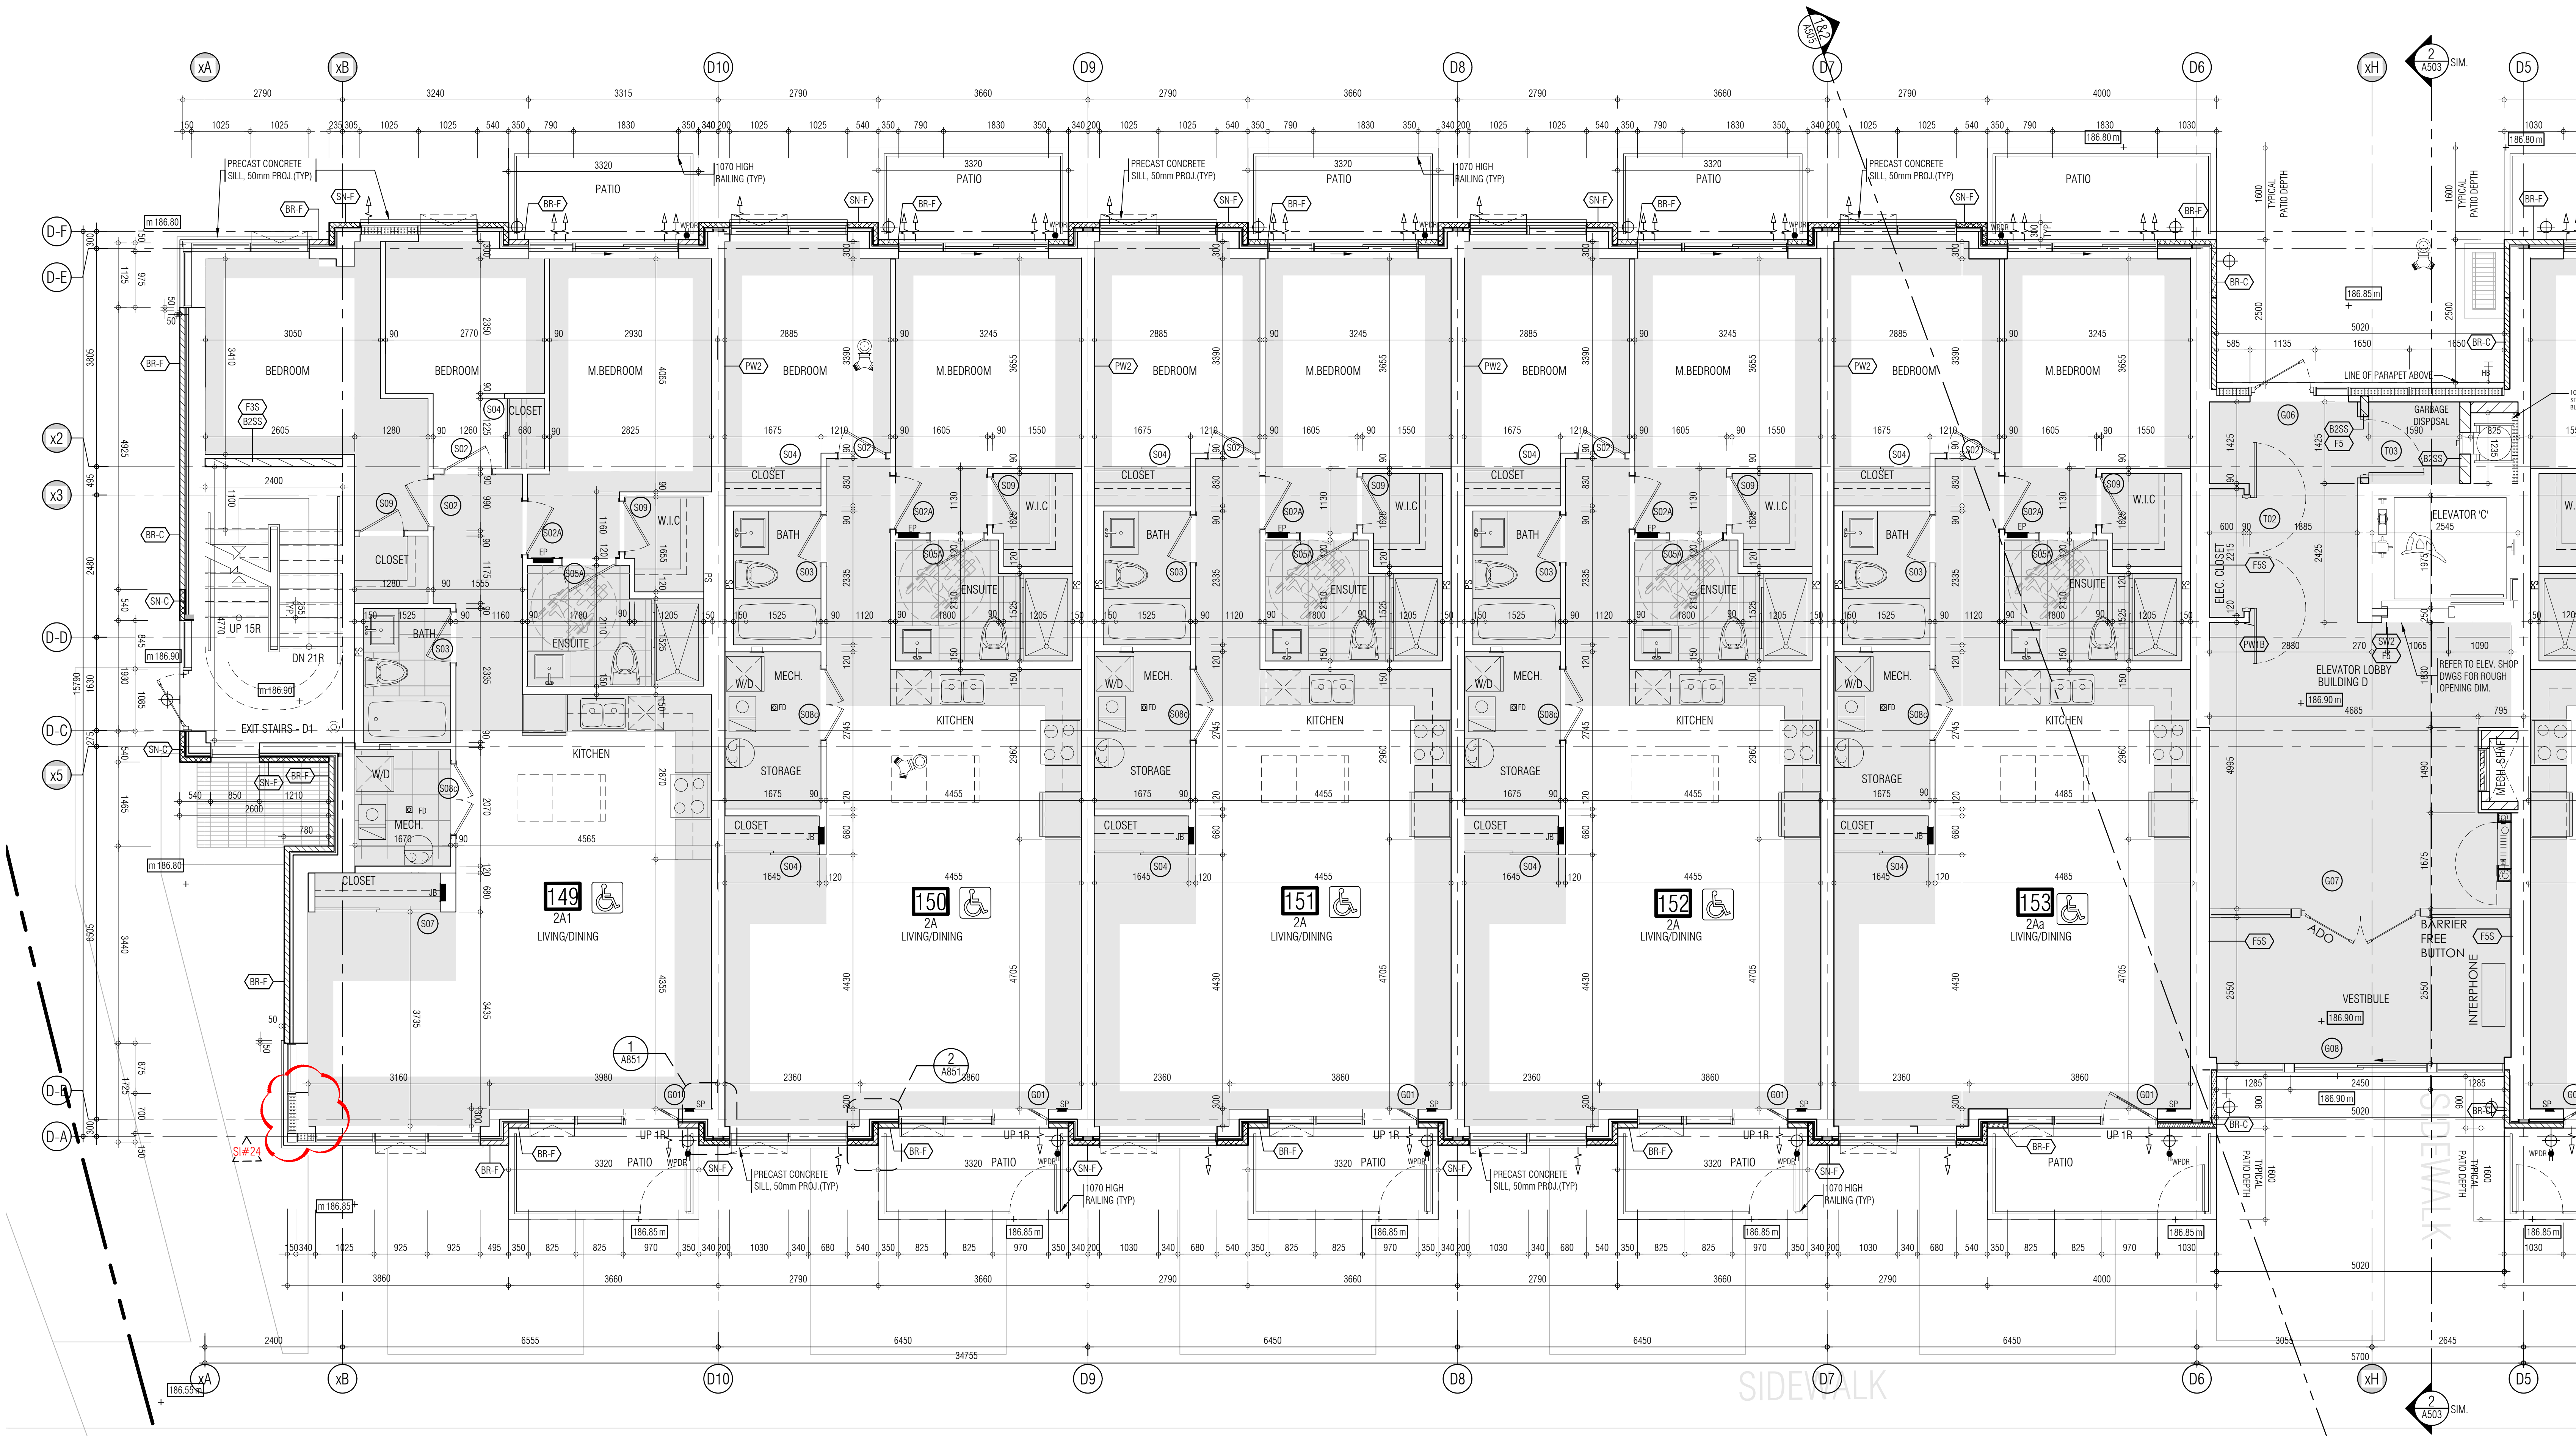

- 01. Oct.07.2019 issued for tender
- 02. Mar.13.2020 issued for design coordination #2
- 03. Mar.16.2020 issued for addendum #2
- 04. Mar.16.2020 issued for addendum #3
- 05. Aug.24.2020 issued for addendum #4
- 06. Sept.28.2020 issued for permit
- 07. Oct.20.2020 issued for addendum #5
- 08. Nov.23.2020 issued for addendum #6
- 09. Dec.14.2020 issued for addendum #7
- 10. Jan.15.2021 issued for addendum #8
- 11. Mar.2.2021 issued for permit
- 12. Mar.09.2021 issued for addendum #9
- 13. Mar.10.2021 issued for addendum #9R
- 14. Mar.26.2021 issued for progress
- 15. May.14.2021 issued for Site Instruction #1
- 16. June.15.2021 issued for Site Instruction #2
- 17. July.7.2021 re-issued for permit
- 18. July.15.2021 issued for Site Instruction #3
- 19. July.27.2021 issued for Site Instruction #4
- 20. Aug.3.2021 issued for Site Instruction #5
- 21. Aug.18.2021 issued for Site Instruction #6
- 22. Aug.20.2021 Re-issued for permit
- 23. Sept.07.2021 issued for Site Instruction #7
- 24. Sept.09.2021 issued for Site Instruction #8
- 25. Sept.16.2021 issued for Building D Permit Revisions
- 26. Sept.22.2021 issued for Site Instruction #9
- 27. Oct.6.2021 Re-issued for permit
- 28. Oct.8.2021 issued for Site Instruction #10
- 30. Oct.28.2021 issued for Site Instruction #11
- 31. Nov.05.2021 issued for Site Instruction #12
- 32. Dec.3.2021 issued for Site Instruction #13
- 33. Dec.6.2021 issued for Site Instruction #14
- 34. Dec.7.2021 issued for Site Instruction #15
- 35. Jan.26.2022 issued for Site Instruction #16
- 36. Jan.31.2022 issued for Site Instruction #17
- 37. Mar.11.2022 issued for Site Instruction #18
- 38. Apr.29.2022 issued for Site Instruction #19
- 39. May.10.2022 issued for Site Instruction #20
- 40. May.24.2022 issued for Site Instruction #21
- 41. Aug.05.2022 issued for I.F.C.
- 42. Aug.18.2022 issued for Site Instruction #22
- 43. Aug.23.2022 issued for Site Instruction #23
- 44. Oct.12.2022 issued for Site Instruction #24

01. SEP18/20219 issued for addendum 1

issued for revisions



1333 SANDHURST DRIVE, SUITE 100 MISSISSAUGA, ONTARIO L4W 1C3
905.709.7021 P.905.709.7080 WWW.GC-ARCHITECTS.COM




ATTMAY + PALLESCHI DRIVE

PROJECT ARCHITECT: B.GRAZIANI
ASSISTANT DESIGNER: R.LINCOLN
DRAWN BY: G.C./F.C./M.B.
CHECKED BY: D.BIASI/G.COLANGELO
PLOT DATE: OCT.11.2022
JOB #: 1331.15

GROUND FLOOR PLAN
BUILDING D (PARTIAL PLAN)

1:50 A-301d1

TITLEBLOCK SIZE: 915 x 1200

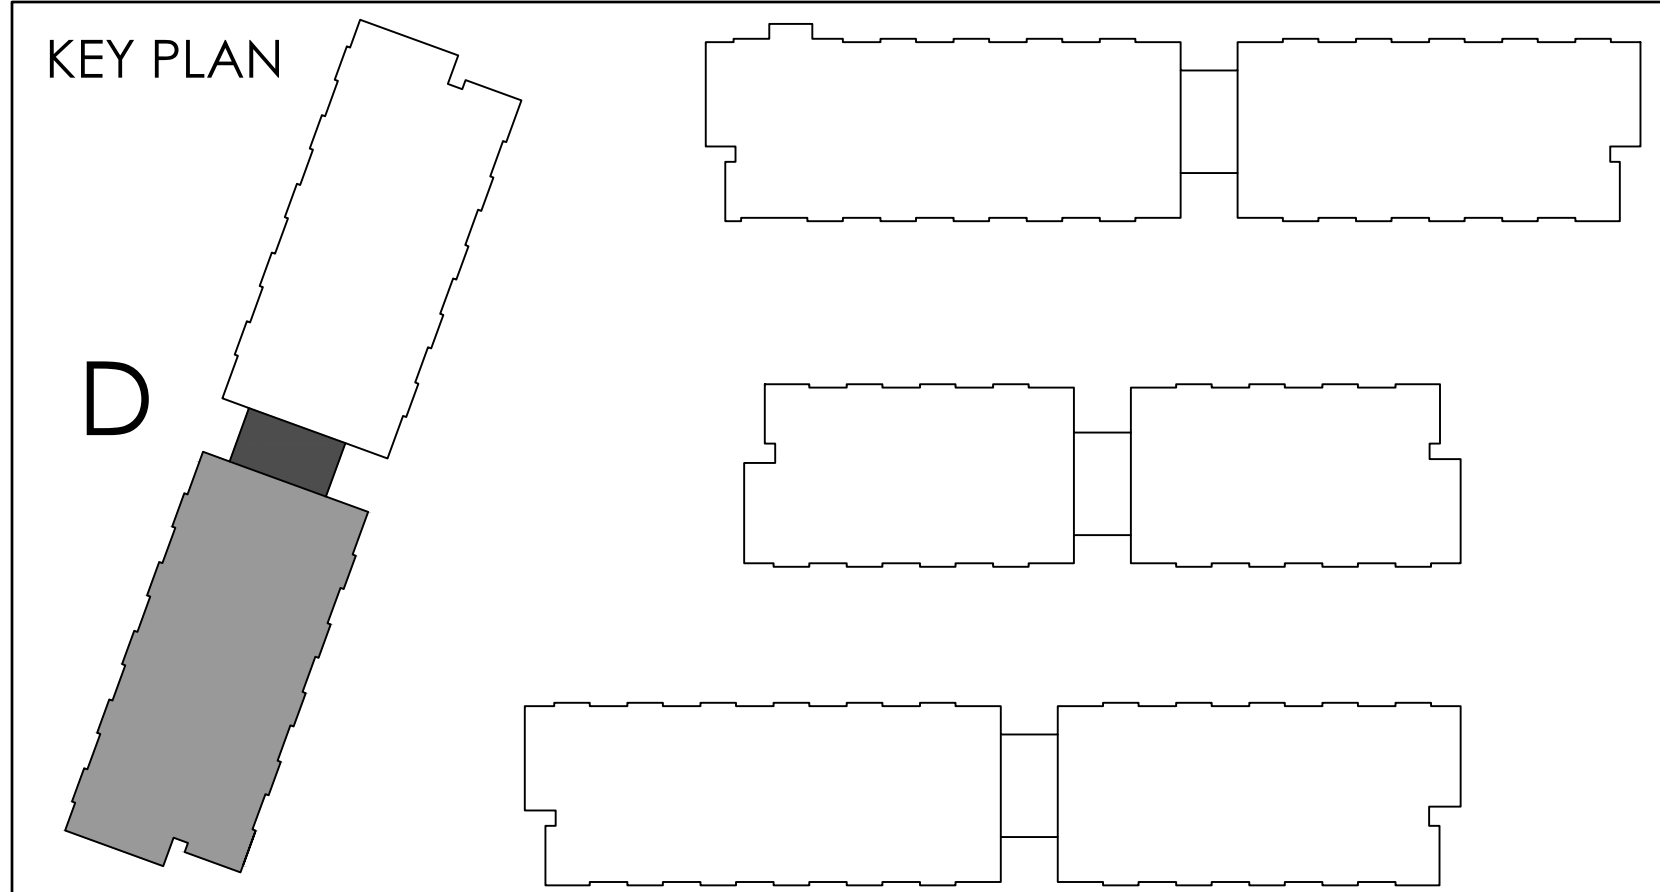

THIS DRAWING IS AN INSTRUMENT OF SERVICE. IT IS PROVIDED BY AND IS THE PROPERTY OF GRAZIANI-CORAZZA ARCHITECTS INC. THE CONTRACTOR MUST VERIFY AND ACCEPT RESPONSIBILITY FOR ALL DIMENSIONS AND COORDINATE THE SITE AND MUST NOTIFY GRAZIANI-CORAZZA ARCHITECTS INC. OF ANY VARIATIONS FROM THE SUPPLIED INFORMATION. GRAZIANI-CORAZZA ARCHITECTS INC. IS NOT RESPONSIBLE FOR THE ACCURACY OF SURVEY, STRUCTURAL, MECHANICAL, ELECTRICAL, AND OTHER ENGINEERING INFORMATION SHOWN ON THIS DRAWING. REFER TO THE APPROPRIATE ENGINEERING DRAWINGS BEFORE PROCEEDING WITH THE WORK. CONSTRUCTION MUST COMPLY TO ALL APPLICABLE CODES AND REQUIREMENTS OF THE AUTHORITIES HAVING JURISDICTION. UNLESS OTHERWISE NOTED, NO MODIFICATION HAS BEEN MADE/MADE AS REPORTED IN BY THIS OFFICE IN REGARDS TO THE ENVIRONMENTAL CONDITION OF THIS SITE.

THIS DRAWING IS NOT TO BE SCALED. ALL ARCHITECTURAL SYMBOLS INDICATED ON THIS DRAWING ARE GRAPHIC REPRESENTATIONS ONLY.

CONDITIONS FOR ELECTRONIC INFORMATION TRANSFER

ELECTRONIC INFORMATION IS SUPPLIED TO THE OTHER ASSOCIATED FIRMS TO ASSIST THEM IN THE EXECUTION OF THEIR WORK. REVIEW THE RECEIPT FROM MUST DETERMINE THE COMPLETENESS, APPROPRIATENESS, RELIANCE OF THE INFORMATION IN RESPECT TO THEIR PARTICULAR RESPONSIBILITY.

GRAZIANI-CORAZZA ARCHITECTS INC. SHALL NOT BE RESPONSIBLE FOR ERROR, OMISSIONS, INCOMPLETENESS DUE TO LOSS OF INFORMATION IN WHICH OR PART WHEN INFORMATION IS TRANSMITTED.

1. TRANSMISSION OF ANY LOSS OF DAMAGE TO THE RECEIVING ELECTRONIC SYSTEM WHEN INFORMATION IS TRANSMITTED.

- 01. Oct.07.2019 issued for tender
- 02. Mar.13.2020 issued for design coordination #2
- 03. Mar.16.2020 issued for addendum #2
- 04. Mar.16.2020 issued for addendum #3
- 05. Aug.24.2020 issued for addendum #4
- 06. Sept.28.2020 issued for permit
- 07. Oct.20.2020 issued for addendum #5
- 08. Nov.23.2020 issued for addendum #6
- 09. Dec.14.2020 issued for addendum #7
- 10. Jan.15.2021 issued for addendum #8
- 11. Mar.2.2021 issued for permit
- 12. Mar.09.2021 issued for addendum #9
- 13. Mar.10.2021 issued for addendum #9R
- 14. Mar.26.2021 issued for progress
- 15. May.14.2021 issued for Site Instruction #1
- 16. June.15.2021 issued for Site Instruction #2
- 17. July.7.2021 re-issued for permit
- 18. July.27.2021 issued for Site Instruction #3
- 19. July.27.2021 issued for Site Instruction #4
- 20. Aug.3.2021 issued for Site Instruction #5
- 21. Aug.18.2021 issued for Site Instruction #6
- 22. Aug.20.2021 Re-issued for permit
- 23. Sept.07.2021 issued for Site Instruction #7
- 24. Sept.09.2021 issued for Site Instruction #8
- 25. Sept.16.2021 issued for Building D Permit Revisions
- 26. Sept.22.2021 issued for Site Instruction #9
- 27. Oct.6.2021 Re-issued for permit
- 28. Oct.8.2021 issued for Site Instruction #10
- 29. Oct.28.2021 issued for Site Instruction #11
- 30. Nov.05.2021 issued for Site Instruction #12
- 31. Dec.3.2021 issued for Site Instruction #13
- 32. Dec.6.2021 issued for Site Instruction #14
- 33. Dec.7.2021 issued for Site Instruction #15
- 34. Jan.26.2022 issued for Site Instruction #16
- 35. Jan.31.2022 issued for Site Instruction #17
- 36. Mar.11.2022 issued for Site Instruction #18
- 37. Apr.29.2022 issued for Site Instruction #19
- 38. May.10.2022 issued for Site Instruction #20
- 39. May.24.2022 issued for Site Instruction #21
- 40. Aug.05.2022 issued for I.F.C.
- 41. Aug.18.2022 issued for Site Instruction #22
- 42. Aug.23.2022 issued for Site Instruction #23
- 43. Oct.12.2022 issued for Site Instruction #24

01. SEP.18.20219 issued for addendum 1

issued for revisions

GRAZIANI CORAZZA ARCHITECTS

1333 SHAWANESSA DRIVE, SUITE 100 MISSISSAUGA, ONTARIO L4W 1C3
905.763.7001 P.905.763.7000 WWW.GC-ARCHITECTS.COM

RESIDENTIAL

ATTMAR + PALLESCHI DRIVE

BRAMPTON ONTARIO


PROJECT ARCHITECT: B. GRAZIANI
ASSISTANT DESIGNER: R. LINCOLN
DRAWN BY: G.C./F.C./M.B.
CHECKED BY: D. BIASE/G. COLANGELO
PLOT DATE: OCT.11.2022
JOB #: 1331.15

GROUND FLOOR PLAN
BUILDING D (PARTIAL PLAN)

1:50 A-301d2

TITLEBLOCK SIZE: 915 x 1200

REF_A301a1 FOR CONTINUATION

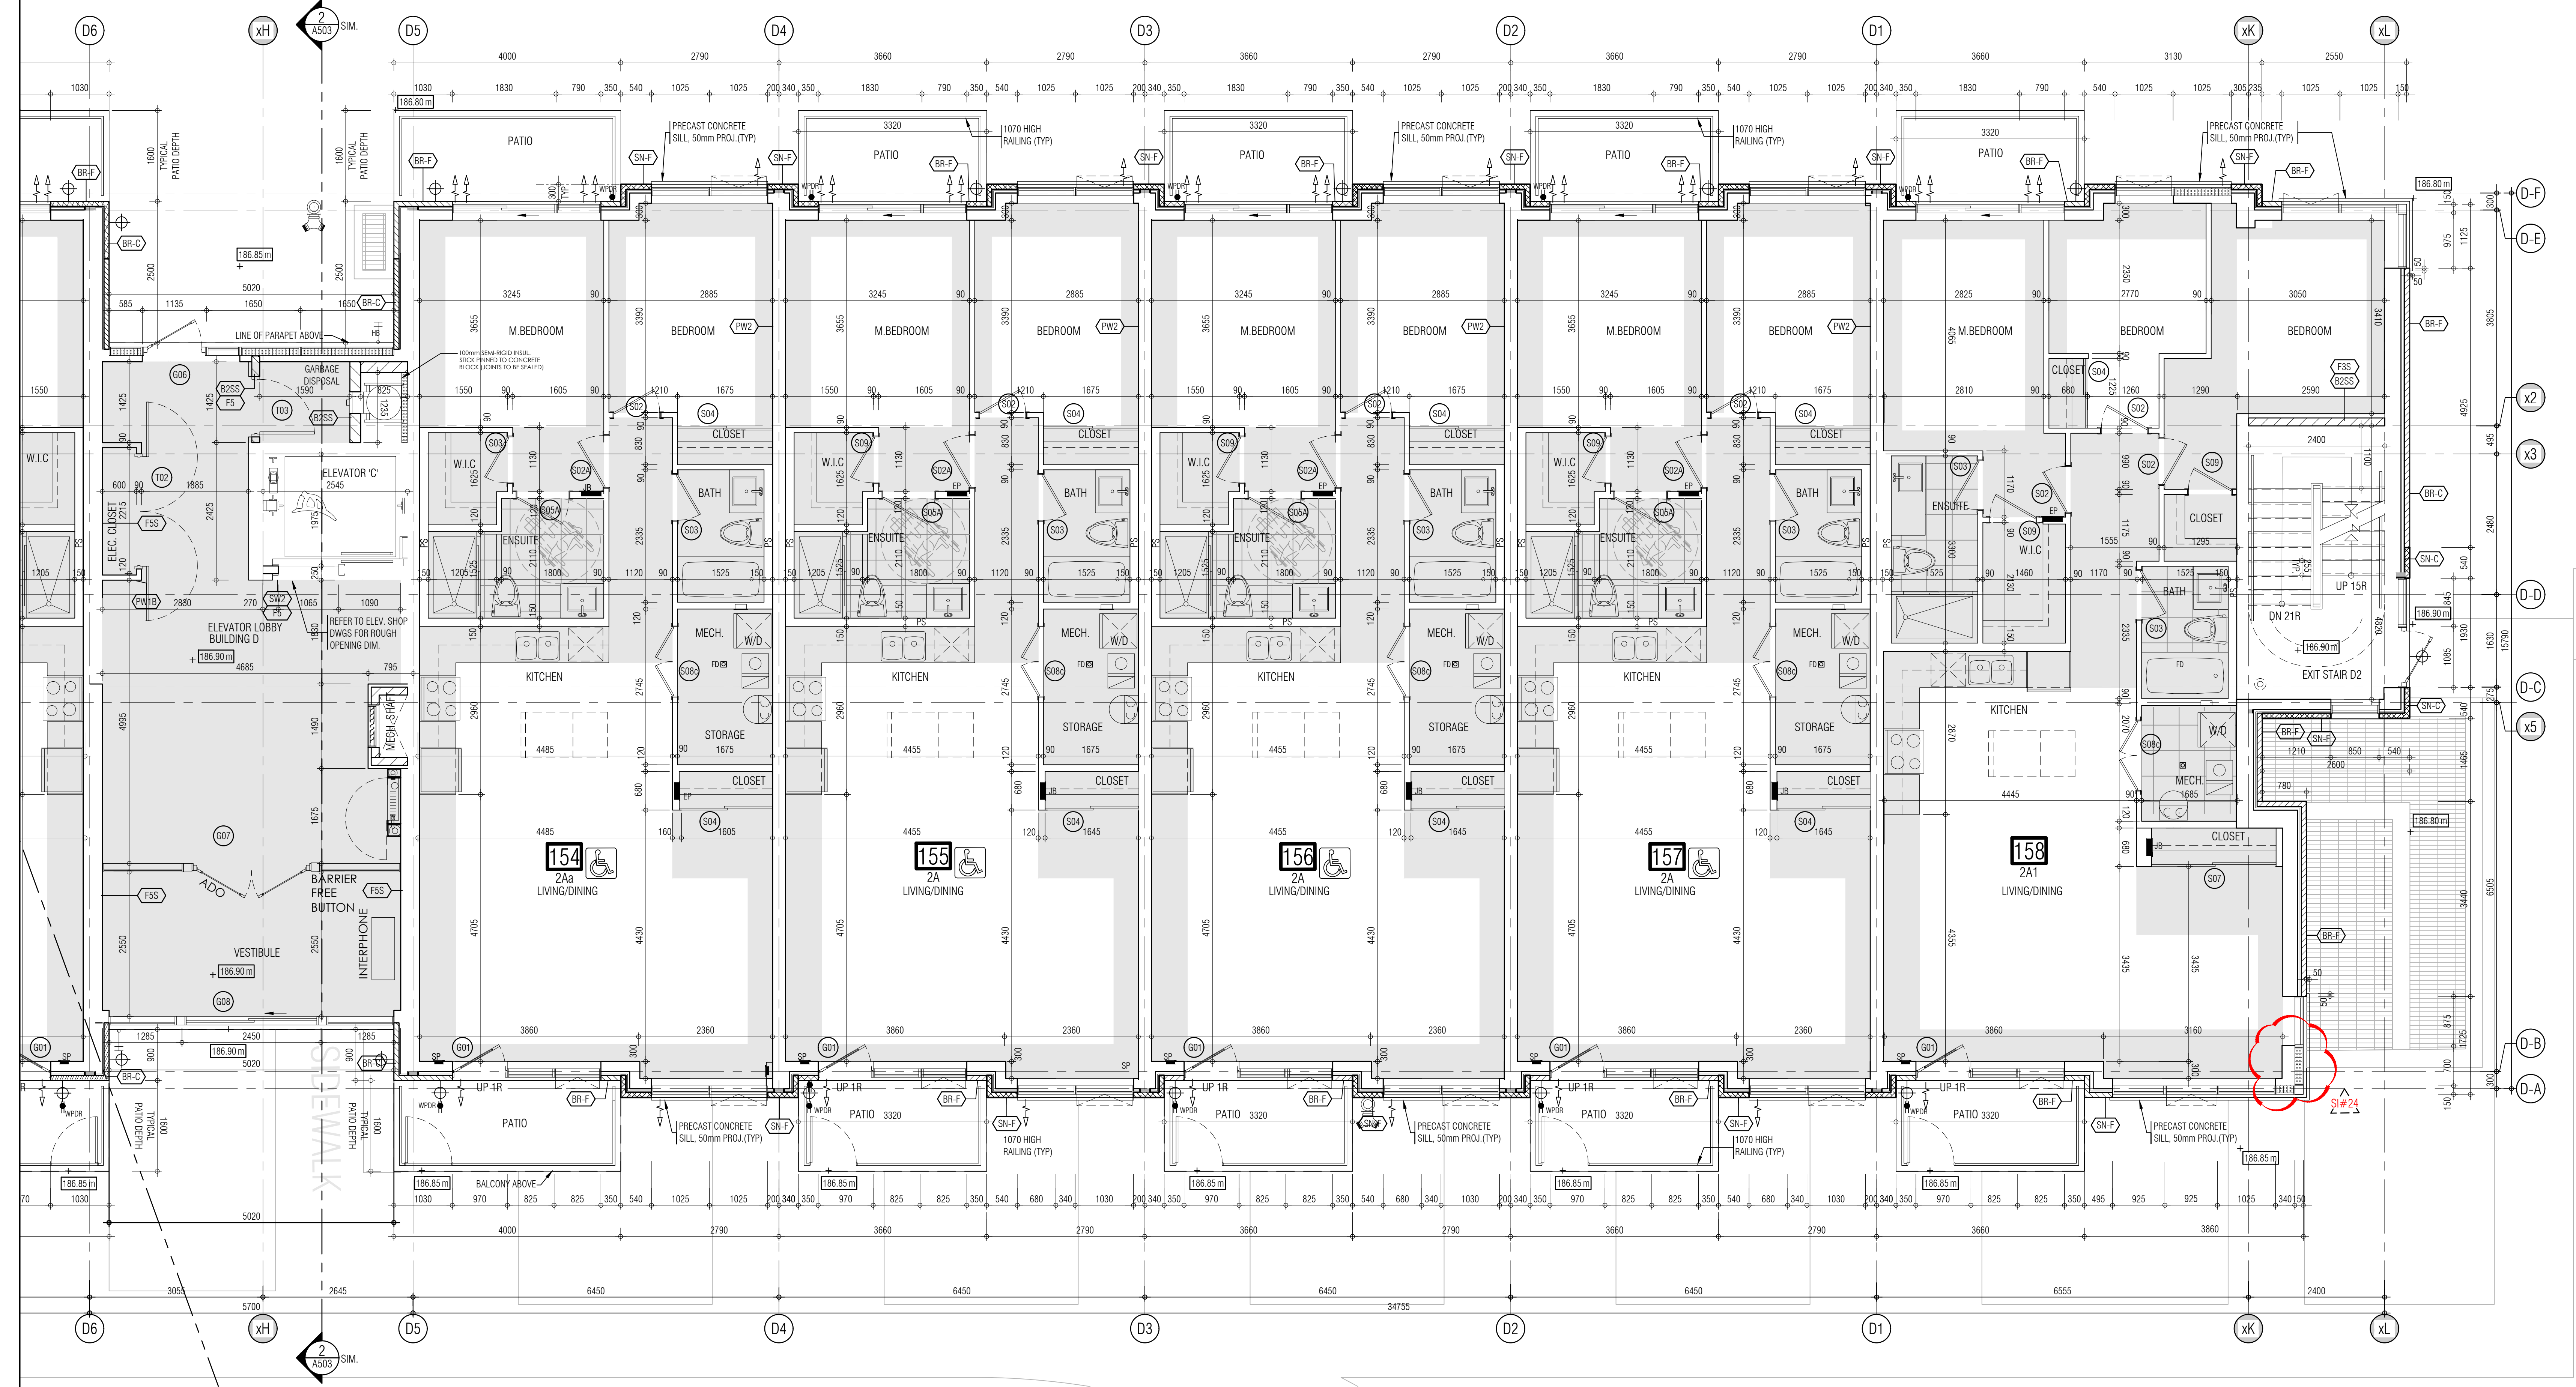

THIS DRAWING IS AN INSTRUMENT OF SERVICE. IT IS PROVIDED BY AND IS THE PROPERTY OF GRAZIANI-CORAZZA ARCHITECTS INC. THE CONTRACTOR MUST BE RESPONSIBLE FOR THE ACCURACY AND COMPLETENESS OF THE INFORMATION IN THIS DRAWING. GRAZIANI-CORAZZA ARCHITECTS INC. IS NOT RESPONSIBLE FOR THE ACCURACY OF SURVEY, STRUCTURAL, MECHANICAL, ELECTRICAL, AND OTHER ENGINEERING INFORMATION SHOWN ON THIS DRAWING. THE CONTRACTOR MUST OBTAIN ALL NECESSARY PERMITS AND APPROVALS FROM THE APPROPRIATE AUTHORITIES BEFORE PROCEEDING WITH THE WORK. CONSTRUCTION MUST COMPLY TO ALL APPLICABLE CODES AND REQUIREMENTS OF THE AUTHORITIES HAVING JURISDICTION. UNLESS OTHERWISE NOTED, NO INVESTIGATION HAS BEEN UNDERTAKEN OR REPORTED IN BY THIS OFFICE IN RELATION TO THE ENVIRONMENTAL CONDITION OF THIS SITE.

THIS DRAWING IS NOT TO BE SCALED. ALL ARCHITECTURAL SYMBOLS INDICATED ON THIS DRAWING ARE GRAPHIC REPRESENTATIONS ONLY.


CONDITIONS FOR ELECTRONIC INFORMATION TRANSFER:

ELECTRONIC INFORMATION IS SUPPLIED TO THE OTHER ASSOCIATED PARTS TO ASSIST THEM IN THE EXECUTION OF THEIR WORK. REVIEW THE RELEVANT PARTS MUST DETERMINE THE COMPLETENESS, APPROPRIATENESS, AND TIMELINESS OF THE INFORMATION IN RESPECT TO THEIR PARTICULAR RESPONSIBILITY.

GRAZIANI-CORAZZA ARCHITECTS INC. SHALL NOT BE RESPONSIBLE FOR ERRORS, OMISSIONS, INCOMPLETENESS DUE TO LOSS OF INFORMATION IN WHOLE OR PART WHEN INFORMATION IS TRANSMITTED.

1. TRANSMISSION OF ANY FILES OR DAMAGE TO THE RECEIVING ELECTRONIC SYSTEM WHEN INFORMATION IS TRANSMITTED.

REF. A304d2 FOR CONTINUATION

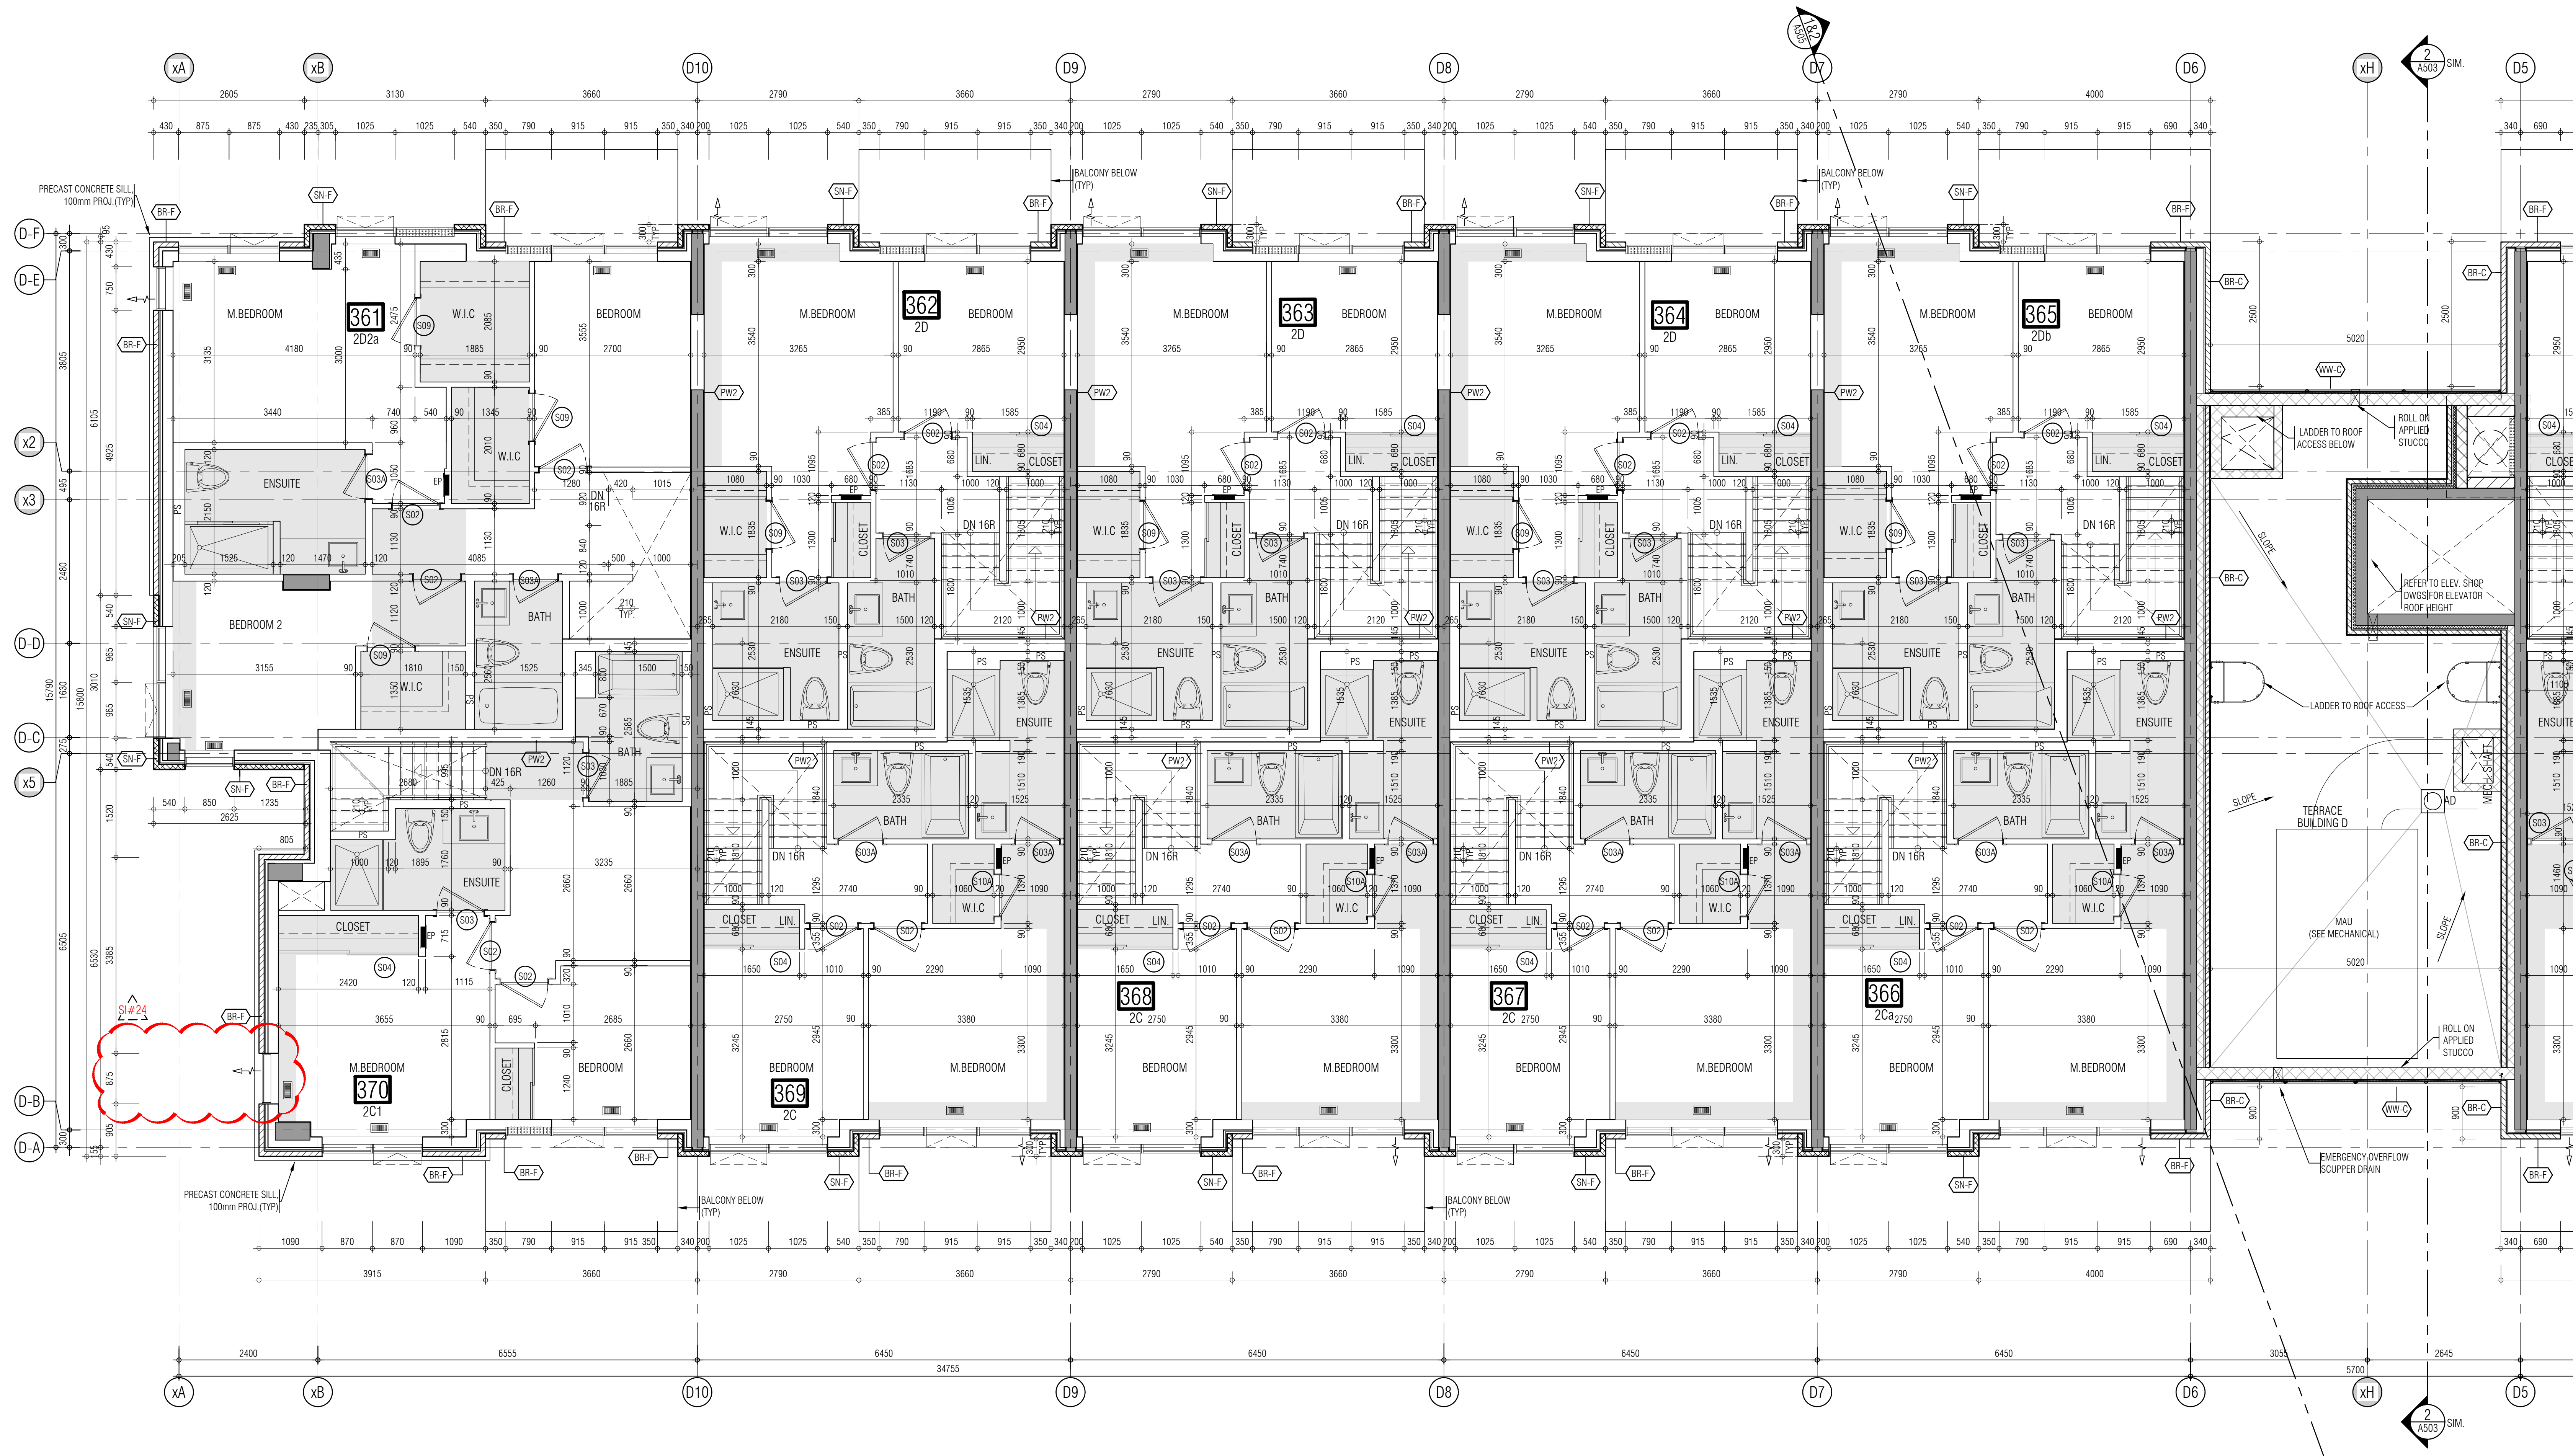

- 01. Oct.07.2019 issued for tender
- 02. Mar.13.2020 issued for design coordination #2
- 03. Mar.16.2020 issued for addendum #2
- 04. Mar.16.2020 issued for addendum #3
- 05. Aug.24.2020 issued for addendum #4
- 06. Sept.28.2020 issued for permit
- 07. Oct.20.2020 issued for addendum #5
- 08. Nov.23.2020 issued for addendum #6
- 09. Dec.14.2020 issued for addendum #7
- 10. Jan.18.2021 issued for addendum #8
- 11. Mar.2.2021 issued for permit
- 12. Mar.09.2021 issued for addendum #9
- 13. Mar.10.2021 issued for addendum #9R
- 14. Mar.26.2021 issued for progress
- 15. May.14.2021 issued for Site Instruction #1
- 16. June.15.2021 issued for Site Instruction #2
- 17. July.7.2021 re-issued for permit
- 18. July.15.2021 issued for Site Instruction #3
- 19. July.27.2021 issued for Site Instruction #4
- 20. Aug.3.2021 issued for Site Instruction #5
- 21. Aug.18.2021 issued for Site Instruction #6
- 22. Aug.20.2021 Re-issued for permit
- 23. Sept.07.2021 issued for Site Instruction #7
- 24. Sept.09.2021 issued for Site Instruction #8
- 25. Sept.16.2021 issued for Building D Permit Revisions
- 26. Sept.22.2021 issued for Site Instruction #9
- 27. Oct.6.2021 Re-issued for permit
- 28. Oct.8.2021 issued for Site Instruction #10
- 29. Oct.28.2021 issued for Site Instruction #11
- 30. Nov.05.2021 issued for Site Instruction #12
- 31. Dec.3.2021 issued for Site Instruction #13
- 32. Dec.6.2021 issued for Site Instruction #14
- 33. Dec.7.2021 issued for Site Instruction #15
- 34. Jan.26.2022 issued for Site Instruction #16
- 35. Jan.31.2022 issued for Site Instruction #17
- 36. Mar.11.2022 issued for Site Instruction #18
- 37. Apr.29.2022 issued for Site Instruction #19
- 38. May.10.2022 issued for Site Instruction #20
- 39. May.24.2022 issued for Site Instruction #21
- 40. Aug.05.2022 issued for I.F.C.
- 41. Aug.18.2022 issued for Site Instruction #22
- 42. Aug.23.2022 issued for Site Instruction #23
- 43. Oct.12.2022 issued for Site Instruction #24

01. Apr.19.2021 issued to client

issued for revisions

GRAZIANI CORAZZA ARCHITECTS

1333 SANDHURST DRIVE, SUITE 109 MISSISSAUGA, ONTARIO L4W 1C3
905.763.7201 P.905.763.7200 WWW.GC-ARCHITECTS.COM

RESIDENTIAL

ATTMAY + PALLESCHI DRIVE


BRAMPTON ONTARIO

PROJECT ARCHITECT: B. GRAZIANI
ASSISTANT DESIGNER: R. LINCOLN
DRAWN BY: G.C./F.C./M.B.
CHECKED BY: D. BIASE/G. COLANGELO
PLOT DATE: OCT.11.2022
JOB #: 1331.15

FORTH FLOOR PLAN
BUILDING D (PARTIAL PLAN)

1:50 A-304d1

TITLEBLOCK SIZE: 915 x 1200

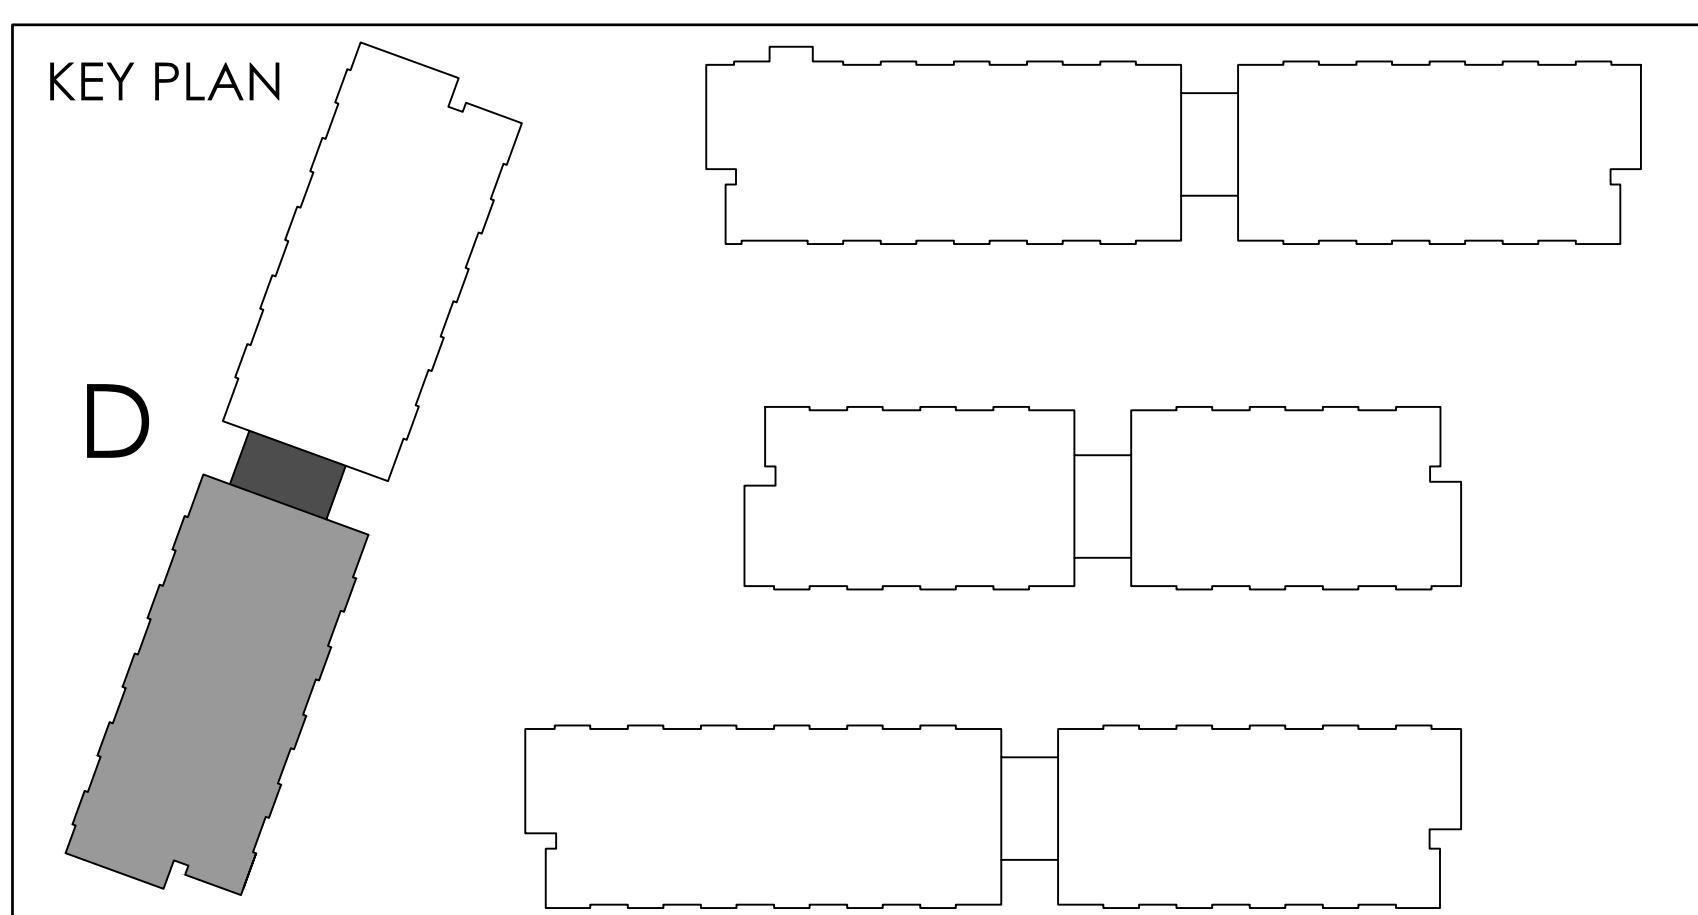

THIS DRAWING IS AN INSTRUMENT OF SERVICE, IS PROVIDED BY AND IS THE PROPERTY OF GRAZIANI-CORAZZA ARCHITECTS INC. THE CONTRACTOR MUST VERIFY AND ACCEPT RESPONSIBILITY FOR ALL DIMENSIONS AND COORDINATE THE SAME WITH THE SURVEY INFORMATION. GRAZIANI-CORAZZA ARCHITECTS INC. IS NOT RESPONSIBLE FOR THE ACCURACY OF SURVEY, STRUCTURAL, MECHANICAL, ELECTRICAL, AND OTHER ENGINEERING INFORMATION SHOWN ON THIS DRAWING. REFER TO THE APPROPRIATE ENGINEERING DRAWINGS BEFORE PROCEEDING WITH THE WORK. CONSTRUCTION MUST COMPLY TO ALL APPLICABLE CODES AND REQUIREMENTS OF THE AUTHORITIES HAVING JURISDICTION. UNLESS OTHERWISE NOTED, NO INSPECTION HAS BEEN UNDERTAKEN OR REPORTED ON BY THIS OFFICE IN RELATION TO THE ENVIRONMENTAL CONDITION OF THIS SITE.

THIS DRAWING IS NOT TO BE SCALED. ALL ARCHITECTURAL SYMBOLS INDICATED ON THIS DRAWING ARE GRAPHIC REPRESENTATIONS ONLY.

CONDITIONS FOR ELECTRONIC INFORMATION TRANSFER

ELECTRONIC INFORMATION IS SUPPLIED TO THE OTHER ASSOCIATED FIRMS TO ASSIST THEM IN THE EXECUTION OF THEIR WORK. REVIEW THE RECEIPT FROM MUST DETERMINE THE COMPLETENESS, APPROPRIATENESS, RELIANCE OF THE INFORMATION IN RESPECT TO THEIR PARTICULAR RESPONSIBILITY.

GRAZIANI-CORAZZA ARCHITECTS INC. SHALL NOT BE RESPONSIBLE FOR ERROR, OMISSIONS, INCOMPLETENESS DUE TO LOSS OF INFORMATION IN WHOLE OR PART WHEN INFORMATION IS TRANSFERRED.

TRANSMISSION OF ANY LOSS OR DAMAGE TO THE RECEIVING ELECTRONIC SYSTEM WHEN INFORMATION IS TRANSFERRED.

01. Oct.07.2019 issued for tender
02. Mar.13.2020 issued for design coordination #2
03. Mar.16.2020 issued for addendum #2
04. Mar.16.2020 issued for addendum #3
05. Aug.24.2020 issued for addendum #4
06. Sept.28.2020 issued for permit
07. Oct.20.2020 issued for addendum #5
08. Nov.23.2020 issued for addendum #6
09. Dec.14.2020 issued for addendum #7
10. Jan.15.2021 issued for addendum #8
11. Mar.2.2021 issued for permit
12. Mar.09.2021 issued for addendum #9
13. Mar.10.2021 issued for addendum #9R
14. Mar.26.2021 issued for progress
15. May.14.2021 issued for Site Instruction #1
16. June.15.2021 issued for Site Instruction #2
17. July.7.2021 re-issued for permit
18. July.15.2021 issued for Site Instruction #3
19. July.27.2021 issued for Site Instruction #4
20. Aug.3.2021 issued for Site Instruction #5
21. Aug.18.2021 issued for Site Instruction #6
22. Aug.20.2021 Re-issued for permit
23. Sept.07.2021 issued for Site Instruction #7
24. Sept.09.2021 issued for Site Instruction #8
25. Sept.16.2021 issued for Building D Permit Revisions
26. Sept.22.2021 issued for Site Instruction #9
27. Oct.6.2021 Re-issued for permit
28. Oct.8.2021 issued for Site Instruction #10
30. Oct.28.2021 issued for Site Instruction #11
31. Nov.05.2021 issued for Site Instruction #12
32. Dec.3.2021 issued for Site Instruction #13
33. Dec.6.2021 issued for Site Instruction #14
34. Dec.7.2021 issued for Site Instruction #15
35. Jan.26.2022 issued for Site Instruction #16
36. Jan.31.2022 issued for Site Instruction #17
37. Mar.11.2022 issued for Site Instruction #18
38. Apr.29.2022 issued for Site Instruction #19
39. May.10.2022 issued for Site Instruction #20
40. May.24.2022 issued for Site Instruction #21
41. Aug.05.2022 issued for I.F.C.
42. Aug.18.2022 issued for Site Instruction #22
43. Aug.23.2022 issued for Site Instruction #23
44. Oct.12.2022 issued for Site Instruction #24

01. Apr.19.2021 issued to client

issued for revisions

GRAZIANI CORAZZA ARCHITECTS

1333 SHANAGOLD DRIVE, SUITE 100 MISSISSAUGA, ONTARIO L4W 1C3
905.760.0201 P.905.760.3388 WWW.GC-ARCHITECTS.COM

ATTMAR + PALLESCHI DRIVE

BRAMPTON ONTARIO


PROJECT ARCHITECT: B. GRAZIANI
ASSISTANT DESIGNER: R. LINCOLN
DRAWN BY: G.C./F.C./M.B.
CHECKED BY: D. BIASE/G. COLANGELO
PLOT DATE: OCT.11.2022
JOB #: 1331.15

**FORTH FLOOR PLAN
BUILDING D (PARTIAL PLAN)**

1:50 **A-304d2**

TITLEBLOCK SIZE: 915 x 1200

REF.A304d1 FOR CONTINUATION

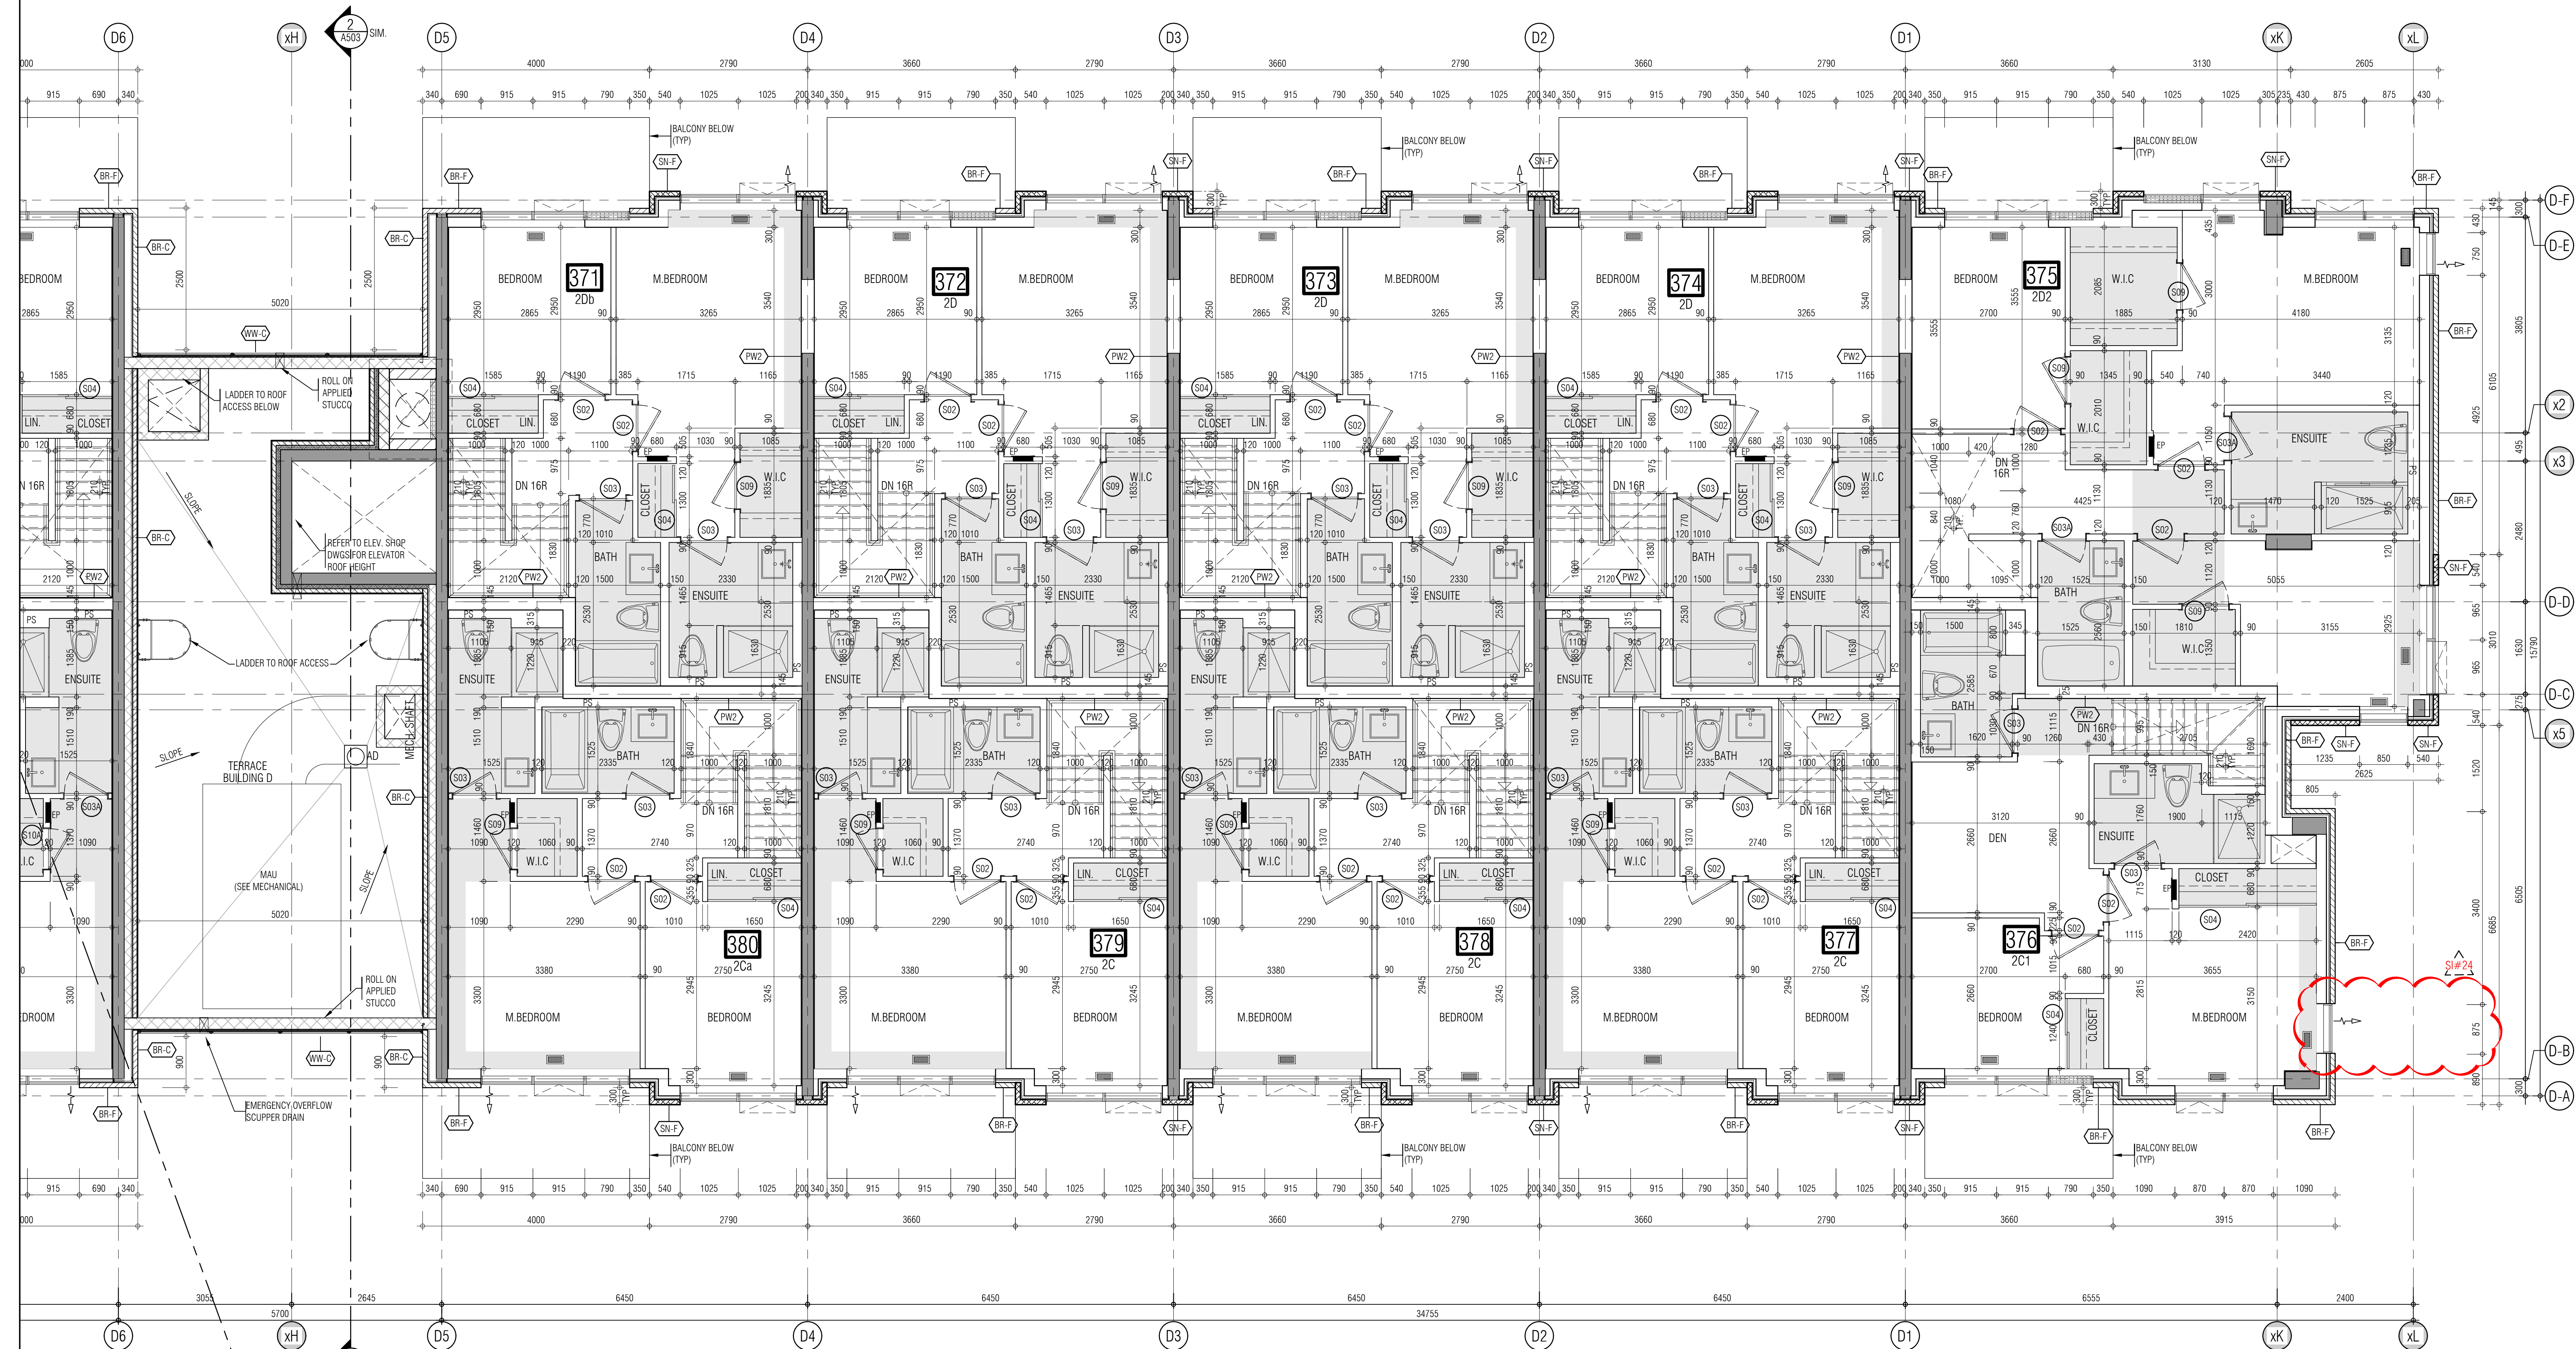

THIS DRAWING IS AN INSTRUMENT OF SERVICE, IT IS PROVIDED BY AND IS THE PROPERTY OF GRAZIANI-CORAZZA ARCHITECTS INC. THE CONTRACTOR MUST VERIFY AND ACCEPT RESPONSIBILITY FOR ALL DIMENSIONS AND COORDINATIONS AND MUST NOTIFY GRAZIANI-CORAZZA ARCHITECTS INC. OF ANY VARIATIONS FROM THE SUPPLIED INFORMATION. GRAZIANI-CORAZZA ARCHITECTS INC. IS NOT RESPONSIBLE FOR THE ACCURACY OF SURVEY, STRUCTURAL, MECHANICAL, ELECTRICAL, AND OTHER ENGINEERING INFORMATION SHOWN ON THIS DRAWING. REFER TO THE APPROPRIATE ENGINEERING DRAWINGS BEFORE PROCEEDING WITH THE WORK. CONSTRUCTION MUST COMPLY TO ALL APPLICABLE CODES AND REQUIREMENTS OF THE AUTHORITIES HAVING JURISDICTION. UNLESS OTHERWISE NOTED, NO MODIFICATION HAS BEEN MADE/NOTED OR REPORTED BY THIS OFFICE IN REGARDS TO THE ENVIRONMENTAL CONDITION OF THIS SITE.


THIS DRAWING IS NOT TO BE SCALED. ALL ARCHITECTURAL SYMBOLS INDICATED ON THIS DRAWING ARE GRAPHIC REPRESENTATIONS ONLY.

CONDITIONS FOR ELECTRONIC INFORMATION TRANSFER

ELECTRONIC INFORMATION IS SUPPLIED TO THE OTHER ASSOCIATED FIRMS TO ASSIST THEM IN THE EXECUTION OF THEIR WORK. REVIEW THE RECEIVED FIRMS MUST DETERMINE THE COMPLETENESS, APPROPRIATENESS, RELIANCE OF THE INFORMATION IN RESPECT TO THEIR PARTICULAR RESPONSIBILITY.

GRAZIANI-CORAZZA ARCHITECTS INC. SHALL NOT BE RESPONSIBLE FOR ERRORS, OMISSIONS, INCOMPLETENESS DUE TO LOSS OF INFORMATION IN WHOLE OR PART WHEN INFORMATION IS TRANSMITTED.

1. TRANSMISSION OF ANY LOSS OF DAMAGE TO THE RECEIVING ELECTRONIC SYSTEM WHEN INFORMATION IS TRANSMITTED.

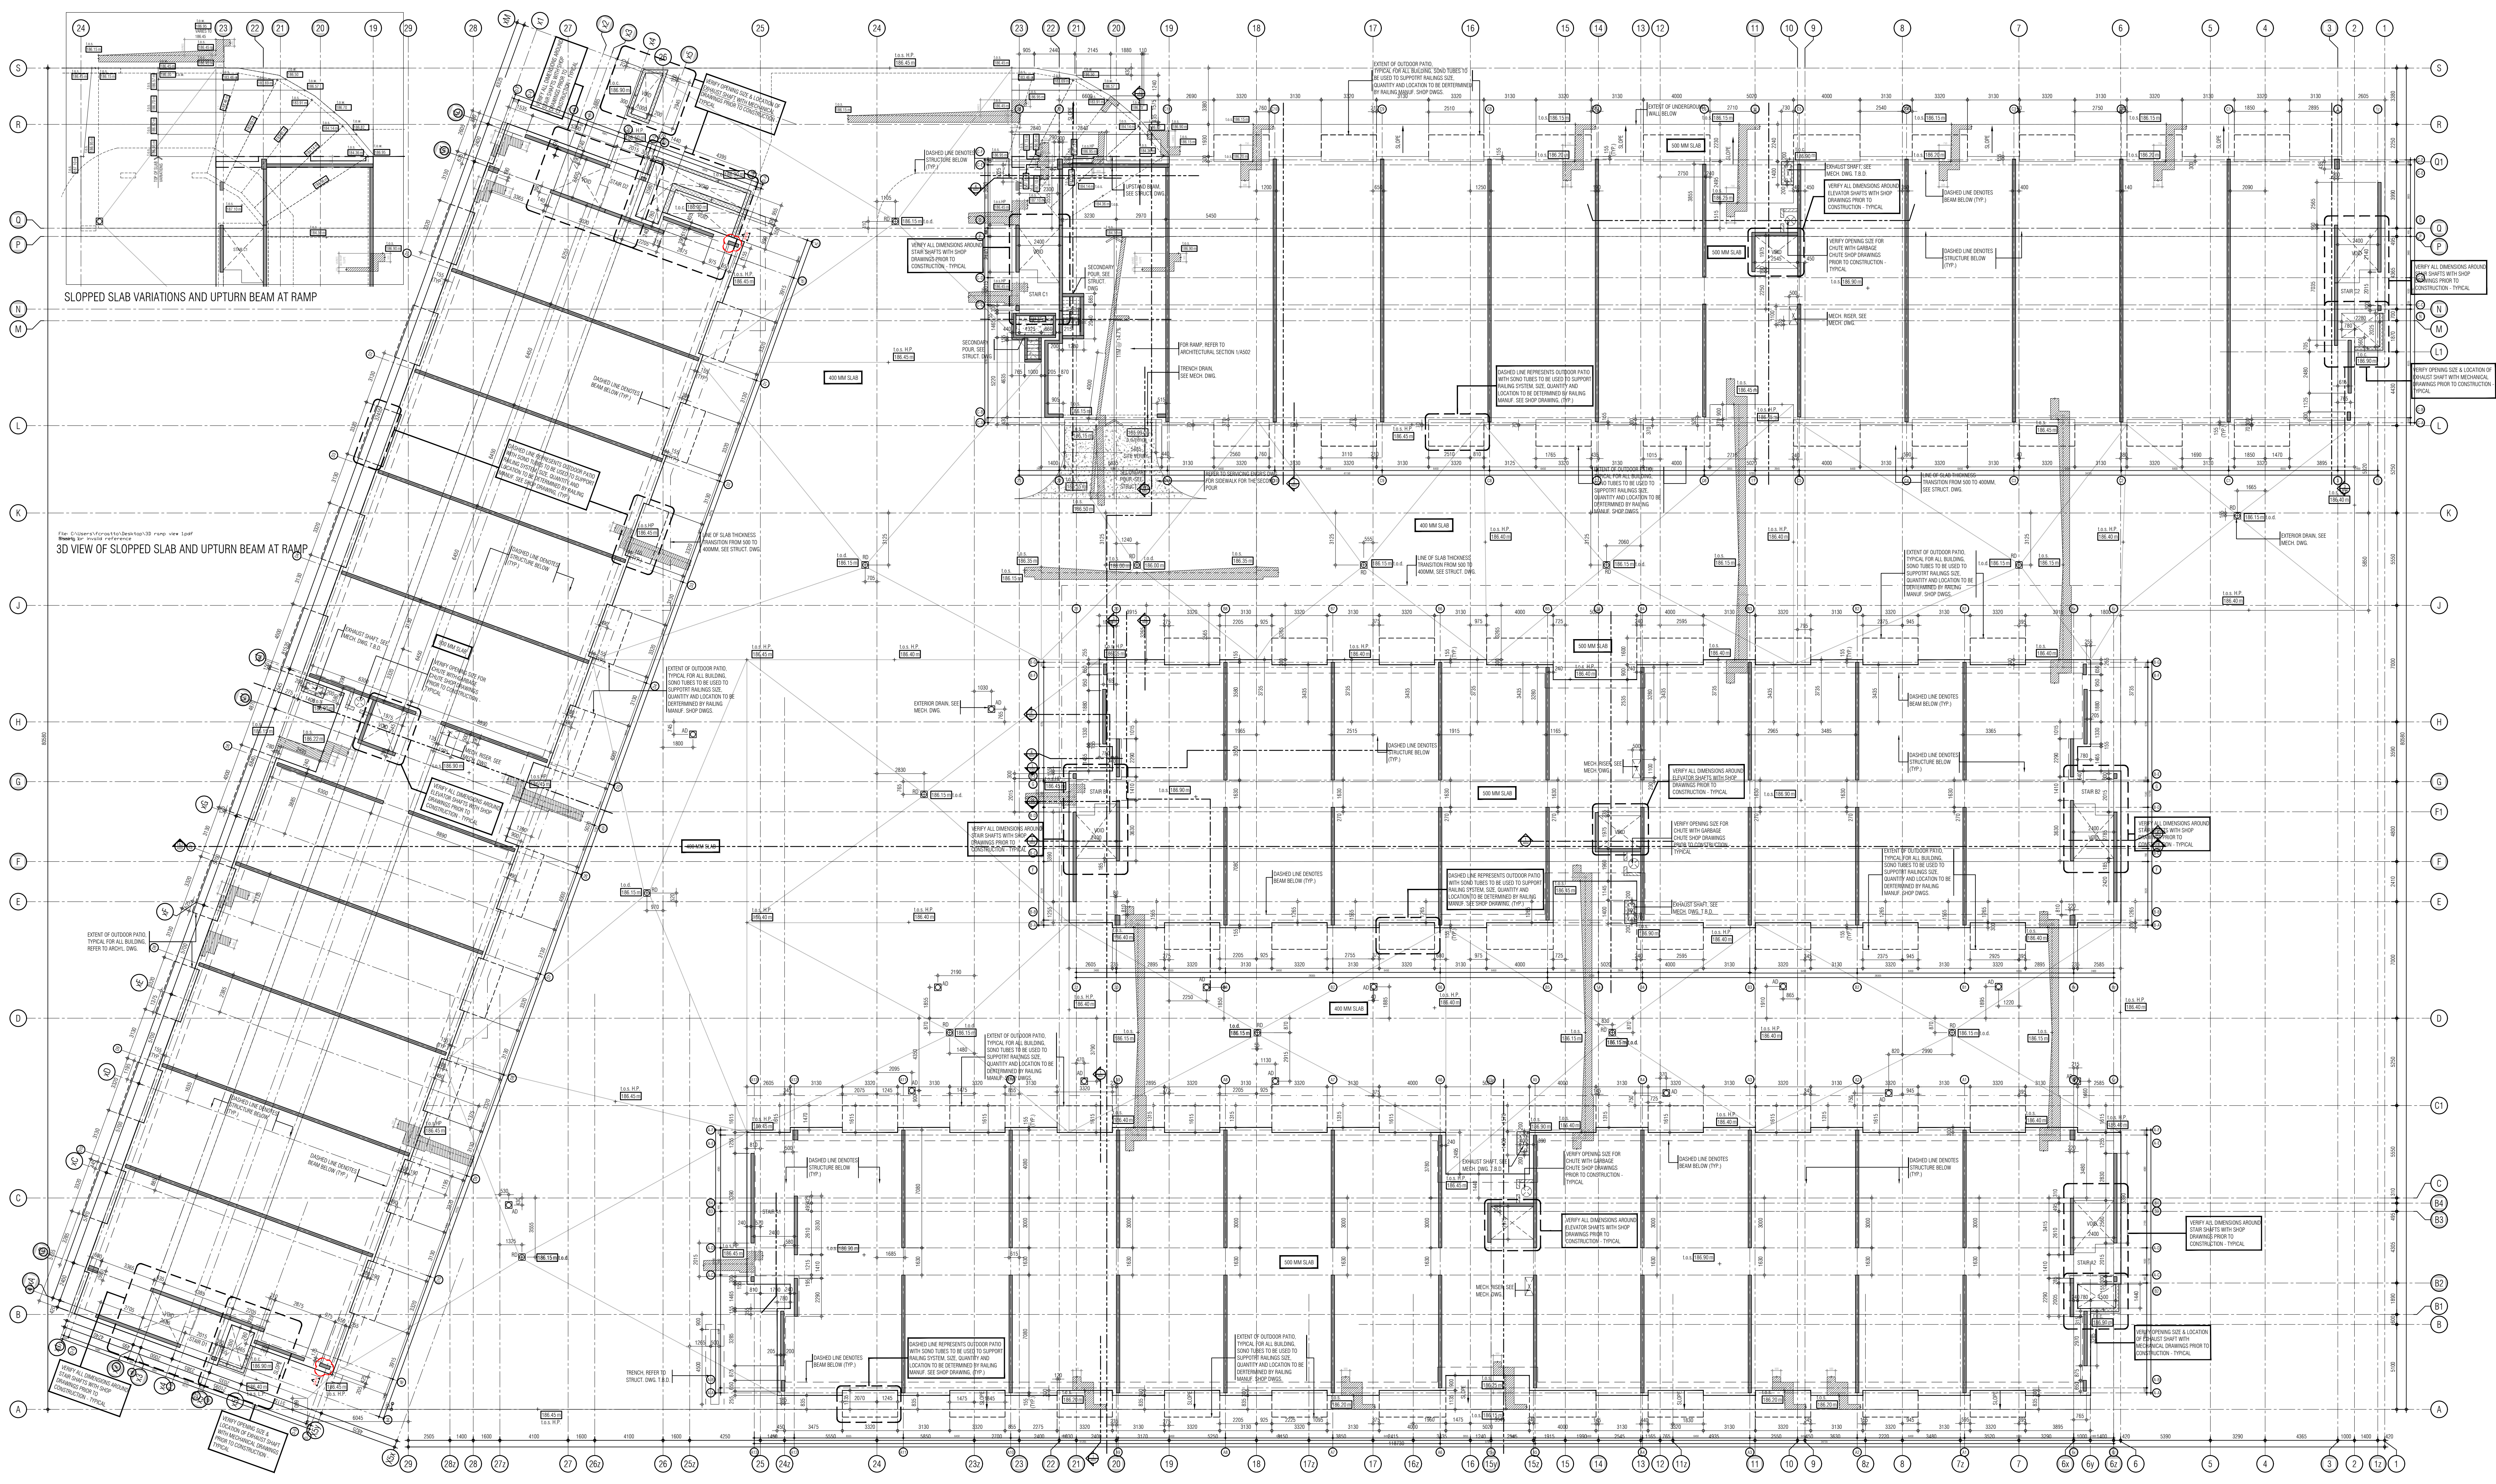

- 01. Oct.07.2019 issued for tender
- 02. Mar.13.2020 issued for design coordination #2
- 03. Mar.16.2020 issued for addendum #2
- 04. Mar.16.2020 issued for addendum #3
- 05. Aug.24.2020 issued for addendum #4
- 06. Sept.28.2020 issued for permit
- 07. Oct.20.2020 issued for addendum #5
- 08. Nov.23.2020 issued for addendum #6
- 09. Dec.14.2020 issued for addendum #7
- 10. Jan.15.2021 issued for addendum #8
- 11. Mar.2.2021 issued for permit
- 12. Mar.09.2021 issued for addendum #9
- 13. Mar.10.2021 issued for addendum #9R
- 14. Mar.26.2021 issued for progress
- 15. May.14.2021 issued for Site Instruction #1
- 16. June.15.2021 issued for Site Instruction #2
- 17. July.7.2021 re-issued for permit
- 18. July.15.2021 issued for Site Instruction #3
- 19. July.27.2021 issued for Site Instruction #4
- 20. Aug.3.2021 issued for Site Instruction #5
- 21. Aug.18.2021 issued for Site Instruction #6
- 22. Aug.20.2021 Re-issued for permit
- 23. Sept.07.2021 issued for Site Instruction #7
- 24. Sept.09.2021 issued for Site Instruction #8
- 25. Sept.16.2021 issued for Building D Permit Revisions
- 26. Sept.22.2021 issued for Site Instruction #9
- 27. Oct.6.2021 Re-issued for permit
- 28. Oct.8.2021 issued for Site Instruction #10
- 29. Oct.28.2021 issued for Site Instruction #11
- 30. Nov.05.2021 issued for Site Instruction #12
- 31. Dec.3.2021 issued for Site Instruction #13
- 32. Dec.6.2021 issued for Site Instruction #14
- 33. Dec.7.2021 issued for Site Instruction #15
- 34. Jan.26.2022 issued for Site Instruction #16
- 35. Jan.31.2022 issued for Site Instruction #17
- 36. Mar.11.2022 issued for Site Instruction #18
- 37. Apr.29.2022 issued for Site Instruction #19
- 38. May.10.2022 issued for Site Instruction #20
- 39. May.24.2022 issued for Site Instruction #21
- 40. Aug.05.2022 issued for I.F.C.
- 41. Aug.18.2022 issued for Site Instruction #22
- 42. Aug.23.2022 issued for Site Instruction #23
- 43. Oct.12.2022 issued for Site Instruction #24

01. SEP/18/2019 issued for addendum 1
issued for revisions



1331 SHARON DRIVE, SUITE 103 MISSISSAUGA, ONTARIO L4W 1C3
905.709.7021 P.905.709.7088 WWW.GC-ARCHITECTS.COM

BRAMPTON + PALLESCHI DRIVE ONTARIO
PROJECT ARCHITECT: B.GRAZIANI
ASSISTANT DESIGNER: R.LINCOLN
DRAWN BY: G.C./C.M.B.
CHECKED BY: D.BIASI/G.COLANGELO
PLOT DATE: OCT.12.2022
JOB #: 1331.15

CONCRETE SLAB EDGE
GROUND FLOOR (OVERALL PLAN)

1:150 CS301-05

TITLEBLOCK SIZE: 915 x 1200






01.	04.07.2019	issued for tender	—
02.	Mar.16.2020	issued for design coordination #2	—
03.	Mar.16.2020	issued for design coordination #3	—
04.	Mar.16.2020	issued for addendum #3	—
05.	Aug.24.2020	issued for addendum #4	—
06.	Sept.28.2020	issued for permit	bg
07.	04.10.2020	issued for addendum #5	—
08.	Nov.23.2020	issued for addendum #6	—
09.	Dec.14.2020	issued for addendum #7	—
10.	Jan.18.2021	issued for addendum #8	—
11.	Mar. 2. 2021	issued for permit	bg
12.	Mar.09.2021	issued for addendum #9	—
13.	Mar.10.2021	issued for addendum #9#1	—
14.	Mar.26.2021	issued for progress	—
15.	May.14.2021	issued for Site Instruction #1	—
16.	June.15.2021	issued for Site Instruction #2	—
17.	July. 1. 2021	re-issued for permit	bg
18.	July.15.2021	issued for Site Instruction #3	bg
19.	July. 27. 2021	issued for Site Instruction #4	bg
20.	Aug. 3. 2021	issued for Site Instruction #5	bg
21.	Aug.16.2021	issued for Site Instruction #6	bg
22.	Aug. 20. 2021	Re-issued for permit.	—

01. SEP:19/20219 Issued for circulation 1 hg
issued for revisions



CONCRETE SLAB EDGE
GROUND FLOOR (ENLARGE PLAN)

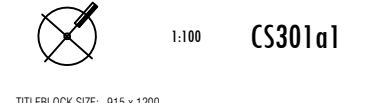

FILEBLOCK SIZE: 915 x 1200

THIS DRAWING IS NOT TO BE SCALED. ALL ARCHITECTURAL SYMBOLS INDICATED ON THIS DRAWING ARE GRAPHIC REPRESENTATIONS ONLY.

CONVENTIONS FOR ELECTRONIC INFORMATION TRANSFER:

ELECTRONIC INFORMATION IS SUPPLIED TO THE OTHER ASSOCIATED FIRMS TO ASSIST THEM IN THE EXECUTION OF THEIR WORK/REVIEW. THE RECIPIENT FIRMS MUST DETERMINE THE COMPLETENESS/APPROPRIATENESS/RELEVANCE OF THE INFORMATION IN RESPECT TO THEIR PARTICULAR RESPONSIBILITY.

GRADWIN+COZZA ARCHITECTS INC. SHALL NOT BE RESPONSIBLE FOR:

1. ERRORS, OMISSIONS, INADEQUACIES DUE TO LOSS OF INFORMATION IN WHOLE OR PART WHEN INFORMATION IS TRANSFERRED.
2. TRANSMISSION OF ANY VIRUS OR DANGER TO THE RECEIVING ELECTRONIC SYSTEM WHEN INFORMATION IS TRANSFERRED.

CG + +

RESIDENTIAL


The logo for Royal Pine Realty is an oval emblem with a green background and a gold border. Inside the oval, the words "ROYAL PINE" are written in a stylized, gold, serif font, with "REALTY" in a smaller font below it. A small gold crown icon is positioned above the word "PINE".

PROJECT ARCHITECT: B.GRAZIANI
ASSISTANT DESIGNER: R.LINCOLN
DRAWN BY: G.C/F.C/M.B
CHECKED BY: D.DRAKE/C.COANFIELD

**NORTH & SOUTH ELEVATION
BUILDING D**

1:50 A-404d3

TITLEBLOCK SIZE: 915 x 1200

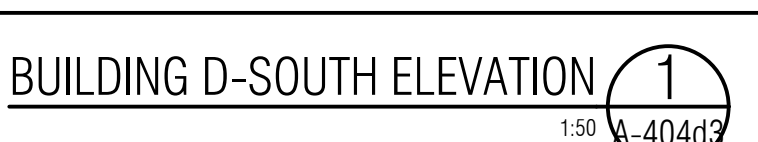

MATERIALS LEGEND	

NOTE: IF PRODUCT SPECIFICATIONS DO NOT AVAILABLE, ATTEMPT TO OBTAIN MATERIALS AND SUBMIT FOR APPROVAL.