



SITE INSTRUCTION

Forestside Estates
 Attmar & Palleschi Drive
 Brampton, Ontario
 Attn: **Vince Staffieri**

SI A26

PROJECT : Forestside
PROJECT # : 1331.15
DATE : Mar. 22, 2023

Site instructions/memos and Addendums are issued only for the purpose of recording any clarification or interpretation of the contract documents or giving direction on problems resulting from field conditions. These memos are subject to the provisions of the contract documents and unless reviewed with and authorized by the Client, will not affect the contract. Should the Contractor require a change in the contract price or project schedule, he shall submit to the Client, prior to commencement of work outlined in this memo, an itemized proposal for approval.

Title: Revisions to plans as itemized.

Reference:		Changes:
A211, A211a, A211b	P1 Underground Plan	<ul style="list-style-type: none"> Revised acoustical ceiling type labeled C3 to C7 as per client selection of ceiling type on acoustical report. Added C7 to wall type description to chart.
A503, A504, A505, A506	Building Sections	<ul style="list-style-type: none"> Revised acoustical ceiling type and labels from C3 to C7.

Reason: Revisions to plans as per client selection of acoustical ceiling types as per acoustical report.

If you have any questions or require any further clarification, please email or call.

Yours truly,

Gino Colangelo
 Associate Principal, Director of Contract Documents

**Distribution:**

Royal Pine Homes	Vince Staffieri Cinzia Caruzo	vince@royalpinehomes.com Cinzia@royalpinehomes.com
Jablonski Engineering	Kevin Deonaraine	kdeonaraine@astint.on.ca
United Engineering	Rene Cuales Leonard Matthews Susan Pan Mark Giorgi	rene@u-eng.ca Lenard@u-eng.ca susan@u-eng.ca mark@u-eng.ca
Candevcon Limited	Diarmund Hogan Dudister Damnaraigh	dhorgan@candevcon.com dude@candevcon.com
Starfire Sprinkler Systems	Elite Novosselova Peter Adrian	elitecanada@hotmail.com Peter@starfiresystems.biz
Strybos Barron King Ltd.	Bryn Barron Kaleigh Gills Sydney Martel	bbarron@strybos.com kgillis@strybos.com smartel@strybos.com
Graziani + Corazza Architects	Domenic Biase Gino Colangelo Fernando Croatto	dbiase@gc-architects.com gcolangelo@gc-architects.com FCroatto@gc-architects.com



THIS DRAWING IS AN INSTRUMENT OF SERVICE. IT IS PROVIDED BY AND IS THE PROPERTY OF GRAZIANI-CORAZZA ARCHITECTS INC. THE CONTRACTOR MUST VERIFY AND ACCEPT RESPONSIBILITY FOR ALL DIMENSIONS AND COORDINATIONS. GRAZIANI-CORAZZA ARCHITECTS INC. SHALL NOT BE RESPONSIBLE FOR ANY ERRORS OR OMISSIONS. GRAZIANI-CORAZZA ARCHITECTS INC. IS NOT RESPONSIBLE FOR THE ACCURACY OF SURVEY, STRUCTURAL, MECHANICAL, ELECTRICAL, AND OTHER ENGINEERING INFORMATION SHOWN ON THIS DRAWING. REFER TO THE APPROPRIATE ENGINEERING DRAWINGS BEFORE PROCEEDING WITH THE WORK. CONSTRUCTION MUST COMPLY TO ALL APPLICABLE CODES AND REQUIREMENTS OF THE AUTHORITY HAVING JURISDICTION. UNLESS OTHERWISE NOTED, NO INVESTIGATION HAS BEEN UNDERTAKEN OR REPORTED ON BY THIS OFFICE IN REGARD TO THE ENVIRONMENTAL CONDITION OF THIS SITE.

THIS DRAWING IS NOT TO BE SCALED. ALL ARCHITECTURAL SYMBOLS INDICATED ON THIS DRAWING ARE GRAPHIC REPRESENTATIONS ONLY.

ELECTRONIC INFORMATION IS SUPPLIED TO THE OTHER ASSOCIATED FIRMS TO ASSIST THEM IN THE EXECUTION OF THEIR WORK. REVIEW THE RECEIPTED FIRMS MUST DETERMINE THE COMPLETENESS, APPROPRIATENESS, RELIANCE OF THE INFORMATION IN RESPECT TO THEIR PARTICULAR RESPONSIBILITY.

GRAZIANI-CORAZZA ARCHITECTS INC. SHALL NOT BE RESPONSIBLE FOR: 1. BROADER, OVERSIGHT, INCOMPLETENESS DUE TO LOSS OF INFORMATION IN WHOLE OR PART WHEN INFORMATION IS TRANSFERRED. 2. TRANSMISSION OF ANY LOSS OR DAMAGE TO THE RECEIVING ELECTRONIC SYSTEM WHEN INFORMATION IS TRANSFERRED.

01. Oct.07.2019 issued for tender
02. Mar.13.2020 issued for design coordination #2
03. Mar.16.2020 issued for addendum #2
04. Mar.16.2020 issued for addendum #3
05. Aug.24.2020 issued for addendum #4
06. Sept.28.2020 issued for permit
07. Oct.20.2020 issued for addendum #5
08. Nov.23.2020 issued for addendum #6
09. Dec.14.2020 issued for addendum #7
10. Jan.15.2021 issued for addendum #8
11. Mar.2.2021 issued for permit
12. Mar.09.2021 issued for addendum #9
13. Mar.10.2021 issued for addendum #9R
14. Mar.26.2021 issued for progress
15. May.14.2021 issued for Site Instruction #1
16. June.15.2021 issued for Site Instruction #2
17. July.7.2021 re-issued for permit
18. July.15.2021 issued for Site Instruction #3
19. July.27.2021 issued for Site Instruction #4
20. Aug.3.2021 issued for Site Instruction #5
21. Aug.18.2021 issued for Site Instruction #6
22. Aug.28.2021 re-issued for permit
23. Sept.07.2021 issued for Site Instruction #7
24. Sept.09.2021 issued for Site Instruction #8
25. Sept.16.2021 issued for Building D Permit Revisions
26. Sept.22.2021 issued for Site Instruction #9
27. Oct.6.2021 re-issued for permit
28. Oct.8.2021 issued for Site Instruction #10
30. Oct.28.2021 issued for Site Instruction #11
31. Nov.05.2021 issued for Site Instruction #12
32. Dec.3.2021 issued for Site Instruction #13
33. Dec.6.2021 issued for Site Instruction #14
34. Dec.7.2021 issued for Site Instruction #15
35. Jan.26.2022 issued for Site Instruction #16
36. Jan.31.2022 issued for Site Instruction #17
37. Mar.11.2022 issued for Site Instruction #18
38. Apr.29.2022 issued for Site Instruction #19
39. May.10.2022 issued for Site Instruction #20
40. May.24.2022 issued for Site Instruction #21
41. Aug.05.2022 issued for I.F.C.
42. Aug.18.2022 issued for Site Instruction #22
43. Aug.23.2022 issued for Site Instruction #23
44. Oct.12.2022 issued for Site Instruction #24
45. Feb.6.2023 issued for Site Instruction #25
46. Mar.22.2023 issued for Site Instruction #26

1. GENERAL NOTES AND LEGEND	2. PARKING LEGEND
3. PARKING STATISTICS	4. LOCKERS LEGEND
5. STORAGE LOCKER STATISTICS	

GENERAL NOTES + LEGEND

1. GENERAL NOTES AND LEGEND

2. PARKING LEGEND

3. PARKING STATISTICS

4. LOCKERS LEGEND

5. STORAGE LOCKER STATISTICS

01. SEP.18.20219 issued for addendum 1

issued for revisions

GRAZIANI CORAZZA ARCHITECTS

1333 SHAWANAGA DRIVE, SUITE 100 MISSISSAUGA, ONTARIO L4W 1C3
905.709.7021 FAX 905.709.7020 WWW.GC-ARCHITECTS.COM

ATTMAR + PALLESCHI DRIVE

BRAMPTON ONTARIO

PROJECT ARCHITECT: R. GRAZIANI
ASSISTANT DESIGNER: R. LINCOLN
DRAWN BY: G.C./C.M.B.
CHECKED BY: D. BIASE/G. COLANGELO
PLOT DATE: MAR.22.2023
JOB # 1331.15

P1 UNDERGROUND PLAN (ENLARGE PLAN)

1:100 A211a

TITLEBLOCK SIZE: 915 x 1200

THIS DRAWING AS AN INSTRUMENT OF SERVICE, IS PROVIDED BY AND IS THE PROPERTY OF GRAZIANI-CORAZZA ARCHITECTS INC. THE CONTRACTOR MUST VERIFY AND ACCEPT RESPONSIBILITY FOR ALL DIMENSIONS AND COORDINATIONS AND MUST NOTIFY GRAZIANI-CORAZZA ARCHITECTS INC. OF ANY DISCREPANCIES FROM THE SUPPLIED INFORMATION. GRAZIANI-CORAZZA ARCHITECTS INC. IS NOT RESPONSIBLE FOR THE ACCURACY OF SURVEY, STRUCTURAL, MECHANICAL, ELECTRICAL AND OTHER ENGINEERING INFORMATION SHOWN ON THIS DRAWING. REFER TO THE APPROPRIATE ENGINEERING DRAWINGS BEFORE PROCEEDING WITH THE WORK. CONSTRUCTION MUST CONFORM TO ALL APPLICABLE CODES AND REQUIREMENTS OF THE AUTHORITIES HAVING JURISDICTION, UNLESS OTHERWISE NOTED. NO REVISIONS TO THIS DRAWING ARE PERMITTED BY THIS OFFICE IN REGARDS TO THE ENVIRONMENTAL CONDITION OF THIS SITE.


THIS DRAWING IS NOT TO BE SCALED. ALL ARCHITECTURAL SYMBOLS INDICATED ON THIS DRAWING ARE GRAPHIC REPRESENTATIONS ONLY.

CONDITIONS FOR ELECTRONIC INFORMATION TRANSFER


ELECTRONIC INFORMATION IS SUPPLIED TO THE OTHER ASSOCIATED FIRMS TO ASSIST THEM IN THE EXECUTION OF THEIR WORK. REVIEW THE RECIPIENT FIRMS MUST DETERMINE THE COMPLETENESS, APPROPRIATENESS, RELIANCE OF THE INFORMATION IN RESPECT TO THEIR PARTICULAR RESPONSIBILITY.

GRAZIANI-CORAZZA ARCHITECTS INC. SHALL NOT BE RESPONSIBLE FOR ERRORS, OMISSIONS, INCOMPLETENESS DUE TO LOSS OF INFORMATION IN WHOLE OR PART WHEN INFORMATION IS TRANSMITTED.

1. TRANSMISSION OF ANY LOSS OF DAMAGE TO THE RECEIVING ELECTRONIC SYSTEM WHEN INFORMATION IS TRANSMITTED.

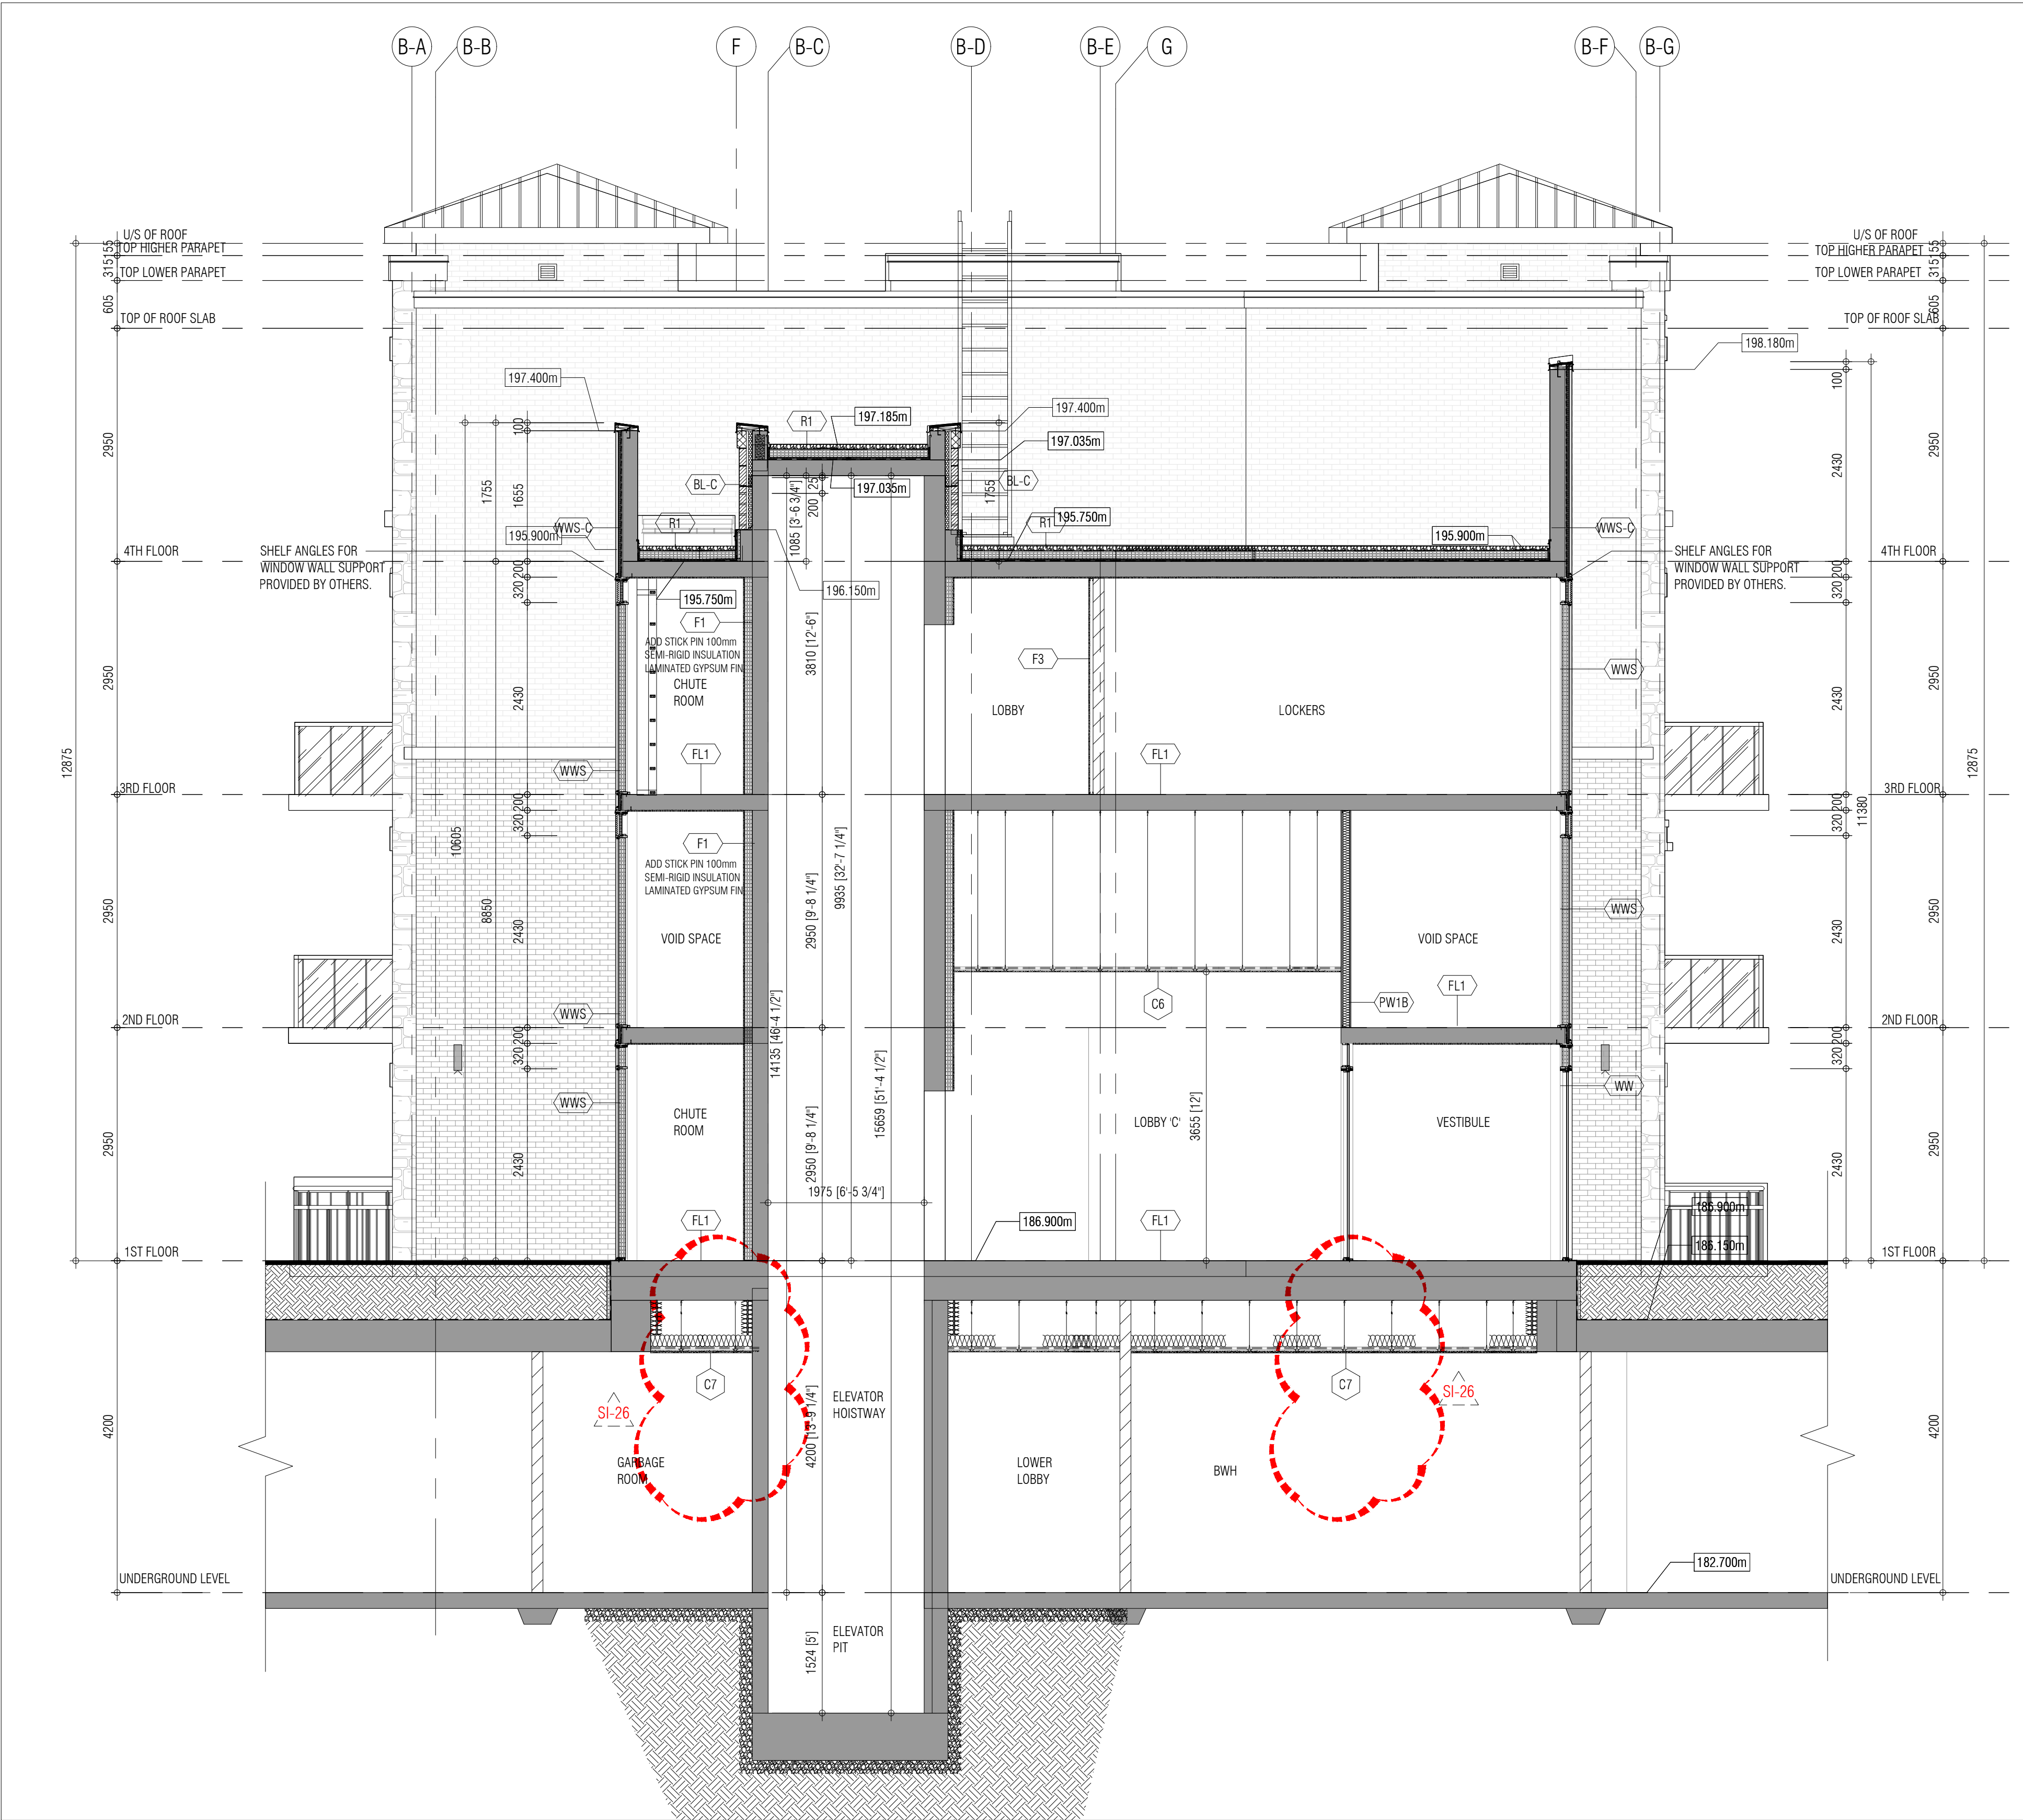

BUILDING SECTION 2
1:50 A503

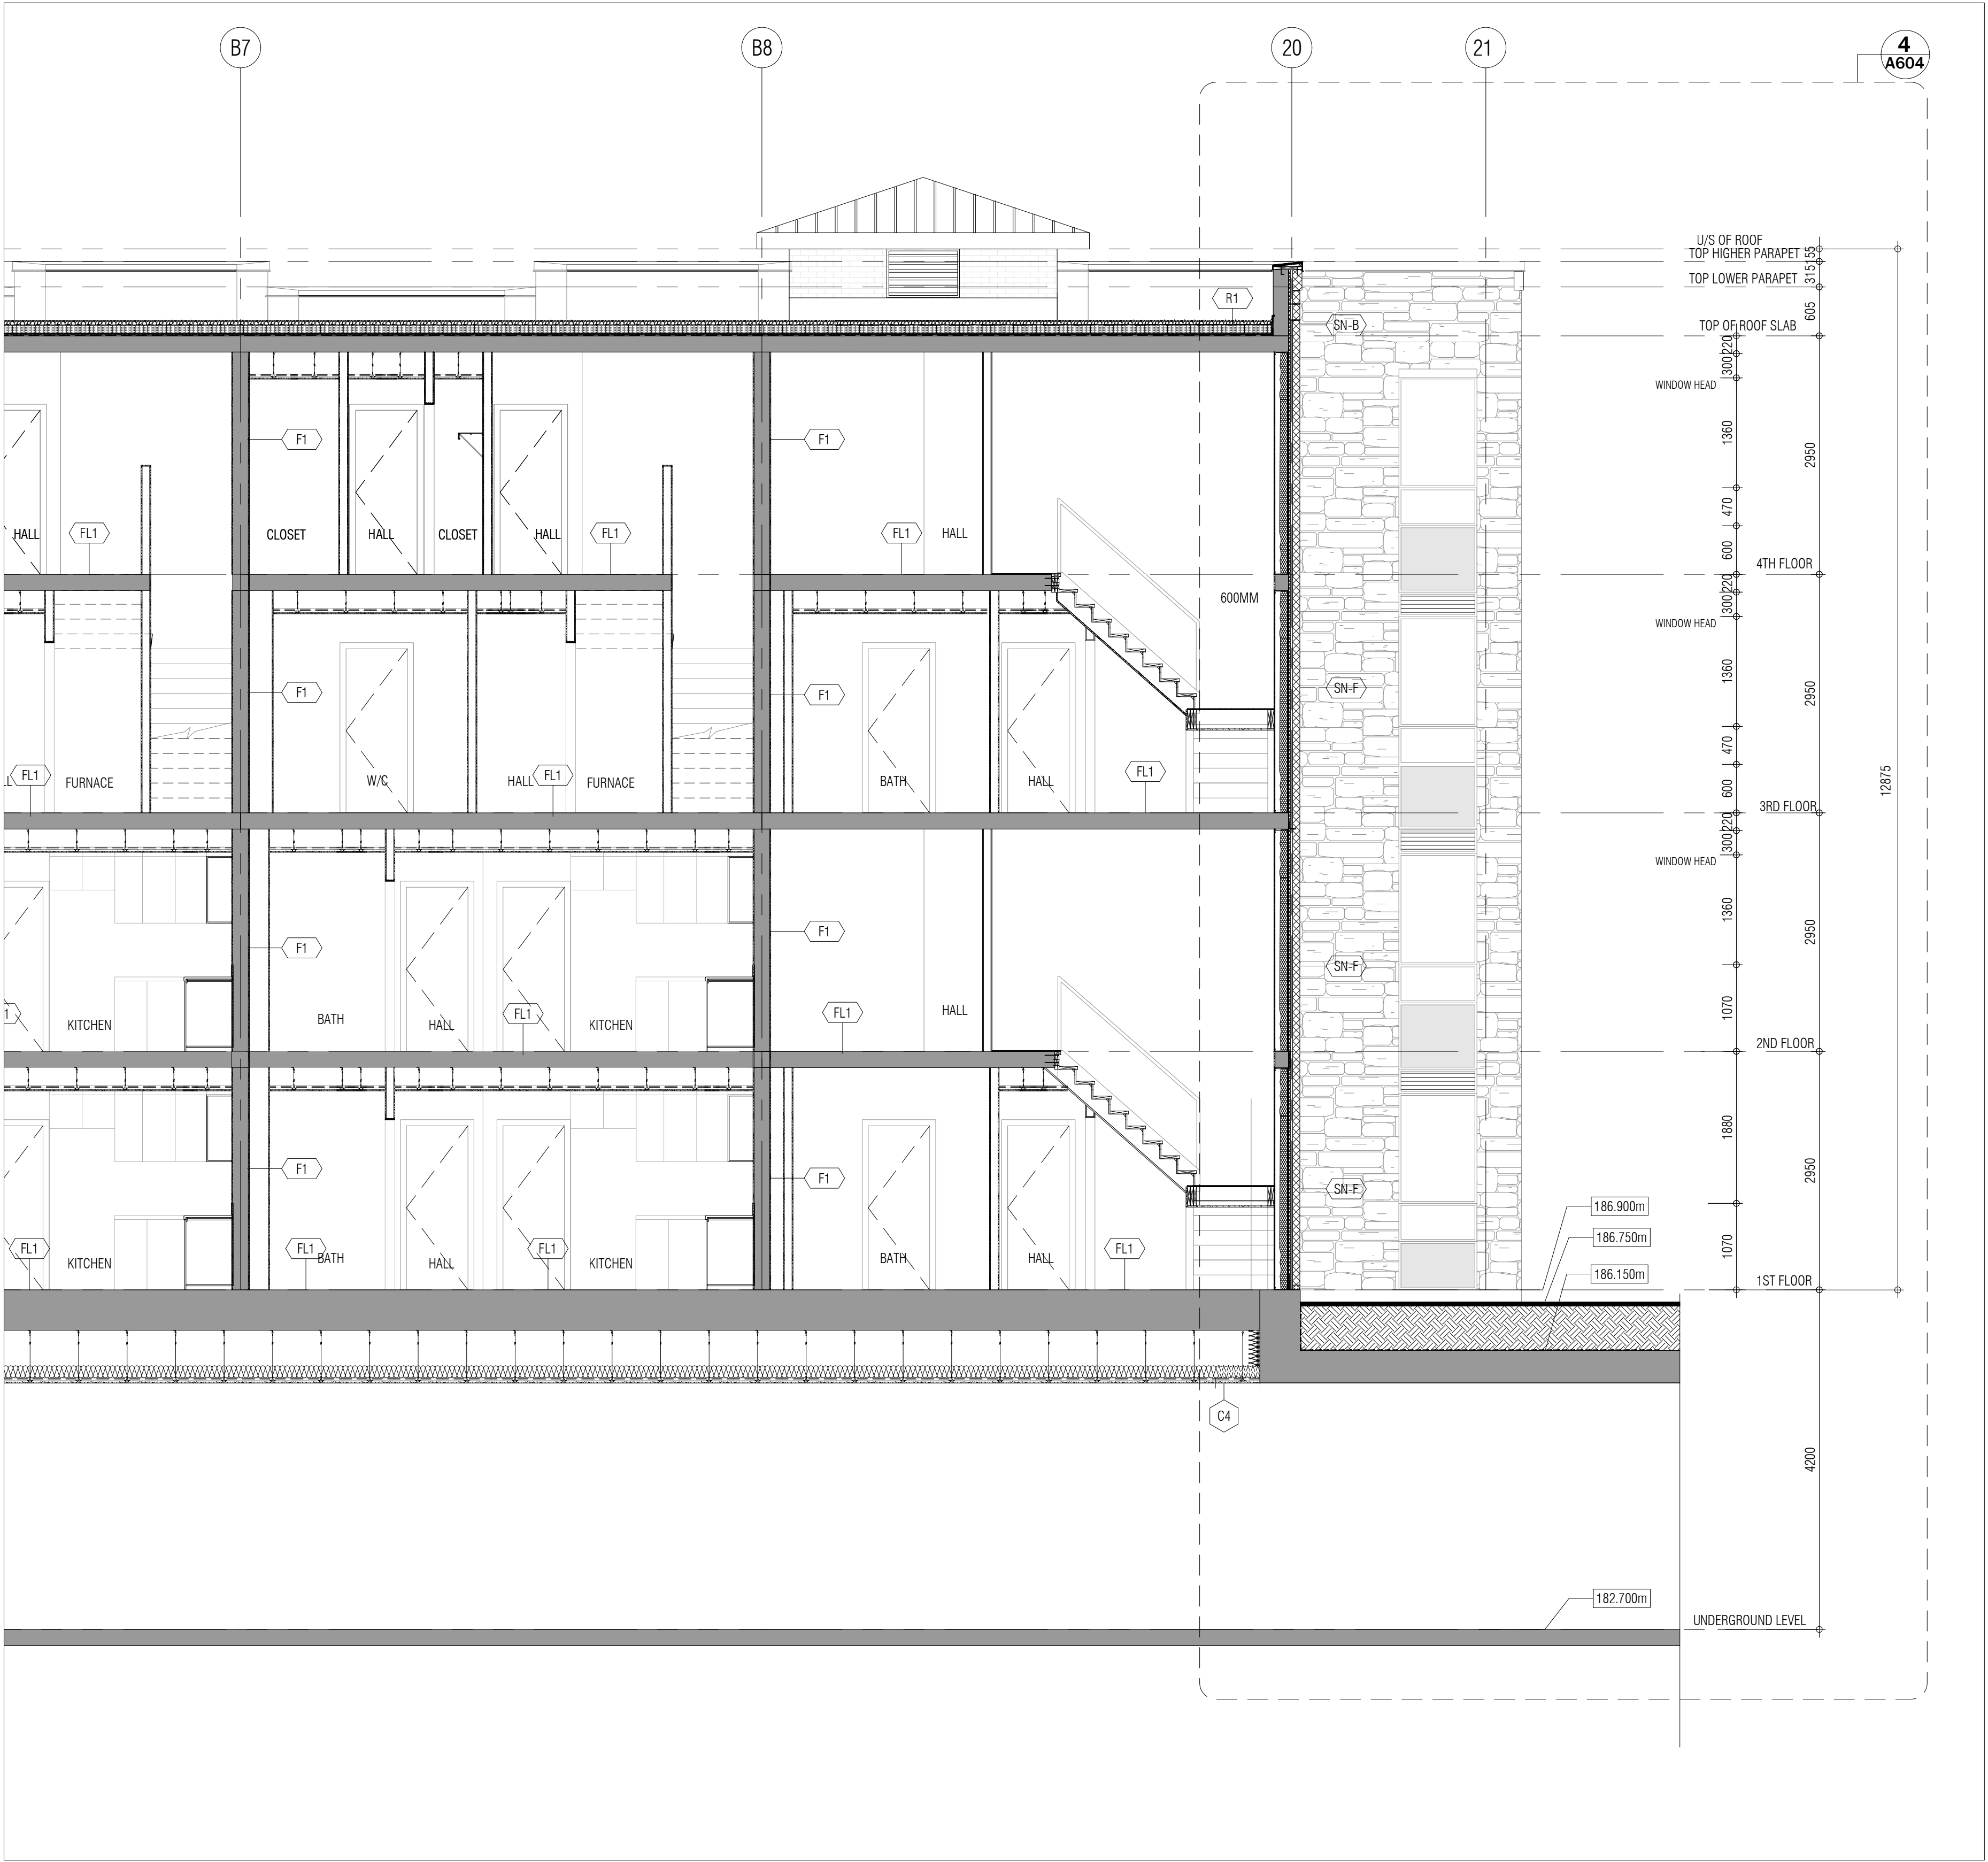

BUILDING SECTION 1
1:50 A503

- 01. Oct.07.2019 issued for tender
- 02. Mar.13.2020 issued for design coordination #2
- 03. Mar.16.2020 issued for addendum #2
- 04. Mar.16.2020 issued for addendum #3
- 05. Aug.24.2020 issued for addendum #4
- 06. Sept.28.2020 issued for permit
- 07. Oct.20.2020 issued for addendum #5
- 08. Nov.23.2020 issued for addendum #6
- 09. Dec.14.2020 issued for addendum #7
- 10. Jan.18.2021 issued for addendum #8
- 11. Mar.2.2021 issued for permit
- 12. Mar.09.2021 issued for addendum #9
- 13. Mar.10.2021 issued for addendum #9R
- 14. Mar.26.2021 issued for progress
- 15. May.14.2021 issued for Site Instruction #1
- 16. June.15.2021 issued for Site Instruction #2
- 17. July.7.2021 re-issued for permit
- 18. July.15.2021 issued for Site Instruction #3
- 19. July.27.2021 issued for Site Instruction #4
- 20. Aug.3.2021 issued for Site Instruction #5
- 21. Aug.18.2021 issued for Site Instruction #6
- 22. Aug.28.2021 Re-issued for permit
- 23. Sept.07.2021 issued for Site Instruction #7
- 24. Sept.09.2021 issued for Site Instruction #8
- 25. Sept.16.2021 issued for Building D Permit Revisions
- 26. Sept.22.2021 issued for Site Instruction #9
- 27. Oct.6.2021 Re-issued for permit
- 28. Oct.8.2021 issued for Site Instruction #10
- 29. Oct.28.2021 issued for Site Instruction #11
- 30. Nov.05.2021 issued for Site Instruction #12
- 31. Dec.3.2021 issued for Site Instruction #13
- 32. Dec.6.2021 issued for Site Instruction #14
- 33. Dec.7.2021 issued for Site Instruction #15
- 34. Jan.26.2022 issued for Site Instruction #16
- 35. Jan.31.2022 issued for Site Instruction #17
- 36. Mar.11.2022 issued for Site Instruction #18
- 37. Apr.29.2022 issued for Site Instruction #19
- 38. May.10.2022 issued for Site Instruction #20
- 39. May.24.2022 issued for Site Instruction #21
- 40. Aug.05.2022 issued for I.F.C.
- 41. Aug.18.2022 issued for Site Instruction #22
- 42. Aug.23.2022 issued for Site Instruction #23
- 43. Oct.12.2022 issued for Site Instruction #24
- 44. Feb.6.2023 issued for Site Instruction #25
- 45. Mar.22.2023 issued for Site Instruction #26

- 01. Apr.19.2021 issued to client
- issued for revisions

GRAZIANI CORAZZA ARCHITECTS

1120 SHARONDAVE DRIVE, SUITE 100 MISSISSAUGA, ONTARIO L4W 1C3
905.760.7001 P.905.760.7000 WWW.GC-ARCHITECTS.COM


ATTMAR + PALLESCHI DRIVE

BRAMPTON ONTARIO


PROJECT ARCHITECT: B. GRAZIANI
ASSISTANT DESIGNER: R. LINCOLN
DRAWN BY: G. C./F. C./M. B.
CHECKED BY: D. BIASSE/G. COLANGELO
PLOT DATE: MAR 22 2023
JOB #: 1331.15

BUILDING SECTION

REF. 1-A505 FOR CONTINUATION

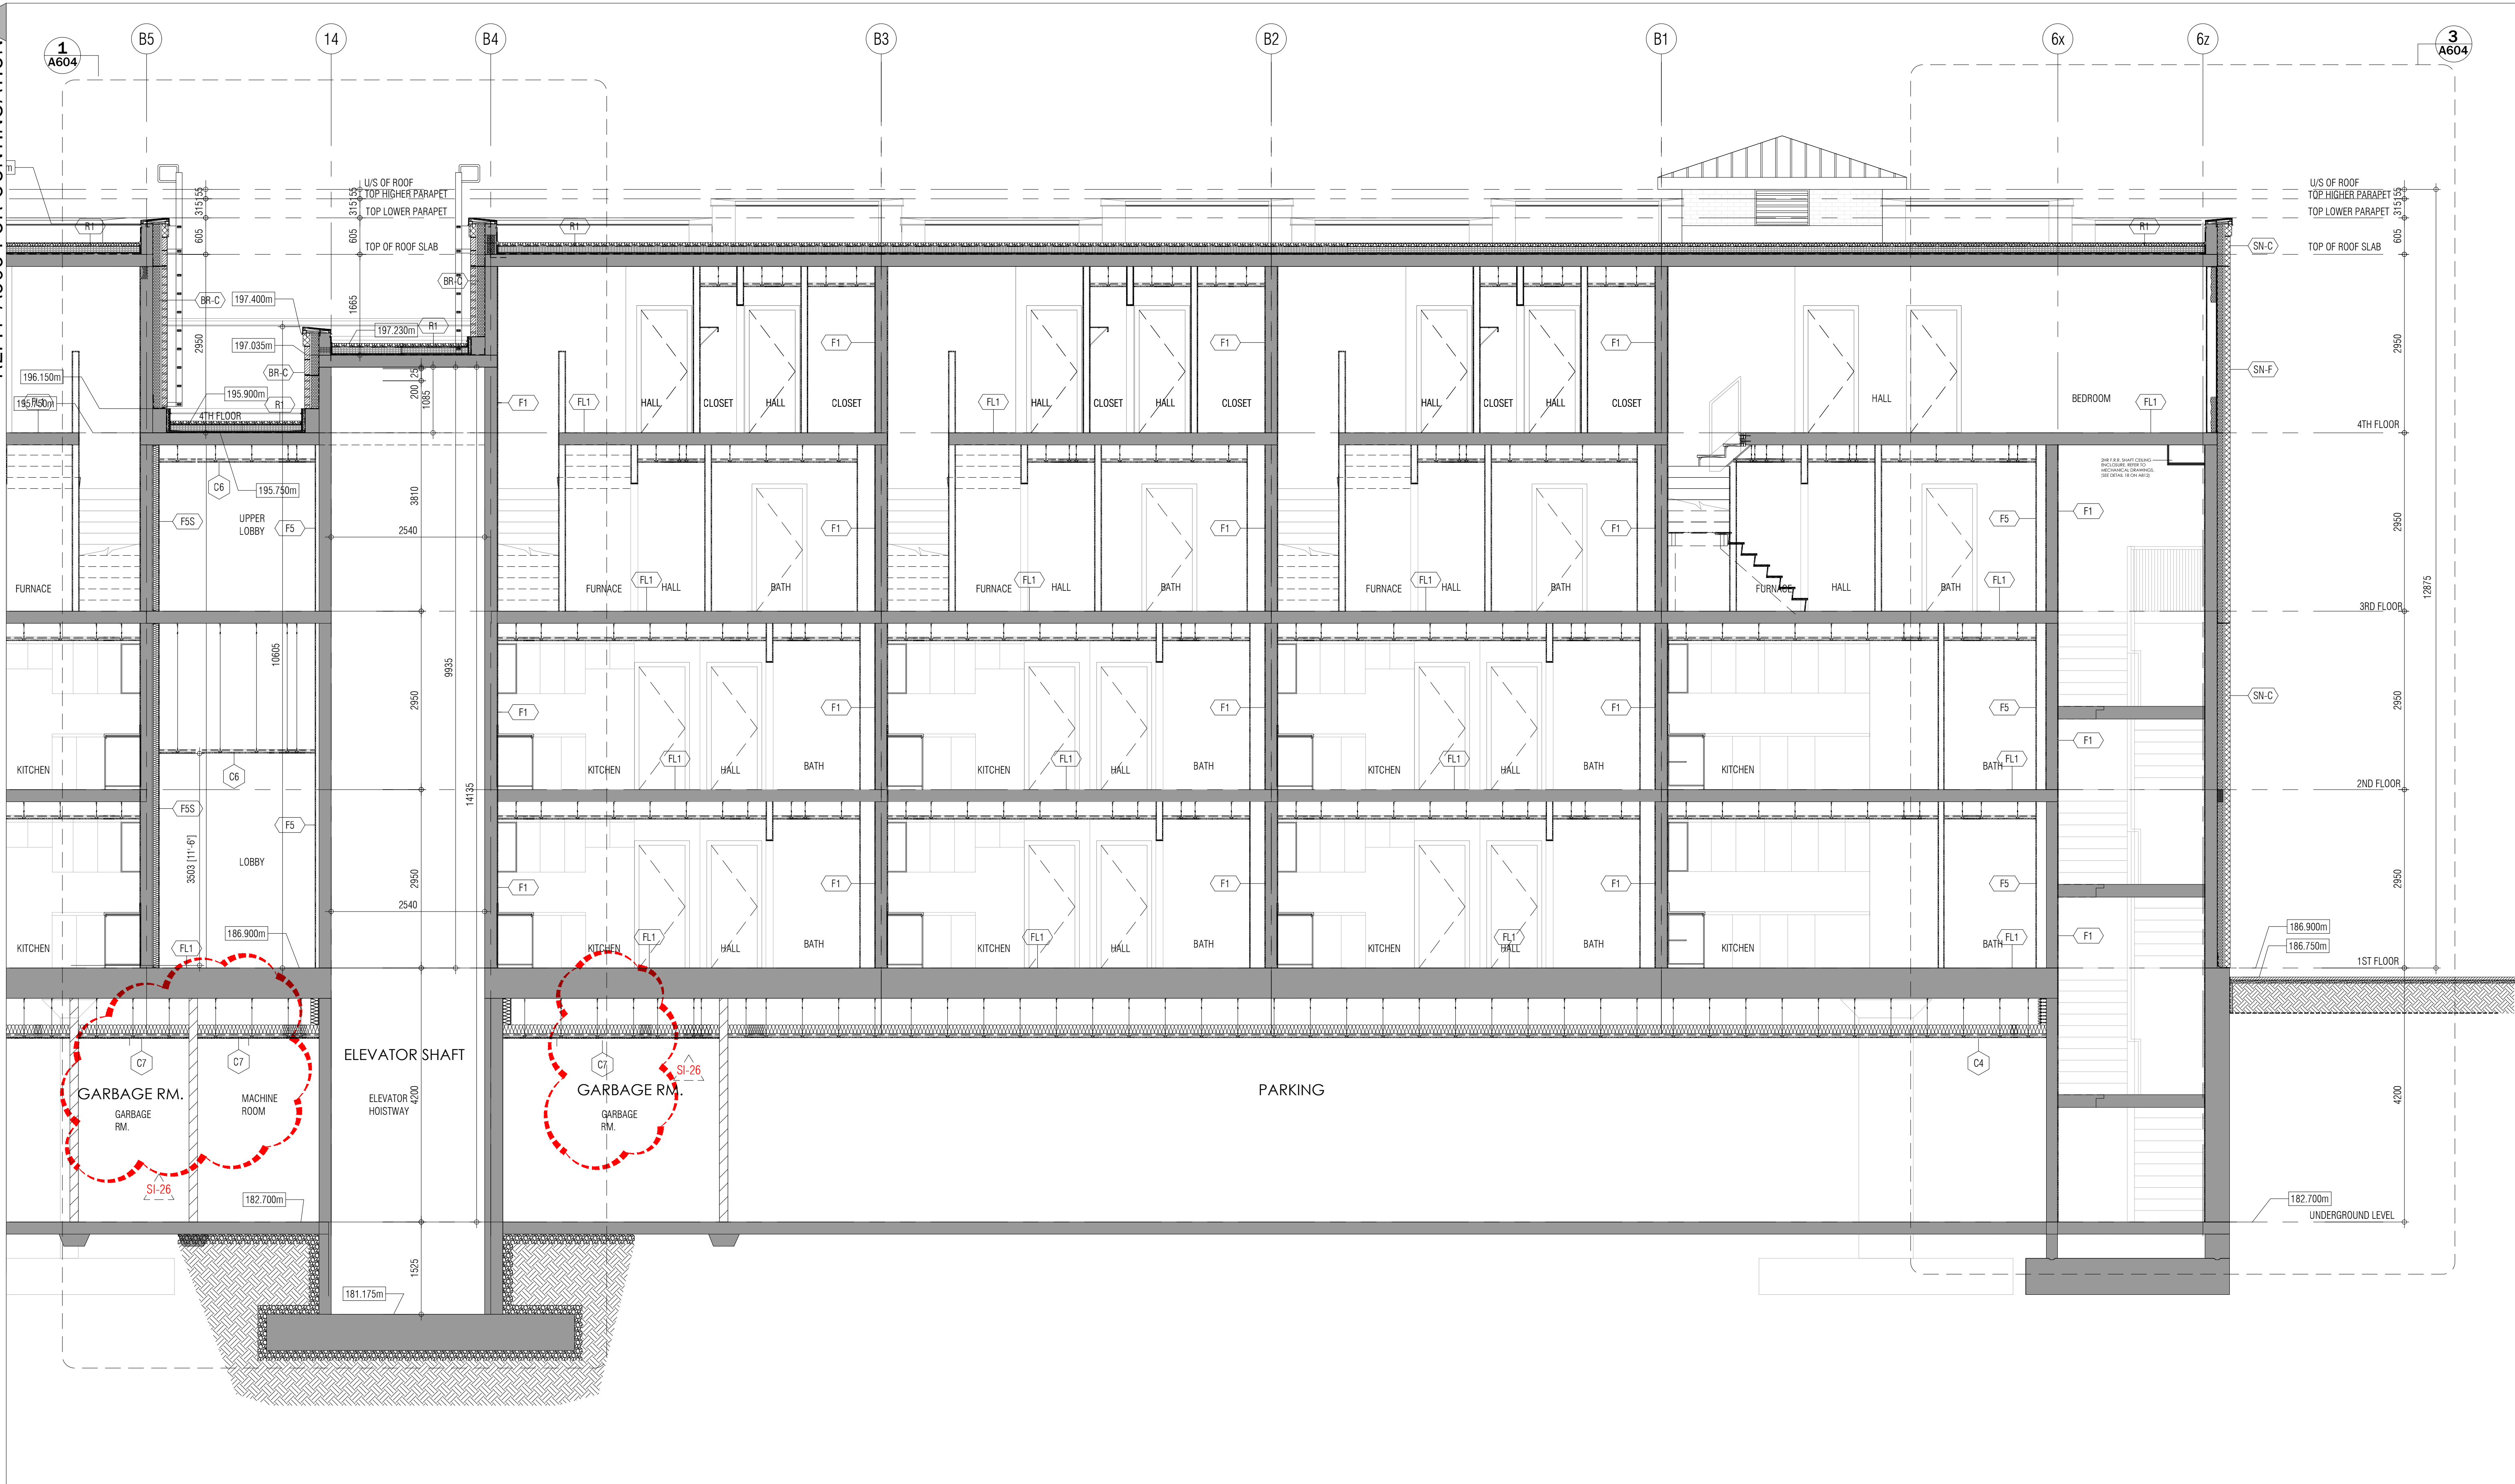

BUILDING SECTION 1
1/50 A504

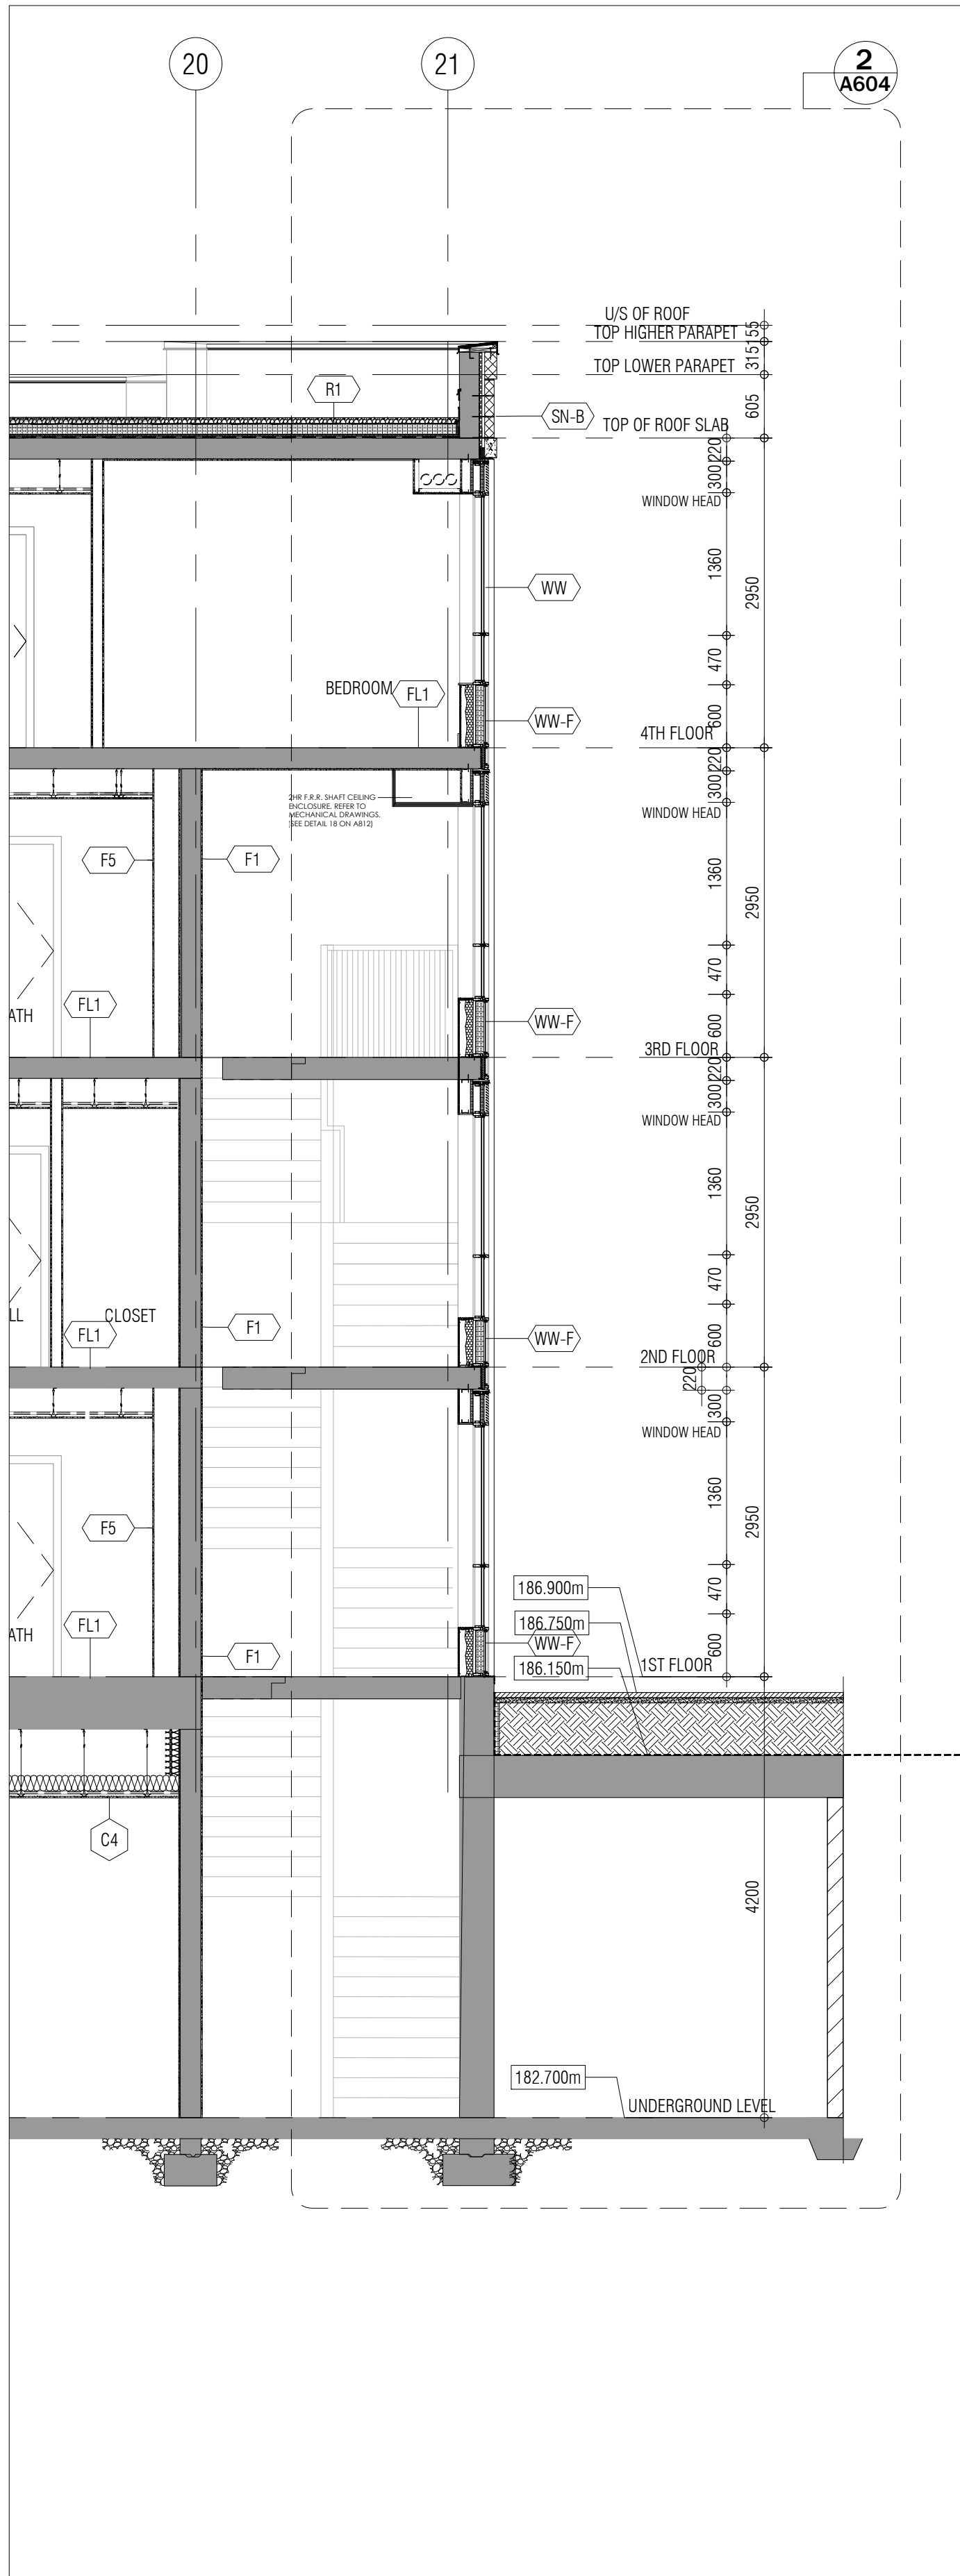

BLDG SEC.(WINDOW CONDITION) 1a
1/50 A504

THIS DRAWING IS AN INSTRUMENT OF SERVICE. IT IS PROVIDED BY AND IS THE PROPERTY OF GRAZIANI-CORAZZA ARCHITECTS INC. THE CONTRACTOR MUST VERIFY AND ACCEPT RESPONSIBILITY FOR ALL DIMENSIONS AND CONDITIONS OF THE SITE AND MUST NOTIFY GRAZIANI-CORAZZA ARCHITECTS INC. OF ANY DISCREPANCIES FROM THE SUPPLIED INFORMATION. GRAZIANI-CORAZZA ARCHITECTS INC. IS NOT RESPONSIBLE FOR THE ACCURACY OF SURVEY, STRUCTURAL, MECHANICAL, ELECTRICAL, AND OTHER ENGINEERING INFORMATION SHOWN ON THIS DRAWING. REFER TO THE APPROPRIATE ENGINEERING DRAWINGS BEFORE PROCEEDING WITH THE WORK. CONSTRUCTION MUST CONFORM TO ALL APPLICABLE CODES AND REQUIREMENTS OF THE AUTHORITIES HAVING JURISDICTION. UNLESS OTHERWISE NOTED, NO INVESTIGATION HAS BEEN UNDERTAKEN OR REPORTED ON BY THIS OFFICE IN REGARD TO THE ENVIRONMENTAL CONDITION OF THIS SITE.

THIS DRAWING IS NOT TO BE SCALED. ALL ARCHITECTURAL SYMBOLS INDICATED ON THIS DRAWING ARE GRAPHIC REPRESENTATIONS ONLY.

CONDITIONS FOR ELECTRONIC INFORMATION TRANSFER

ELECTRONIC INFORMATION IS SUPPLIED TO THE OTHER ASSOCIATED FIRMS TO ASSIST THEM IN THE EXECUTION OF THEIR WORK. REVIEW THE RECEIPTED FIRMS MUST DETERMINE THE COMPLETENESS, APPROPRIATENESS, RELIABILITY OF THE INFORMATION IN RESPECT TO THEIR PARTICULAR RESPONSIBILITY.

GRAZIANI-CORAZZA ARCHITECTS INC. SHALL NOT BE RESPONSIBLE FOR ERRORS, OMISSIONS, INCOMPLETENESS DUE TO LOSS OF INFORMATION IN WHOLE OR PART WHEN INFORMATION IS TRANSMITTED.

1. TRANSMISSION OF ANY LOSS OF DAMAGE TO THE RECEIVING ELECTRONIC SYSTEM WHEN INFORMATION IS TRANSMITTED.

- 01. Oct.07.2019 issued for tender
- 02. Mar.13.2020 issued for design coordination #2
- 03. Mar.16.2020 issued for addendum #2
- 04. Mar.16.2020 issued for addendum #3
- 05. Aug.24.2020 issued for addendum #4
- 06. Sept.28.2020 issued for permit
- 07. Oct.20.2020 issued for addendum #5
- 08. Nov.23.2020 issued for addendum #6
- 09. Dec.14.2020 issued for addendum #7
- 10. Jan.18.2021 issued for addendum #8
- 11. Mar.2.2021 issued for permit
- 12. Mar.09.2021 issued for addendum #9
- 13. Mar.10.2021 issued for addendum #9R
- 14. Mar.26.2021 issued for progress
- 15. May.14.2021 issued for Site Instruction #1
- 16. June.15.2021 issued for Site Instruction #2
- 17. July.7.2021 re-issued for permit
- 18. July.15.2021 issued for Site Instruction #3
- 19. July.27.2021 issued for Site Instruction #4
- 20. Aug.3.2021 issued for Site Instruction #5
- 21. Aug.18.2021 issued for Site Instruction #6
- 22. Aug.28.2021 re-issued for permit
- 23. Sept.07.2021 issued for Site Instruction #7
- 24. Sept.09.2021 issued for Site Instruction #8
- 25. Sept.16.2021 issued for Building D Permit Revisions
- 26. Sept.22.2021 issued for Site Instruction #9
- 27. Oct.6.2021 re-issued for permit
- 28. Oct.8.2021 issued for Site Instruction #10
- 30. Oct.28.2021 issued for Site Instruction #11
- 31. Nov.05.2021 issued for Site Instruction #12
- 32. Dec.3.2021 issued for Site Instruction #13
- 33. Dec.6.2021 issued for Site Instruction #14
- 34. Dec.7.2021 issued for Site Instruction #15
- 35. Jan.26.2022 issued for Site Instruction #16
- 36. Jan.31.2022 issued for Site Instruction #17
- 37. Mar.11.2022 issued for Site Instruction #18
- 38. Apr.29.2022 issued for Site Instruction #19
- 39. May.10.2022 issued for Site Instruction #20
- 40. May.24.2022 issued for Site Instruction #21
- 41. Aug.04.2022 issued for I.F.C.
- 42. Aug.18.2022 issued for Site Instruction #22
- 43. Aug.23.2022 issued for Site Instruction #23
- 44. Oct.12.2022 issued for Site Instruction #24
- 45. Feb.6.2023 issued for Site Instruction #25
- 46. Mar.22.2023 issued for Site Instruction #26

01. Apr.19.2021 issued to client

issued for revisions

GRAZIANI
CORAZZA
ARCHITECTS

1100 SHAWNEE DRIVE, SUITE 100 MISSISSAUGA, ONTARIO L4W 1C3
905.760.7001 P.905.760.7000 WWW.GC-ARCHITECTS.COM

RESIDENTIAL


ATTMAR + PALLESCHI DRIVE

BRAMPTON ONTARIO

PROJECT ARCHITECT: B.GRAZIANI
ASSISTANT DESIGNER: R.LINCOLN
DRAWN BY: G.C./F.C./M.B.
CHECKED BY: D.BIASE/G.COLANGELO
PLOT DATE: MAR.22.2023
JOB #: 1331.15

BUILDING SECTION

REF. 2-A505 FOR CONTINUATION

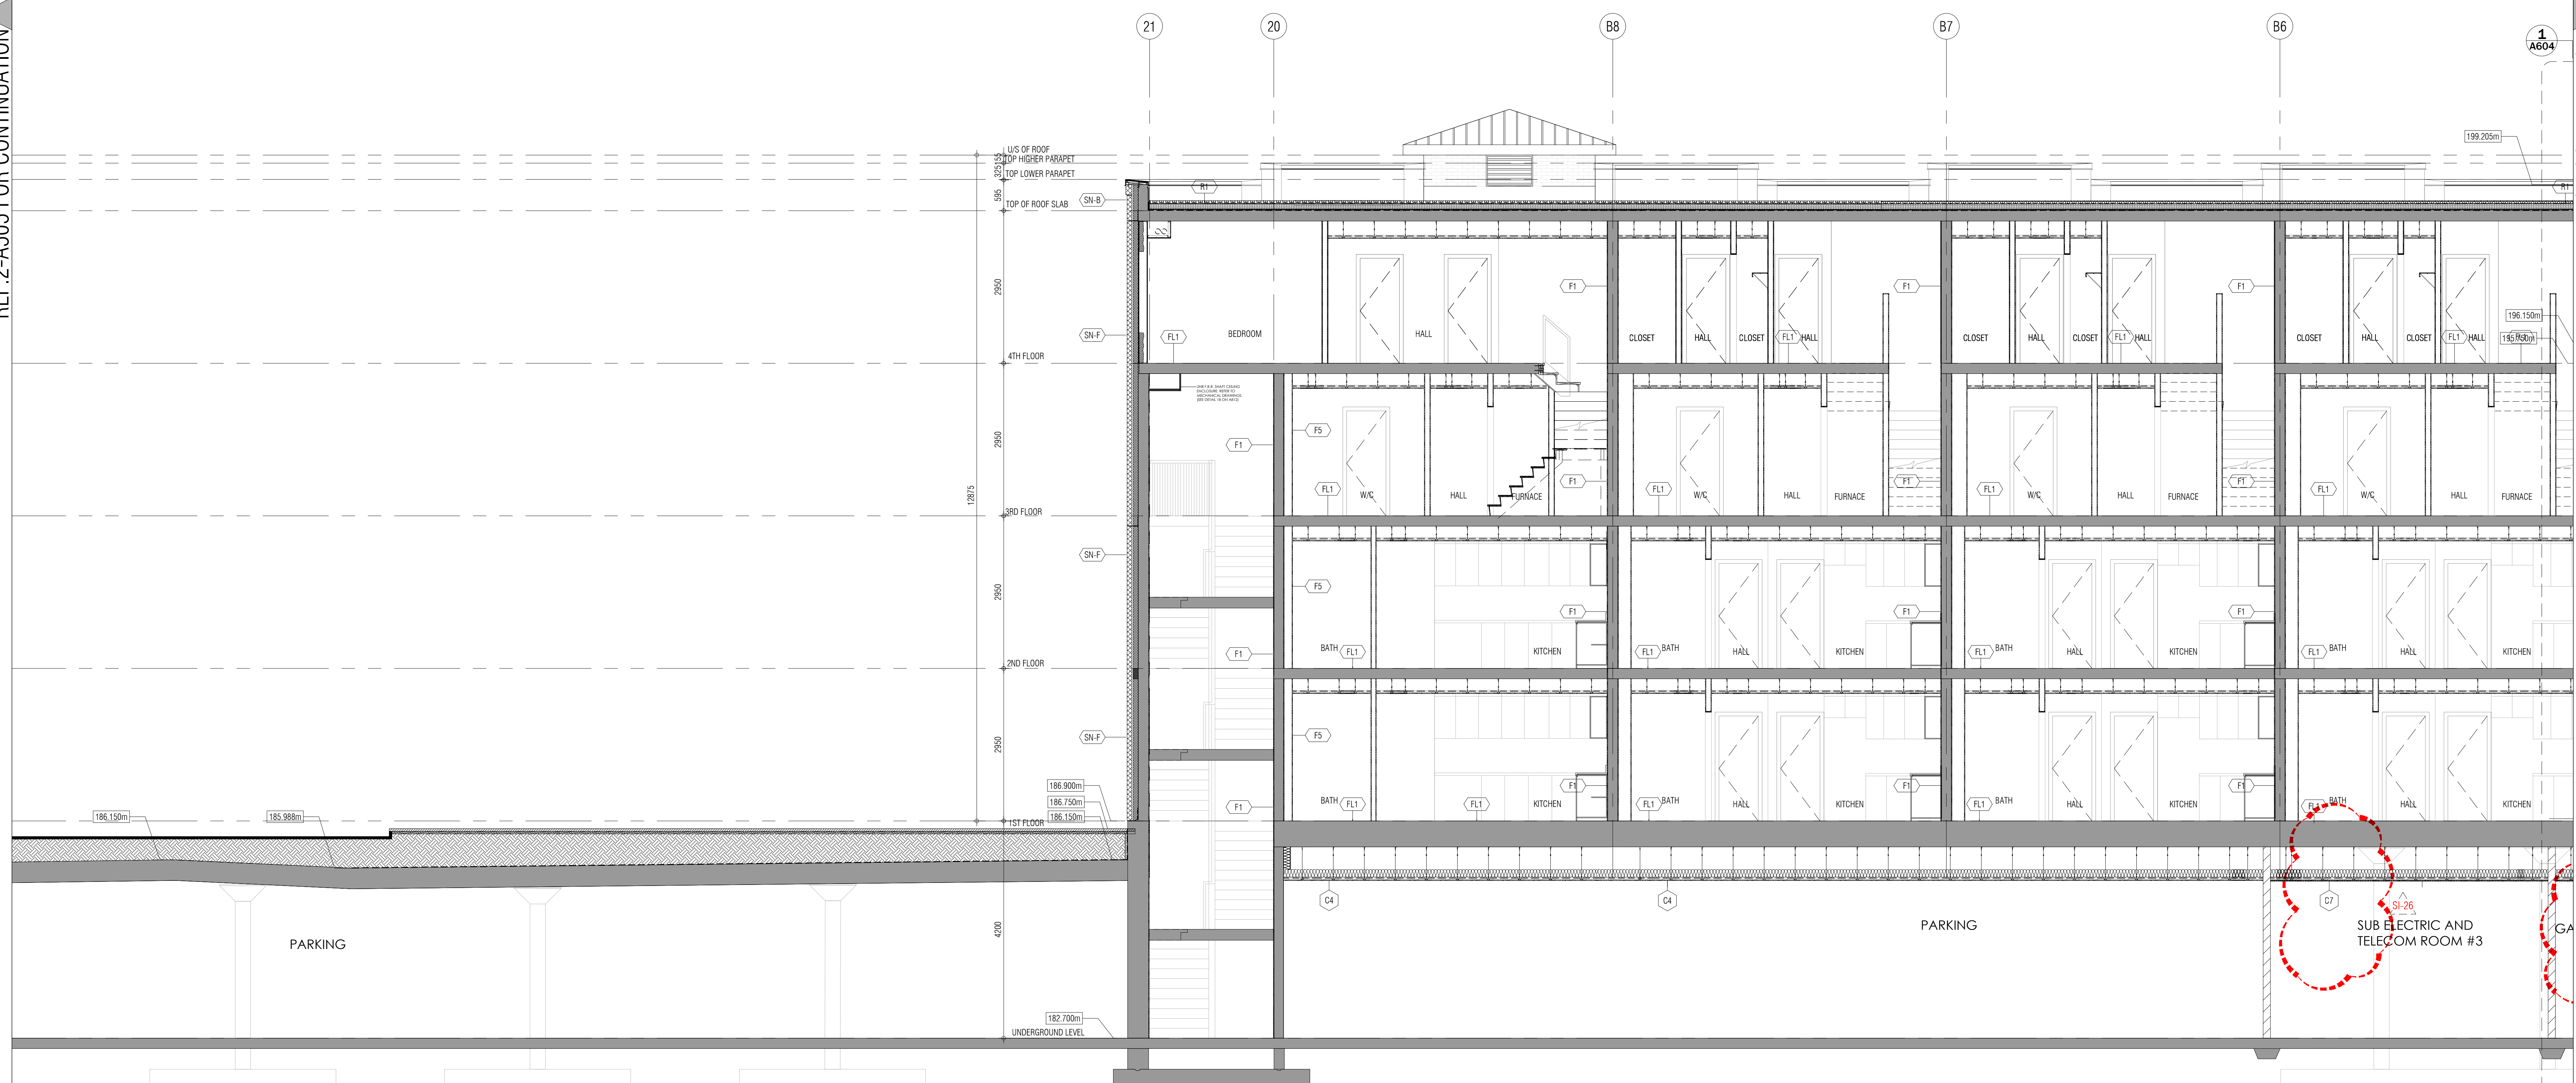


REF.1-A504 FOR CONTINUATION

THE CONTRACTOR AGREES TO REFER TO THE APPROPRIATE ENGINEERING DRAWINGS BEFORE PROCEEDING WITH THE WORK. CONSTRUCTION MUST CONFORM TO ALL APPLICABLE CODES AND REGULATIONS. ANY VIOLATION OF THESE TERMS WILL BE CONSIDERED A BREACH OF CONTRACT. NO INVESTIGATION IS TO BE UNDERTAKEN OR REPORTED ON IF THE CONTRACTOR HAS BEEN ADVISED BY THE ARCHITECT OF ANY VIOLATIONS. THIS DRAWING IS NOT TO BE USED AS AN ARCHITECTURAL SYMBOLS REQUIRED ON THIS DRAWING ARE GRAPHIC REPRESENTATIONS ONLY.


THIS DRAWING IS THE PROPERTY OF DRAKON-COARZA ARCHITECTS INC. INFORMATION IS SUPPLIED TO THE ABOVE ASSOCIATED PARTIES FOR THEM TO ASSIST THEM IN THE EXECUTION OF THEIR WORK. HOWEVER, THE INCIDENT PARTIES ARE NOT TO BE HELD RESPONSIBLE FOR ANY VIOLATIONS OF THE INFORMATION IN THIS RESPECT TO THEIR PARTICULAR RESPONSIBILITY.

DRAKON-COARZA ARCHITECTS INC. SHALL NOT BE RESPONSIBLE FOR ANY VIOLATIONS OF THE INFORMATION IN THIS DRAWING OR INFORMATION IN WHOLE OR PART WHEN INFORMATION IS TRANSFERRED TO ANY OTHER PARTY WITHOUT THE WRITTEN PERMISSION OF DRAKON-COARZA ARCHITECTS INC. WHEN INFORMATION IS TRANSFERRED, THE CONTRACTOR AGREES TO BE RESPONSIBLE FOR THE INFORMATION IN THAT SYSTEM WHEN INFORMATION IS TRANSFERRED.

Oct 07 2019	issued for tender	
Mar 13 2020	issued for design coordination #2	
Mar 16 2020	issued for addendum #2	
Mar 16 2020	issued for addendum #3	
Aug 24 2020	issued for addendum #4	
Sep 28 2020	issued for permit	
Oct 20 2020	issued for addendum #5	
Nov 23 2020	issued for addendum #6	
Dec 14 2020	issued for addendum #7	
Jan 18 2021	issued for addendum #8	
Mar 2 2021	issued for permit	
Mar 09 2021	issued for addendum #9	
Mar 10 2021	issued for addendum #9B	
Mar 16 2021	issued for progress	
May 14 2021	issued for Site Instruction #1	
June 15 2021	issued for Site Instruction #2	
July 7 2021	Re-issued for permit	
July 15 2021	issued for Site Instruction #3	
July 21 2021	issued for Site Instruction #4	
Aug 3 2021	issued for Site Instruction #5	
Aug 18 2021	issued for Site Instruction #6	
Aug 28 2021	Re-issued for permit.	
Sep 07 2021	issued for Site Instruction #7	
Sep 27 2021	issued for Site Instruction #8	
Sep 28 2021	issued for Building Permit Revisions	
Sep 28 2021	issued for Site Instruction #9	
Oct 2 2021	Re-issued for permit.	
Oct 28 2021	issued for Site Instruction #10	
Oct 28 2021	issued for Site Instruction #11	
Nov 05 2021	issued for Site Instruction #12	
Dec 3 2021	issued for Site Instruction #13	
Dec 6 2021	issued for Site Instruction #14	
Dec 7 2021	issued for Site Instruction #15	
Jan 26 2022	issued for Site Instruction #16	
Mar 31 2022	issued for Site Instruction #17	
Jun 1 2022	issued for Site Instruction #18	
Apr 29 2022	issued for Site Instruction #19	
May 10 2022	issued for Site Instruction #20	
Mar 23 2022	issued for Site Instruction #21	
Aug 06 2022	issued for I.F.C.	
Aug 28 2022	issued for Site Instruction #22	
Aug 28 2022	issued for Site Instruction #23	
Oct 12 2022	issued for Site Instruction #24	
Feb 6 2023	issued for Site Instruction #25	
Mar 23 2023	issued for Site Instruction #26	

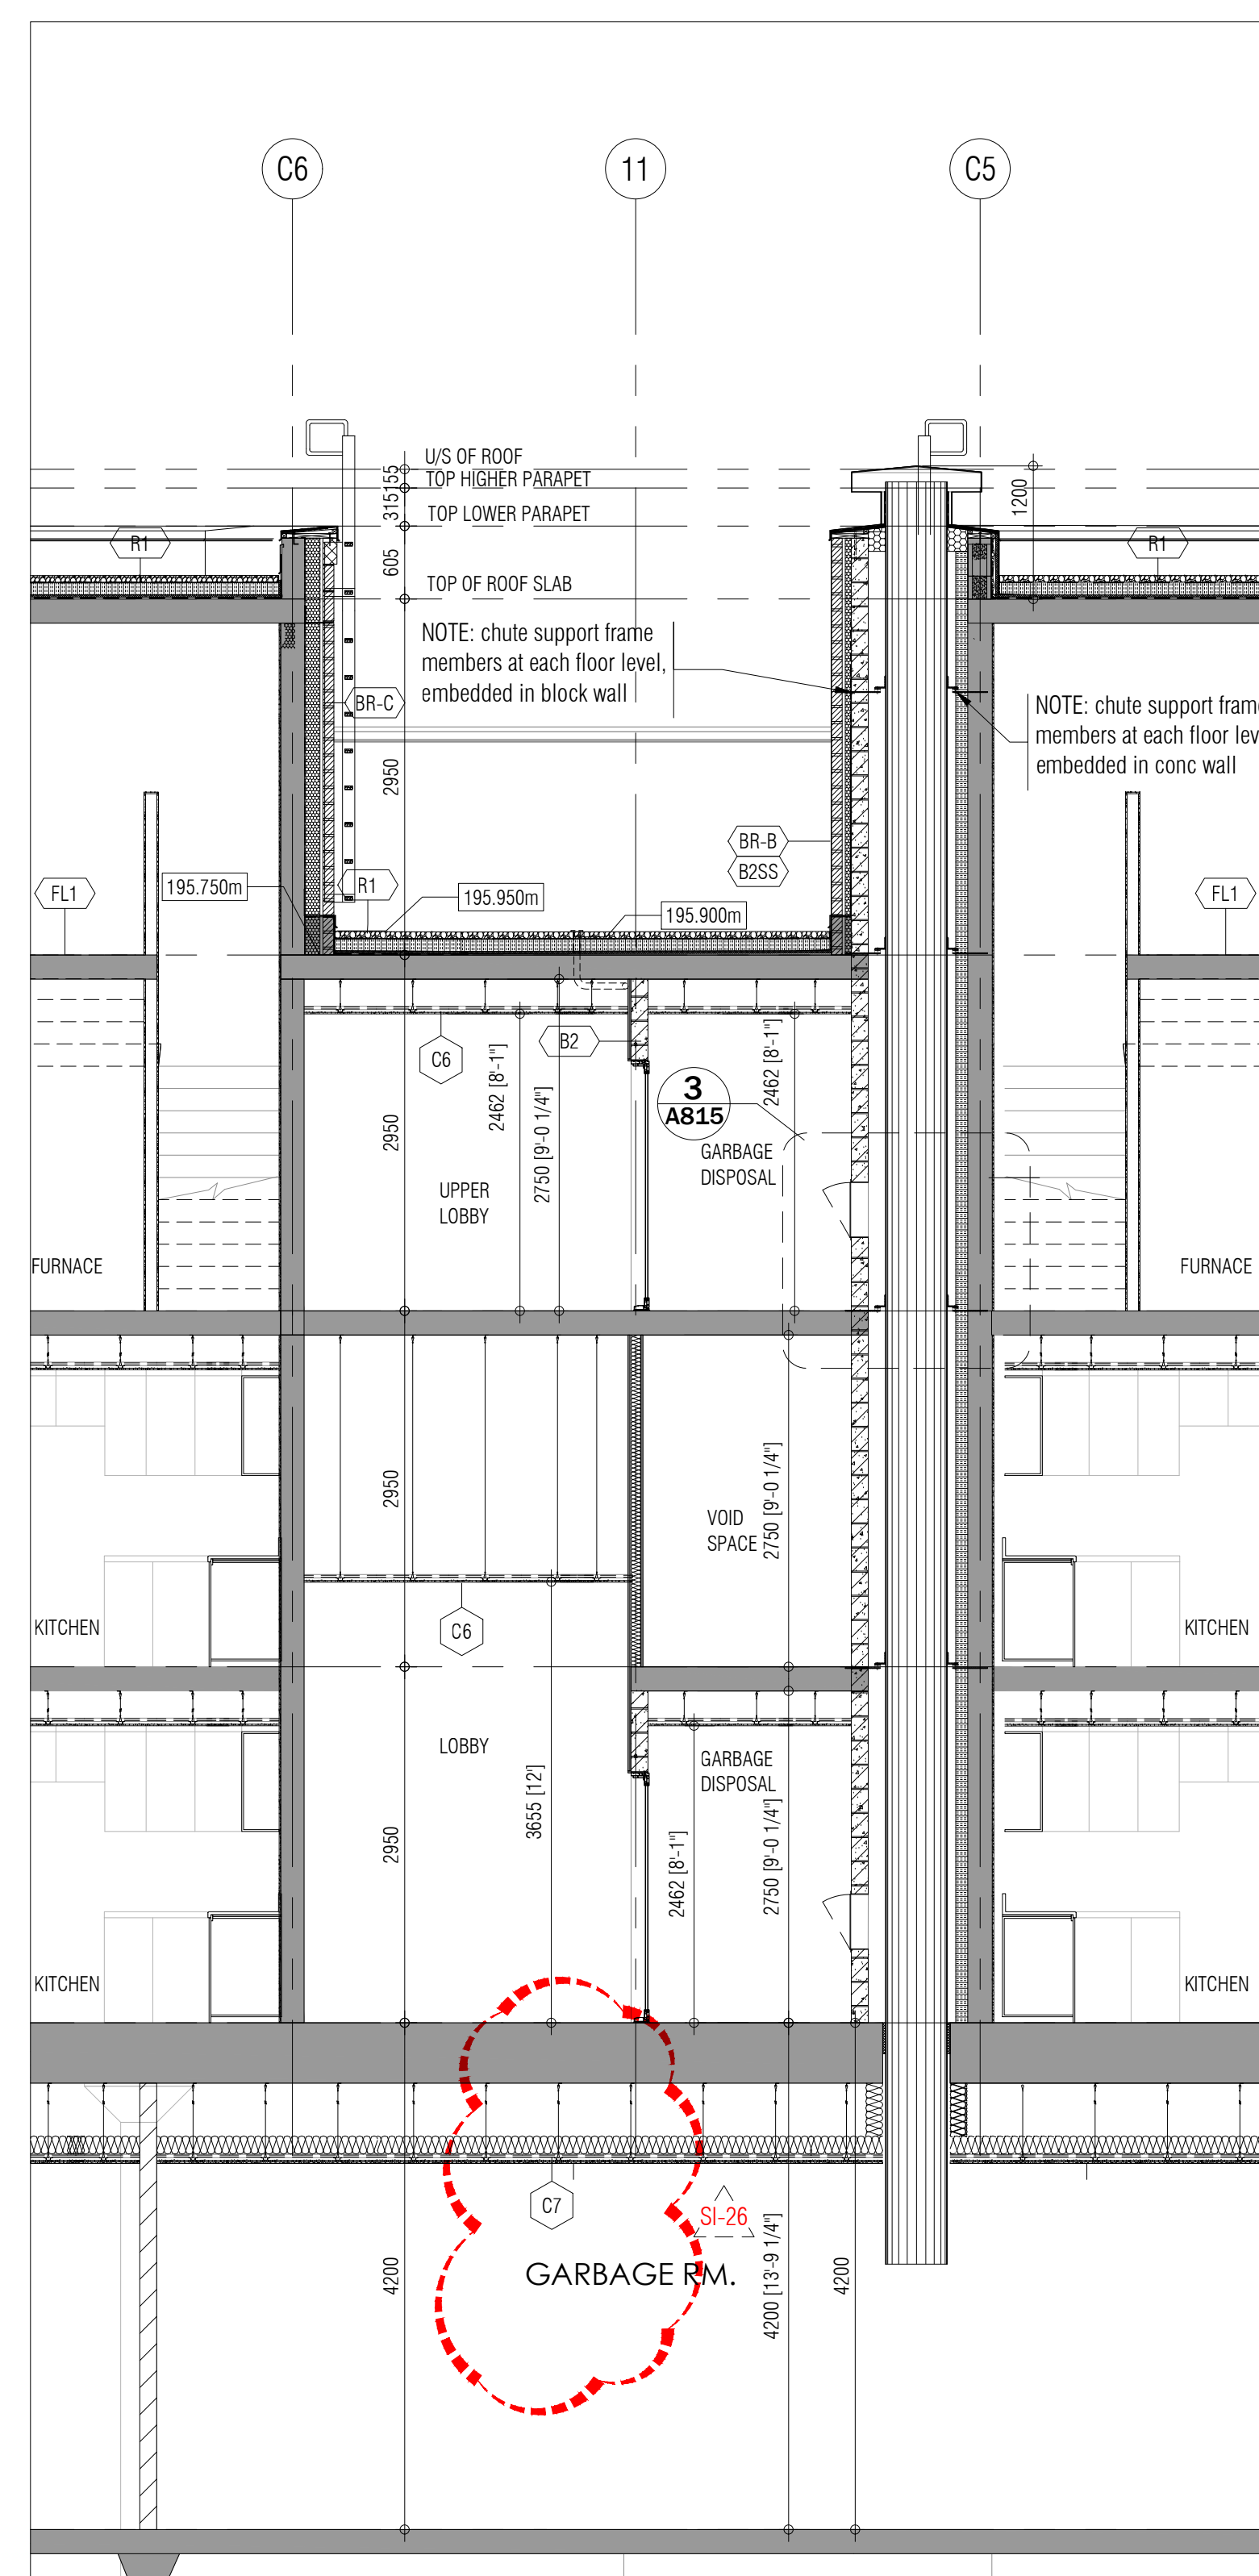

BUILDING SECTION AT CHUTE 3
1:50 A505

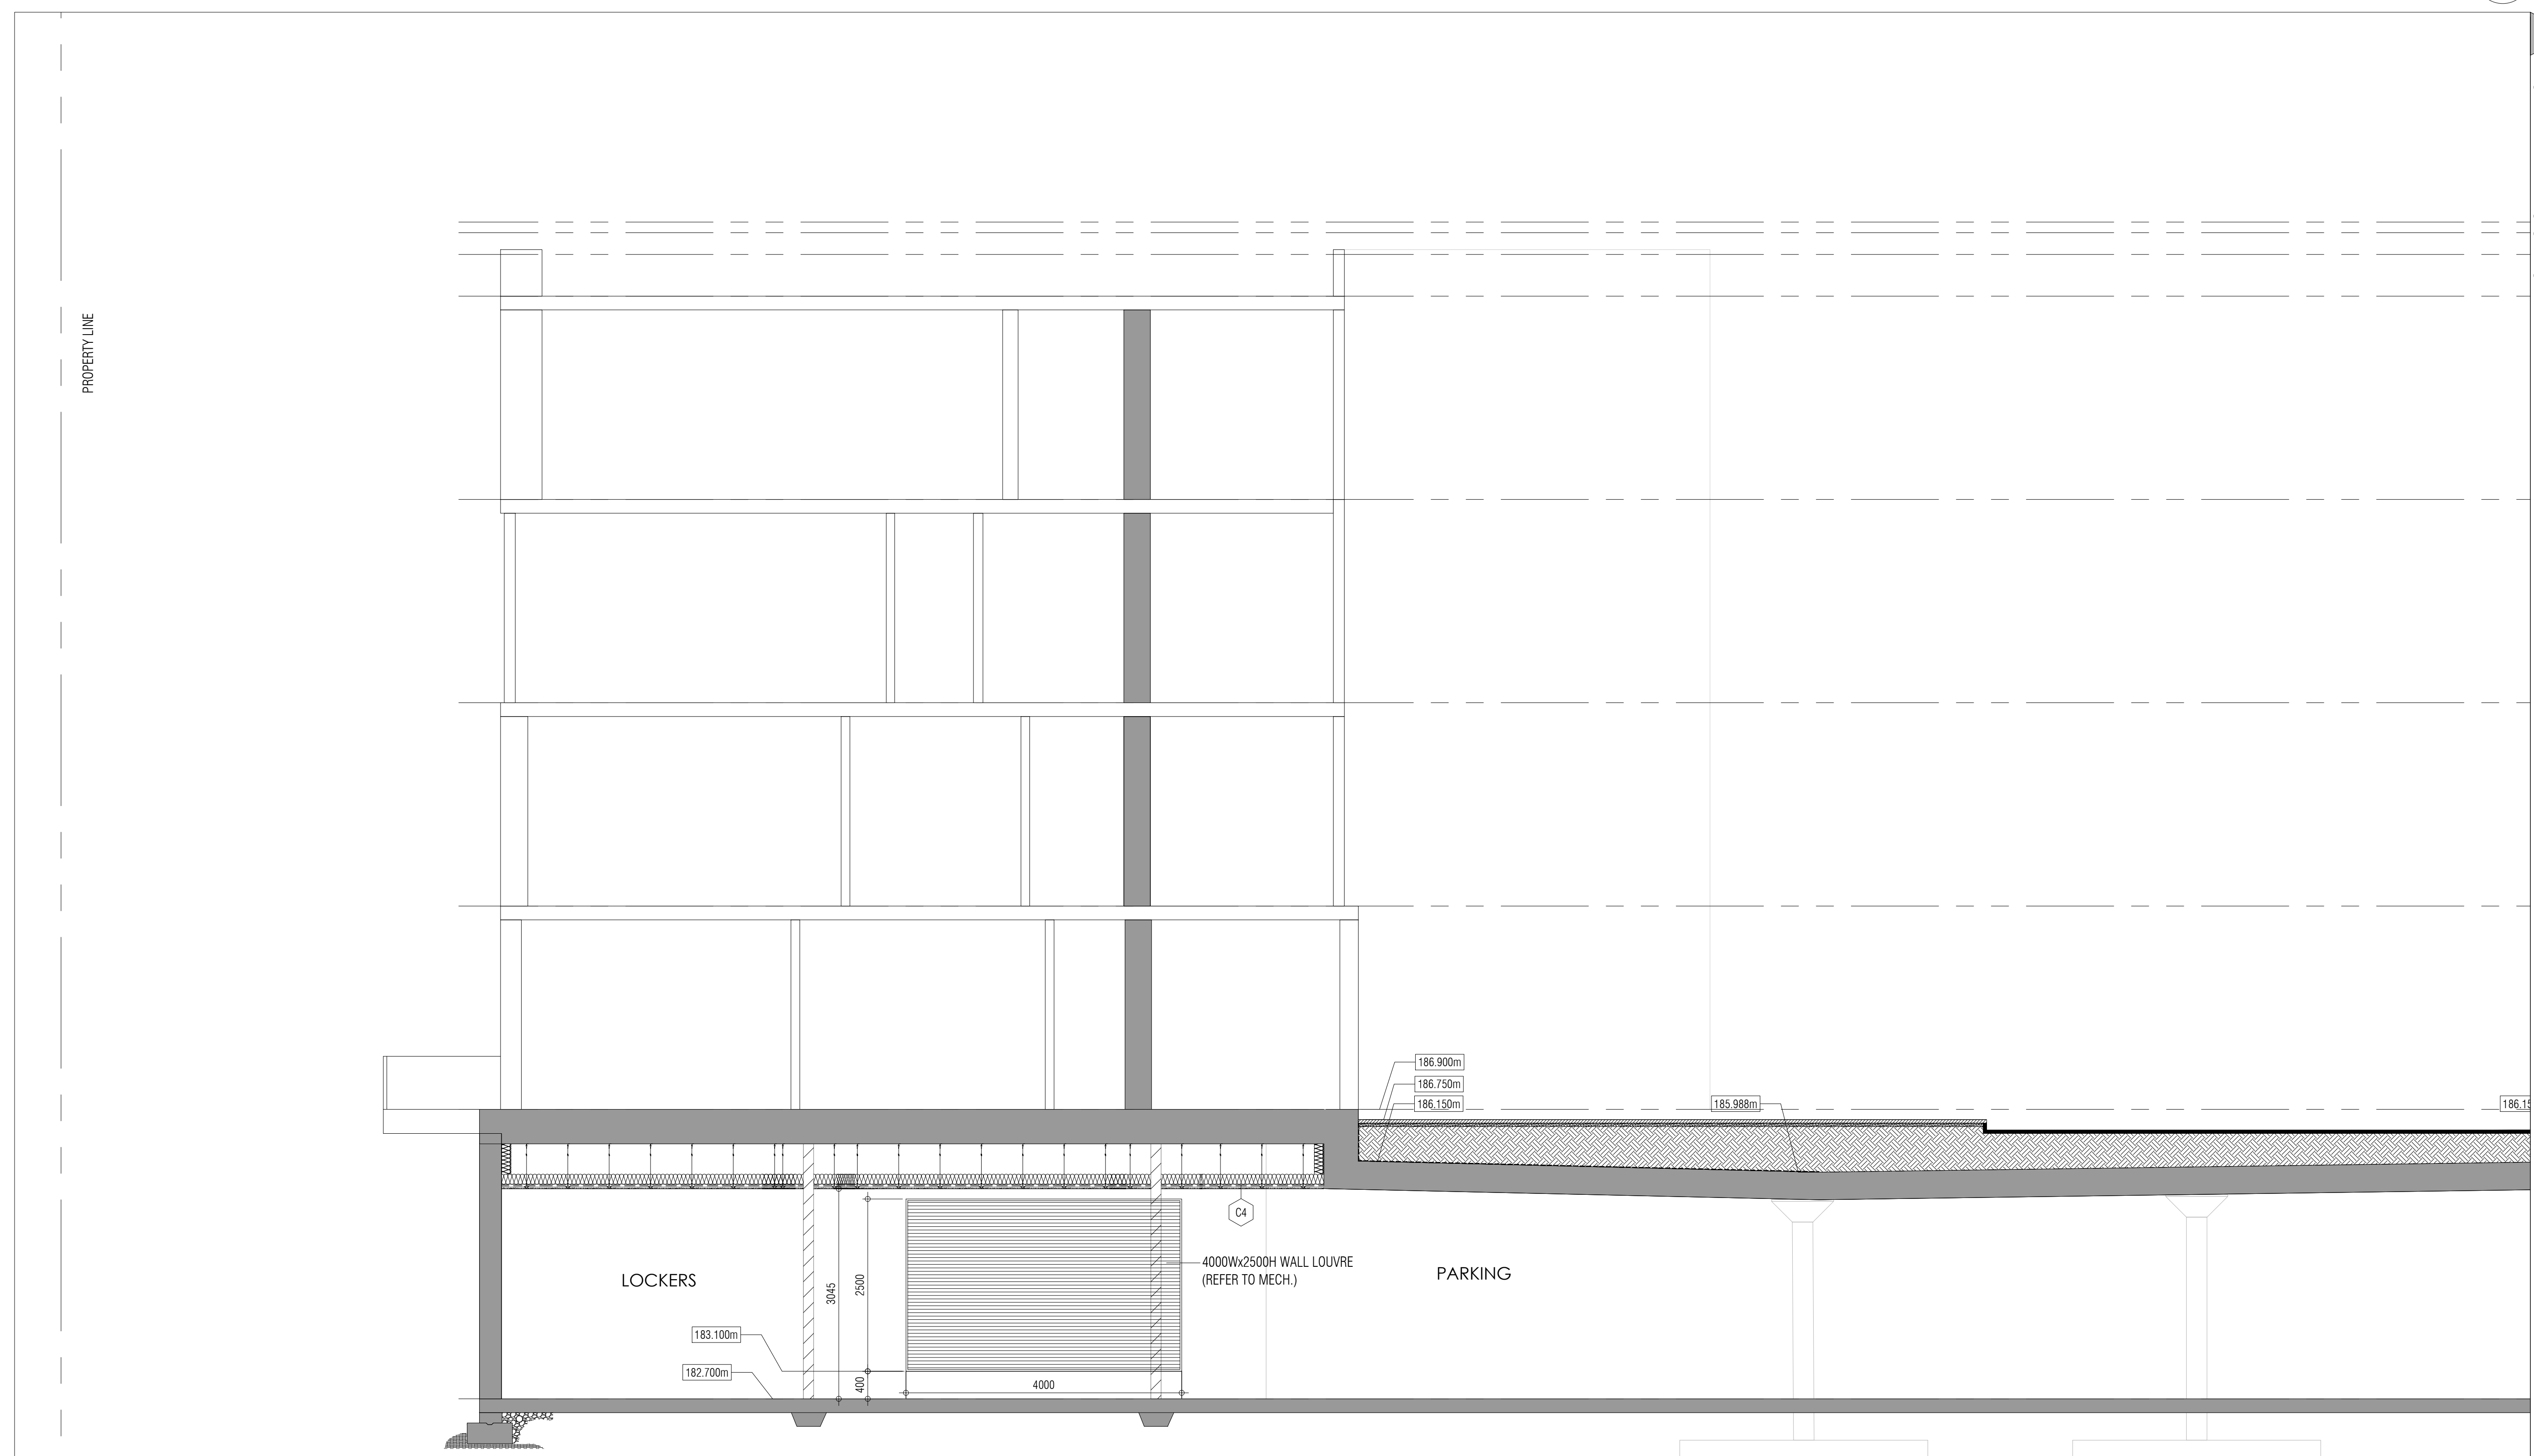

BUILDING SECTION 2
1:50 A505


REF.1-A505 FOR CONTINUATION

			


BUILDING SECTION

:50 **A505**


TITLEBLOCK SIZE: 915 x 1200

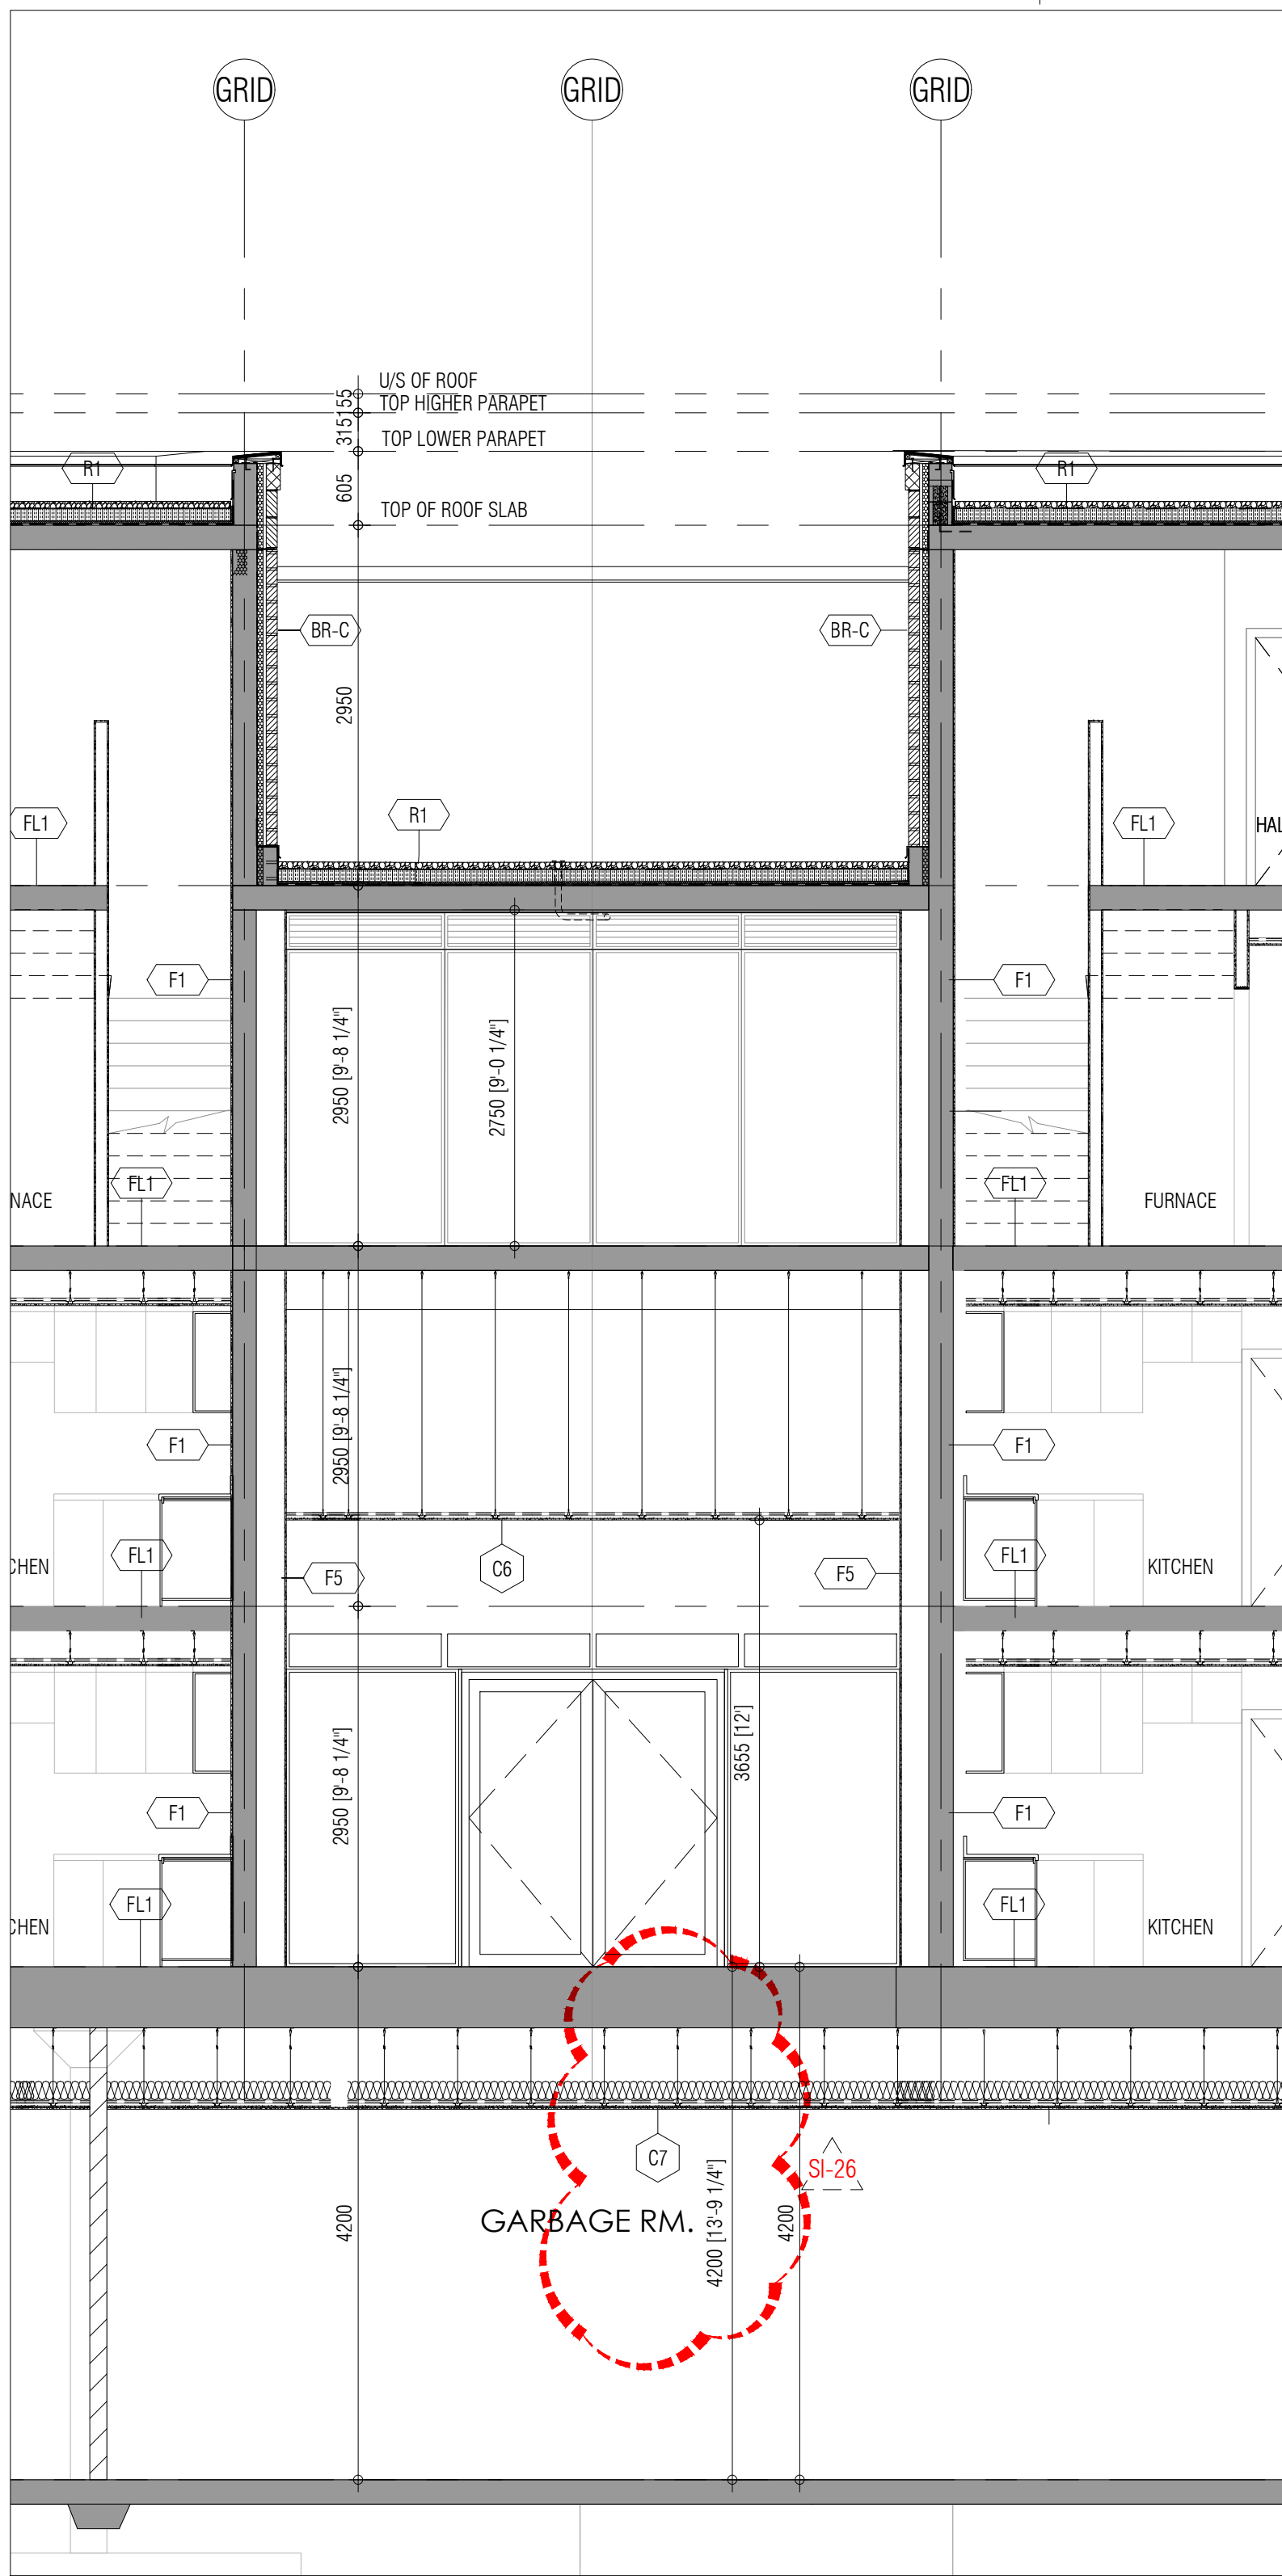

BUILDING SECTION AT LINK - HIGH LOBBY 1
1:30 A506

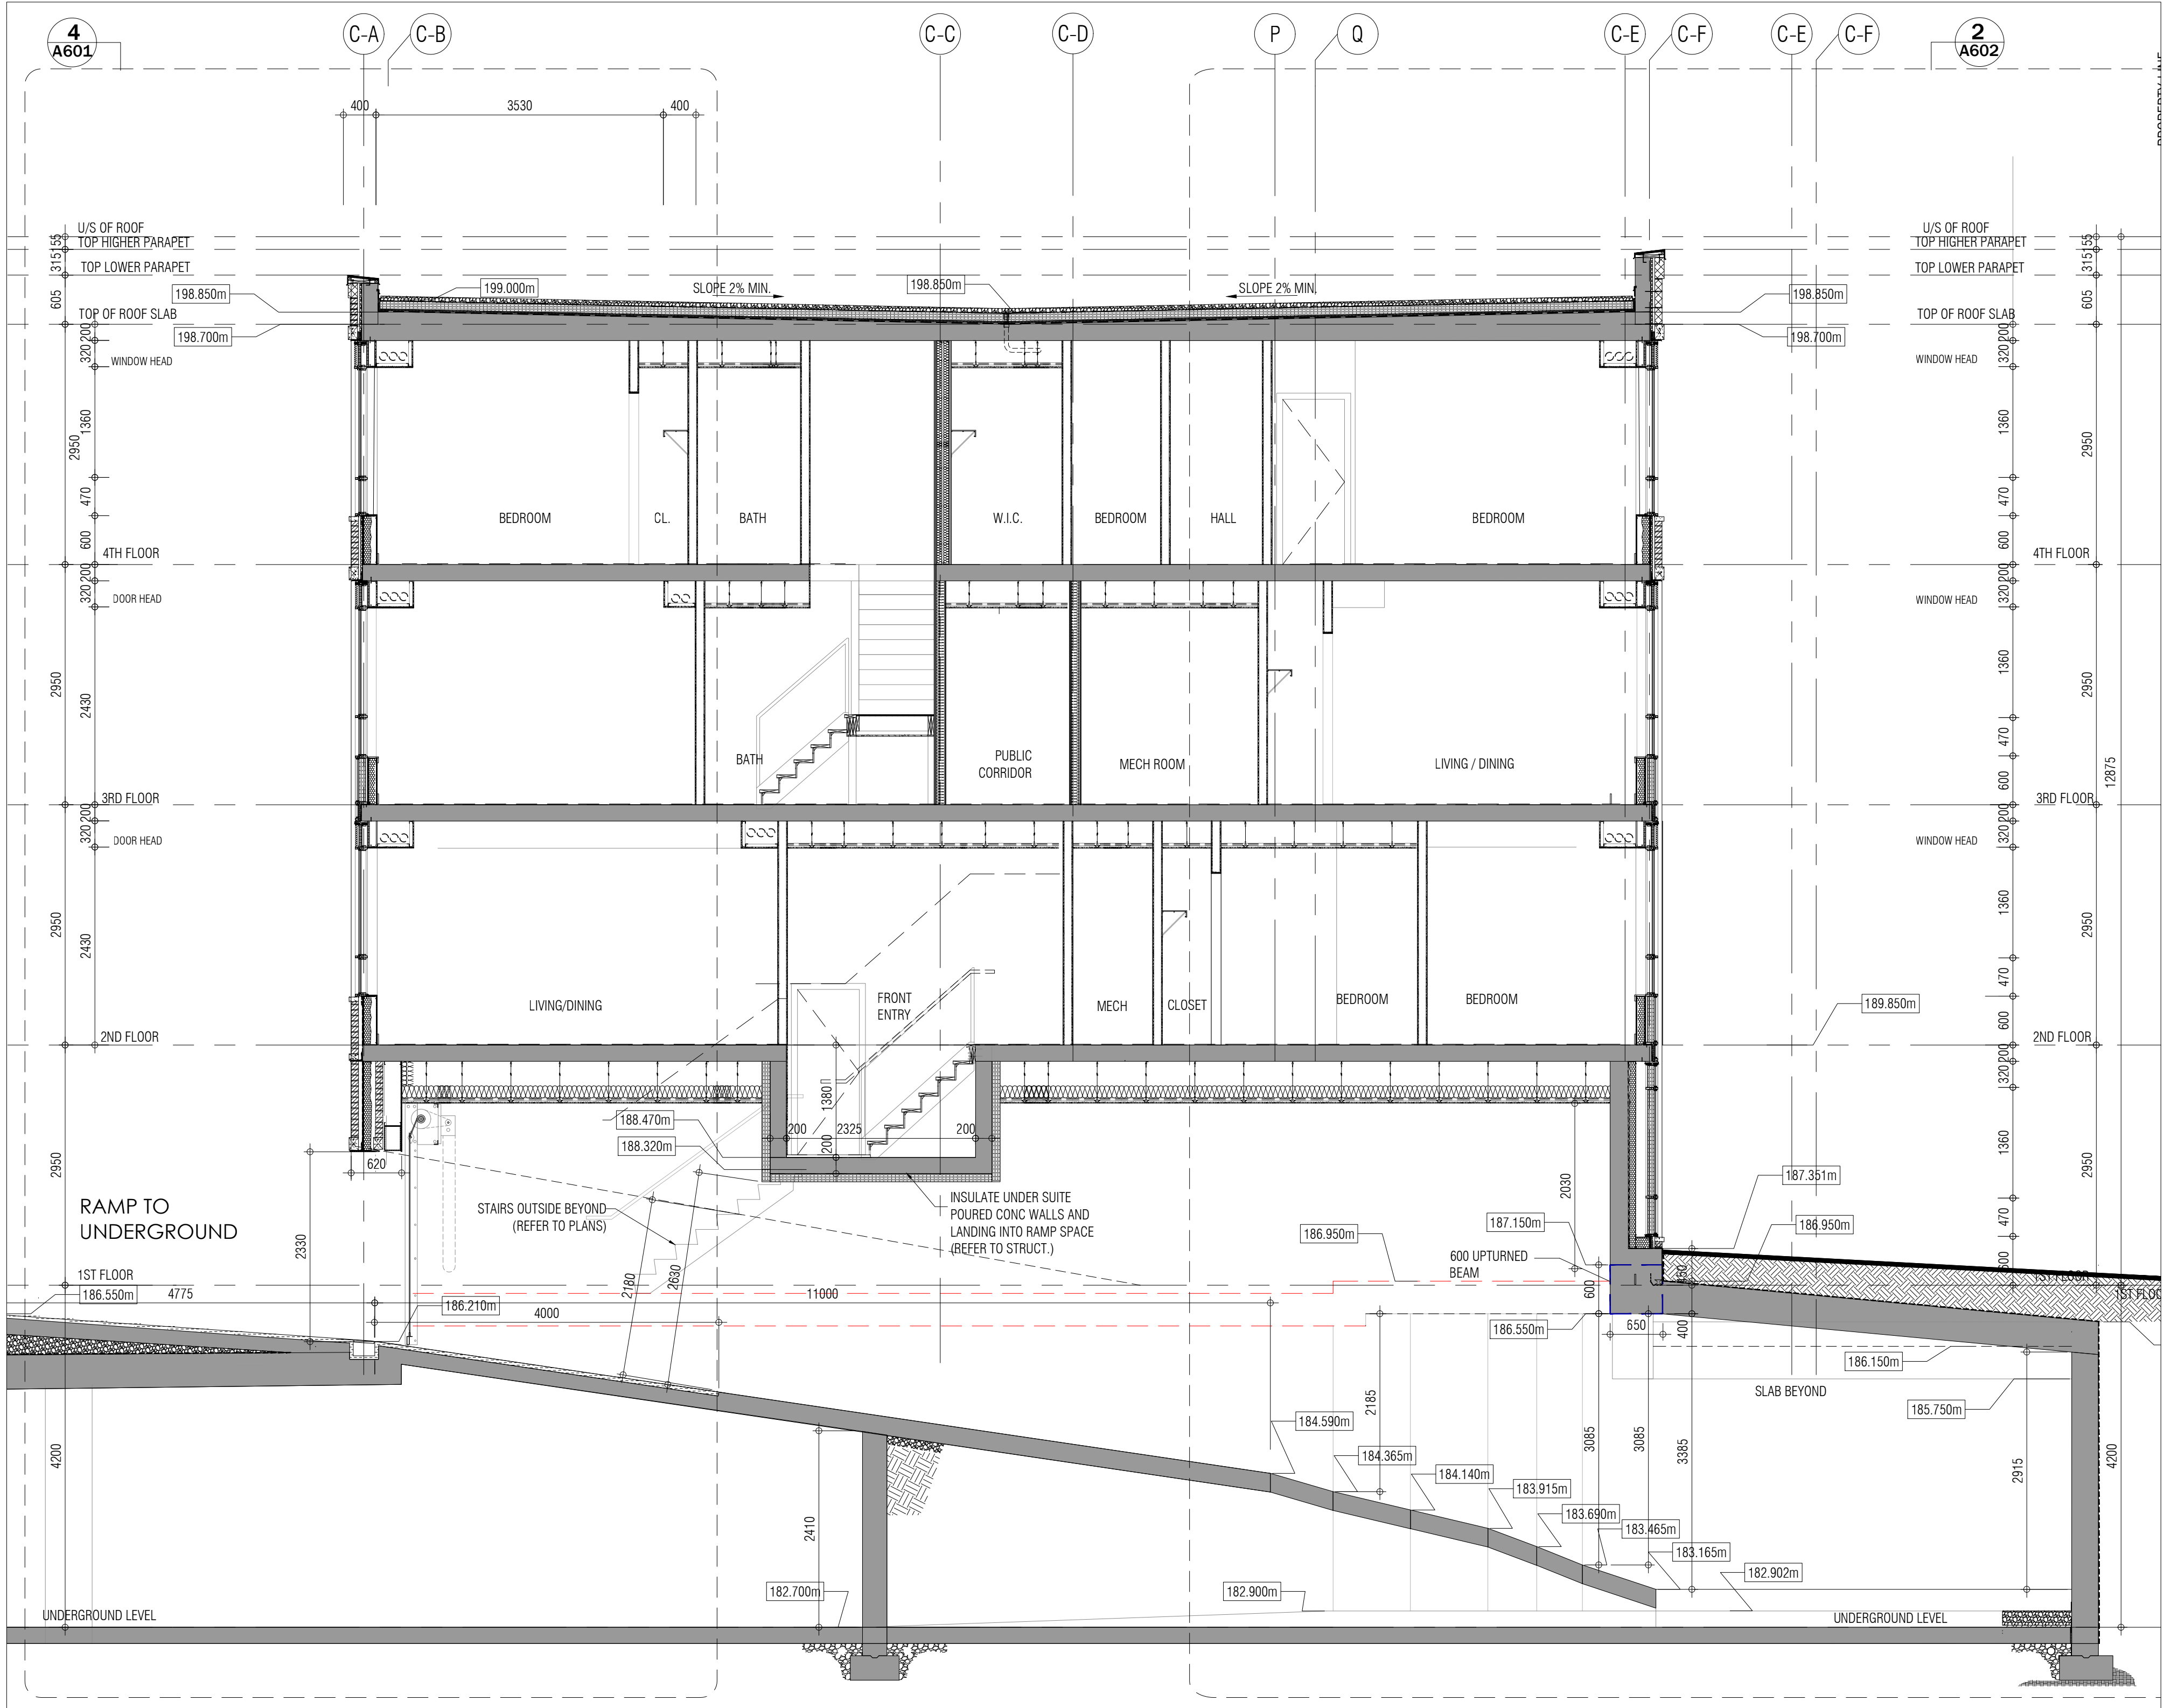

BUILDING SECTION AT SEC. FLR. UNIT 239 SIDE ENTRANCE ANDSTEPS 3
1:50 A506

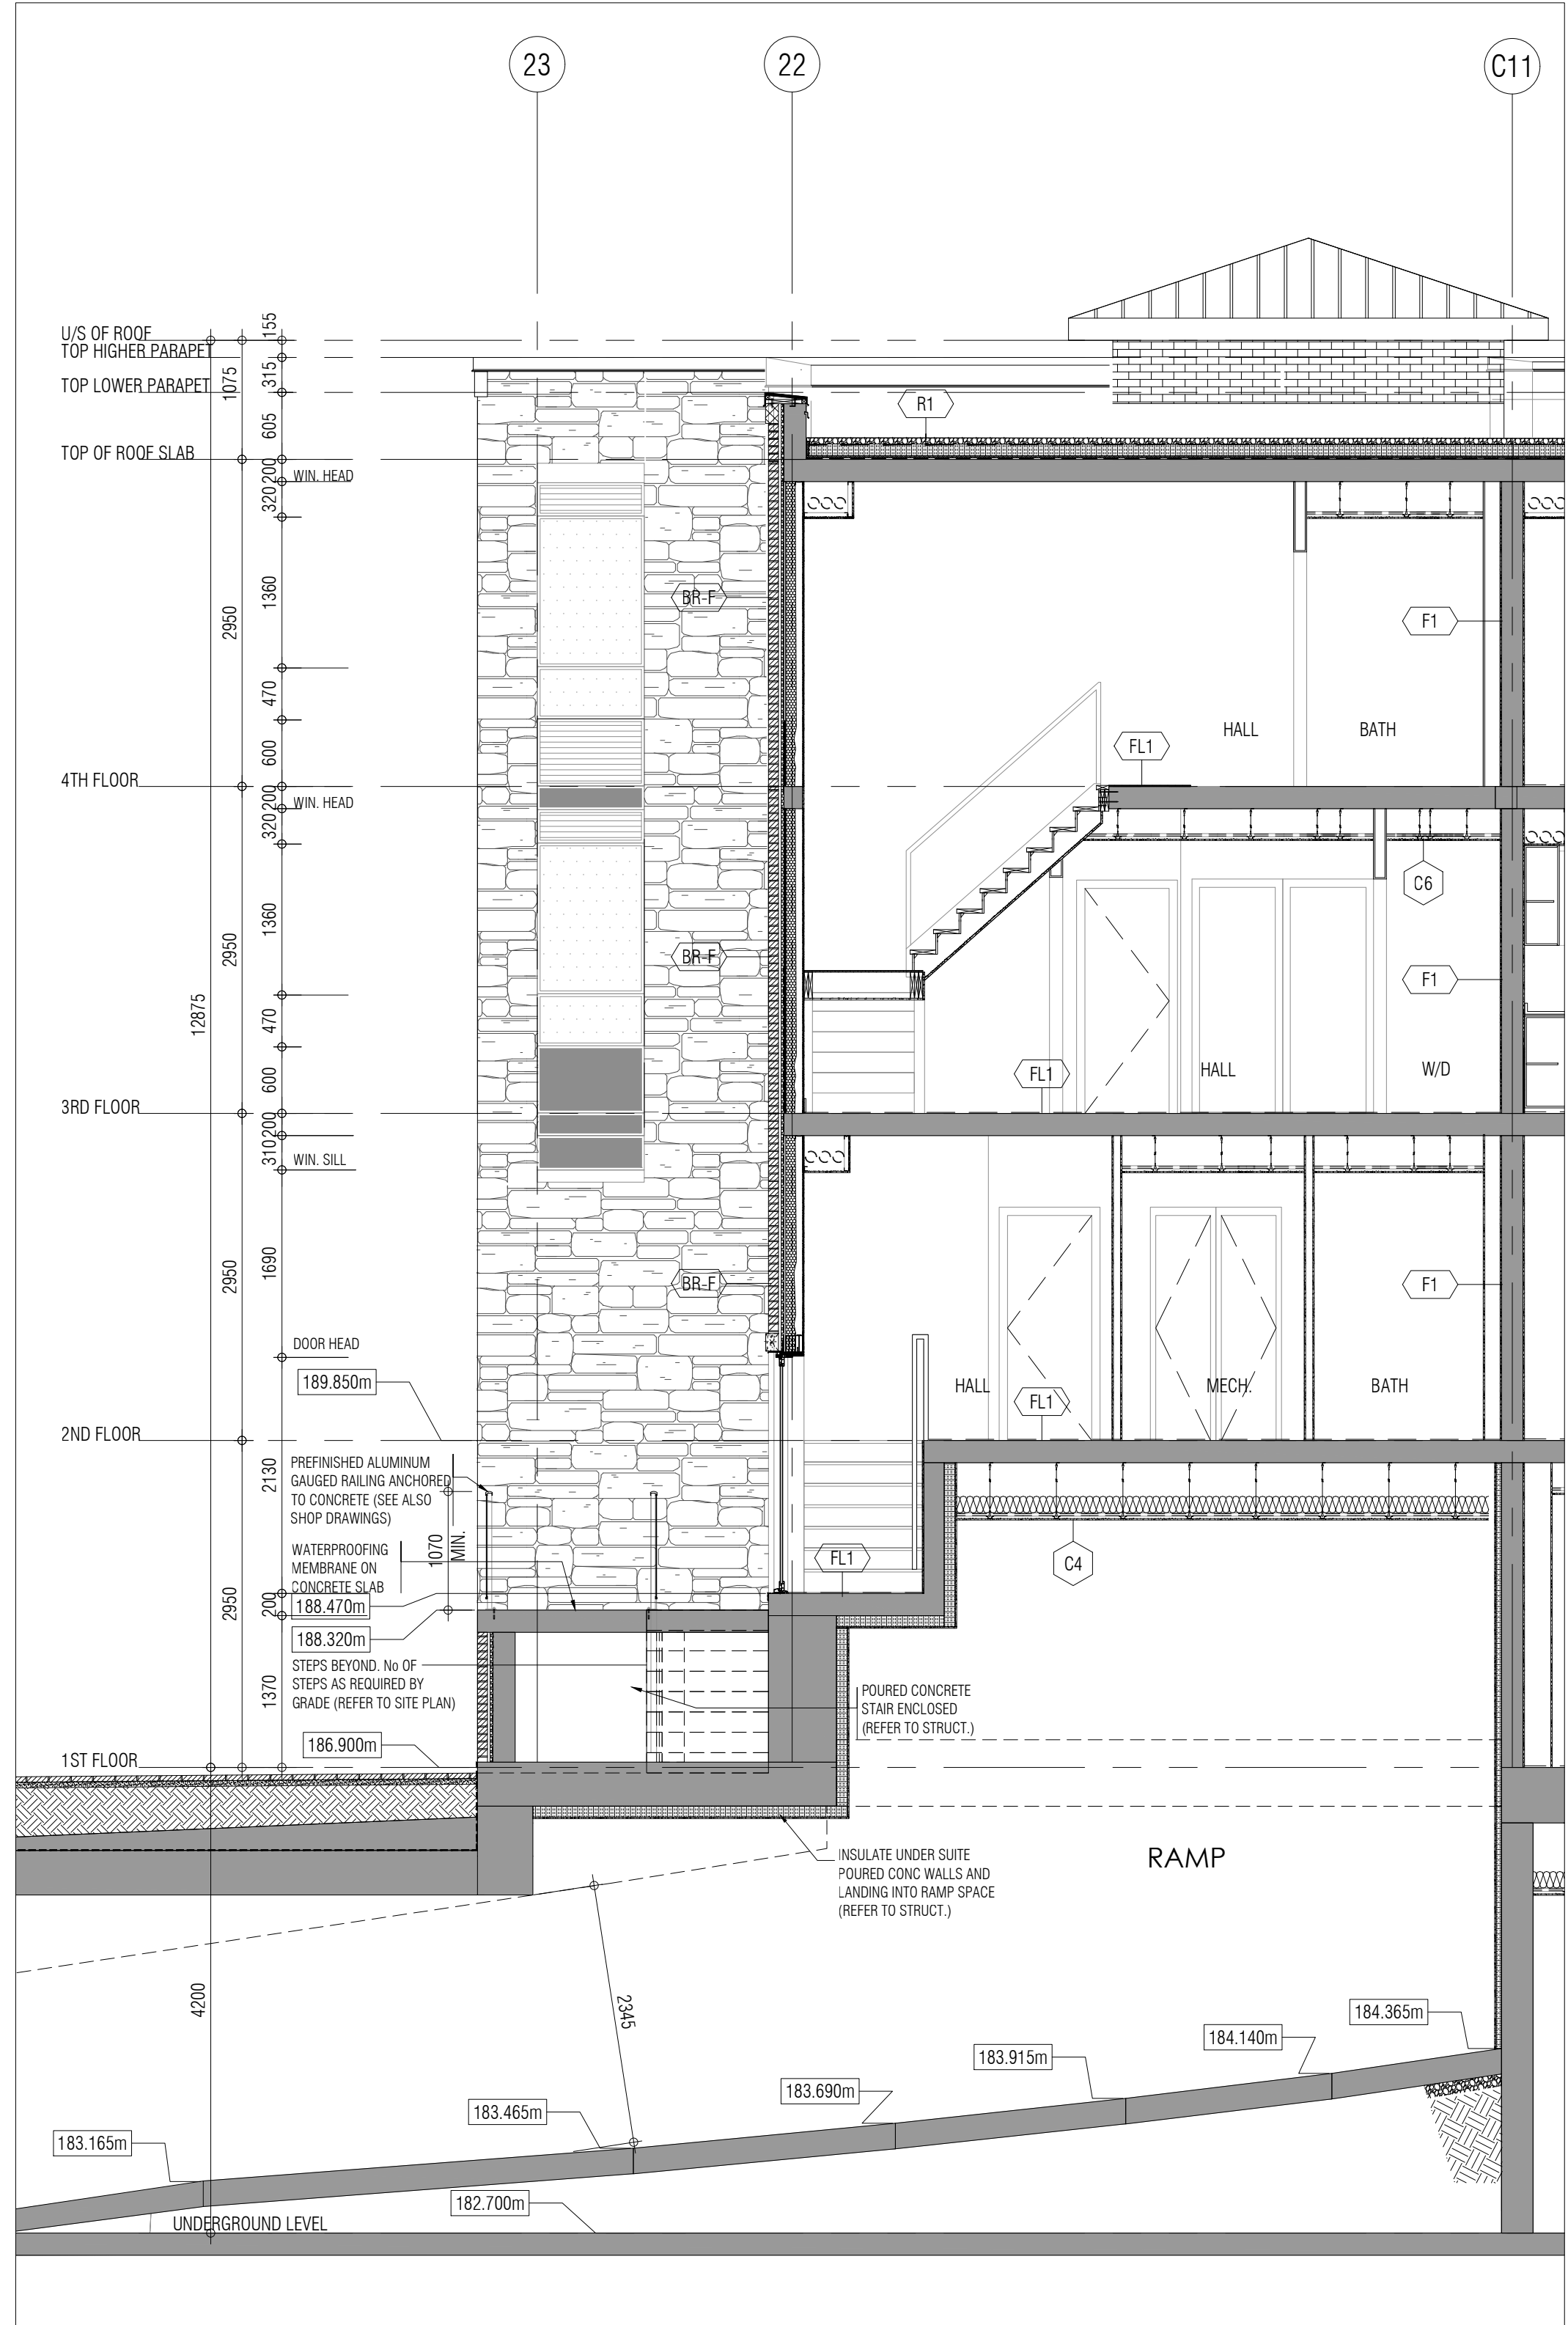

BUILDING SECTION AT SEC. FLR. UNIT 239 SIDE ENTRANCE ANDSTEPS 2
1:50 A506

THIS DRAWING, AS AN INSTRUMENT OF SERVICE, IS PROVIDED BY AND IS THE PROPERTY OF GRAZIANI-CORAZZA ARCHITECTS INC. THE CONTRACTOR MUST VERIFY AND ACCEPT RESPONSIBILITY FOR ALL DIMENSIONS AND COORDINATIONS AND MUST NOTIFY GRAZIANI-CORAZZA ARCHITECTS INC. OF ANY DISCREPANCIES FROM THE SUPPLIED INFORMATION. GRAZIANI-CORAZZA ARCHITECTS INC. IS NOT RESPONSIBLE FOR THE ACCURACY OF SURVEY, STRUCTURAL, MECHANICAL, ELECTRICAL, AND OTHER ENGINEERING INFORMATION SHOWN ON THIS DRAWING. REFER TO THE APPROPRIATE ENGINEERING DRAWINGS BEFORE PROCEEDING WITH THE WORK. CONSTRUCTION MUST COMPLY TO ALL APPLICABLE CODES AND REQUIREMENTS OF THE AUTHORITIES HAVING JURISDICTION, UNLESS OTHERWISE NOTED. NO REVISIONS TO THIS DRAWING ARE PERMITTED IN ANY OFFICE IN REGARDS TO THE ENVIRONMENTAL CONDITION OF THIS SITE.

THIS DRAWING IS NOT TO BE SCALED. ALL ARCHITECTURAL SYMBOLS INDICATED ON THIS DRAWING ARE GRAPHIC REPRESENTATIONS ONLY.

CONDITIONS FOR ELECTRONIC INFORMATION TRANSFER

ELECTRONIC INFORMATION IS SUPPLIED TO THE OTHER ASSOCIATED FIRMS TO ASSIST THEM IN THE EXECUTION OF THEIR WORK. REVIEW THE RECIPIENT FIRMS MUST DETERMINE THE COMPLETENESS, APPROPRIATENESS, RELIANCE OF THE INFORMATION IN RESPECT TO THEIR PARTICULAR RESPONSIBILITY.

GRAZIANI-CORAZZA ARCHITECTS INC. SHALL NOT BE RESPONSIBLE FOR ERRORS, OMISSIONS, INCOMPLETENESS DUE TO LOSS OF INFORMATION IN WHOLE OR PART WHEN INFORMATION IS TRANSMITTED.

1. TRANSMISSION OF ANY LOSS OF DAMAGE TO THE RECEIVING ELECTRONIC SYSTEM WHEN INFORMATION IS TRANSMITTED.

- 01. Oct.07.2019 issued for tender
- 02. Mar.13.2020 issued for design coordination #2
- 03. Mar.16.2020 issued for addendum #2
- 04. Mar.16.2020 issued for addendum #3
- 05. Aug.24.2020 issued for addendum #4
- 06. Sept. 28.2020 issued for permit
- 07. Oct.20.2020 issued for addendum #5
- 08. Nov.23.2020 issued for addendum #6
- 09. Dec.14.2020 issued for addendum #7
- 10. Jan.18.2021 issued for addendum #8
- 11. Mar. 2. 2021 issued for permit
- 12. Mar.09.2021 issued for addendum #9
- 13. Mar.10.2021 issued for addendum #9R
- 14. Mar.26.2021 issued for progress
- 15. May 14. 2021 issued for Site Instruction #1
- 16. June 15. 2021 issued for Site Instruction #2
- 17. July. 7. 2021 re-issued for permit
- 18. July. 15. 2021 issued for Site Instruction #3
- 19. July. 27. 2021 issued for Site Instruction #4
- 20. Aug. 3. 2021 issued for Site Instruction #5
- 21. Aug. 18. 2021 issued for Site Instruction #6
- 22. Aug. 28. 2021 Re-issued for permit.
- 23. Sept. 07. 2021 issued for Site Instruction #7
- 24. Sept. 09. 2021 issued for Site Instruction #8
- 25. Sept. 16. 2021 issued for Building D Permit Revisions
- 26. Sept. 22. 2021 issued for Site Instruction #9
- 27. Oct. 6. 2021 Re-issued for permit.
- 28. Oct. 8. 2021 issued for Site Instruction #10
- 30. Oct. 28. 2021 issued for Site Instruction #11
- 31. Nov. 05. 2021 issued for Site Instruction #12
- 32. Dec. 3. 2021 issued for Site Instruction #13
- 33. Dec. 6. 2021 issued for Site Instruction #14
- 34. Dec. 7. 2021 issued for Site Instruction #15
- 35. Jan. 26. 2022 issued for Site Instruction #16
- 36. Jan. 31. 2022 issued for Site Instruction #17
- 37. Mar. 11. 2022 issued for Site Instruction #18
- 38. Apr. 29. 2022 issued for Site Instruction #19
- 39. May 10. 2022 issued for Site Instruction #20
- 40. May 24. 2022 issued for Site Instruction #21
- 41. Aug. 05. 2022 issued for I.F.C.
- 42. Aug. 18. 2022 issued for Site Instruction #22
- 43. Aug. 22. 2022 issued for Site Instruction #23
- 44. Oct. 12. 2022 issued for Site Instruction #24
- 45. Feb. 6. 2023 issued for Site Instruction #25
- 46. Mar. 22. 2023 issued for Site Instruction #26

01. Apr.19.2021 issued to client

issued for revisions

GRAZIANI CORAZZA ARCHITECTS

1330 SHAWNEE DRIVE, SUITE 100 MISSISSAUGA, ONTARIO L4W 1C3
905.709.7021 FAX: 905.709.7088 WWW.GC-ARCHITECTS.COM

ATTMAR + PALLESCI DRIVE

BRAMPTON ONTARIO

PROJECT ARCHITECT: B. GRAZIANI
ASSISTANT DESIGNER: R. LINCOLN
DRAWN BY: G.C./F.C./M.B.
CHECKED BY: D. BIASE/G. COLANGELO
PLOT DATE: MAR 22 2023
JOB #: 1331.15

BUILDING SECTION