ROYAL PINE HOMES
3550 LANGSTAFF ROAD, SUITE 200
WOODBRIDGE, ONTARIO L4L 9G3
TEL: (905) 856-2150 • (416) 213-7181
FAX: (905) 856-6543

PURCHASE ORDER

ORDER:

DATE: 02/08/24

TO: Maple Drywall

SHIP TO: Grovetrail Dev. Inc. Phs. 2

LOT NUMBER #161-(45-04 Elv. A-Opt. Main)

PLEASE SUPPLY:	QUANTITY	PRICE	AMOUNT
DESCRIPTION: Inventory Unit			
Ensuite #2 2 Twin Bath			
↳ Delete standard tub/shower	2	$287.00	$574.00
enclosure and install shower in			
both bathrooms			

INVOICE TO: Grovetrail Dev. Inc. Phs. 2

№ 000587

Authorized Signature

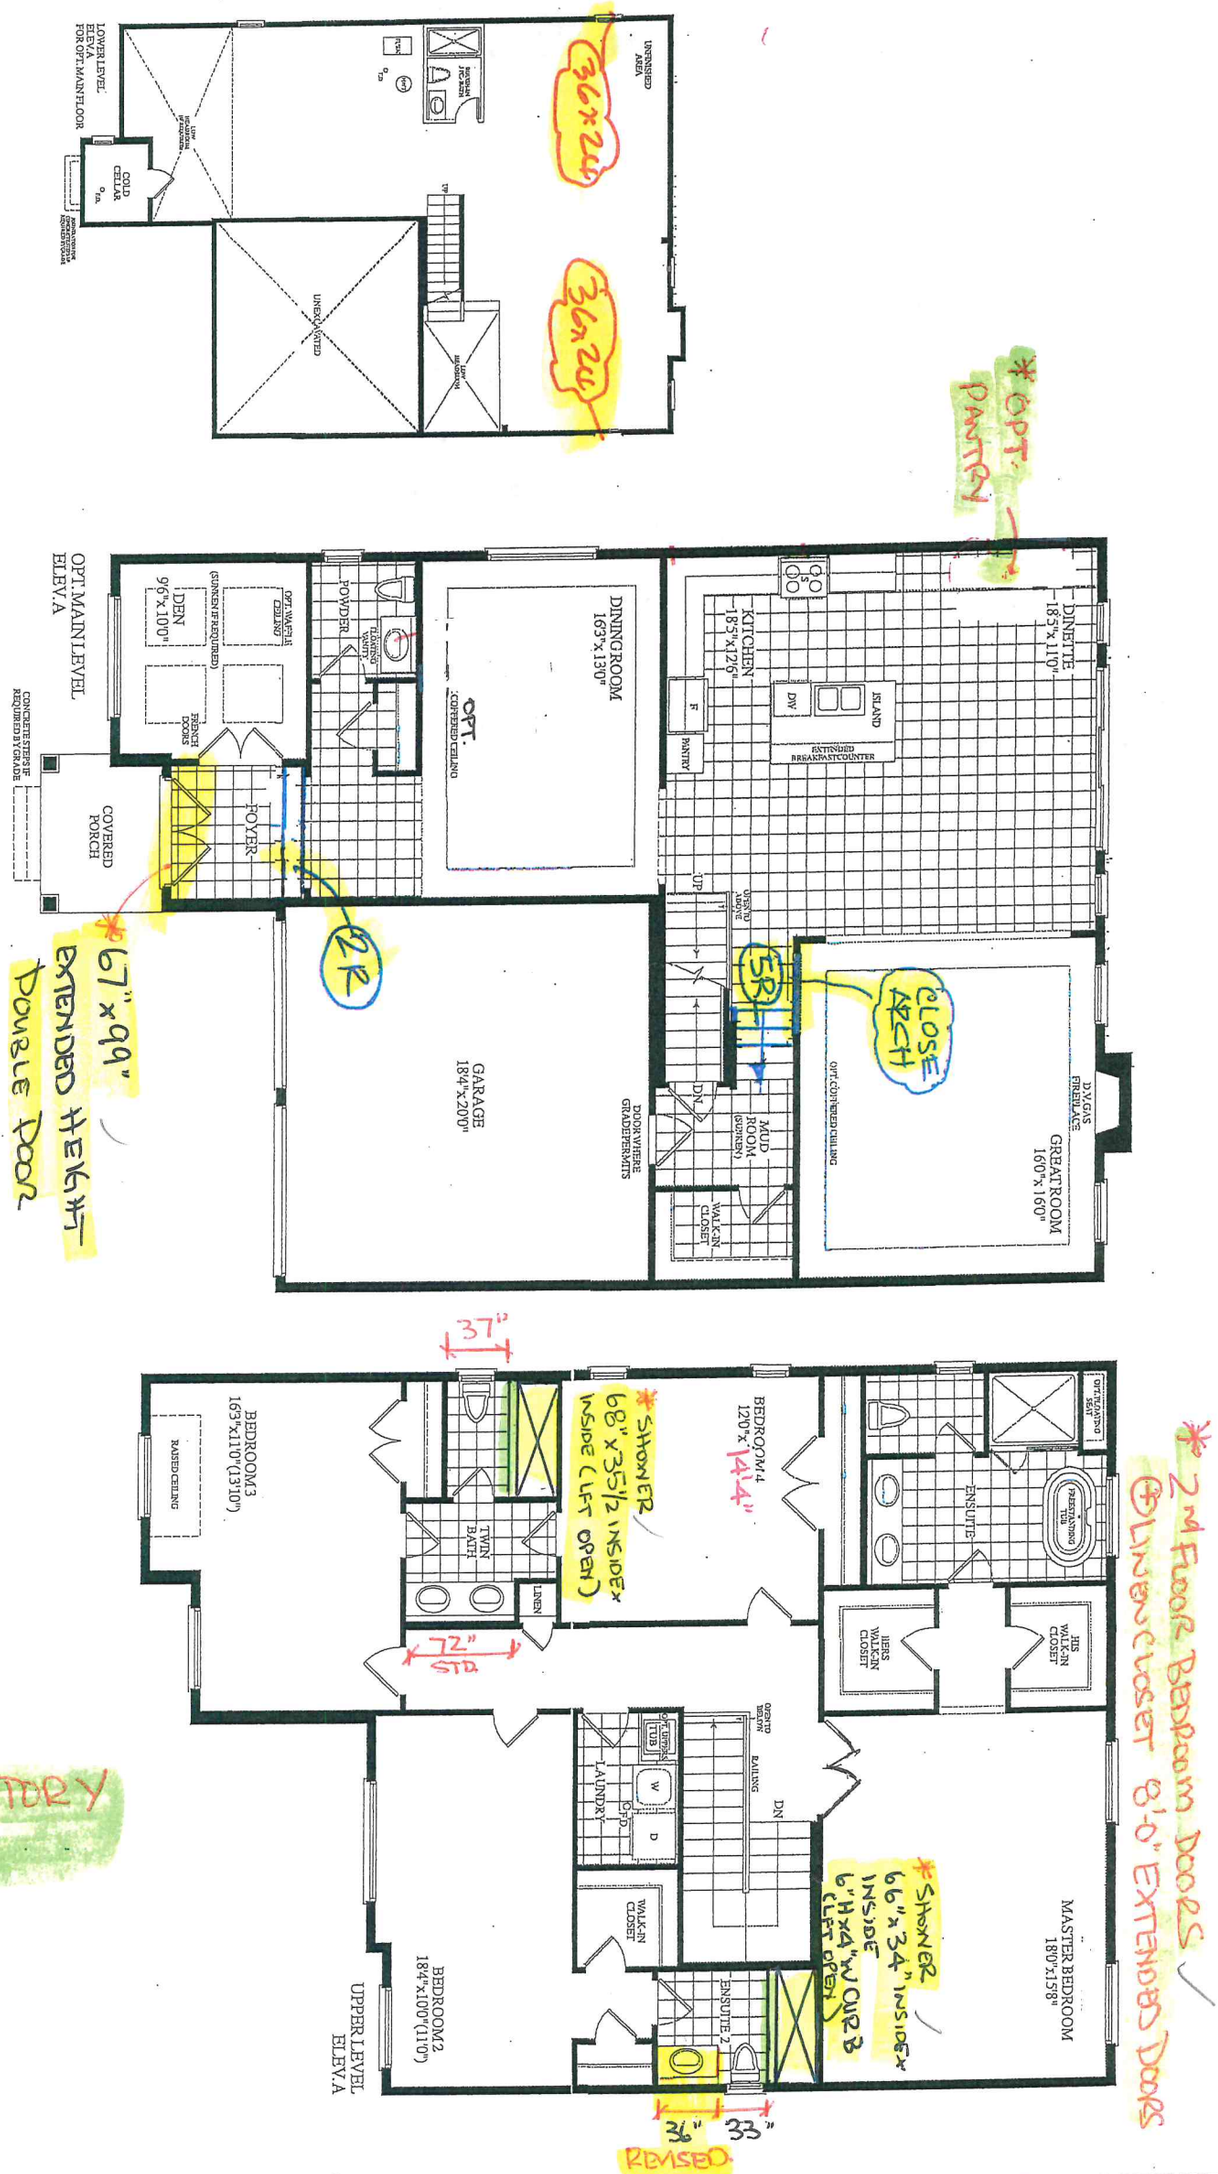

INVENTORY LOT

LOT 161. 45-04 DUNCAN . EL. A. OPTIONAL MAIN LEVEL
4 BEDROOM 3225 Sq. Ft.