



STRUCTURALS

CONSTRUCTION SUMMARY

Grovetrail Developments Inc.

PURCHASERS: SUNGYONG HA and WOO RI KOH

TEL:

| LOT NUMBER   | PHASE | HOUSE TYPE       | CLOSING DATE |
|--------------|-------|------------------|--------------|
| 79 BLOCK 242 | 3     | MACKENZIE Elev B | 06-Aug-25    |

|           |   |
|-----------|---|
| Offer     | BONUS PACKAGE FOR TOWNHOUSE: PURCHASER TO RECEIVE \$7,500.00 (INCLUSIVE OF TAXES) WORTH OF UPGRADES AT DECOR CENTRE AT TIME OF COLOUR CHART |
| Worksheet | Note:   |

|           |   |
|-----------|---|
| Offer     | BONUS PACKAGE FOR TOWNHOUSE: 5 APPLIANCES TO INCLUDE FRIDGE, STOVE, DISHWASHER WITH STAINLESS STEEL FINISH AND WHITE WASHER AND DRYER AS PER VENDORS SAMPLES. DELIVERED ONLY - NOT INSTALLED. |
| Worksheet | Note:   |

Date Added: 10-Feb-25

Invoice Number: 8723

|  |
|--|
| 1 - BASEMENT- Install 200 amp service in lieu of the standard. (See Sketch)  |
| Note:  |
| 1 - MASTER ENSUITE SHOWER STALL- Install frameless glass shower enclosure for the master ensuite shower stall, in lieu of the builders standard framed glass. (See Sketch) |
| Note:  |
| 1 - PURCHASER AWARE AND ACCEPTS THAT ANY CHANGES MADE TO UPGRADES AFTER SIGNING THIS PURCHASERS EXTRA FORM ARE SUBJECT TO A MINIMUM ADMINISTRATION FEE OF \$1,000          |
| Note:  |
| 1 - PURCHASER HAS ATTENDED A STRUCTURAL APPOINTMENT AT THE DESIGN STUDIO AND HAS DECLINED ANY ADDITIONAL UPGRADES  |
| Note:  |
| 1 - BONUS PACKAGE-PURCHASER TO RECEIVE \$7,500 (INCLUSIVE OF TAXES) WORTH OF UPGRADES AT THE DESIGN STUDIO AT TIME OF COLOUR CHART   |
| Note: BONUS PACKAGE-PURCHASER HAS A REMAINING \$1,680.50 (INCLUSIVE OF TAXES) WORTH OF UPGRADES AT THE DESIGN STUDIO AT TIME OF COLOUR CHART                               |




Date Added:

Invoice Number: 8727

|   |
|---|
| 1 - UPPER HALL- Install Smooth ceilings throughout the Upper hall (See Sketch)  |
| Note:   |
| 1 - PURCHASER AWARE AND ACCEPTS THAT ANY CHANGES MADE TO UPGRADES AFTER SIGNING THIS PURCHASERS EXTRA FORM ARE SUBJECT TO A MINIMUM ADMINISTRATION FEE OF \$1,000 |
| Note:   |
| 1 - BONUS PACKAGE-PURCHASER TO RECEIVE \$1,680 (INCLUSIVE OF TAXES) WORTH OF UPGRADES AT THE DESIGN STUDIO AT TIME OF COLOUR CHART                                |
| Note:   |

This Document is Extremely Time Sensitive - Printed 13 Feb 25 at 9:36

x SH  
x LK

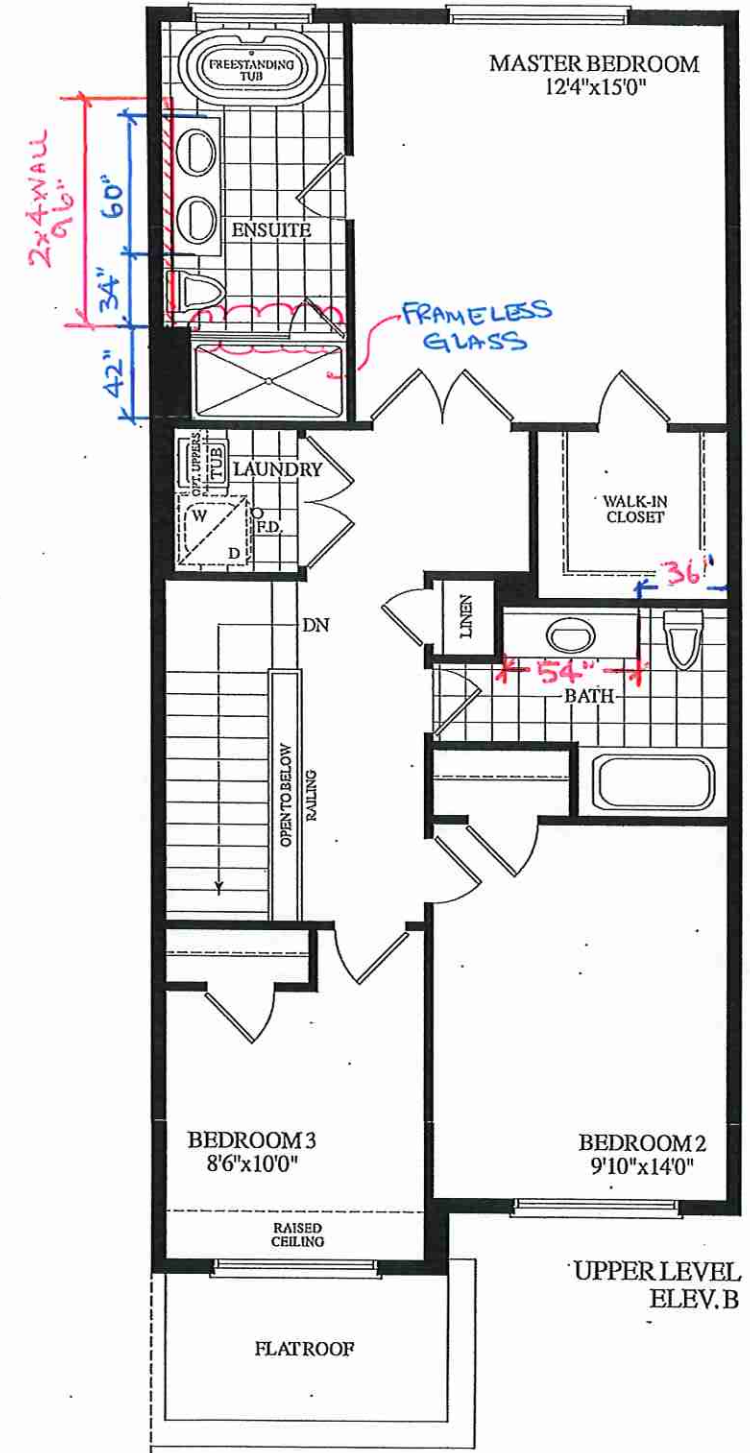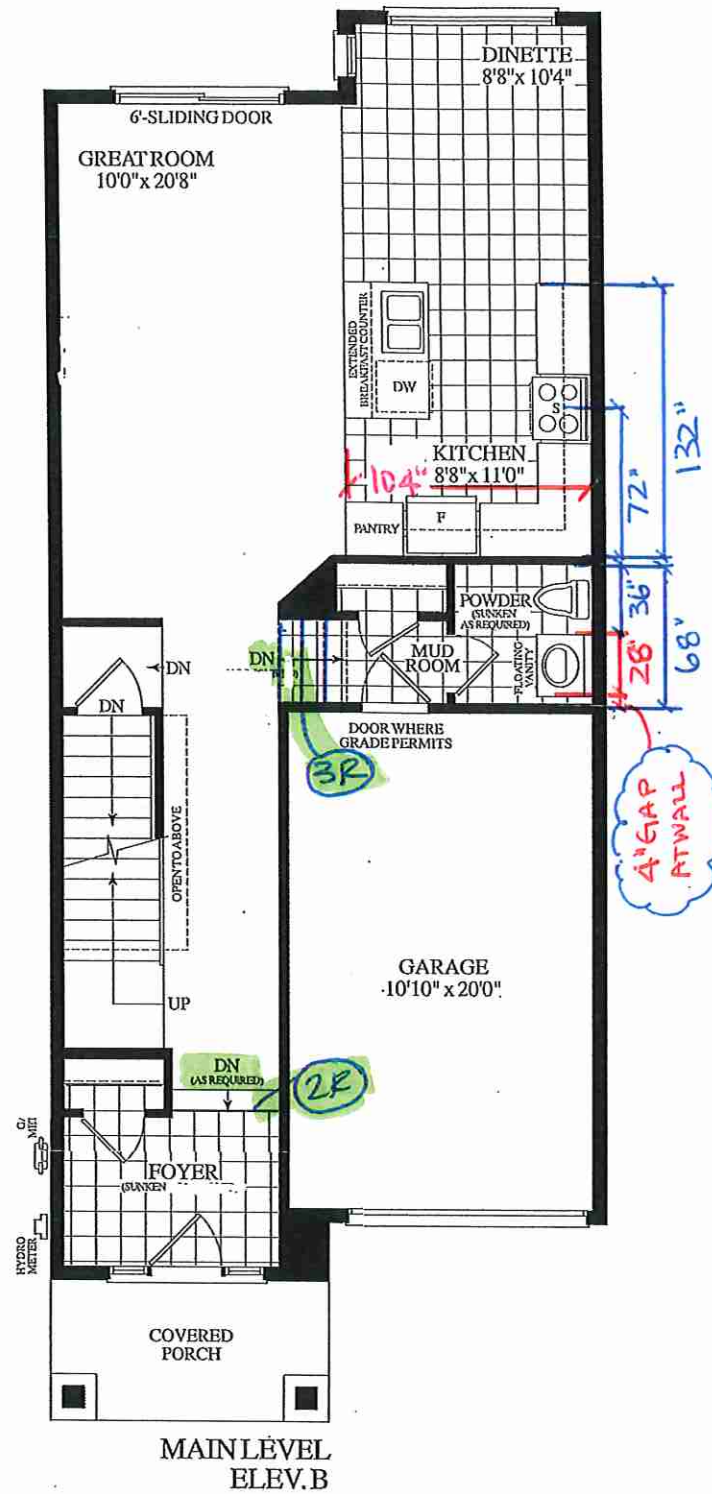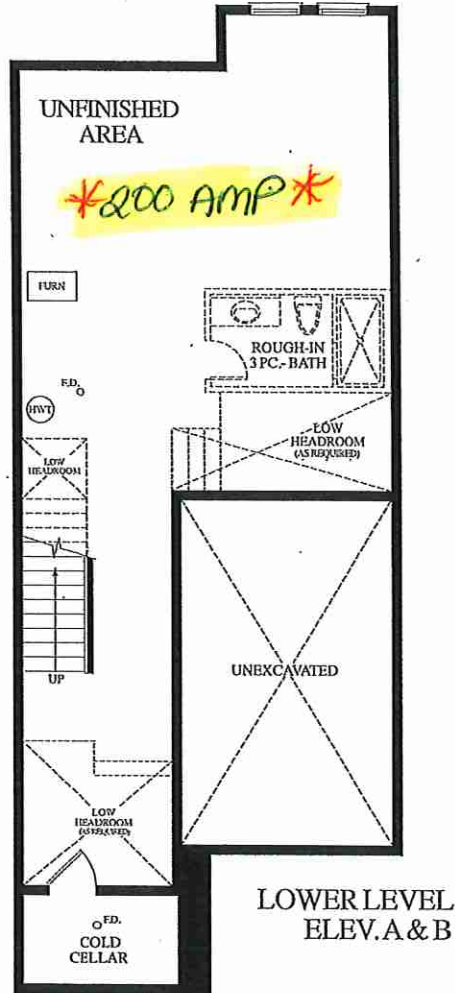

OAKRIDGE  
MEADOWS