

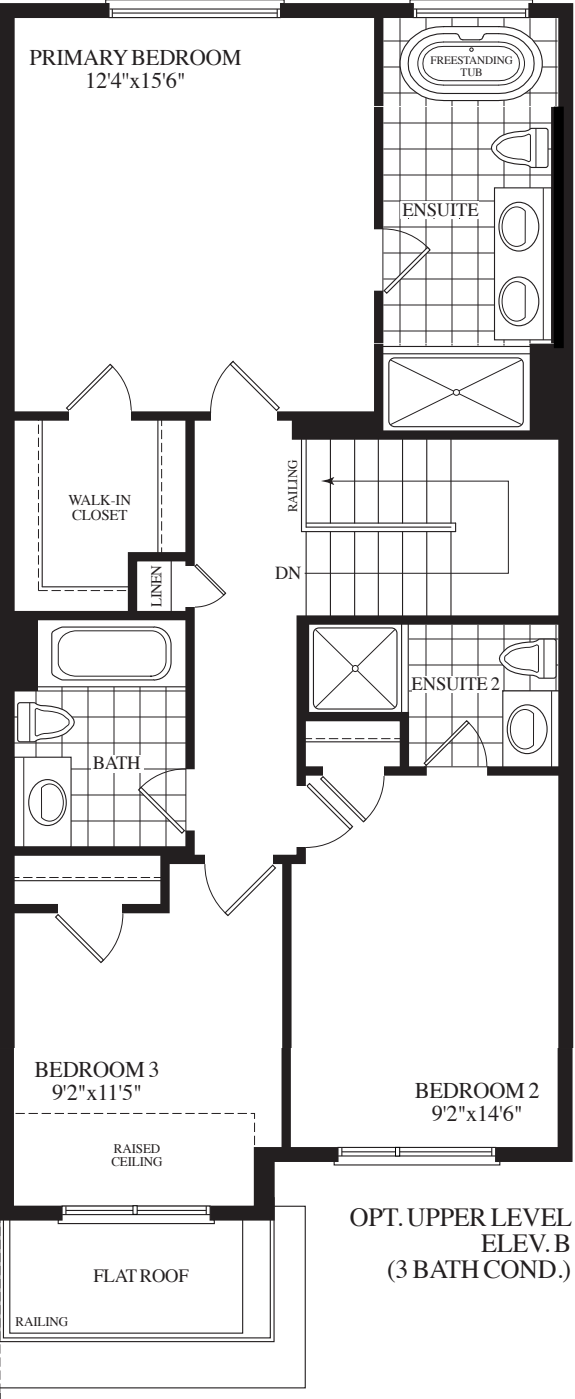


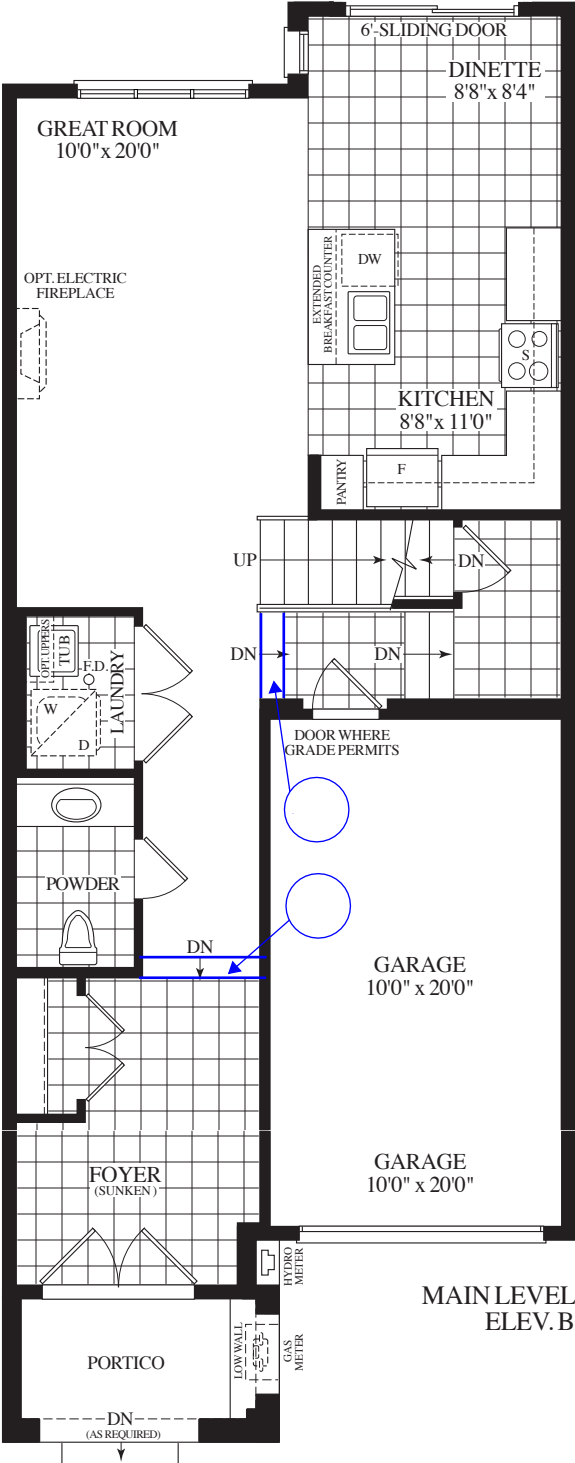

Materials, specifications and floor plans are subject to change without notice. All renderings are artist's concept. All floor plans are approximate dimensions. Actual usable floor space may vary from the stated floor area. E.&O.E.

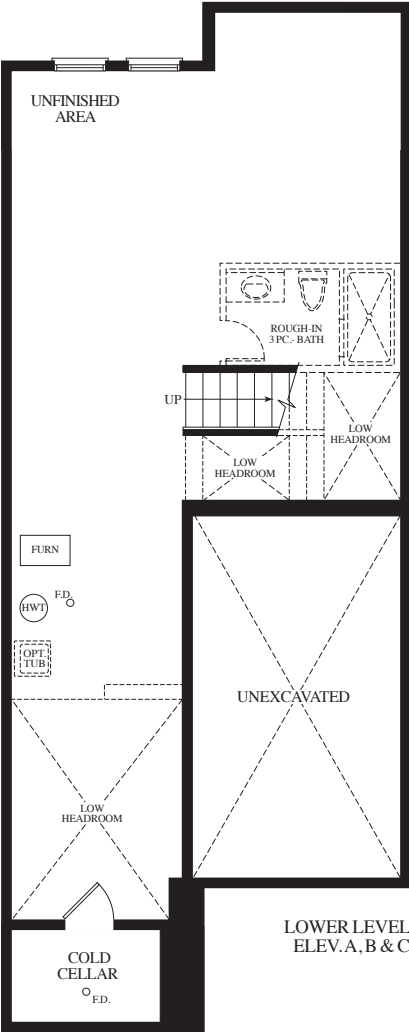

ELEVATION B

THE ANNE

20-15

1,685 SQ. FT.

BLK 18 TH. 113

18TH