




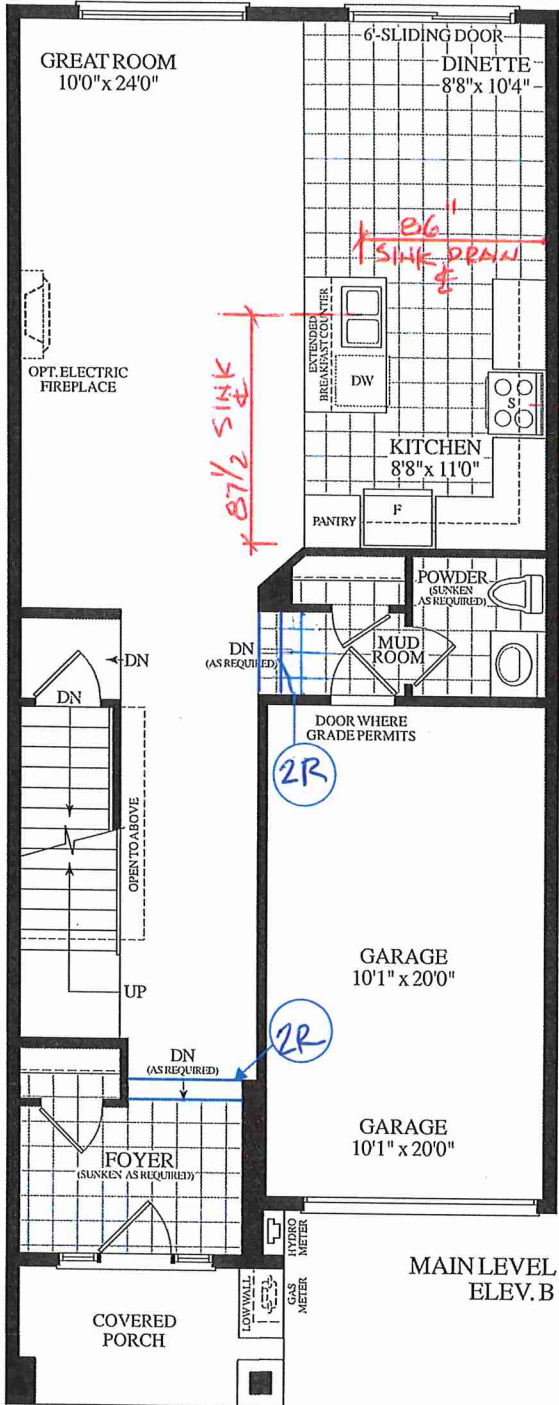

Materials, specifications and floor plans are subject to change without notice. All renderings are artist's concept. All floor plans are approximate dimensions. Actual usable floor space may vary from the stated floor area. E.&O.E.

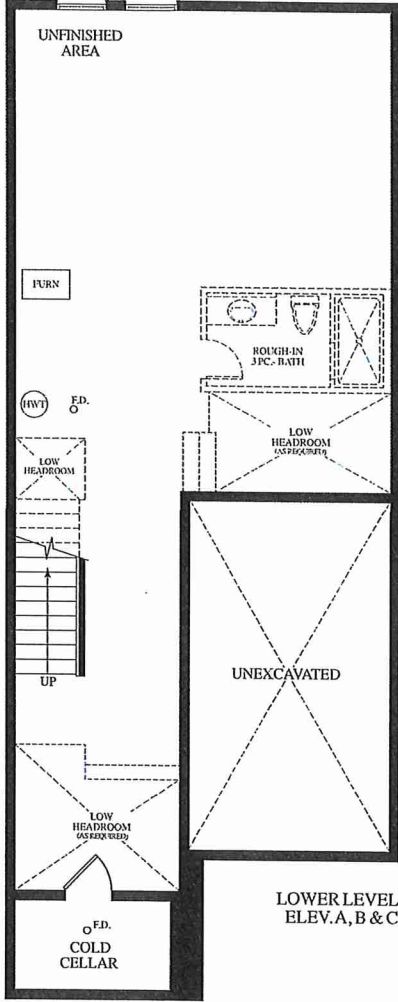

INVENTORY HOUSE

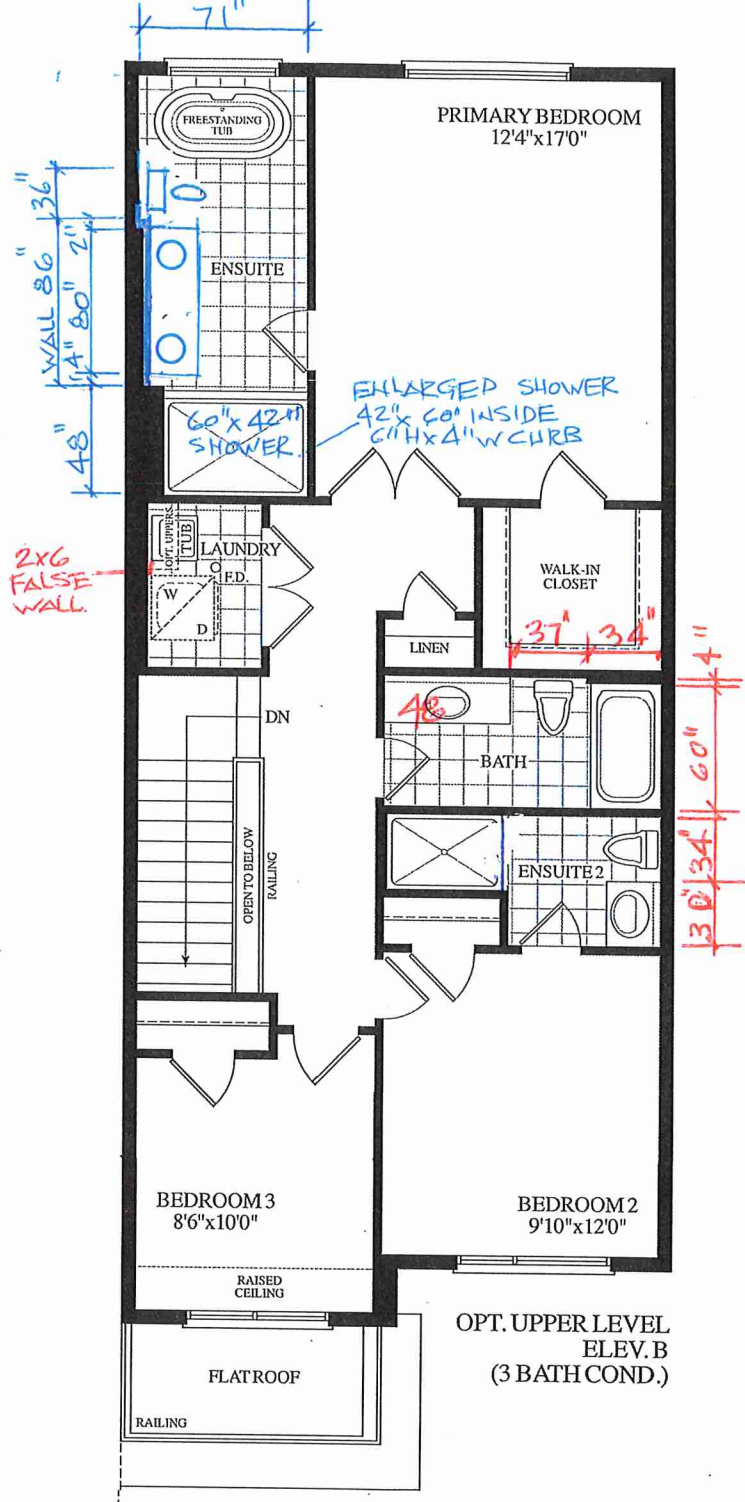

ELEVATION B

THE DIANA

20-17

1,780 SQ. FT.

BLK. 18 TH. 112