






ELEVATION B

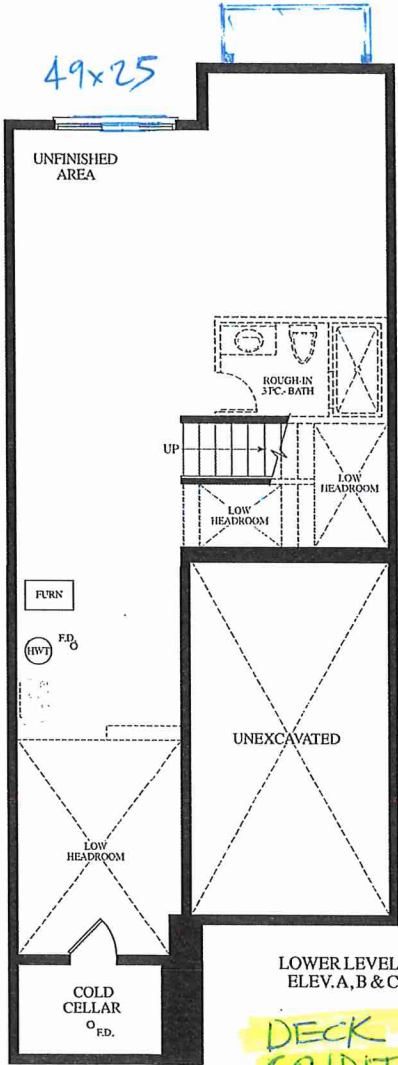

2x6
FALSE
WALL

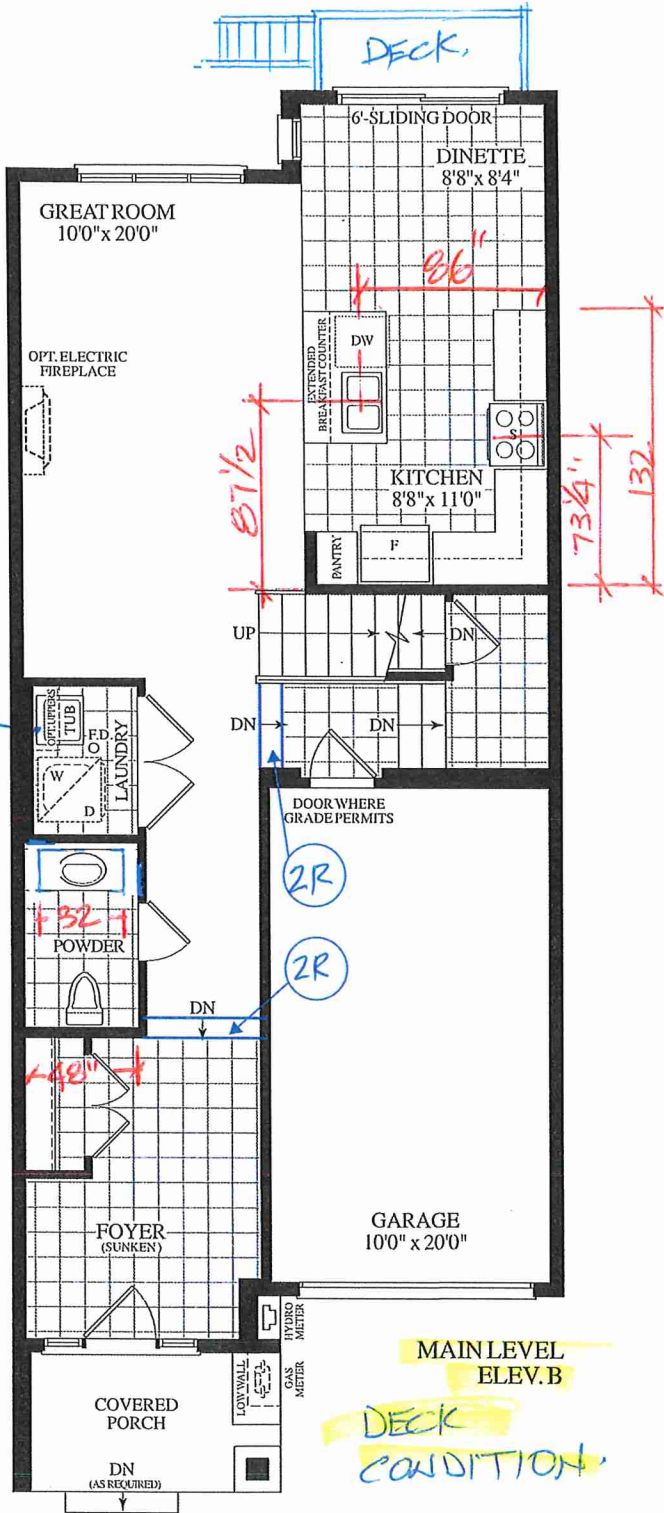

Materials, specifications and floor plans are subject to change without notice. All renderings are artist's concept. All floor plans are approximate dimensions. Actual usable floor space may vary from the stated floor area. E.&O.E.

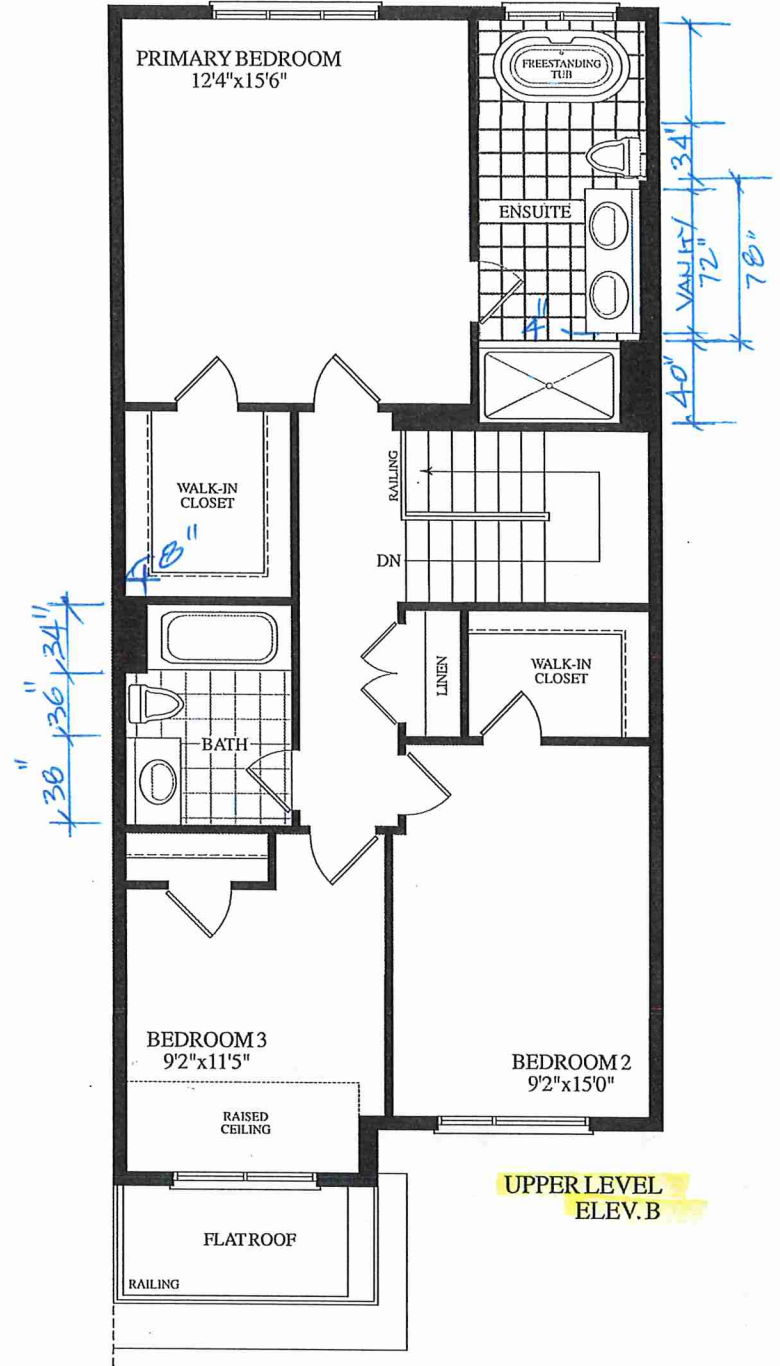

INVENTORY HOUSE

BLK. 9 TH. 56 20-15 THE ANNE EL. B 3 BDRM 2 BATH

1685 SQ. FT.



ELEVATION B

THE ANNE
20-15
1,685 SQ. FT.