



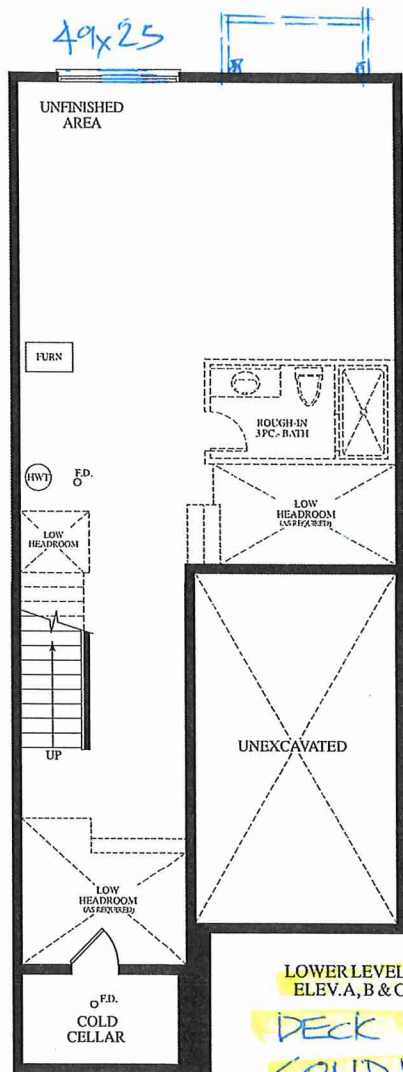

LOWER LEVEL
ELEV. A, B & C


DECK CONDITION

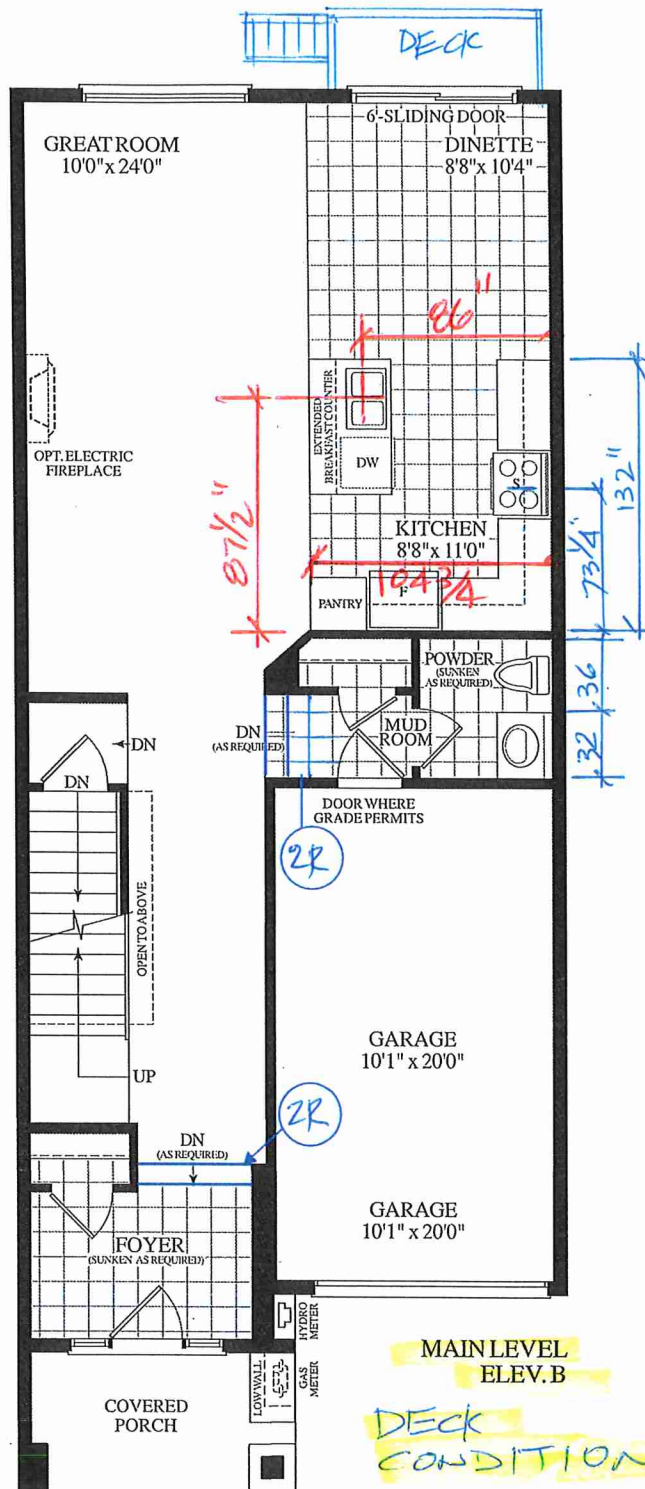

MAIN LEVEL
ELEV.B

DECK CONDITION

Materials, specifications and floor plans are subject to change without notice. All renderings are artist's concept. All floor plans are approximate dimensions. Actual usable floor space may vary from the stated floor area. E.&O.E.

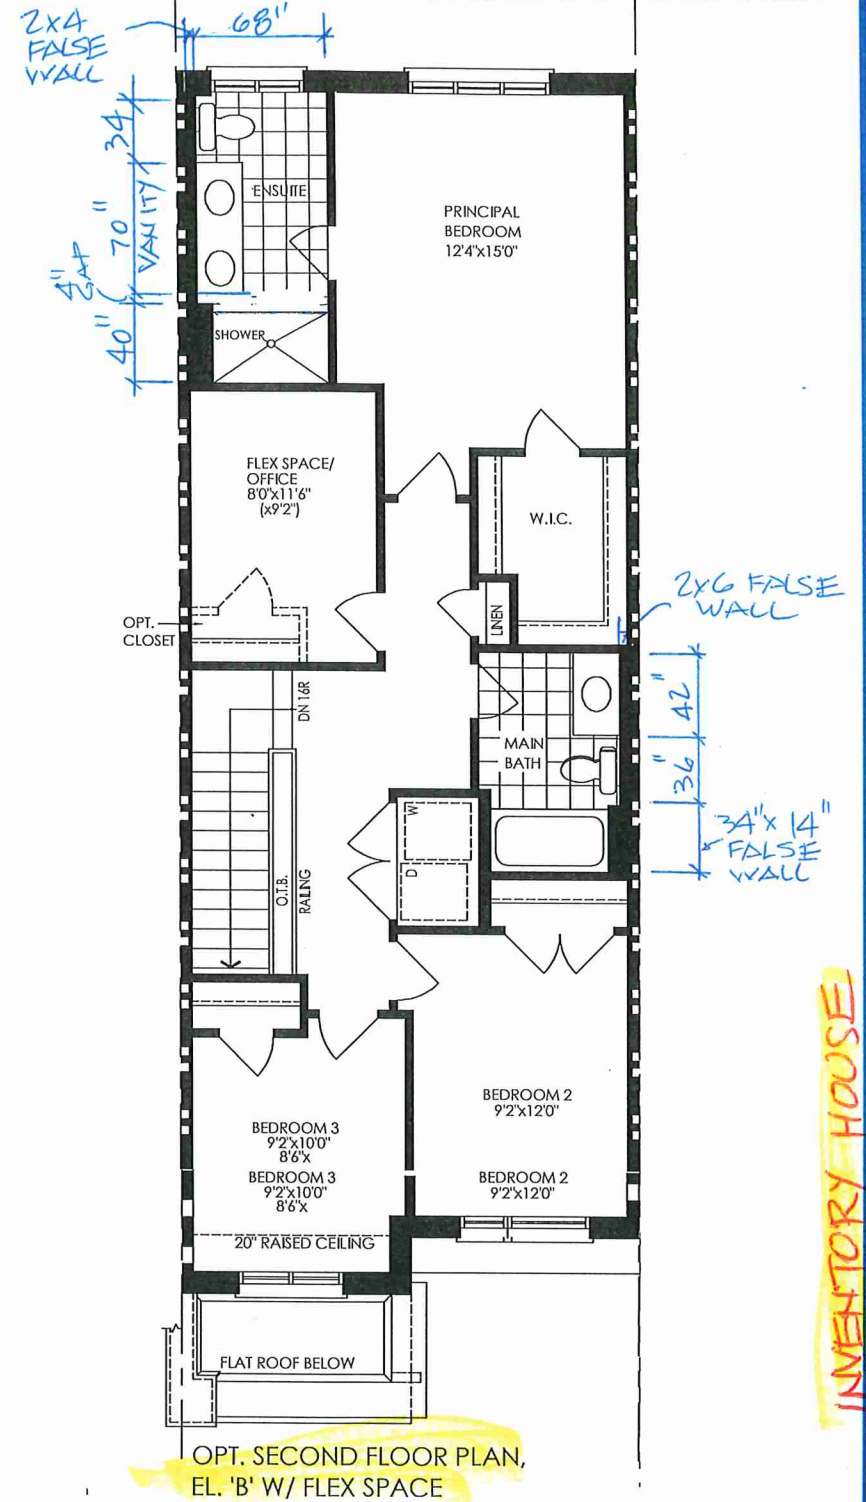

OPT. SECOND FLOOR PLAN,
EL. 'B' W/ FLEX SPACE

INVENTORY HOUSE

4 BDRM. 2 BATH.

20-17 THE DIANA EL. B

BLK.9 TH. 59

1780 SQ.FT.



ELEVATION B

THE DIANA

20-17

1,780 SQ. FT.

BLK. 18 TH. 117