






ELEVATION C

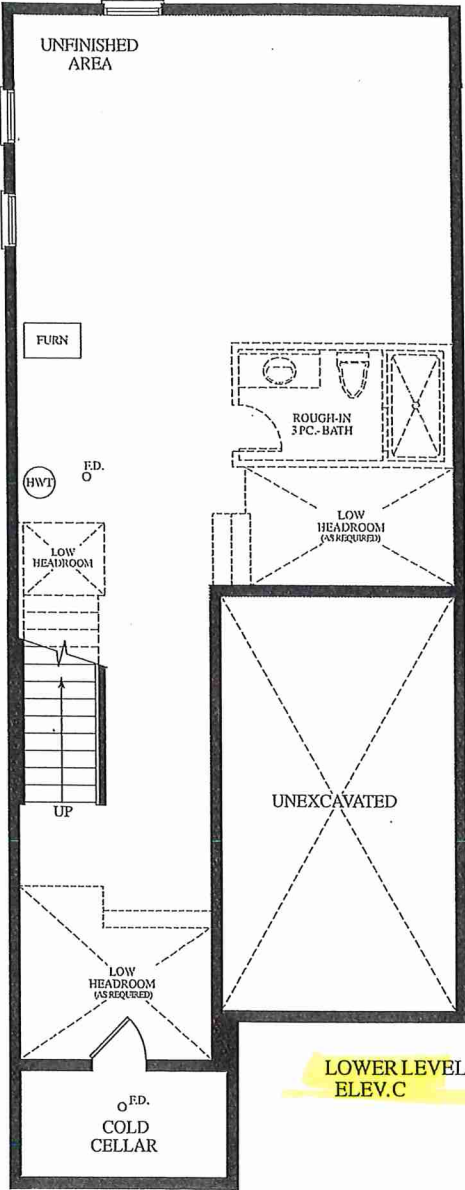

LOWER LEVEL
ELEV. C

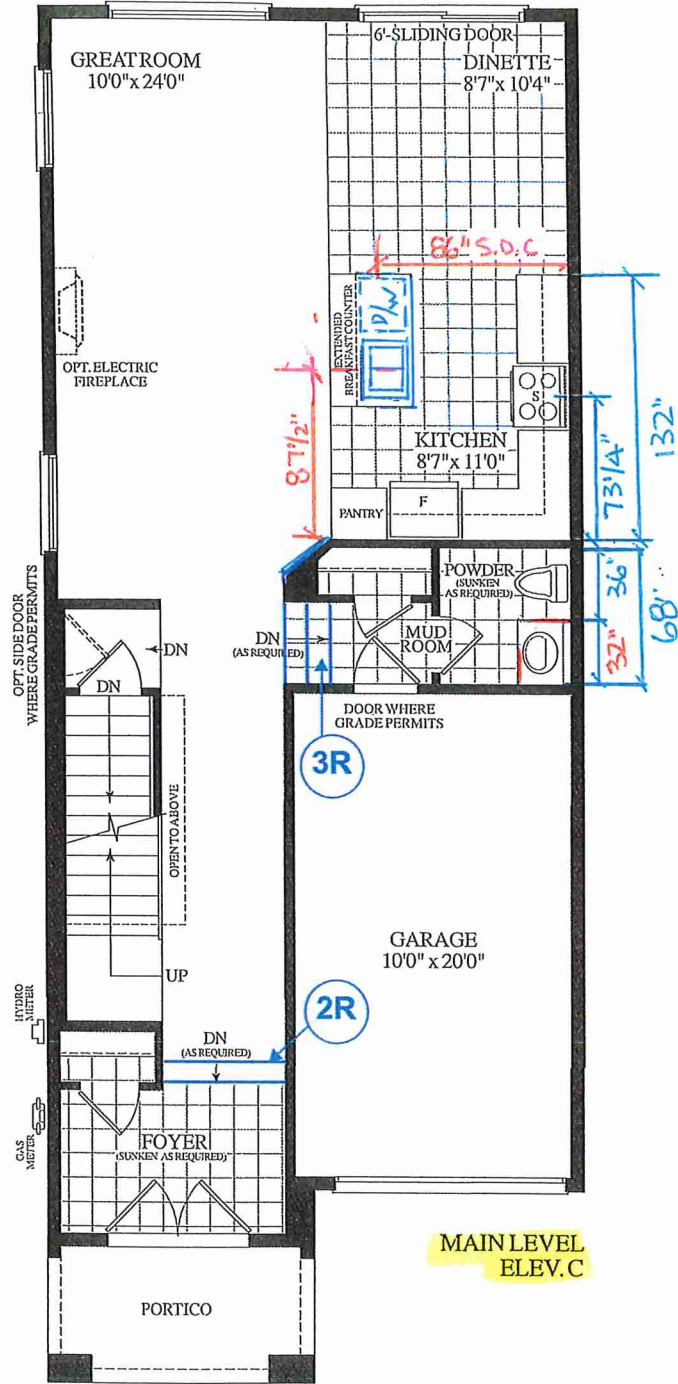

MAIN LEVEL
ELEV. C

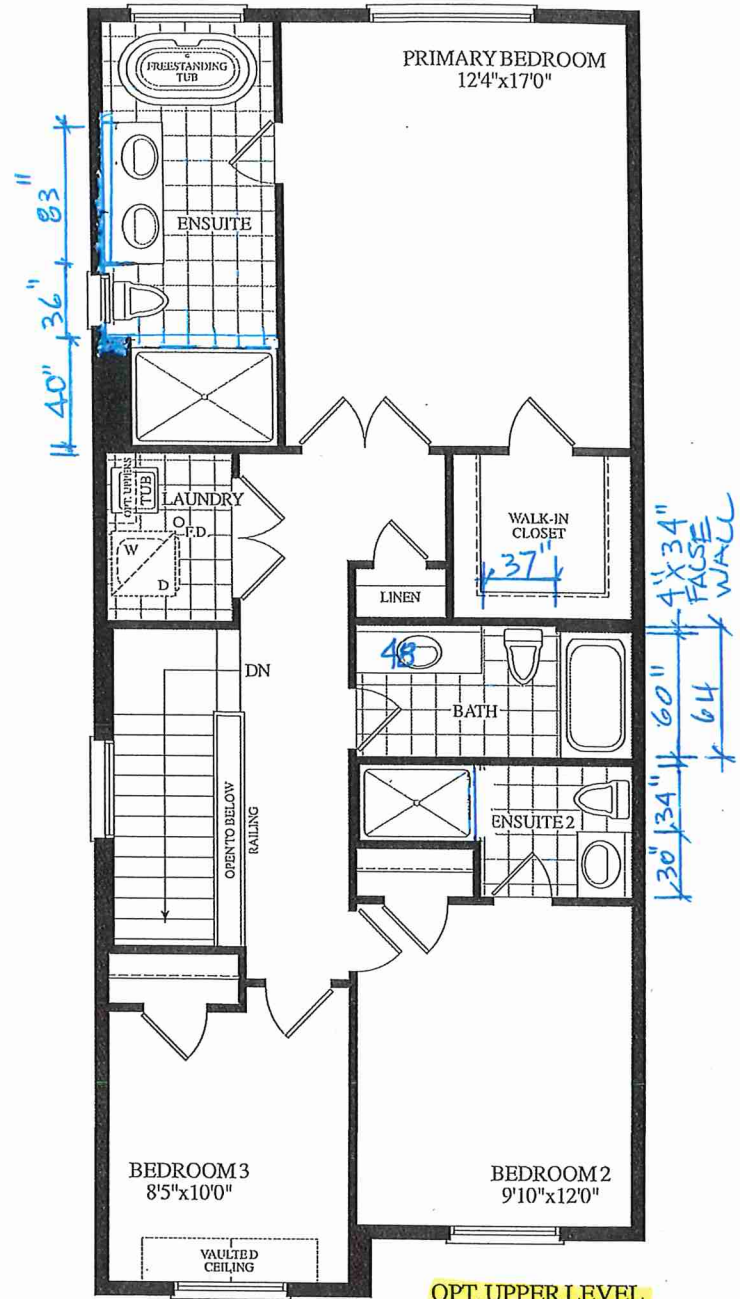

OPT. UPPER LEVEL
ELEV. C
(3 BATH COND.)

Materials, specifications and floor plans are subject to change without notice. All renderings are artist's concept. All floor plans are approximate dimensions. Actual usable floor space may vary from the stated floor area. E.&O.E.