



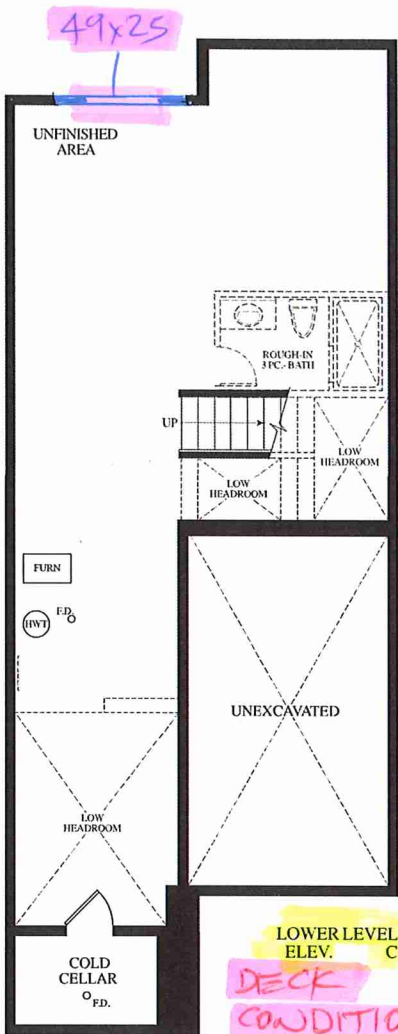


DECK CONDITION

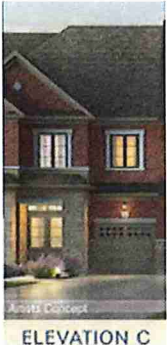


LOWER LEVEL ELEV. C
DECK CONDITION

2x6 FALSE WALL

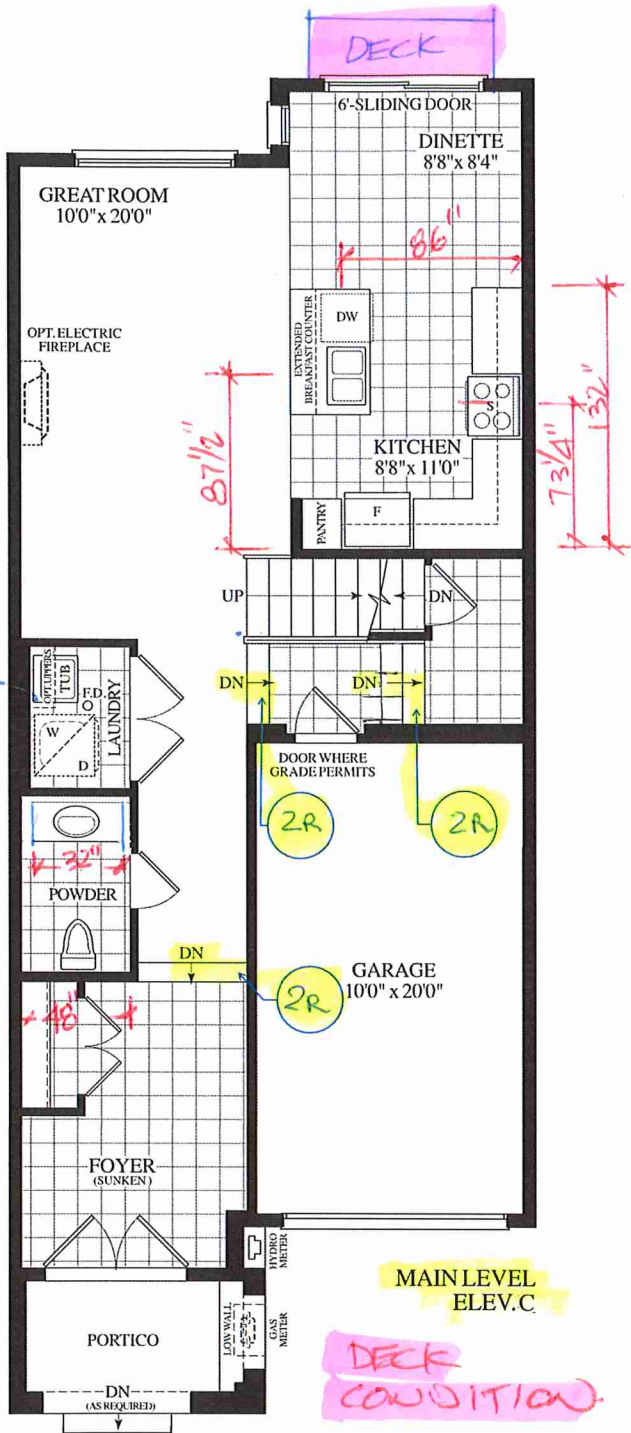

MAIN LEVEL ELEV. C
DECK CONDITION

Materials, specifications and floor plans are subject to change without notice. All renderings are artist's concept. All floor plans are approximate dimensions. Actual usable floor space may vary from the stated floor area. E.&O.E.

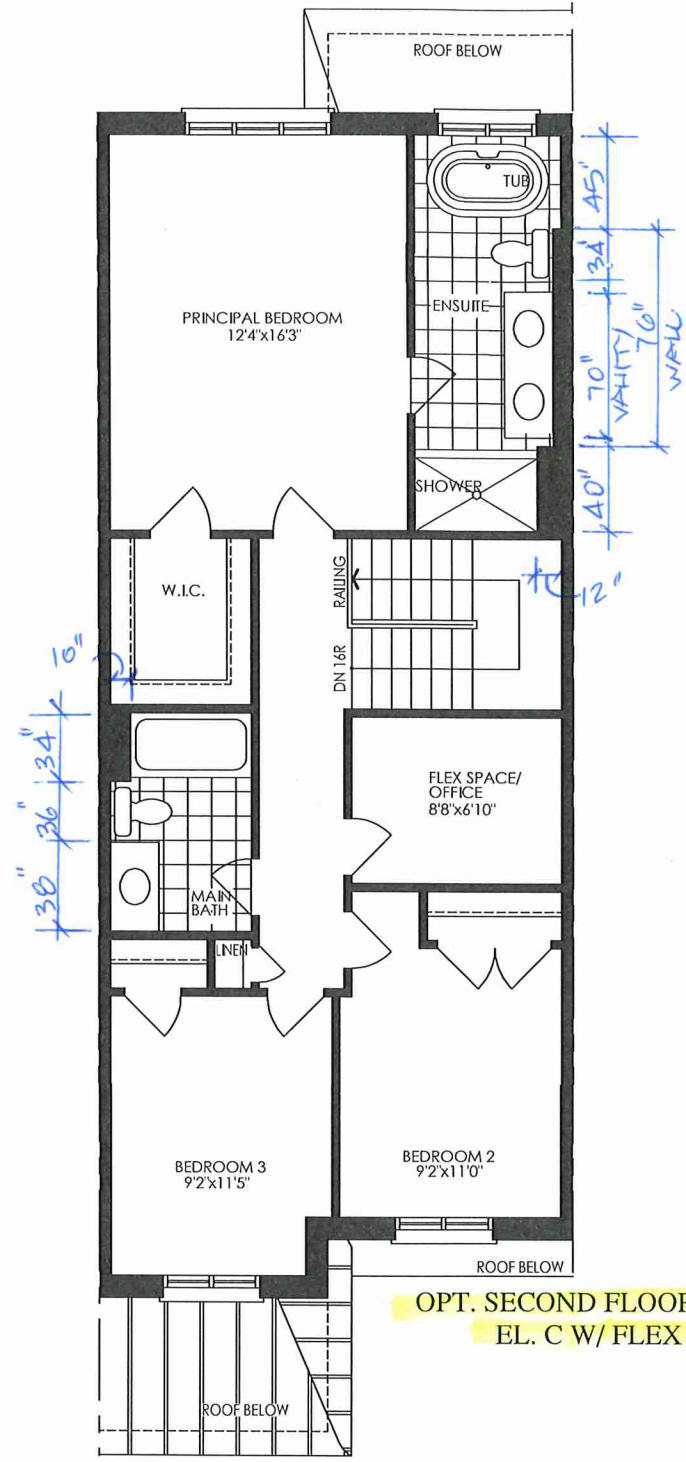

OPT. SECOND FLOOR PLAN
EL. C W/ FLEX SPACE

INVENTORY