
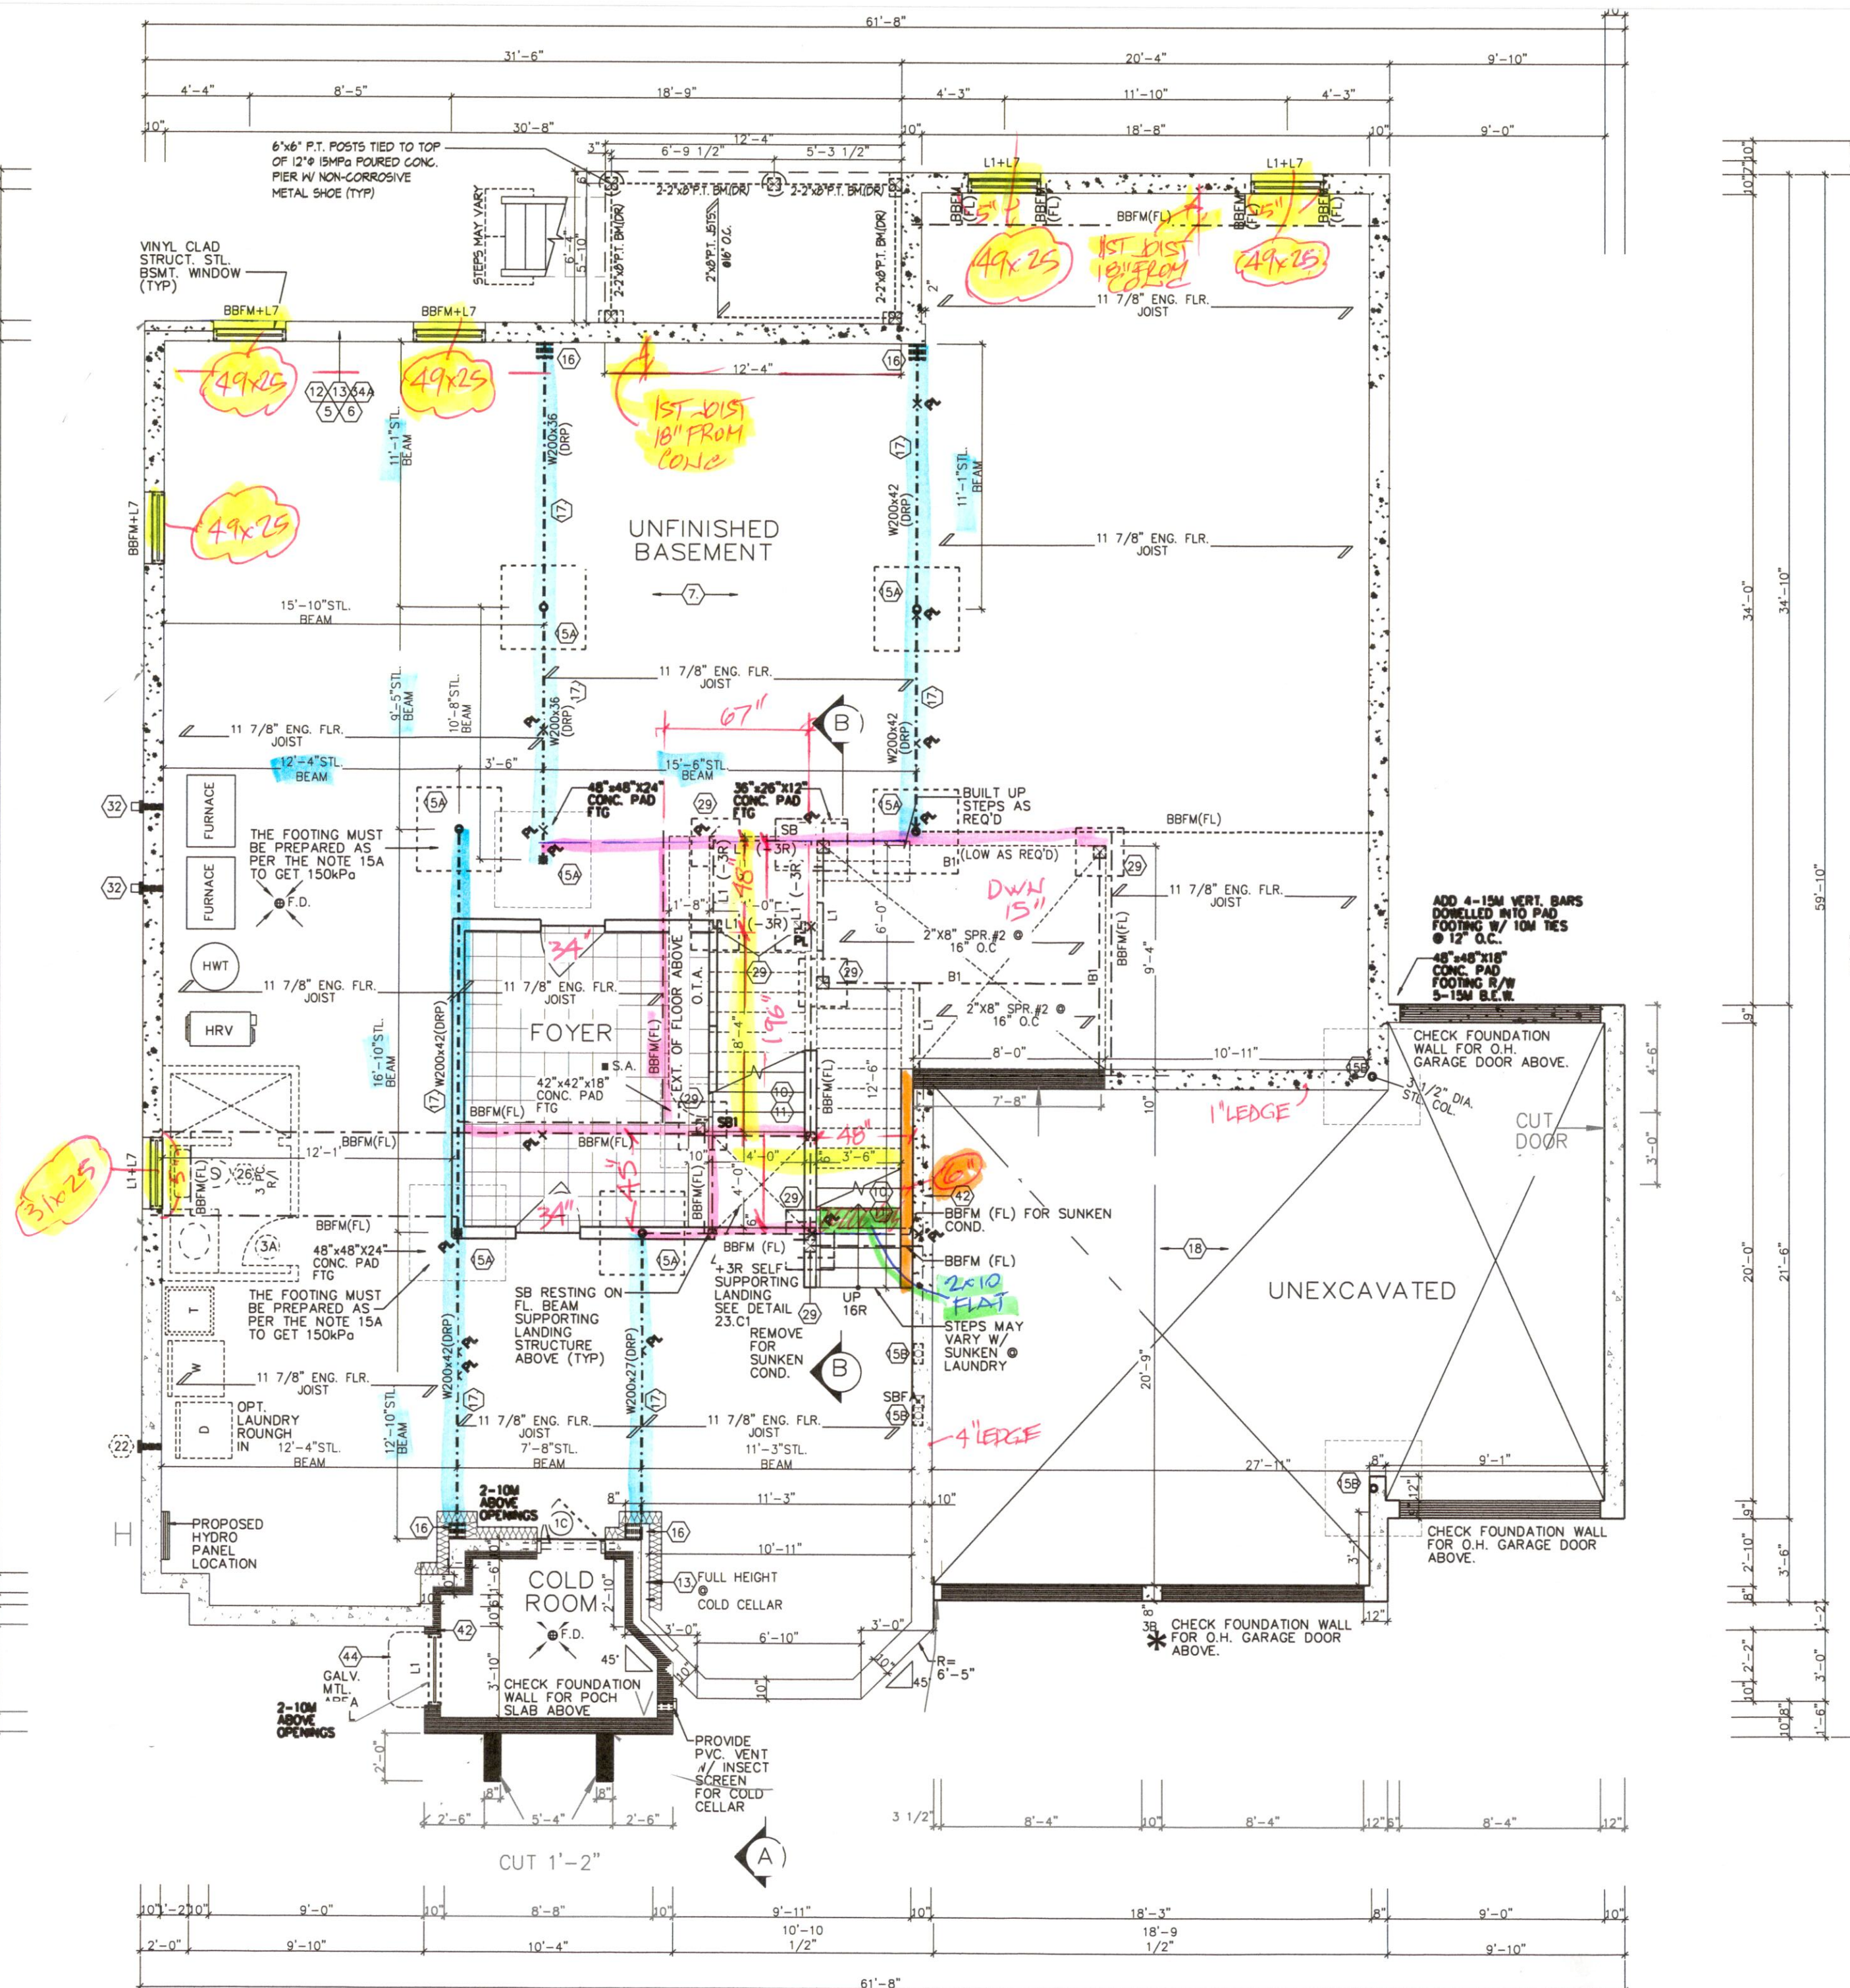


JULY 22 2024	REVISED AS PER STRUCTURAL ENGINEER REISSUED FOR FINAL APPROVAL
JULY 15 2024	REVISED AS PER CONTROL ARCHITECTS COMMENTS
JUNE 17 2024	REVISED AS PER PURCHASERS REQUEST

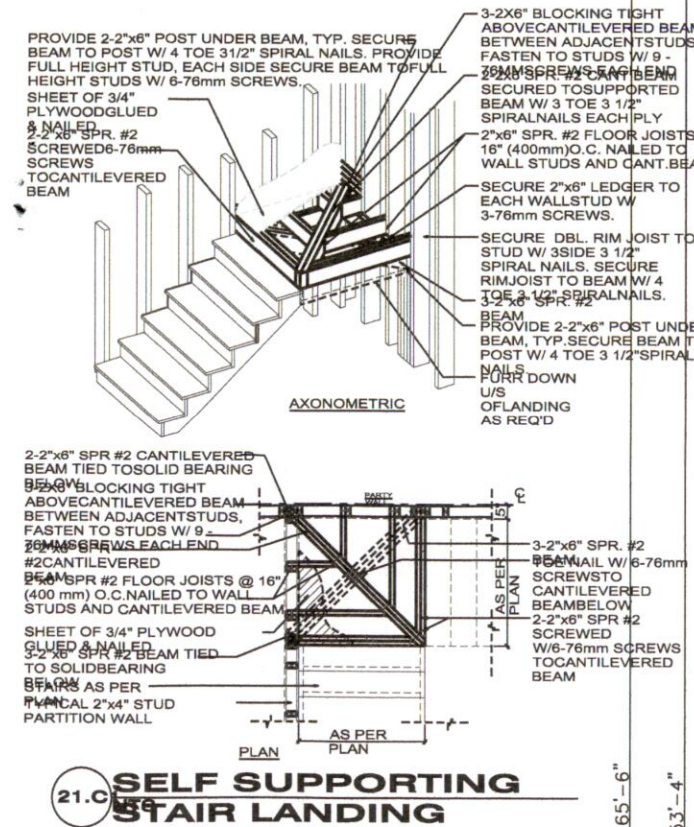

- * 2x6 RATE RANSET TOP OF BEAM
- * CONFIRM BSMINT WINDOWS CORRECT LOCATION

LOT 4


ESTATES OF WEST RIVER/ 2185715 Ontario Inc.
WEST RIVER SOUTH PH. 2

200-3550 Langstaff Road Vaughan, Ontario L4L 9G3 • T 416.213.7181 • F 905.856.6543 • **60-03-NEW CASTLE** •

All drawings specifications, related documents and design are the copyright property of Royal Pine Homes. Reproduction of this property in whole or in part is strictly prohibited without Royal Pine Homes written permission.

3/16" = 1'-0"	02
---------------	-----------

JULY 22 2024 REVISED AS PER STRUCTURAL ENGINEER
REISSUED FOR FINAL APPROVAL
JULY 15 2024 REVISED AS PER
CONTROL ARCHITECTS COMMENTS
JUNE 17 2024 REVISED AS PER
PURCHASERS REQUEST

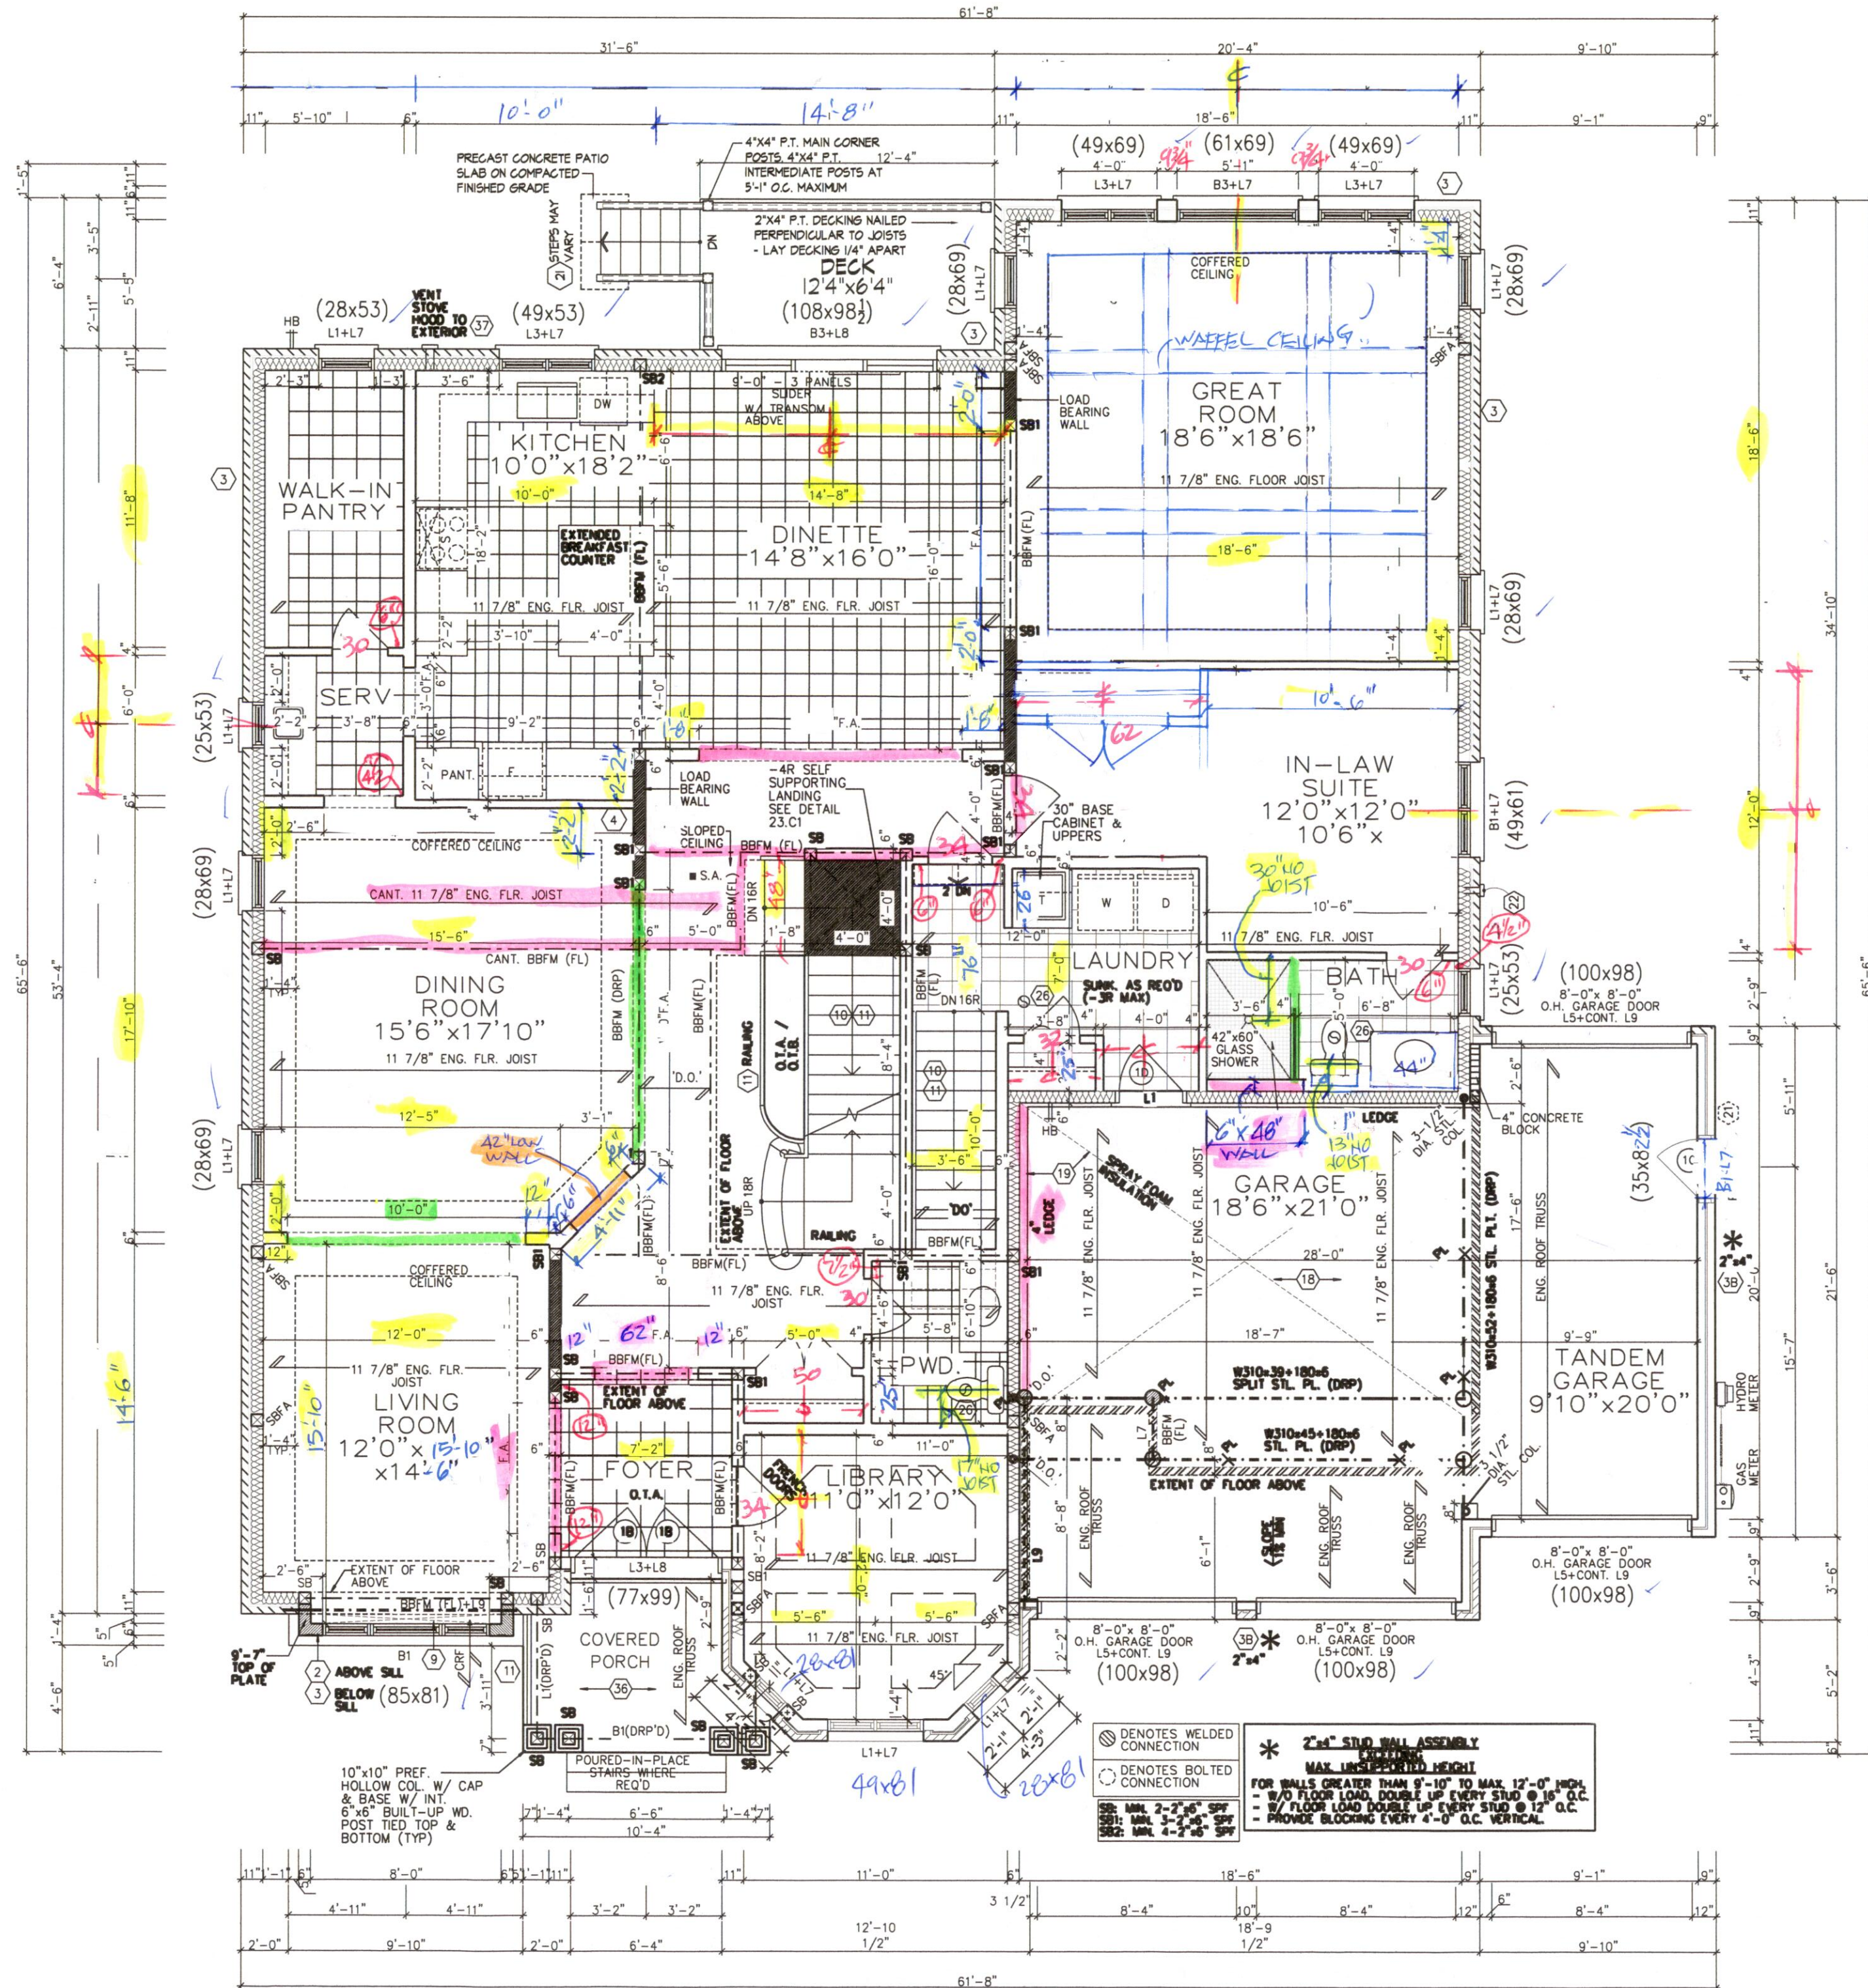

LOT 4





ESTATES OF WEST RIVER/ 2185715 Ontario Inc.
WEST RIVER SOUTH PH. 2

200-3550 Langstaff Road Vaughan, Ontario L4L 9G3 • T 416.213.7181 • F 905.856.6543 • 60-03- NEW CASTLE •

All drawings specifications, related documents and design are the copyright property of Royal Pine Homes. Reproduction of this property in whole or in part is strictly prohibited without Royal Pine Homes written permission.

OPT. GROUND FLOOR
PLAN EL. B W/ OPT.
IN-LAW SUITE

LOT 4

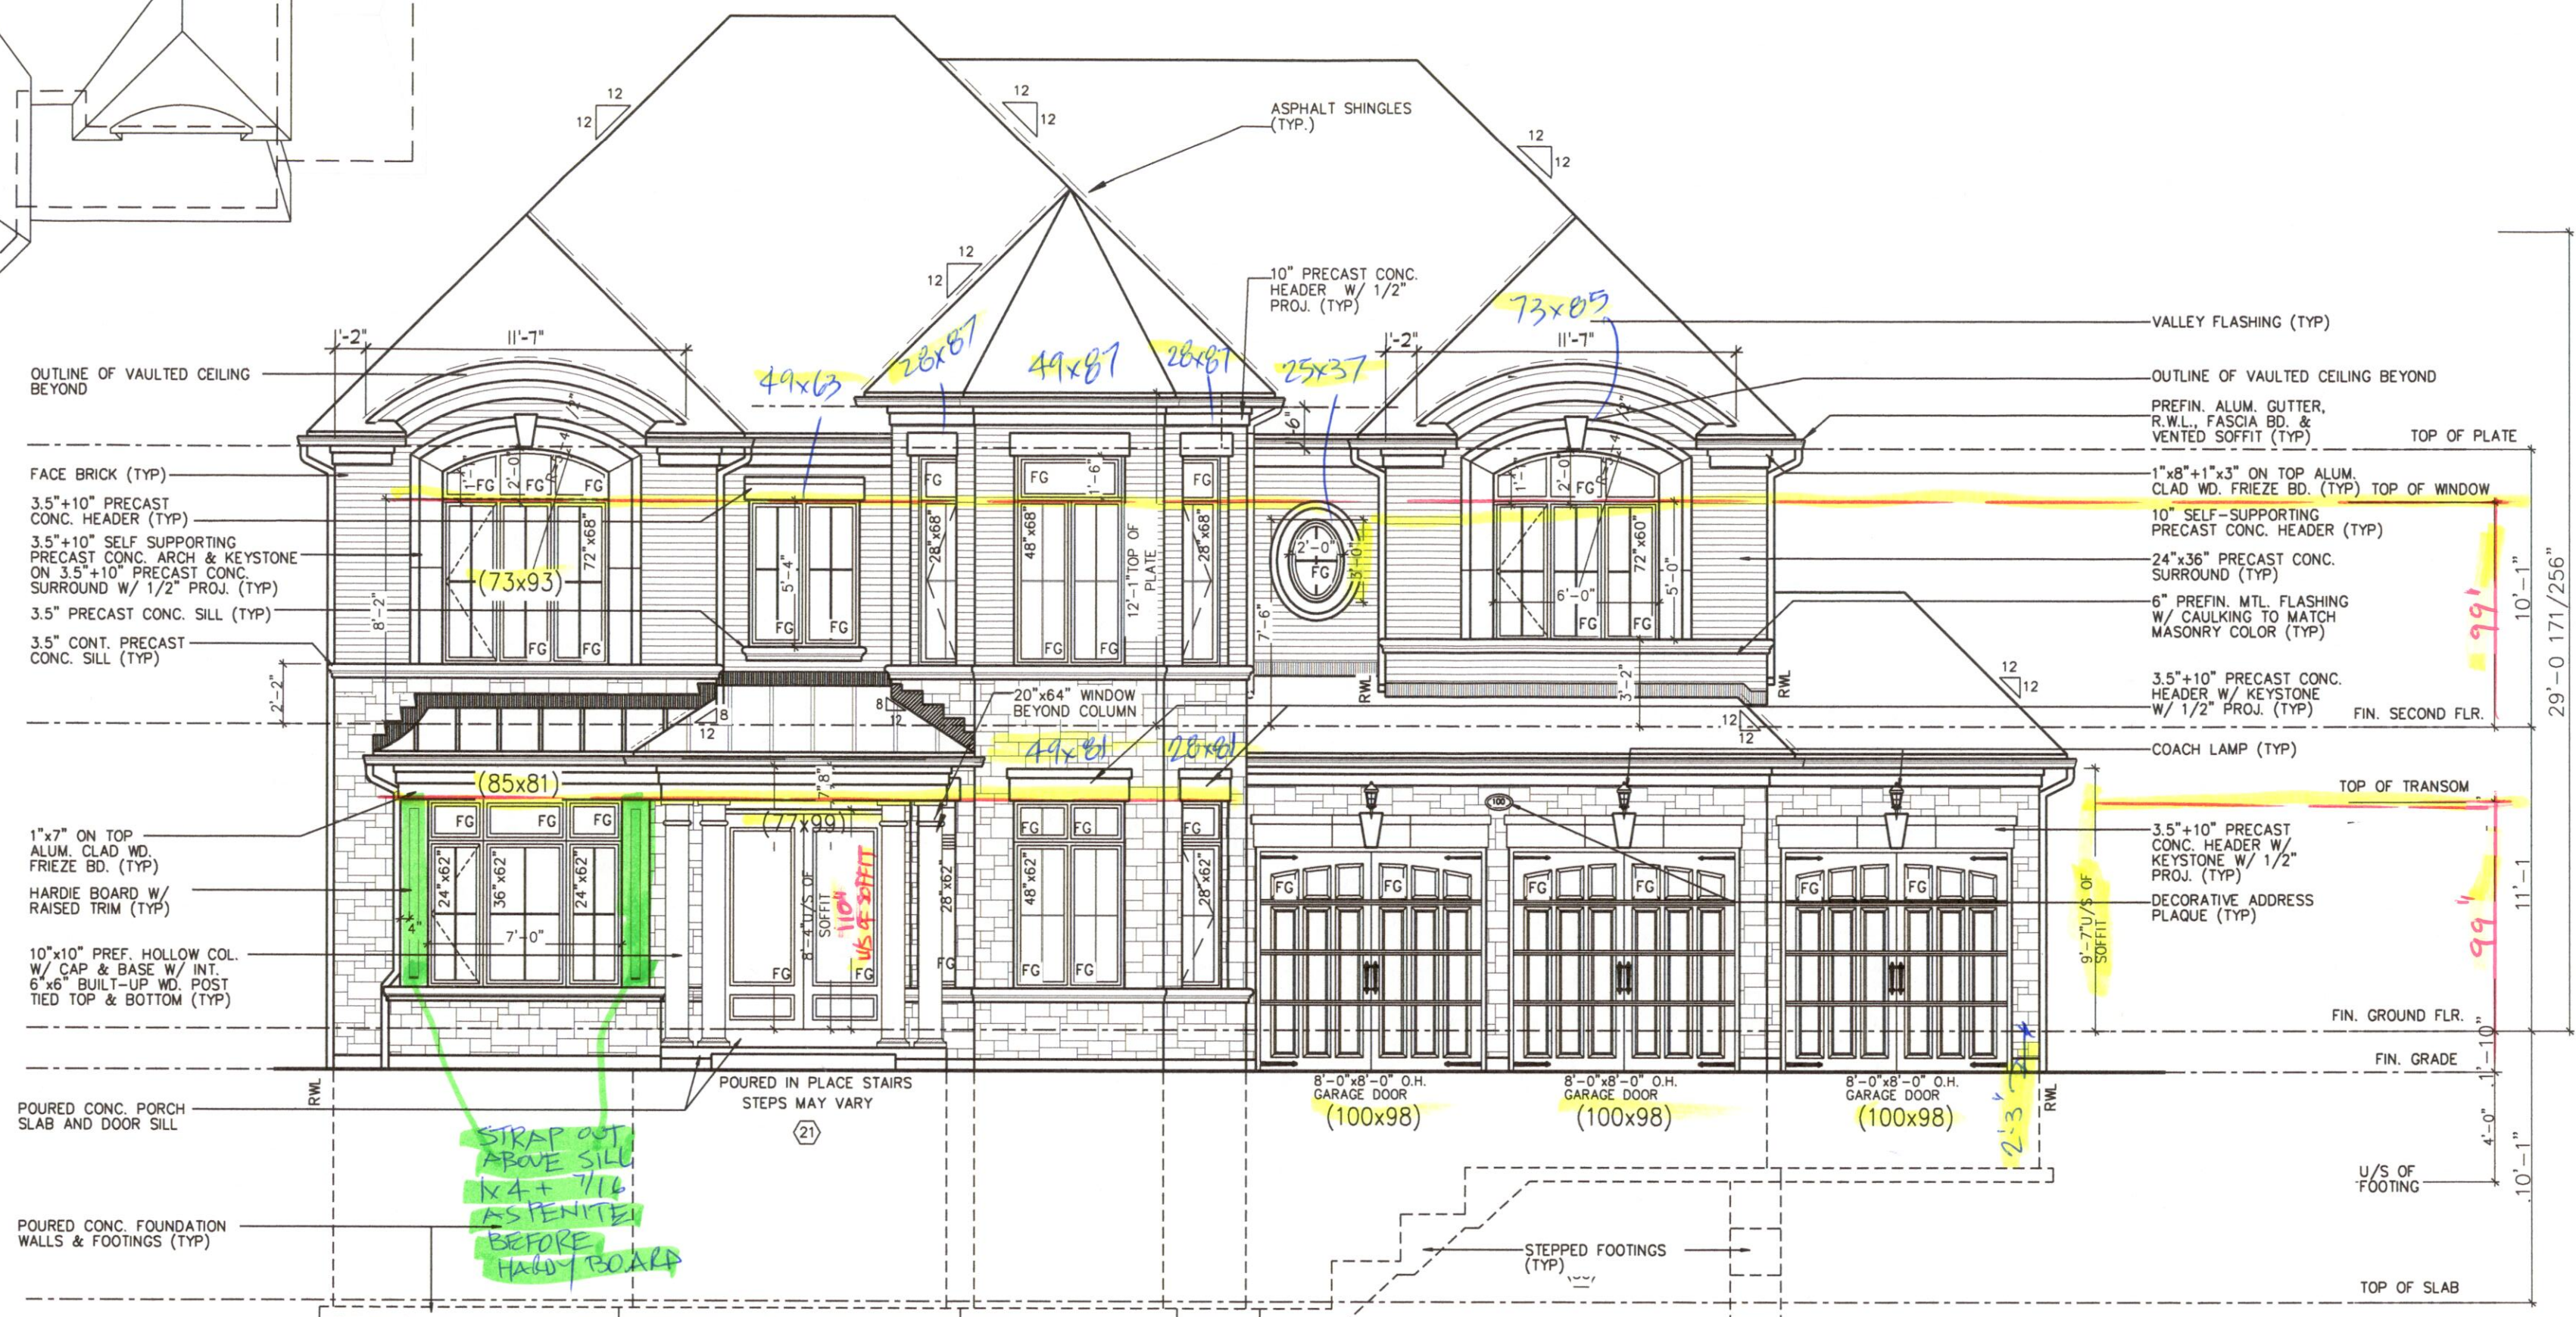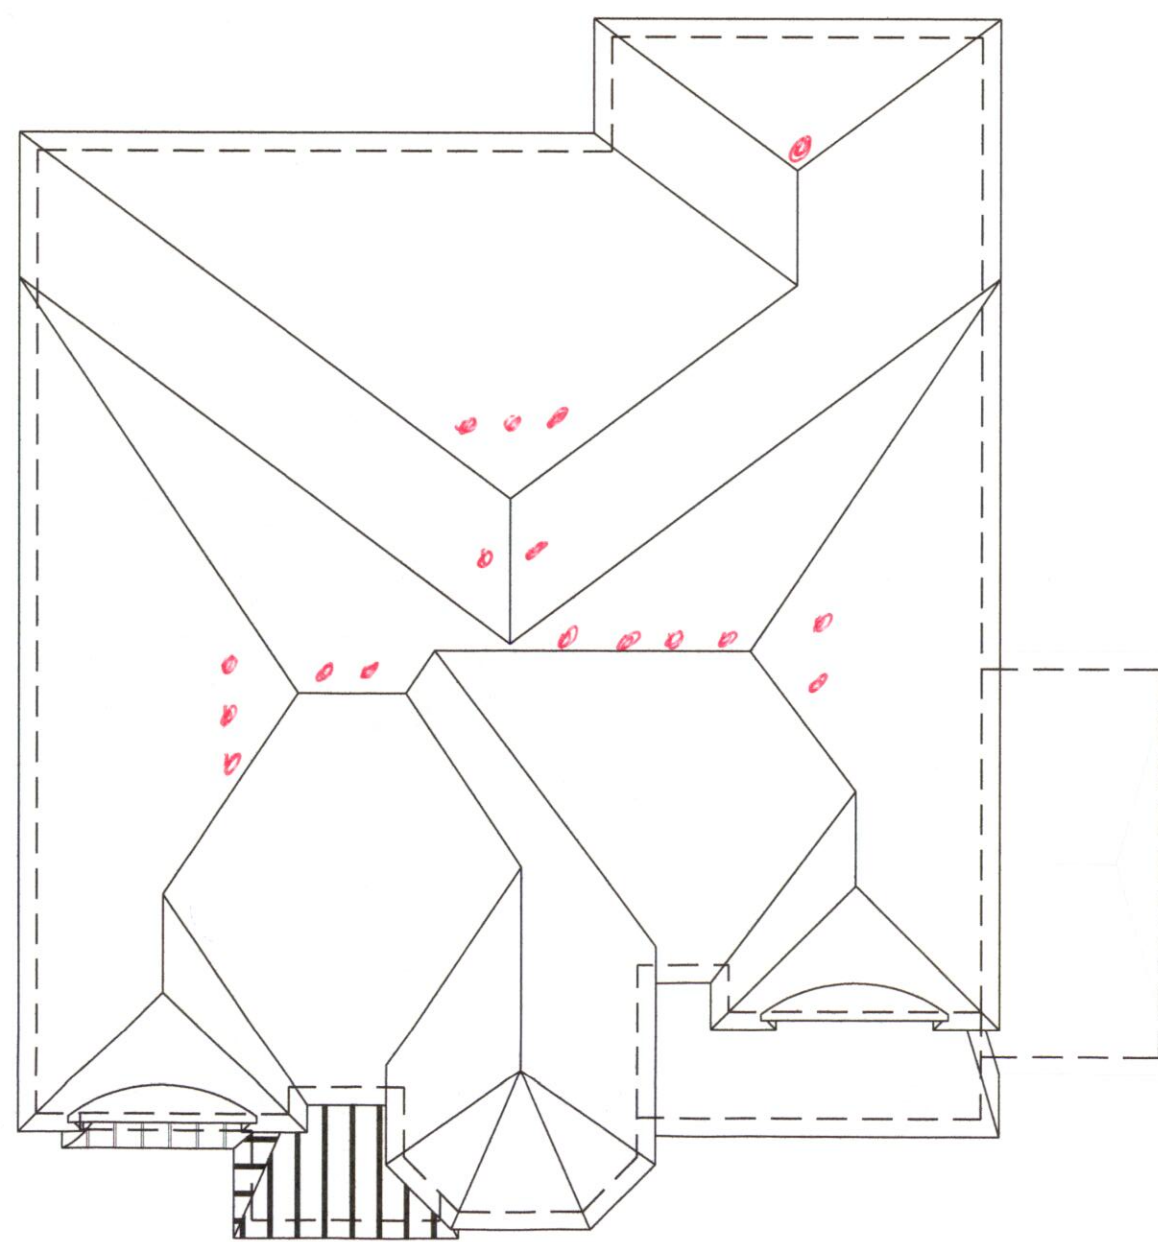

LOT 4
60-03 EL. B
3 CAR GARAGE
THE ESTATES OF WEST RIVER VALLEY

LOT 4




ESTATES OF WEST RIVER/ 2185715 Ontario Inc.
WEST RIVER SOUTH PH. 2

200-3550 Langstaff Road Vaughan, Ontario L4L 9G3 • T 416.213.7181 • F 905.856.6543

60-03 NEW CASTLE

FRONT
ELEV. B

All drawings specifications, related documents and design are the copyright property of Royal Pine Homes. Reproduction of this property in whole or in part is strictly prohibited without Royal Pine Homes written permission.

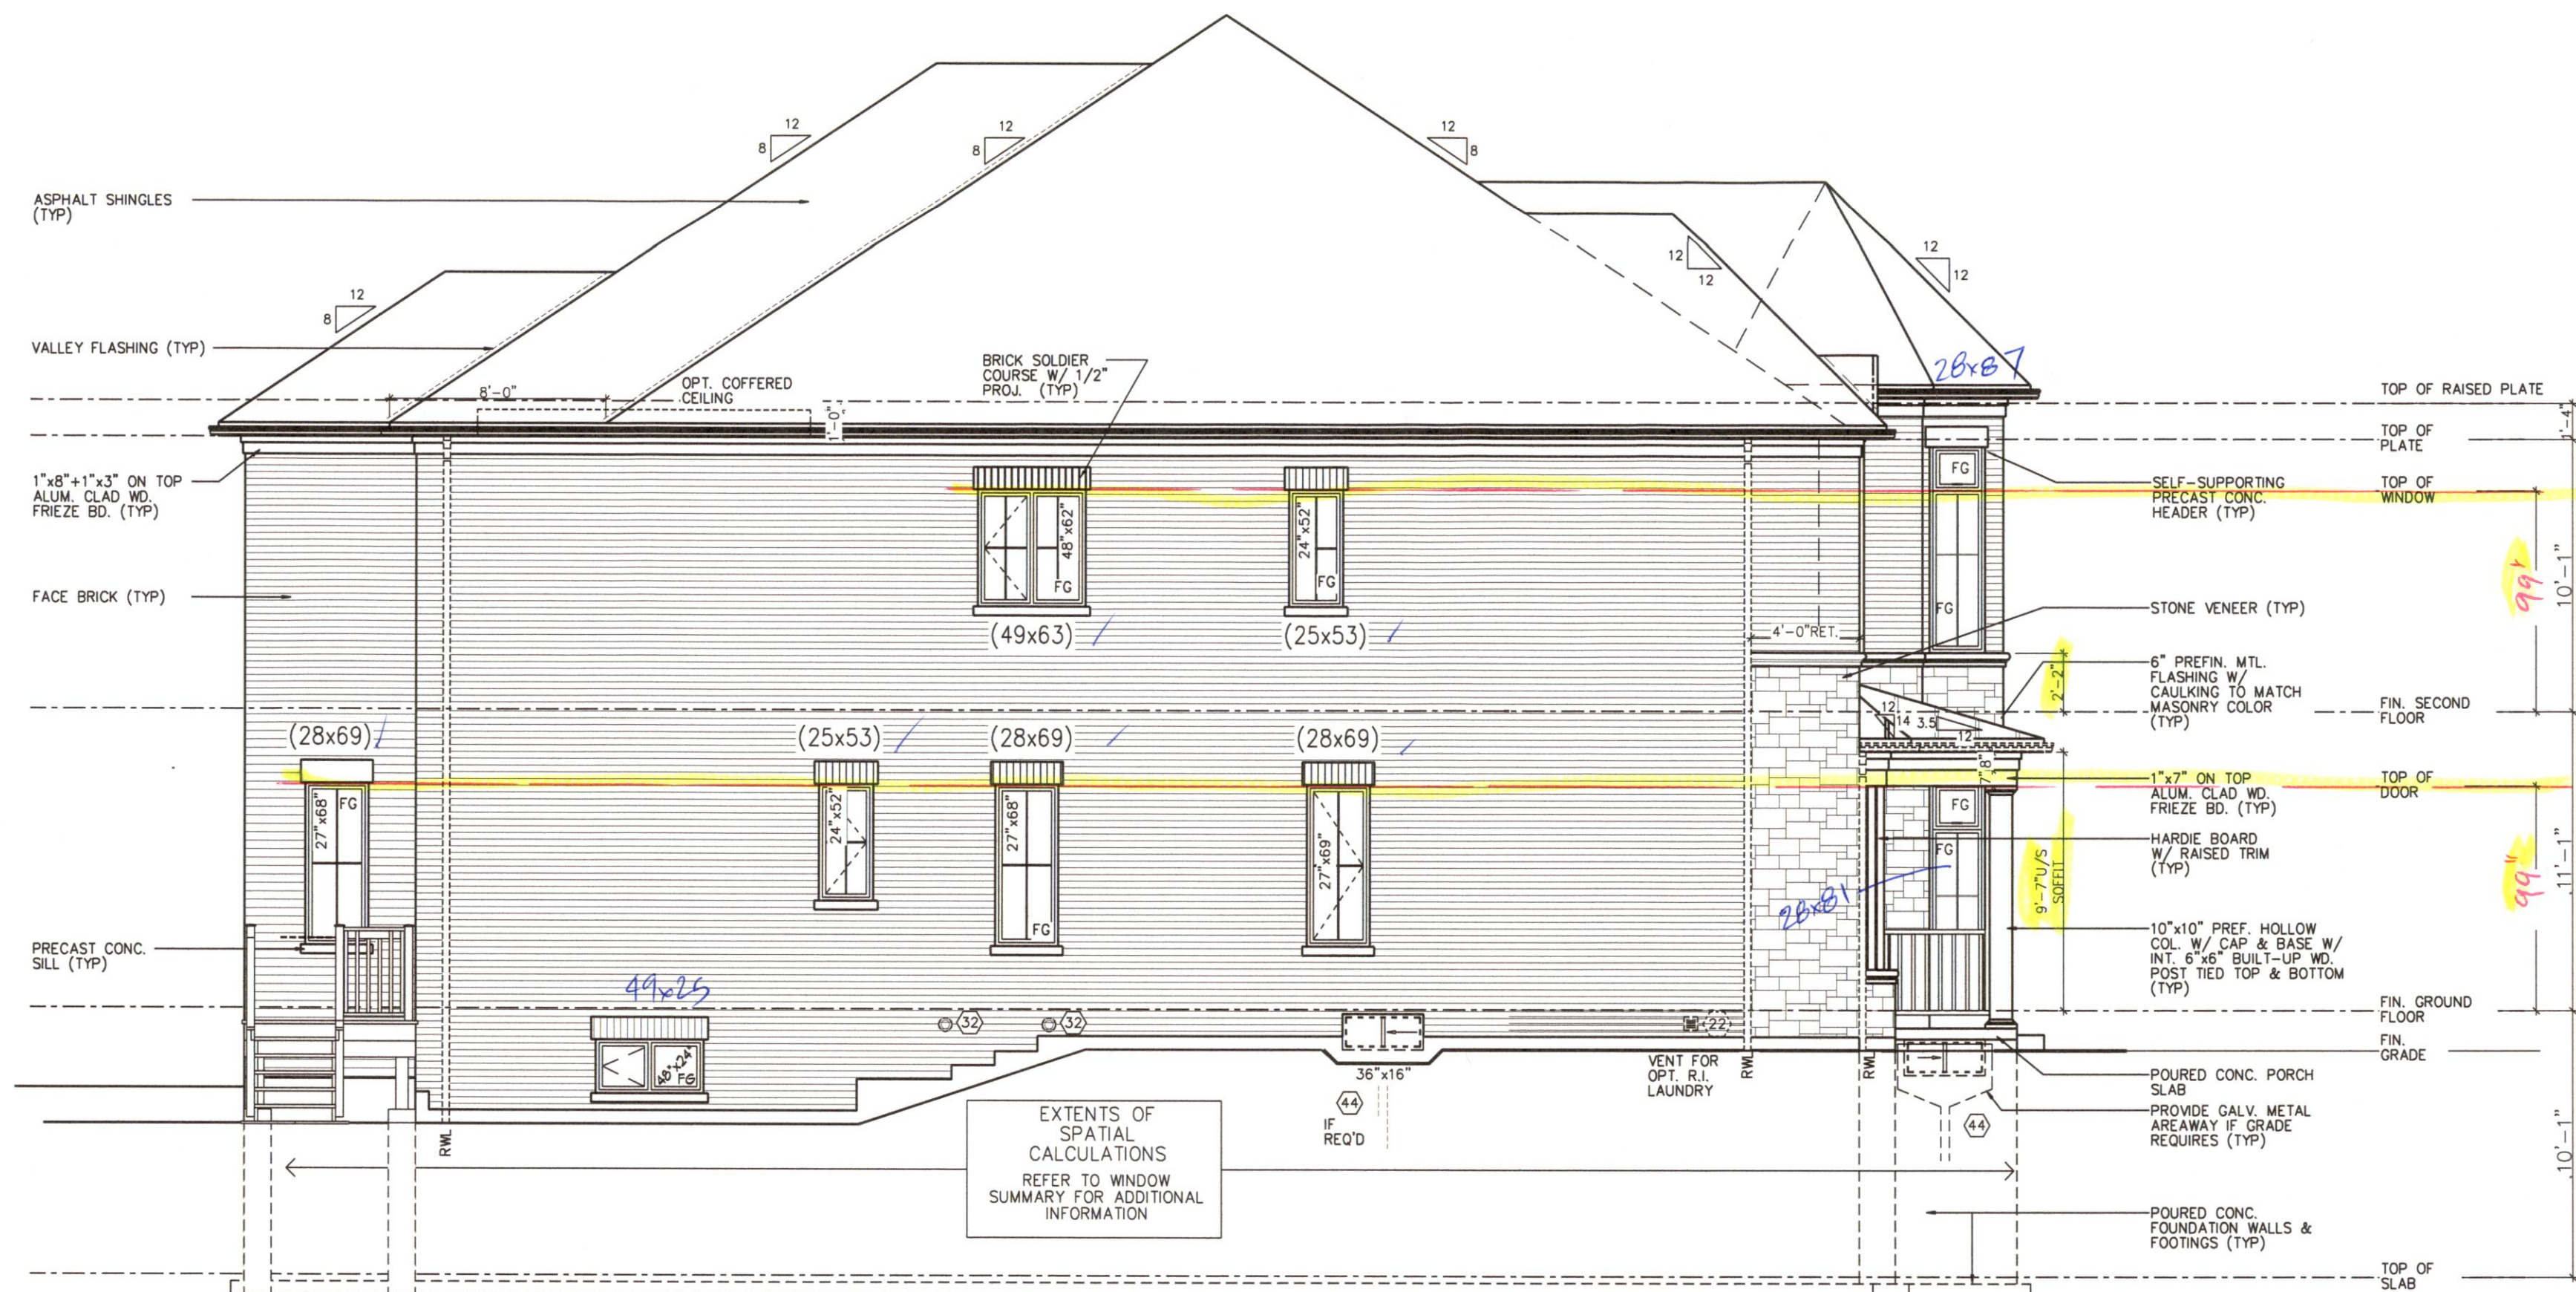

LOT 4



ESTATES OF WEST RIVER/ 2185715 Ontario Inc.
WEST RIVER SOUTH PH. 2

200-3550 Langstaff Road Vaughan, Ontario L4L 9G3 • T 416.213.7181 • F 905.856.6543

3 -60-03- NEW CASTLE -

**LEFT SIDE
ELEV. B**

All drawings specifications, related documents and design are the copyright property of Royal Pine Homes. Reproduction of this property in whole or in part is strictly prohibited without Royal Pine Homes written permission.



P.T. BEAM AS PER PLANS TIED TO TOP OF 6"x6" P.T. POSTS TIED TO TOP OF 12"Ø 15MPA POURED CONC. PIER WITH NON-CORROSIVE METAL SHOE (TYP)


LOT 4



ESTATES OF WEST RIVER/ 2185715 Ontario Inc.
WEST RIVER SOUTH PH. 2

200-3550 Langstaff Road Vaughan, Ontario L4L 9G3 • T 416.213.7181 • F 905.856.6543 **60-03-NEW CASTLE-ELEV. B**

All drawings specifications, related documents and design are the copyright property of Royal Pine Homes. Reproduction of this property in whole or in part is strictly prohibited without Royal Pine Homes written permission.

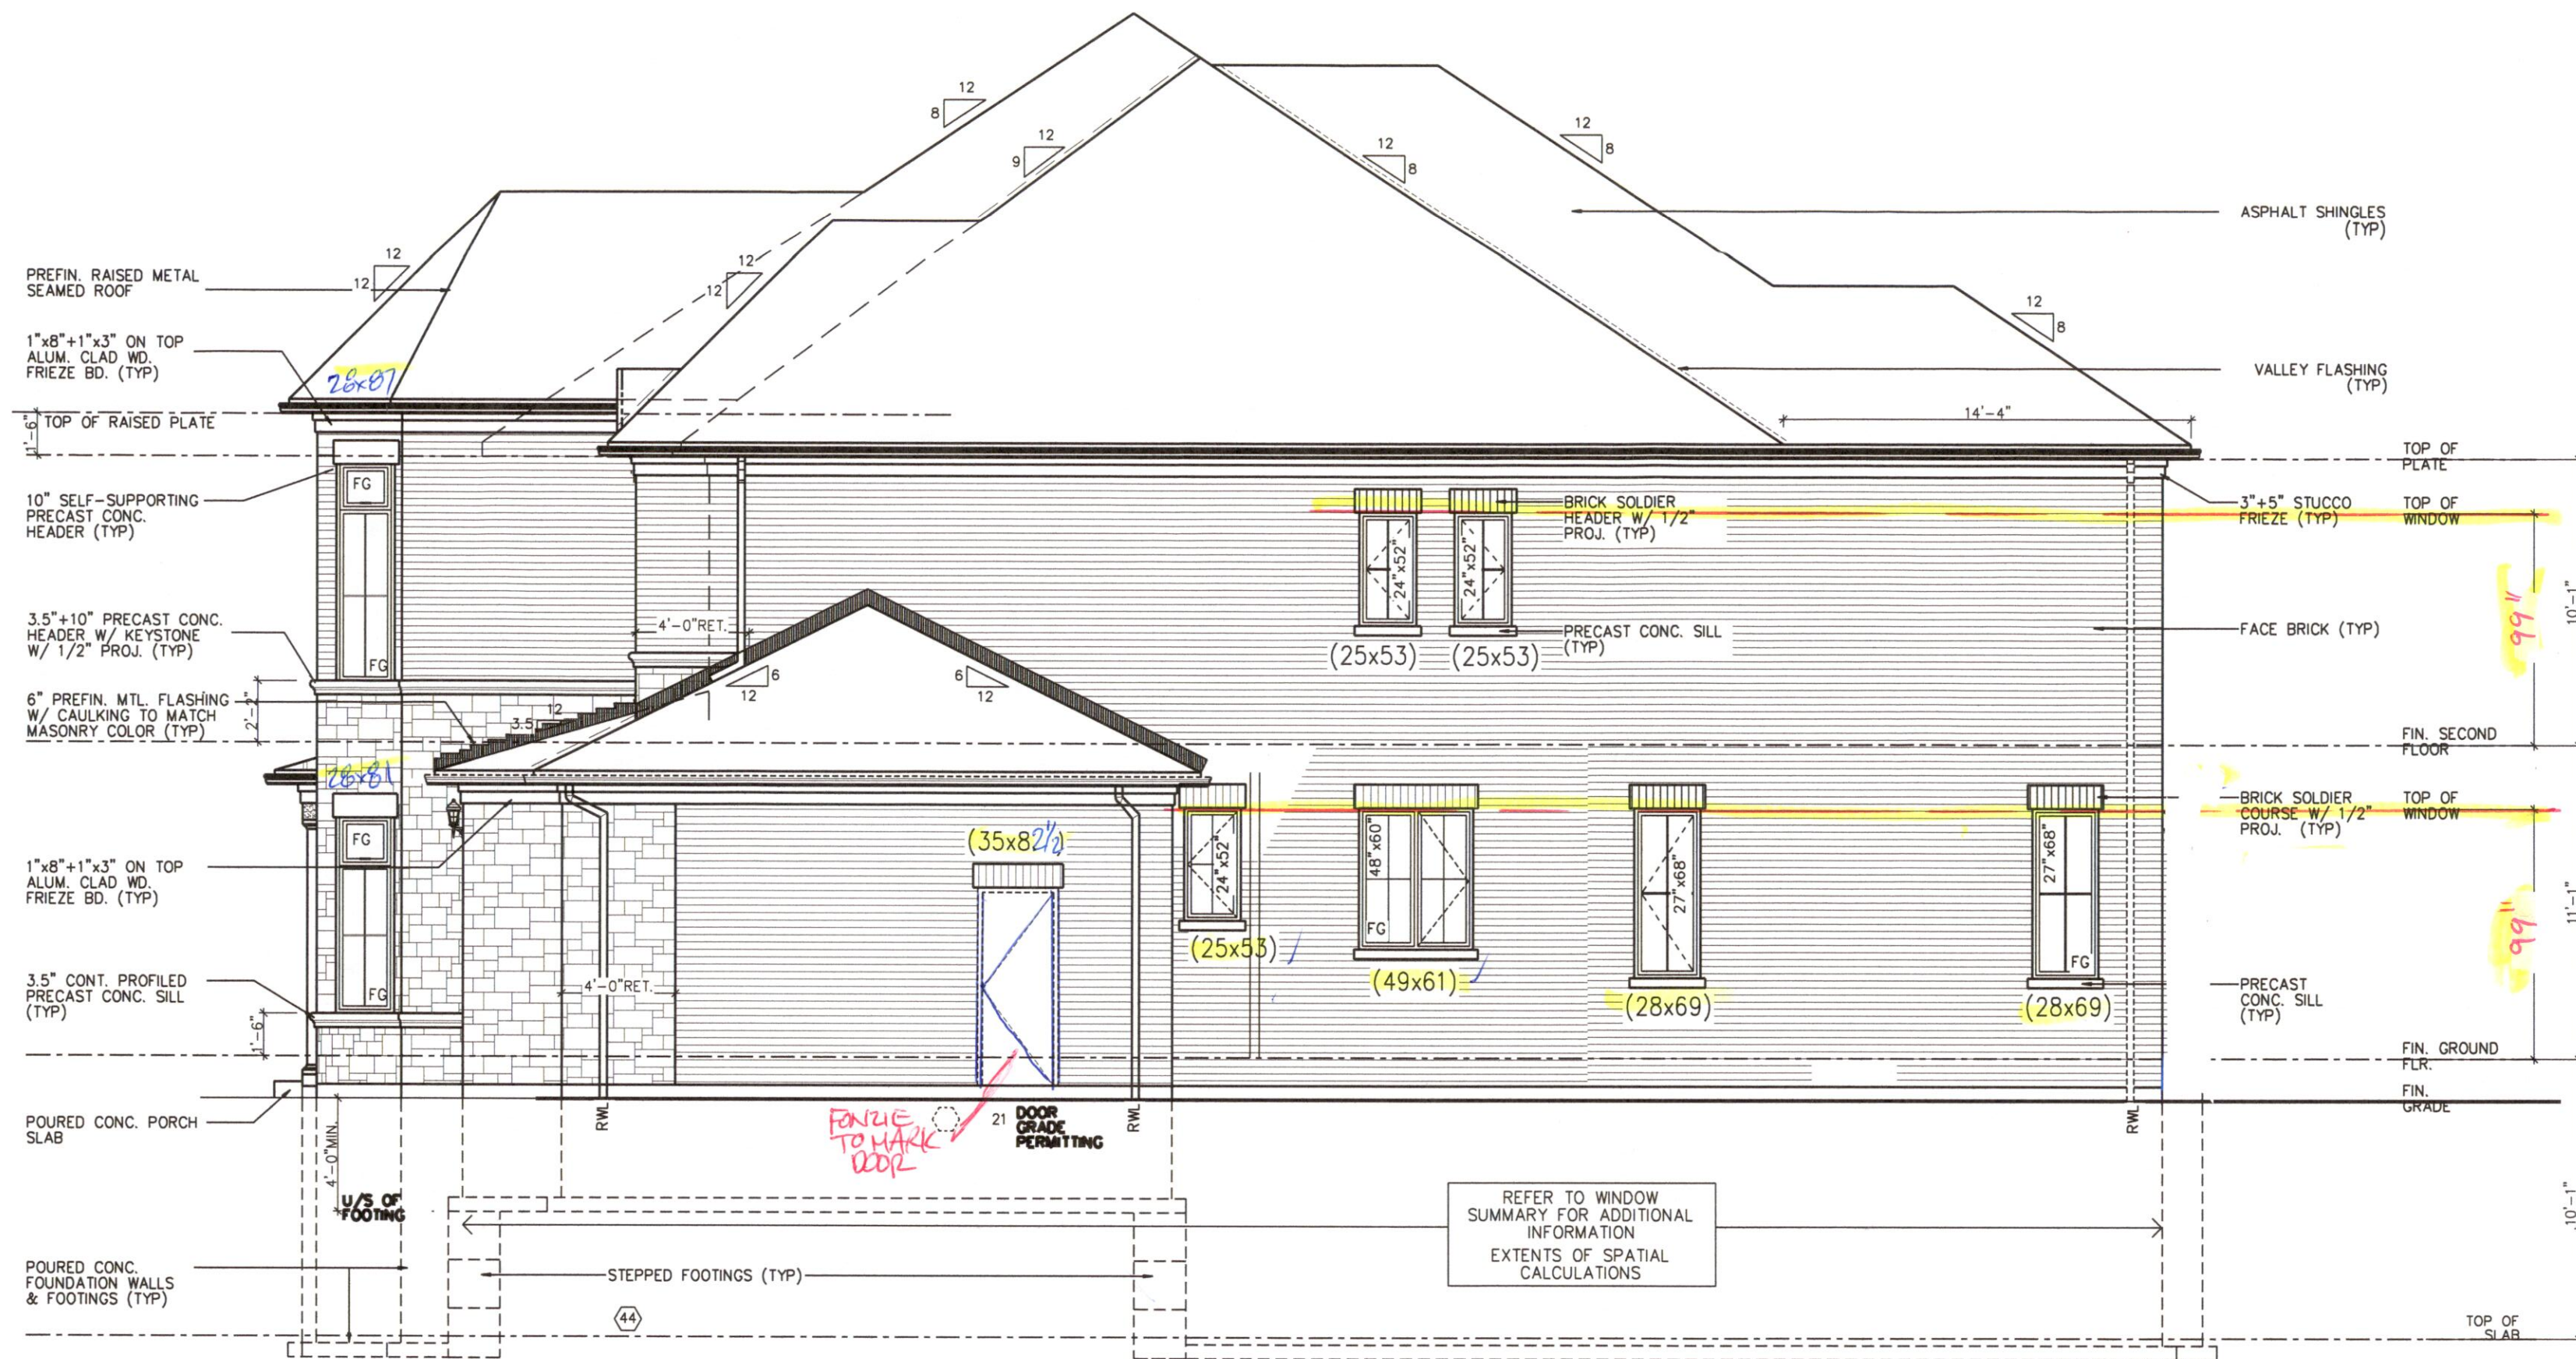

LOT 4



ESTATES OF WEST RIVER/ 2185715 Ontario Inc.
WEST RIVER SOUTH PH. 2

200-3550 Langstaff Road Vaughan, Ontario L4L 9G3 • T 416.213.7181 • F 905.856.6543

60-03- NEW CASTLE

**RIGHT SIDE
ELEV. 'B'**

All drawings specifications, related documents and design are the copyright property of Royal Pine Homes. Reproduction of this property in whole or in part is strictly prohibited without Royal Pine Homes written permission.